

INDEX OF SHEETS

- SHEET NO. 1 TITLE PAGE
 2 TYPICAL CROSS-SECTION OF IMPROVEMENT STABILIZED GRAVEL BASE COURSE OF CUTBACK ASPHALT WITH PEA STONE SEAL ITEM 304-B
 3 BANKING AND WIDENING TABLES
 4 QUANTITY SHEET (ITEMS AND DRAINAGE)
 5-7 EARTHWORK SHEETS
 8-14 PLAN AND PROFILE SHEETS
 15 DETAILS OF 6' X 5' R.C. BOX EXTENSION
 16 REINFORCING STEEL SCHEDULE
 17 CONSTRUCTION DETAILS CD (DRAINAGE AND MARKERS)
 18 CONSTRUCTION DETAILS CD-1 (DITCHES)
 19 CONSTRUCTION DETAILS CD-2 (TYPICAL SLOPE GRADING)
 20 STANDARD STRUCTURE SHEET S-40 (BARRICADES, SIGNS & LIGHTS)
 21 STANDARD STRUCTURE SHEET S-48-46 (THREE CABLE GUARD RAIL)
 22 STANDARD STRUCTURE SHEET S-53-48 (P.C. R.C. DROP INLET)
 23-39 CROSS SECTIONS
 40-41 CHANNEL SECTIONS

STANDARD STRUCTURE SHEET APPROVED BY THE CHIEF ENGINEER, VERMONT STATE DEPARTMENT OF HIGHWAYS.

S-40 JUNE 10, 1950

PROJECT NAME & NUMBER	TYPE	PAVEMENT AREA
ORWELL S 241 (1)	STABILIZED GRAVEL BASE COURSE OF CUTBACK ASPHALT	18,440 S.Y.
RECORD PLANS		
MATERIALS		
SUB BASE OF GRAVEL WHITE PIT, ORWELL	REINFORCING STEEL	VT. STRUCT. ST. CO., BURLINGTON
CRUSHED GRAVEL WHITE PIT, ORWELL	R.C.P. FEDERAL PIPE CO., GLENS FALLS, N.Y.	
CUTBACK ASPHALT SOCONY VACUUM, E. PROV., R.I.	A.C.C.G.M.P. NEW ENG. METAL CULVERT CO., BOSTON, MASS.	
SAND FOR SEAL CLARK & HAYNES, POULTNEY	CABLE FOR GUARD RAIL AMERICAN STEEL & WIRE CO., N.Y.	
PEASTONE FOR SEAL VT. MARBLE CO., FLORENCE	WHITE G.R. PAINT BRADLEY LABS., BRATTLEBORO	
CEMENT LONE STAR PORT. CEM. CO., HUDSON, N.Y.	BLACK G.R. PAINT FRANKLIN PAINT CO., FRANKLIN, MASS.	
CONC. AGGREGATE W.C. KIRBY, BURLINGTON		
CONTRACTOR SHATTUCK, BURNETT & GONYO, BURLINGTON	CONTRACT DATED	APRIL 16, 1954
RESIDENT ENG'R R. FUNK	CONTRACT STARTED	MAY 5, 1954
INSPECTORS A. DELANO	CONTRACT COMPLETED	OCTOBER 19, 1954
RECORD PLANS R. FUNK 7-1-55	CONTRACT ACCEPTED	OCTOBER 19, 1954

STATE OF VERMONT DEPARTMENT OF HIGHWAYS


PROPOSED IMPROVEMENT

SECONDARY PROJECT



TOWN OF ORWELL COUNTY OF ADDISON VERMONT ROUTE F10 ORWELL-SUDBURY ROAD

BEGINNING AT A POINT APPROXIMATELY 979.4 FEET EAST OF THE INTERSECTION OF VERMONT ROUTES 22-A AND F-10 AND EXTENDING EASTERLY 8232.8 FEET

LENGTH OF PROJECT 8232.8 FEET = 1.559 MILES

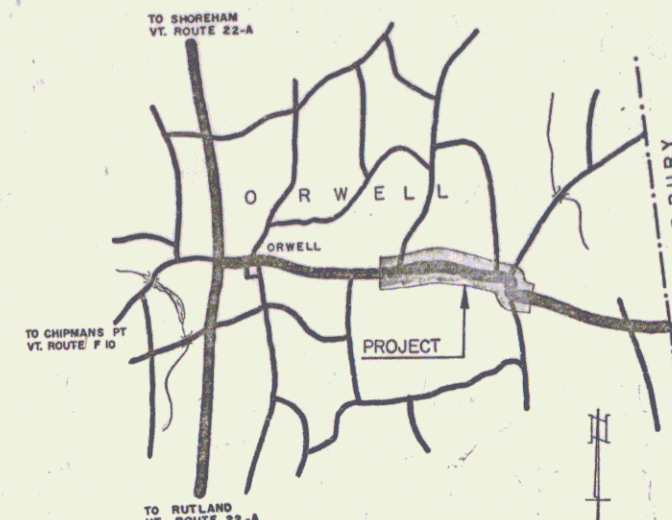

FED. ROAD DISTRICT NO.	STATE	PROJECT NO.	SHEET NO.	TOTAL SHEETS
1	VT	241 (1)	1	41

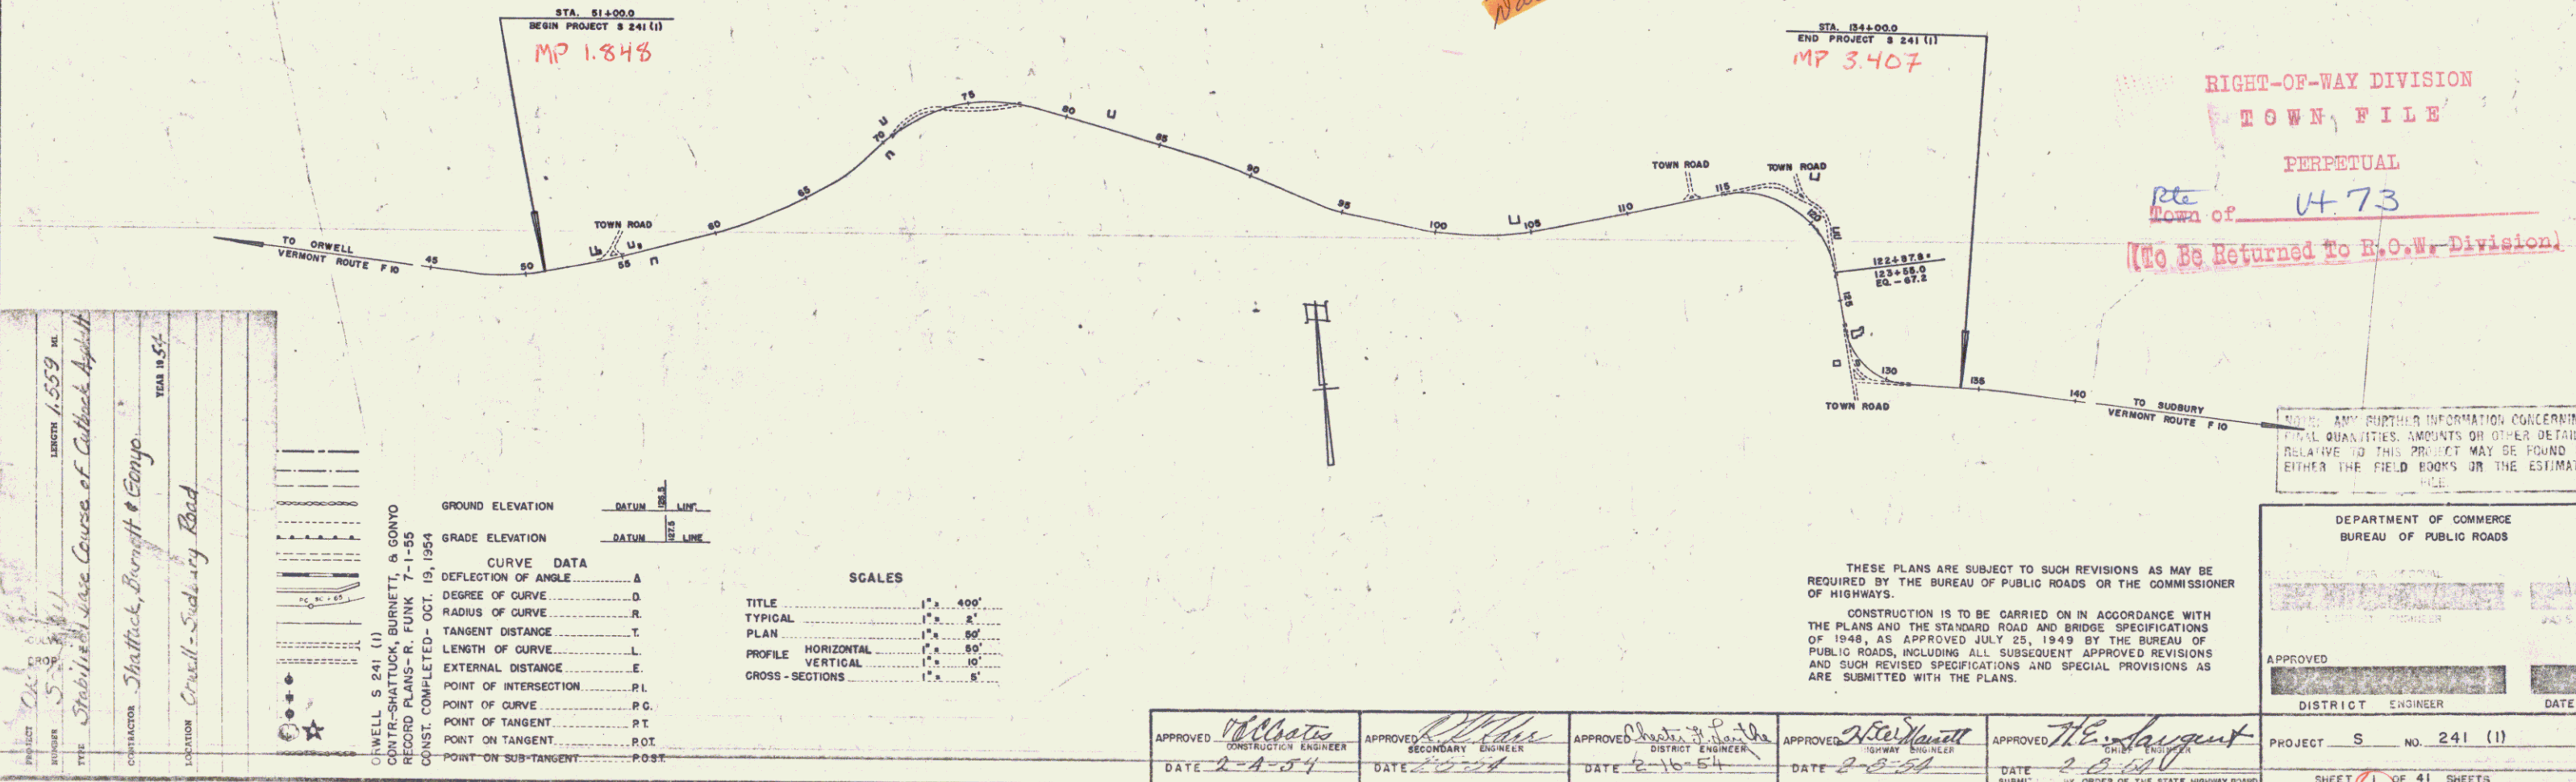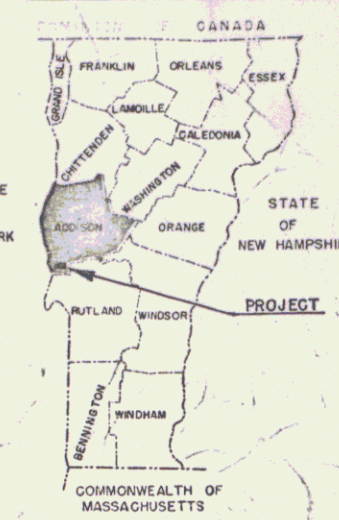

4773

PLAN	DATE	BY	CHECKED	DATE	BY
12-31	12-31	A. J. J. J.	A. J. J. J.	12-31	A. J. J. J.
12-31	12-31	A. J. J. J.	A. J. J. J.	12-31	A. J. J. J.

PROFILE	DATE	BY	CHECKED	DATE	BY
12-31	12-31	A. J. J. J.	A. J. J. J.	12-31	A. J. J. J.
12-31	12-31	A. J. J. J.	A. J. J. J.	12-31	A. J. J. J.

