

INDEX OF SHEETS

SHEET NO.	TITLE PAGE
1	TYPICAL CROSS SECTION OF IMPROVEMENT, DOUBLE TACK COAT OF REFINED TAR WITH PEASTONE SEAL, ITEM 312-A
2	QUANTITY SHEET (ITEMS)
3	QUANTITY SHEET (DRAINAGE)
4	EARTHWORK SHEETS
5-7	ROADWAY STANDARD SHEET RS 56-1
8	" " " RS 56-3
9	" " " RS 56-4
10	" " " RS 56-6
11	" " " RS 56-9
12	" " " RS 56-10
13	" " " RS 56-12
14	" " " RS 56-14
15	" " " RS 56-14
16-23	PLAN & PROFILE SHEETS
24-47	CROSS SECTION SHEETS

STATE OF VERMONT DEPARTMENT OF HIGHWAYS

Proposed Improvement


TOWNS OF BRANDON & GOSHEN COUNTIES OF RUTLAND & ADDISON BRANDON - ROCHESTER RD.

PROJECT NAME & NUMBER	TYPE	PAVEMENT AREA
BRANDON - GOSHEN St 191-N	ADDITIONAL TACK COAT OF REFINED TAR WITH PEASTONE SEAL	20,992.2 Sq Yds
RECORD PLANS		
MATERIALS		
SUBBASE OF GRAVEL	Penstone Tar Seal Vt. M. & Co. Windsor, Vt.	
CRUSHED GRAVEL (2050)	KCP Vt. Concrete Pipe Co. Windsor, Vt.	
REFINED TAR	ACGMP Bangor Metal C. Co. Bangor, Me.	
BITUMINOUS CONCRETE	Whitcomb Bros. Co. Whitcomb, Vt.	
CONTRACTOR - Boston Construction Corp.		
RESIDENT ENGR. - C. J. Crissell		
INSPECTOR - H. A. Davis		
RECORD PLANS - C. J. Crissell		
CONTRACT DATED Oct 5, 1956		
CONTRACT STARTED Oct 31, 1956		
CONTRACT COMPLETED Aug 29, 1957		
CONTRACT ACCEPTED Aug 29, 1957		

BEGINNING AT A POINT APPROXIMATELY 8,204.0 FEET SOUTHWESTERLY OF THE BRANDON - GOSHEN TOWN LINE AND EXTENDING NORTHEASTERLY 9,236.5 FEET

LENGTH OF PROJECT 9,236.5 FEET = 1.749 MILES
4 x 2.76 2 x 1.248

LEICESTER
ADDISON CO.
BRANDON

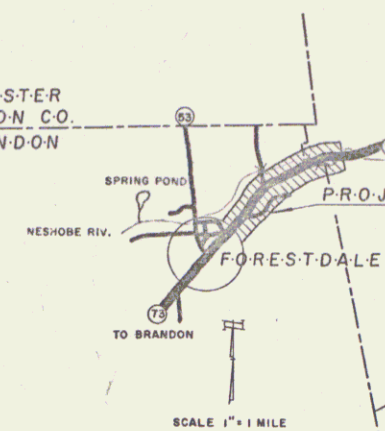

ADDISON CO.
GOSHEN
CHITTENDEN
RUTLAND CO.

FED. ROAD DISTRICT	STATE	PROJECT NO.	SHEET NO.	TOTAL SHEETS
1	Vt.	5191(N)	1	47




ROUTE VT 73
PROJECT: ST 191(N)
PIN: 00R414
DATE: 8/30/1956

RIGHT-OF-WAY DIVISION
TOWN FILE

PERPETUAL

Town of VT 73

(To Be Returned To R.O.W. Division)

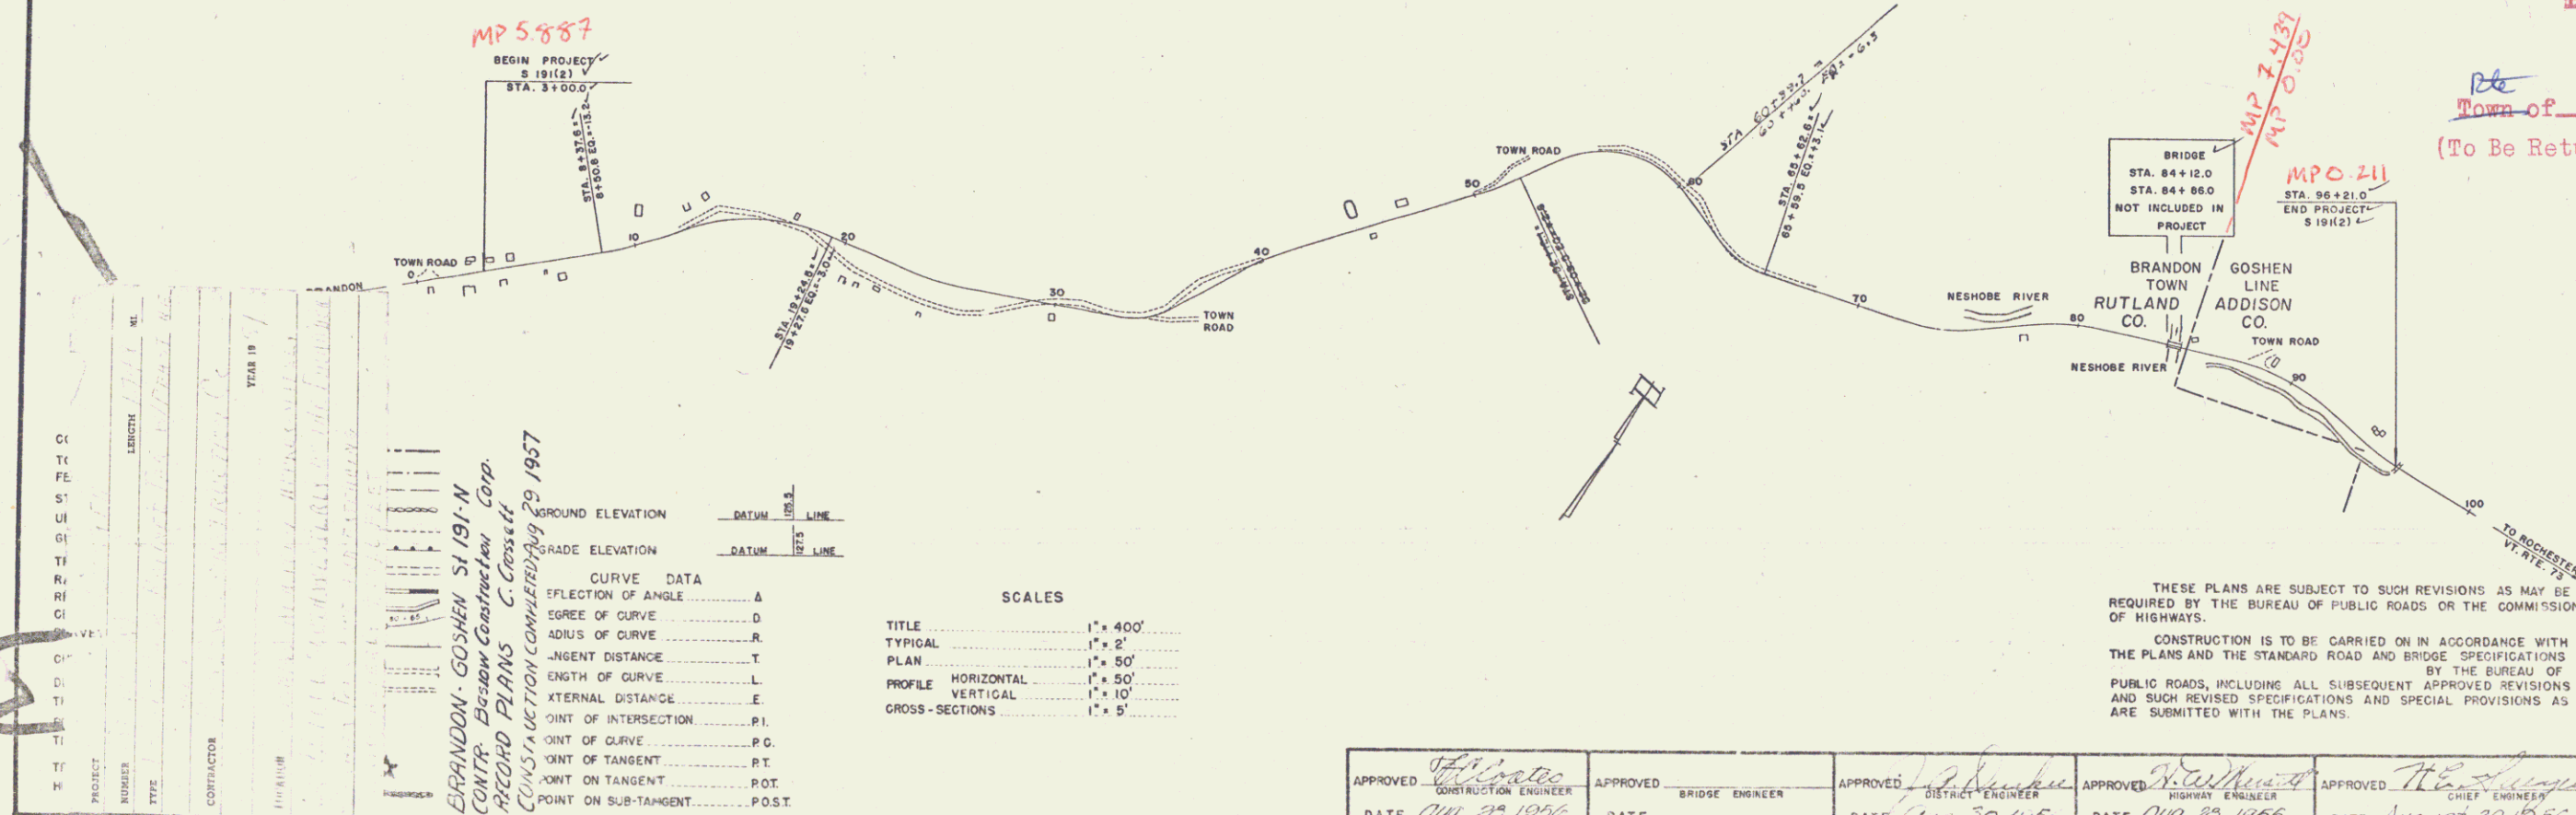

NOTE: ANY FURTHER INFORMATION CONCERNING FINAL QUANTITIES, SPECIFICATIONS OR OTHER DETAILS RELATIVE TO THIS PROJECT MAY BE FOUND IN EITHER THE FIELD BOOKS OR THE ESTIMATE

THESE PLANS ARE SUBJECT TO SUCH REVISIONS AS MAY BE REQUIRED BY THE BUREAU OF PUBLIC ROADS OR THE COMMISSIONER OF HIGHWAYS.
CONSTRUCTION IS TO BE CARRIED ON IN ACCORDANCE WITH THE PLANS AND THE STANDARD ROAD AND BRIDGE SPECIFICATIONS BY THE BUREAU OF PUBLIC ROADS, INCLUDING ALL SUBSEQUENT APPROVED REVISIONS AND SUCH REVISED SPECIFICATIONS AND SPECIAL PROVISIONS AS ARE SUBMITTED WITH THE PLANS.

DEPARTMENT OF COMMERCE
BUREAU OF PUBLIC ROADS

APPROVED

DIST. ENGINEER

DATE

APPROVED
CONSTRUCTION ENGINEER
DATE: Aug 29, 1956

APPROVED
BRIDGE ENGINEER
DATE

APPROVED
DISTRICT ENGINEER
DATE: Aug 29, 1956

APPROVED
HIGHWAY ENGINEER
DATE: Aug 29, 1956

APPROVED
CHIEF ENGINEER
DATE: August 30, 1956
SUBMITTED BY ORDER OF THE STATE HIGHWAY BOARD

PROJECT NO. 191(N)
SHEET 1 OF 47 SHEETS

○ Indicates "Cutting and Removing Trees" Item 110
 □ " " Boundary Markers

					CONSTRUCT APPROACHES				
					LT		RT		
					14 F 25 ✓		13 F 21 ✓		

PARCEL	INSTRUMENT	DATE	GRANTOR	GRANTEE	RECORDED	BOOK	PAGE	DATE	REMARKS
1	W.D.O.E.	9-12-56	Paul A. & Bernice E. White	St. of Vt.	Brandon	74	17	10-27-56	
2	W.D.O.E.	11-8-56	Grace Episcopal Church of Forestdale	St. of Vt.	Brandon	74	30	11-16-56	
3	W.D.O.E.	9-12-56	Millard G. & Mildred I. Smith	St. of Vt.	Brandon	74	18	10-27-56	
4	W.D.O.E.	9-7-56	Tellisphore F. & Barbara V. Gagnon	St. of Vt.	Brandon	74	19	10-27-56	
5A,B	W.D.O.E.	9-7-56	Frederick W. & Eleanor W. Fletcher	St. of Vt.	Brandon	74	21	10-27-56	See also sheet 17

CONSTRUCT APPROACHES



LT	RT
14+25	13+22

CONSTRUCT DRIVES

LT	RT
11+00	10+00
13+50	12+50
11+00	10+00
13+50	12+50

TWO CABLE GUARD RAIL


LT	RT
15+73	16+00

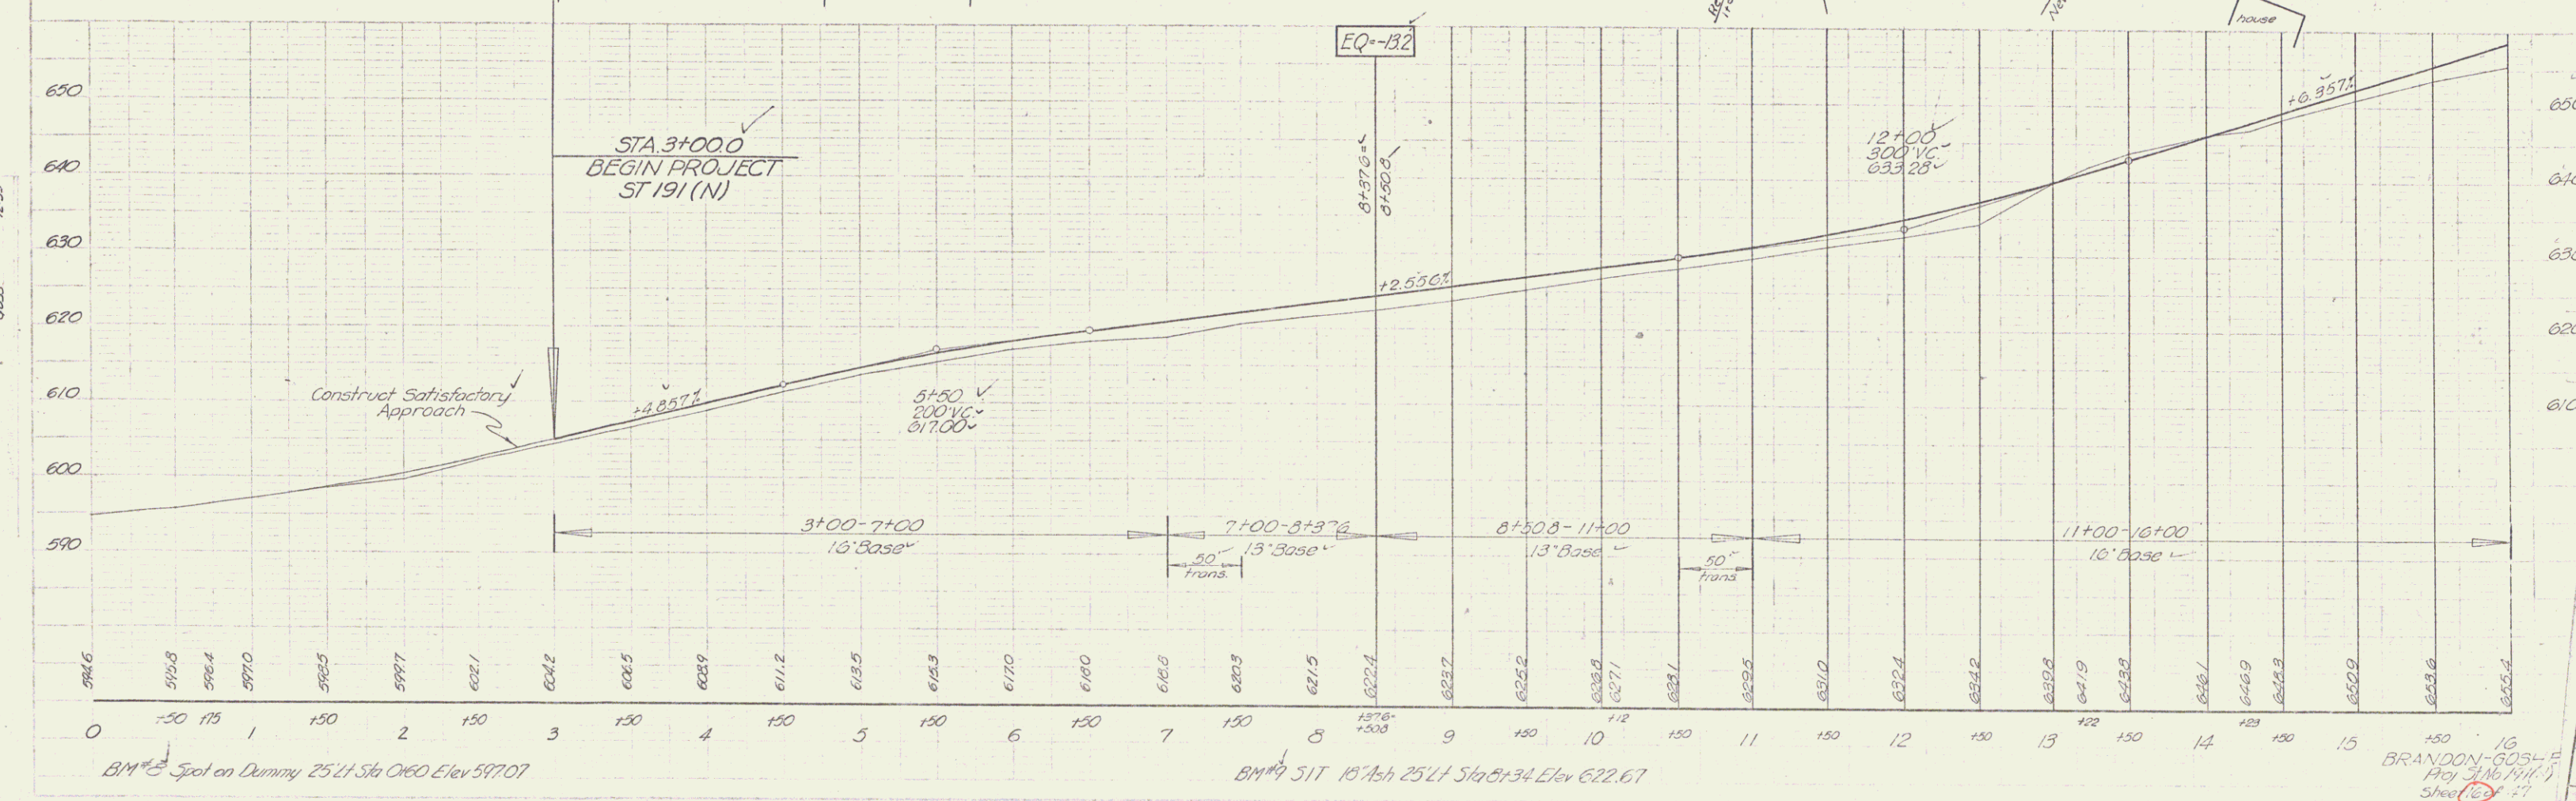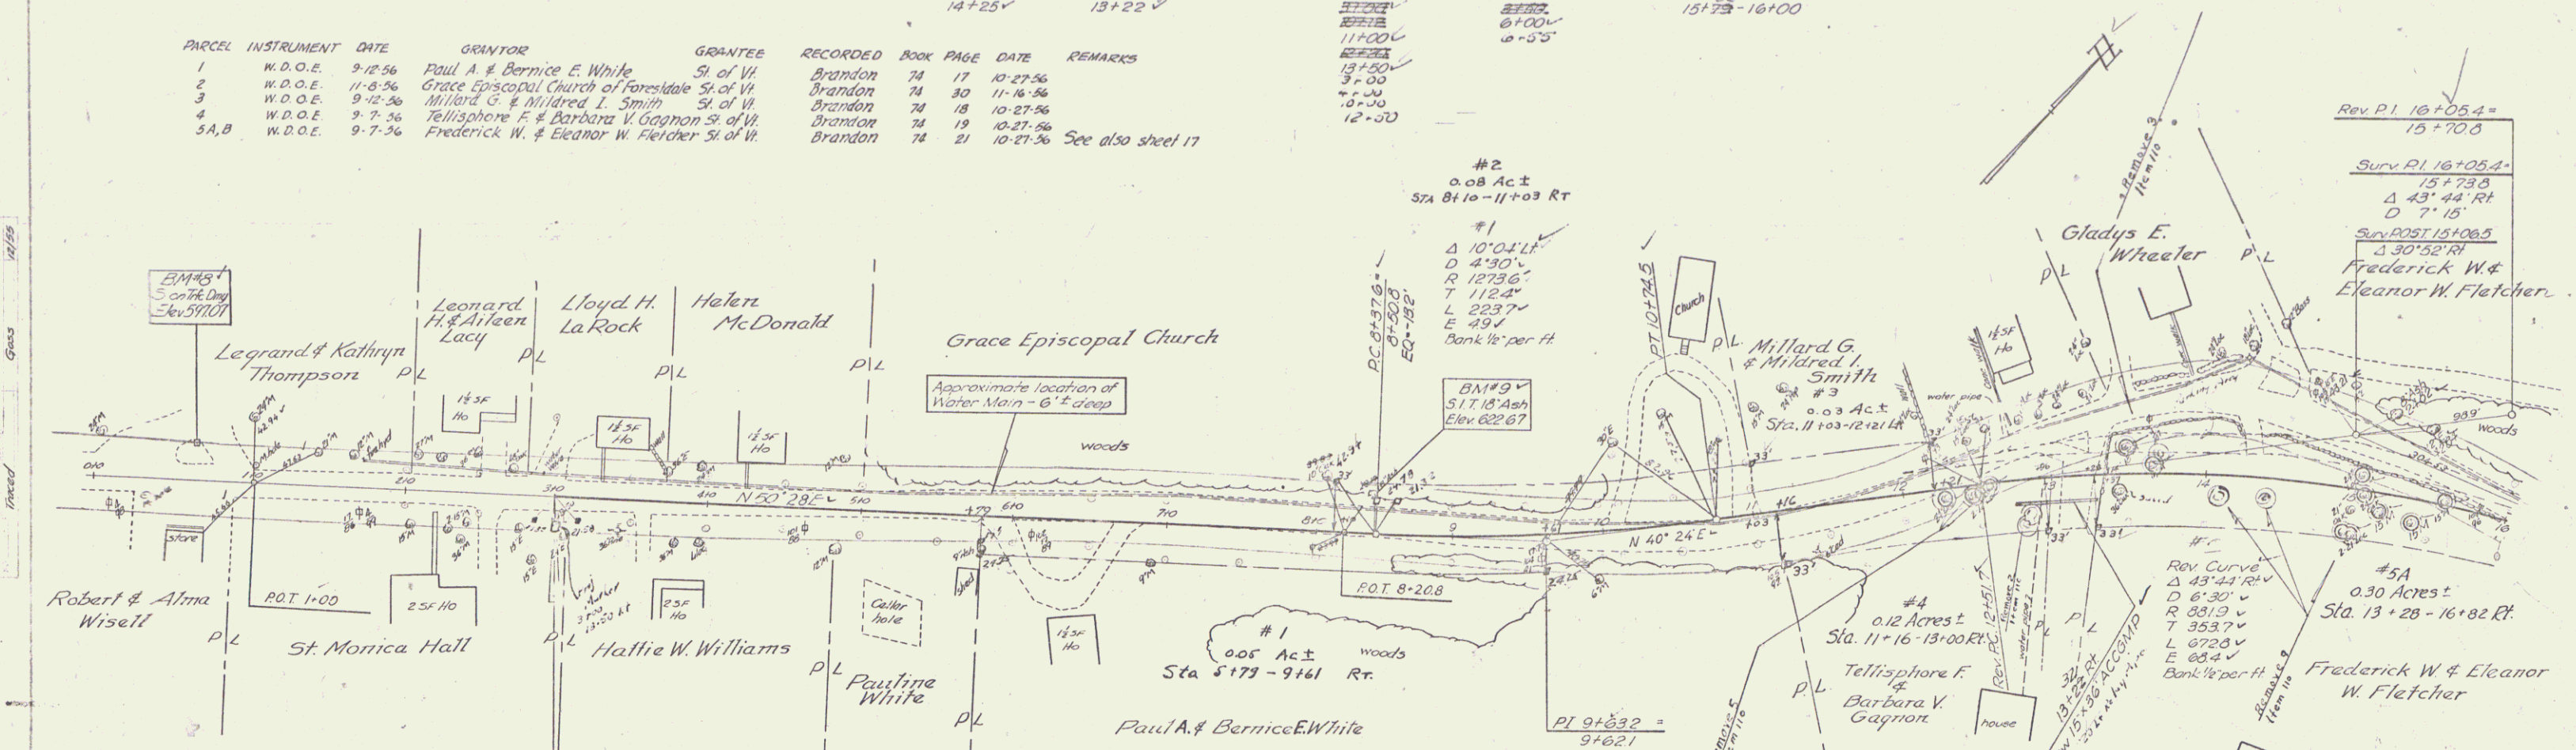

BM #12 Spot on Dummy 25' Lt Sta 0+60 Elev 597.07

BM #9 51T 15' Ash 25' Lt Sta 8+34 Elev 622.67

BRANDON-003-L-F Proj 200' 1/4" 1/2" Sheet 150 of 17

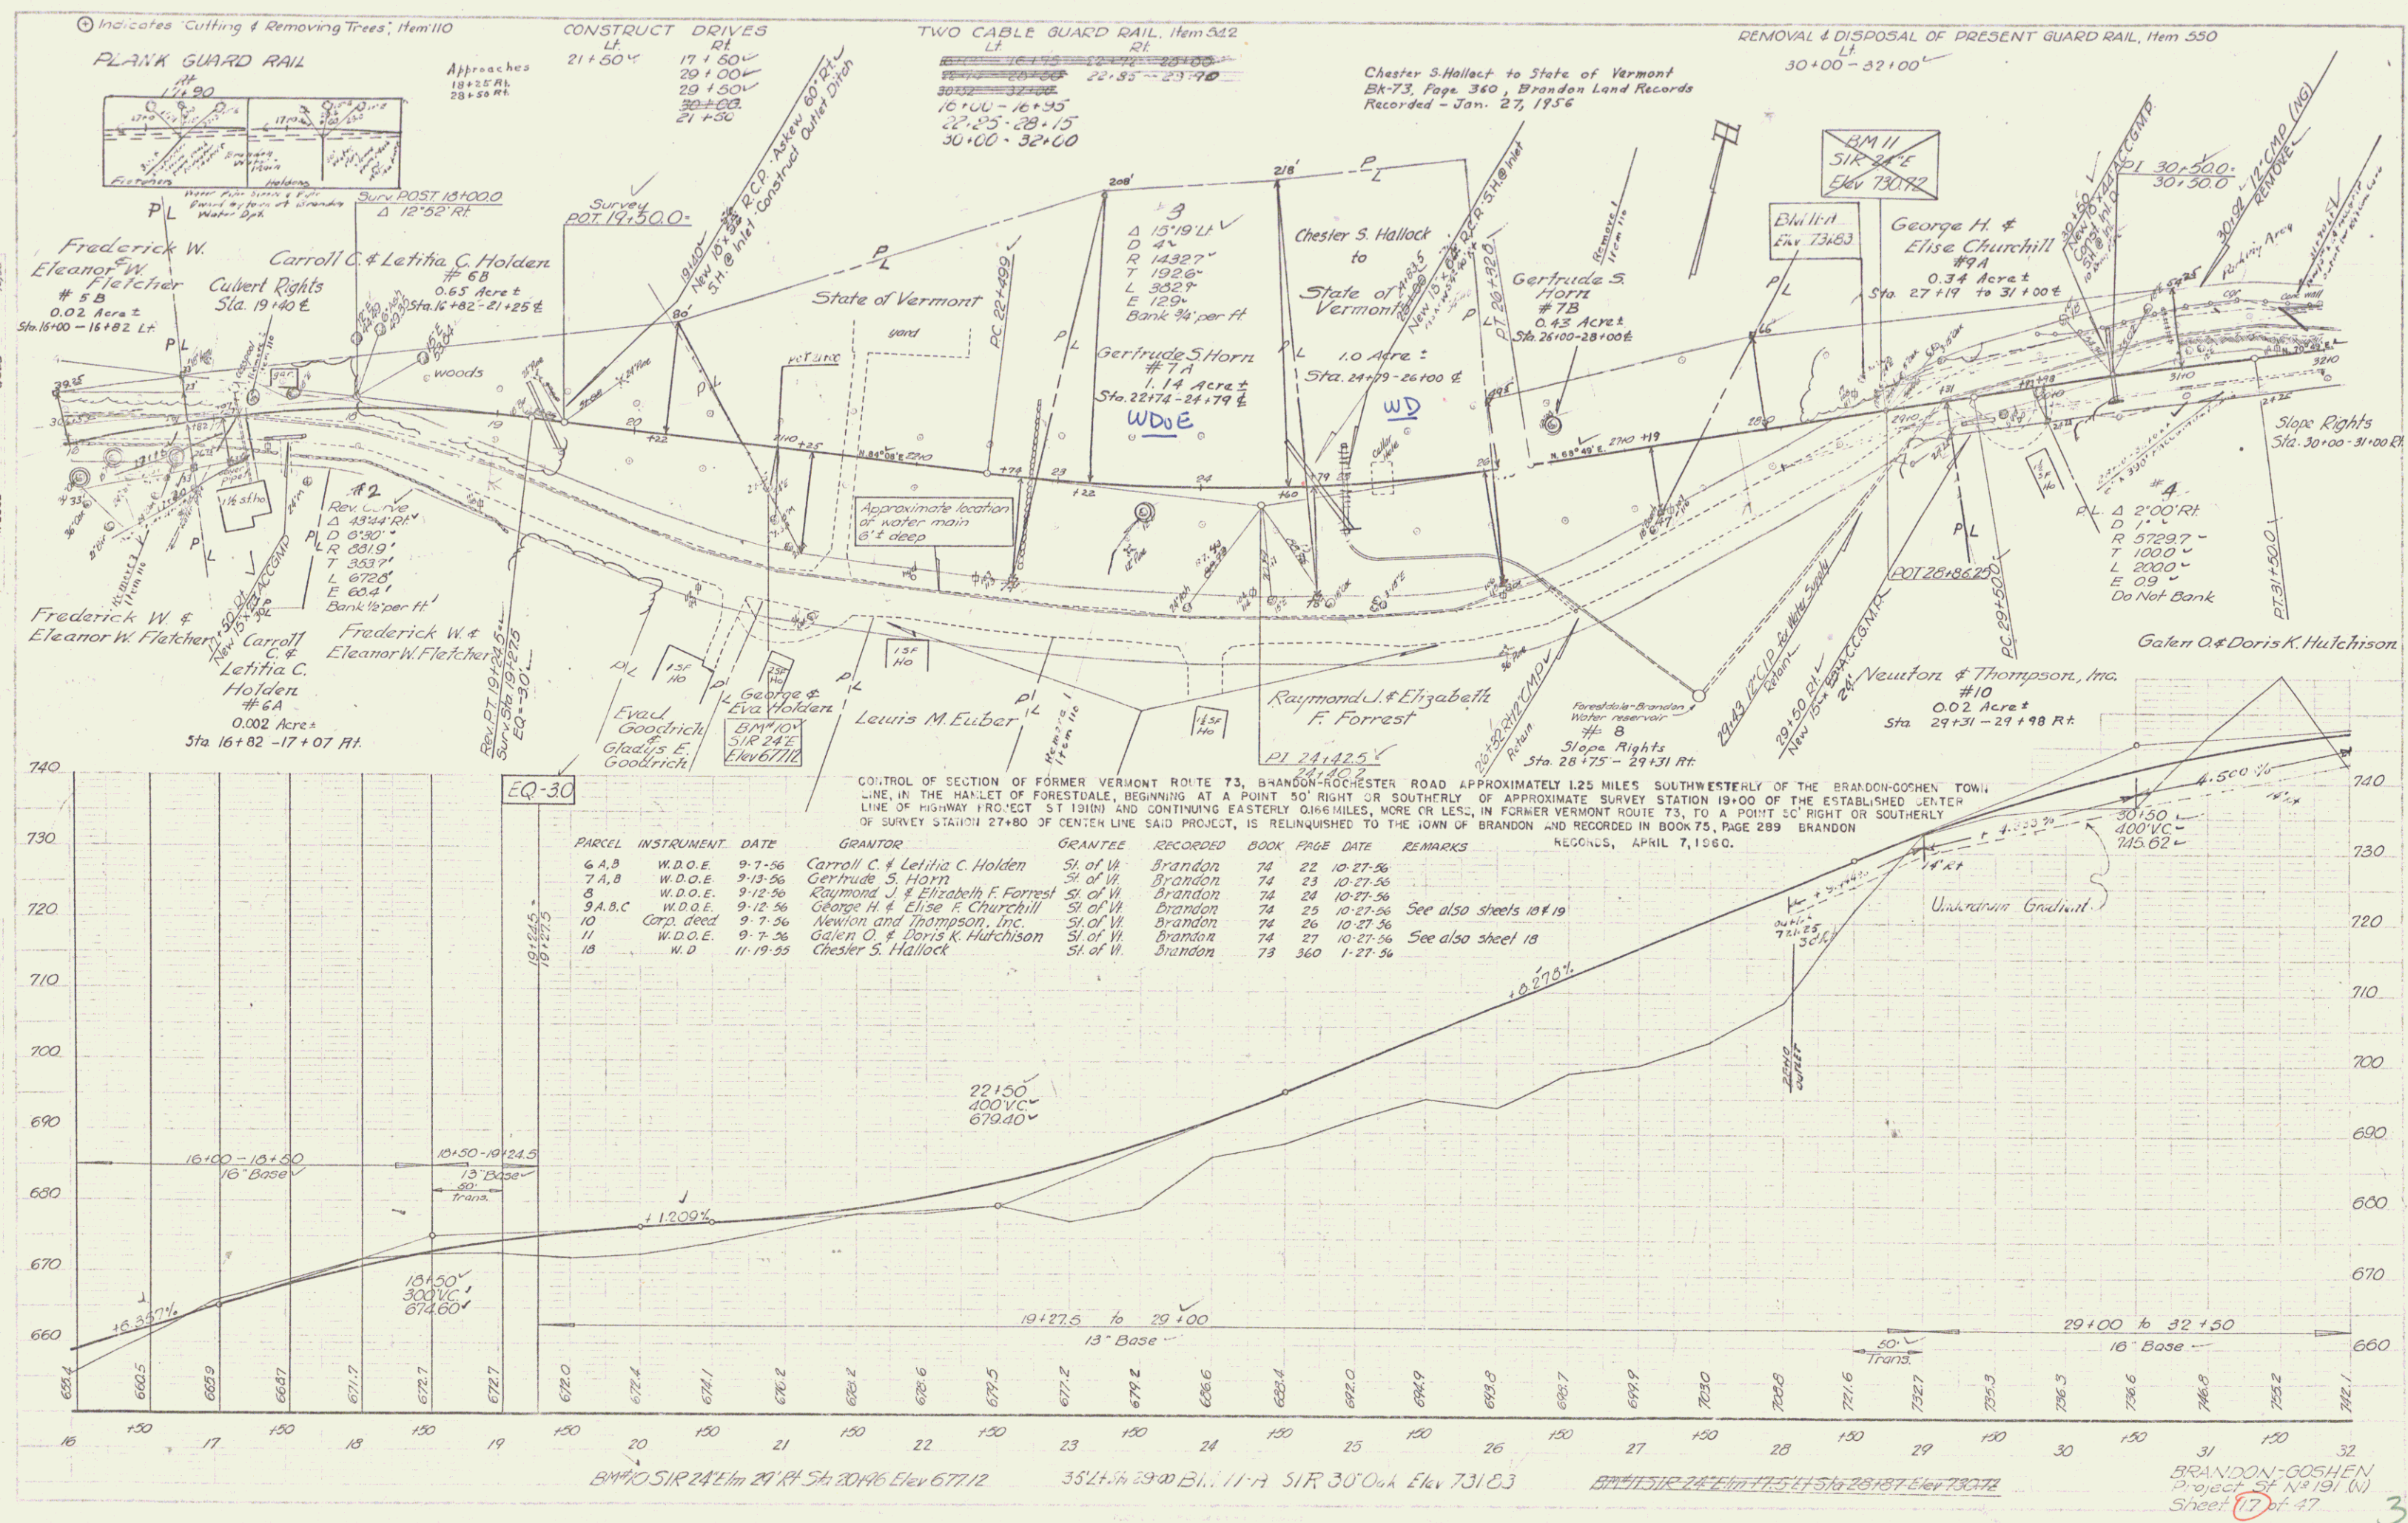

Indicates "Cutting and Removing Trees", Item 110



REMOVAL AND DISPOSAL OF
PRESENT GUARD RAIL
LT RT
83+10-84+05 ✓ 83+90-84+10 ✓
84+00-85+65 ✓ 84+150-85+145 ✓

TWO CABLE GUARD RAIL
LT RT
77+00-78+05 ✓ 83+55-84+15 ✓
83+15-84+12 ✓ 84+05-85+12 ✓
84+55-85+13 ✓ 91+01-93+13 ✓
91+15-91+20 ✓ 94+05-95+15 ✓
95+15-95+120 ✓ 95+15-95+120 ✓
95+15-95+120 ✓ 95+15-95+120 ✓

CONSTRUCT DRIVES
LT RT
86+60 ✓ 81+30 ✓
92+40 ✓

CONSTRUCT APPROACH
LT RT
88+50 ✓ 81+30 ✓

PARCEL	INSTRUMENT	DATE	GRANTOR	GRANTEE	RECORDED	BOOK	PAGE	DATE	REMARKS
15	W.D.O.E.	9-13-56	Earl C. & Elsie M. Hooker	St. of Vt.	Goshen	12	365	10-28-56	
16	W.D.O.E.	9-12-56	Hollis H. & Anna Atwell	St. of Vt.	Goshen	12	368	10-28-56	
17	W.D.O.E.	9-12-56	Guy E. & Arlie I. Ladd	St. of Vt.	Goshen	12	371	10-28-56	See also sheet 23

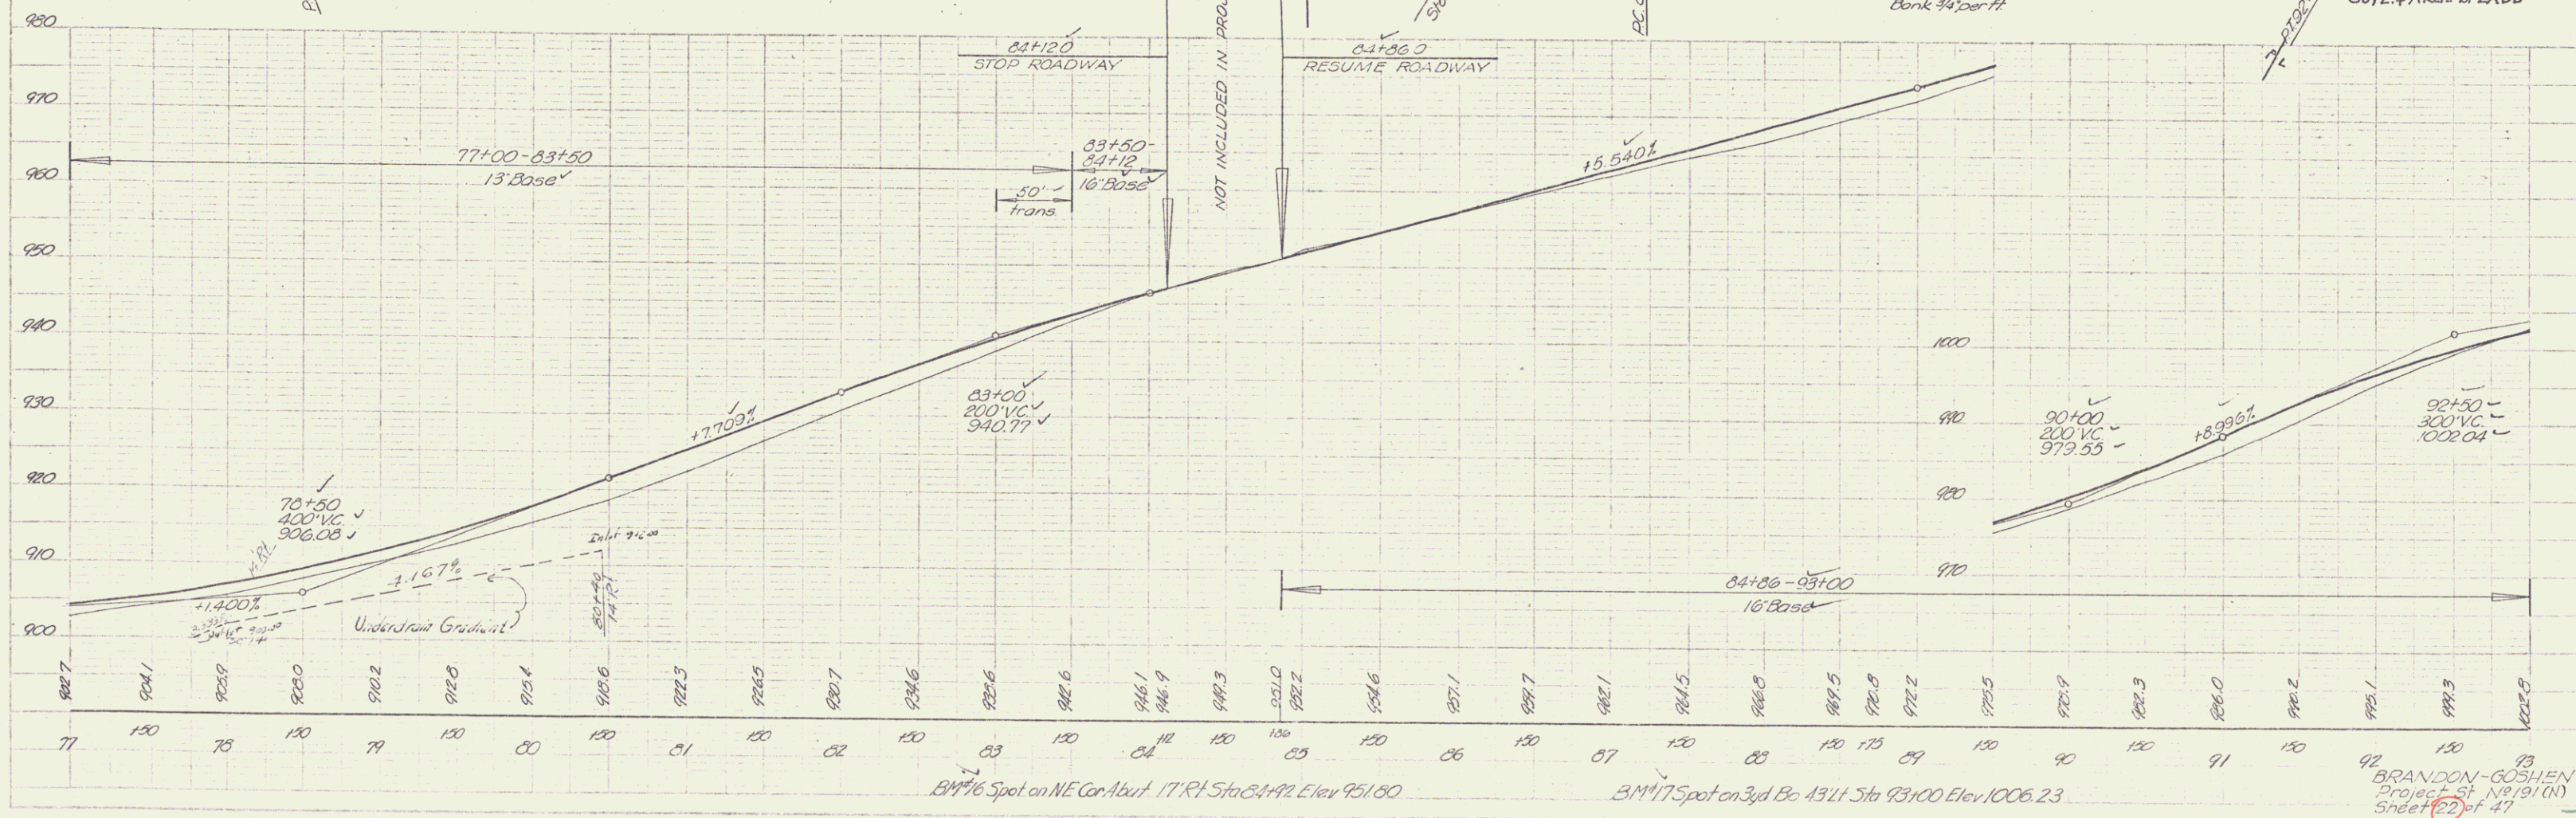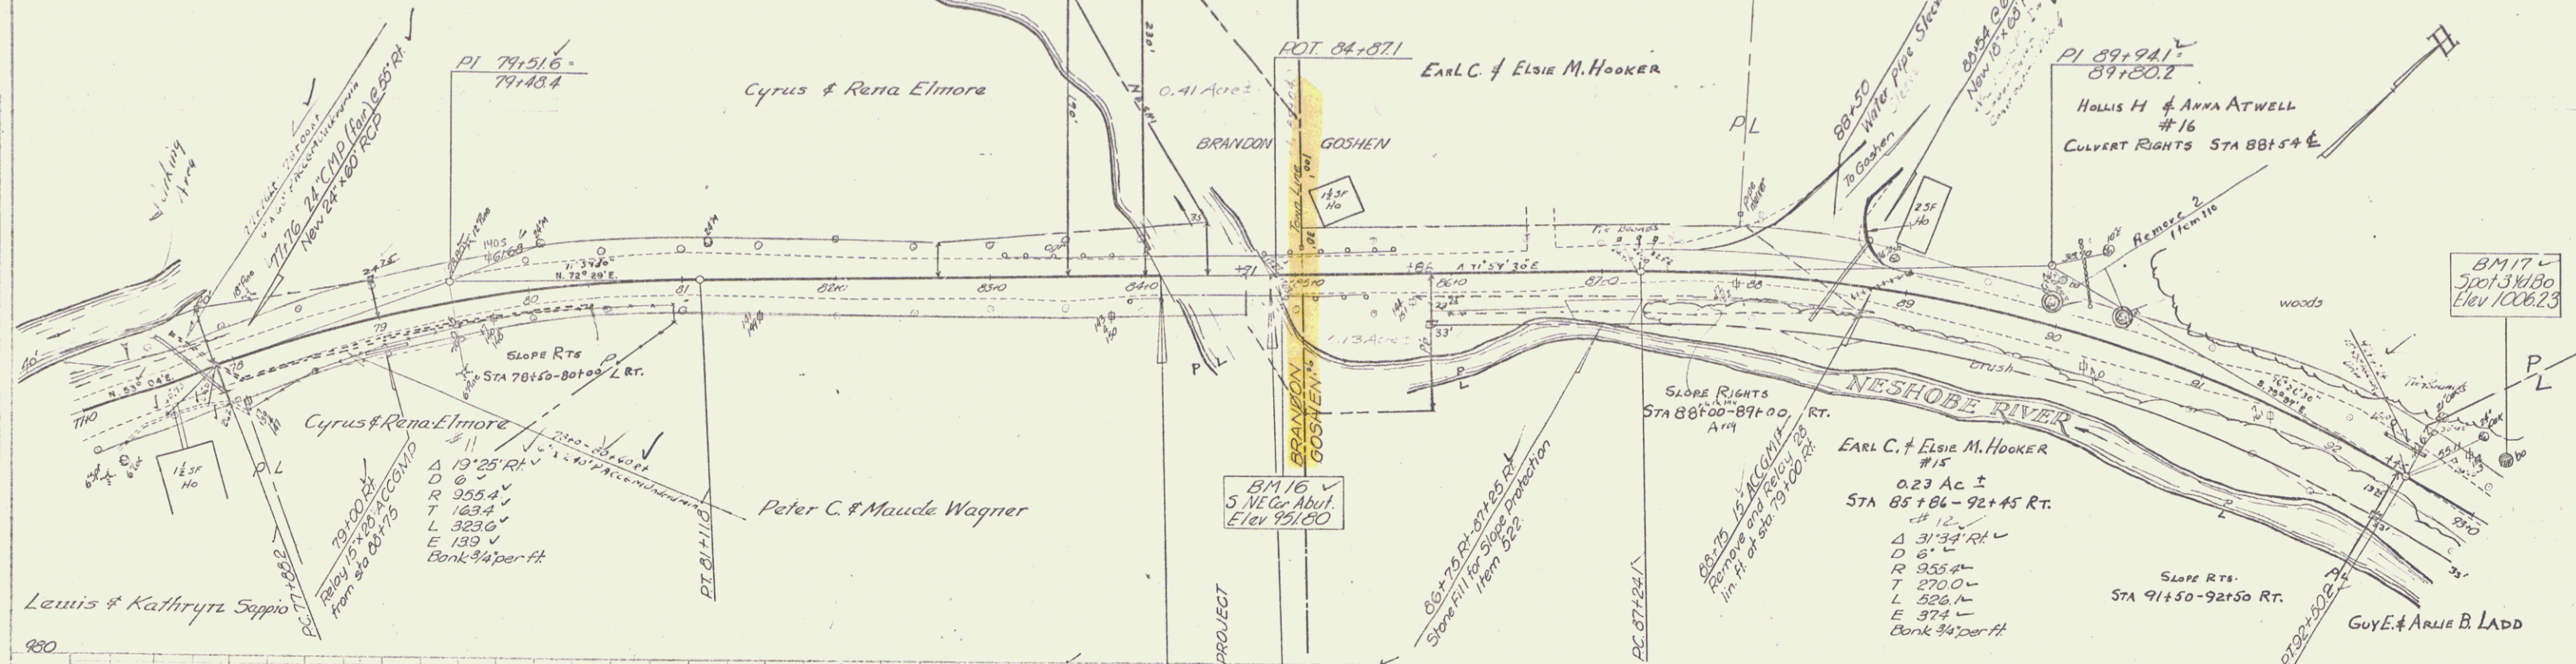


BM 16 Spot on NE Cor. Abut. 171 Rt. Sta 84+42 Elev 951.00

BM 17 Spot on Syd. Br. 43 Rt. Sta 93+100 Elev 1006.23

BRANDON-GOSHEN
Project St. No 91(N)
Sheet 22 of 47



REMOVAL AND DISPOSAL OF
PRESENT GUARD RAIL
Lt. Rt.
95+75-96+15✓ 95+75-96+20✓

17
Q. 12 AC±
STA 92+45 - 96+08 RT.
SLOPE RIGHTS 93+50 - 96+00 LT.

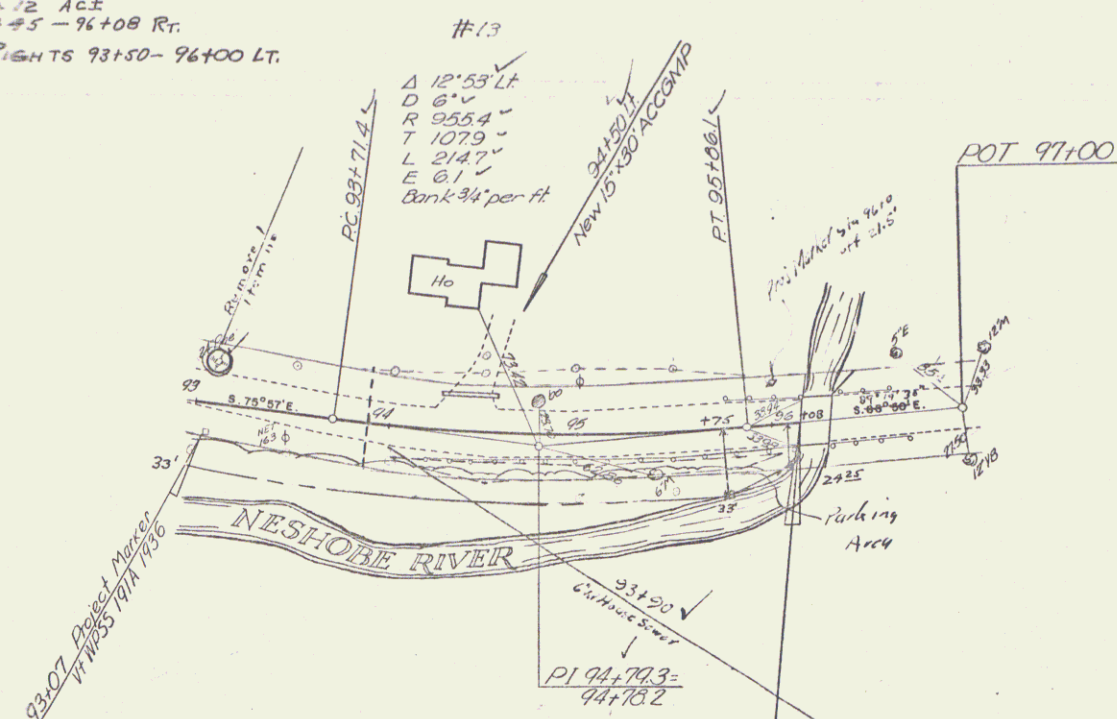

96+21
END PROJECT
ST 191 N

Construct Satisfactory Approach

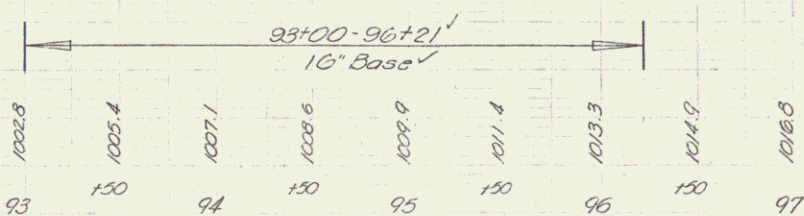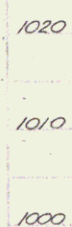

BRANDON-GOSHEN
Proj. St No. 191 (N)
Sheet 23 of 47