

INDEX OF SHEETS

- 1 TITLE PAGE
- 2 TYPICAL CROSS SECTION OF IMPROVEMENT
- 3 DRAINAGE AND ITEM QUANTITY SHEET
- 4-7 EARTHWORK SHEETS
- 8 STANDARD SHEET B-1 (BANKING TABLES)
- 9 STANDARD SHEET B-10 (EMBANKMENT ON A SLOPE)
- 10 STANDARD SHEET D-2 (HEADWALLS & UNDERDRAIN)
- 11 STANDARD SHEET G-2A (TWO CABLE GUARD RAIL)
- 12 STANDARD SHEET G-4 (GUIDE POST, MARKER POST & PLANK GUARD RAIL)
- 13 STANDARD SHEET J-1 (MARKERS)
- 14-22 PLAN & PROFILE SHEETS
- 23 DETAILS OF CUMPP ARCH STA. 109+01
- 24 CHANNEL SECTIONS
- 25-64 CROSS SECTIONS

PROJECT NAME & NUMBER TYPE PAVEMENT AREA
GOSHEN S 0162(2) SINGLE TACK COAT OF REFINED TAR & BLEND MIX PEA STONE SEAL WITH CUTBACK ASPHALT 26,183.3

RECORD PLANS

MATERIALS

SUB-BASE OF GRAVEL - GOLDEN PIT - GOSHEN, BAKER PIT - BRANDON, VT.
PEA STONE - VERMONT MARBLE QUARRY - FLORENCE, VERMONT.
REFINED TAR - KOPPERS PRODUCTS CO. - EVERETT, MASSACHUSETTS.
ASPHALT - MOBIL OIL CO. - EAST PROVIDENCE, RHODE ISLAND.
REINFORCING STEEL - HANNIBAL GREEN'S SON & CO. INC. - TROY, N. Y.
ASPHALT COATED CORR. GALV. METAL PIPE - NORTHEASTERN METAL CULVERT CO. - WESTMINSTER, VERMONT.
TWO CABLE GUARD RAIL - BETHLEHEM STEEL - S.T. GRISWOLD CO. INC. - ESSEX JUNCTION, VERMONT.


CONTRACTOR - EARLE & MERRY INC. - RUTLAND, VERMONT. CONTRACT DATED - DECEMBER 10, 1959.
RESIDENT ENGINEER - ELBERT H. SHAM - CONTRACT STARTED - JANUARY 4, 1960.
RECORD PLANS - ALEXANDER G. SPIDLE - CONTRACT COMPLETED - OCTOBER 21, 1960.
CONTRACT ACCEPTED - OCTOBER 21, 1960.

STATE OF VERMONT DEPARTMENT OF HIGHWAYS


Proposed Improvement

TOWN OF GOSHEN
COUNTY OF ADDISON
VERMONT ROUTE 73
BRANDON-ROCHESTER ROAD

BEGINNING AT A POINT APPROXIMATELY 0.10 MILE
FROM THE BRANDON-GOSHEN TOWN LINE AND
EXTENDING EASTERLY 11,782.5 FEET
11,782.5
2232
LENGTH OF PROJECT 11,782.5 FEET = 2.234 MILES

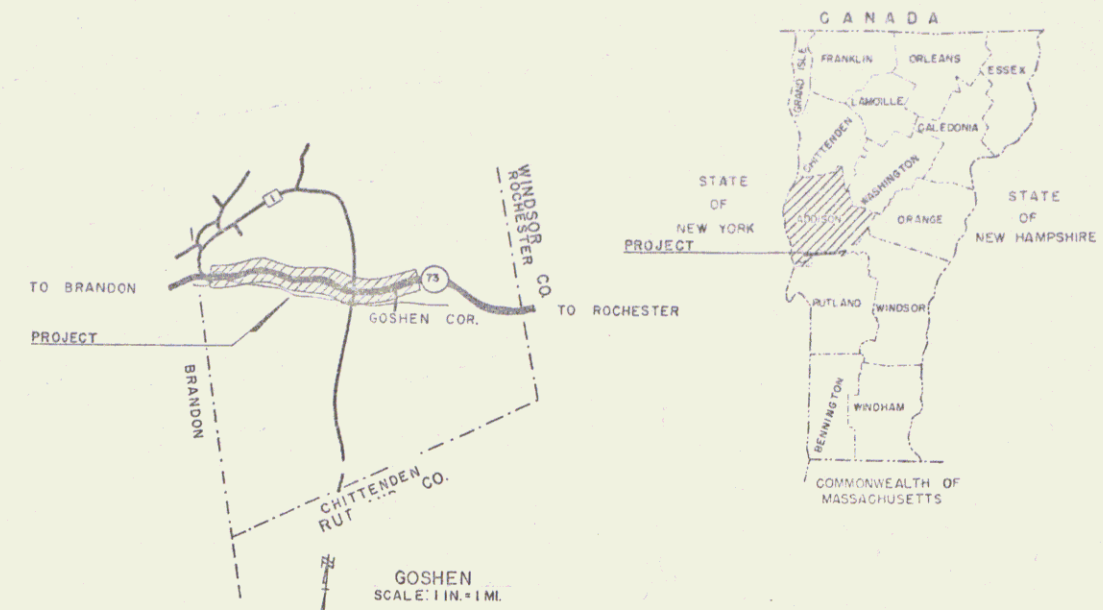

PROJECT: S 0162(2)
PIN: 00R418
DATE: 12/29/1958

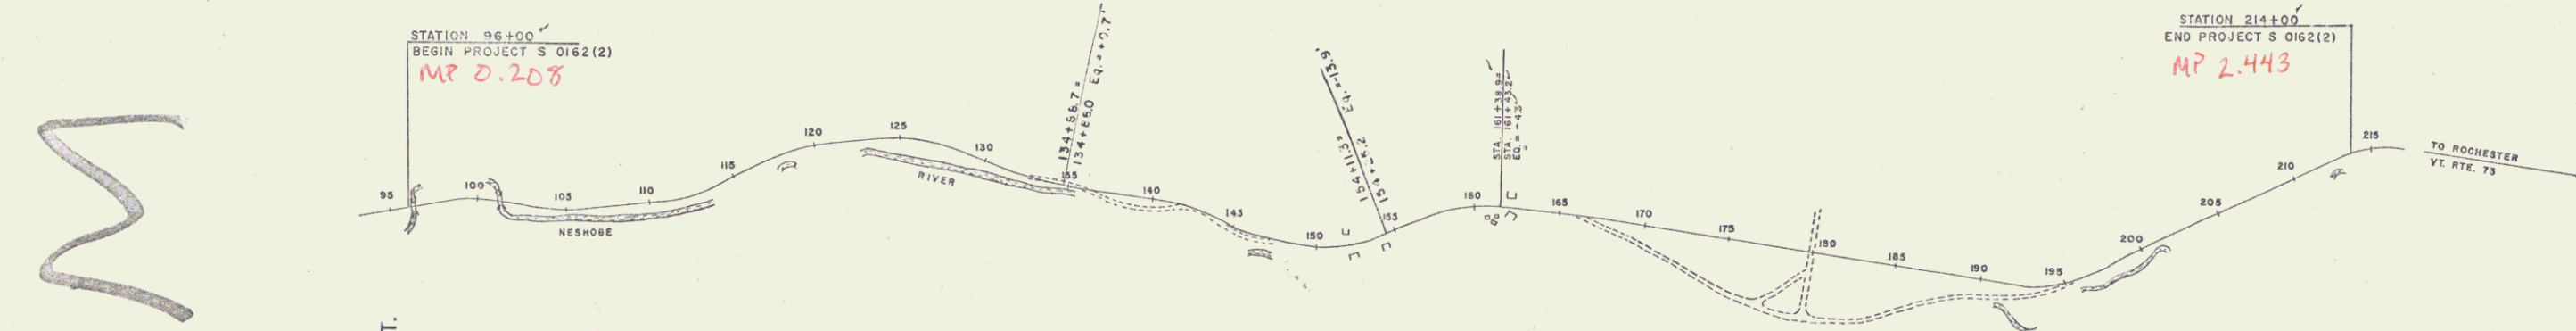

PROJECT: GOSHEN
NUMBER: S 0162(2)
LENGTH: 2.232 MI.
TYPE: Single Tack Coat of Refined Tar & Blend Mix P&S
STONE: Stone Seal with Cutback Asphalt
CONTRACTOR: EARLE & MERRY INC.
RUTLAND, VERMONT
YEAR: 1960
LICENSE: Beginning at a point approximately 0.10 mile from the Brandon-Goshen Town Line and extending easterly 11,782.5 feet.
2620

GOSHEN S 0162(2)
CONTRACTOR: EARLE & MERRY INC. - RUTLAND, VT.
RECORD PLANS - ALEXANDER G. SPIDLE
DATE: OCTOBER 21, 1960.

GROUND ELEVATION
GRADE ELEVATION
CURVE DATA
DEFLECTION OF ANGLE
DEGREE OF CURVE
RADIUS OF CURVE
TANGENT DISTANCE
LENGTH OF CURVE
EXTERNAL DISTANCE
POINT OF INTERSECTION
POINT OF CURVE
POINT OF TANGENT
POINT ON TANGENT
POINT ON SUB-TANGENT
POST

SCALES
TITLE 1" = 500'
TYPICAL 1" = 20'
PLAN 1" = 50'
PROFILE HORIZONTAL 1" = 50'
PROFILE VERTICAL 1" = 10'
CROSS SECTIONS 1" = 5' & 10'

APPROVED: [Signature] DATE: OCT 29 1960
APPROVED: [Signature] DATE: DEC 24 1959
APPROVED: [Signature] DATE: DEC 29 1959
APPROVED: [Signature] DATE: DEC 29 1959
RIGHT-OF-WAY DIVISION
TOWN FILE
PERPETUAL
Town of U+73
(To Be Returned To R.O.W. Division)

NOTE: ANY FURTHER INFORMATION CONCERNING FINAL QUANTITIES, AMOUNTS OF OTHER MATERIALS RELATIVE TO THIS PROJECT MAY BE FOUND IN EITHER THE FIELD BOOKS OR THE ESTIMATE FILE.

DEPARTMENT OF COMMERCE
BUREAU OF PUBLIC ROADS
APPROVED: [Signature] DATE: [Date]
DIVISION ENGINEER
PROJECT: S NO. 0162(2)
SHEET 1 OF SHEETS 64