

INDEX OF SHEETS	
SHEET NO	TITLE SHEET
1	TYPICAL CROSS-SECTION OF IMPROVEMENT (BITUMINOUS CONCRETE PAVEMENT, ITEM 36-B(100))
2	QUANTITY SHEET (ITEMS)
3	QUANTITY SHEET (GRAINAGE)
4	EARTHWORK SHEETS
5	PLAN AND PROFILE SHEETS
6	STANDARD SHEET SB-PA#1 (DETAILS OF 12" X 12" C.M.R.P.A. AT STA 366+23.5, DETAIL 'B')
7	STANDARD SHEET SB-PA#2 (DETAILS OF 12" X 12" C.M.R.P.A. AT STA 366+23.5, DETAIL 'C')
8	STANDARD SHEET SB-PP#1 (DETAILS OF 12" X 12" C.M.R.P.A. AT STA 366+23.5, DETAIL 'D')
9	STANDARD SHEET SB-PP#2 (DETAILS OF 12" X 12" C.M.R.P.A. AT STA 366+23.5, DETAIL 'E')
10	STANDARD SHEET B-1 (BANKING TABLES)
11	STANDARD SHEET B-2 (SLOPE STABILIZATION)
12	STANDARD SHEET C-1 (TREATED TIMBER CURB)
13	STANDARD SHEET D-1 (PRECAST R.C.P. DROP INLET)
14	STANDARD SHEET D-2 (HEADWALLS & UNDERDRAIN)
15	STANDARD SHEET E-1 (BARRICADES, SIGNS & LIGHTS)
16	STANDARD SHEET G-2 (TWO CABLE GUARD RAIL)
17	STANDARD SHEET G-4 (WIDE POSTS & MARKER POSTS)
18	STANDARD SHEET J-1 (MARKERS)
19	CROSS-SECTION SHEETS
20	CURVE BANKING TRANSITION SHEETS

PROJECT	NUMBER
Goshen-Rochester	S-FLH 0162 (1)
TYPE	SURFACE AREA
Bituminous Concrete	37,526 sq

RECORD PLANS MATERIALS	
GRAVEL - Lyon and Severy Pits, Rochester, Vermont	
CUTBACK ASPHALT - Mobile Oil Co., East Providence, Rhode Island	
BITUMINOUS CONCRETE - L.M. Dike & Son, Inc., Proctor, Vermont Plant	
REINFORCING CONCRETE PIPE - American Marietta Co., Windsor, Vermont	
ALUMINUM PIPE AND CEMENT METAL PLATE PIPE - New England Metal Culvert Co., Palmer, Mass. and Arma Steel Corp., Middletown, Ohio	
CONCRETE, CLASS B - Joseph P. Carrara & Sons, Inc., Rutland, Vermont	
REINFORCING STEEL - Bethlehem Steel Co., Bethlehem, Pa.	
GUARD RAIL - Bethlehem Steel Co., Sparrows Point, Maryland	
WOOD POSTS - Koppers, Nashua, N.H. and Slodddard Enterprises, Inc., Northfield, Vermont	
TIMBER CURB - Koppers, Nashua, New Hampshire	
CONTRACTOR - Burnett and Campbell, Inc., P.O. 2, Burlington, Vermont	
RESIDENT ENGINEER - William B. Lowe	
INSPECTORS - Sherwood C. Murray, R. Guthridge	
RECORD PLANS - S.C. Murray, W.B. Lowe	
CONTRACT DATED - Nov. 9, 1960	
CONTRACT STARTED - Nov. 15, 1960	
CONTRACT COMPLETED - Aug. 9, 1962	
CONTRACT ACCEPTED - Aug. 9, 1962	

STATE OF VERMONT DEPARTMENT OF HIGHWAYS

PROPOSED IMPROVEMENT

FEDERAL AID SECONDARY PROJECT

TOWNS OF GOSHEN & ROCHESTER

COUNTIES OF ADDISON & WINDSOR

VERMONT ROUTE #73

BRANDON - ROCHESTER ROAD

BEGINNING AT A POINT APPROXIMATELY 0.75 MILE WESTERLY OF THE GOSHEN - ROCHESTER TOWN LINE AND EXTENDING EASTERLY 2.933 MILES 3.193 MILES.

LENGTH OF PROJECT 16,866 FEET 3.193 MILES

1958 ADT - 125
1980 ADT - 180
1980 DHV - 35
D - 65%
T - 11%
V - 30 MPH (FROM 236+00 TO 270+75)
40 MPH (FROM 270+75 TO 301+00)

PROJECT: S-FLH 0162 (1)
PIN: 00R419
DATE: 06/30/1960

NOTE: ELEVATIONS ARE BASED ON U.S.G.S. BEACH MARKS AT STA 262+15.4 OFF 40' LT. AND STA 321+10.4 OFF 15' RT.

COUNTY	GOSHEN-ROCHESTER
TOWN L. FENCE	3.198 MI.
STOVE UNFENC	
GUARD	
TRAVEL	
RAILROAD	
RETAIN	
CENTER	
SURVEY	
CULVERT	
DROP I	
TROUBLE	
POWER	
TELEPH	
TRAFFIC	
WEDGES	

LOCALITY: Beginning at a point approximately 0.75 mile westerly of The Goshen-Rochester Town Line and extending easterly 3.198 miles.

CONTRACTOR: BURNETT & CAMPBELL, INC.

RECORD PLANS: S-FLH 0162 (1)

CONSTRUCTION COMPLETED - AUGUST 9, 1962

RECORD PLANS - S.C. MURRAY, W.B. LOWE

CONTRACTOR: BURNETT & CAMPBELL, INC.

RECORD PLANS: S-FLH 0162 (1)

CONSTRUCTION COMPLETED - AUGUST 9, 1962

RECORD PLANS - S.C. MURRAY, W.B. LOWE

CONTRACTOR: BURNETT & CAMPBELL, INC.

RECORD PLANS: S-FLH 0162 (1)

CONSTRUCTION COMPLETED - AUGUST 9, 1962


RECORD PLANS - S.C. MURRAY, W.B. LOWE


CONTRACTOR: BURNETT & CAMPBELL, INC.

RECORD PLANS: S-FLH 0162 (1)

MAILED 8/53
H.M. HARRIS
Traced by M. GOWAN 1/59

MAILED 8/59
H.M. HARRIS
Traced by M. GOWAN 1/59

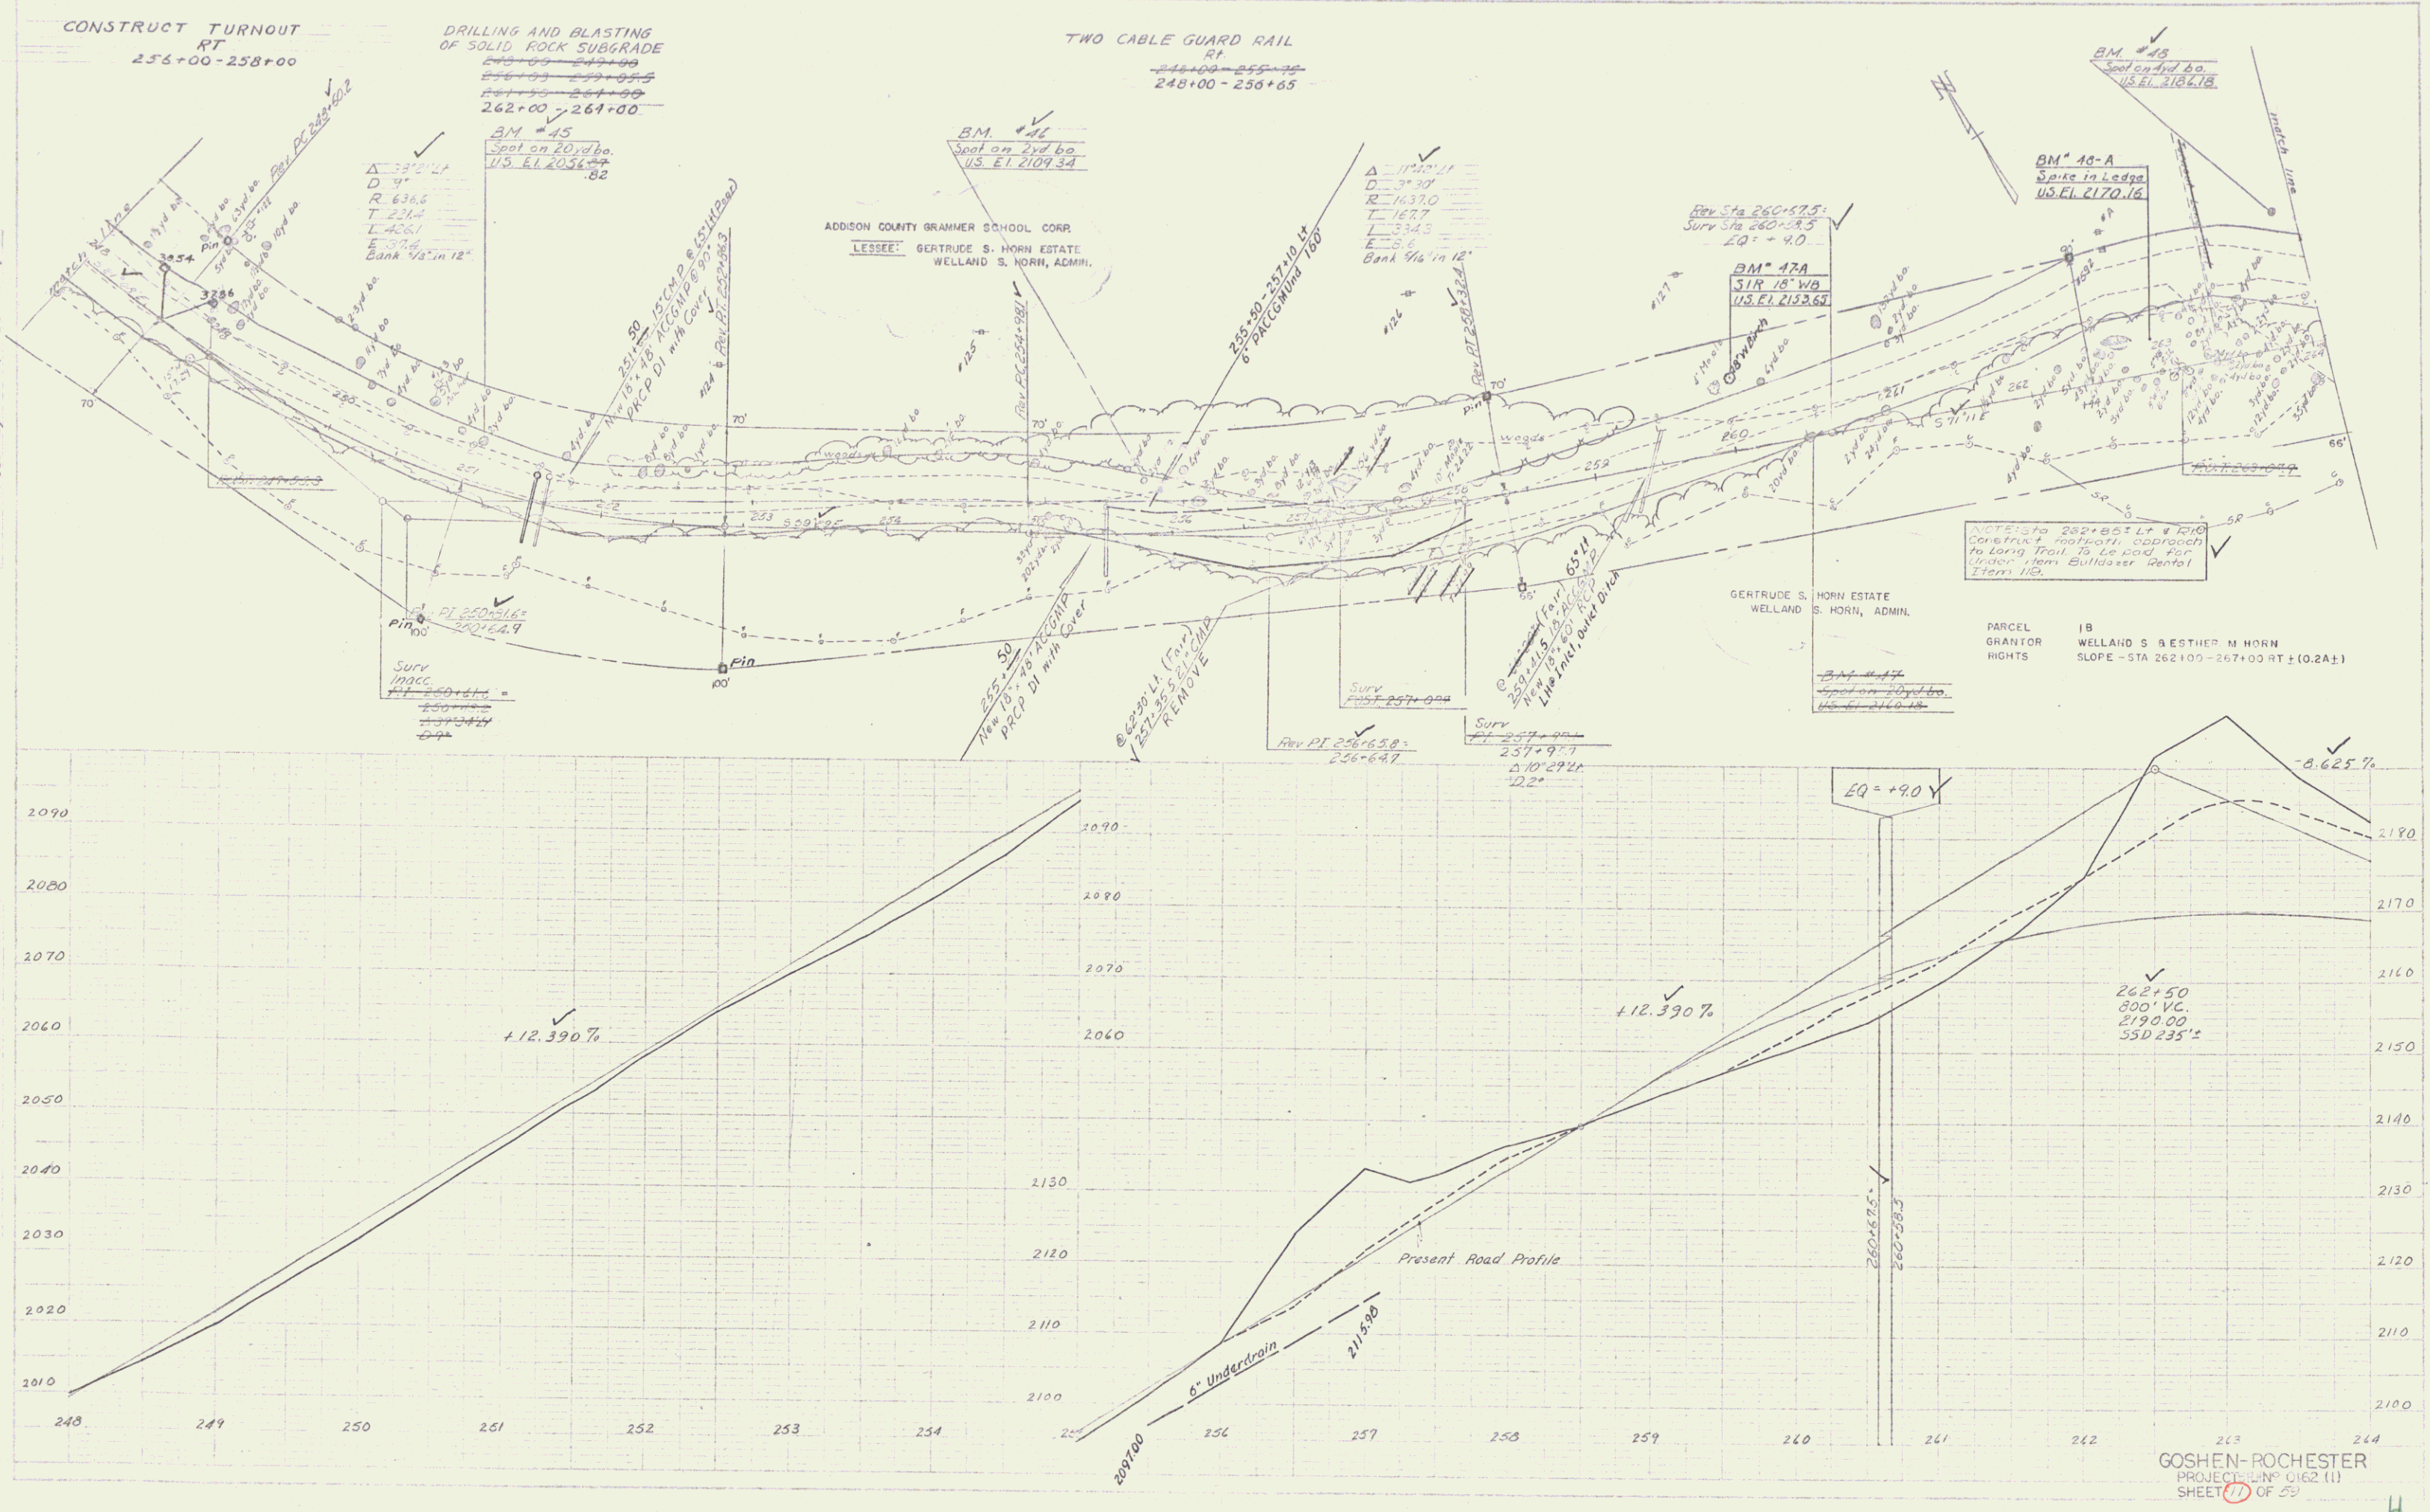

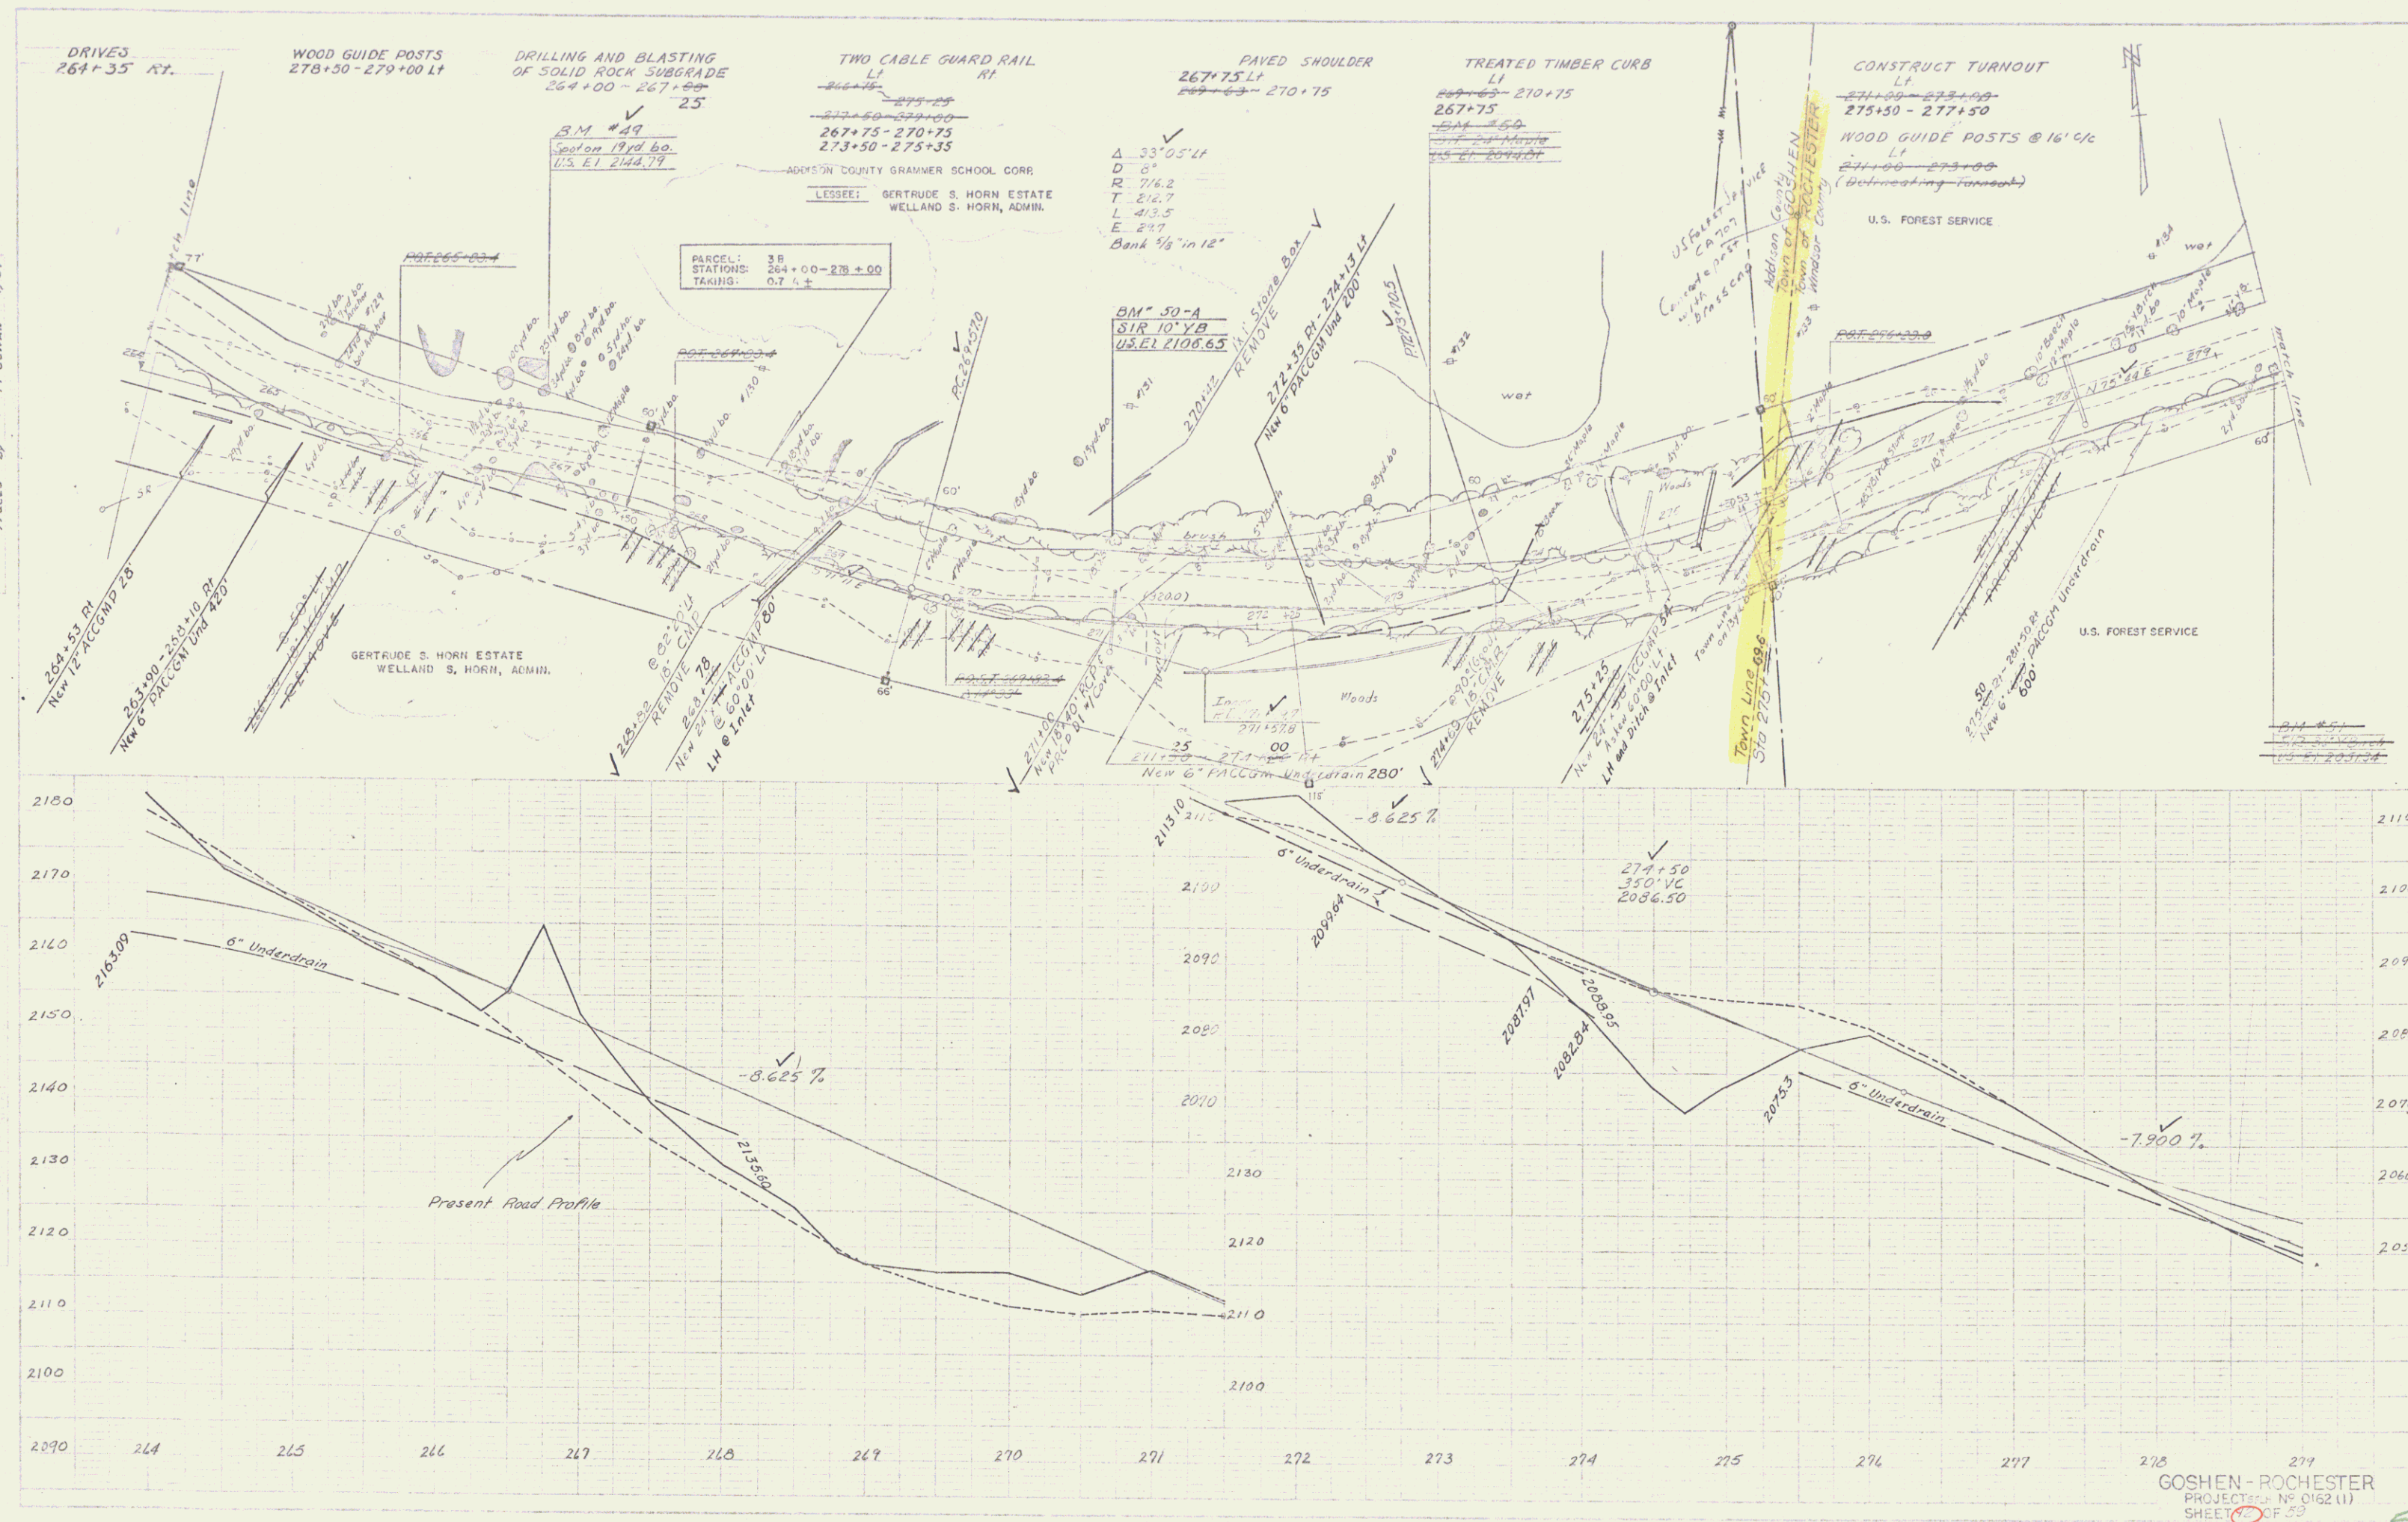

WOOD GUIDE POSTS
279+00-282+50 Lt
294+00-295+00 Rt

TWO CABLE GUARD RAIL
Lt Rt
279+00-282+50 293+75-295+00
283+50-290+50 75

UNCLASSIFIED CHANNEL EXCAVATION
Lt Rt
288+75-290+50 293+75-295+00
50 20

STONE FILL FOR SLOPE PROTECTION
Lt Rt
288+75-290+50 293+75-295+00
50 20

PARCEL: A,B,C,D,E,F,G,H,I,J
GRANTOR: UNITED STATES OF AMERICA
STATIONS: 275+50-402+00
PERMIT AREA: 24.2 ACRES ±

BM # 52
SIR 24" Y Birch
U.S. EL. 2012.76
7' 2.7 A, ±
STA 275+75-305+53.7 LT.

BM # 51-A
SIR 24" Y Birch
U.S. EL. 2041.24

BM # 53
SIR 31" Y Birch
U.S. EL. 1945.68

Traced by
M. H. Hama
M. G. Hama

M. H. Hama
M. G. Hama



CONSTRUCT TURNOUT
LT
305+00-308+00



UNCLASSIFIED CHANNEL EXCAVATION
RT 75
295+00-299+50
303+50-305+20
307+20-308+25
302+25-305+25
307+40-308+60

STONE FILL FOR SLOPE PROTECTION
RT 75
295+00-299+50
302+25-305+25
307+40-308+60

TWO CABLE GUARD RAIL
LT
295+00-299+75
305+75-308+75
310+75-311+55


WOOD GUIDE POSTS
295+00-299+50 RT
302+40-305+00 RT
307+00-308+40 RT

Traced by
M. Hara 8/58
M. Hara 8/58
M. Gowan 1/59

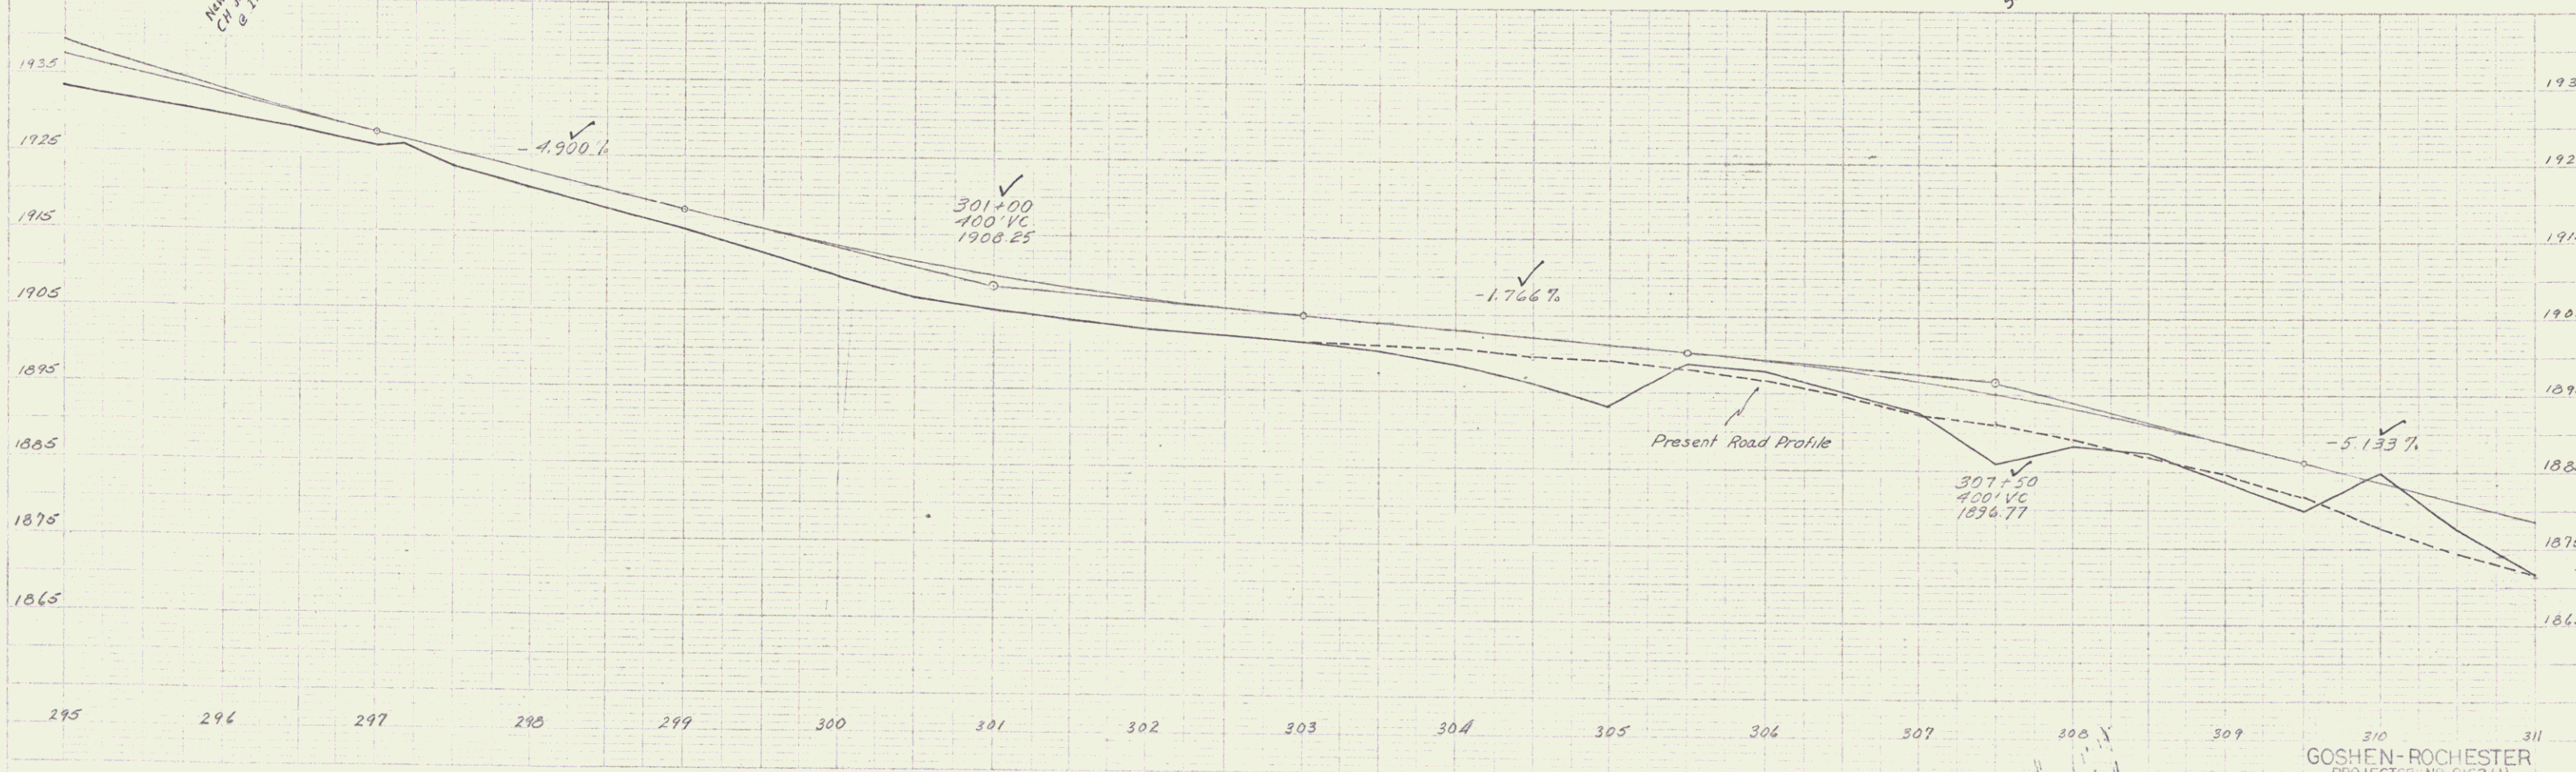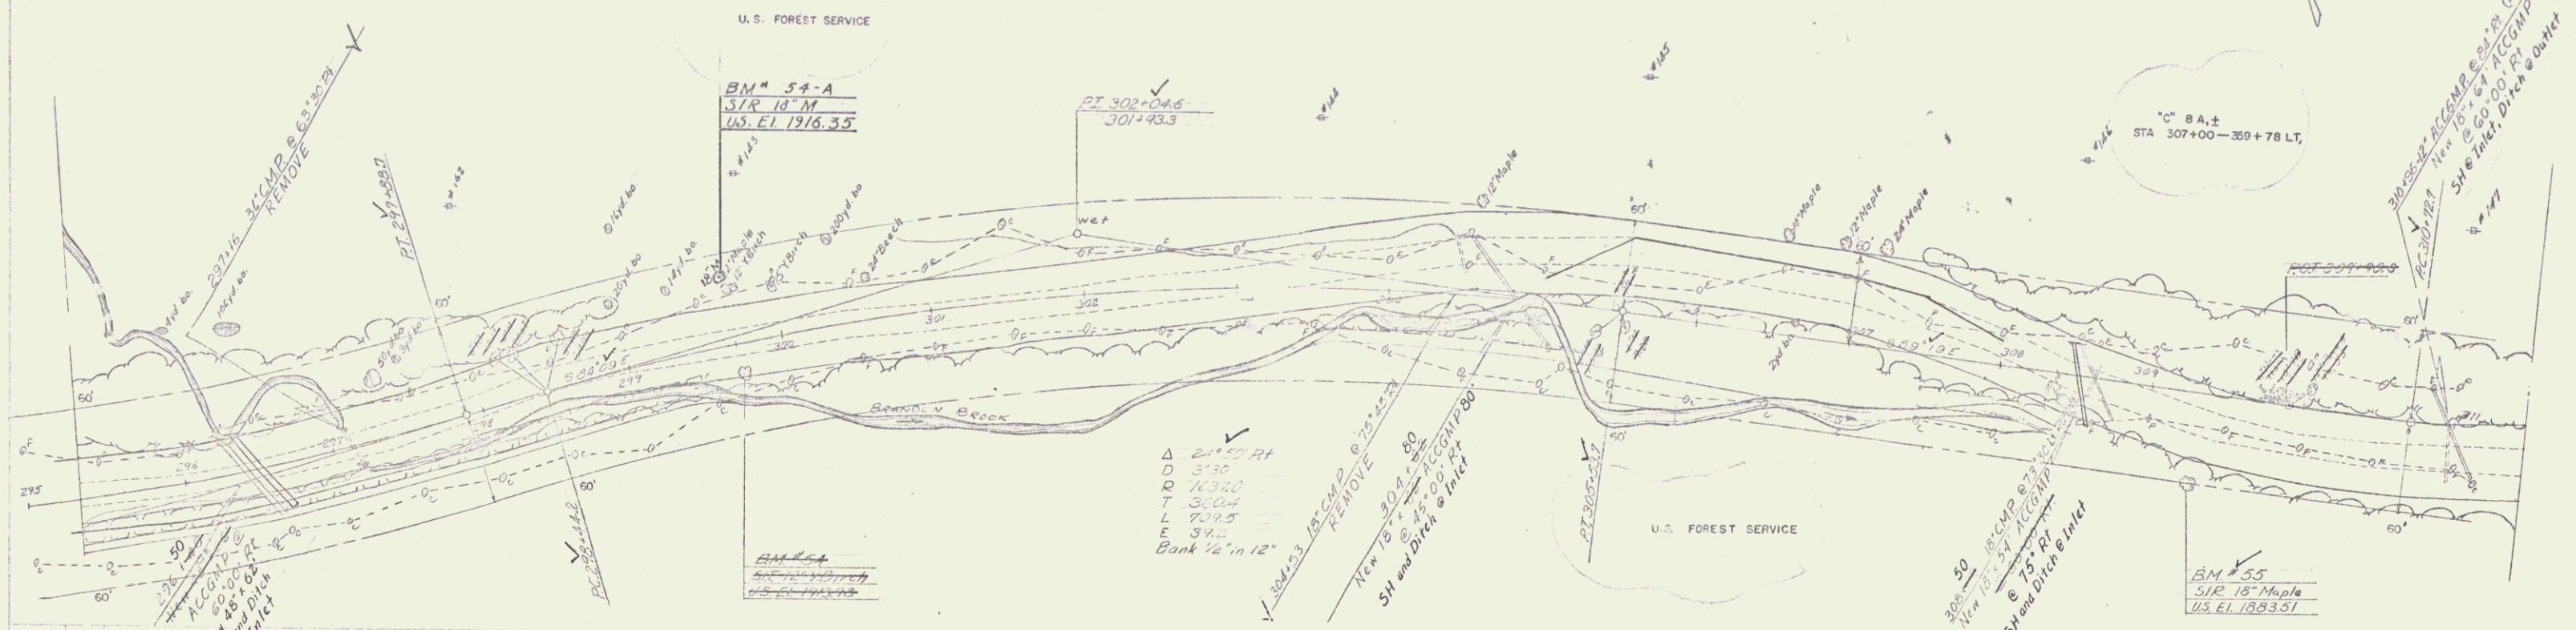


Traced by P. McGowan 4/53

William Atkinson 4/59

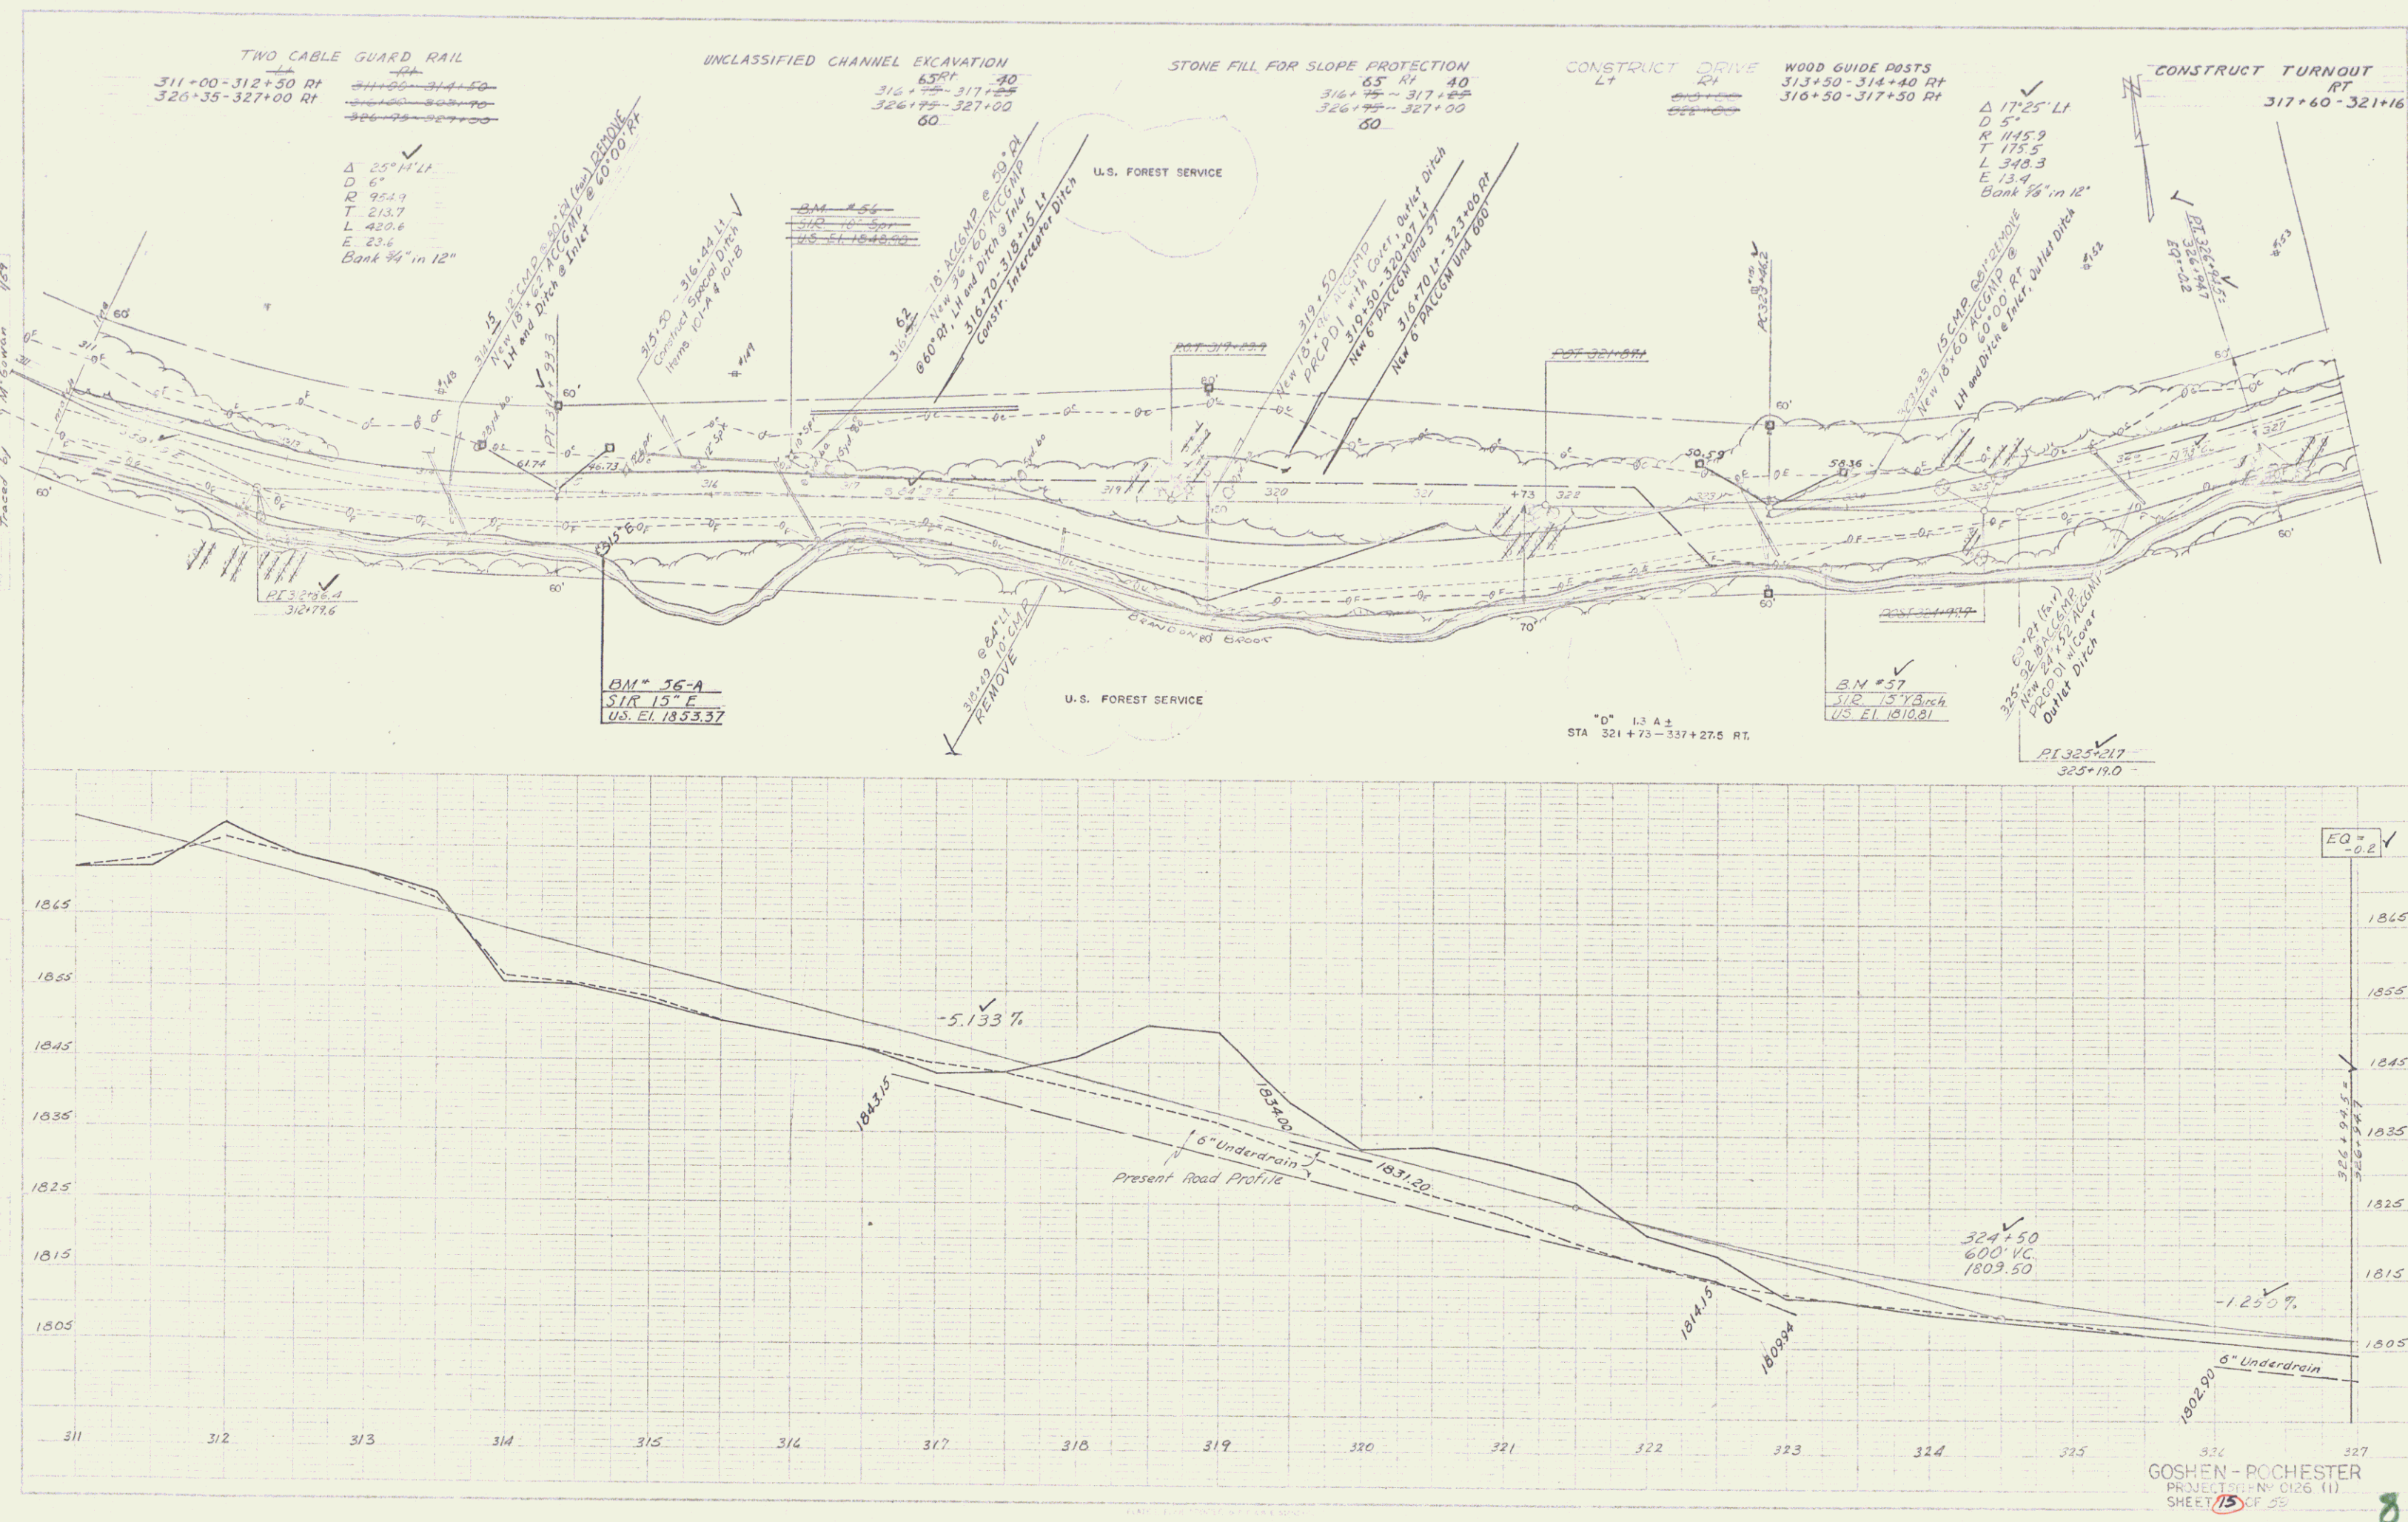


9/58
1/59
M. W. More
1/59
T. W. More

6/58
1/59
M. W. More
1/59

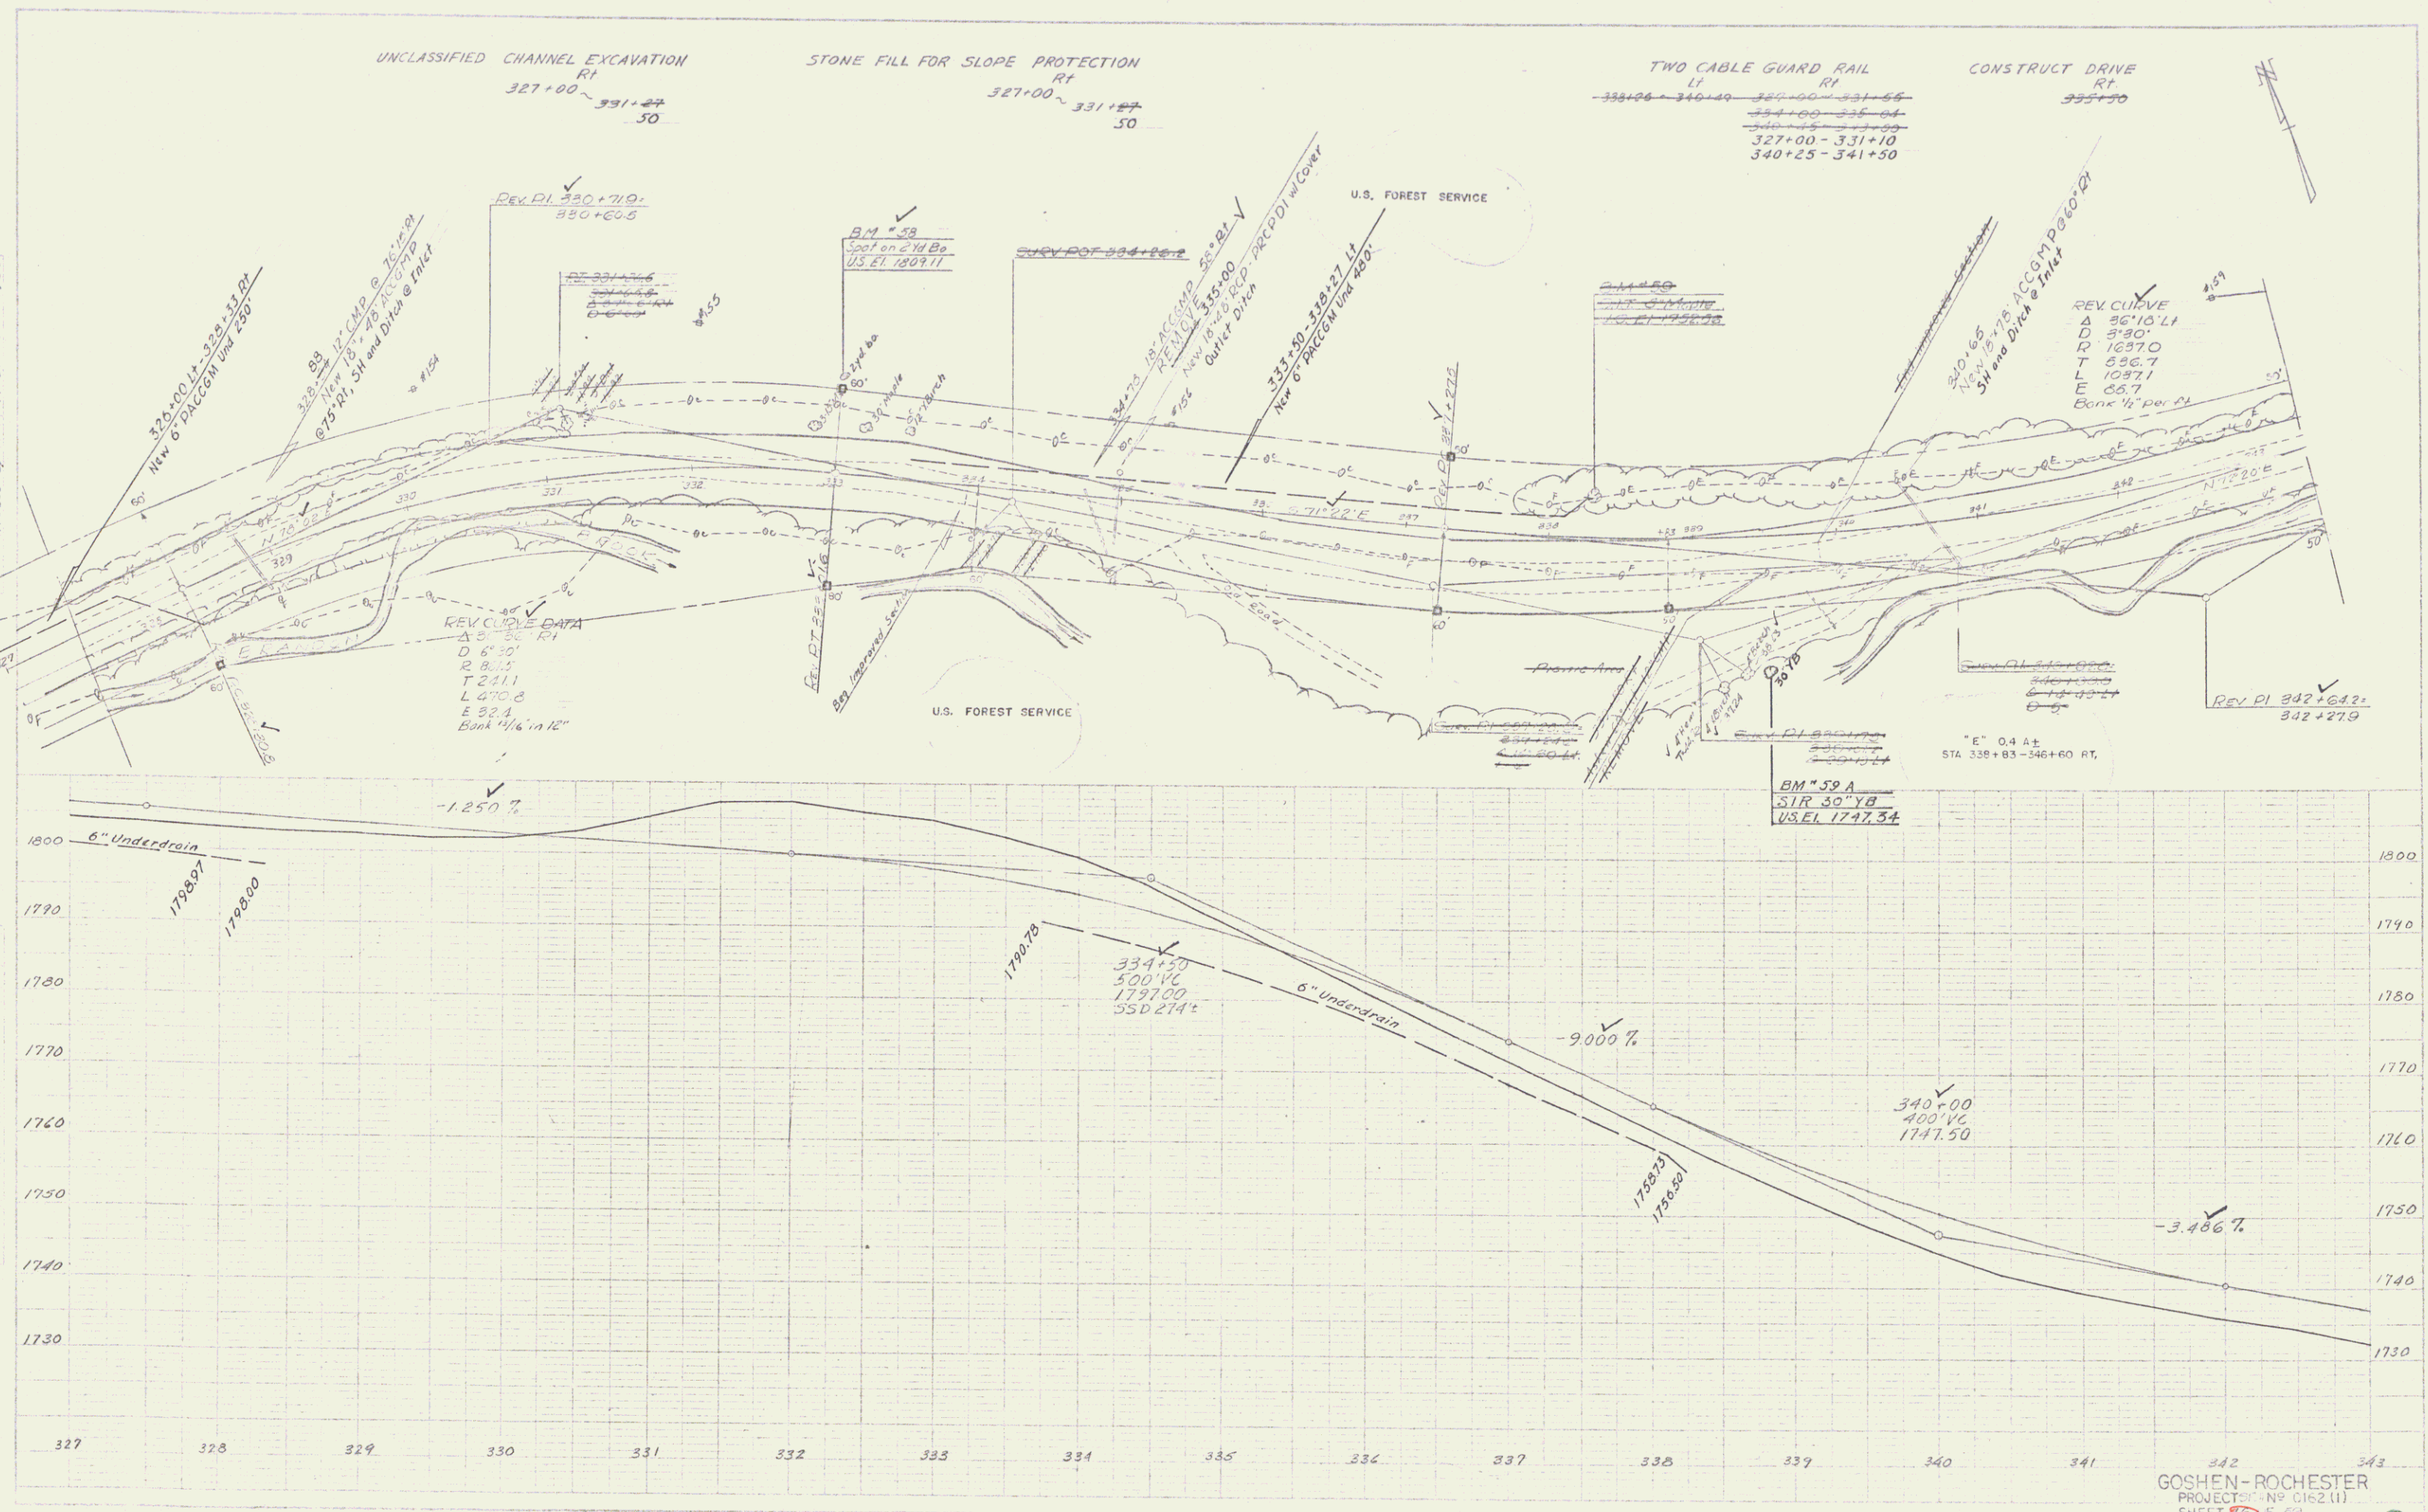

GOSHEN - ROCHESTER
PROJECT NO. C162(1)
SHEET 10 OF 12

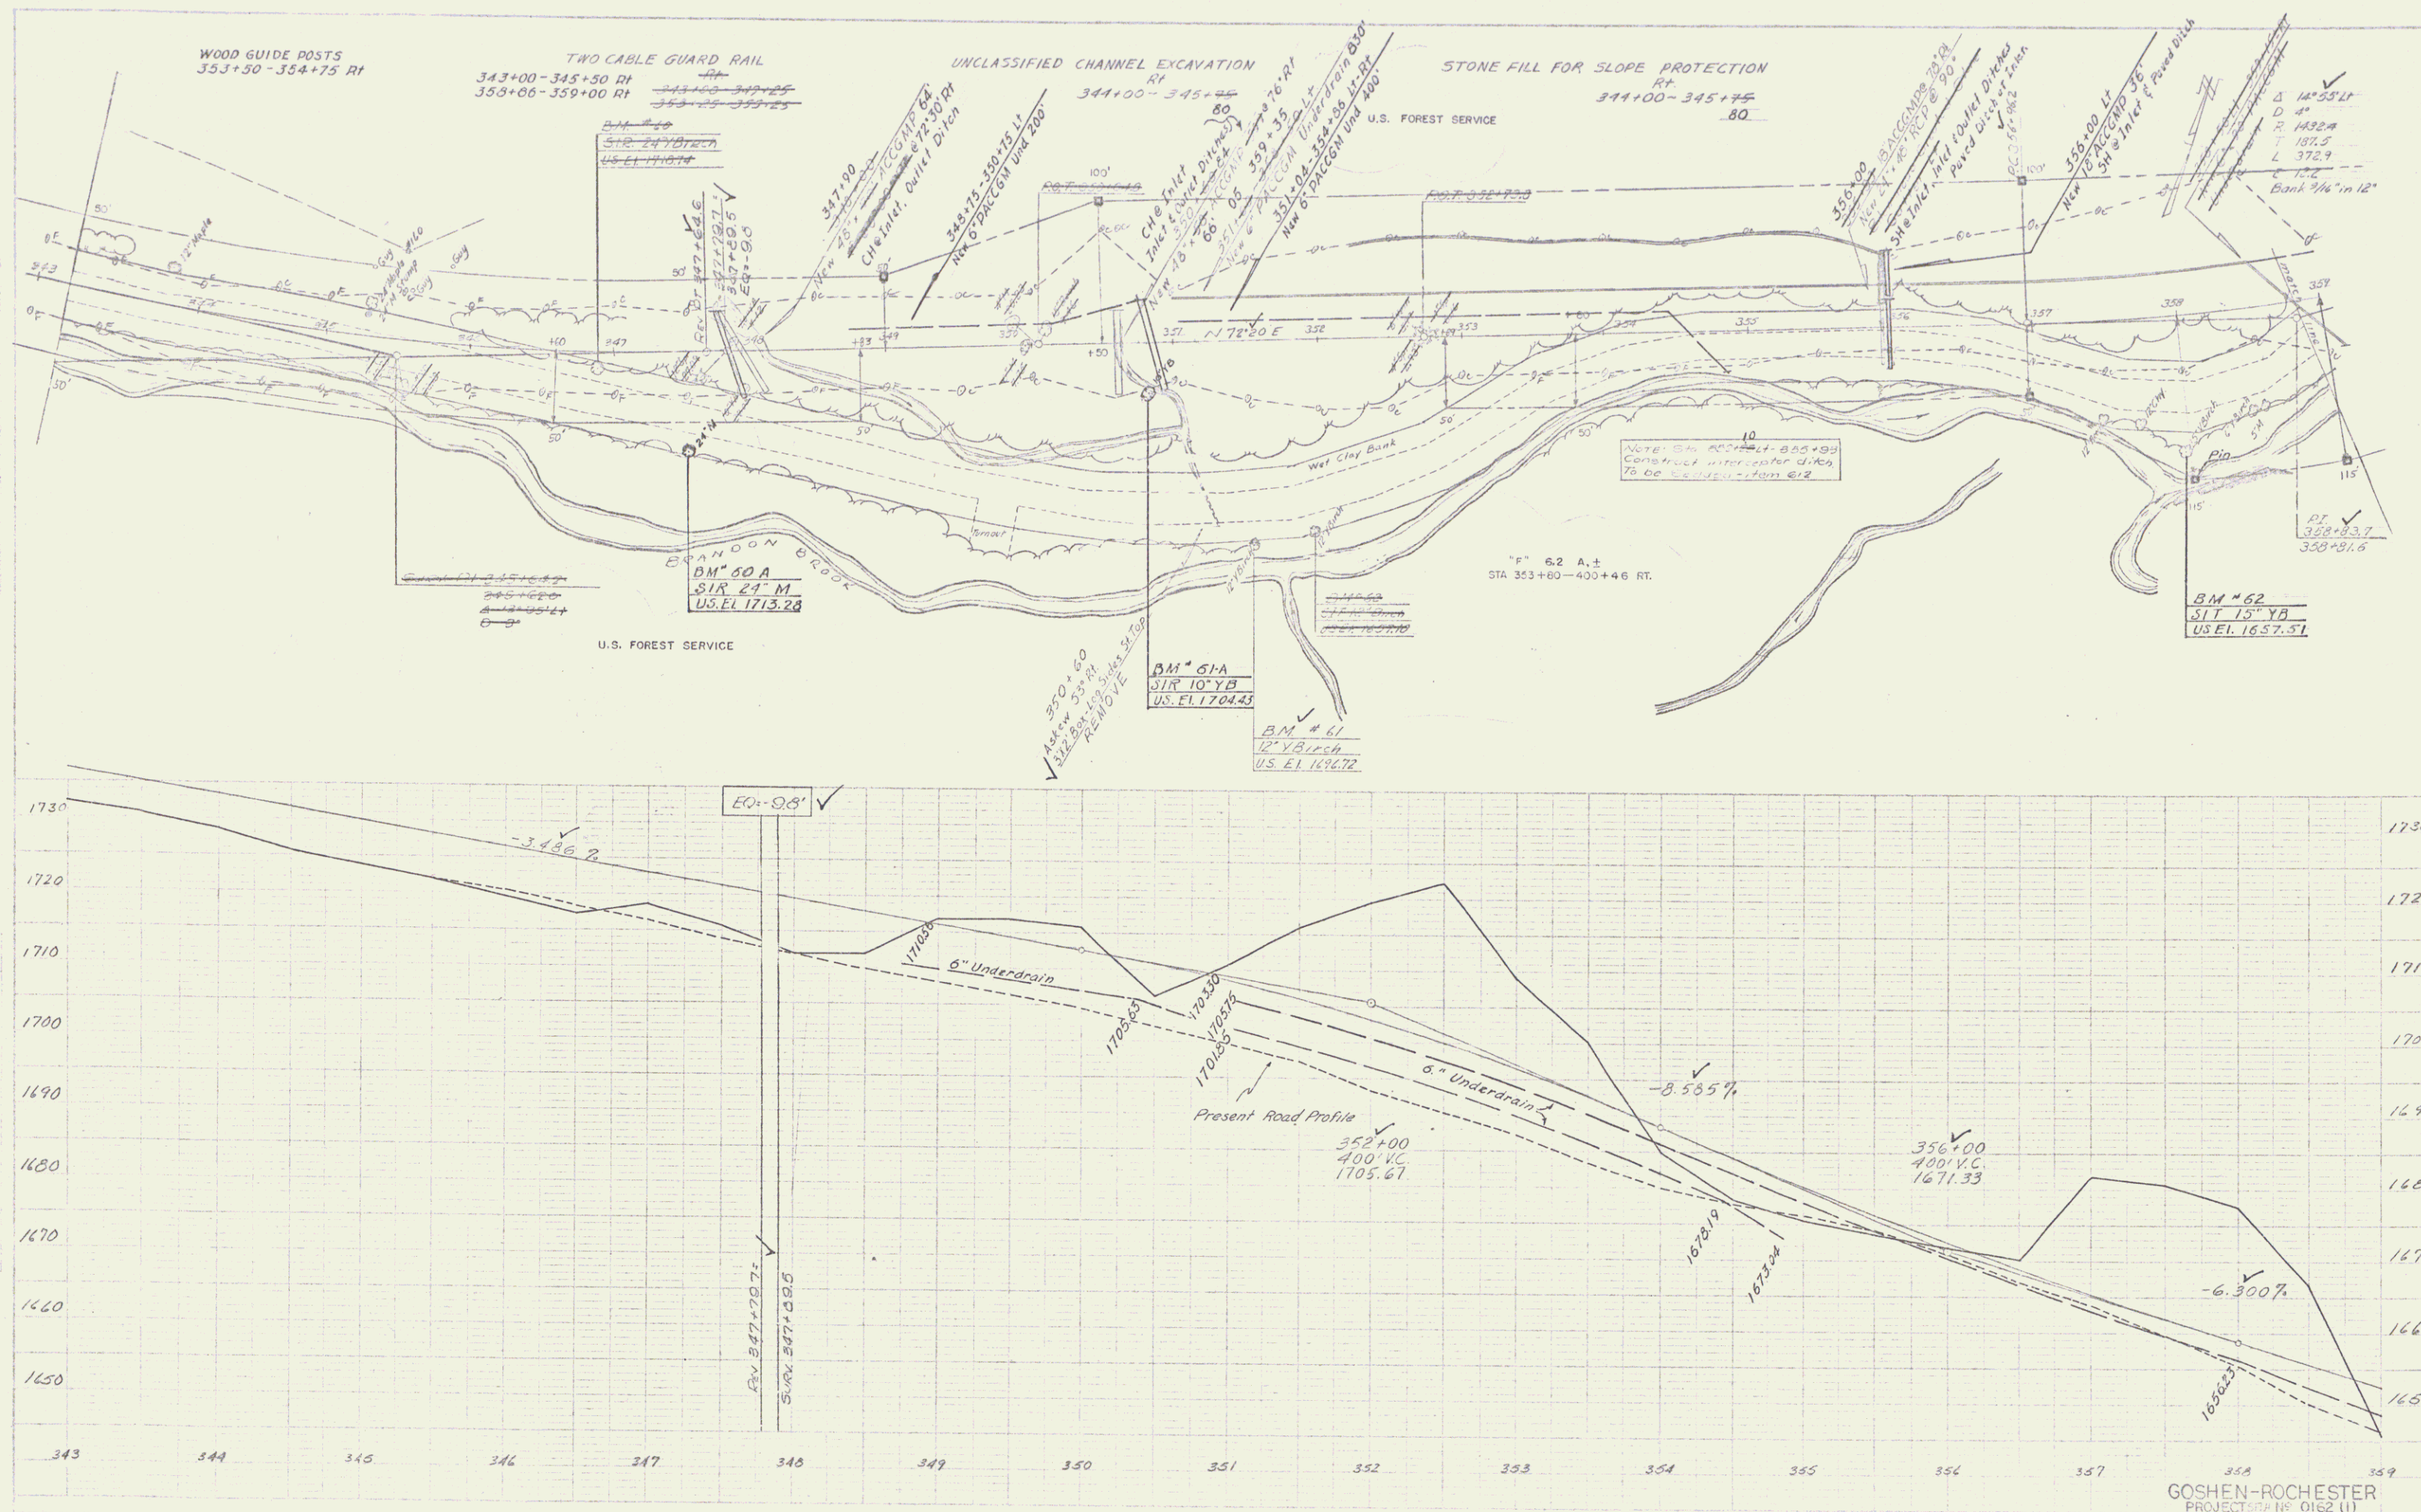


GOSHEN-ROCHESTER
PROJECT NO. 0162 (I)
SHEET 17 OF 50

10

8/28
1/20
Martin
M. Mera
1/59
Traced by

8/28
1/20
Williams
M. Mera
1/59

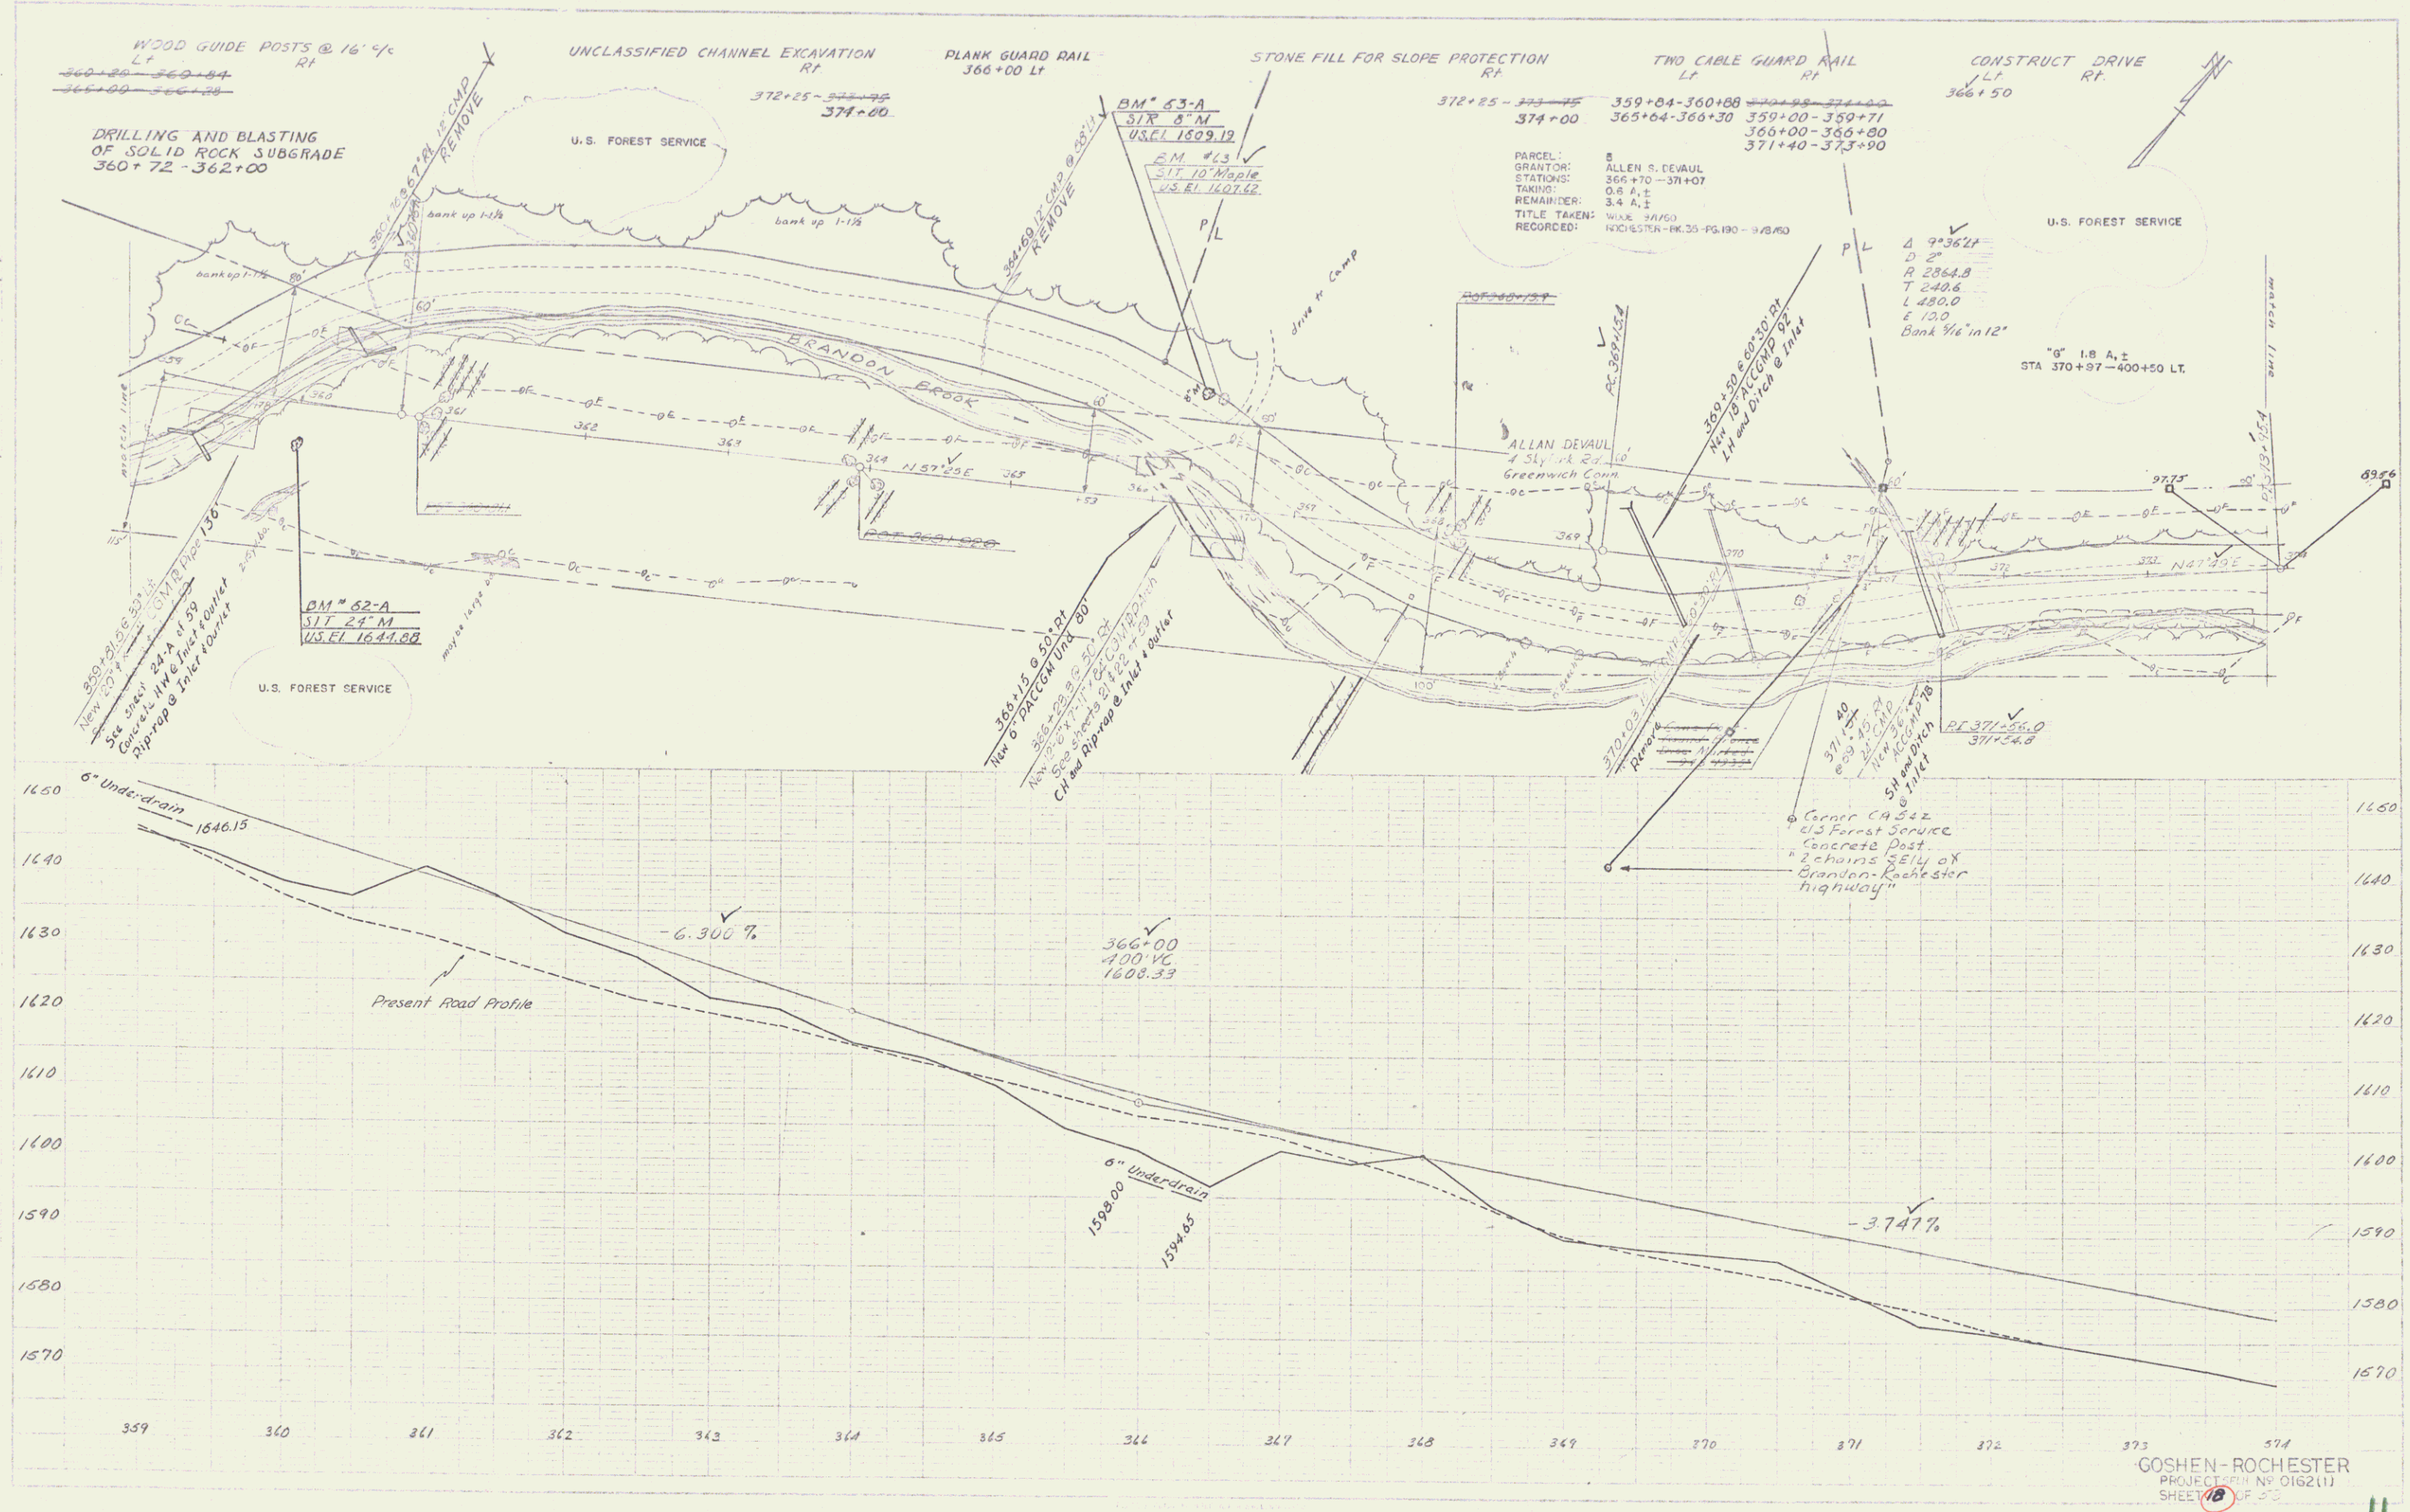

Traced by
M. J. Sullivan
1/59

8/59
M. J. Sullivan

