

PLAN	DATE
DESIGNED BY	
PLANNED BY	
CHECKED BY	
NOTED BY	
NO.	

PROFILE	DATE
DESIGNED BY	
PLANNED BY	
CHECKED BY	
NOTED BY	
NO.	

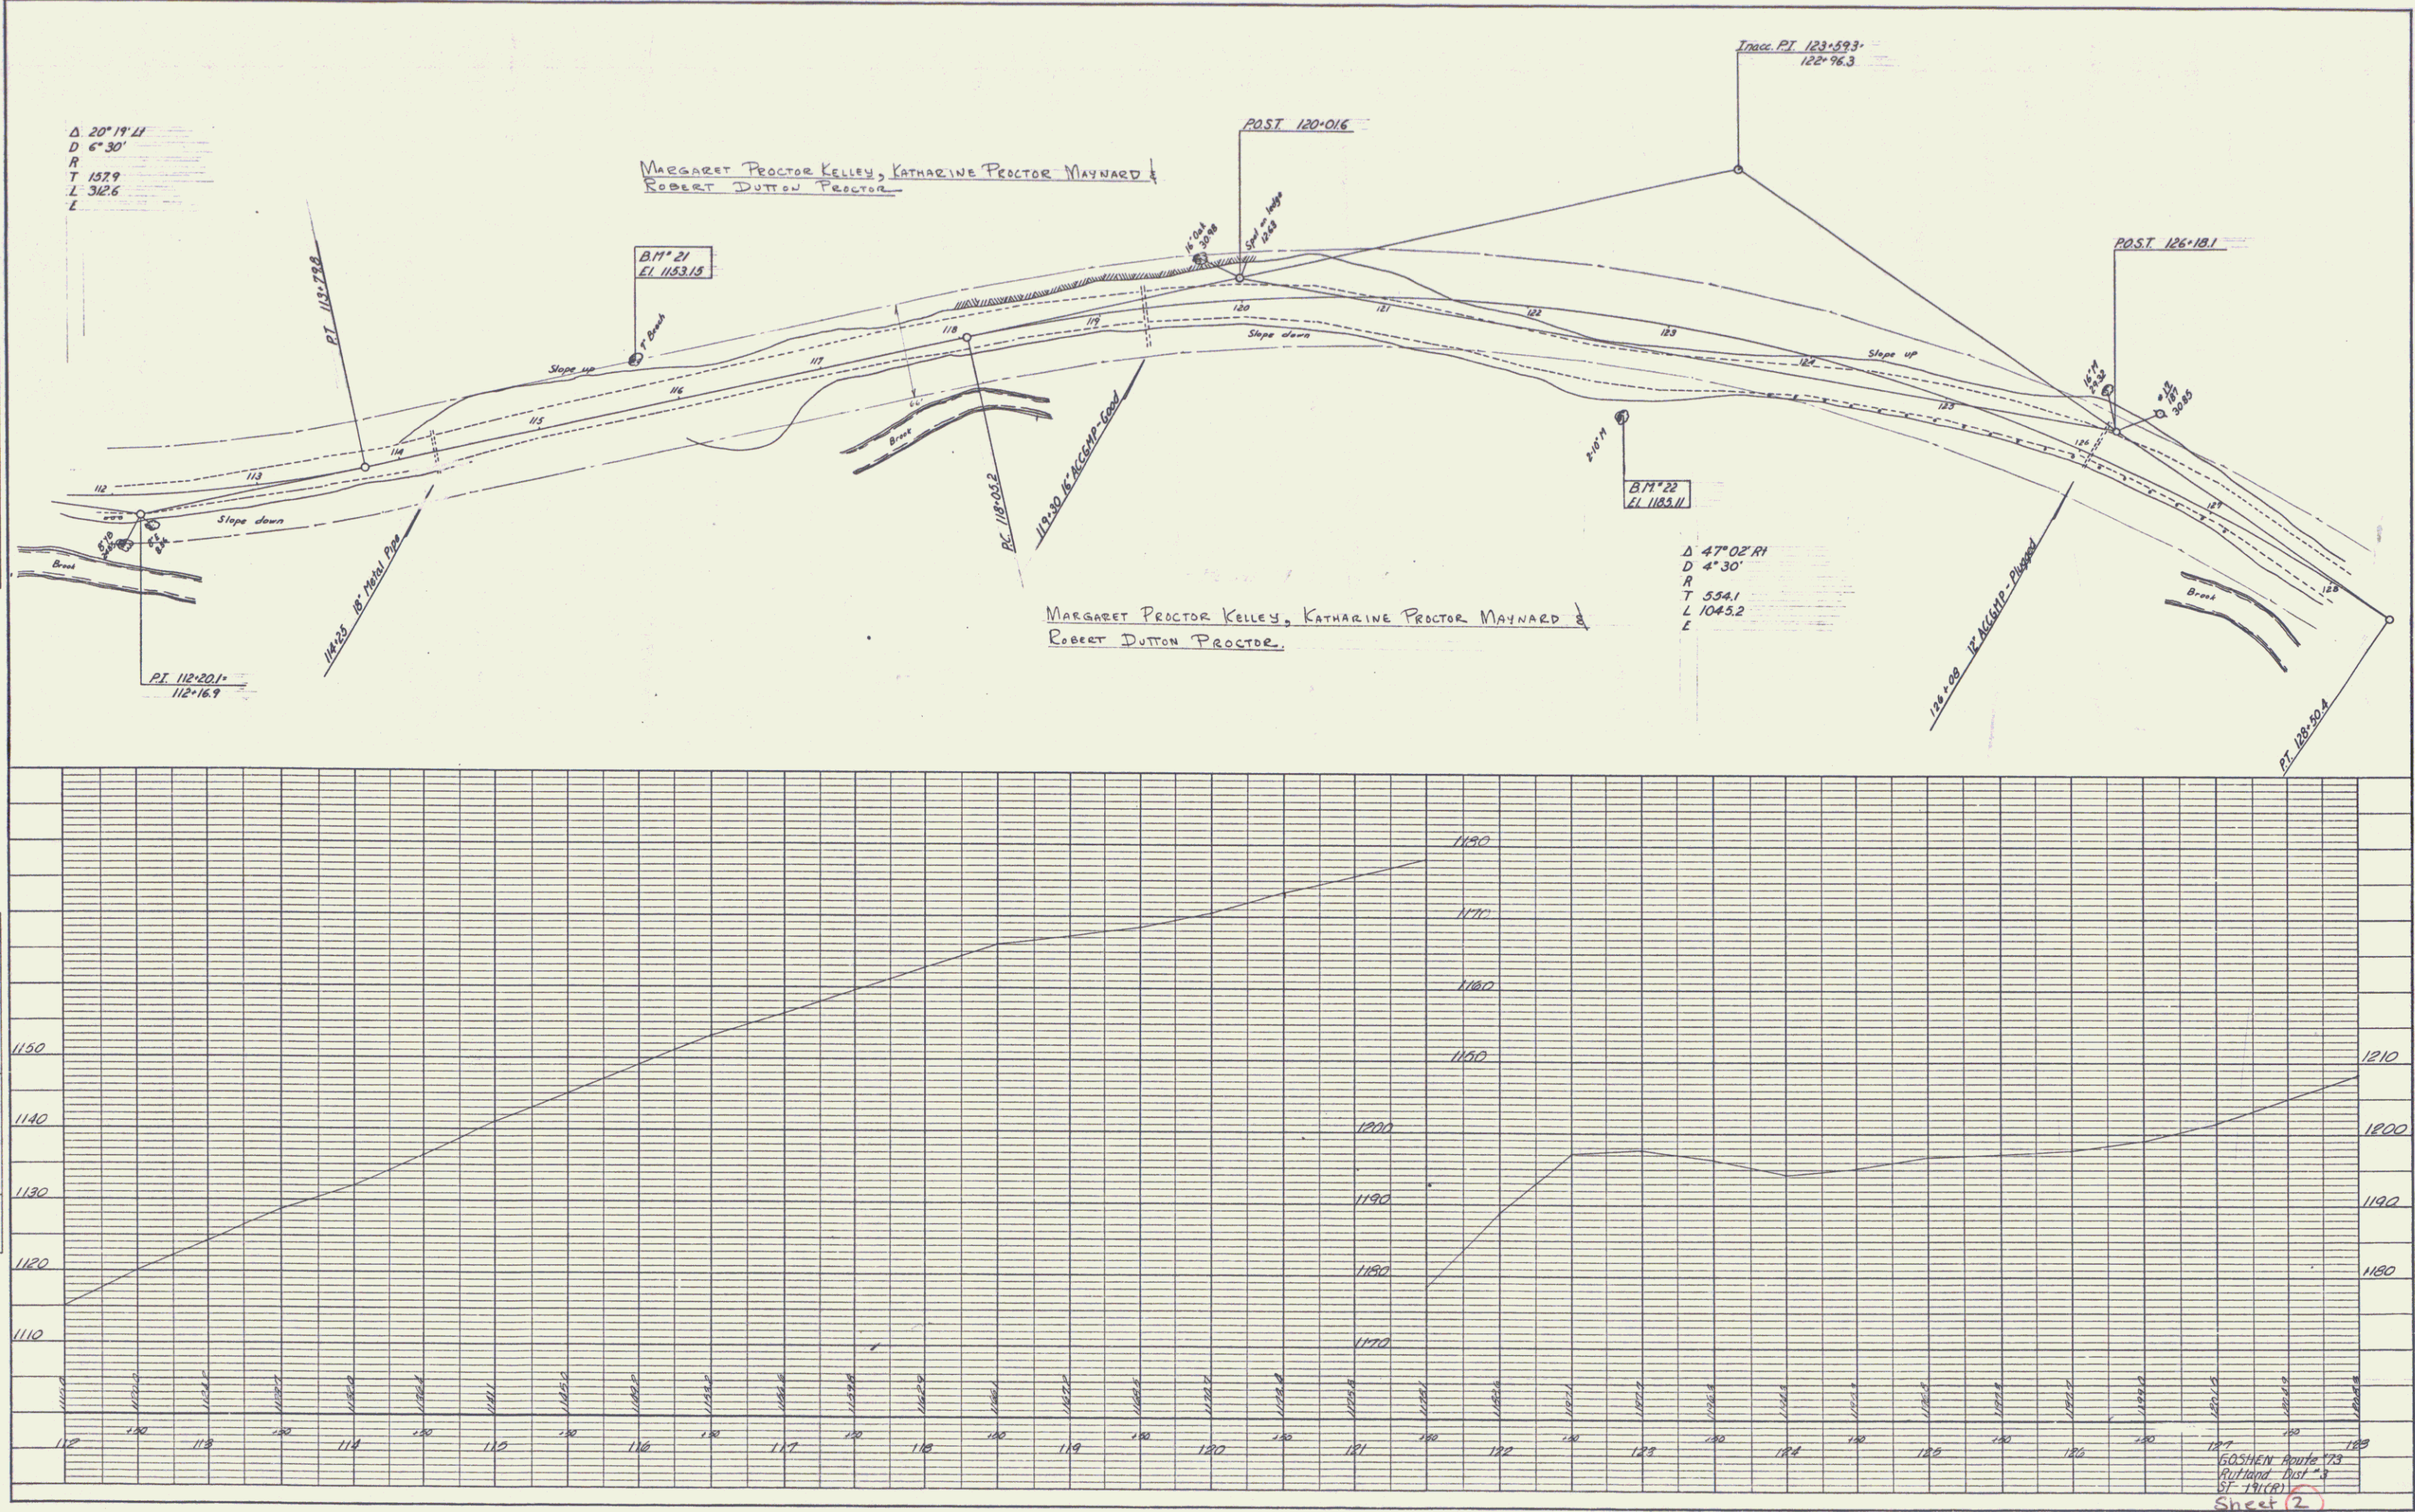


PLATE 1. PLAN PROFILE (S.P.E. & E. STANDARD)
 KUFFEL & EIDER CO. NEW YORK
 K & E CO. NO. 345-1

GOSHEN Route 173
 Putnam Dist. 3
 St. Albans
 Sheet 2

PLAN	SURVEYED	DATE
	NOTED	BY
	ALIGNED	
	RT. OF WAY CHECKED	

PROFILE	SURVEYED	DATE
	NOTED	BY
	ALIGNED	
	RT. OF WAY CHECKED	



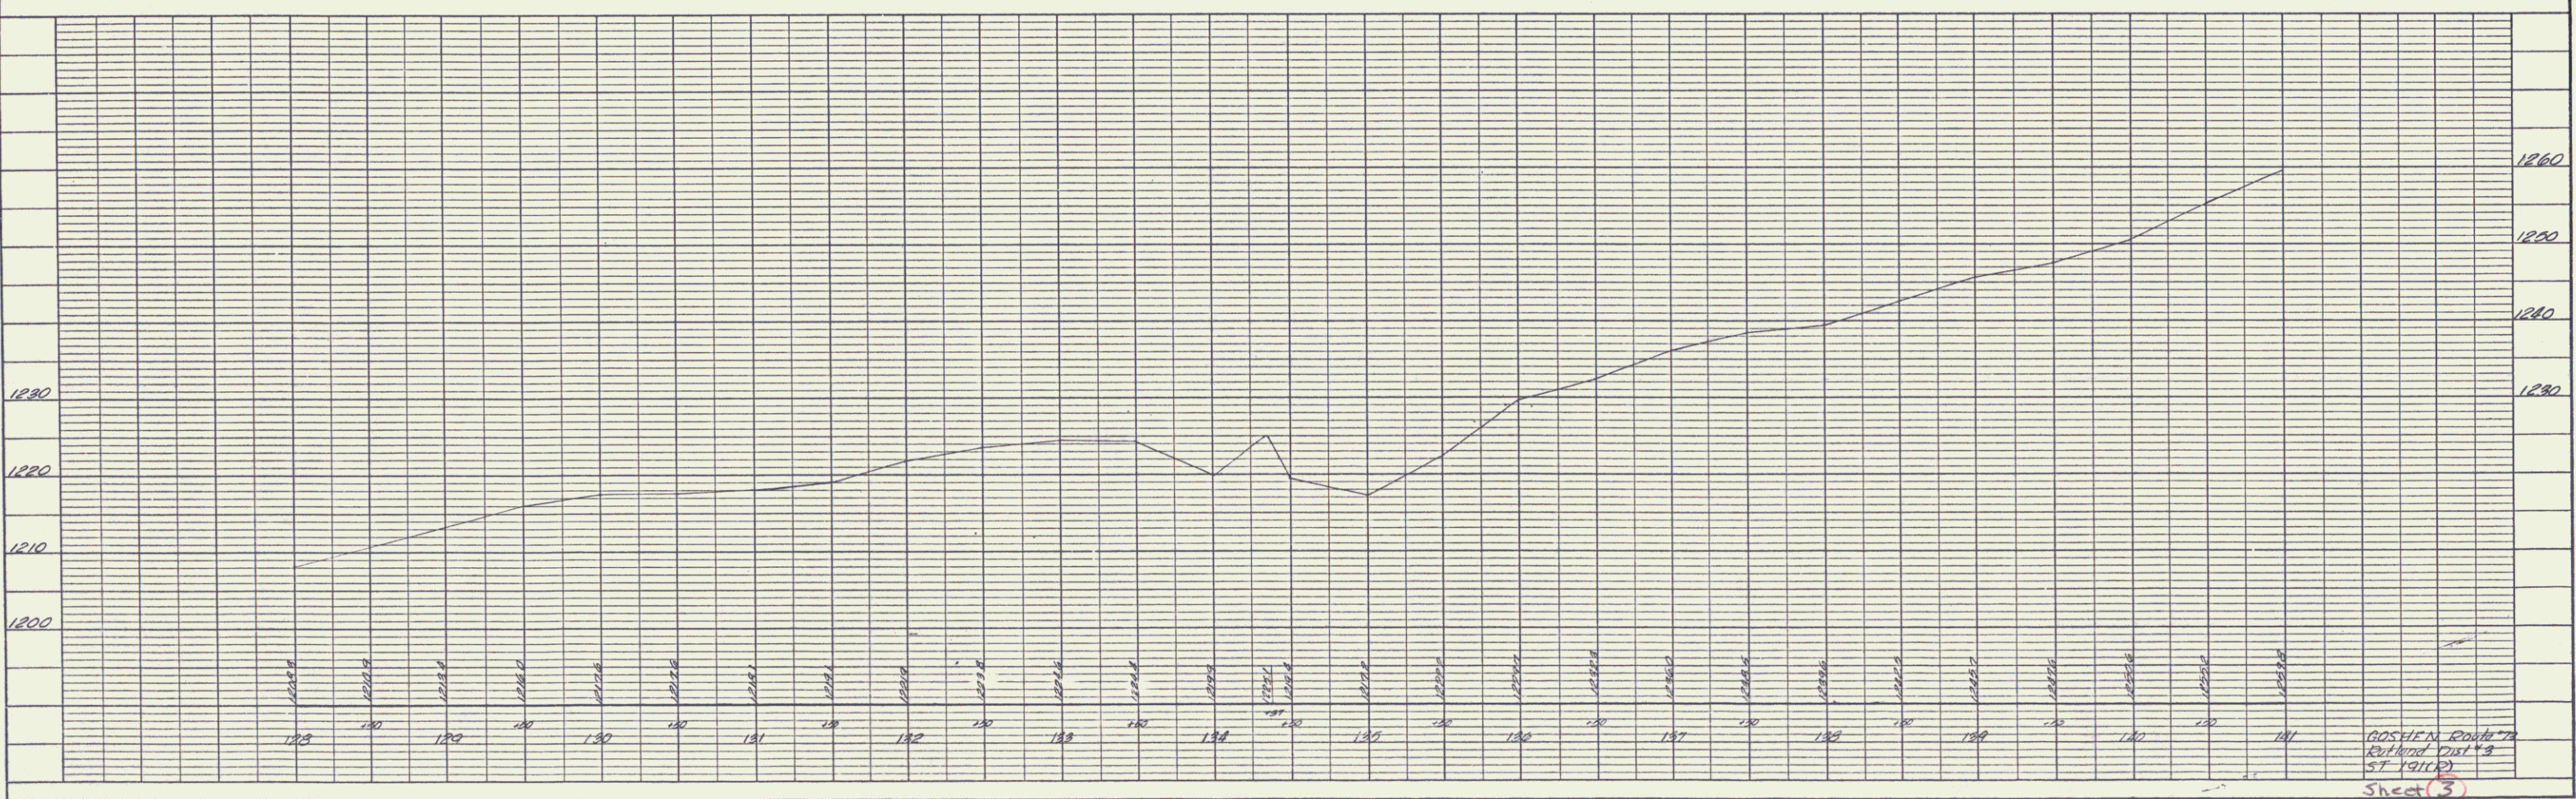


PLATE 1 - PLAN - PROFILE O.P.R.A.E. STANDARD
KEUFFEL & ESSER CO., NEW YORK
K.E.E. CO. NO. 345-1

GOSHEN ROAD
Rt. 100, Dist. 13
ST. 1911 (R)
Sheet 3


PROFILE NOTE BOOK NO. _____ SURVEYED _____ PLOTTED _____ GRADES CHECKED _____ B. M.'S NOTED _____ STRUCTURE NOTATION: CHWD _____	BY	DATE

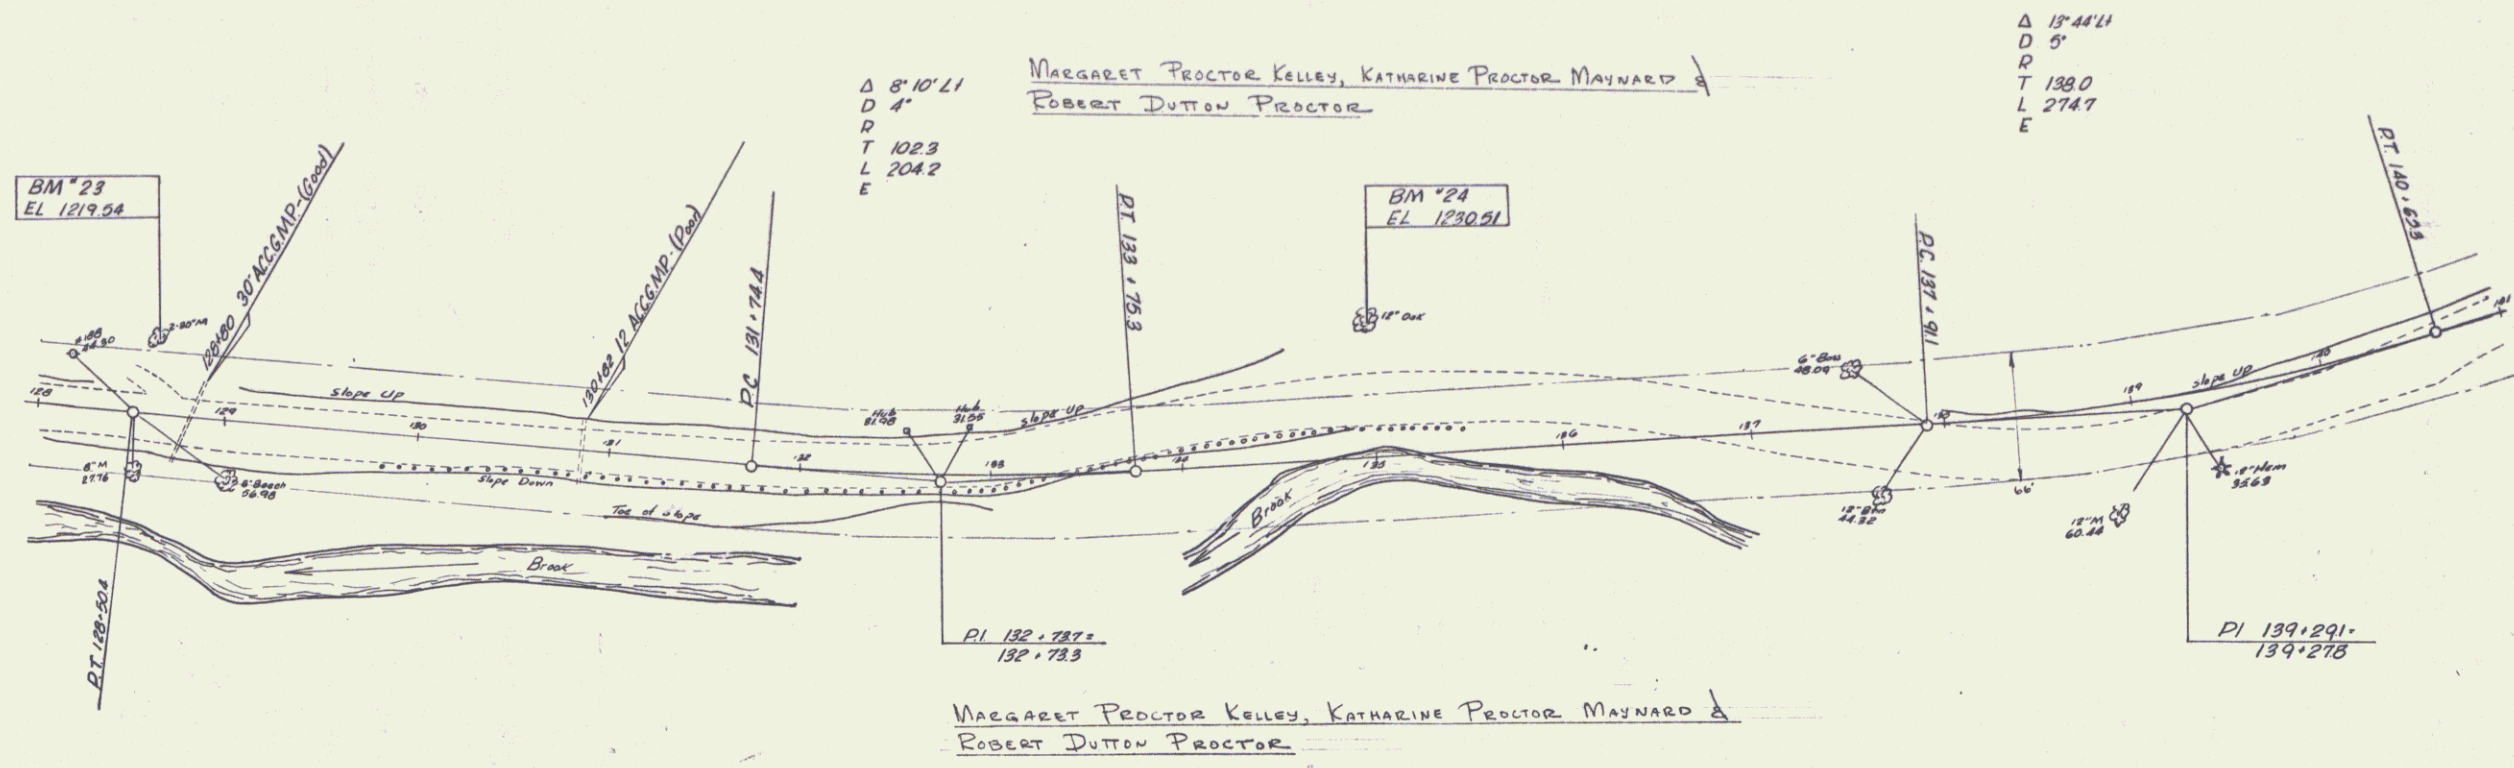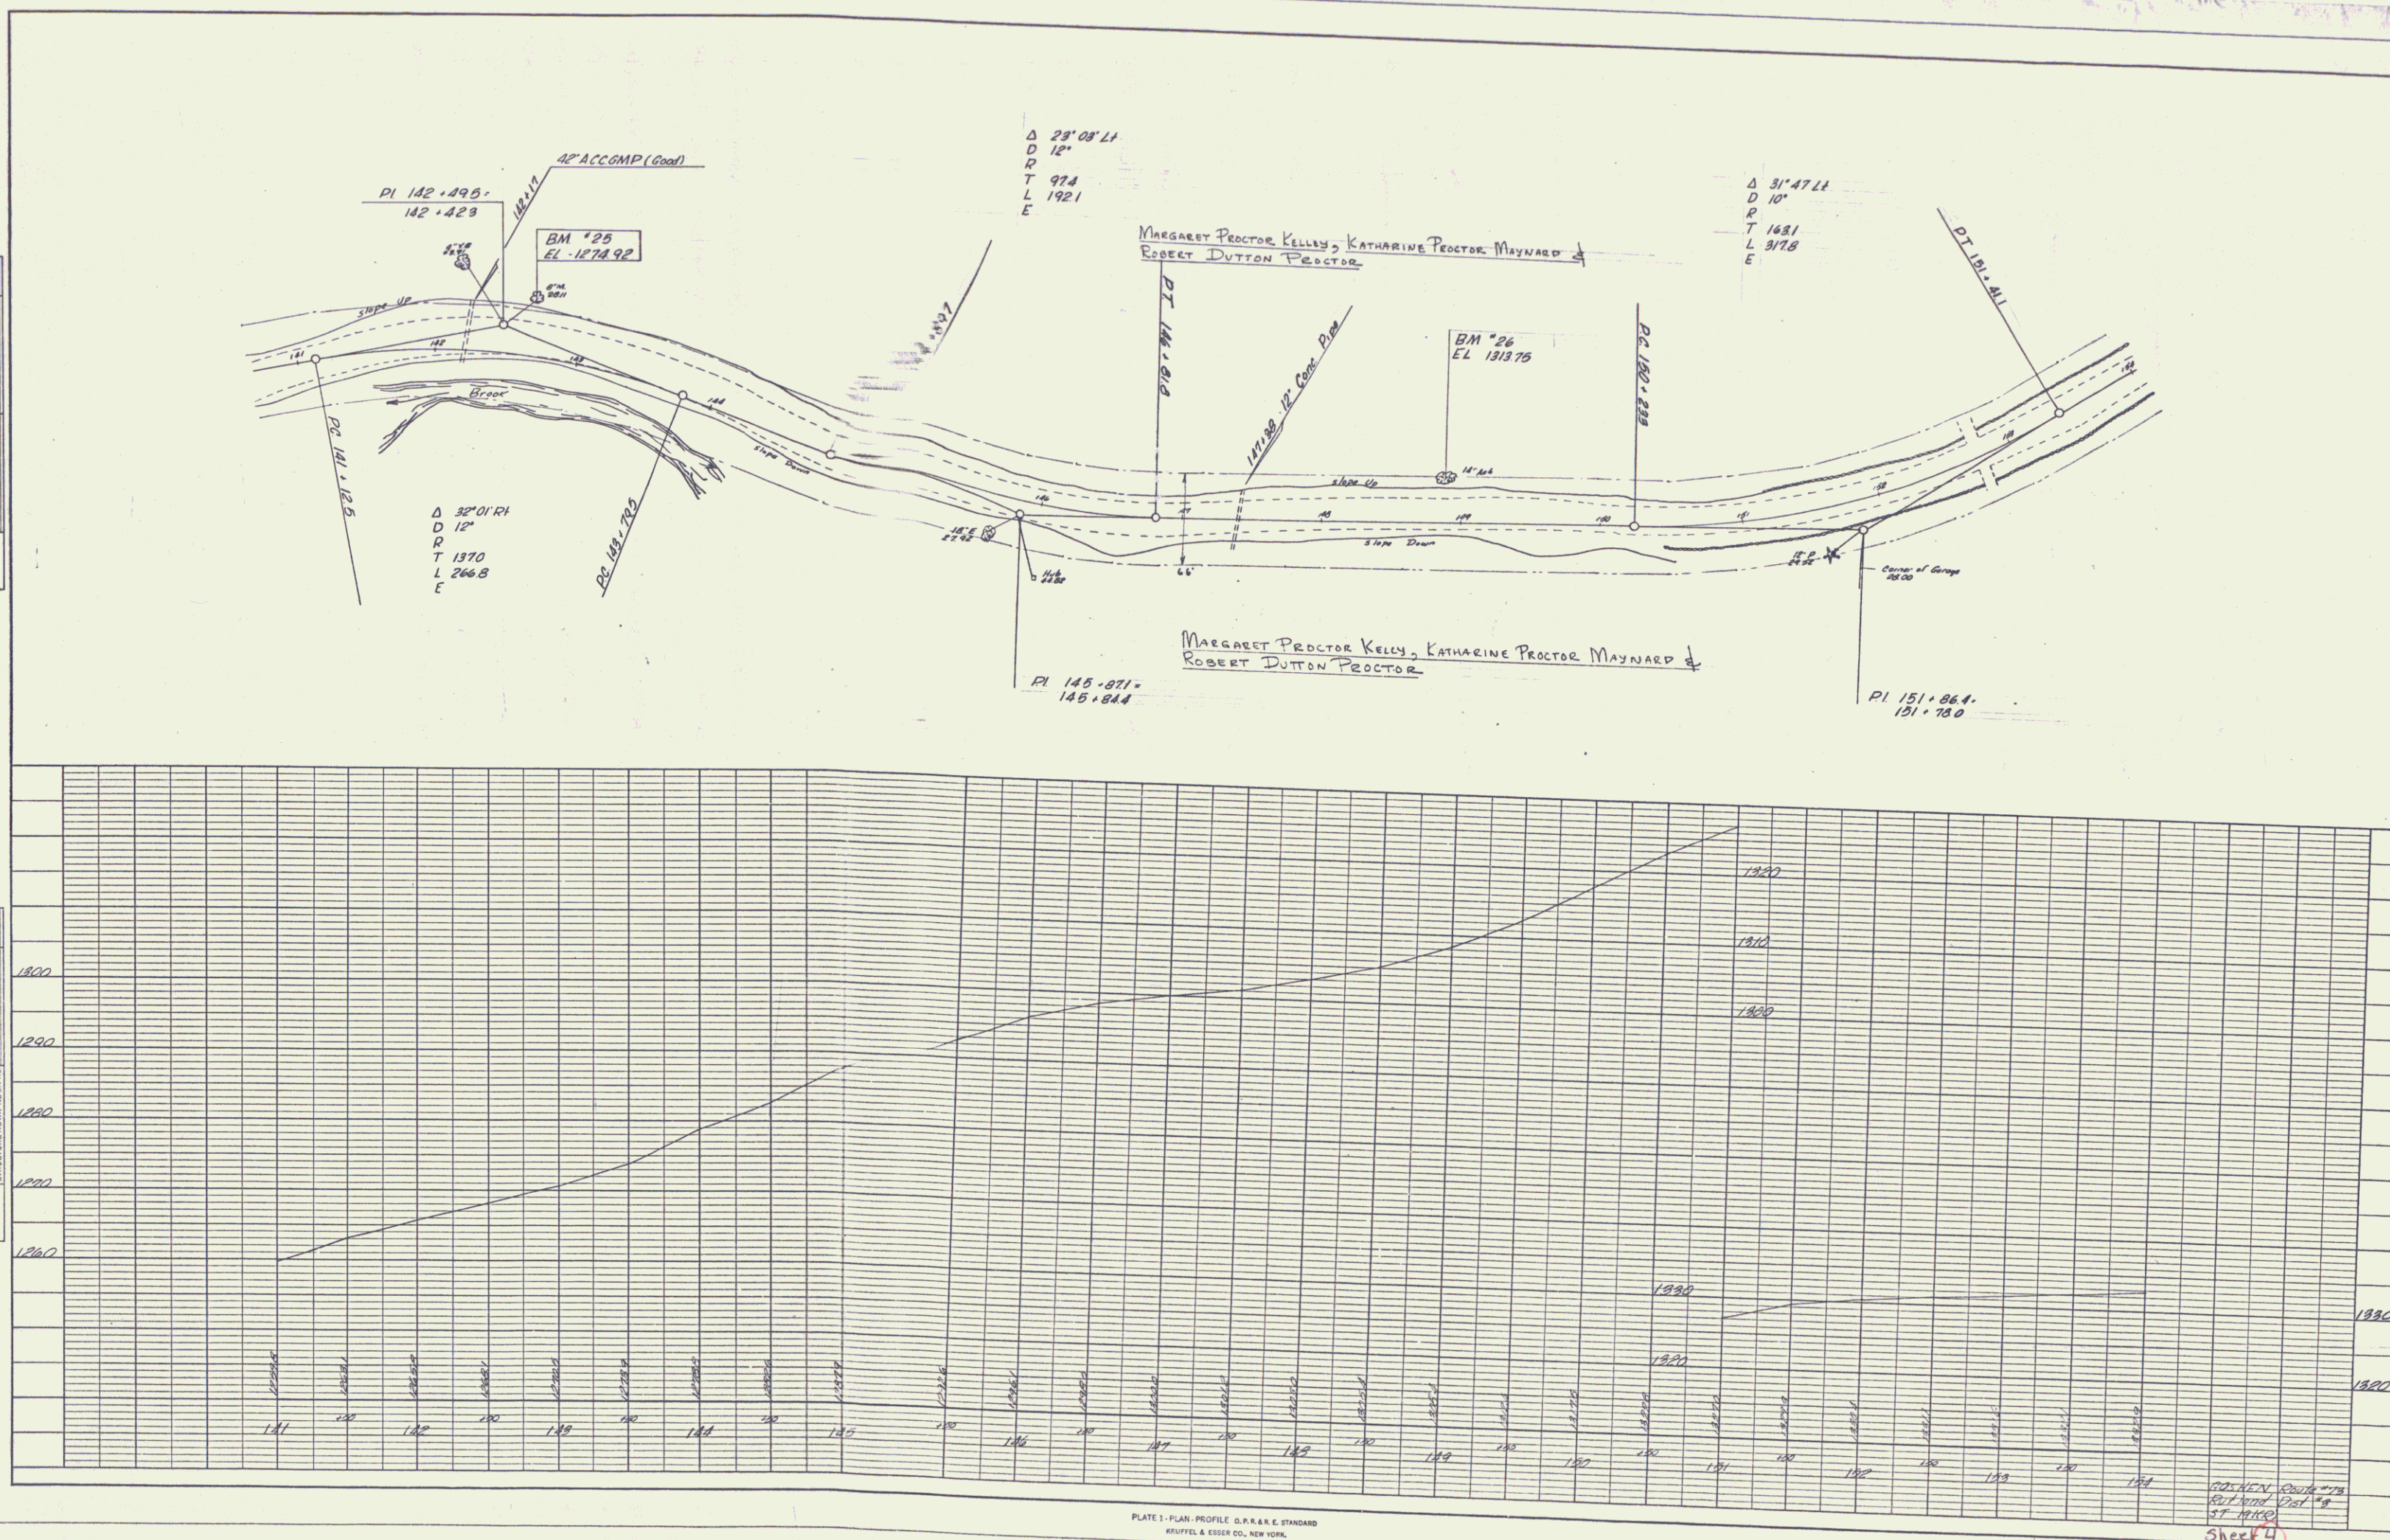

PLAN	DATE	BY	REVISION
1	9/12	L. Maynard	1
2	10/23	L. Maynard	2
3	11/23	L. Maynard	3
4	12/27	L. Maynard	4
5	1/27	L. Maynard	5
6	2/27	L. Maynard	6
7	3/27	L. Maynard	7
8	4/27	L. Maynard	8
9	5/27	L. Maynard	9
10	6/27	L. Maynard	10
11	7/27	L. Maynard	11
12	8/27	L. Maynard	12
13	9/27	L. Maynard	13
14	10/27	L. Maynard	14
15	11/27	L. Maynard	15
16	12/27	L. Maynard	16
17	1/27	L. Maynard	17
18	2/27	L. Maynard	18
19	3/27	L. Maynard	19
20	4/27	L. Maynard	20
21	5/27	L. Maynard	21
22	6/27	L. Maynard	22
23	7/27	L. Maynard	23
24	8/27	L. Maynard	24
25	9/27	L. Maynard	25
26	10/27	L. Maynard	26
27	11/27	L. Maynard	27
28	12/27	L. Maynard	28
29	1/27	L. Maynard	29
30	2/27	L. Maynard	30
31	3/27	L. Maynard	31
32	4/27	L. Maynard	32
33	5/27	L. Maynard	33
34	6/27	L. Maynard	34
35	7/27	L. Maynard	35
36	8/27	L. Maynard	36
37	9/27	L. Maynard	37
38	10/27	L. Maynard	38
39	11/27	L. Maynard	39
40	12/27	L. Maynard	40
41	1/27	L. Maynard	41
42	2/27	L. Maynard	42
43	3/27	L. Maynard	43
44	4/27	L. Maynard	44
45	5/27	L. Maynard	45
46	6/27	L. Maynard	46
47	7/27	L. Maynard	47
48	8/27	L. Maynard	48
49	9/27	L. Maynard	49
50	10/27	L. Maynard	50
51	11/27	L. Maynard	51
52	12/27	L. Maynard	52
53	1/27	L. Maynard	53
54	2/27	L. Maynard	54
55	3/27	L. Maynard	55
56	4/27	L. Maynard	56
57	5/27	L. Maynard	57
58	6/27	L. Maynard	58
59	7/27	L. Maynard	59
60	8/27	L. Maynard	60
61	9/27	L. Maynard	61
62	10/27	L. Maynard	62
63	11/27	L. Maynard	63
64	12/27	L. Maynard	64
65	1/27	L. Maynard	65
66	2/27	L. Maynard	66
67	3/27	L. Maynard	67
68	4/27	L. Maynard	68
69	5/27	L. Maynard	69
70	6/27	L. Maynard	70
71	7/27	L. Maynard	71
72	8/27	L. Maynard	72
73	9/27	L. Maynard	73
74	10/27	L. Maynard	74
75	11/27	L. Maynard	75
76	12/27	L. Maynard	76
77	1/27	L. Maynard	77
78	2/27	L. Maynard	78
79	3/27	L. Maynard	79
80	4/27	L. Maynard	80
81	5/27	L. Maynard	81
82	6/27	L. Maynard	82
83	7/27	L. Maynard	83
84	8/27	L. Maynard	84
85	9/27	L. Maynard	85
86	10/27	L. Maynard	86
87	11/27	L. Maynard	87
88	12/27	L. Maynard	88
89	1/27	L. Maynard	89
90	2/27	L. Maynard	90
91	3/27	L. Maynard	91
92	4/27	L. Maynard	92
93	5/27	L. Maynard	93
94	6/27	L. Maynard	94
95	7/27	L. Maynard	95
96	8/27	L. Maynard	96
97	9/27	L. Maynard	97
98	10/27	L. Maynard	98
99	11/27	L. Maynard	99
100	12/27	L. Maynard	100
101	1/27	L. Maynard	101
102	2/27	L. Maynard	102
103	3/27	L. Maynard	103
104	4/27	L. Maynard	104
105	5/27	L. Maynard	105
106	6/27	L. Maynard	106
107	7/27	L. Maynard	107
108	8/27	L. Maynard	108
109	9/27	L. Maynard	109
110	10/27	L. Maynard	110
111	11/27	L. Maynard	111
112	12/27	L. Maynard	112
113	1/27	L. Maynard	113
114	2/27	L. Maynard	114
115	3/27	L. Maynard	115
116	4/27	L. Maynard	116
117	5/27	L. Maynard	117
118	6/27	L. Maynard	118
119	7/27	L. Maynard	119
120	8/27	L. Maynard	120
121	9/27	L. Maynard	121
122	10/27	L. Maynard	122
123	11/27	L. Maynard	123
124	12/27	L. Maynard	124
125	1/27	L. Maynard	125
126	2/27	L. Maynard	126
127	3/27	L. Maynard	127
128	4/27	L. Maynard	128
129	5/27	L. Maynard	129
130	6/27	L. Maynard	130
131	7/27	L. Maynard	131
132	8/27	L. Maynard	132
133	9/27	L. Maynard	133
134	10/27	L. Maynard	134
135	11/27	L. Maynard	135
136	12/27	L. Maynard	136
137	1/27	L. Maynard	137
138	2/27	L. Maynard	138
139	3/27	L. Maynard	139
140	4/27	L. Maynard	140
141	5/27	L. Maynard	141
142	6/27	L. Maynard	142
143	7/27	L. Maynard	143
144	8/27	L. Maynard	144
145	9/27	L. Maynard	145
146	10/27	L. Maynard	146
147	11/27	L. Maynard	147
148	12/27	L. Maynard	148
149	1/27	L. Maynard	149
150	2/27	L. Maynard	150
151	3/27	L. Maynard	151
152	4/27	L. Maynard	152
153	5/27	L. Maynard	153
154	6/27	L. Maynard	154
155	7/27	L. Maynard	155
156	8/27	L. Maynard	156
157	9/27	L. Maynard	157
158	10/27	L. Maynard	158
159	11/27	L. Maynard	159
160	12/27	L. Maynard	160
161	1/27	L. Maynard	161
162	2/27	L. Maynard	162
163	3/27	L. Maynard	163
164	4/27	L. Maynard	164
165	5/27	L. Maynard	165
166	6/27	L. Maynard	166
167	7/27	L. Maynard	167
168	8/27	L. Maynard	168
169	9/27	L. Maynard	169
170	10/27	L. Maynard	170
171	11/27	L. Maynard	171
172	12/27	L. Maynard	172
173	1/27	L. Maynard	173
174	2/27	L. Maynard	174
175	3/27	L. Maynard	175
176	4/27	L. Maynard	176
177	5/27	L. Maynard	177
178	6/27	L. Maynard	178
179	7/27	L. Maynard	179
180	8/27	L. Maynard	180
181	9/27	L. Maynard	181
182	10/27	L. Maynard	182
183	11/27	L. Maynard	183
184	12/27	L. Maynard	184
185	1/27	L. Maynard	185
186	2/27	L. Maynard	186
187	3/27	L. Maynard	187
188	4/27	L. Maynard	188
189	5/27	L. Maynard	189
190	6/27	L. Maynard	190
191	7/27	L. Maynard	191
192	8/27	L. Maynard	192
193	9/27	L. Maynard	193
194	10/27	L. Maynard	194
195	11/27	L. Maynard	195
196	12/27	L. Maynard	196
197	1/27	L. Maynard	197
198	2/27	L. Maynard	198
199	3/27	L. Maynard	199
200	4/27	L. Maynard	200
201	5/27	L. Maynard	201
202	6/27	L. Maynard	202
203	7/27	L. Maynard	203
204	8/27	L. Maynard	204
205	9/27	L. Maynard	205
206	10/27	L. Maynard	206
207	11/27	L. Maynard	207
208	12/27	L. Maynard	208
209	1/27	L. Maynard	209
210	2/27	L. Maynard	210
211	3/27	L. Maynard	211
212	4/27	L. Maynard	212
213	5/27	L. Maynard	213
214	6/27	L. Maynard	214
215	7/27	L. Maynard	215
216	8/27	L. Maynard	216
217	9/27	L. Maynard	217
218	10/27	L. Maynard	218
219	11/27	L. Maynard	219
220	12/27	L. Maynard	220
221	1/27	L. Maynard	221
222	2/27	L. Maynard	222
223	3/27	L. Maynard	223
224	4/27	L. Maynard	224
225	5/27	L. Maynard	225
226	6/27	L. Maynard	226
227	7/27	L. Maynard	227
228	8/27	L. Maynard	228
229	9/27	L. Maynard	229
230	10/27	L. Maynard	230
231	11/27	L. Maynard	231
232	12/27	L. Maynard	232
233	1/27	L. Maynard	233
234	2/27	L. Maynard	234
235	3/27	L. Maynard	235
236	4/27	L. Maynard	236
237	5/27	L. Maynard	237
238	6/27	L. Maynard	238
239	7/27	L. Maynard	239
240	8/27	L. Maynard	240
241	9/27	L. Maynard	241
242	10/27	L. Maynard	242
243	11/27	L. Maynard	243
244	12/27	L. Maynard	244
245	1/27	L. Maynard	245
246	2/27	L. Maynard	246
247	3/27	L. Maynard	247
248	4/27	L. Maynard	248
249	5/27	L. Maynard	249
250	6/27	L. Maynard	250
251	7/27	L. Maynard	251
252	8/27	L. Maynard	252
253	9/27	L. Maynard	253
254	10/27	L. Maynard	254
255	11/27	L. Maynard	255
256	12/27	L. Maynard	256
257	1/27	L. Maynard	257
258	2/27	L. Maynard	258
259	3/27	L. Maynard	259
260	4/27	L. Maynard	260
261	5/27	L. Maynard	261
262	6/27	L. Maynard	262
263	7/27	L. Maynard	263
264	8/27	L. Maynard	264
265	9/27	L. Maynard	265
266	10/27	L. Maynard	266
267	11/27	L. Maynard	267
268	12/27	L. Maynard	268
269	1/27	L. Maynard	269
270	2/27	L. Maynard	270
271	3/27	L. Maynard	271
272	4/27	L. Maynard	272
273	5/27	L. Maynard	273
274	6/27	L. Maynard	274
275	7/27	L. Maynard	275
276	8/27	L. Maynard	276
277	9/27	L. Maynard	277
278	10/27	L. Maynard	278
279	11/27	L. Maynard	279
280	12/27	L. Maynard	280
281	1/27	L. Maynard	281
282	2/27	L. Maynard	282
283	3/27	L. Maynard	283
284	4/27	L. Maynard	284
285	5/27	L. Maynard	285
286	6/27	L. Maynard	286
287	7/27	L. Maynard	287
288	8/27	L. Maynard	288
289	9/27	L. Maynard	289
290	10/27	L. Maynard	290
291	11/27	L. Maynard	291
292	12/27	L. Maynard	292
293	1/27	L. Maynard	293
294	2/27	L. Maynard	294
295	3/27	L. Maynard	295
296	4/27	L. Maynard	296
297	5/27	L. Maynard	297
298	6/27	L. Maynard	298
299	7/27	L. Maynard	299
300	8/27	L. Maynard	300
301	9/27	L. Maynard	301
302	10/27	L. Maynard	302
303	11/27	L. Maynard	303
304	12/27	L. Maynard	304
305	1/27	L. Maynard	305
306	2/27	L. Maynard	306
307	3/27	L. Maynard	307
308	4/27	L. Maynard	308
309	5/27	L. Maynard	309
310	6/27	L. Maynard	310
311	7/27	L. Maynard	311
312	8/27	L. Maynard	312
313	9/27	L. Maynard	313
314	10/27	L. Maynard	314
315	11/27	L. Maynard	315
316	12/27	L. Maynard	316
317	1/27	L. Maynard	317
318	2/27	L. Maynard	318
319	3/27	L. Maynard	319
320	4/27		


PLAN	
DATE	BY
SURVEYED	
NOTE BOOK	
REVISIONS	
NO. OF WY. CHECKED	
NO.	

PROFILE	
DATE	BY
SURVEYED	
NOTE BOOK	
REVISIONS	
NO. OF WY. CHECKED	
NO.	

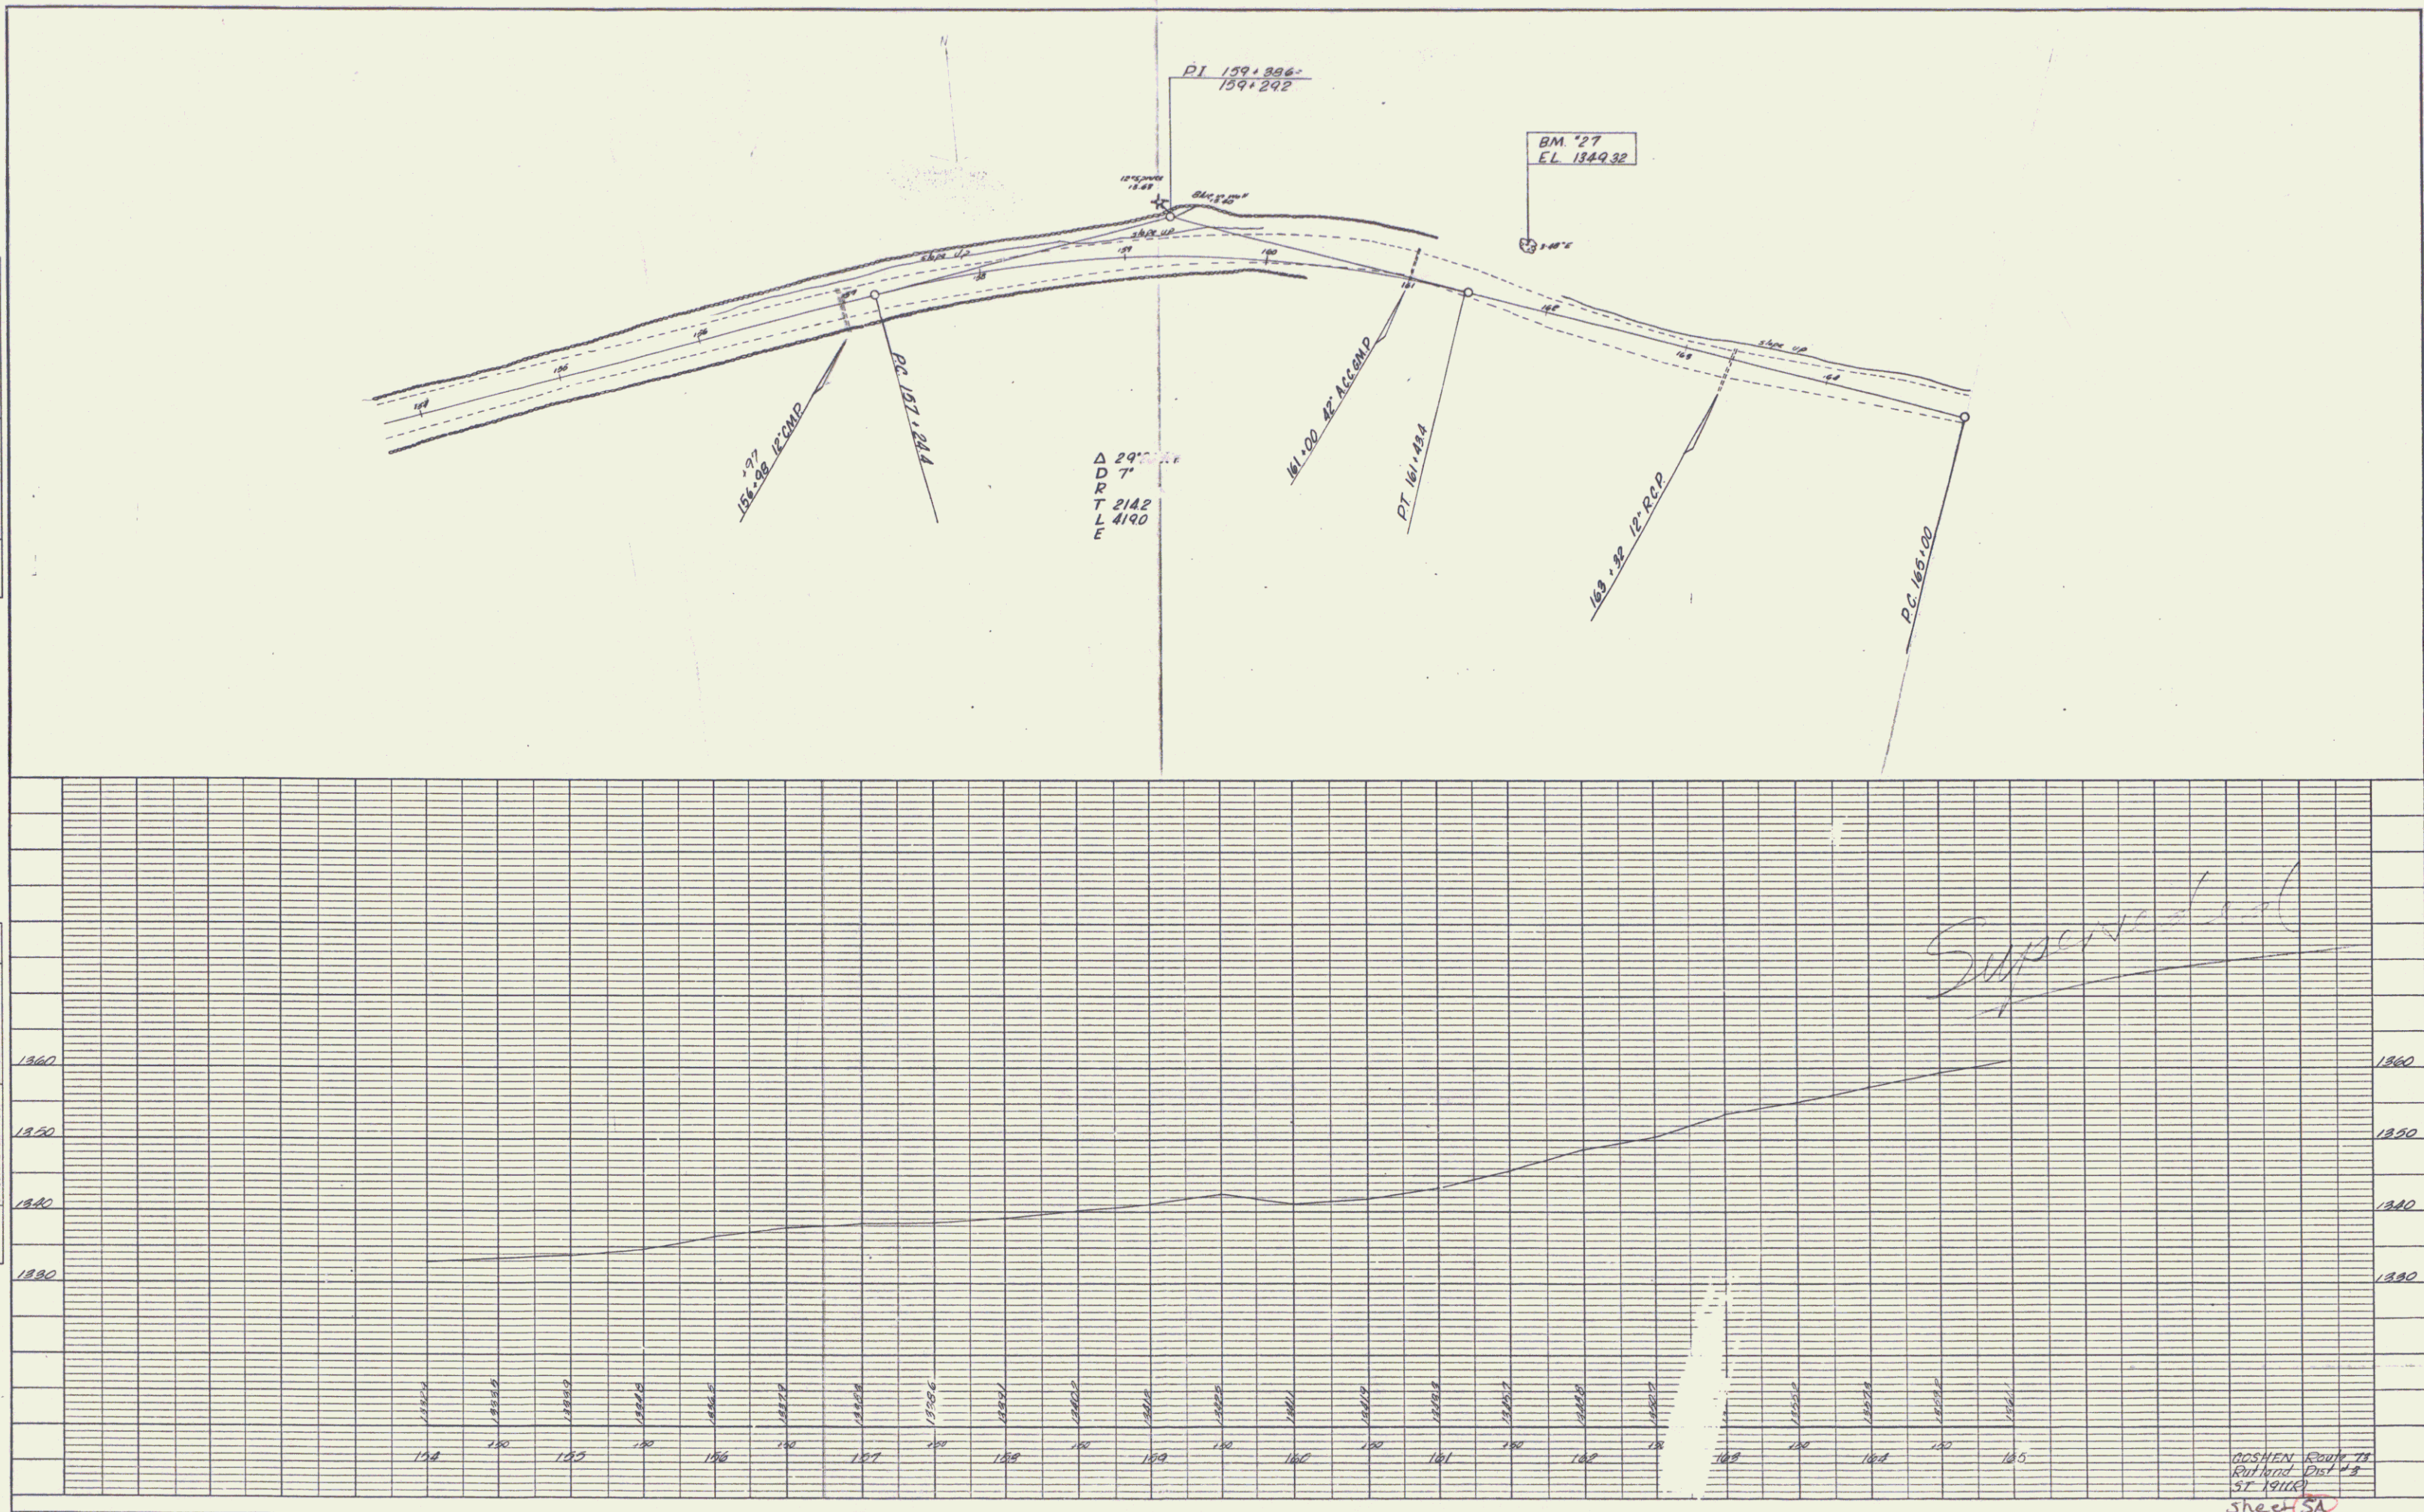


PLAN	SURVEYED _____	BY _____	DATE _____
NOTE BOOK _____	PLOTTED _____		
NO. _____	ALIGNMENT CHECKED _____		
	RT. OF WAY CHECKED _____		

NO. _____	BY _____	DATE _____
SURVEYED _____ PLOTTED _____ GRADES CHECKED _____ B. M.'S NOTED _____ STRUCTURE NOTATIONS CHECKED _____		

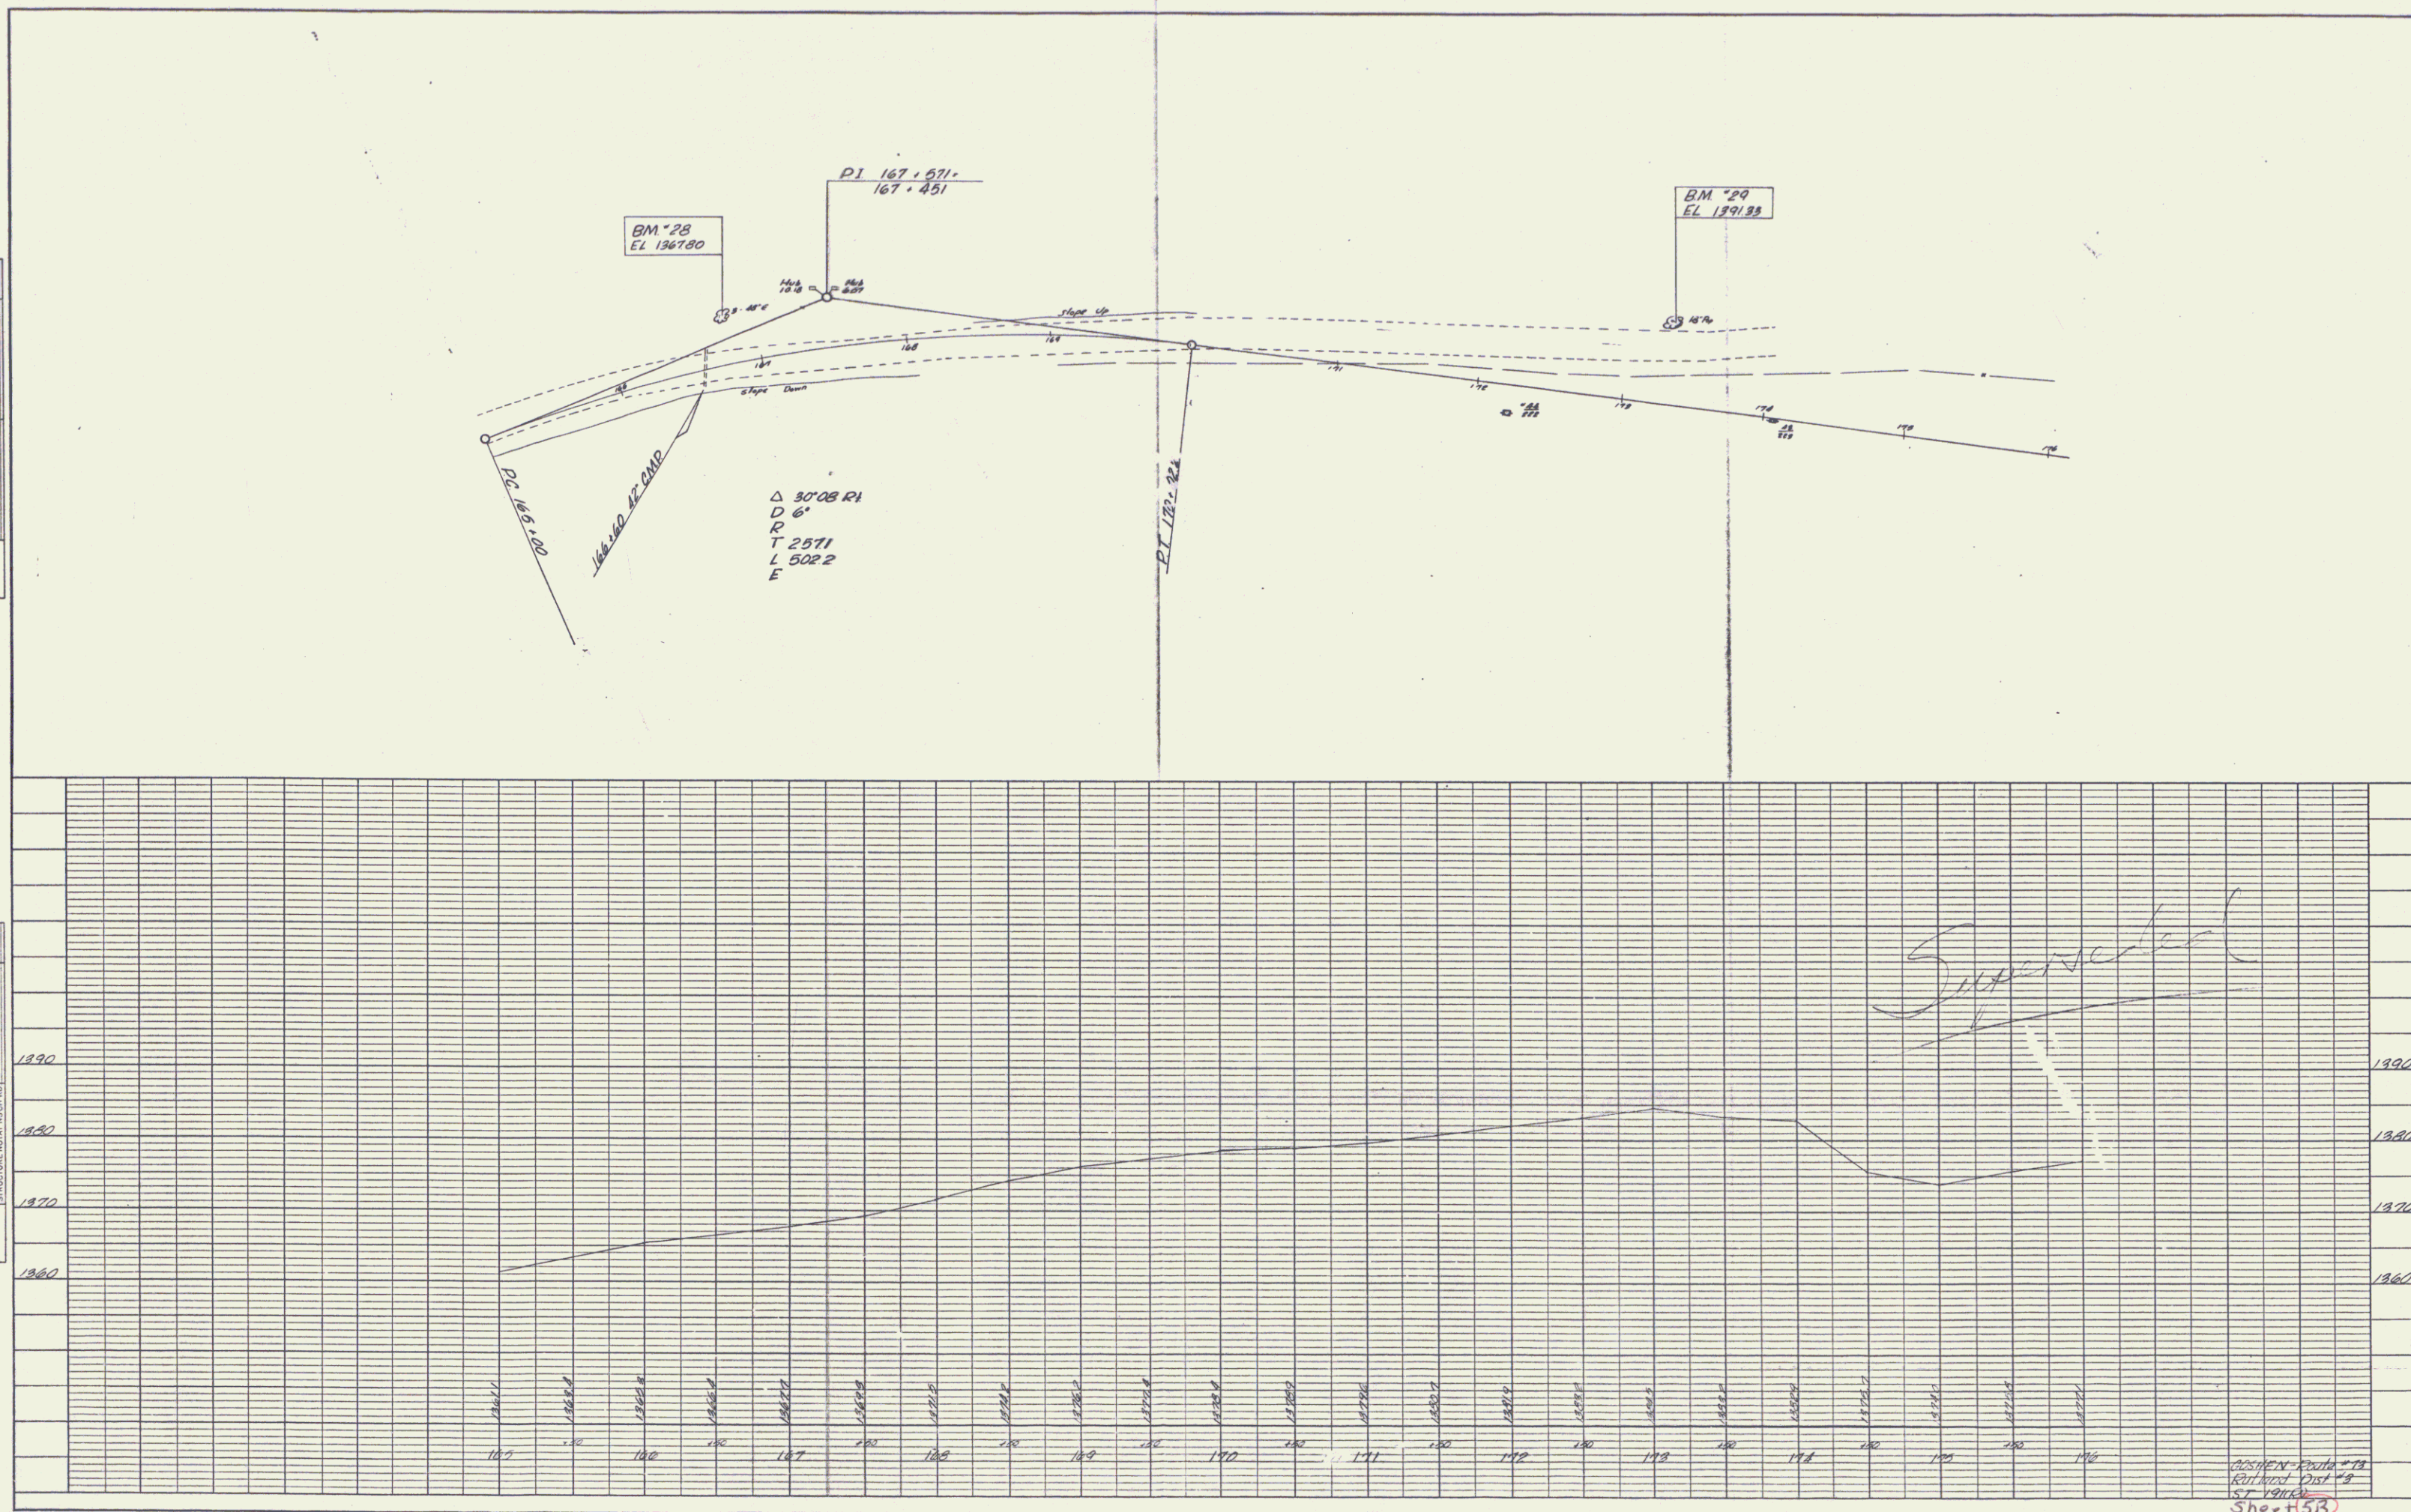

PLAN	DATE
SUBJECT: <u>Highway 73</u>	DATE: <u>12-27-27</u>
BY: <u>L. H. HANLEY</u>	
CHECKED: <u>W. C. CONLEY</u>	
NO. OF WAY CHECKED: <u>1</u>	
NO.	

PROFILE	DATE
SUBJECT: <u>Highway 73</u>	DATE: <u>12-27-27</u>
BY: <u>MM</u>	
CHECKED: <u>MM</u>	
NO. OF WAY CHECKED: <u>1</u>	
NO.	

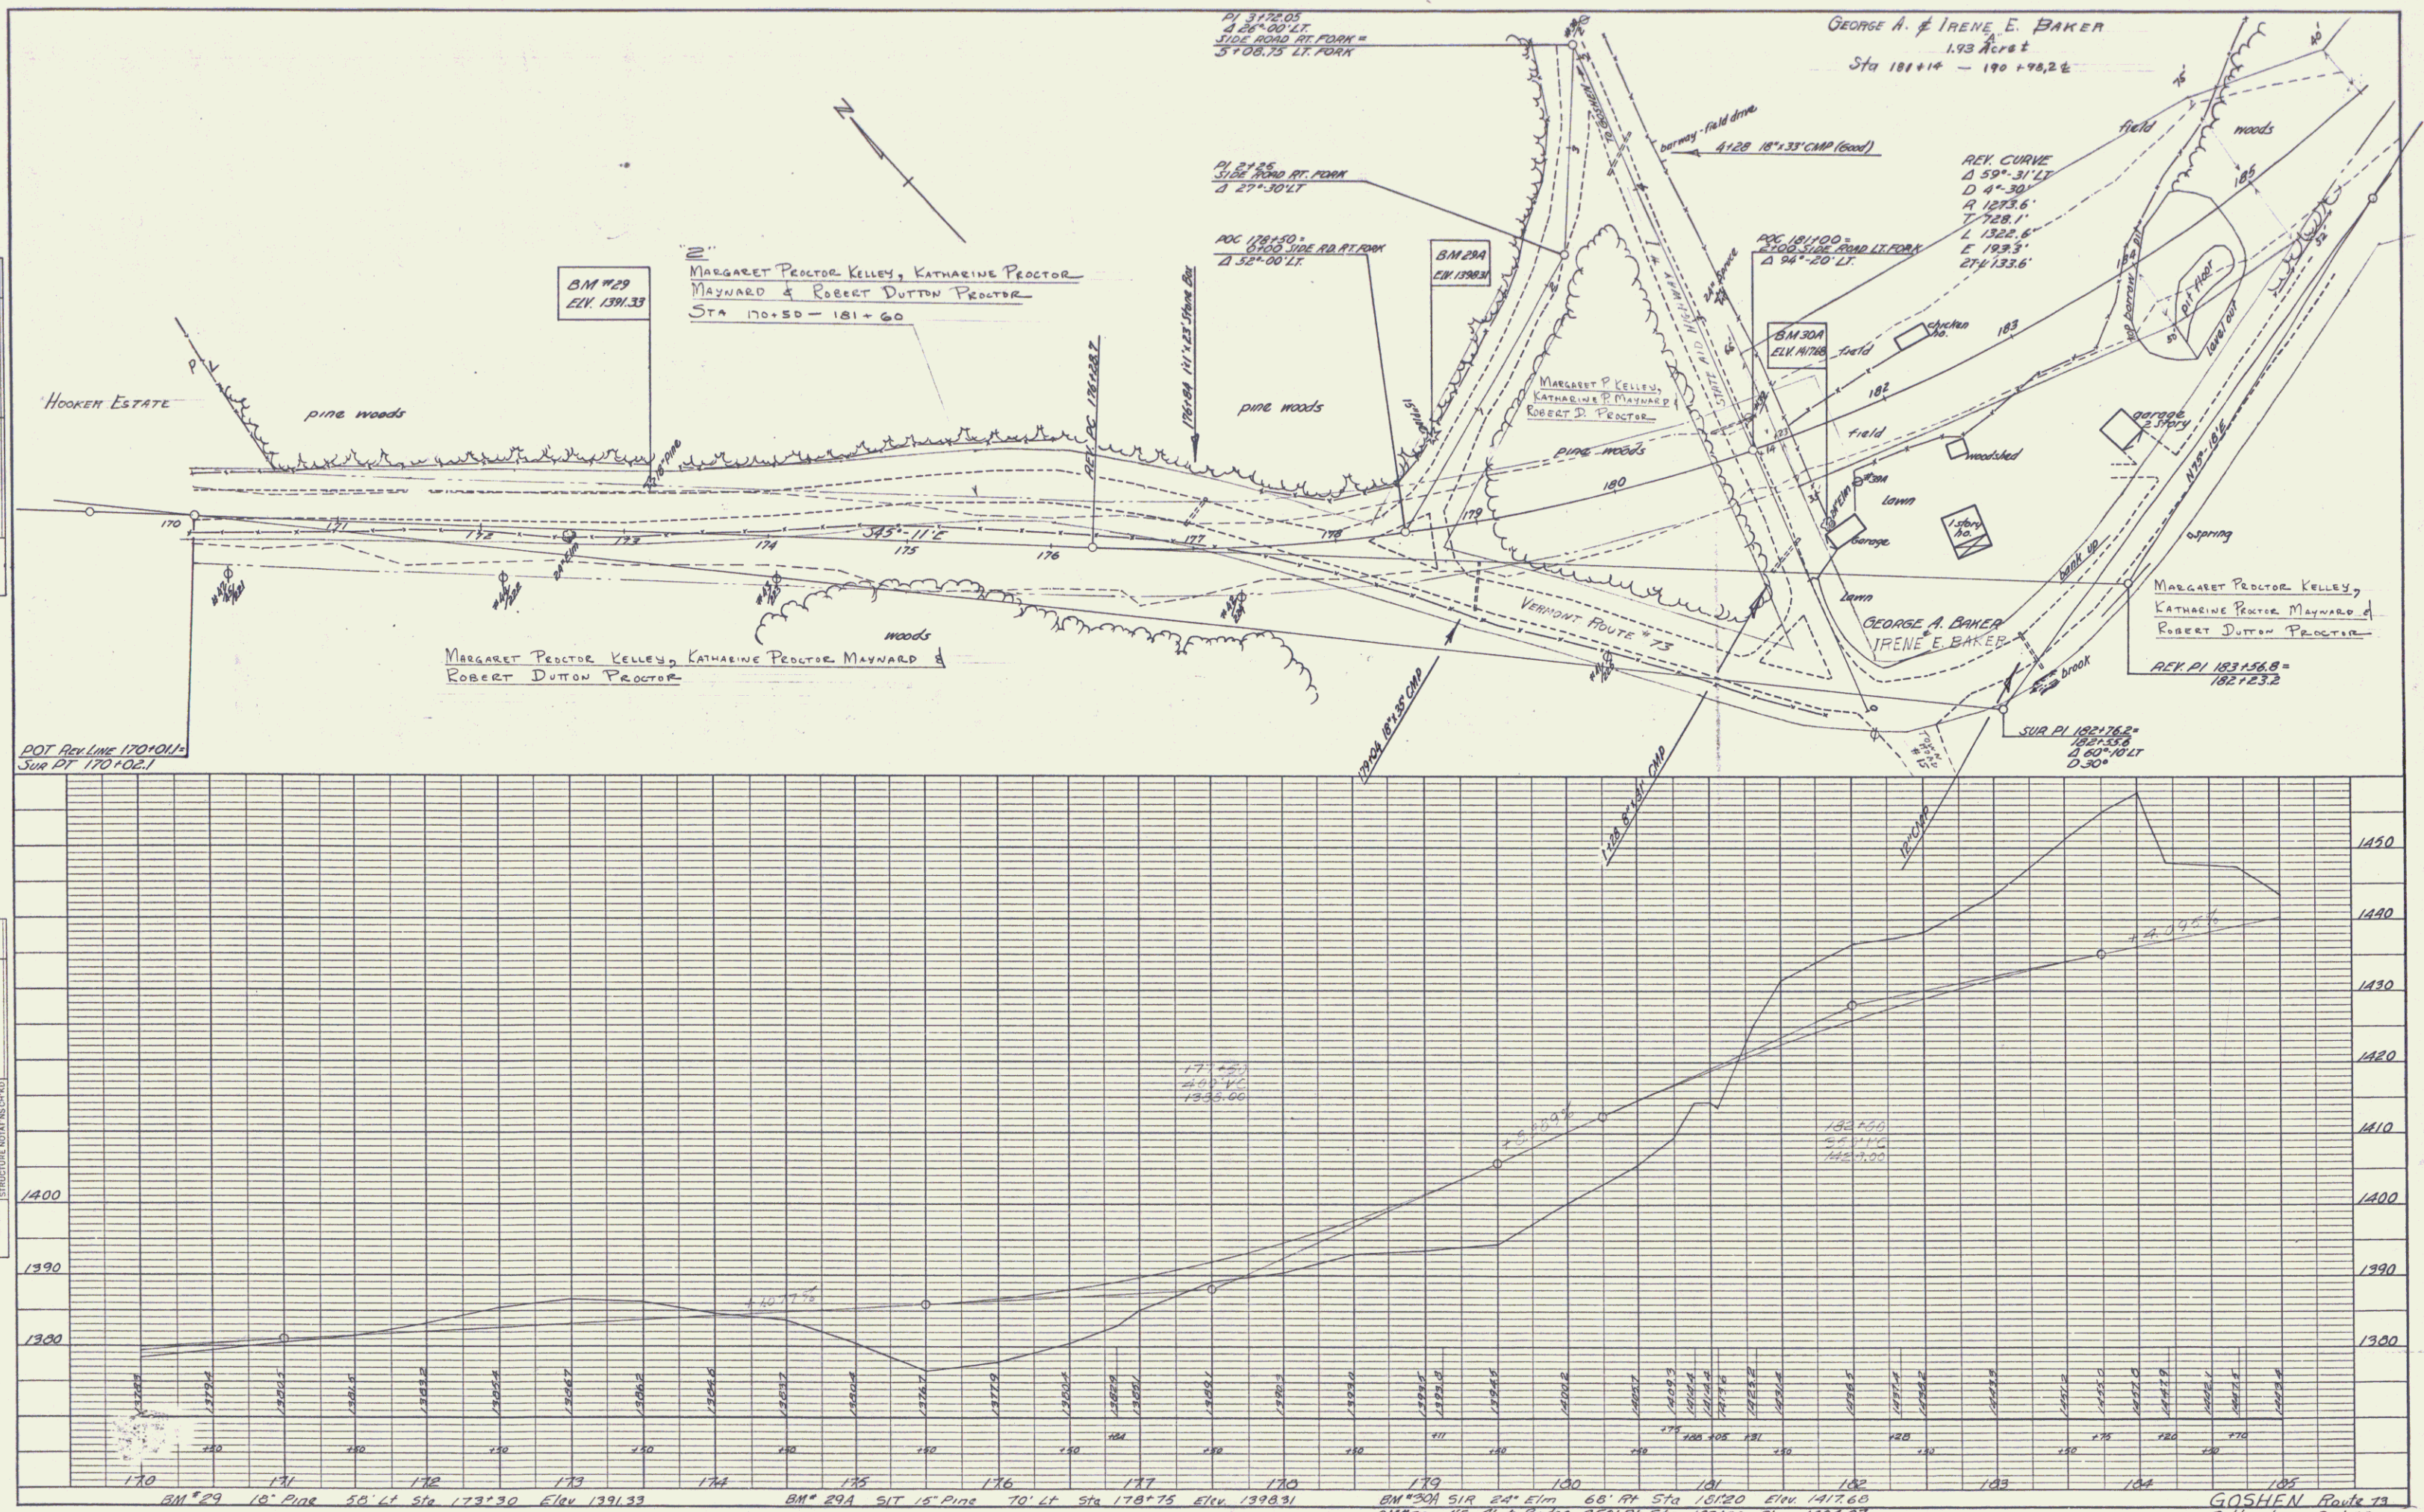

PLAN	SURVEYED	BY	DATE
	NOTED		
NOTE BOOK	CHECKED		
	BY		
NO.			

PROFILE	SURVEYED	BY	DATE
	NOTED		
NOTE BOOK	CHECKED		
	BY		
NO.			


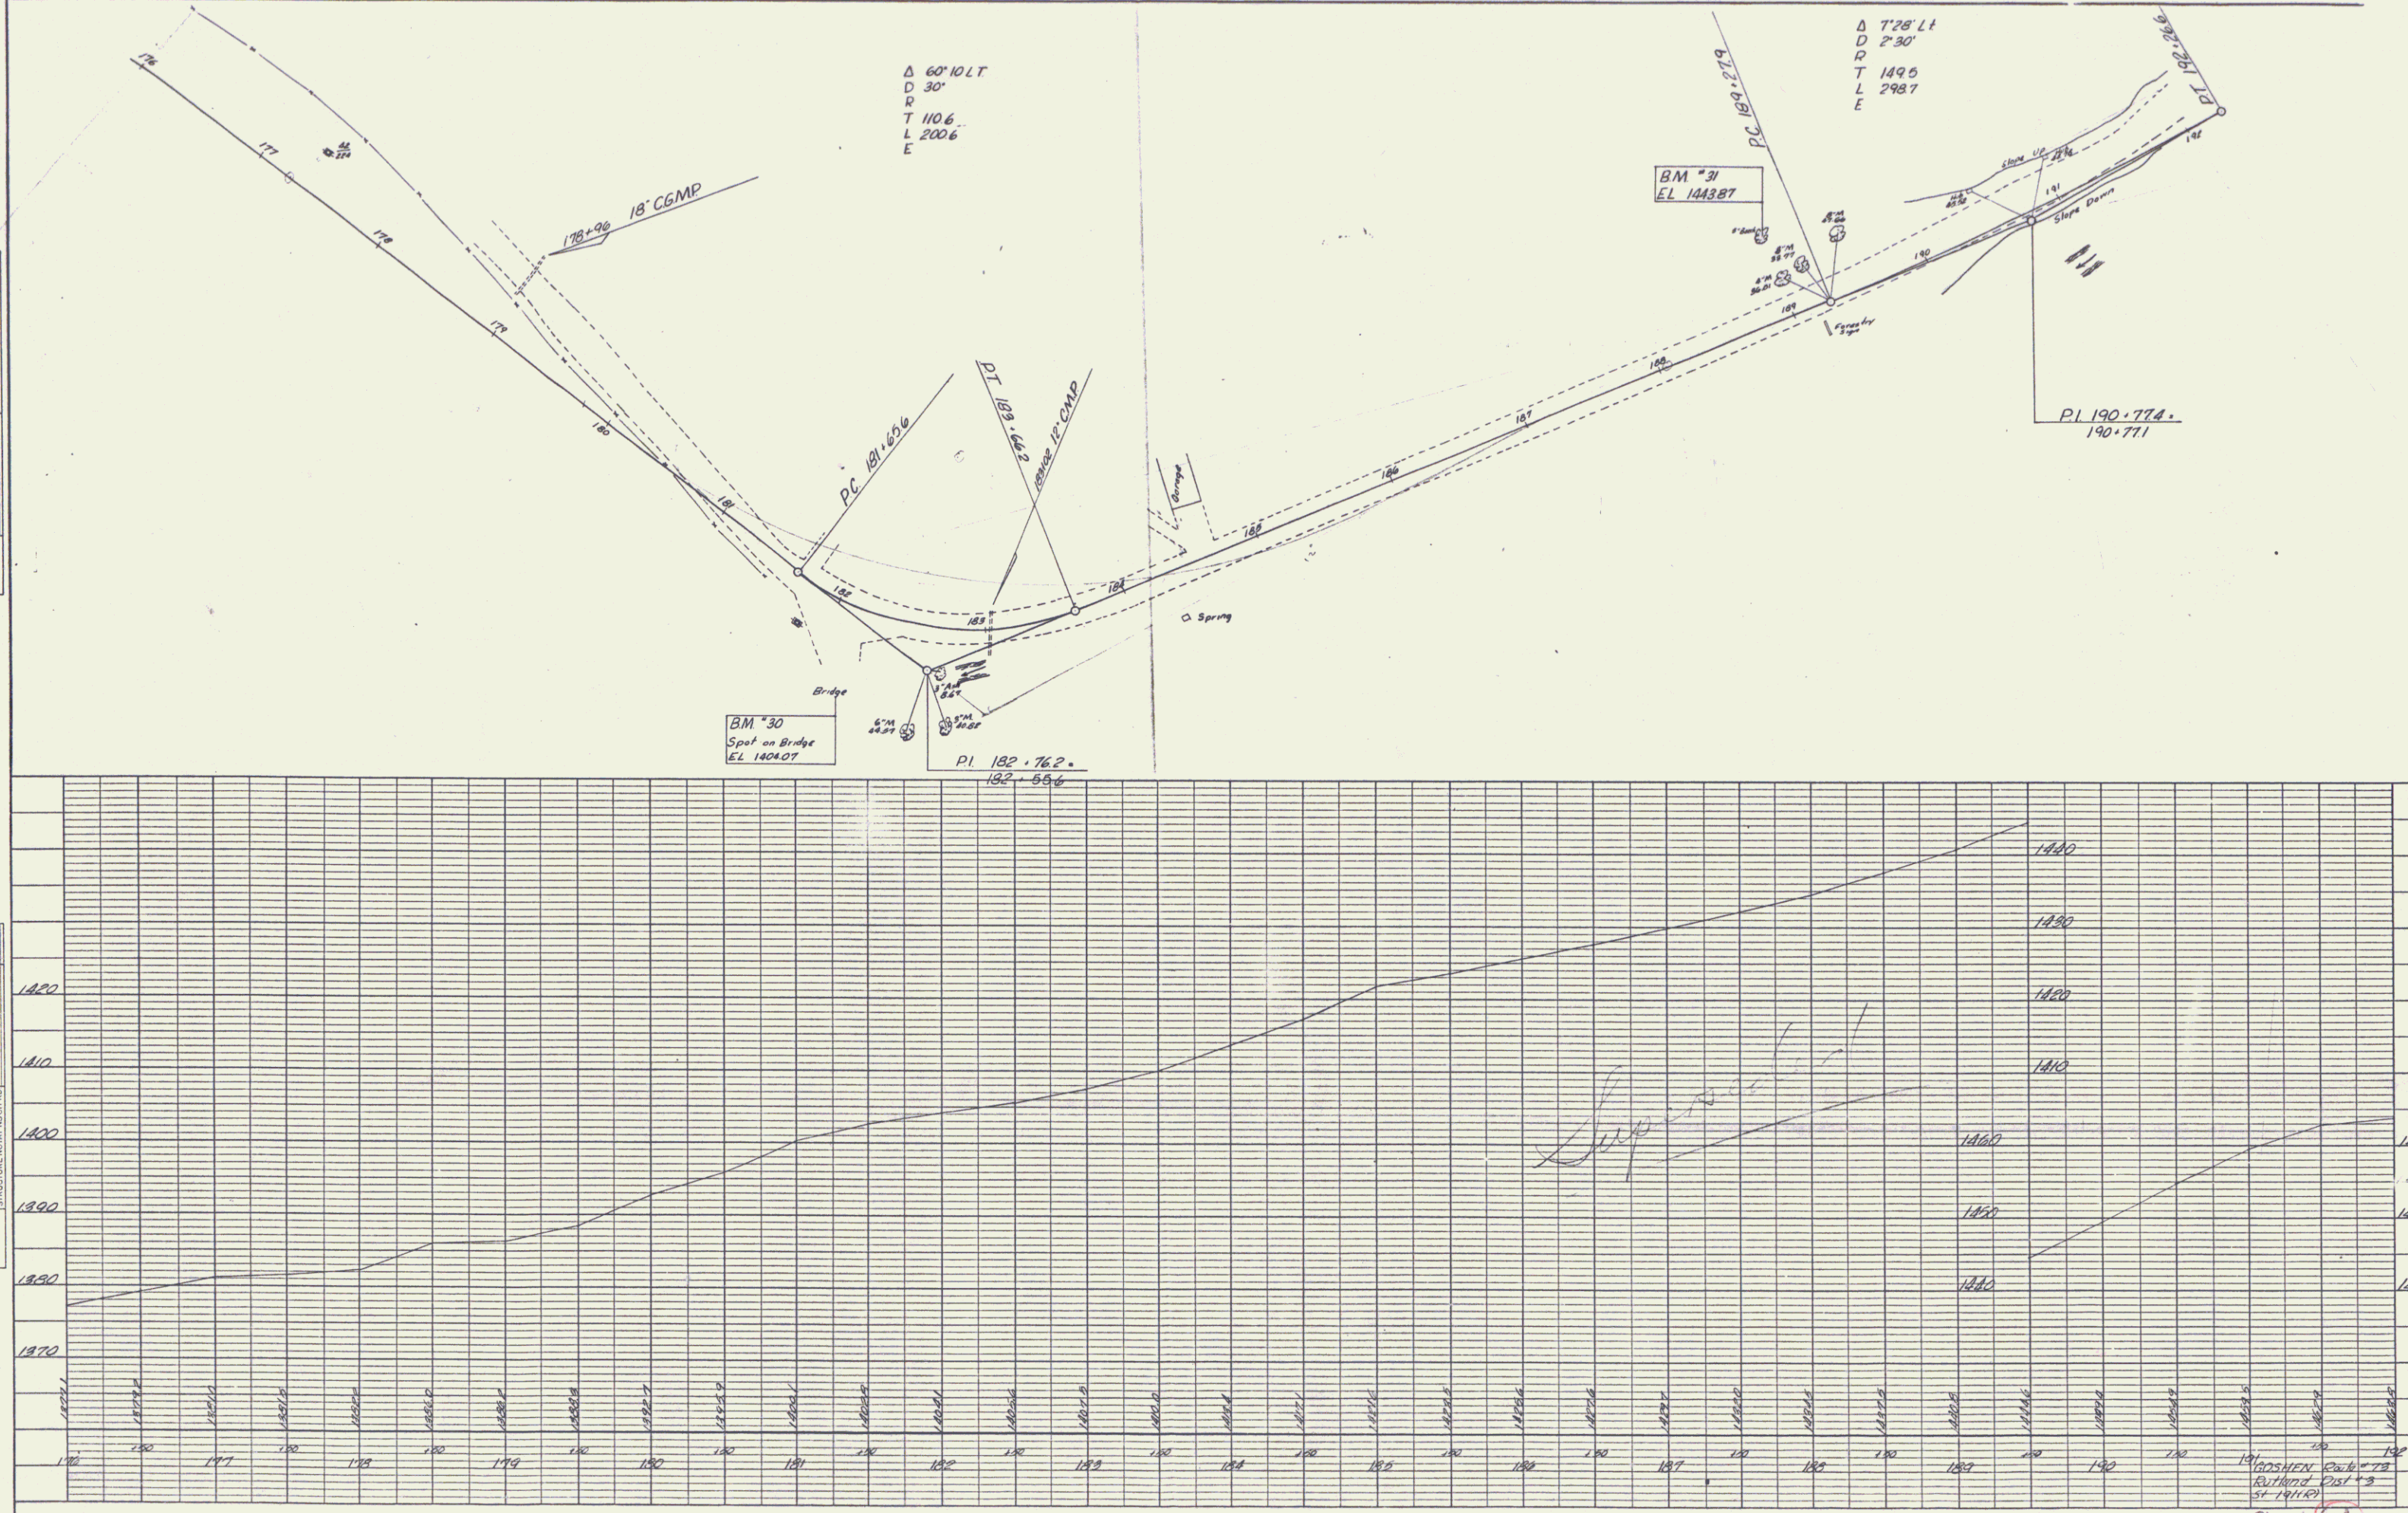


PLATE 1. PLAN. PROFILE. O.P.R. & E. STANDARD
KEUFFEL & ESSER CO., NEW YORK.
K & E CO. NO. 345-1


191 GOSHEN PARK - 78
RUTLAND DIST - 3
ST. 1911-1912
Sheet 6A

PLAN	SURVEYED	DATE
	PLOTTED	BY
	CHECKED	
	RT. OF WAY CHECKED	
NO.		

PROFILE	SURVEYED	DATE
	PLOTTED	BY
	CHECKED	
	RT. OF WAY CHECKED	
NO.		

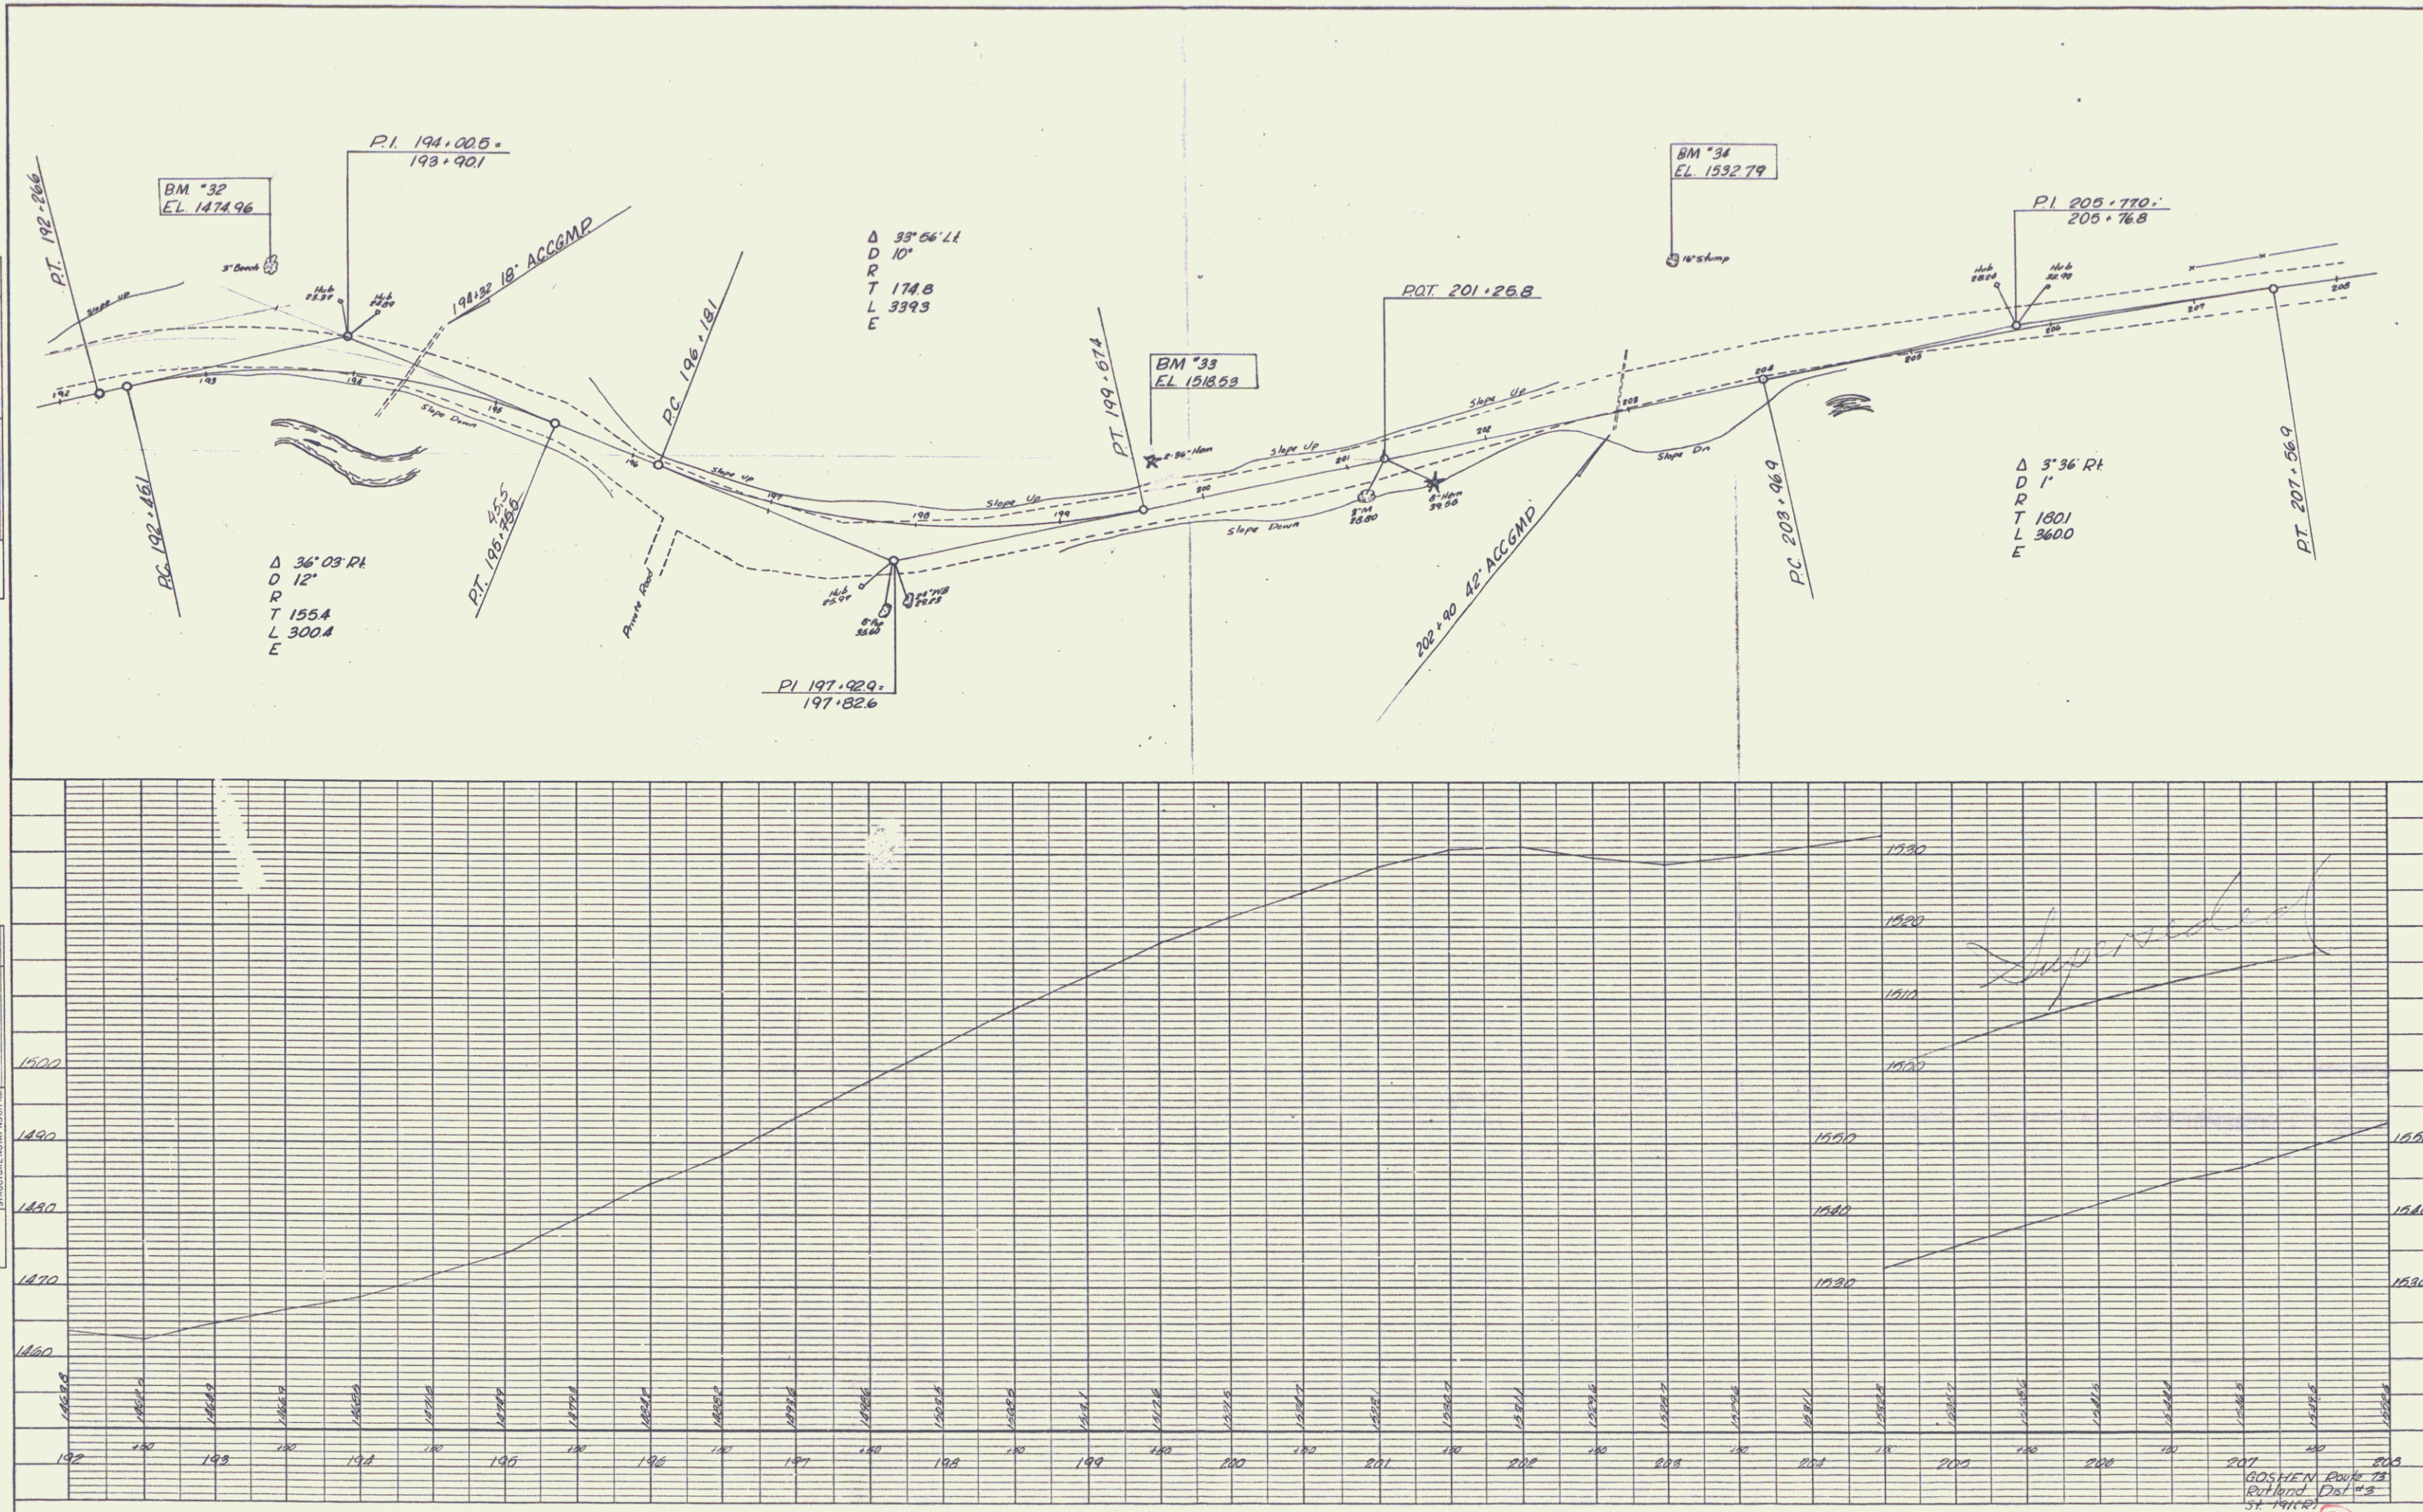

PROFILE		RY	DATE
NOTE BOOK	SURVEYED	WM	10-57
NO.	PLOTTED		
	GRADES CHECKED		
	R. N.1 NOTED		
	STRUCTURE MOUNTING CANVUS		

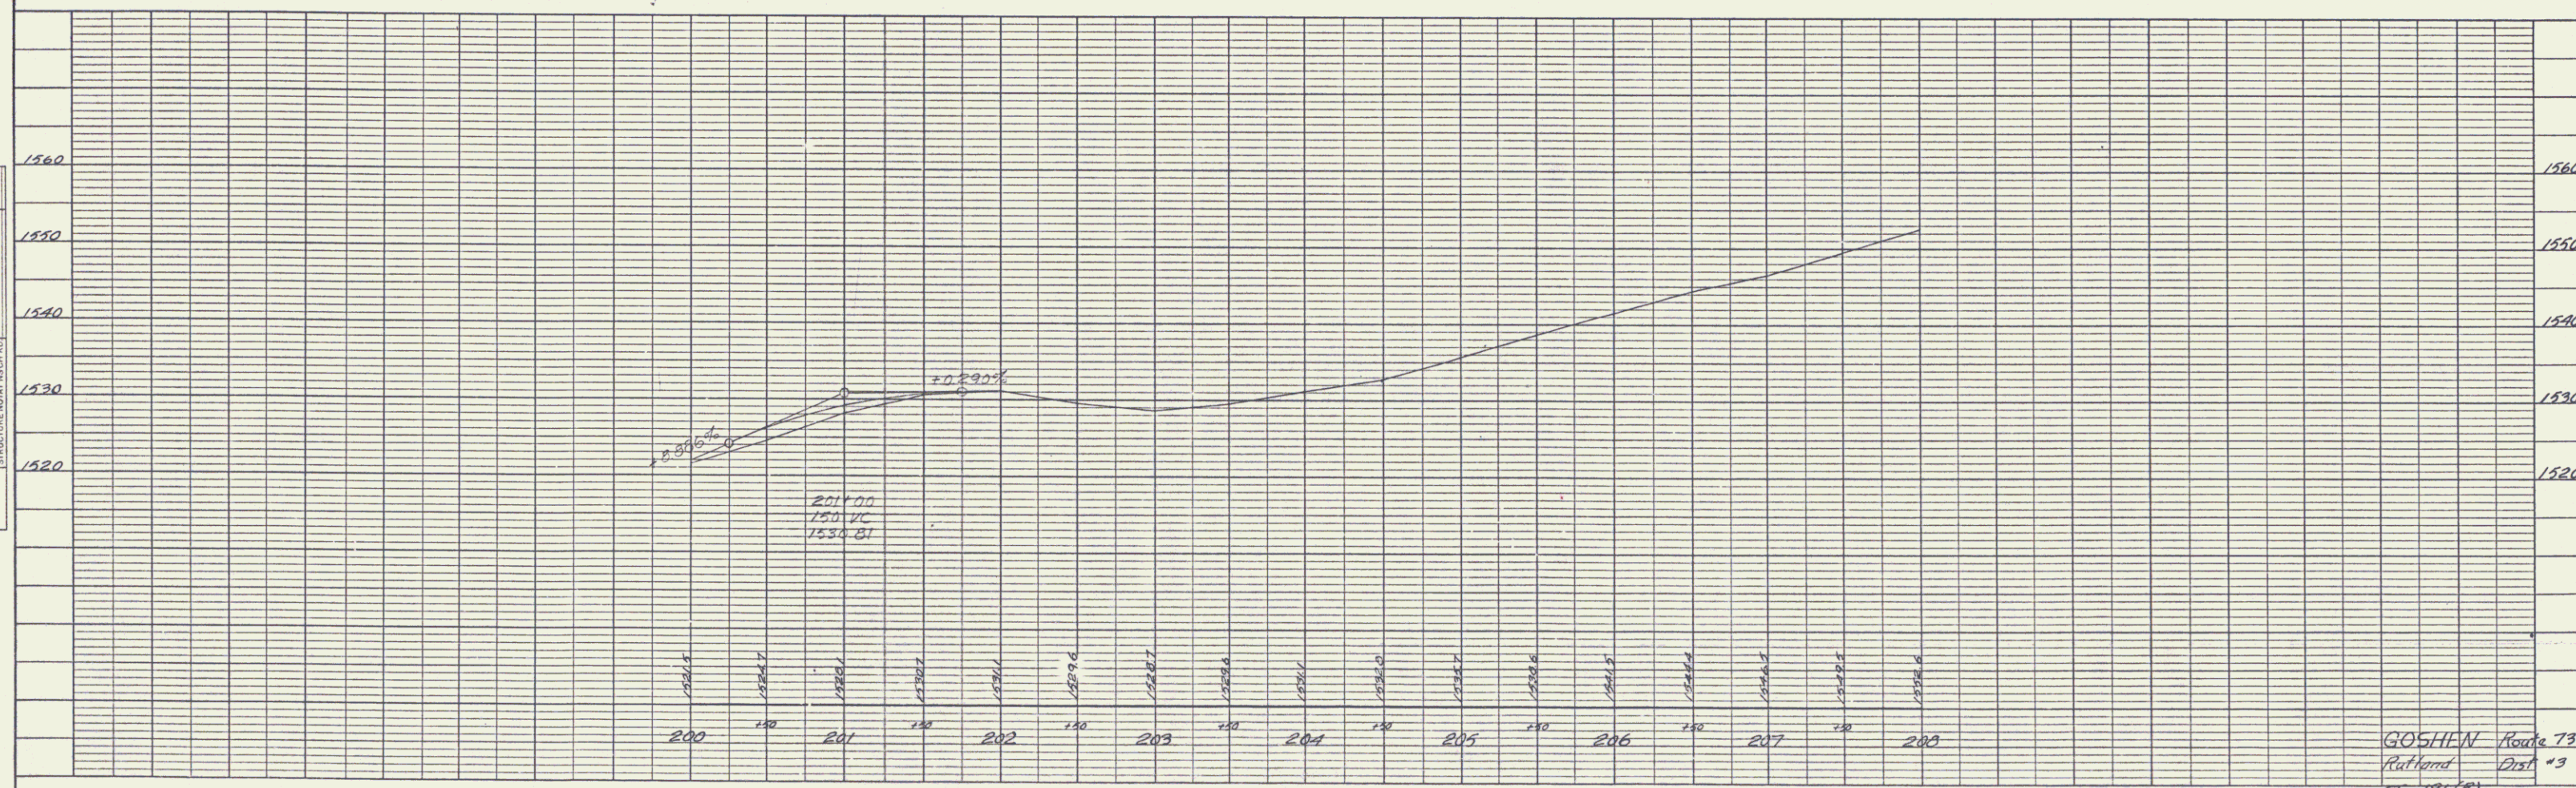


GOSHEN	Route 73
Rutland	Dist #3
St. 191 (R)	

Sheet 8

PLAN	DESIGNED	BY	DATE
	PLANNED	CHECKED	
NOTED	BY	DATE	

PROFILE	DESIGNED	BY	DATE
	PLANNED	CHECKED	
NOTED	BY	DATE	

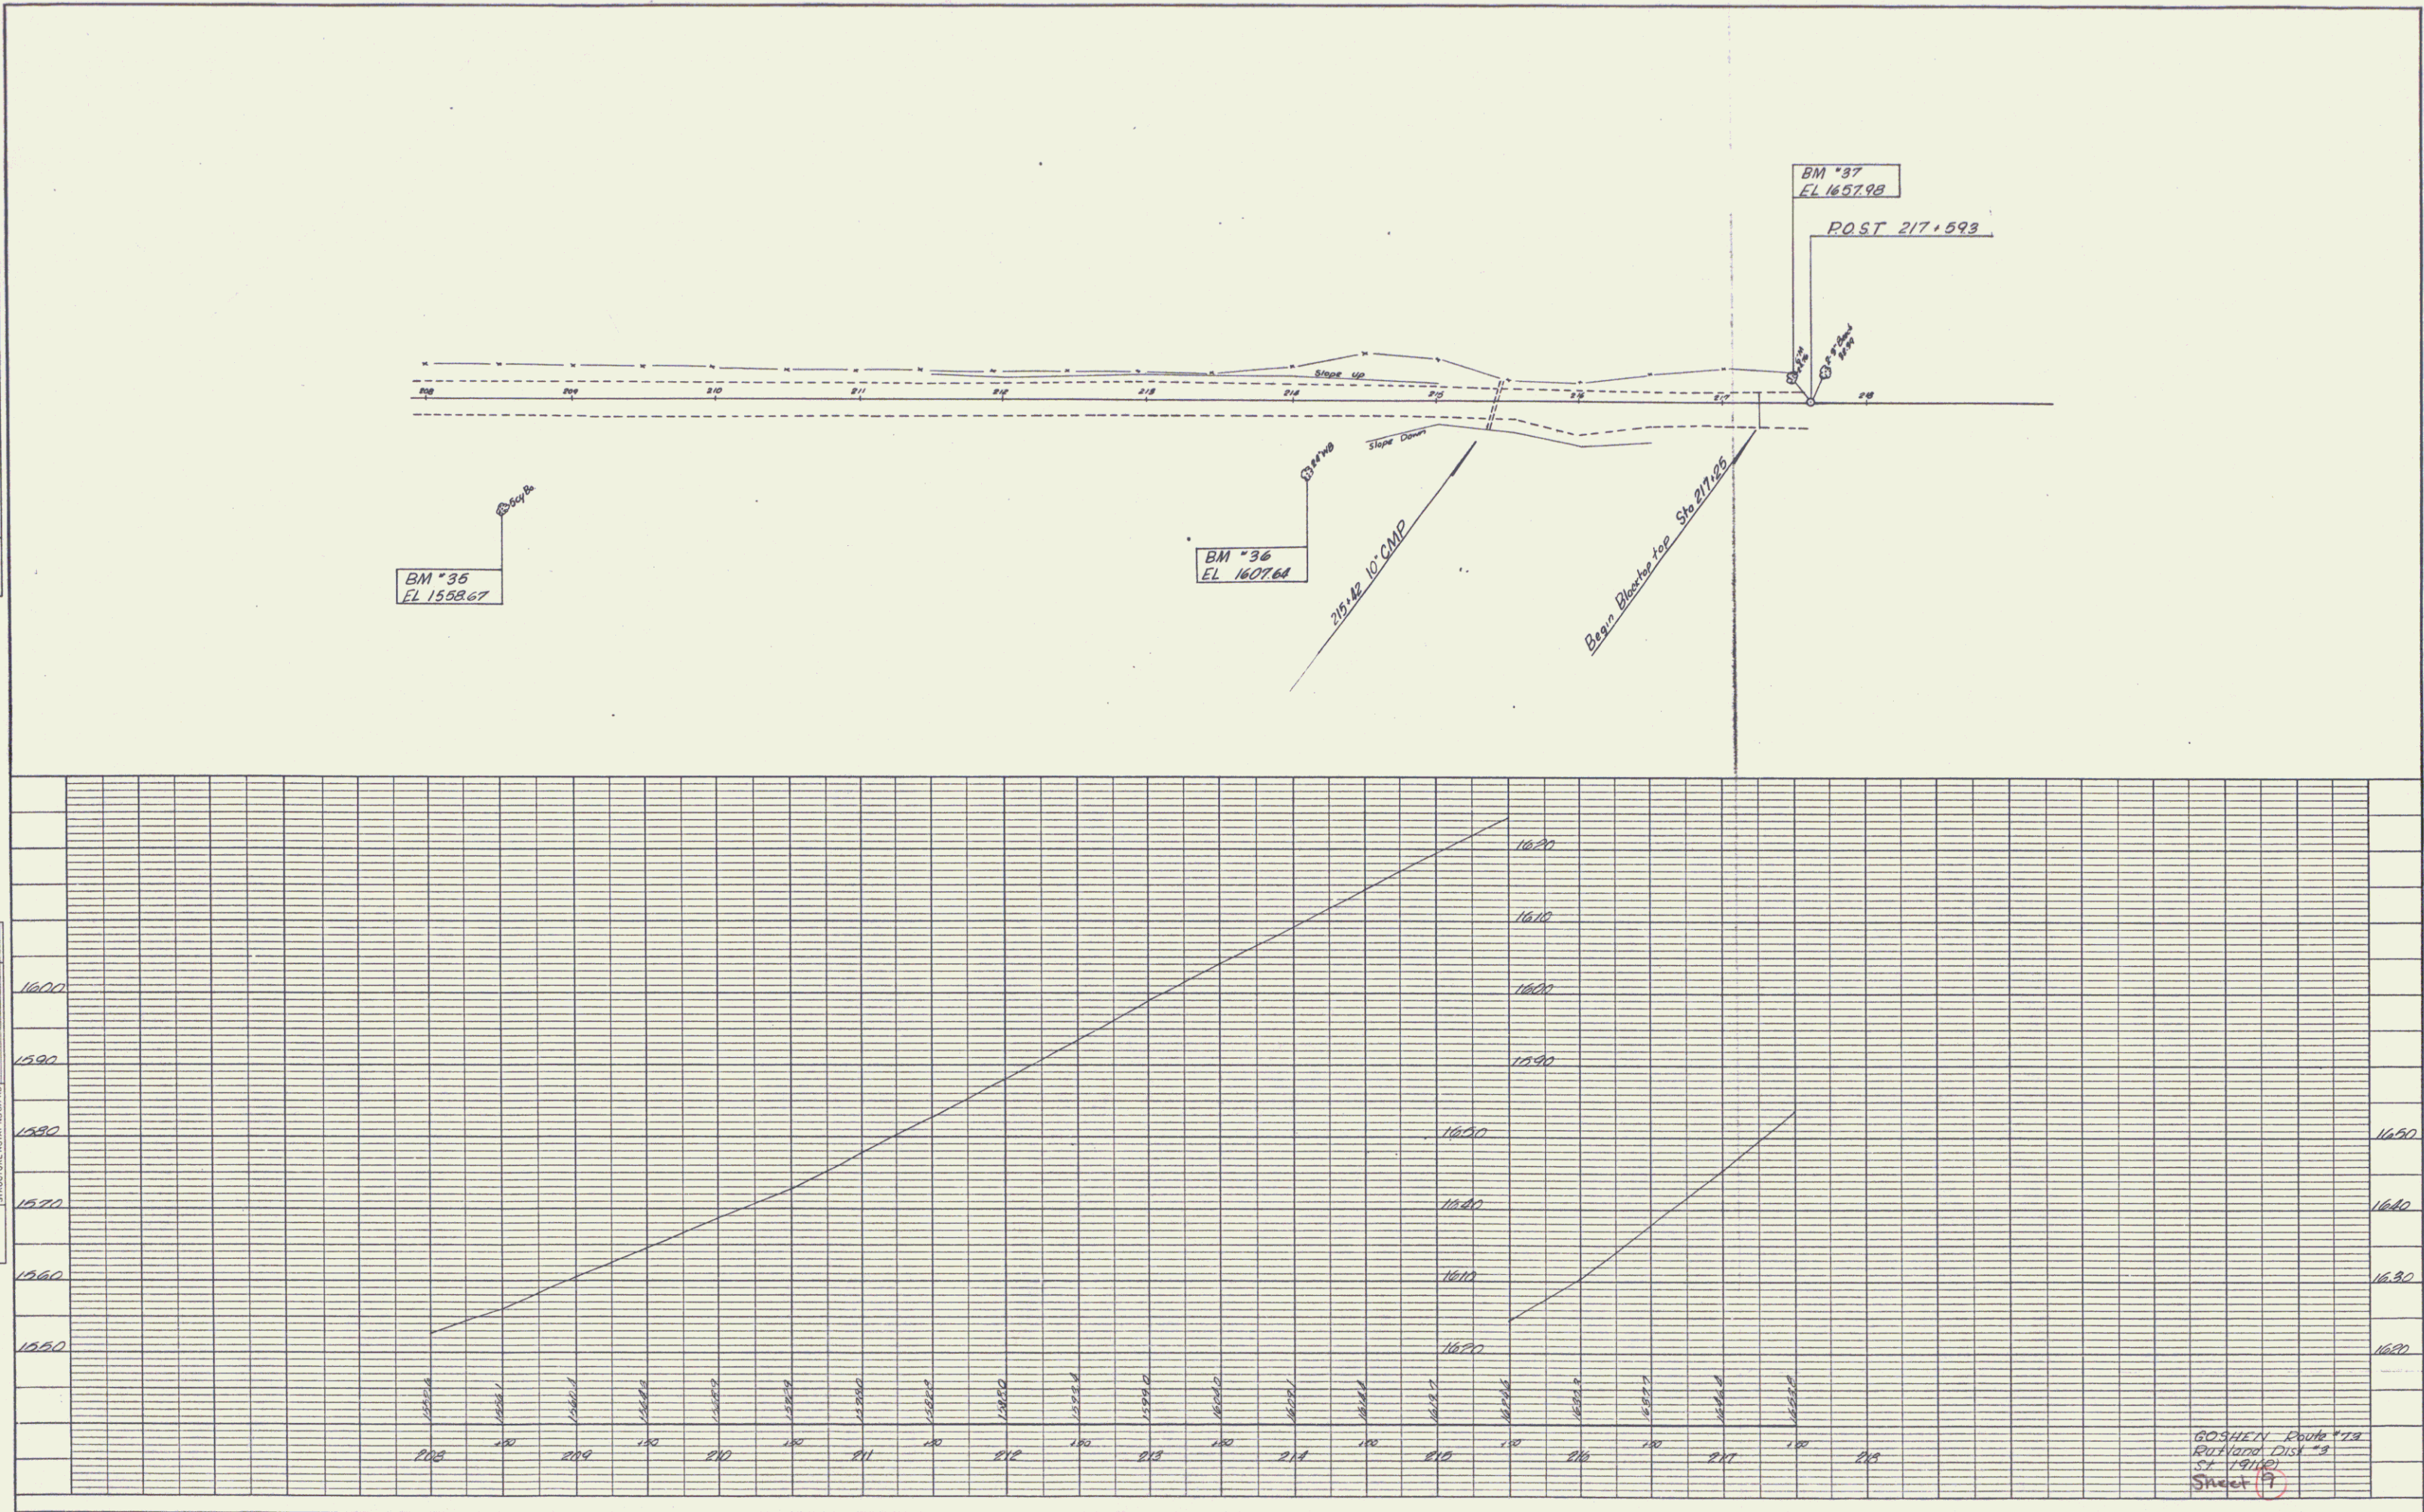

GOSHEN Route 128
Rt 128 Dist 1.3
Sta 191.62
Sheet 19