

INDEX OF SHEETS

SHEET NO.	TITLE PAGE
1	TITLE PAGE
2	TYPICAL CROSS SECTION OF IMPROVEMENT (DOUBLE TACK COAT OF REFINED TAR)
3	BANKING TABLE, ROADWAY STANDARD RS 56-1 WITH PESTONE SEAL, ITEM 312-A
4	QUANTITY SHEET (ITEM 8 DRAINAGE)
5	QUANTITY SHEET (SUMMARY)
6-8	EARTHWORK SHEETS
9	ROADWAY STANDARD RS 56-3
10	" " RS 56-4
11	" " RS 56-5
12	" " RS 56-6
13	" " RS 56-7
14	" " RS 56-8
15-24	PLAN AND PROFILE SHEETS
24-A	7'-0" X 5'-1" CORR. GALV. METAL PIPE ARCH
25-74	CROSS SECTIONS


Project Name & Number	Type	Assessment Area
Rochester ST 191 S	Double Tack Coat	28,324 sq. yds.
Record Plans		
Materials		
Subbase of Gravel - Stoddards & Martin, Inc. Barre, Vt. Filled Tar - Barrett Division, Malden, Mass.		
Crushed Gravel - Lyon A. Co. (or. pro. 1-1)		
Pestone for Seal, Colonial Sand & Gravel Co. Portland, Me. Portland Cement Concrete Pipe, 14" Conc. Pipe Co. Windsor, Vt.		
Sand, Colonial Sand & Gravel Co. Sharon, Vt.		
Contractor - Willard B. Martin		
Resident Engr - C. B. Foster		
Inspector - Earl Crutchfield		
Record Plans - C. B. Foster		
Contract Dated - Aug 2, 1956		
Contract Started - Aug 14, 1956		
Contract Completed - Nov 4, 1956		
Contract Accepted - Nov 1, 1957		

STATE OF VERMONT DEPARTMENT OF HIGHWAYS PROPOSED IMPROVEMENT

TOWN OF ROCHESTER COUNTY OF WINDSOR BRANDON - ROCHESTER ROAD VERMONT ROUTE 73

BEGINNING AT A POINT APPROXIMATELY 4.067 MILES
SOUTHEASTERLY OF THE CHITTENDEN - ROCHESTER TOWN
LINE AND EXTENDING NORTHEASTERLY
2.414 MILES


LENGTH OF PROJECT = 12,746.40 FEET = 2.414 MILES

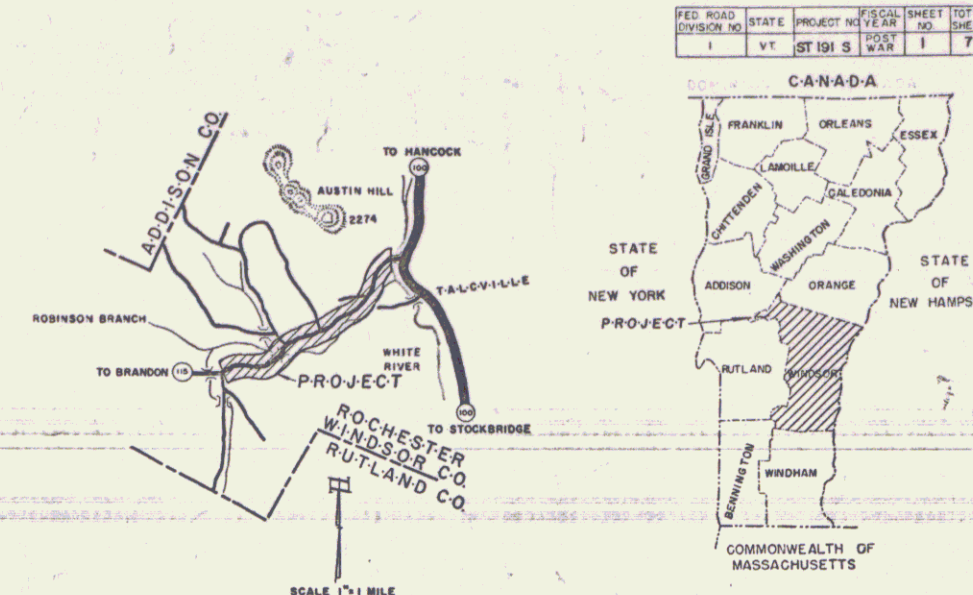

RIGHT-OF-WAY DIVISION
TOWN FILE
PERPETUAL

Project of 1473
[To Be Returned To R.O.W. Division]

PROJECT: ST 191 S
PIN: OOR 423
DATE: 6/7/69/1956

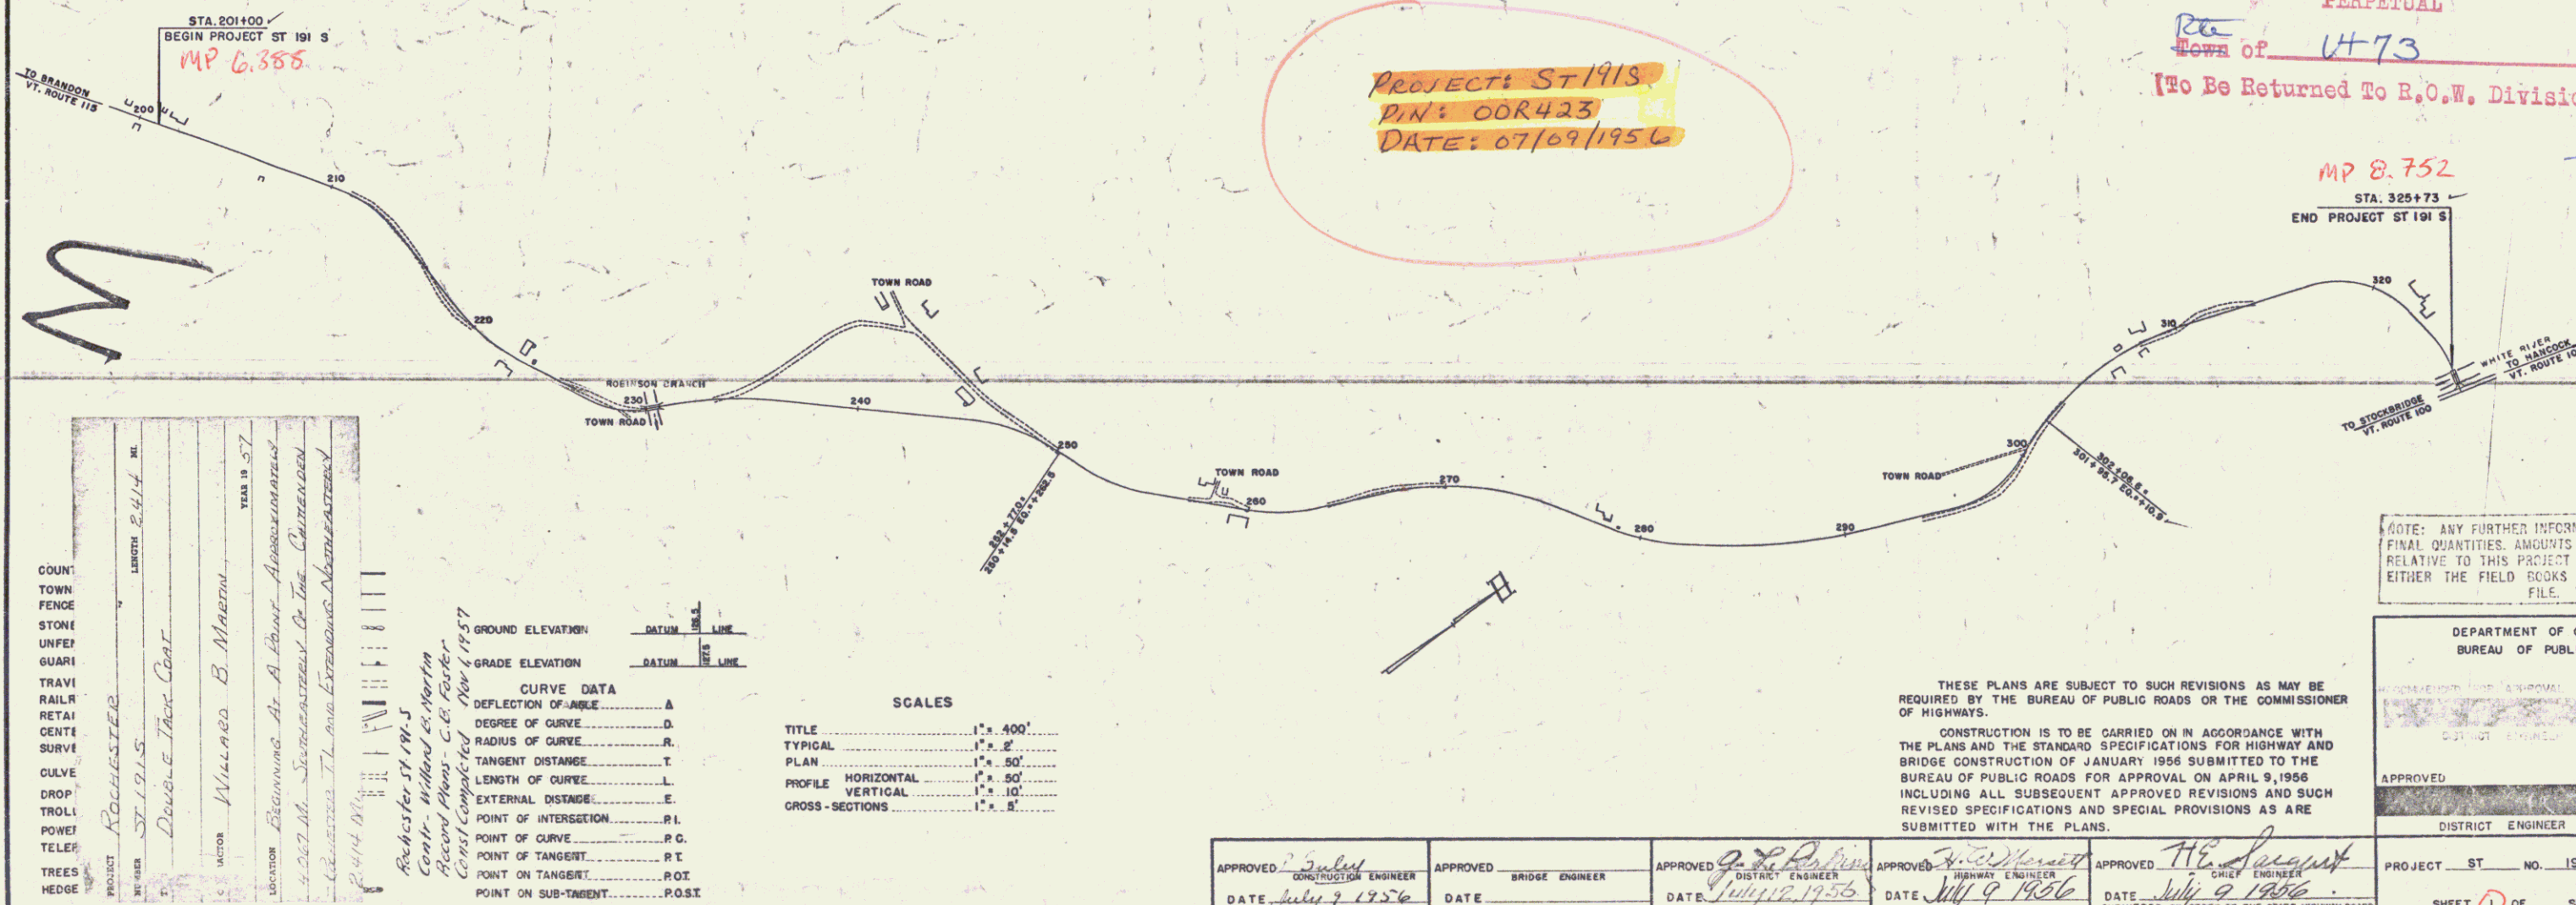

COUNTY	ROCHESTER
TOWN	ST 191 S
FENCE	DOUBLE TACK COAT
STONE	WILLARD B. MARTIN
UNFENCE	WILLARD B. MARTIN
GUARD	WILLARD B. MARTIN
TRAIL	WILLARD B. MARTIN
RAIL	WILLARD B. MARTIN
RETAI	WILLARD B. MARTIN
CENTI	WILLARD B. MARTIN
SURVI	WILLARD B. MARTIN
CULVE	WILLARD B. MARTIN
DROP	WILLARD B. MARTIN
TROLI	WILLARD B. MARTIN
POWER	WILLARD B. MARTIN
TELE	WILLARD B. MARTIN
TREES	WILLARD B. MARTIN
HEDGE	WILLARD B. MARTIN

GROUND ELEVATION	DATUM	LINE
GRADE ELEVATION	DATUM	LINE
CURVE DATA		
DEFLECTION OF ANGLE	D	
DEGREE OF CURVE	D	
RADIUS OF CURVE	R	
TANGENT DISTANCE	T	
LENGTH OF CURVE	L	
EXTERNAL DISTANCE	E	
POINT OF INTERSECTION	P.I.	
POINT OF CURVE	P.C.	
POINT OF TANGENT	P.T.	
POINT ON TANGENT	P.O.T.	
POINT ON SUB-TANGENT	P.O.S.T.	

TITLE	SCALE
TYPICAL	1" = 400'
PLAN	1" = 50'
PROFILE	1" = 50'
CROSS-SECTIONS	1" = 10'

THESE PLANS ARE SUBJECT TO SUCH REVISIONS AS MAY BE
REQUIRED BY THE BUREAU OF PUBLIC ROADS OR THE COMMISSIONER
OF HIGHWAYS.

CONSTRUCTION IS TO BE CARRIED ON IN ACCORDANCE WITH
THE PLANS AND THE STANDARD SPECIFICATIONS FOR HIGHWAY AND
BRIDGE CONSTRUCTION OF JANUARY 1956 SUBMITTED TO THE
BUREAU OF PUBLIC ROADS FOR APPROVAL ON APRIL 9, 1956
INCLUDING ALL SUBSEQUENT APPROVED REVISIONS AND SUCH
REVISED SPECIFICATIONS AND SPECIAL PROVISIONS AS ARE
SUBMITTED WITH THE PLANS.

APPROVED	CONSTRUCTION ENGINEER	APPROVED	BRIDGE ENGINEER	APPROVED	DISTRICT ENGINEER	APPROVED	HIGHWAY ENGINEER	APPROVED	CHIEF ENGINEER	PROJECT	NO.	191 S
DATE	July 7, 1956	DATE	July 12, 1956	DATE	July 9, 1956	DATE	July 9, 1956	DATE	July 9, 1956	SHEET	1	OF SHEETS 74

NOTE: ANY FURTHER INFORMATION CONCERNING
FINAL QUANTITIES, AMOUNTS OR OTHER DETAILS
RELATIVE TO THIS PROJECT MAY BE FOUND IN
EITHER THE FIELD BOOKS OR THE ESTIMATE
FILE.

DEPARTMENT OF COMMERCE
BUREAU OF PUBLIC ROADS


APPROVED

DISTRICT ENGINEER

PROJECT NO. 191 S

PLAN	DATE	BY	CHKD
1/1/53	1/1/53	WJ	WJ
NOTE: ROAD ALIGNED CHANGED			
NO. 1			
NO. 2			
NO. 3			
NO. 100			

PROFILE	DATE	BY	CHKD
1/1/53	1/1/53	WJ	WJ
NOTE: ROAD ALIGNED CHANGED			
NO. 1			
NO. 2			
NO. 3			
NO. 100			

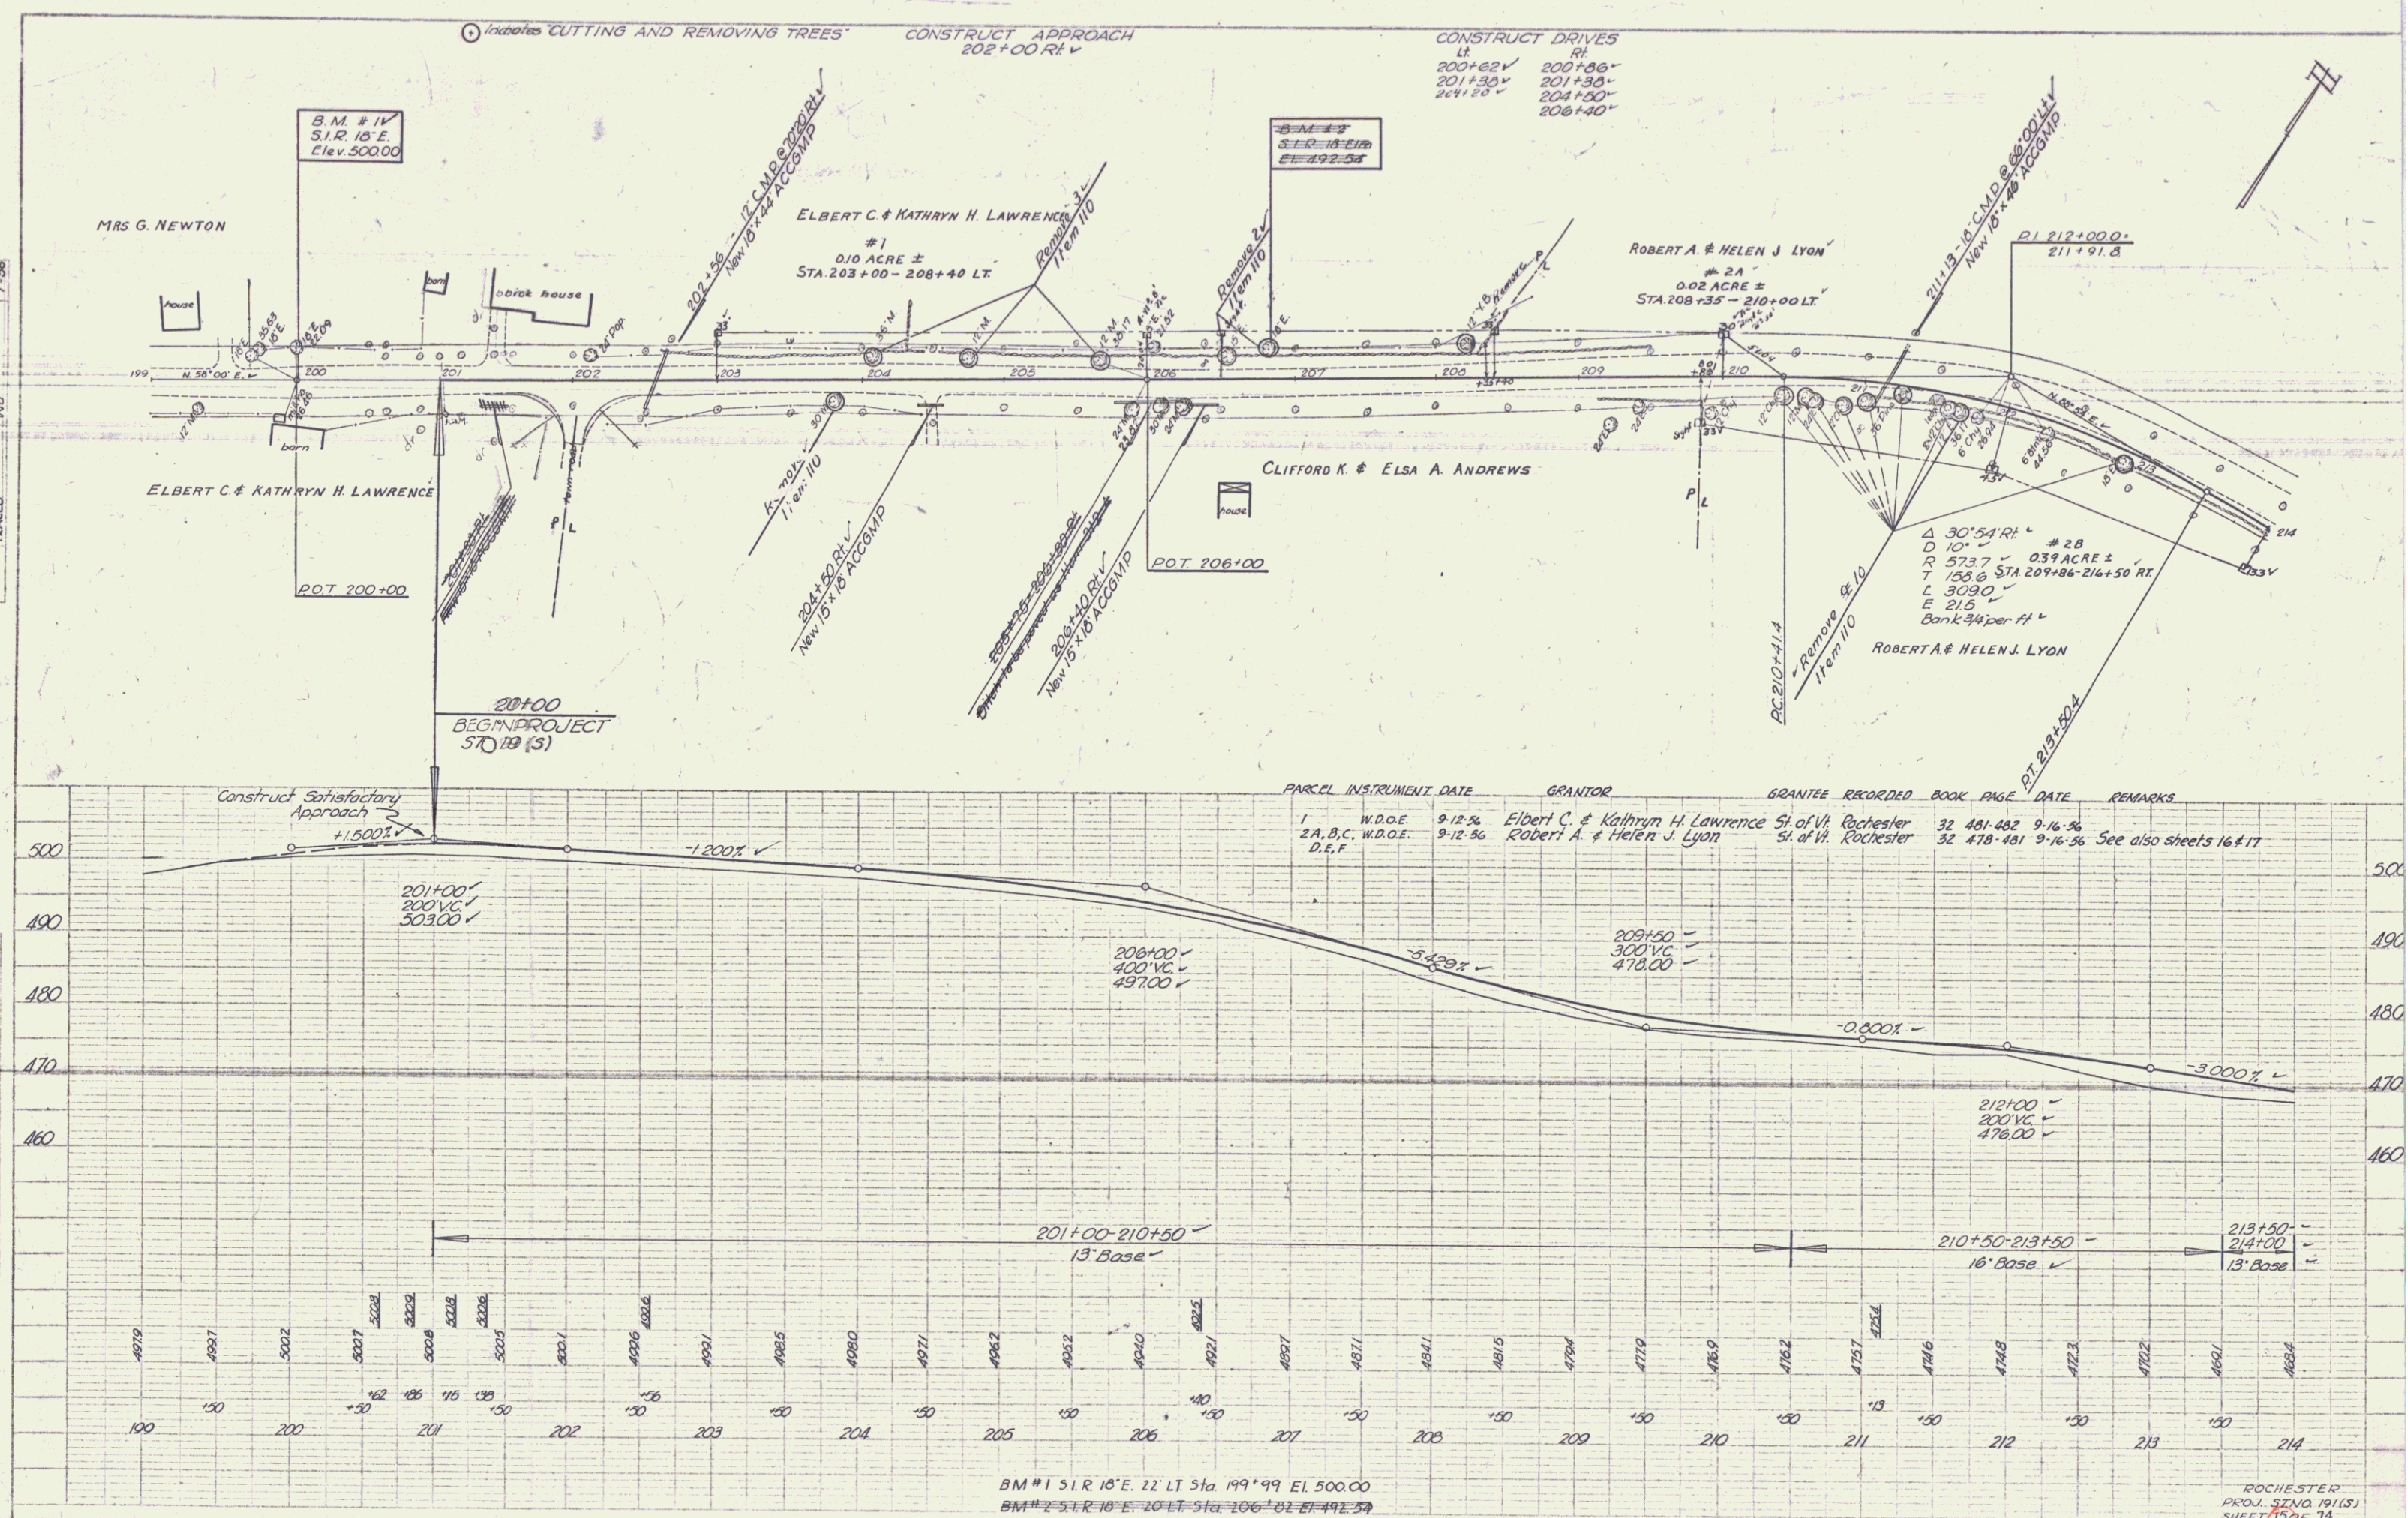


BM #1 S. 1 R. 10 E. 22 LT 5th 199*99 El 500.00
 BM #2 S. 1 R. 10 E. 20 LT 5th 106*81 El 492.54

ROCHESTER
 PROJ. SENO 191(S)
 SHEET 15 OF 14

PLAN
 1-55
 1-56
 1-57
 1-100

PROFILE
 1-55
 1-56
 1-57
 1-100

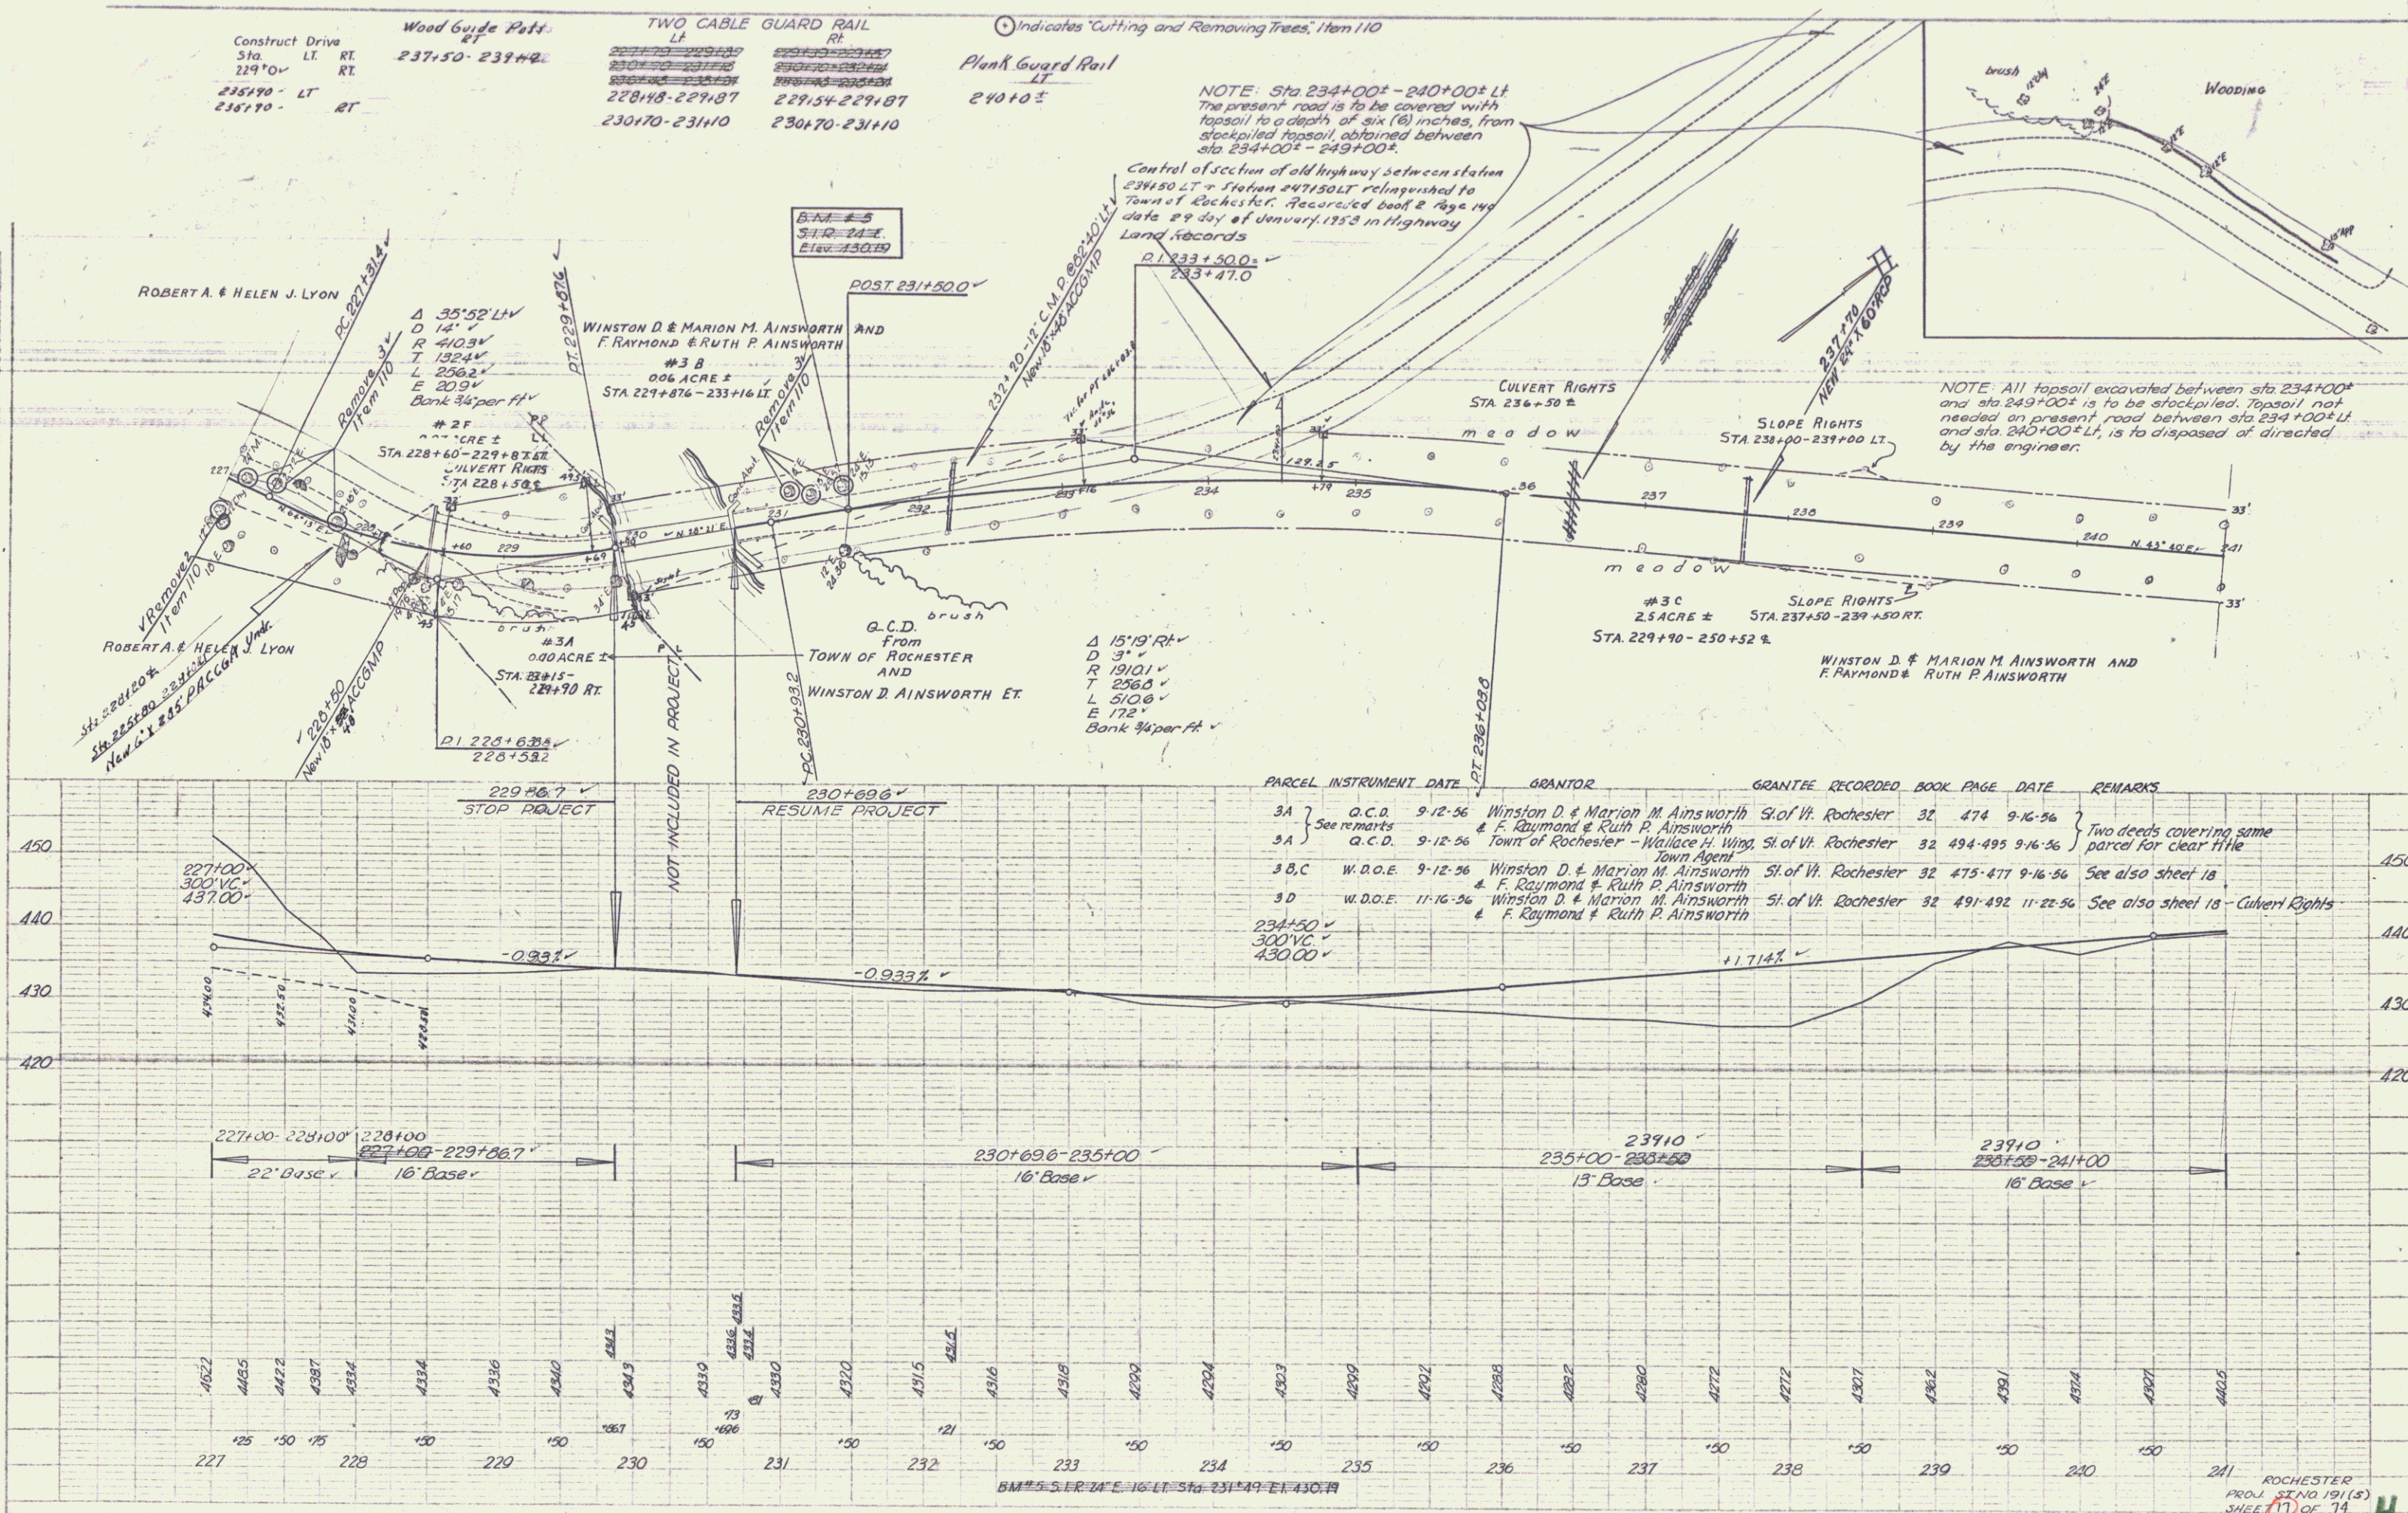

PLAN	DATE	BY	CHECKED
DESIGNED	1/26		
DRAWN			
NOTED			
APPROVED			
NO.			

PROFILE	DATE	BY	CHECKED
DESIGNED			
DRAWN			
NOTED			
APPROVED			
NO.			


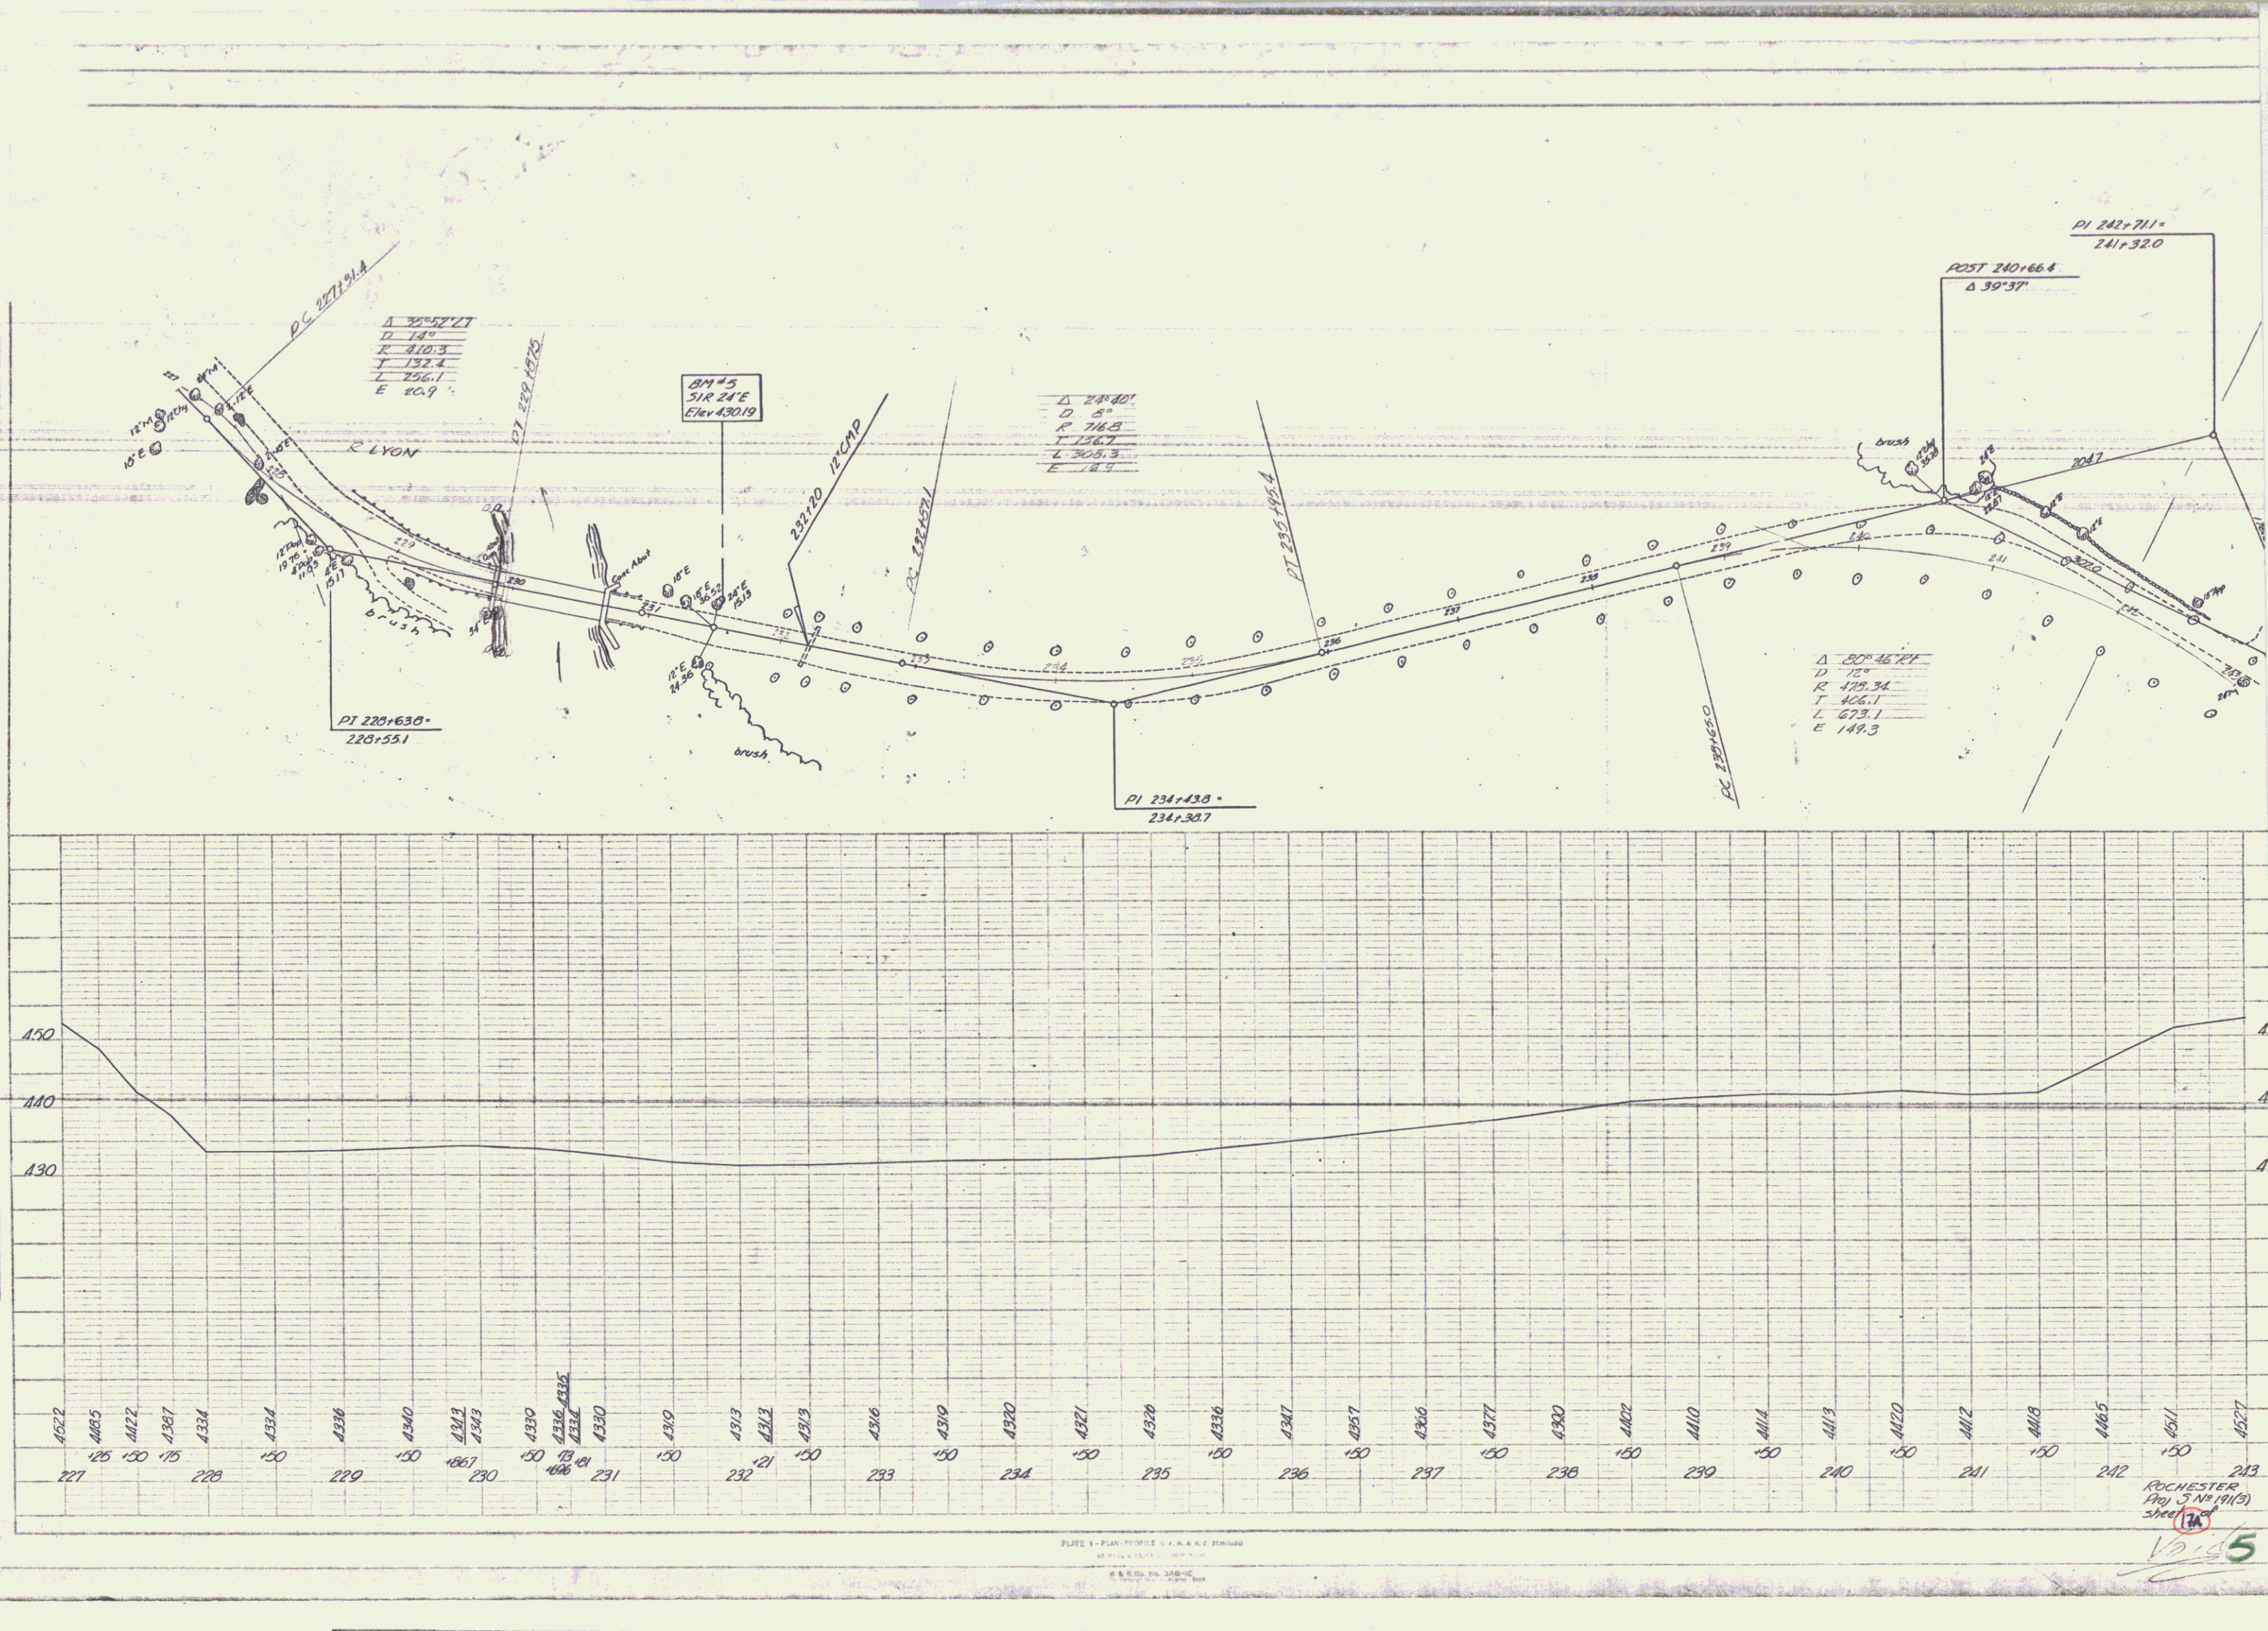




PLATE 1 - PLAN PROFILE & ELEVATION
 H. B. & S. CO. INC. ENGINEERS
 1000 N. 10TH ST. SPOKANE, IDAHO

ROCHESTER
 Proj. J. N. 191(3)
 Sheet 15
 10-55

PLAN
 DATE 11-28-56
 DRAWN BY J. A. GARDNER
 CHECKED BY J. A. GARDNER
 SCALE 1" = 40'


PROFILE
 DATE 11-28-56
 DRAWN BY J. A. GARDNER
 CHECKED BY J. A. GARDNER
 SCALE 1" = 40'

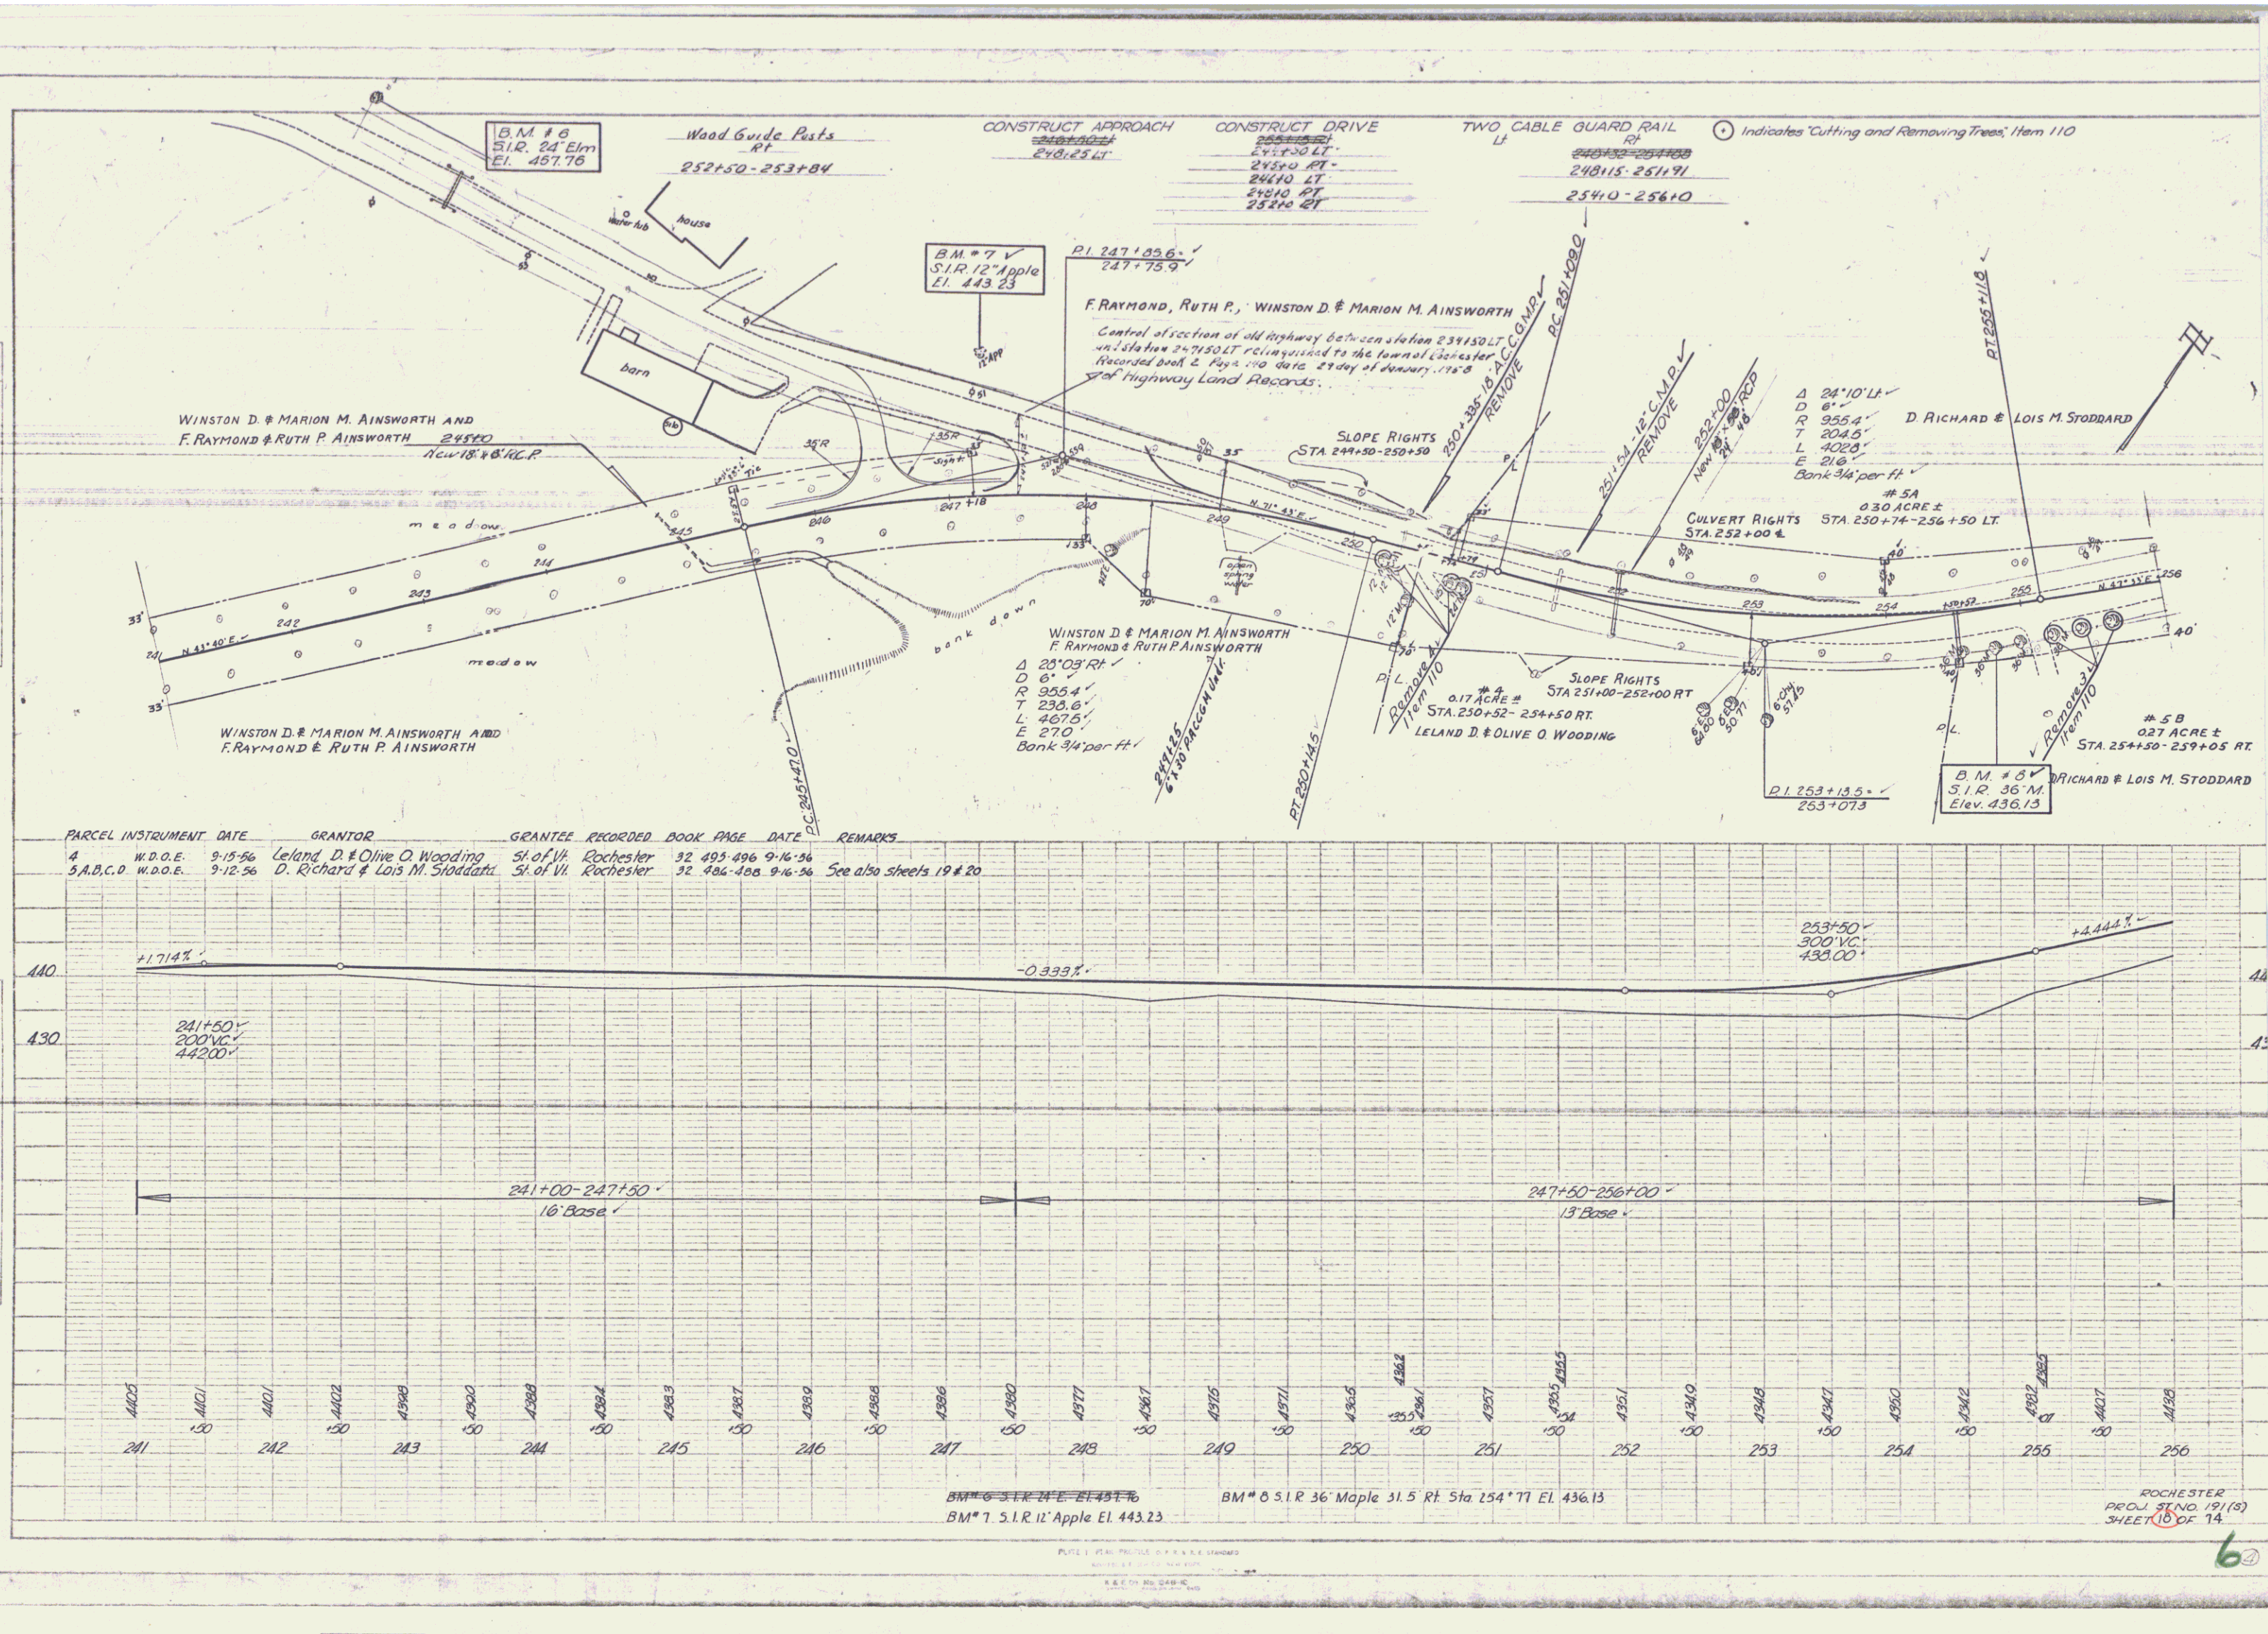

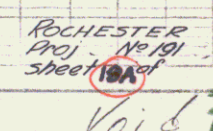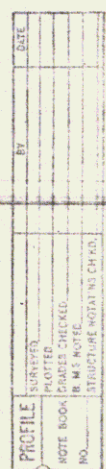



PLAN	DATE	1/56
DESIGNED BY	PAUL J. DOLAN	
CHECKED BY	LAURENCE	
IN CHARGE	LAURENCE	
NOTED BY	LAURENCE	
DATE	1/56	

PROFILE	DATE	1/56
DESIGNED BY	PAUL J. DOLAN	
CHECKED BY	LAURENCE	
IN CHARGE	LAURENCE	
NOTED BY	LAURENCE	
DATE	1/56	

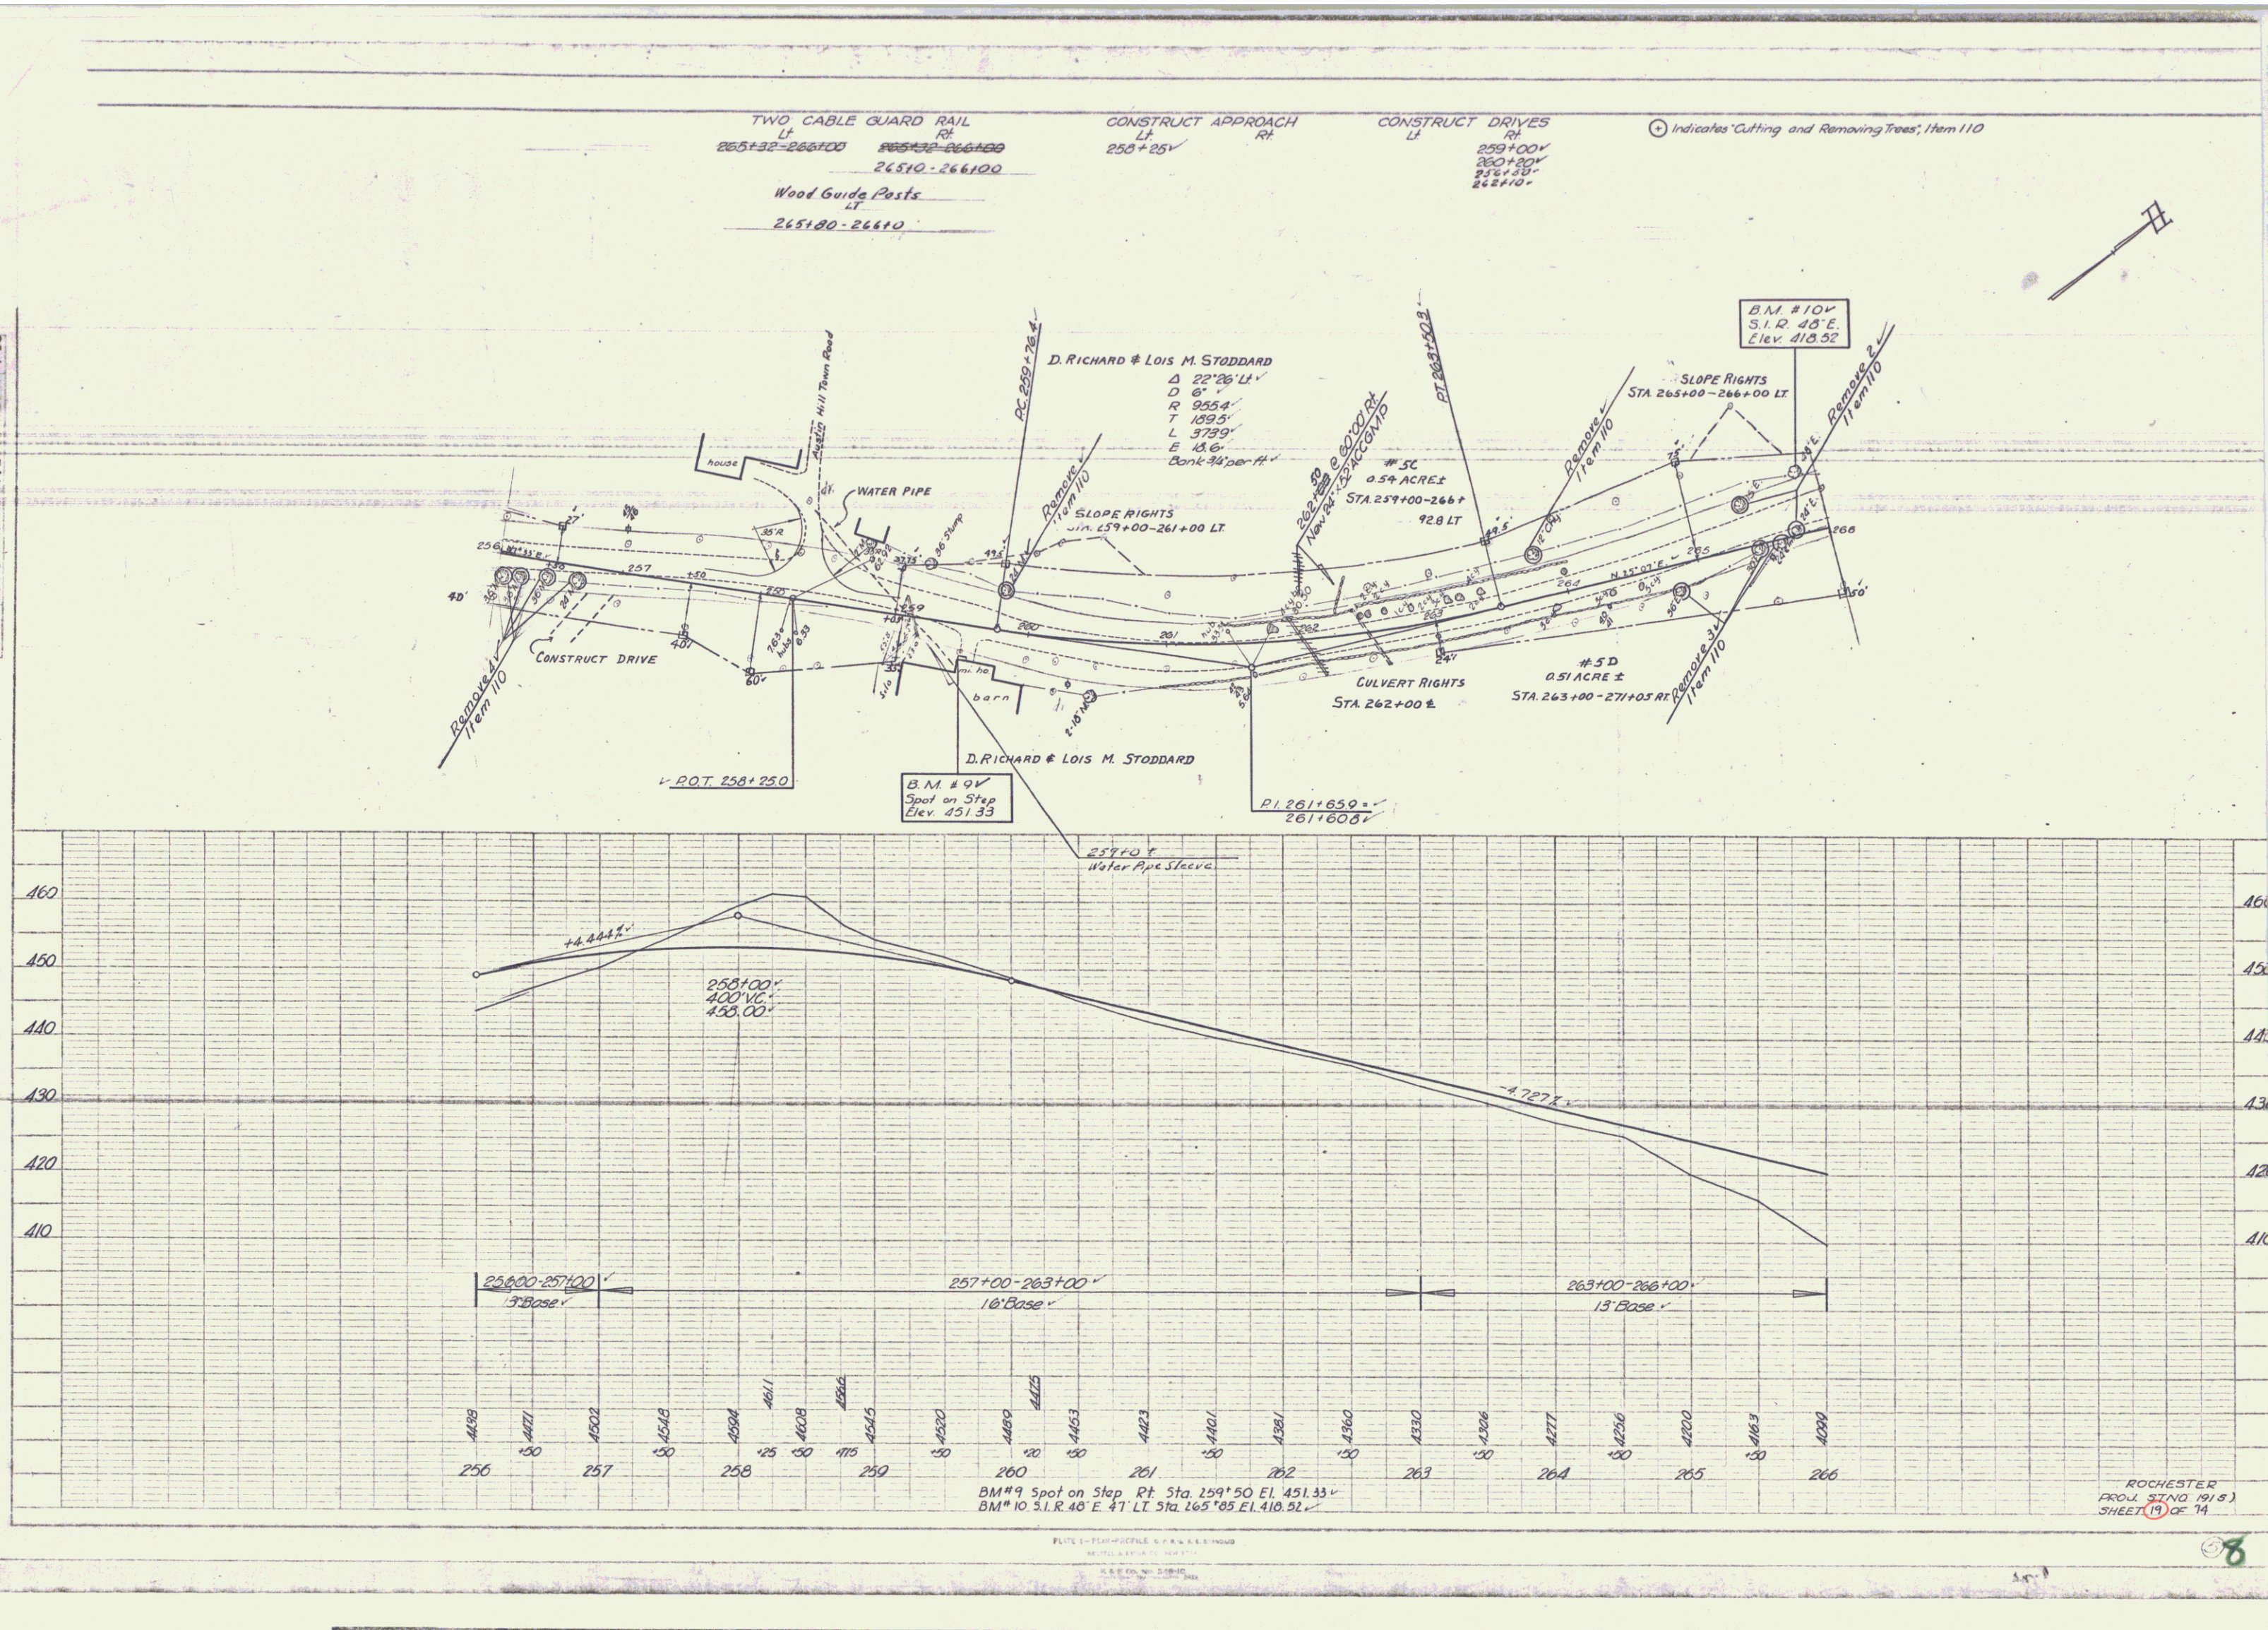

PLAN
 DATE 1/25
 DRAWN BY J. J. J.
 CHECKED BY W. J.
 SCALE 1"=50'

PROFILE
 DATE 1/25
 DRAWN BY J. J. J.
 CHECKED BY W. J.
 SCALE 1"=50'

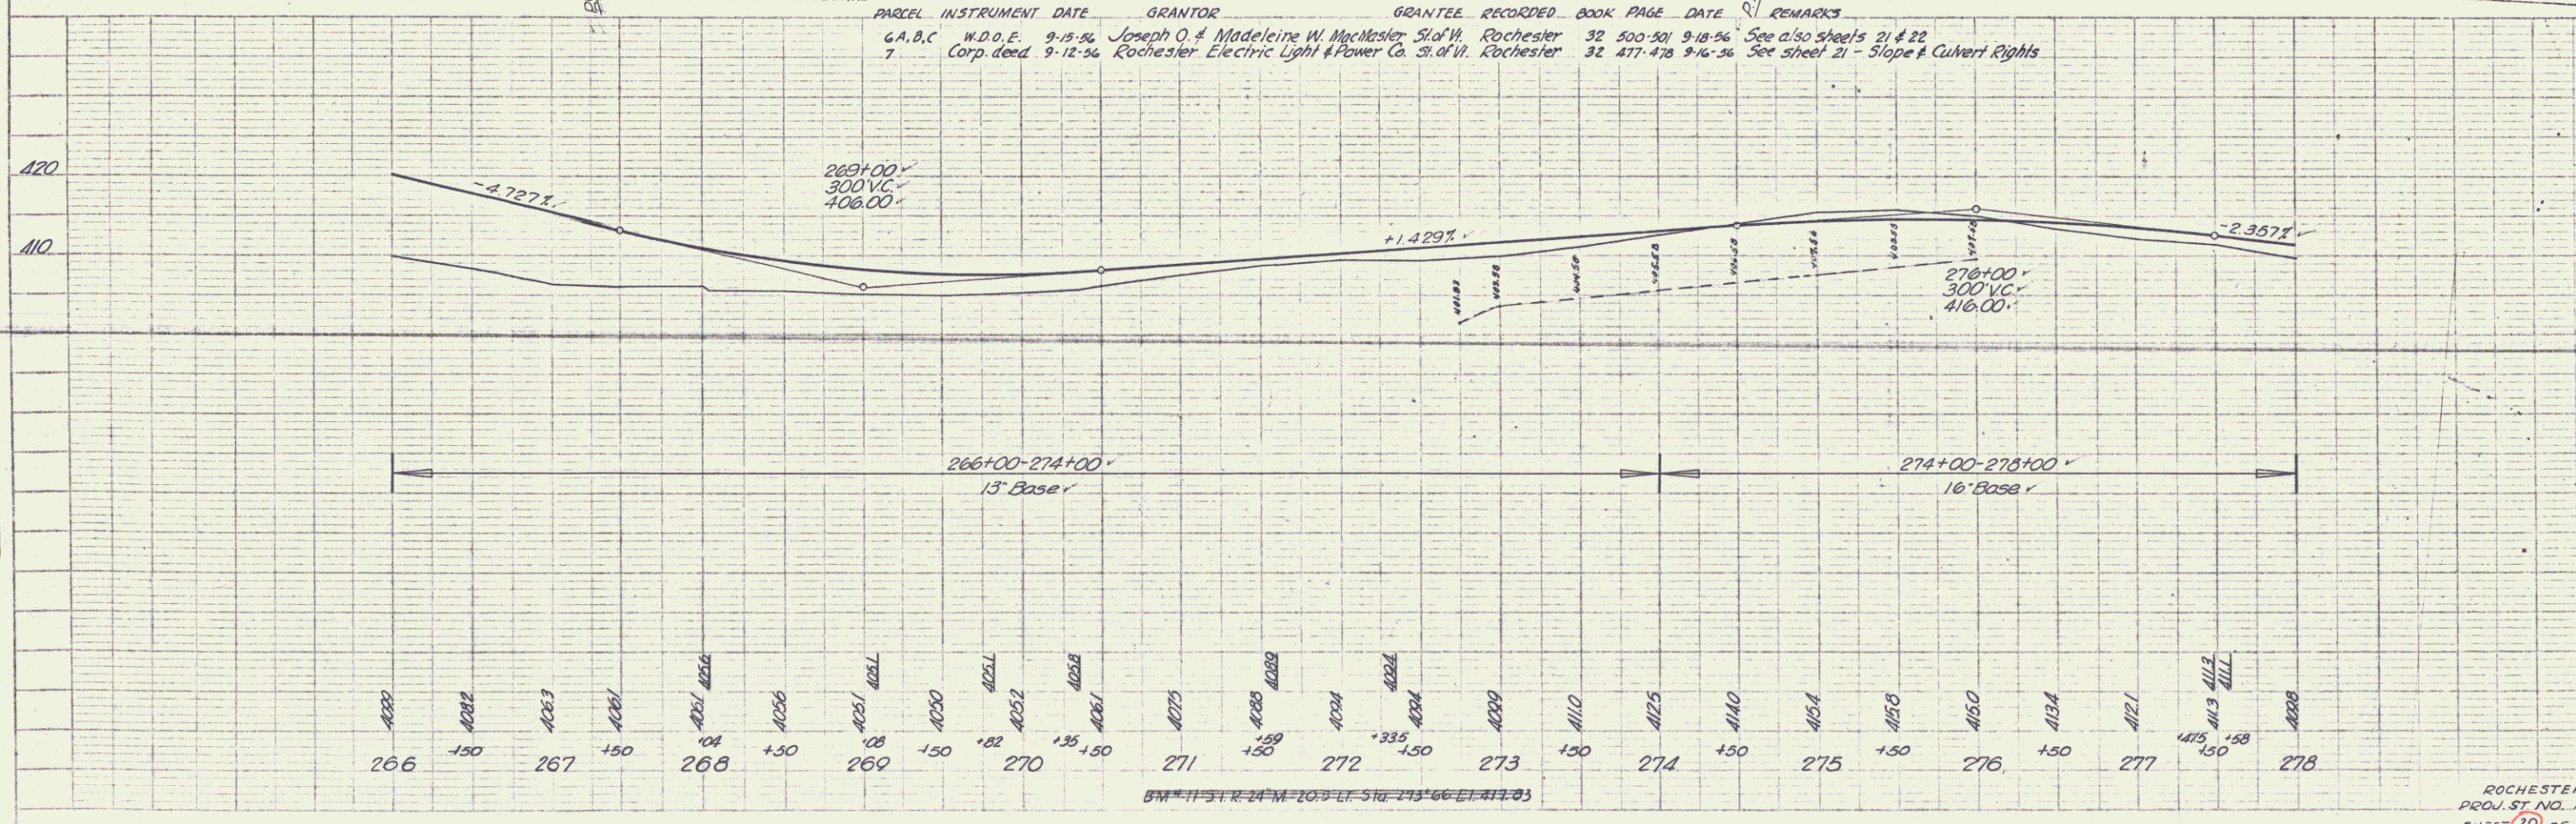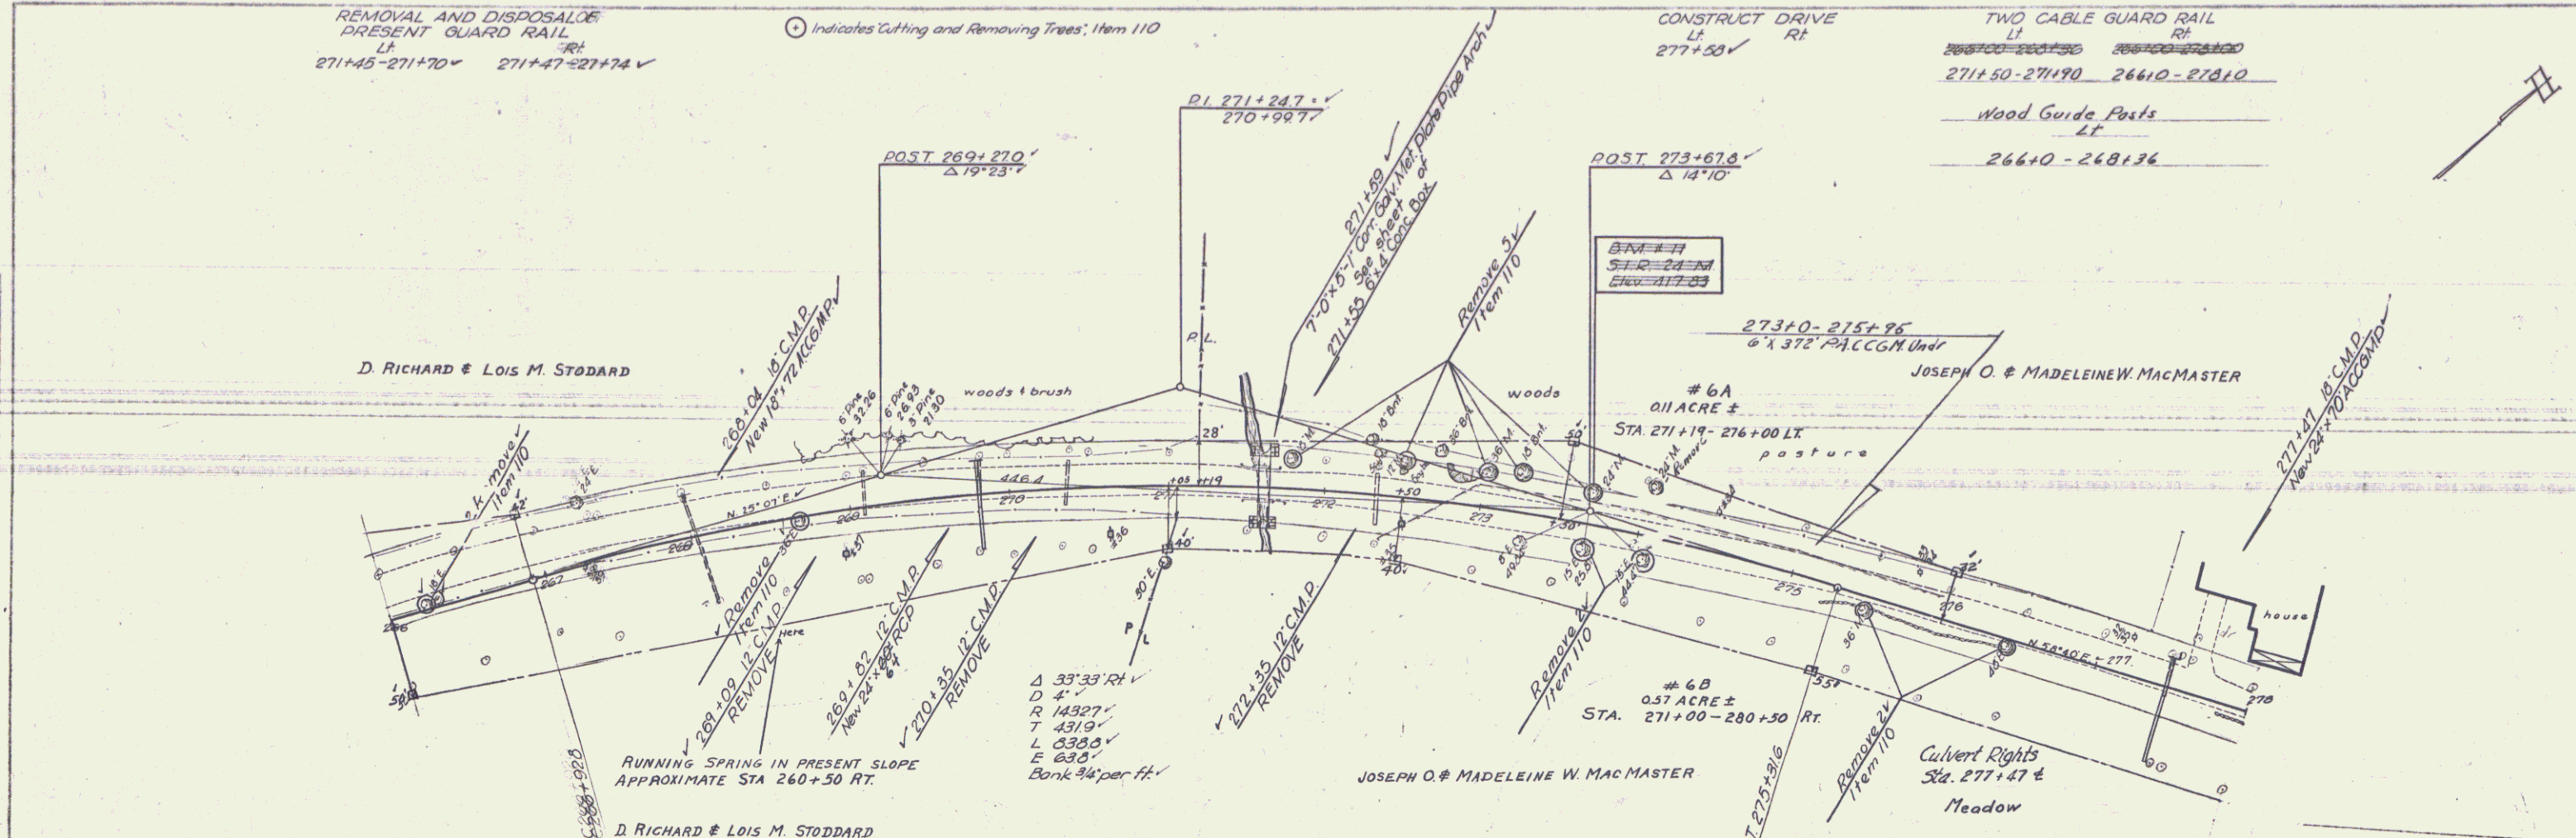

PARCEL	INSTRUMENT DATE	GRANTOR	GRANTEE	RECORDED BOOK PAGE DATE	REMARKS
6A, B, C	W.D.O.E. 9-18-56	Joseph O. & Madeleine W. MacMaster, Slat. W. Rochester	32 500-501	9-18-56	See also sheets 21 & 22
7	Corp. deed 9-12-56	Rochester Electric Light & Power Co. Slat. W. Rochester	32 477-478	9-16-56	See sheet 21 - Slope & Culvert Rights

