

INDEX OF SHEETS	
SHEET NO.	TITLE PAGE
1	TYPICAL CROSS-SECTION OF IMPROVEMENT
2	BANKING AND WIDENING TABLES
3	PLAN AND PROFILE
4-8	DETAIL SHEET 10x10 R.C. BOX 561+73
9	STANDARD STRUCTURE SHEET 3-28 PIPE CULVERTS
10	STANDARD STRUCTURE SHEET R.C.P. 2 4-16 R.C. BOX
11	3-30 GUARD RAIL
12	3-30A BOUNDARY MARKERS
13	3-40 BARRICADES, SIGNS & LIGHTS
14	3-41 ROUNDING SLOPES
15	CROSS-SECTIONS

STANDARD STRUCTURE SHEETS APPROVED
BY THE CHIEF ENGINEER
3-28 APRIL 26, 1941
3-30 MAY 12, 1941
3-30A APRIL 19, 1941
3-40 SEPT. 5, 1940

STATE OF VERMONT STATE HIGHWAY DEPARTMENT PLAN AND PROFILE OF PROPOSED STATE HIGHWAY SECONDARY


TOWN OF SHELDON

VERMONT ROUTE 104B
SWANTON-ENOSBURG ROAD


BEGINNING AT A POINT 1.026 MILES SOUTHEASTERLY FROM THE HIGHGATE
SHELDON TOWN LINE AND EXTENDING SOUTHEASTERLY 4355.9 FT. TO ITS
NEW INTERSECTION WITH ROUTE 105. ALSO "A" LINE JCT. OF ROUTES 104 & 105

MAIN LINE 4355.9 FEET = 0.824 MILES
477+35 RT. - 478+35 RT. "A" LINE 93.0 FEET = 0.018 MILES
LENGTH OF PROJECT 4448.9 FEET = 0.842 MILES

FED. ROAD DIST. NO.	STATE	S. NO.	SECTION	SHEET NO.	TOTAL SHEETS
9	VT.	201(8)	1	29	

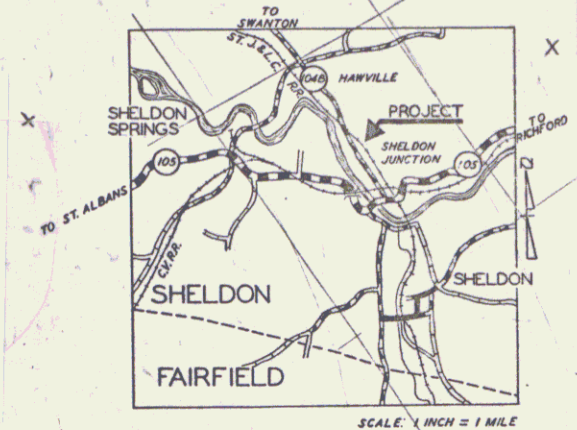

RIGHT-OF-WAY DIVISION
TOWN FILE
PERPETUAL
Town of Sheldon
(To Be Returned To R.O.W. Division)

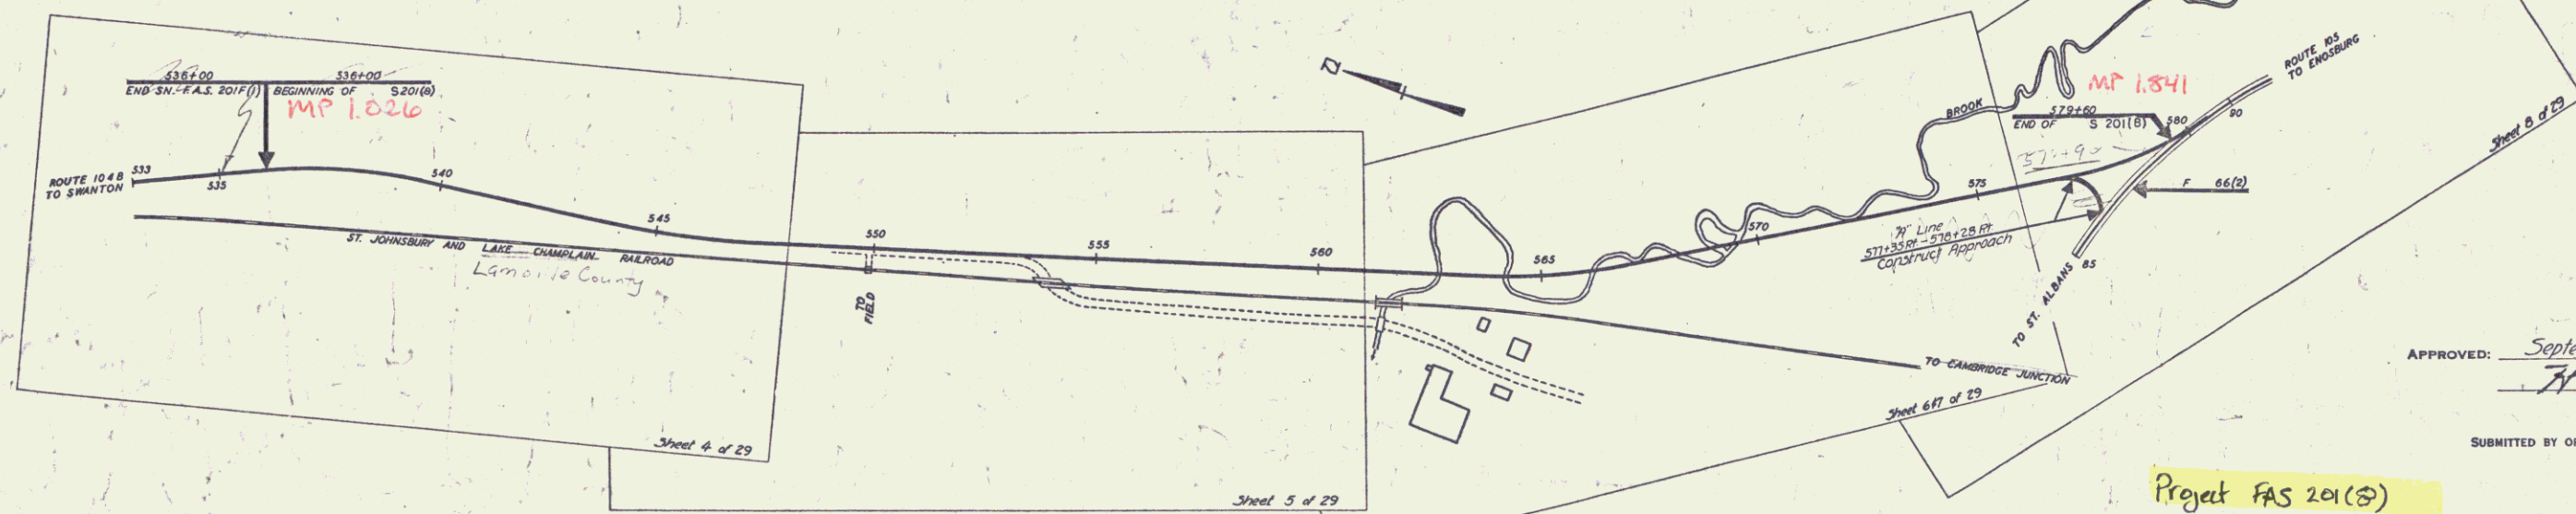

COUNTY LINE	
TOWN LINE	
FENCE LINE	
STONE WALL	
UNFENCED PROPERTY	
GUARD RAIL	
TRAVELED WAY	
RAILROAD	
RETAINING WALL	
CENTER LINE	
SURVEY LINE	
CULVERT	
DROP INLET	
TROLLEY POLE	
POWER POLE	
TELEPHONE POLE	
TREES	
HEDGE	

GROUND ELEVATION	DATUM	LINE
GRADE ELEVATION	DATUM	LINE
CURVE DATA		
DEFLECTION ANGLE		Δ
DEGREE OF CURVE		D
RADIUS OF CURVE		R
TANGENT DISTANCE		T
LENGTH OF CURVE		L
EXTERNAL DISTANCE		E
POINT OF INTERSECTION		P. I.
POINT OF CURVE		P. C.
POINT OF TANGENT		P. T.
POINT ON TANGENT		P. O. T.

SCALES	
TITLE	1" = 200'
TYPICAL	1" = 2'
PLAN	1" = 50'
PROFILE HORIZONTAL	1" = 50'
PROFILE VERTICAL	1" = 10'
CROSS SECTIONS	1" = 5'


THESE PLANS ARE SUBJECT TO SUCH REVISIONS AS MAY BE
REQUIRED BY THE PUBLIC ROADS ADMINISTRATION OR THE COM-
MISSIONER OF HIGHWAYS.
CONSTRUCTION IS TO BE CARRIED ON IN ACCORDANCE WITH
THE PLANS AND THE STANDARD ROAD AND BRIDGE SPECIFICATIONS
OF 1936, AS APPROVED DECEMBER 29TH, 1936 BY THE PUBLIC
ROADS ADMINISTRATION, INCLUDING ALL SUBSEQUENT APPROVED
REVISIONS AND SUCH REVISED SPECIFICATIONS AND SPECIAL
PROVISIONS AS ARE SUBMITTED WITH THE PLANS.

APPROVED <u>Sept. 17, 1945</u> ROAD ENGINEER	APPROVED <u>Sept. 17, 1945</u> DISTRICT HIGHWAY COMMISSIONER	SERIES <u>201(8)</u> FILED SHEET <u>1</u> OF <u>29</u>
---	---	---


Robert Remington
James Park
Louis Lown


3/12
Popey

STATE	NO.	YEAR	SHEET	TOTAL
VT.	1018	1946	4	29


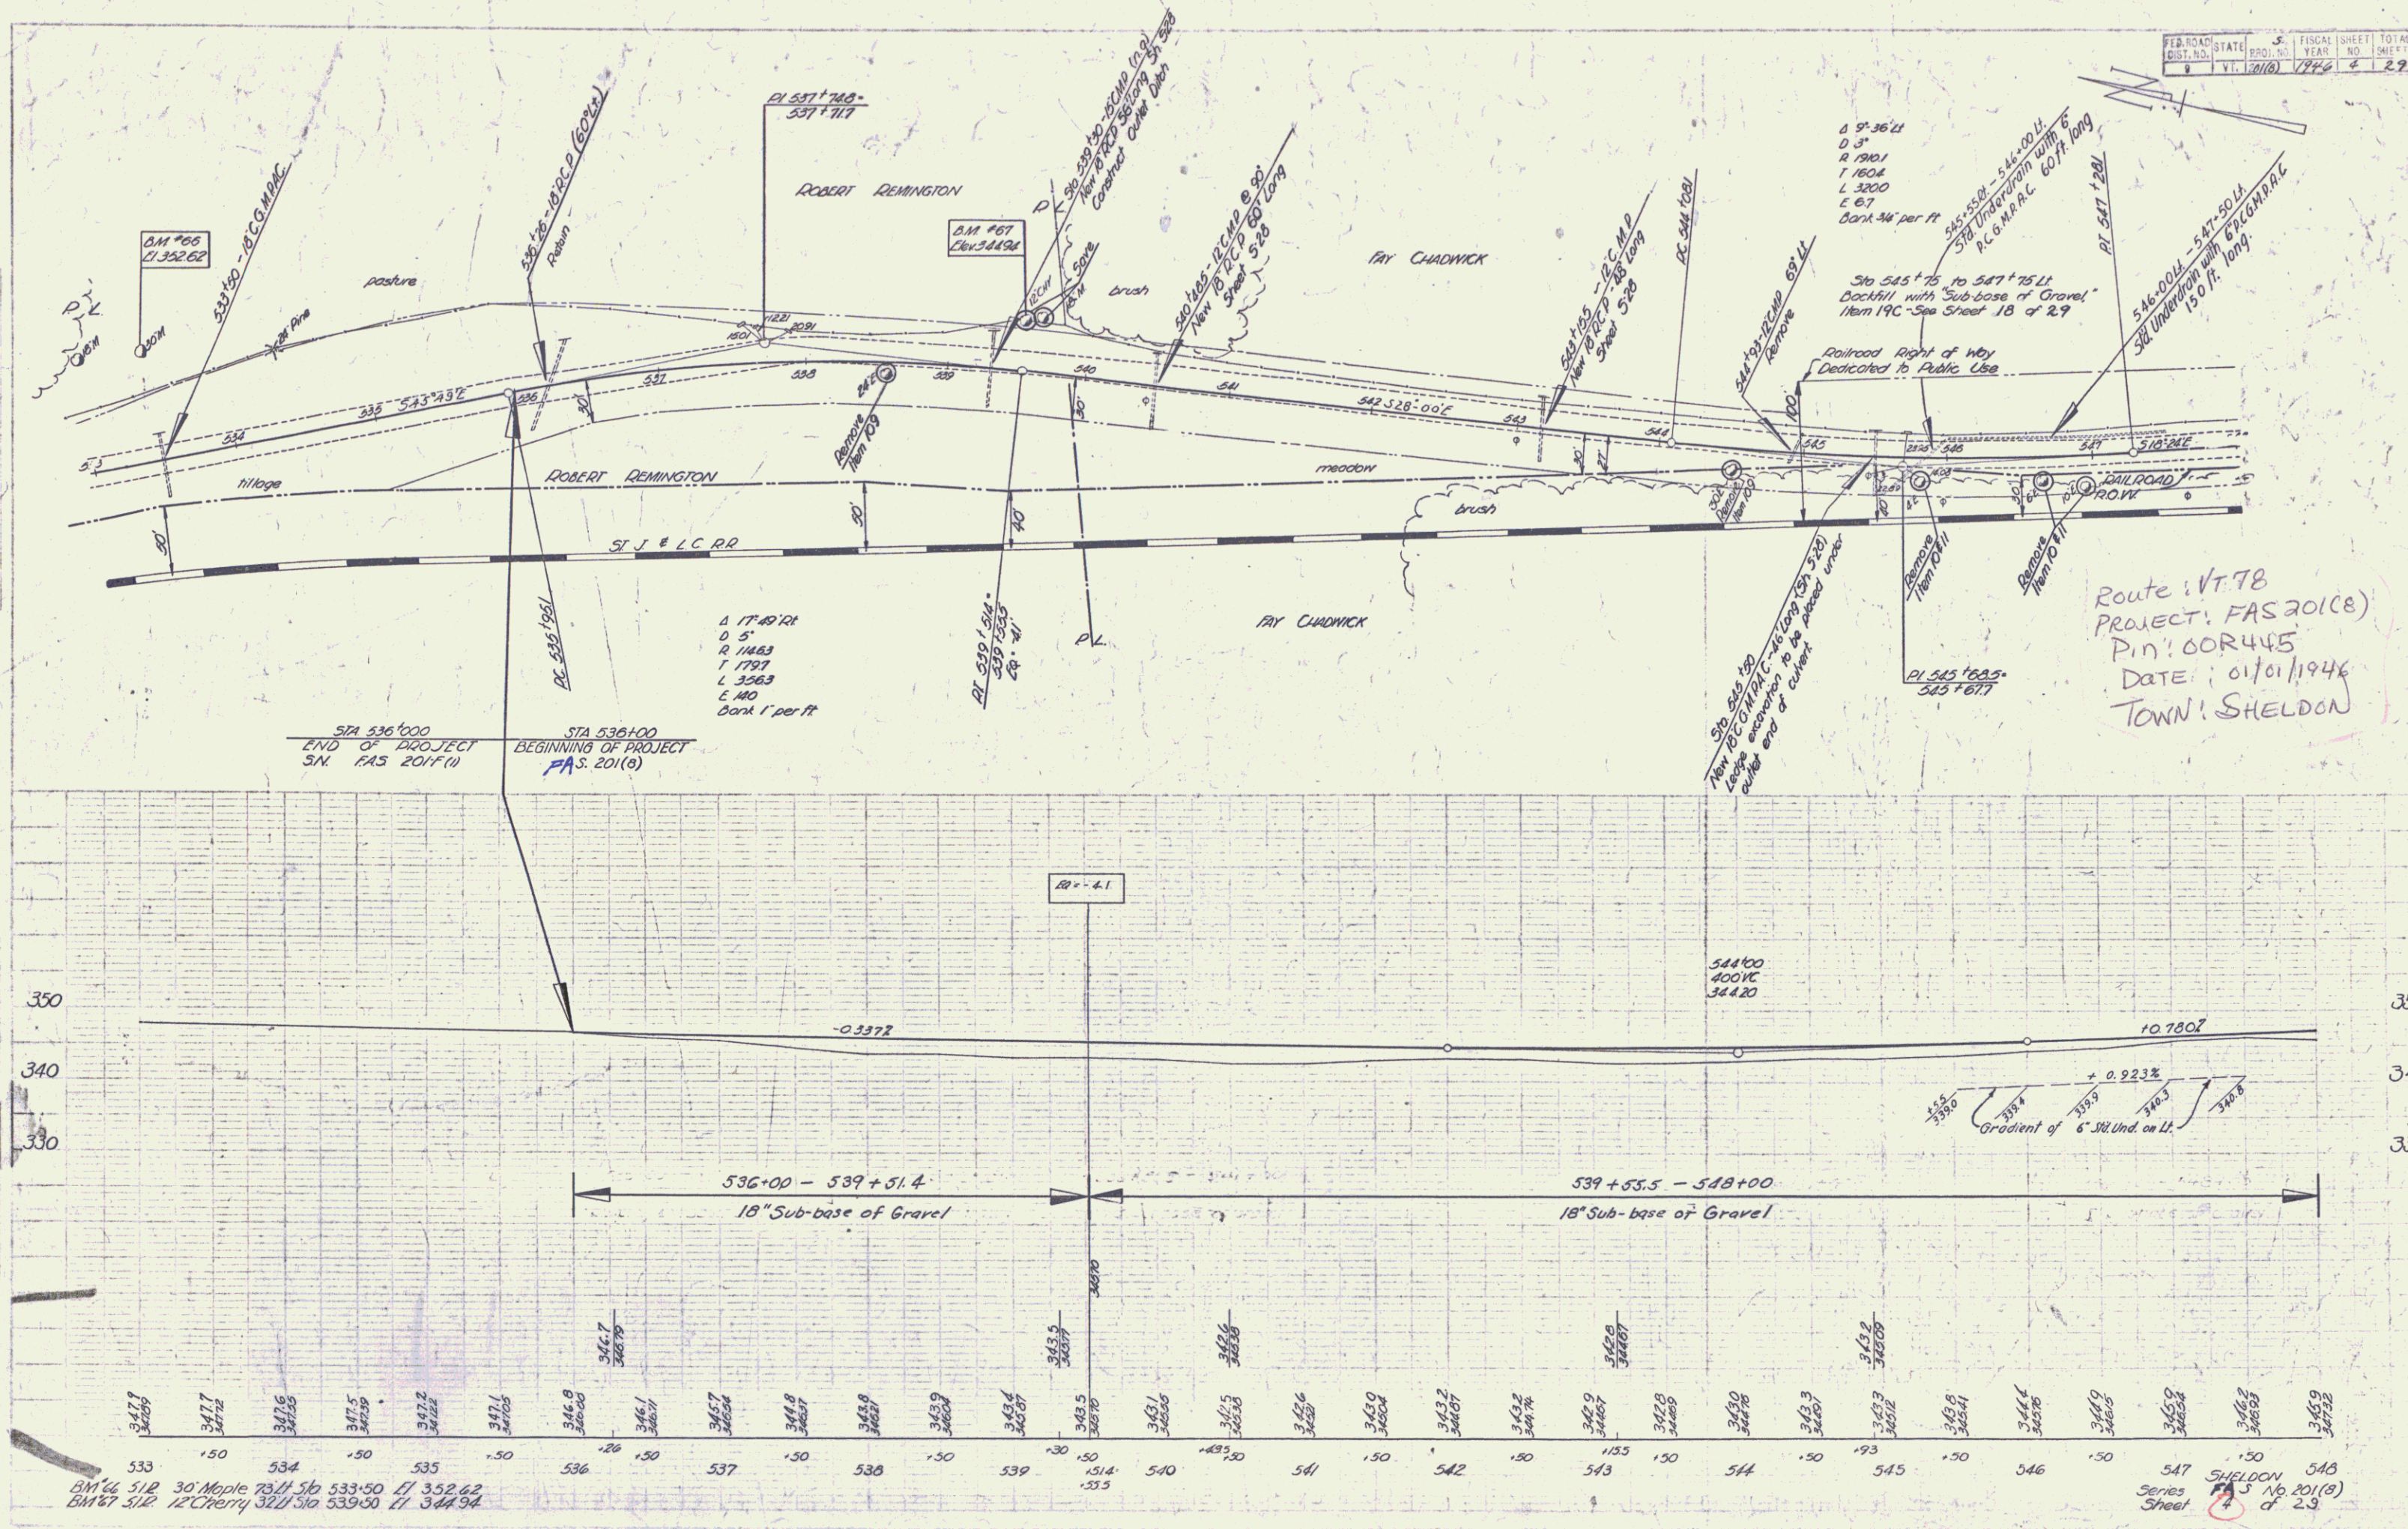


Route 1 VT 78
Project: FAS 201(8)
Pin: 00R445
Date: 01/01/1946
Town: Sheldon

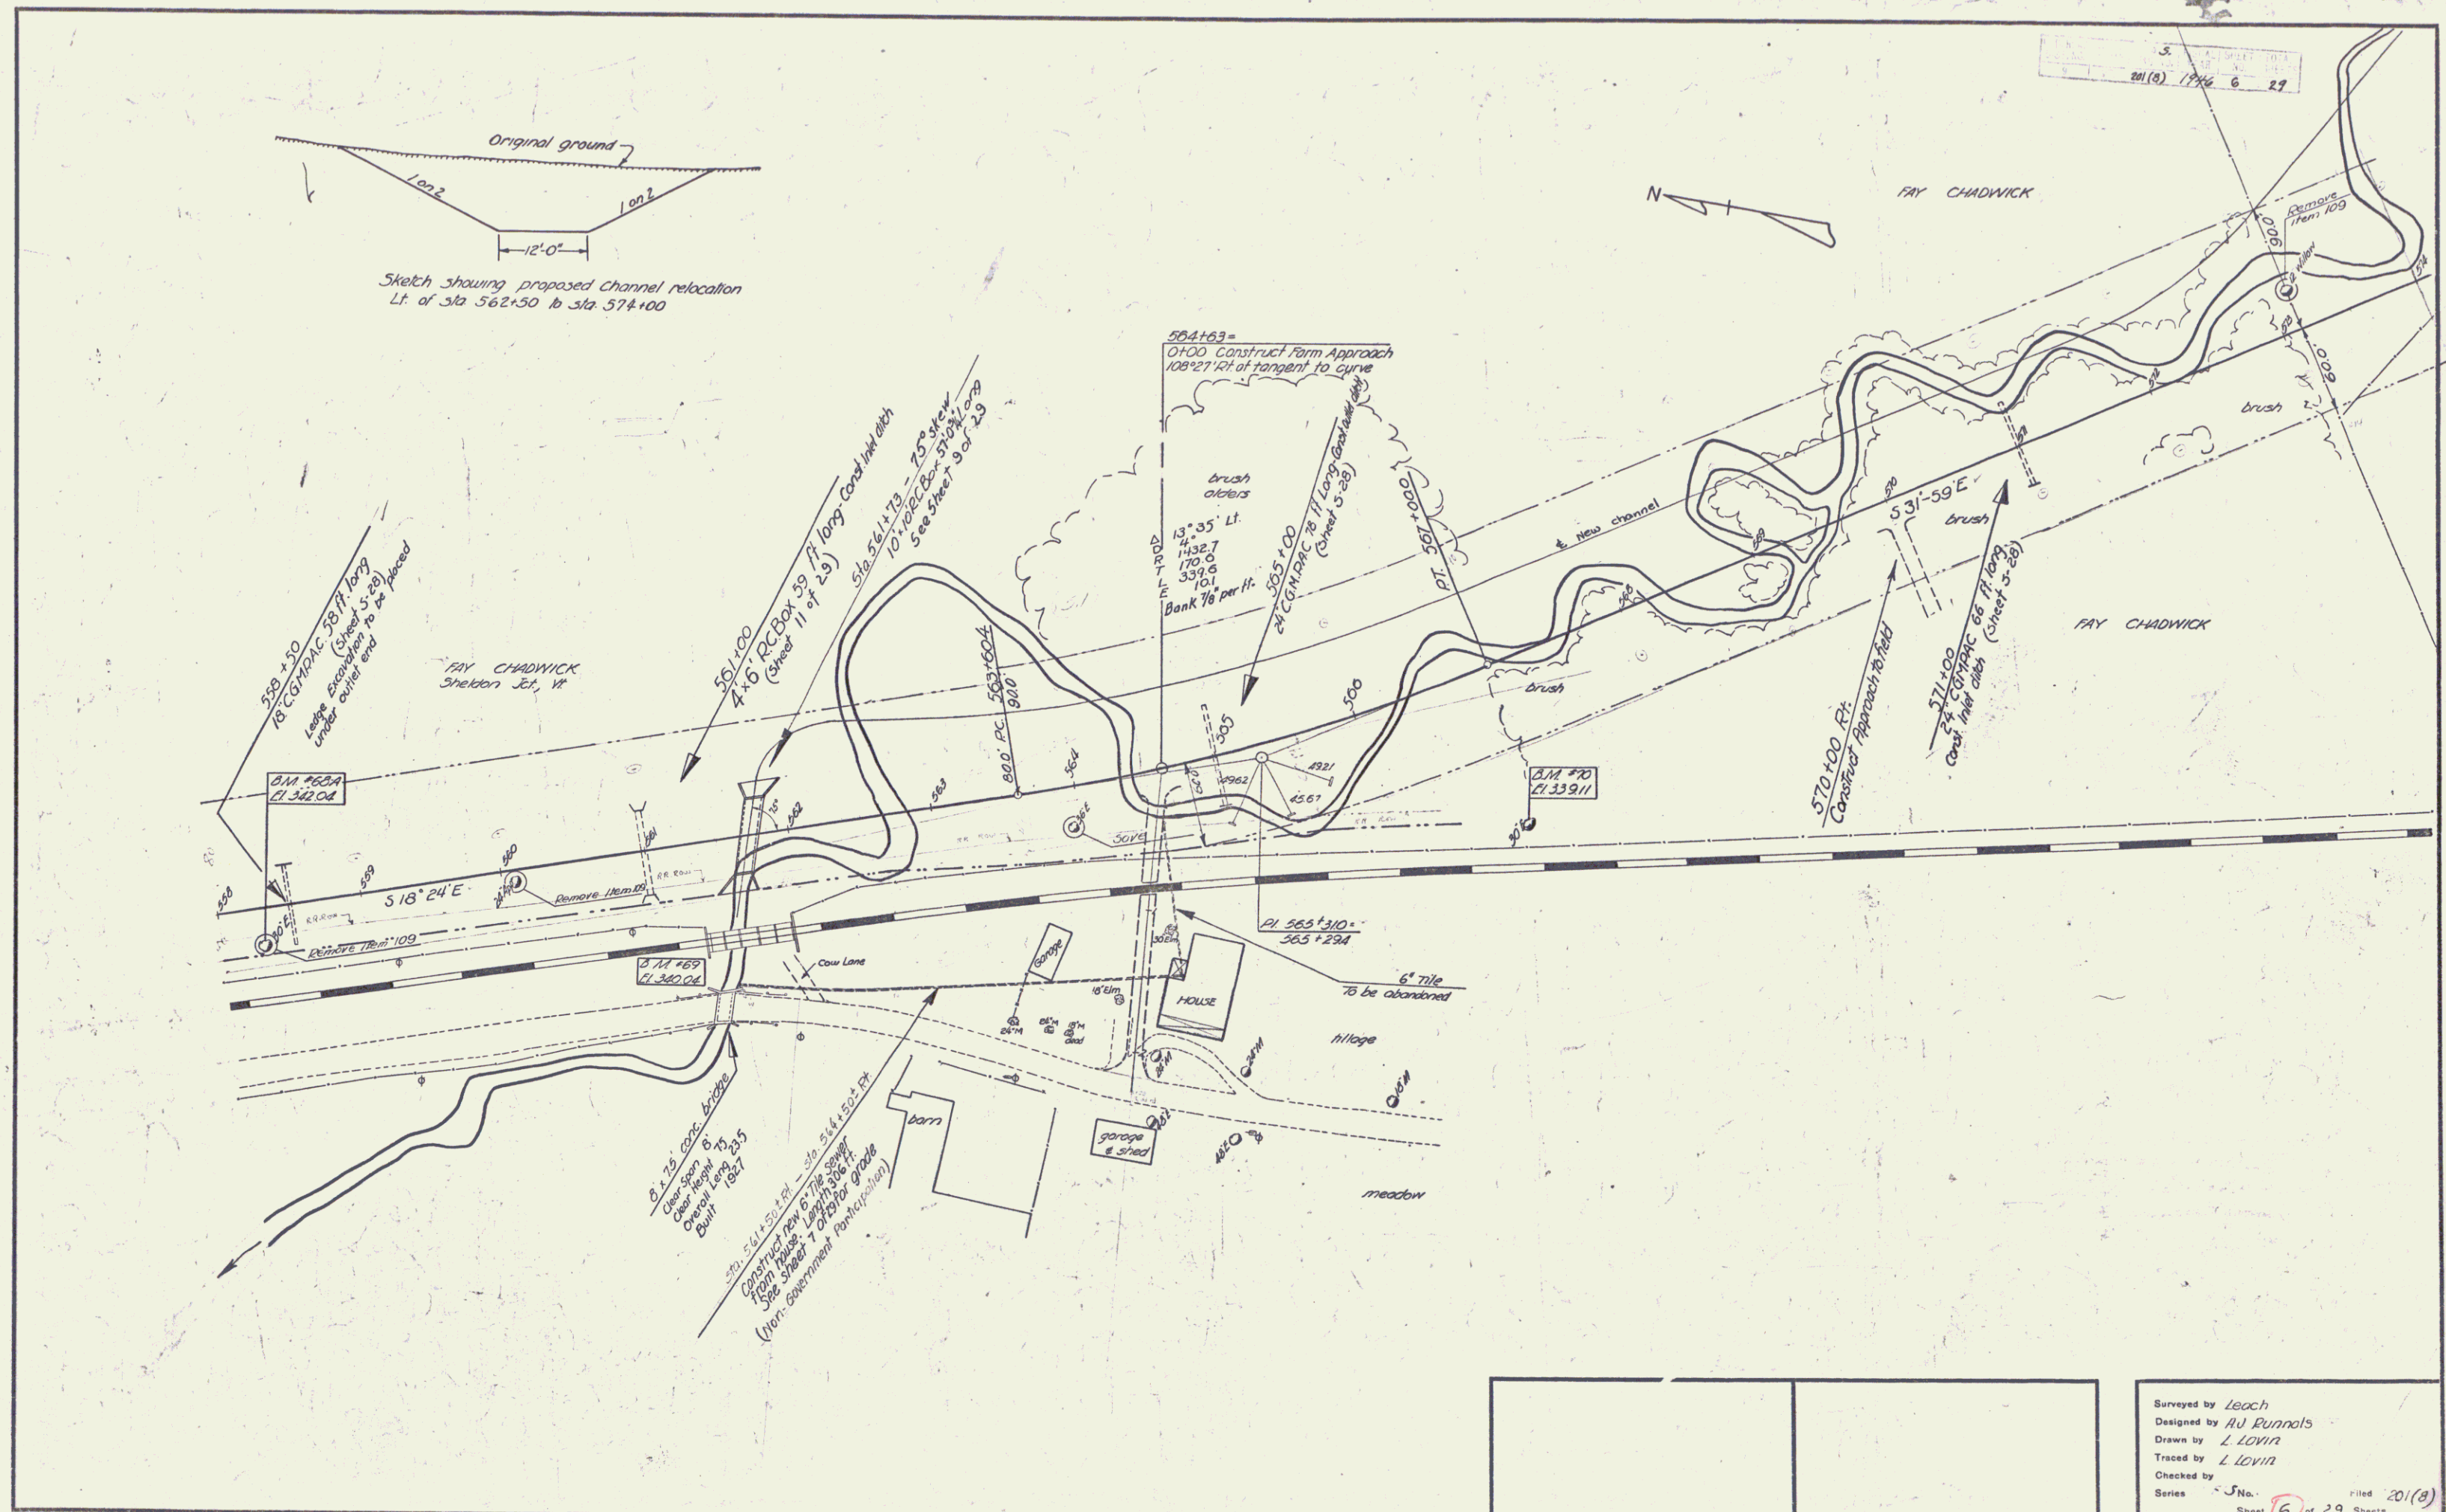

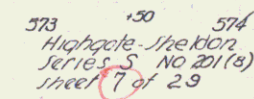

201(8) 1946 8 29

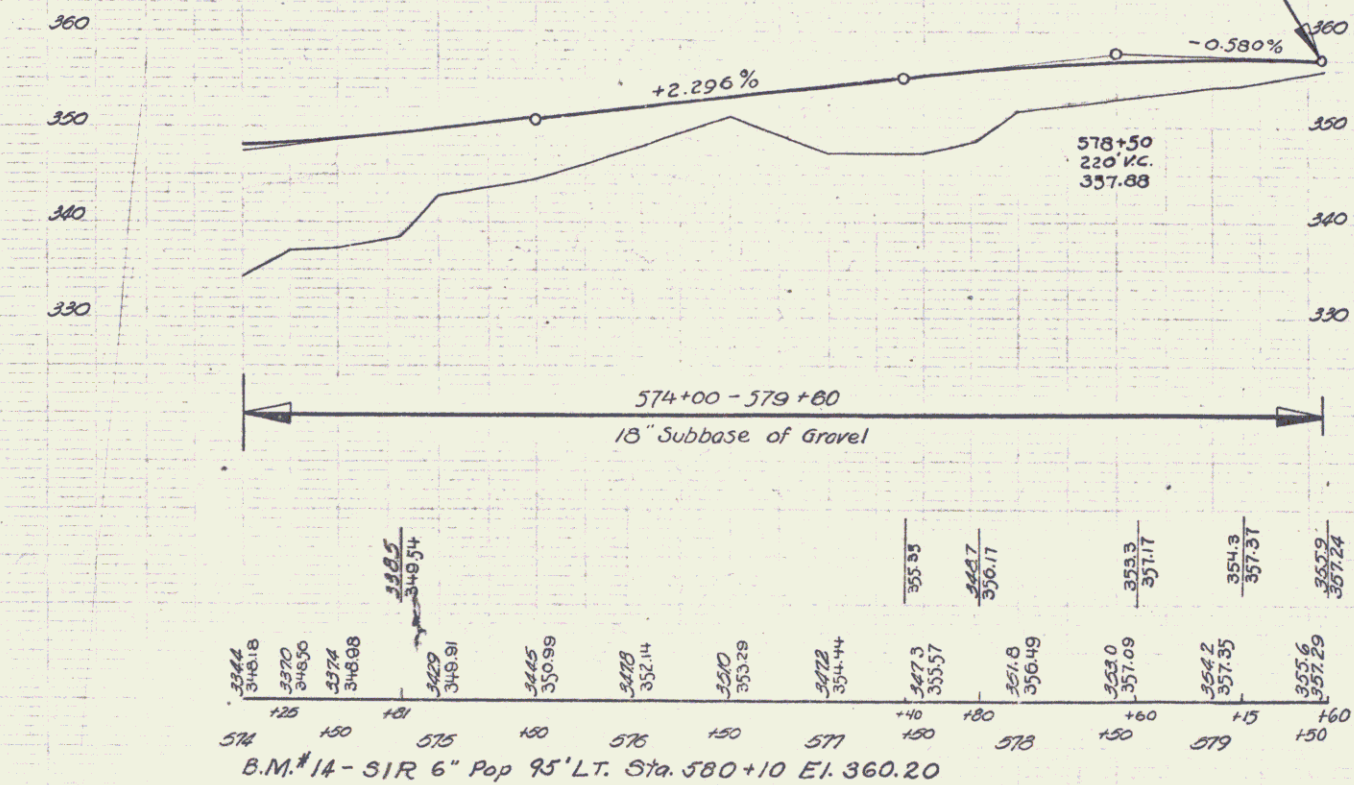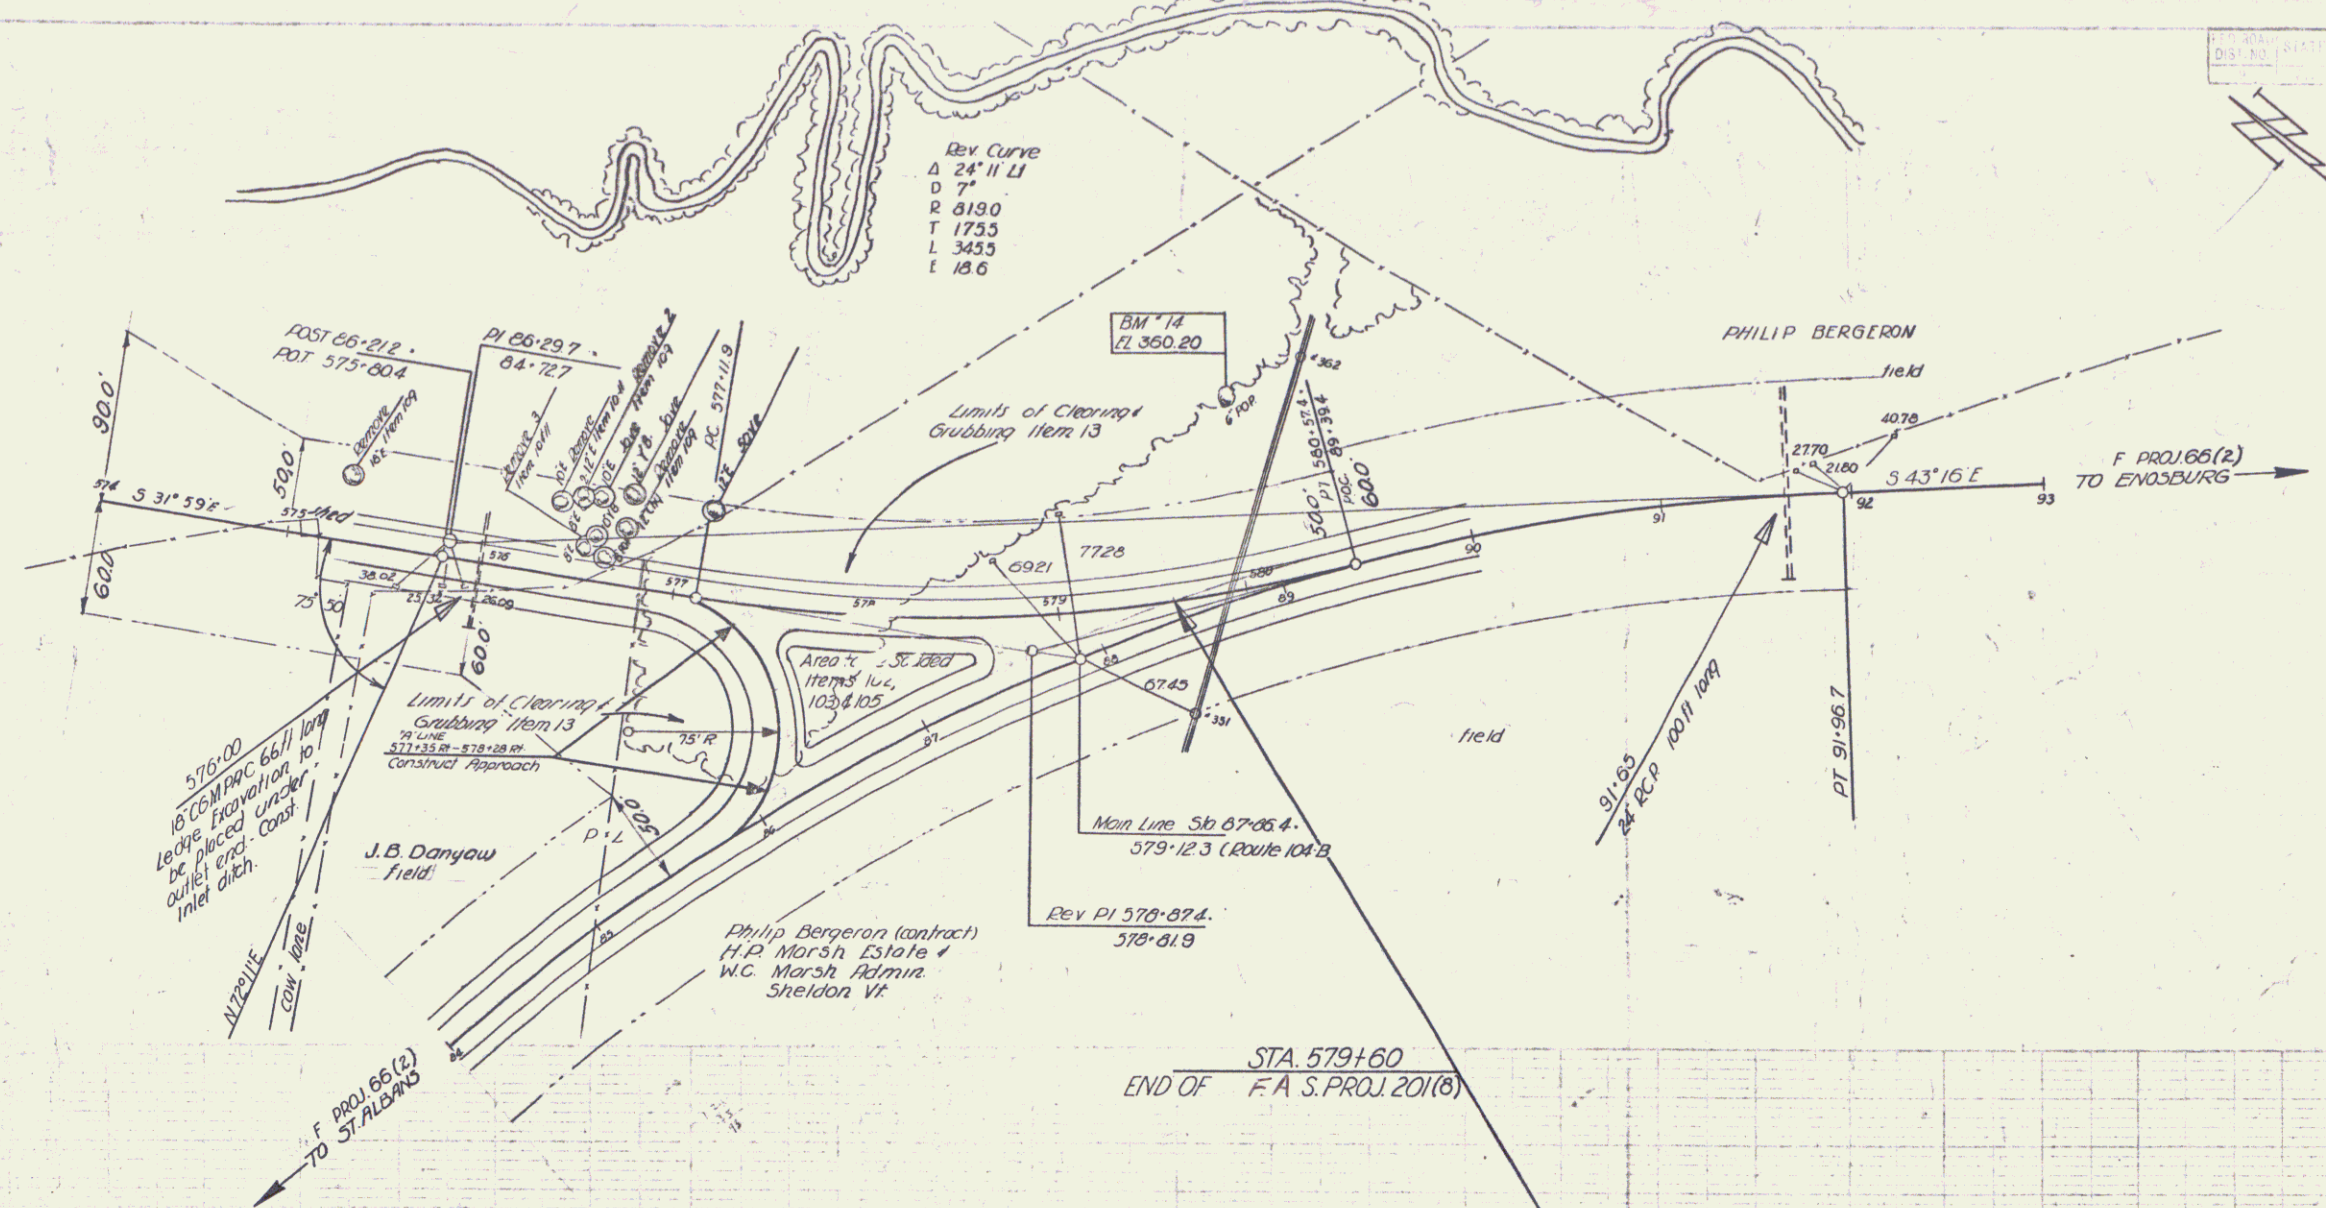

B.M. 14 - S.I.R. 6" Pop 95' LT. Sta. 580+10 El. 360.20

SHIELDON
Series 5 No. 201(8)
Sheet 9 of 23