


- SHEET NO. 1 TITLE PAGE
 2 TYPICAL CROSS-SECTION OF IMPROVEMENT (DOUBLE TACK COAT OF REFINED TAR WITH PEASTONE SEAL)
 3 ROADWAY STANDARD SHEET RS 56-1 (BANKING)
 4 ROADWAY STANDARD SHEET RS 56-12 (BARRICADES, SIGNS AND LIGHTS)
 5 QUANTITY SHEET (ITEMS)
 6 QUANTITY SHEET (DRAINAGE)
 7-10 EARTHWORKS SHEETS
 11-22 PLAN AND PROFILE SHEETS
 23 ROADWAY STANDARD SHEET RS 56-3 (MARKERS)
 24 ROADWAY STANDARD SHEET RS 56-4 (DRAINAGE)
 25 ROADWAY STANDARD SHEET RS 56-6 (TYPICAL GRADINGS AND TURNOUTS)
 26 ROADWAY STANDARD SHEET RS 56-11 (THREE CABLE GUARD RAIL)
 27-66 CROSS SECTION SHEETS

PROJECT NAME AND NUMBER	TYPE	PAVT. AREA
VERSHIRE-W. FAIRLEE S17-6(7)-DOUBLE TK-CT39,203 sy.		
RECORD PLANS		
MATERIALS		
PEASTONE-TWIN STATE LABORATORY, N.H.	METAL PIPE-H.E. METAL PIPE CO.	
TAR-Hopwood Products Co., Inc., Mass.	STEEL GUIDE POSTS-Vermeer	
R.O.P.-Vt. Concrete Pipe Works, Vt.	GUARD RAIL-Vermeer	
CONTRACTOR-Ralph B. Goodrich, Inc.	GRAVEL-Vermeer	
RESIDENT ENGINEER-John H. Hughes	CONTRACT DATED-DEC. 25, 1955	
INSPECTOR-Allen J. Davis	CONTRACT STARTED-JAN. 14, 1957	
RECORD PLANS-Davis & Hughes	CONTRACT COMPLETED-OCT. 29, 1957	
	CONTRACT ACCEPTED-OCT. 29, 1957	

TOWNS OF VERSHIRE-W. FAIRLEE

COUNTY OF ORANGE CHELSEA-WEST FAIRLEE ROAD VERMONT ROUTE 113

BEGINNING AT A POINT APPROXIMATELY 21,566.3 FEET EASTERLY OF THE CHELSEA-VERSHIRE TOWN LINE AND EXTENDING EASTERLY 17,328.5 FEET EXCLUDING BRIDGES AND APPROACHES
 LENGTH OF ROADWAY 16,778.5 FEET+ 3.1777 MILES
 LENGTH OF PROJECT 16,778.5 FEET+ 3.1777 MILES

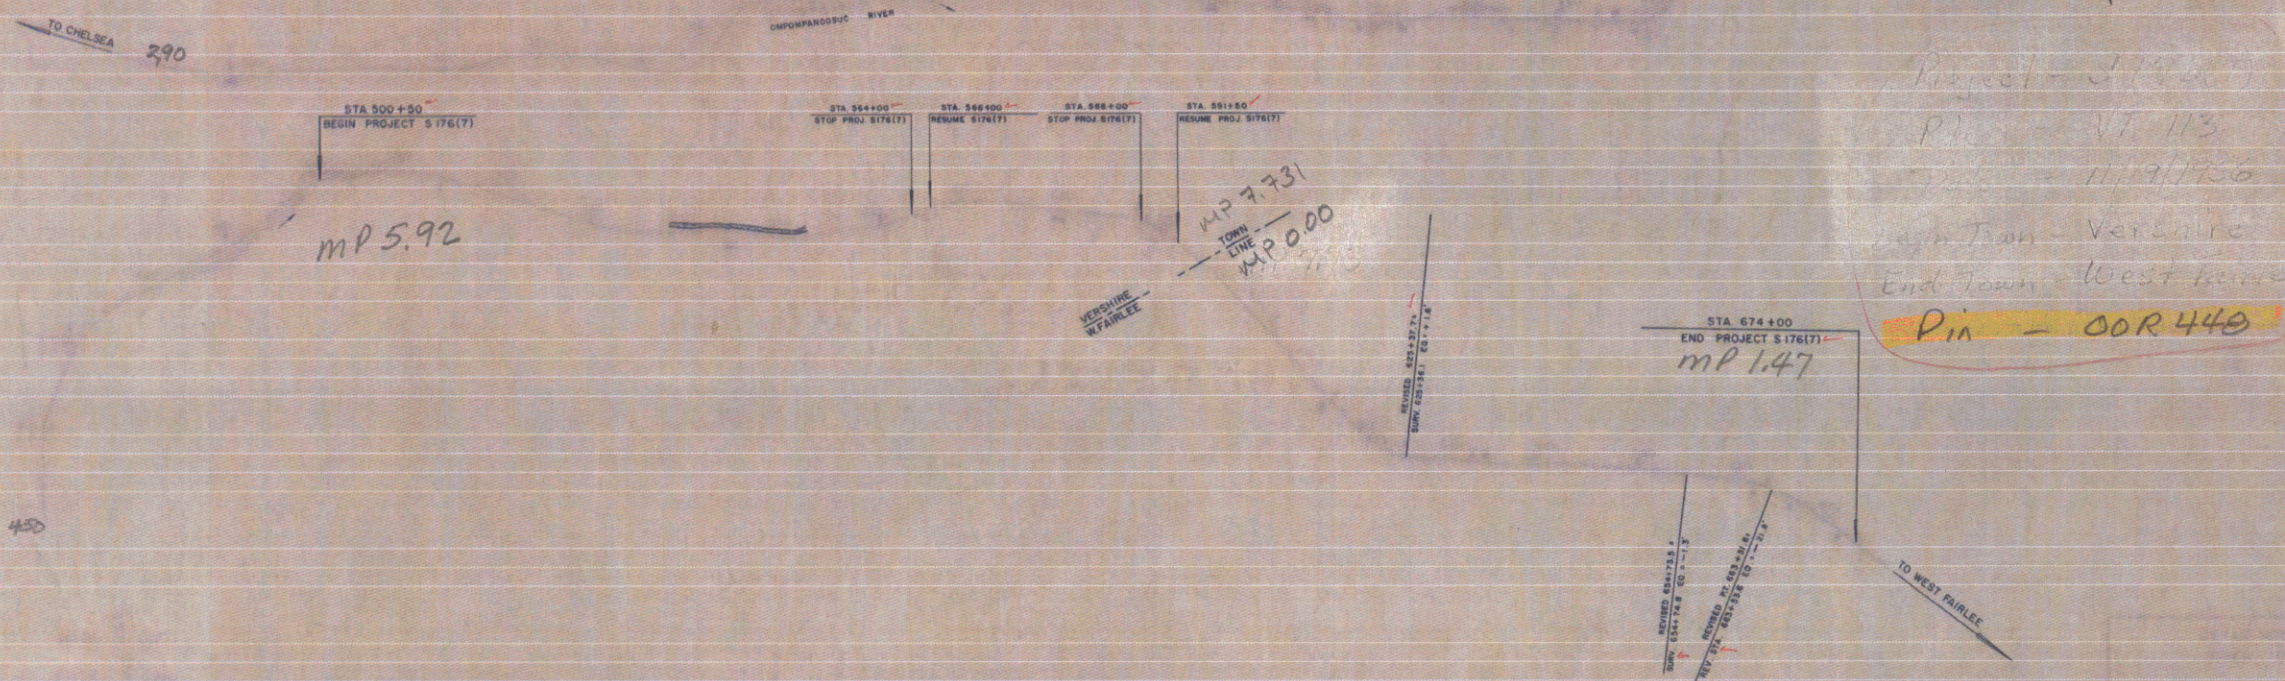

PROJECT Vershire-West Fairlee
 NUMBER 5176 (7)
 TYPE Double Tack Coat of Refined Tar with Peastone Seal
 CONTRACTOR Ralph B. Goodrich, Inc.
 LOCATION Beginning at a point approximately 21,566.3 ft. easterly of the Chelsea-Vershire Town Line and extending easterly 17,328.5 ft. including bridges and approaches
 VERMONT ROUTE 113
 CONTRACTOR-RALPH B. GOODRICH INC.
 RECORD PLANS
 CONTRACT COMPLETED-OCT. 29, 1957

CONSTRUCTION OF JANUARY 1956, AS APPROVED BY THE BUREAU OF PUBLIC ROADS JULY 5, 1956 INCLUDING ALL SUBSEQUENT APPROVED REVISIONS AND SUCH REVISED SPECIFICATIONS AND SPECIAL PROVISIONS AS ARE SUBMITTED WITH THE PLANS

[Signature] 11-20-56
 [Signature] 11-20-56
 [Signature] NOV. 20, 1956
 [Signature] NOV. 19, 1956

S 176 (7)
 1 60