

INDEX OF SHEETS	
SHEET NO.	1
1	TITLE PAGE
2	TYPICAL CROSS-SECTION OF IMPROVEMENT
3	BANKING AND WIDENING TABLES
4	QUANTITY SHEET (ITEMS)
5-5A	QUANTITY SHEETS (DRAINAGE)
5-9	EARTHWORK SHEETS
10-20	PLAN AND PROFILE SHEETS
21	CONSTRUCTION DETAILS (DRAINAGE)
22	CONSTRUCTION DETAILS (DITCHES)
23	STANDARD STRUCTURE SHEET S 40 (BARRICADES, SIGNS & LIGHTS)
24	STANDARD STRUCTURE SHEET S 45-45 (GUARD RAIL)
25-53	CROSS-SECTIONS

STANDARD STRUCTURE SHEET APPROVED BY THE CHIEF
ENGINEER, VERMONT STATE DEPARTMENT OF HIGHWAYS.



S-40 JUNE 10, 1950

STATE OF VERMONT STATE HIGHWAY DEPARTMENT

PLAN AND PROFILE OF PROPOSED STATE HIGHWAY

SECONDARY PROJECT

PROJECT NO.	STATE	PROJECT NO.	FISCAL YEAR	SHEET NO.	TOTAL SHEETS
1	VT.	S 176 (5)	WAR	1	53

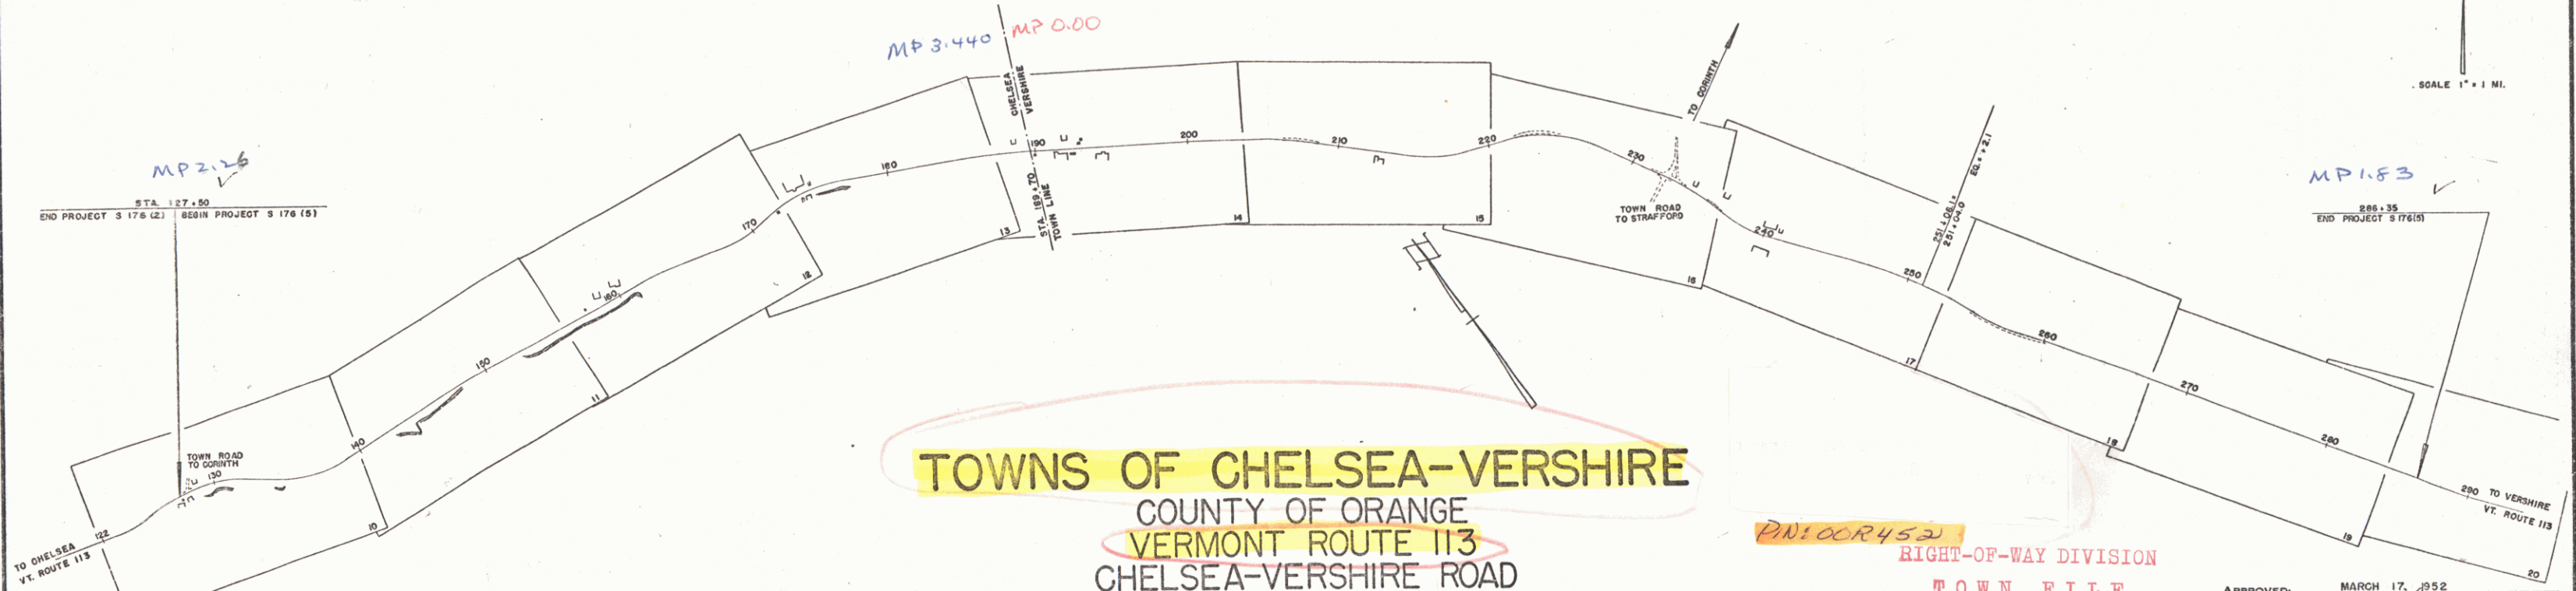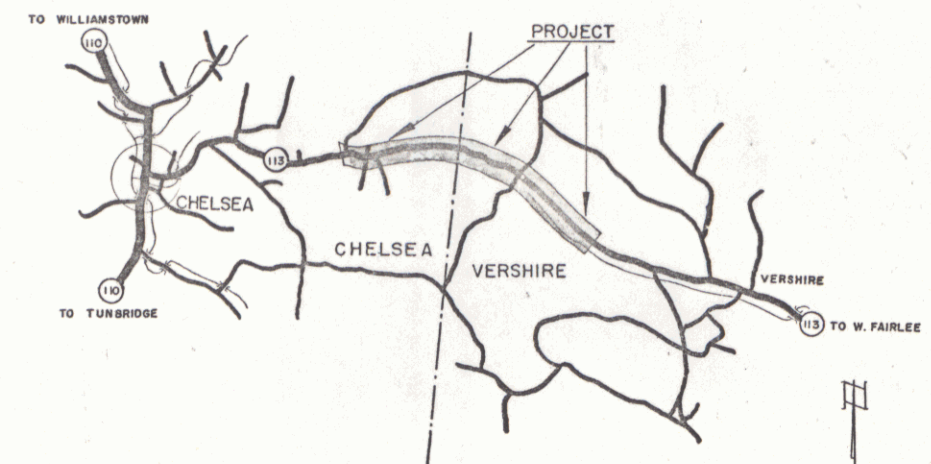

TOWNS OF CHELSEA-VERSHIRE
COUNTY OF ORANGE
VERMONT ROUTE 113
CHELSEA-VERSHIRE ROAD

BEGINNING AT A POINT APPROXIMATELY 11,952.9 FT. EAST
OF THE INTERSECTION OF VERMONT ROUTES 110 AND
113 AND EXTENDING EASTERLY 15,887.1 FEET

LENGTH OF PROJECT 15,887.1 FT. = 3.009 MILES

RIGHT-OF-WAY DIVISION
TOWN FILE

PERPETUAL

Town of Chelsea

(To Be Returned To R.O.W. Division)

APPROVED: MARCH 17, 1952
H. P. Sargent
CHIEF ENGINEER

SUBMITTED BY ORDER OF THE STATE HIGHWAY BOARD

NOTE: ANY FURTHER INFORMATION CONCERNING
FIVE QUANTITIES, AMOUNTS OR OTHER DETAILS
RELATIVE TO THIS PROJECT MAY BE FOUND IN
EITHER THE FIELD BOOKS OR THE ESTIMATE
FILE.

PROJECT Chelsea-Vershire
SHEET 5-176(5)
TYPE State En Base
CONTRACTOR Willard B. Martin
LOCATION See Title page

GROUND ELEVATION	DATUM	LINE
GRADE ELEVATION	DATUM	LINE
CURVE DATA		
DEFLECTION ANGLE	Δ	
DEGREE OF CURVE	D	
RADIUS OF CURVE	R	
TANGENT DISTANCE	T	
LENGTH OF CURVE	L	
EXTERNAL DISTANCE	E	
POINT OF INTERSECTION	P. I.	
POINT OF CURVE	P. C.	
POINT OF TANGENT	P. T.	
POINT ON TANGENT	P. O. T.	

TITLE	1"=	500'
TYPICAL	1"=	2'
PLAN	1"=	50'
PROFILE	1"=	50'
CROSS SECTIONS	1"=	5'

PROJECT NAME & NUMBER	TYPE	PAVEMENT AREA
CHELSEA-VERSHIRE S 176 (5)	STAR GR. BASE	3,530.5 S.Y.
RECORD PLANS		
MATERIALS		
SUB-BASE OF GRAVEL WHITE RIVER, SHARON, VT.	RCP	VT. CONC. PIPE CO. WINDSOR, VT.
CRUSHED GRAVEL WAITS RIVER, BRADFORD, VT.	ACCGMP	NEW ENG. MET. CULVERT CO. PALMER, M.
ASPHALT SOCONY VACUUM, RIVERMIDE, R.I.	FIBRE DRAIN PIPE	BROWN CO. BERLIN, N.H.
GUARD RAIL AM. STEEL & WIRE CO. NEW HAVEN, CT.	CEMENT	PORTLAND CEMENT CO. GLENS FALLS
CONC. AGG. COLONIAL SAYS & CO. SHARON, VT.		
CONTRACTOR WILLARD B. MARTIN, E. CORINTH, VT.	CONTRACT DATED	JUNE 16, 1952
RES. ENGINEER H.G. GAREIS - ROBERT FUNK	CONTRACT STARTED	JUNE 16, 1952
INSPECTOR RALPH JILLSON	CONTRACT COMPLETED	SEPT. 10, 1953
RECORD PLANS	CONTRACT ACCEPTED	SEPT. 10, 1953

THESE PLANS ARE SUBJECT TO SUCH REVISIONS AS MAY BE
REQUIRED BY THE BUREAU OF PUBLIC ROADS OR THE COM-
MISSIONER OF HIGHWAYS.

CONSTRUCTION IS TO BE CARRIED ON IN ACCORDANCE WITH
THE PLANS AND THE STANDARD ROAD AND BRIDGE SPECIFICATIONS
OF 1948, AS APPROVED JULY 25, 1949 BY THE BUREAU
OF PUBLIC ROADS INCLUDING ALL SUBSEQUENT APPROVED
REVISIONS AND SUCH REVISED SPECIFICATIONS AND SPECIAL
PROVISIONS AS ARE SUBMITTED WITH THE PLANS.

DEPARTMENT OF COMMERCE
BUREAU OF PUBLIC ROADS

RECOMMENDED FOR APPROVAL

DISTRICT ENGINEER DATE


APPROVED

DIVISION ENGINEER DATE


APPROVED <u>MAY 23, 1952</u> <u>H. P. Sargent</u> DISTRICT ENGINEER	APPROVED <u>MARCH 17, 1952</u> <u>H. P. Sargent</u> CONSTRUCTION ENGINEER	APPROVED <u>MARCH 17, 1952</u> <u>H. P. Sargent</u> SECONDARY ENGINEER	APPROVED <u>MARCH 17, 1952</u> <u>H. P. Sargent</u> HIGHWAY ENGINEER	APPROVED <u>MAY 23, 1952</u> <u>H. P. Sargent</u> DISTRICT ENGINEER (ACTING)
---	---	--	--	--


PROJECT 5 NO. 176(5) FILED
SHEET 1 OF 53

PLAN	COVERED	BY	DATE
NOTE BOOK	PLATTED	<i>Spaulding</i>	<i>12-31</i>
NO.	ALIGNMENT CHECKED	<i>Palmer</i>	<i>1-32</i>
	BY, OF NEW CHECKS	<i>Troced</i>	

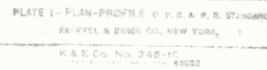

CHelsea-VERSHIRE
Project S No 176(5)
Sheet 11 of 53

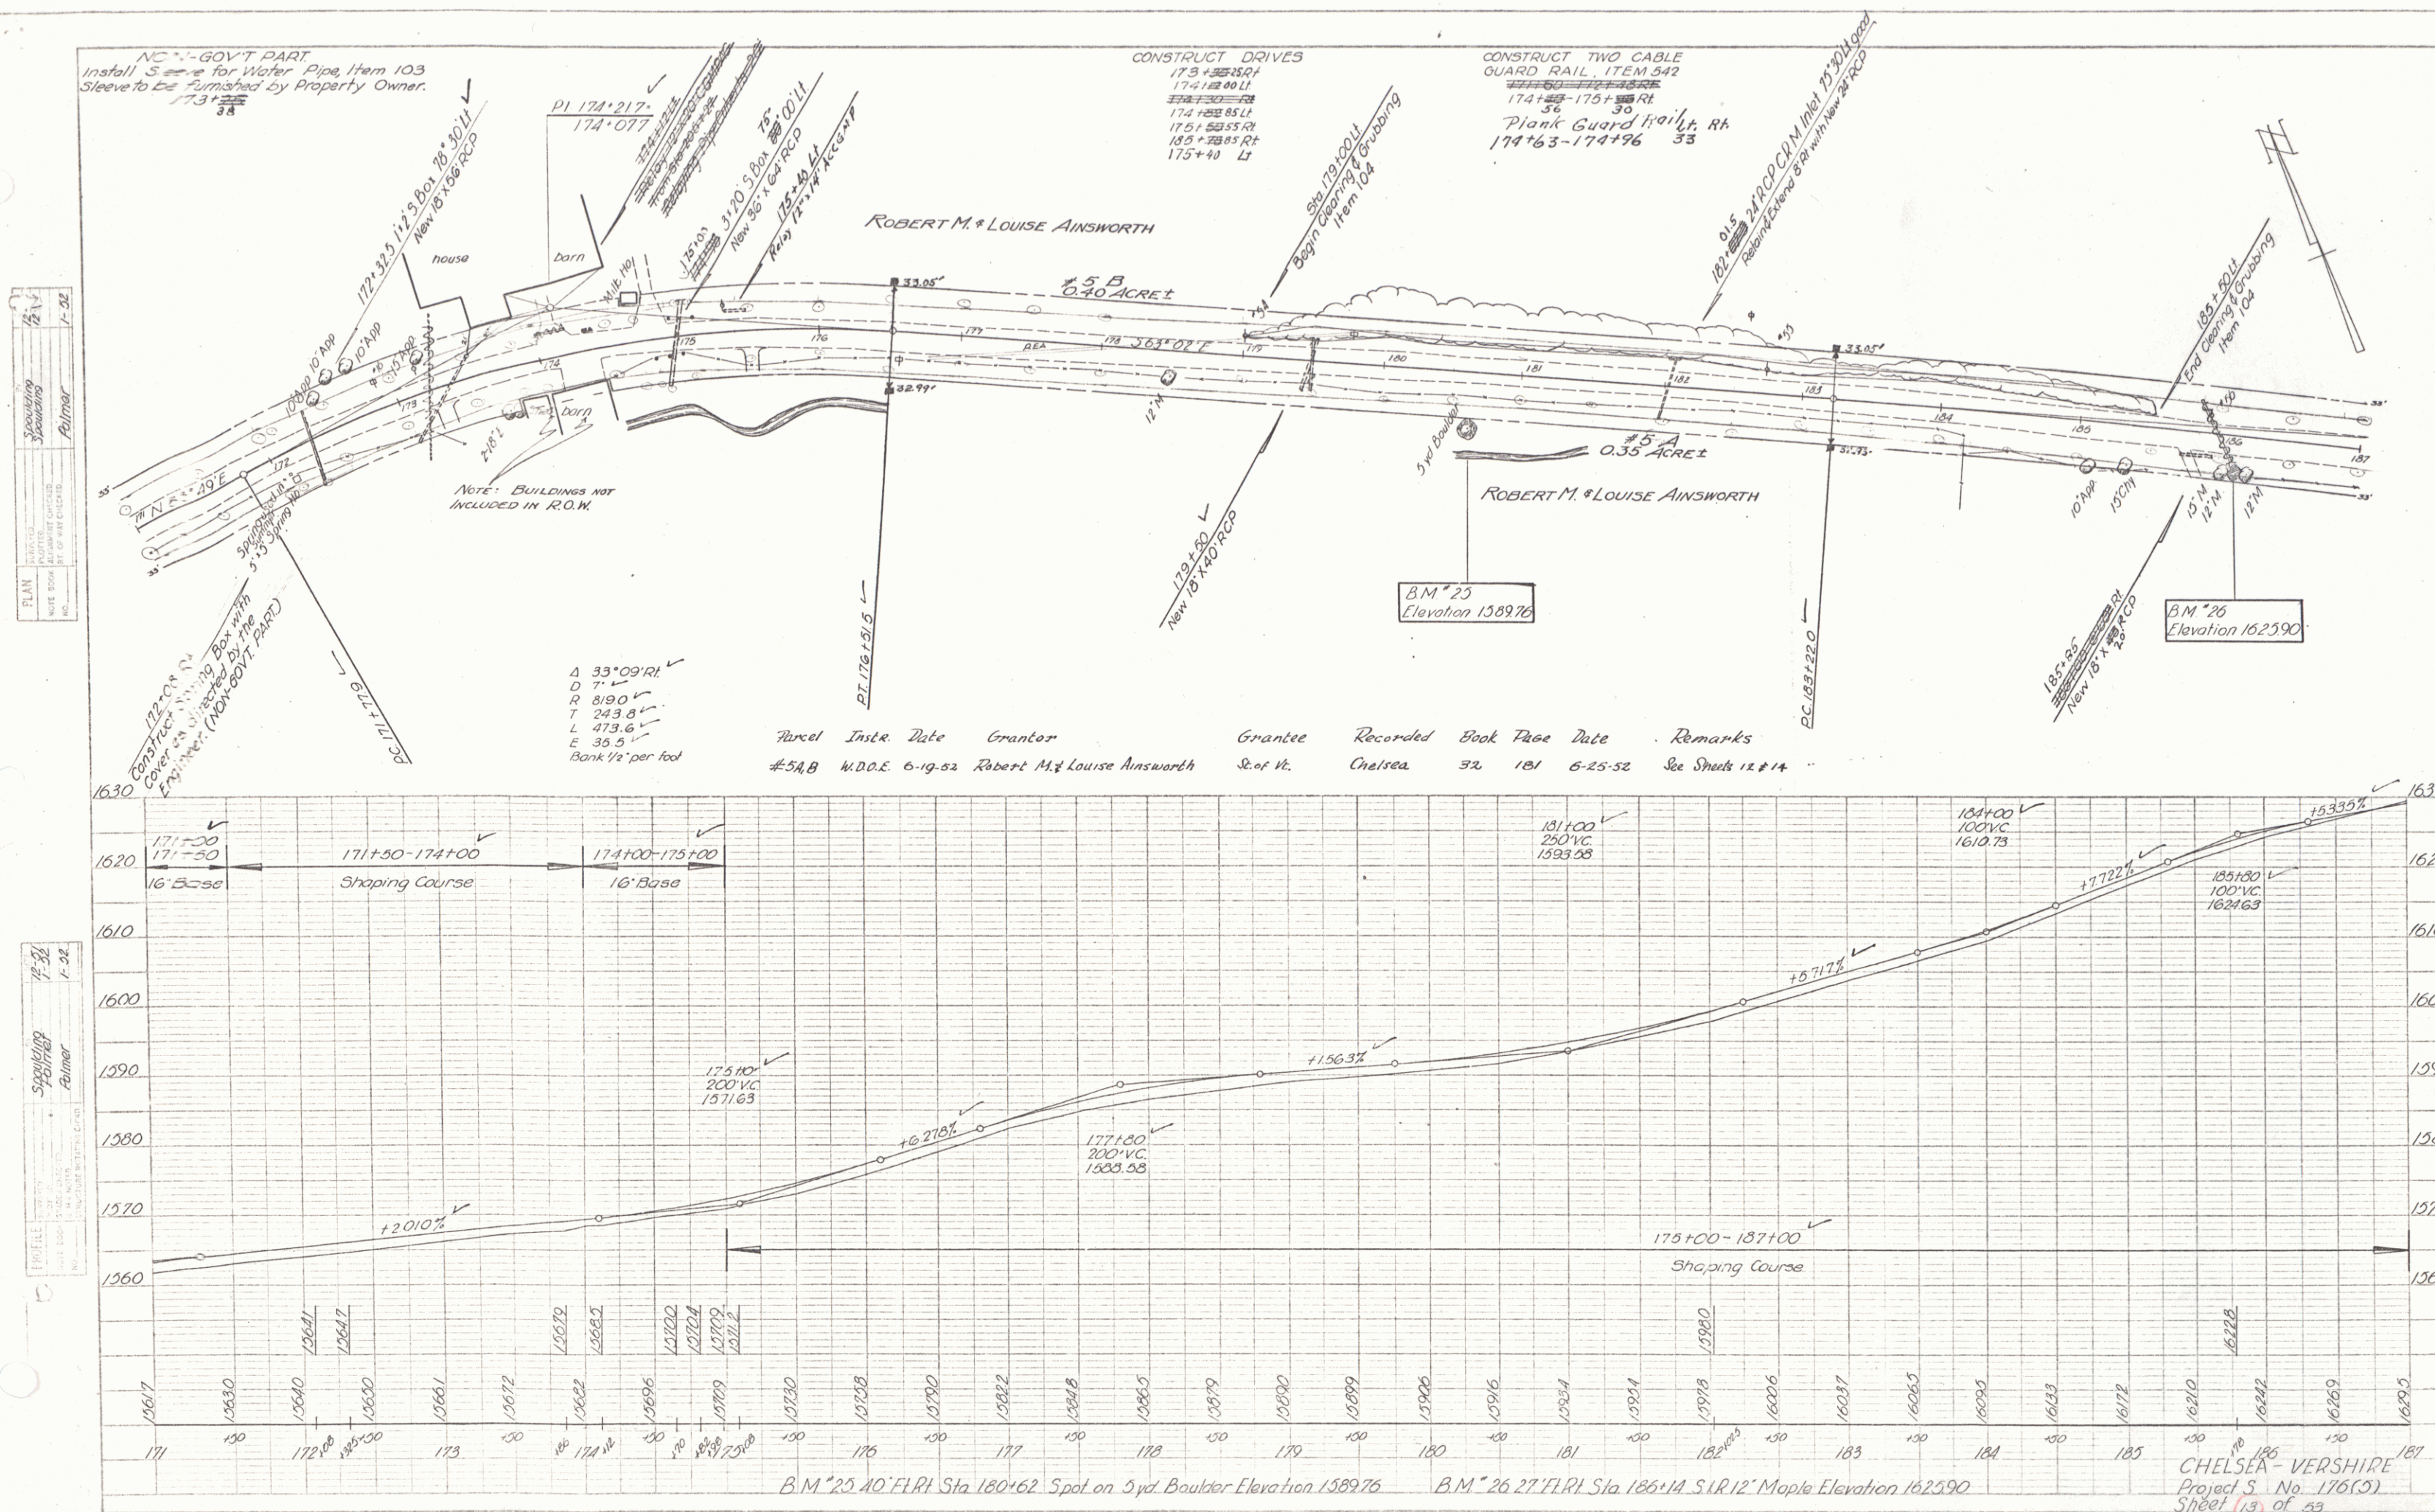

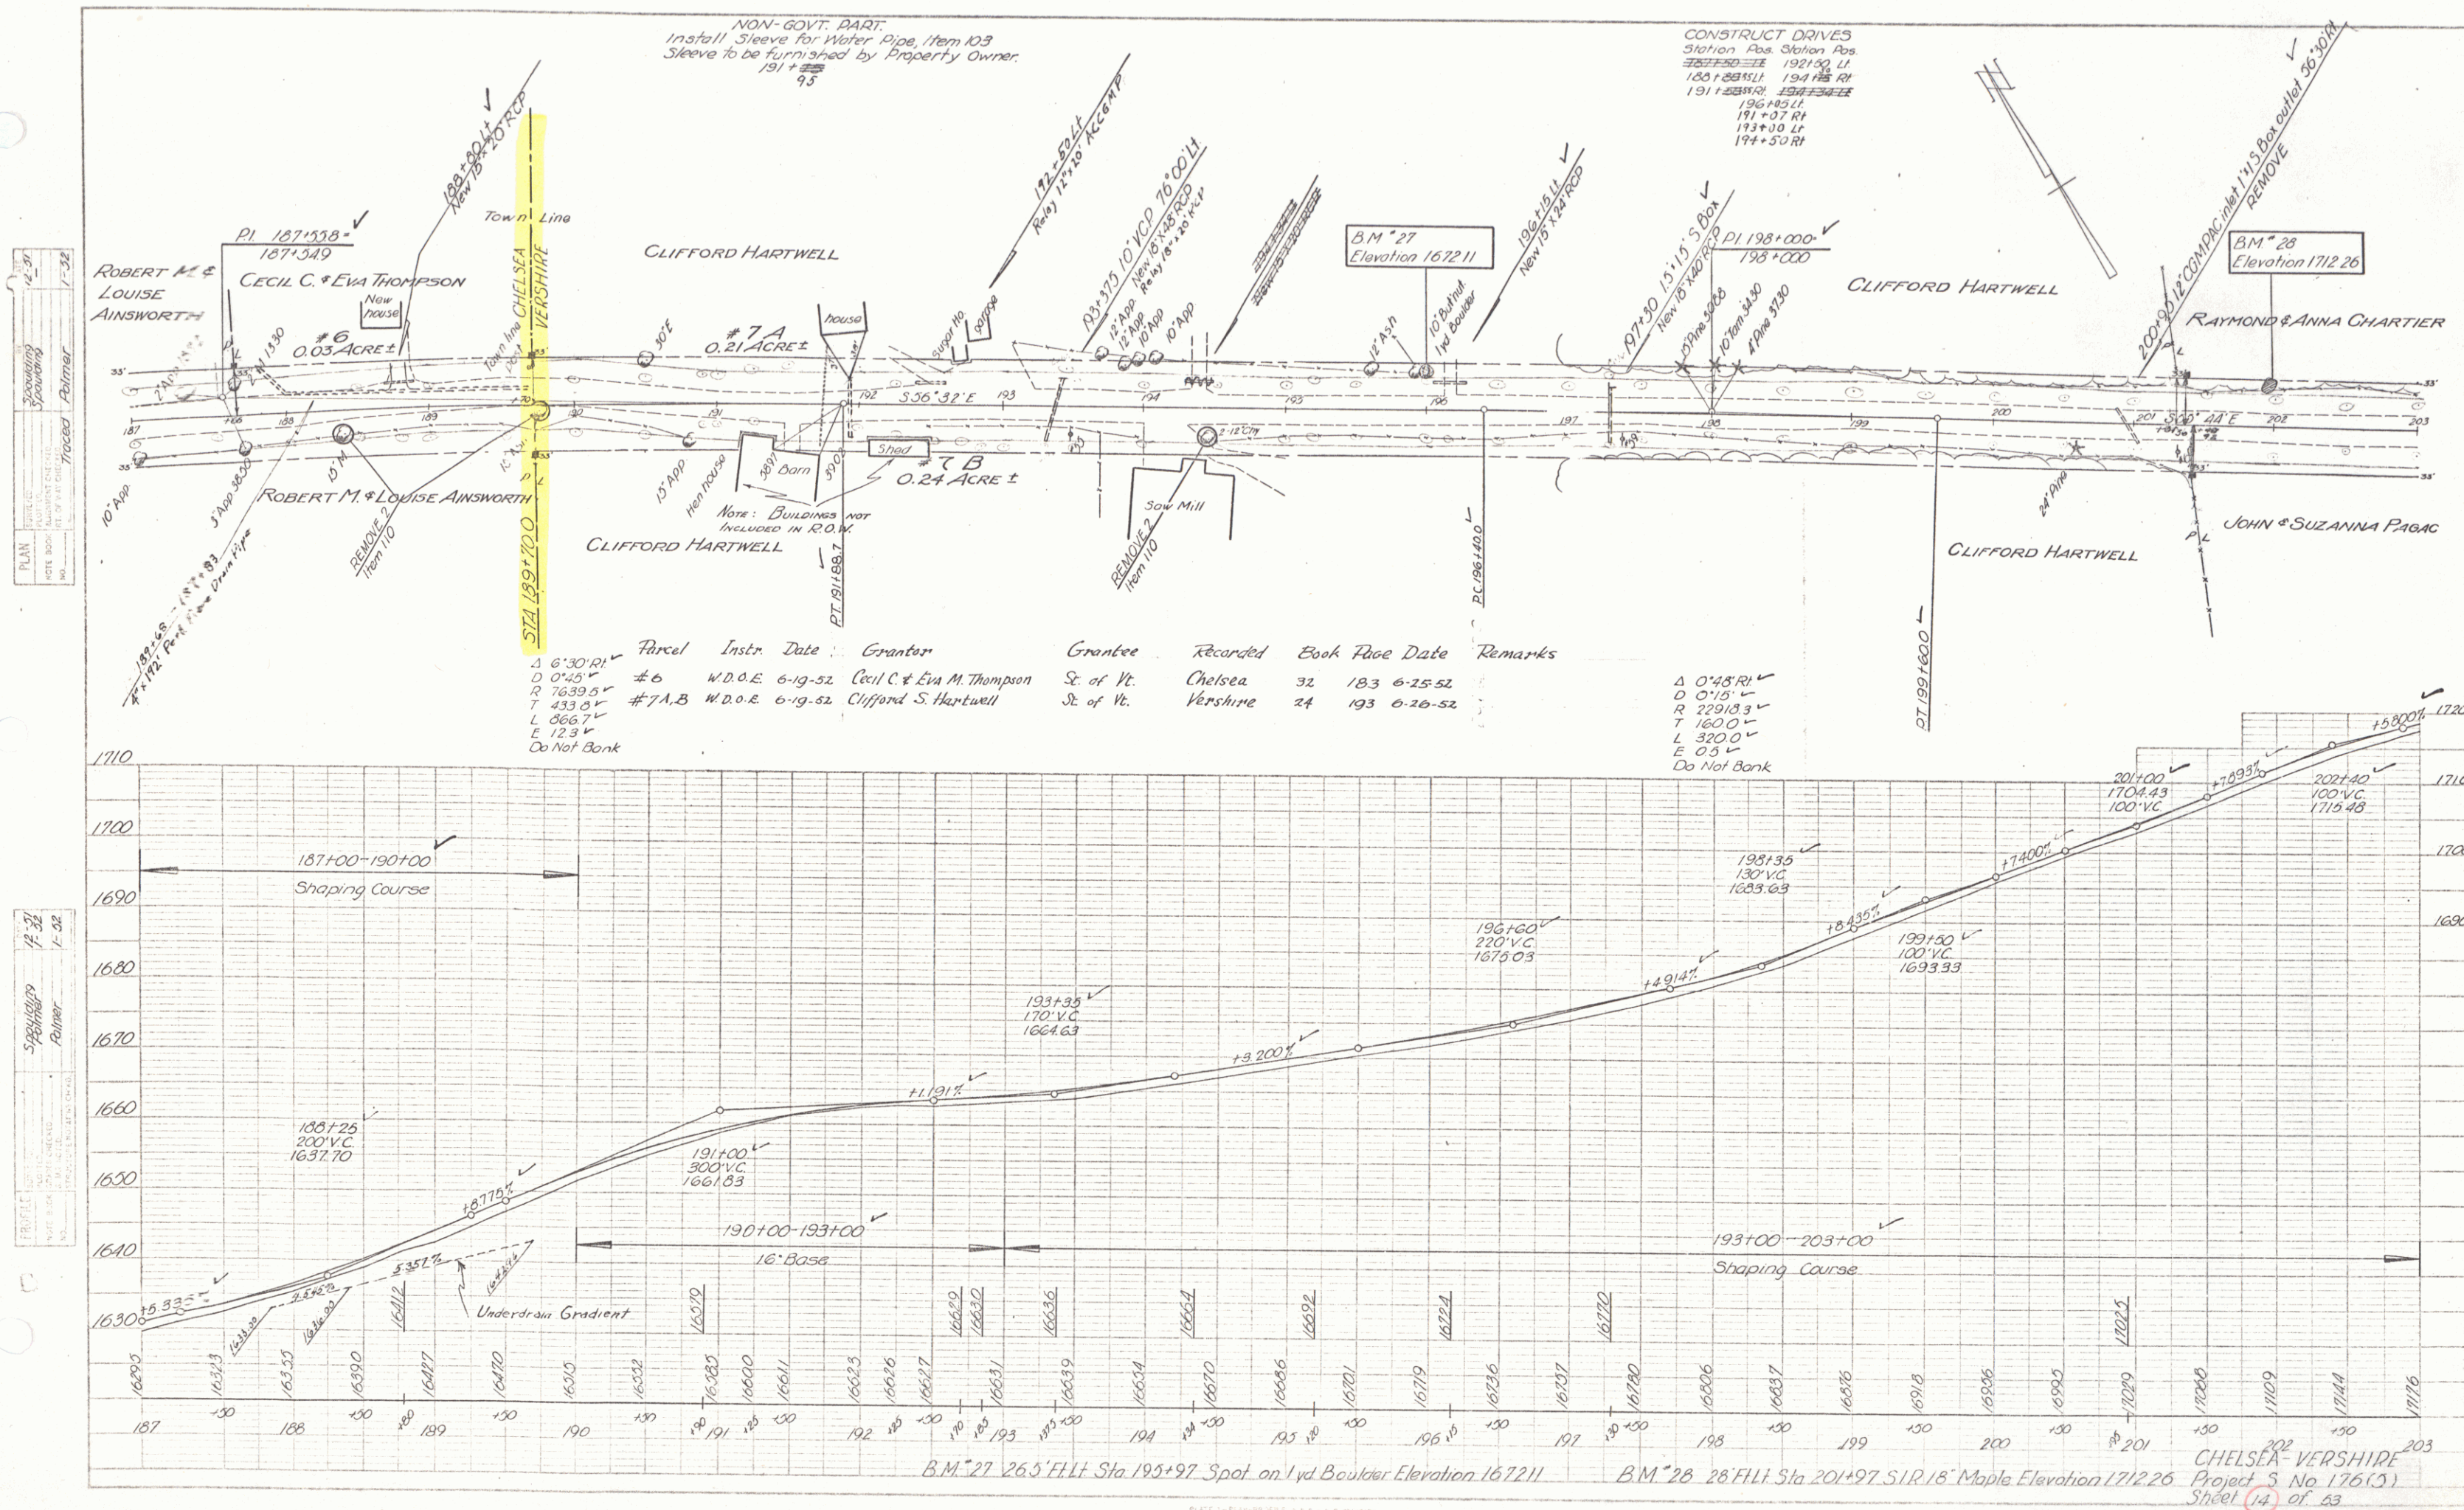


Parcel	Inste	Date	Grantor	Grantee	Recorded	Book	Page	Date	Remarks
#8A.E.C.	W.D.O.E.	6-19-52	Raymond & Anna Chartier	St. of Vt.	Vershire	24	191	6-26-52	See Sheets 14 & 16
#9	W.D.O.E.	6-19-52	John & Suzanna Pagac	St. of Vt.	Vershire	24	201	6-26-52	See Sheet 16

CONSTRUCT DRIVES
Station Pos
212+00 RT
204+75 LT
209+45 RT
216+60 LT


NON-GOV'T. PART
Install Sleeve for Water Pipe Item 103
Sleeve to be furnished by Property Owner.
219+00

Δ 25'51" LI
D 5'5"
R 1146.3
T 242.1
L 477.0
E 25.3
Bank 1/2" per foot


PLAN
SHEET NO. 15
DATE 1-30-53
BY J. H. HARRIS

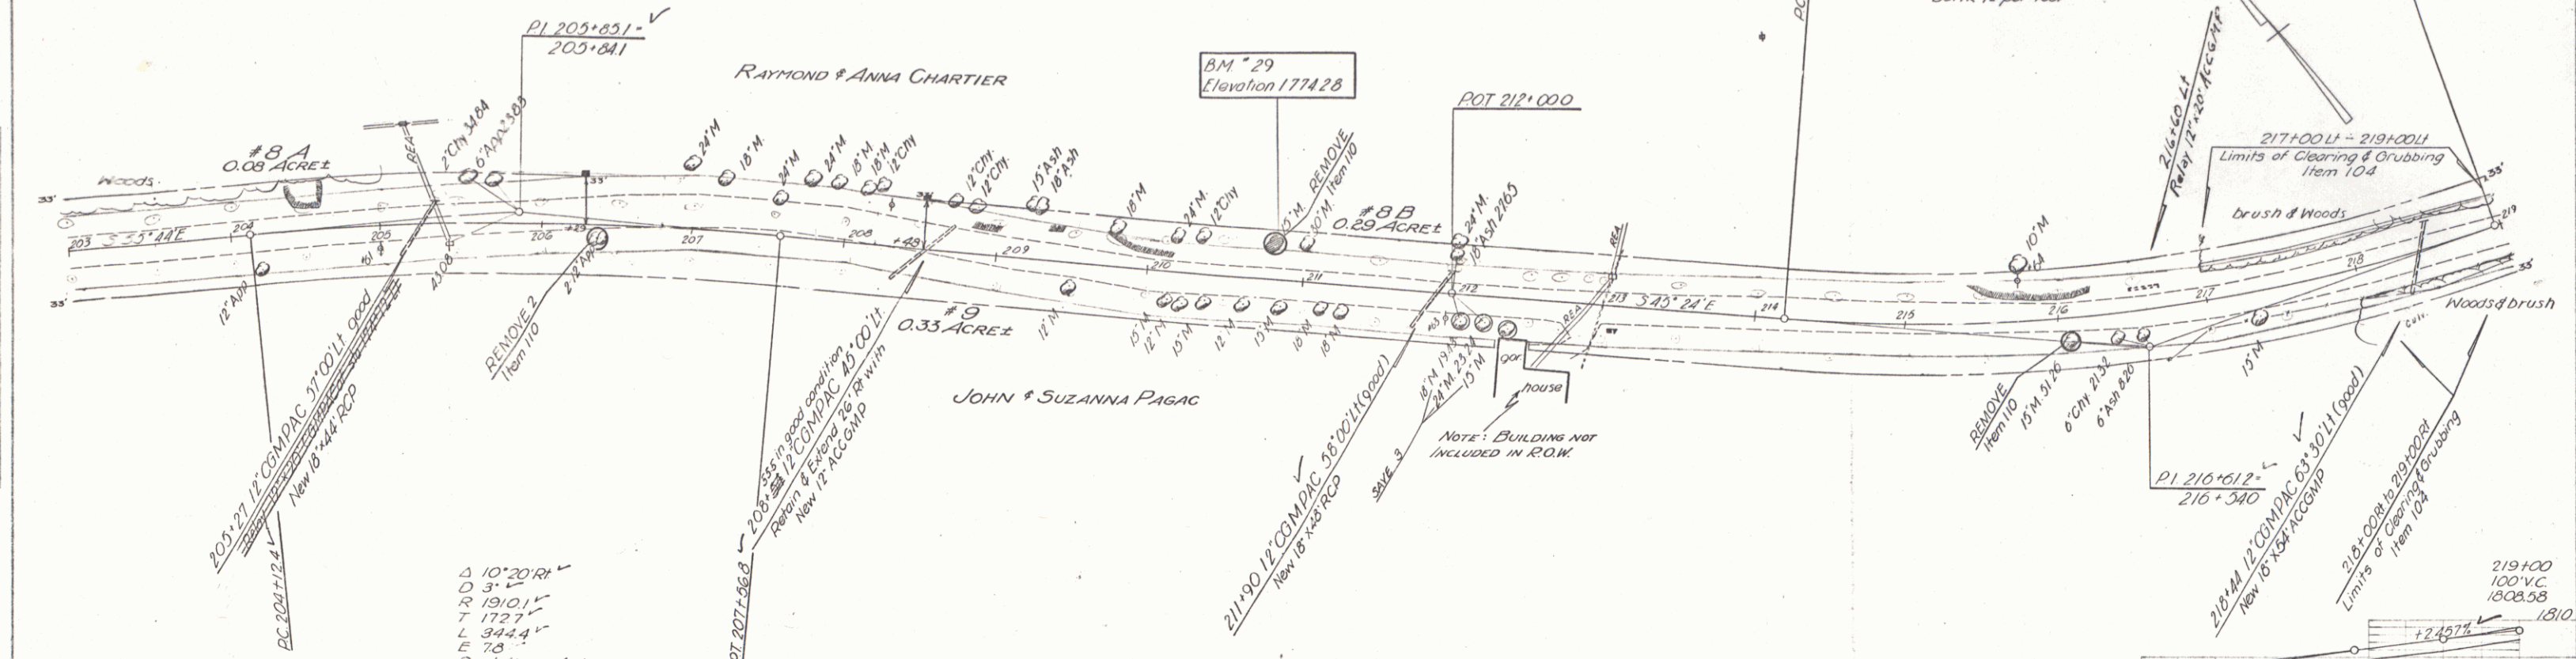

PROFILE
SHEET NO. 16
DATE 1-30-53
BY J. H. HARRIS

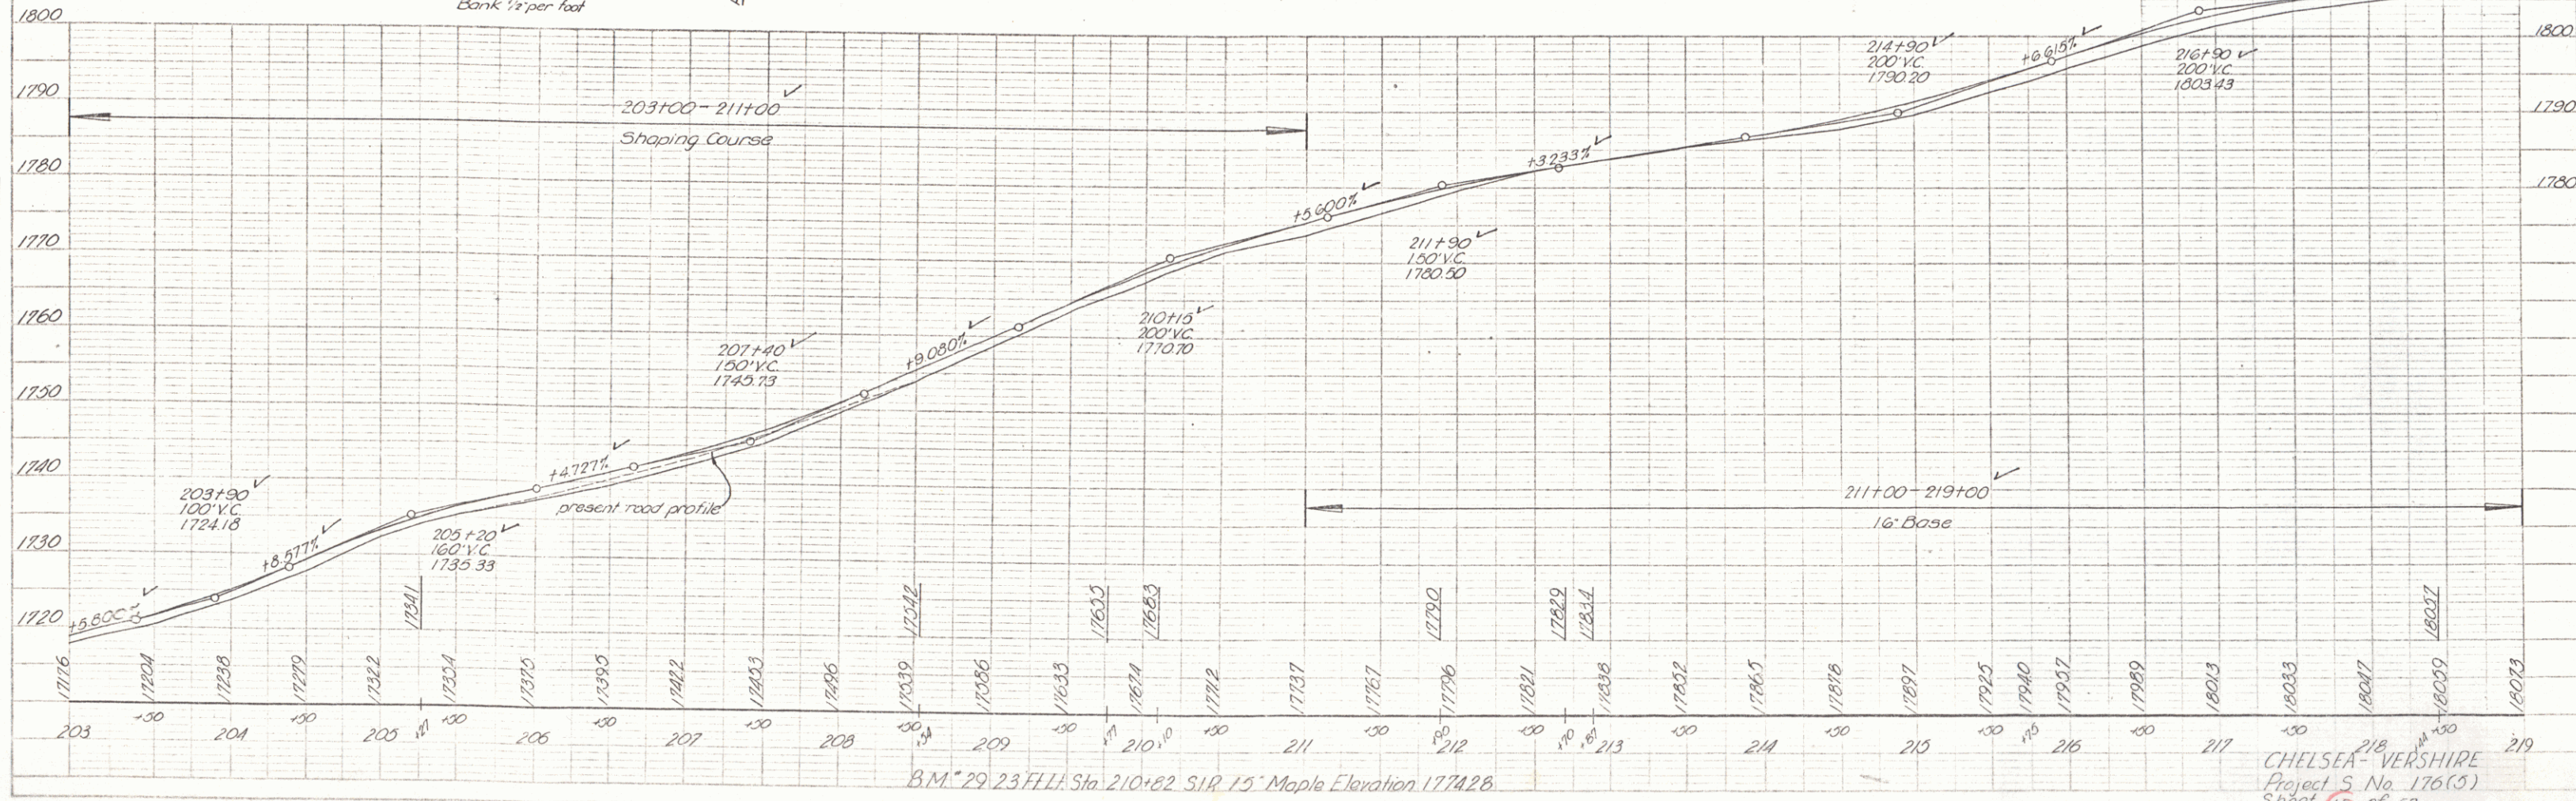


CHELSEA - VERSHIRE
Project 5, No. 176(3)
Sheet 15 of 33

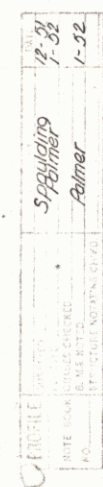

PLAN
 1" = 30'
 1-02
 S. J. Palmer
 1-02

ELEVATION
 1" = 30'
 1-02
 S. J. Palmer
 1-02

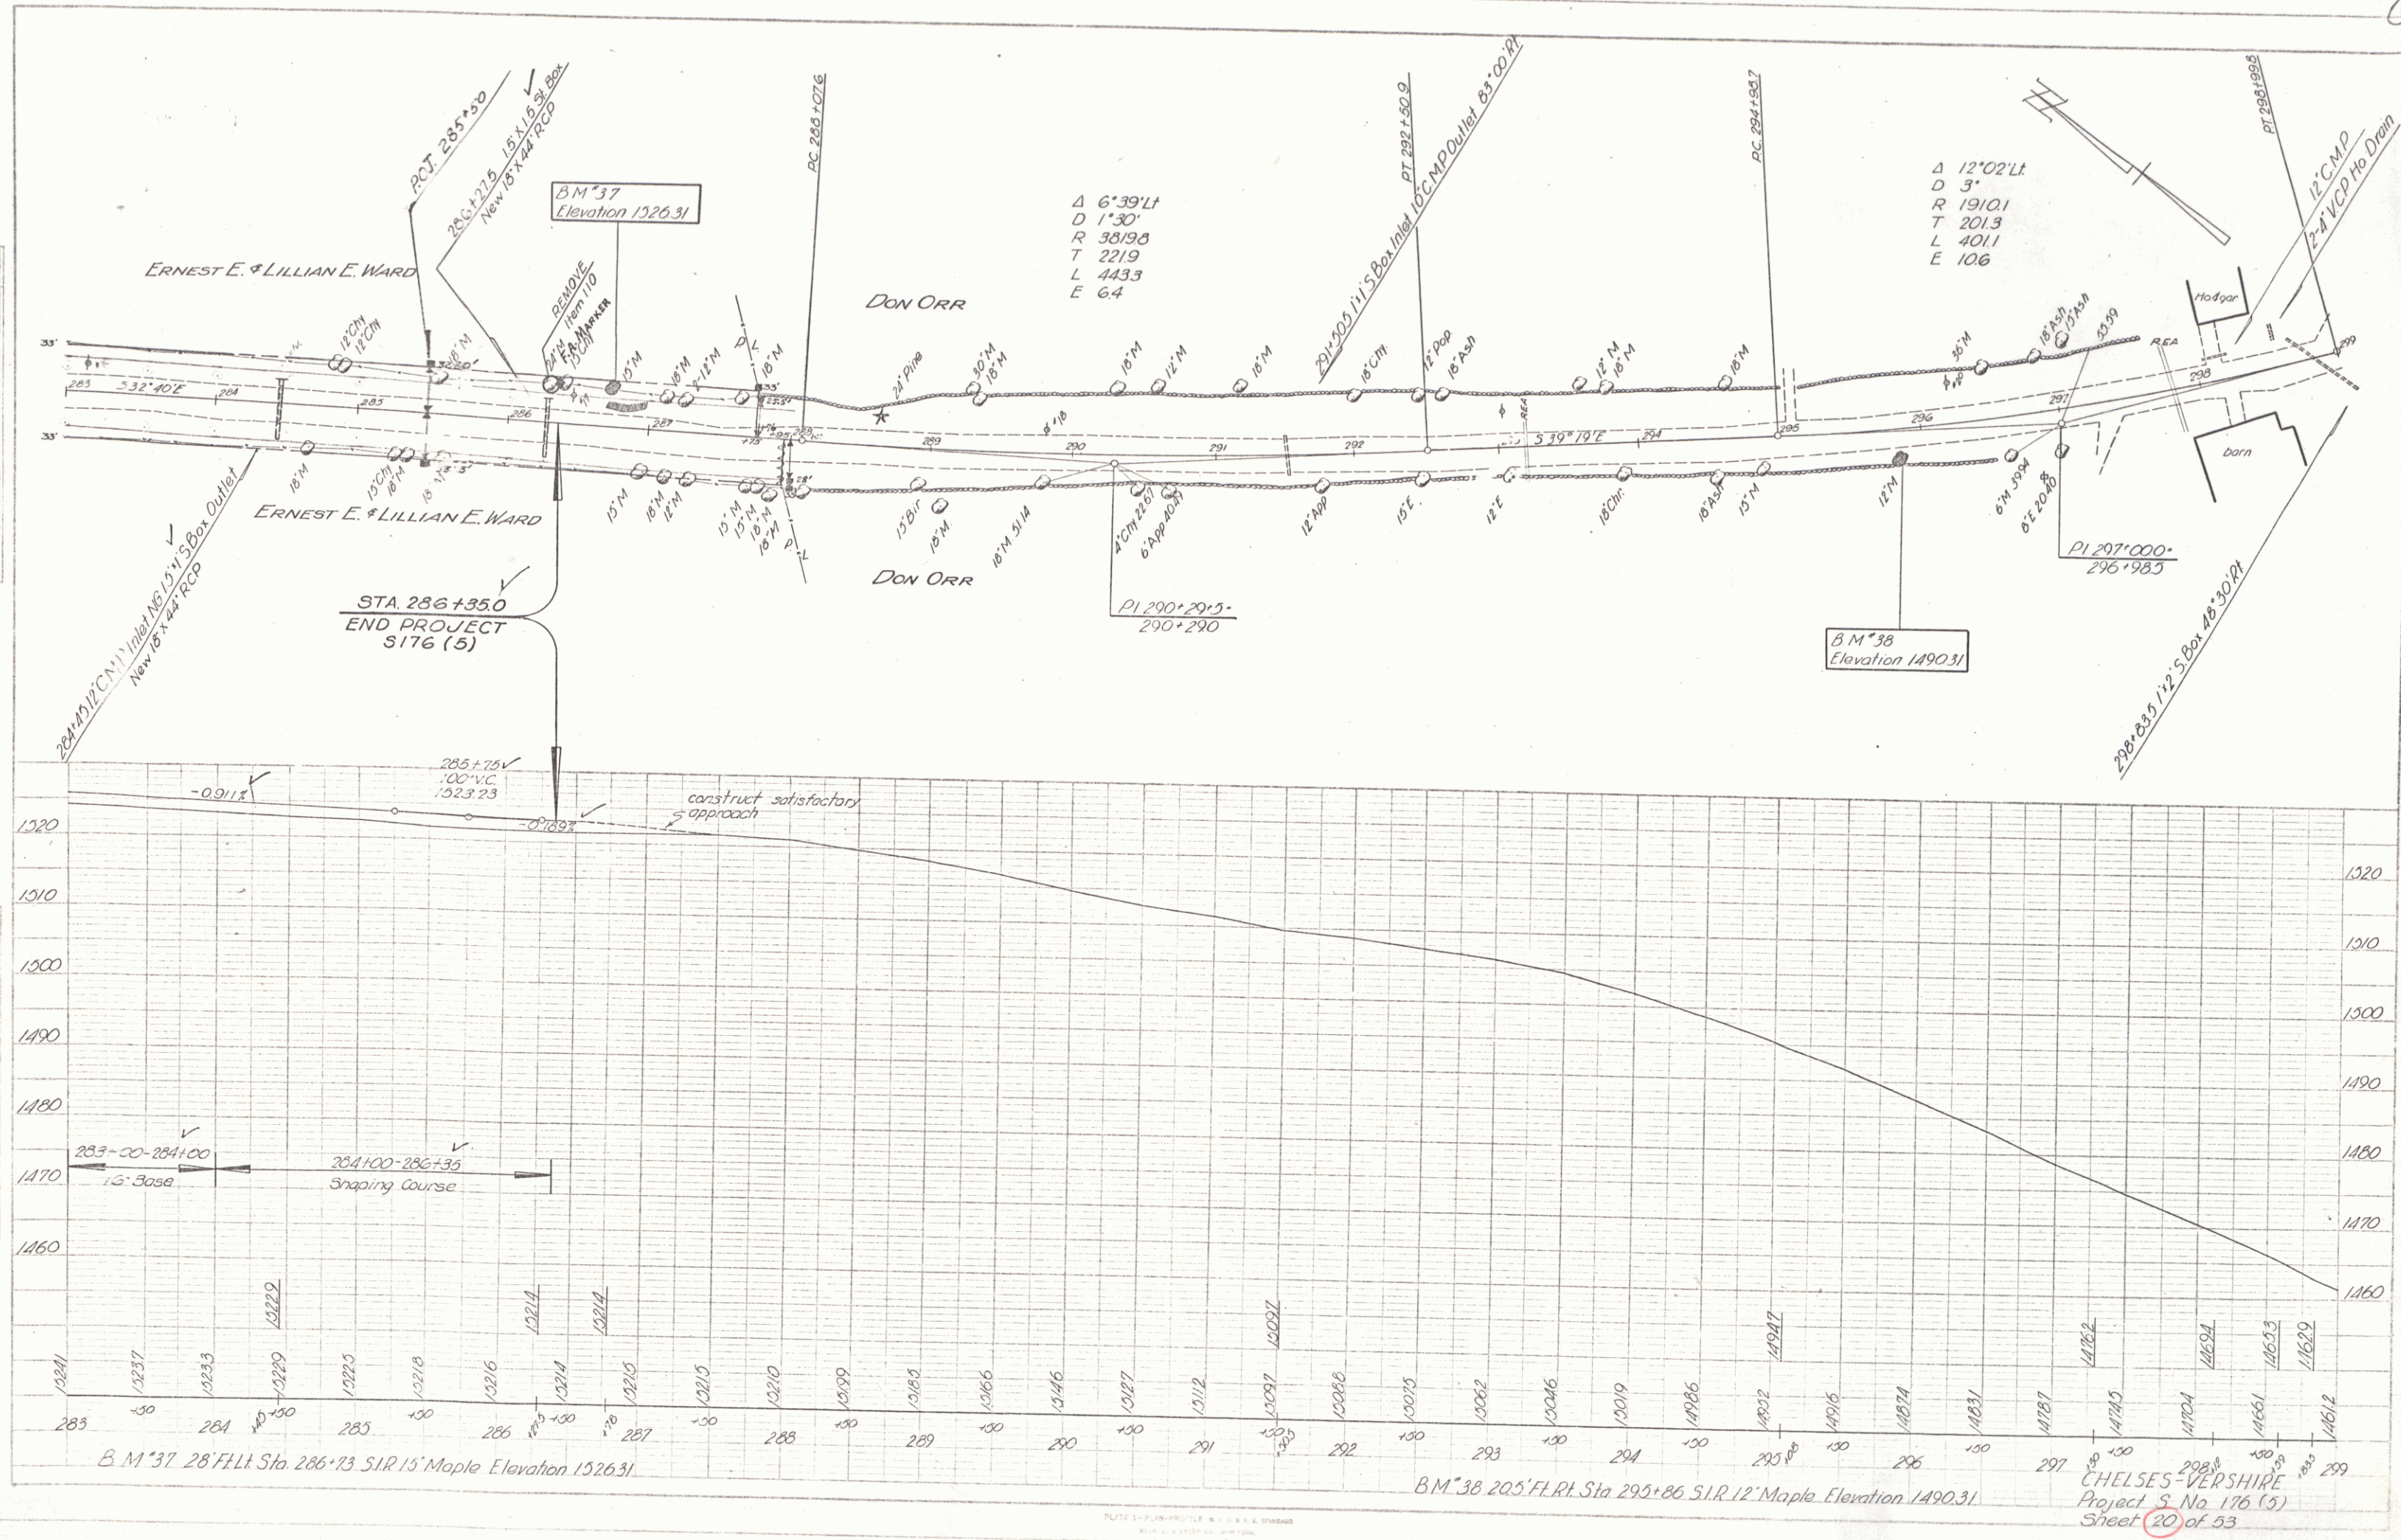

CHELSEA-VERSHIRE
 Project S No. 176 (5)
 Sheet 20 of 53