


PLAN	NOTED	BY	DATE
NOTE BOOK	NO. OF WAT. CHECKED		

PROFILE	NOTED	BY	DATE
NOTE BOOK	NO. OF WAT. CHECKED		

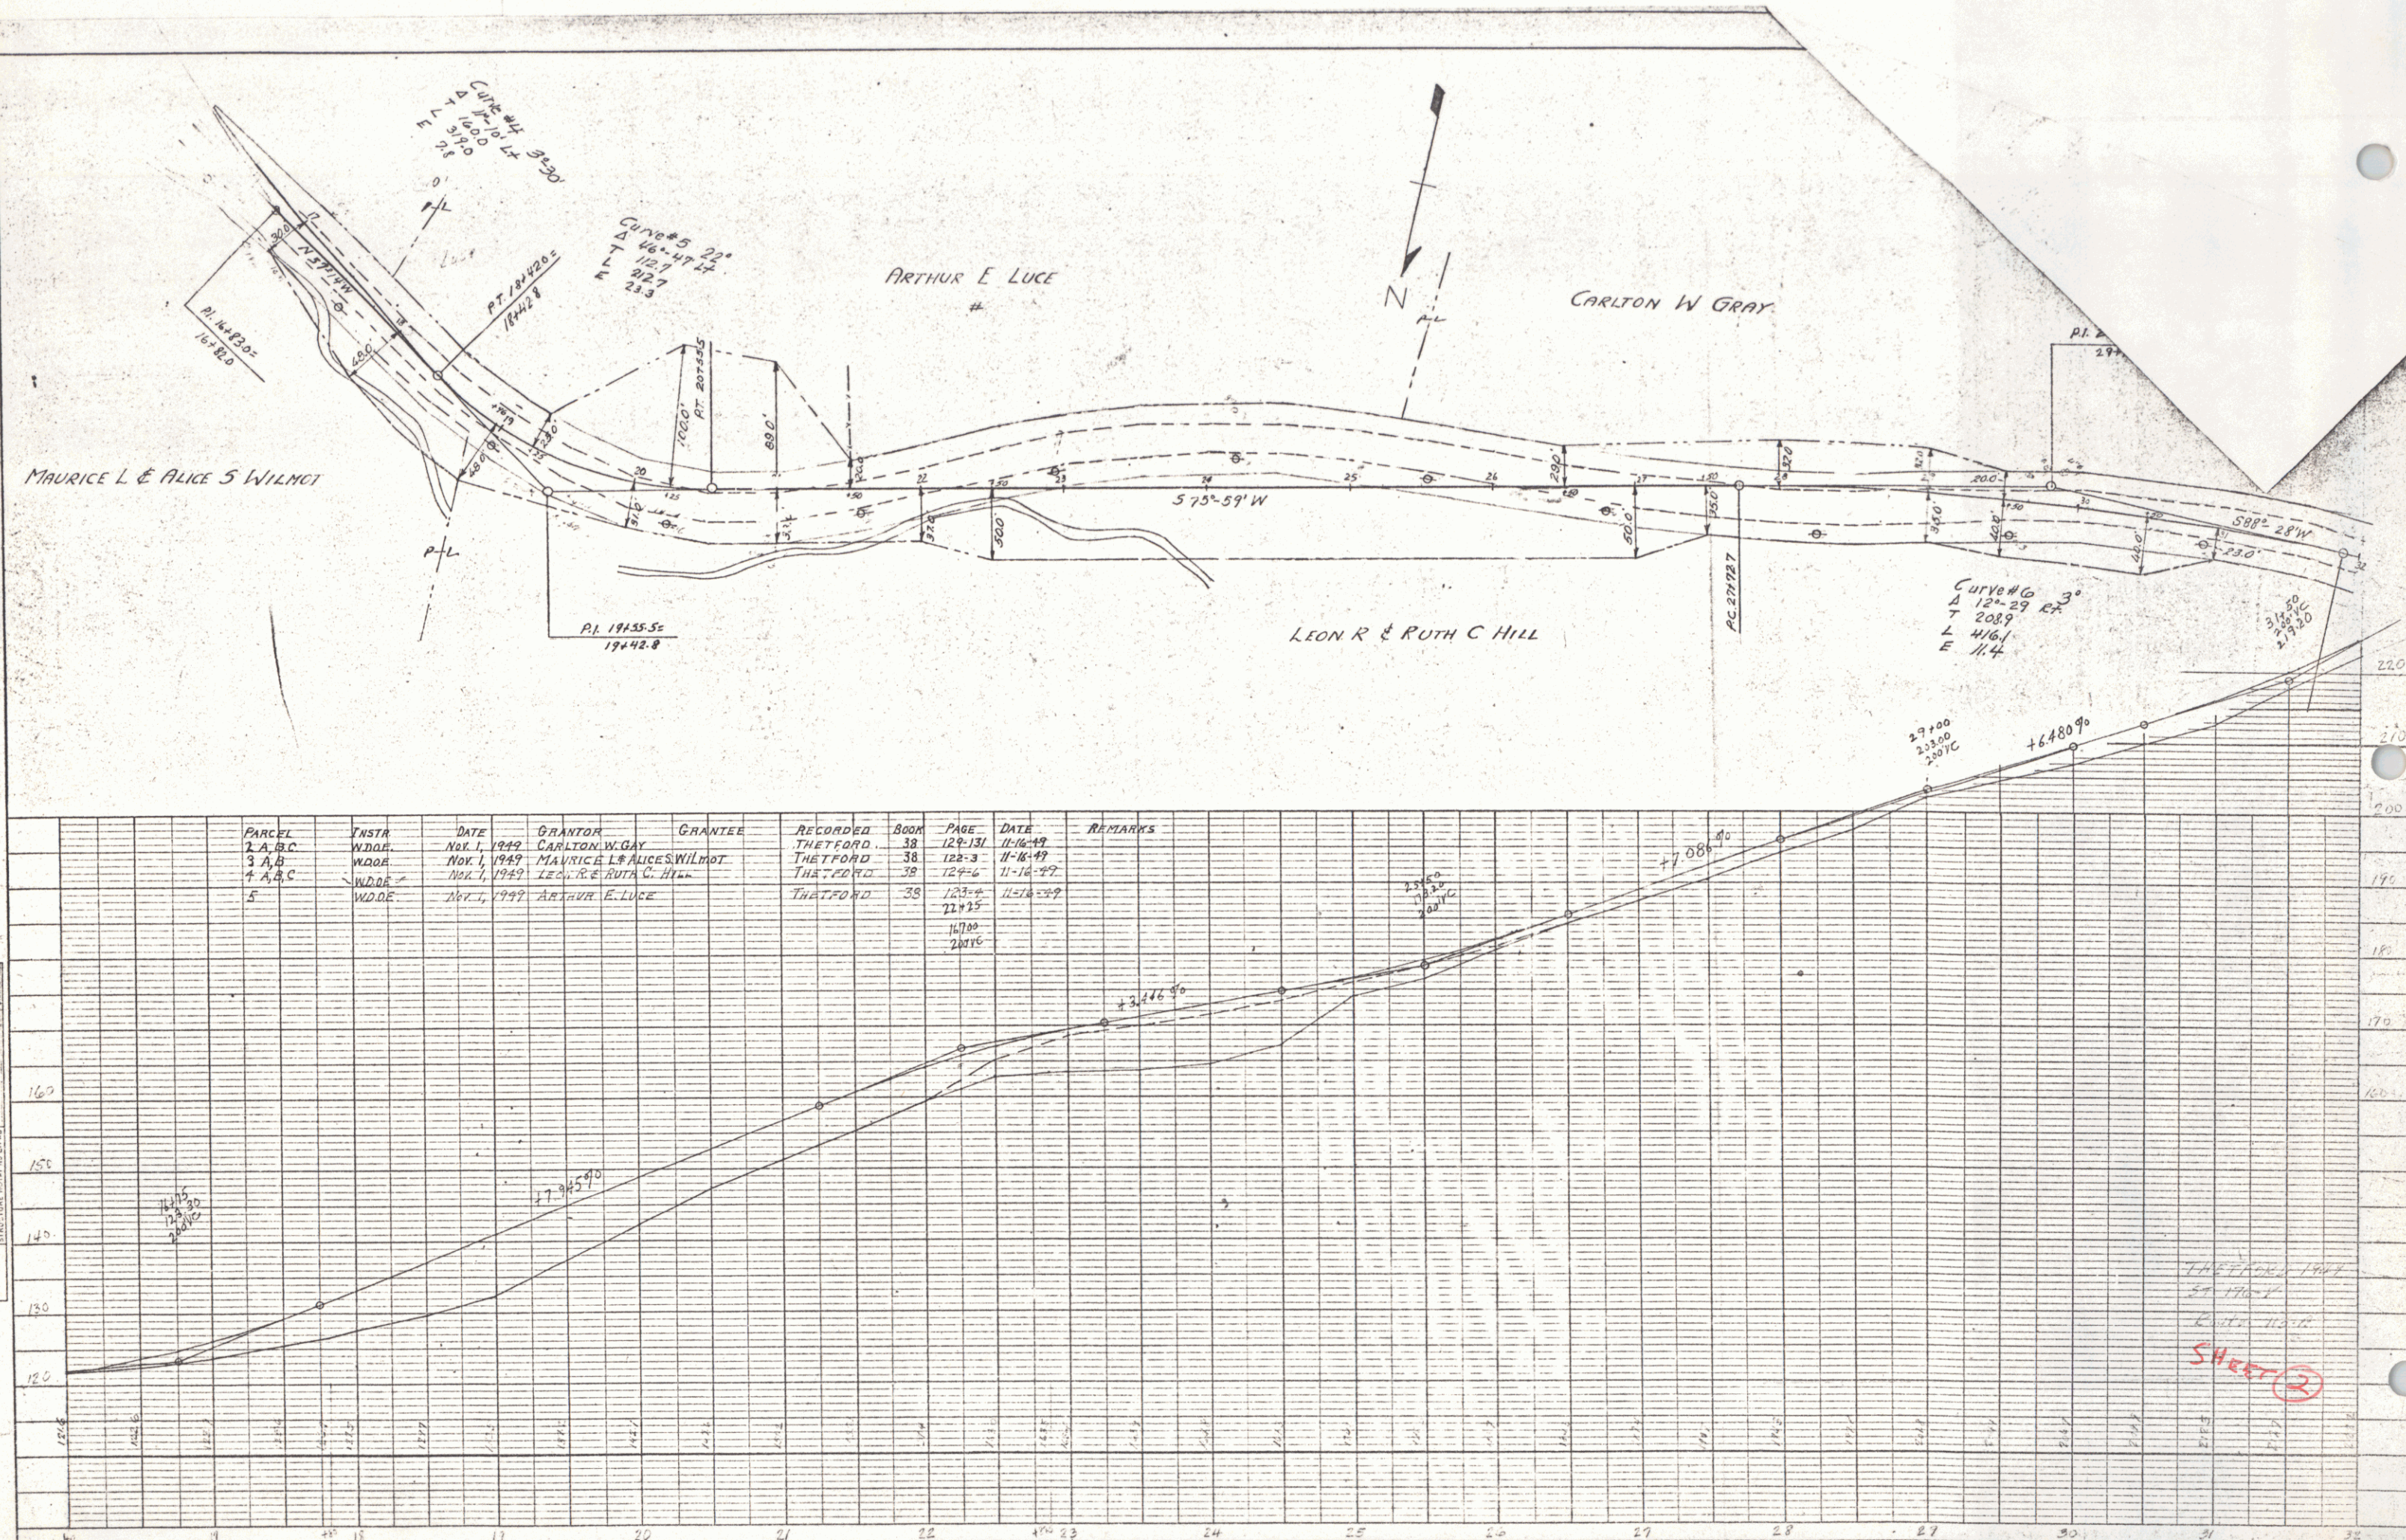

PLAN	DATE	
	BY	
	DESIGNED	
	NOTED	
CHECKED REVISIONS NO. OF SHEETS		

PROFILE	DATE	
	BY	
	DESIGNED	
	NOTED	
CHECKED REVISIONS NO. OF SHEETS		


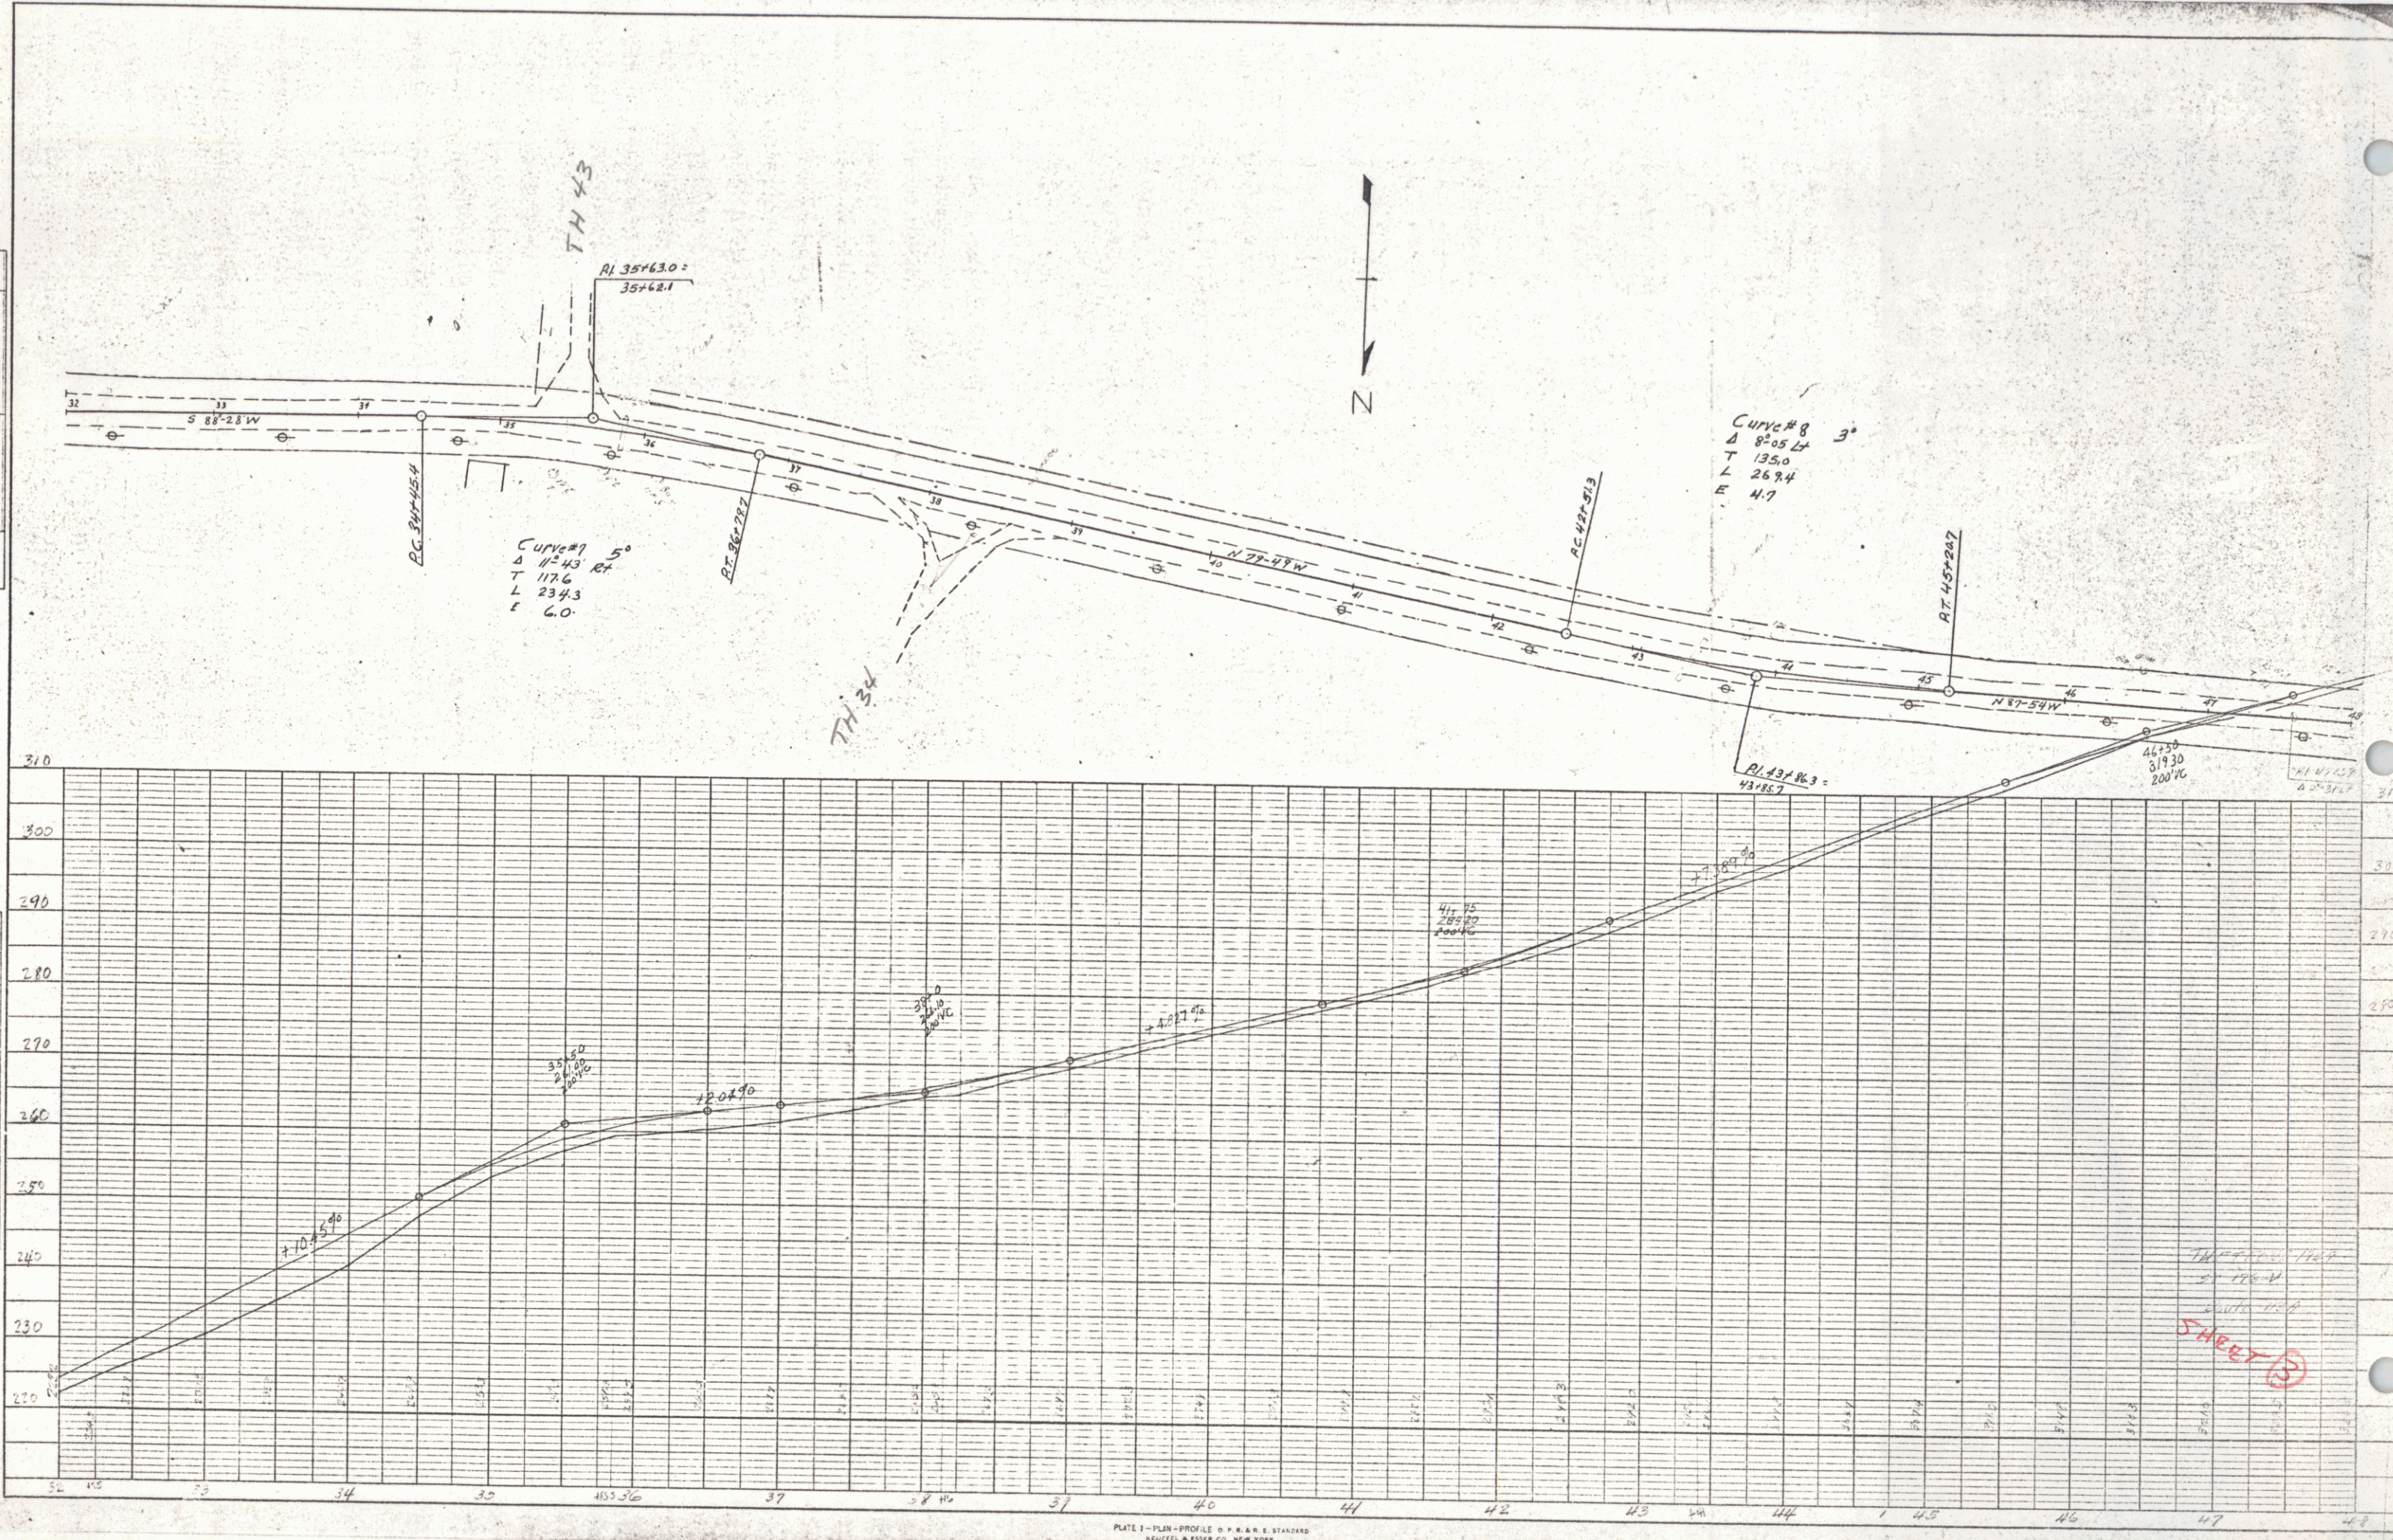


PLATE 1 - PLAN-PROFILE D. P. M. & S. STANDARD
ACUFFEL & ESSER CO. NEW YORK

IN REPLY TO
SHEET 13

PLAN	DATE	
	BY	
PROFILE	DATE	
	BY	

PROFILE	DATE	
	BY	

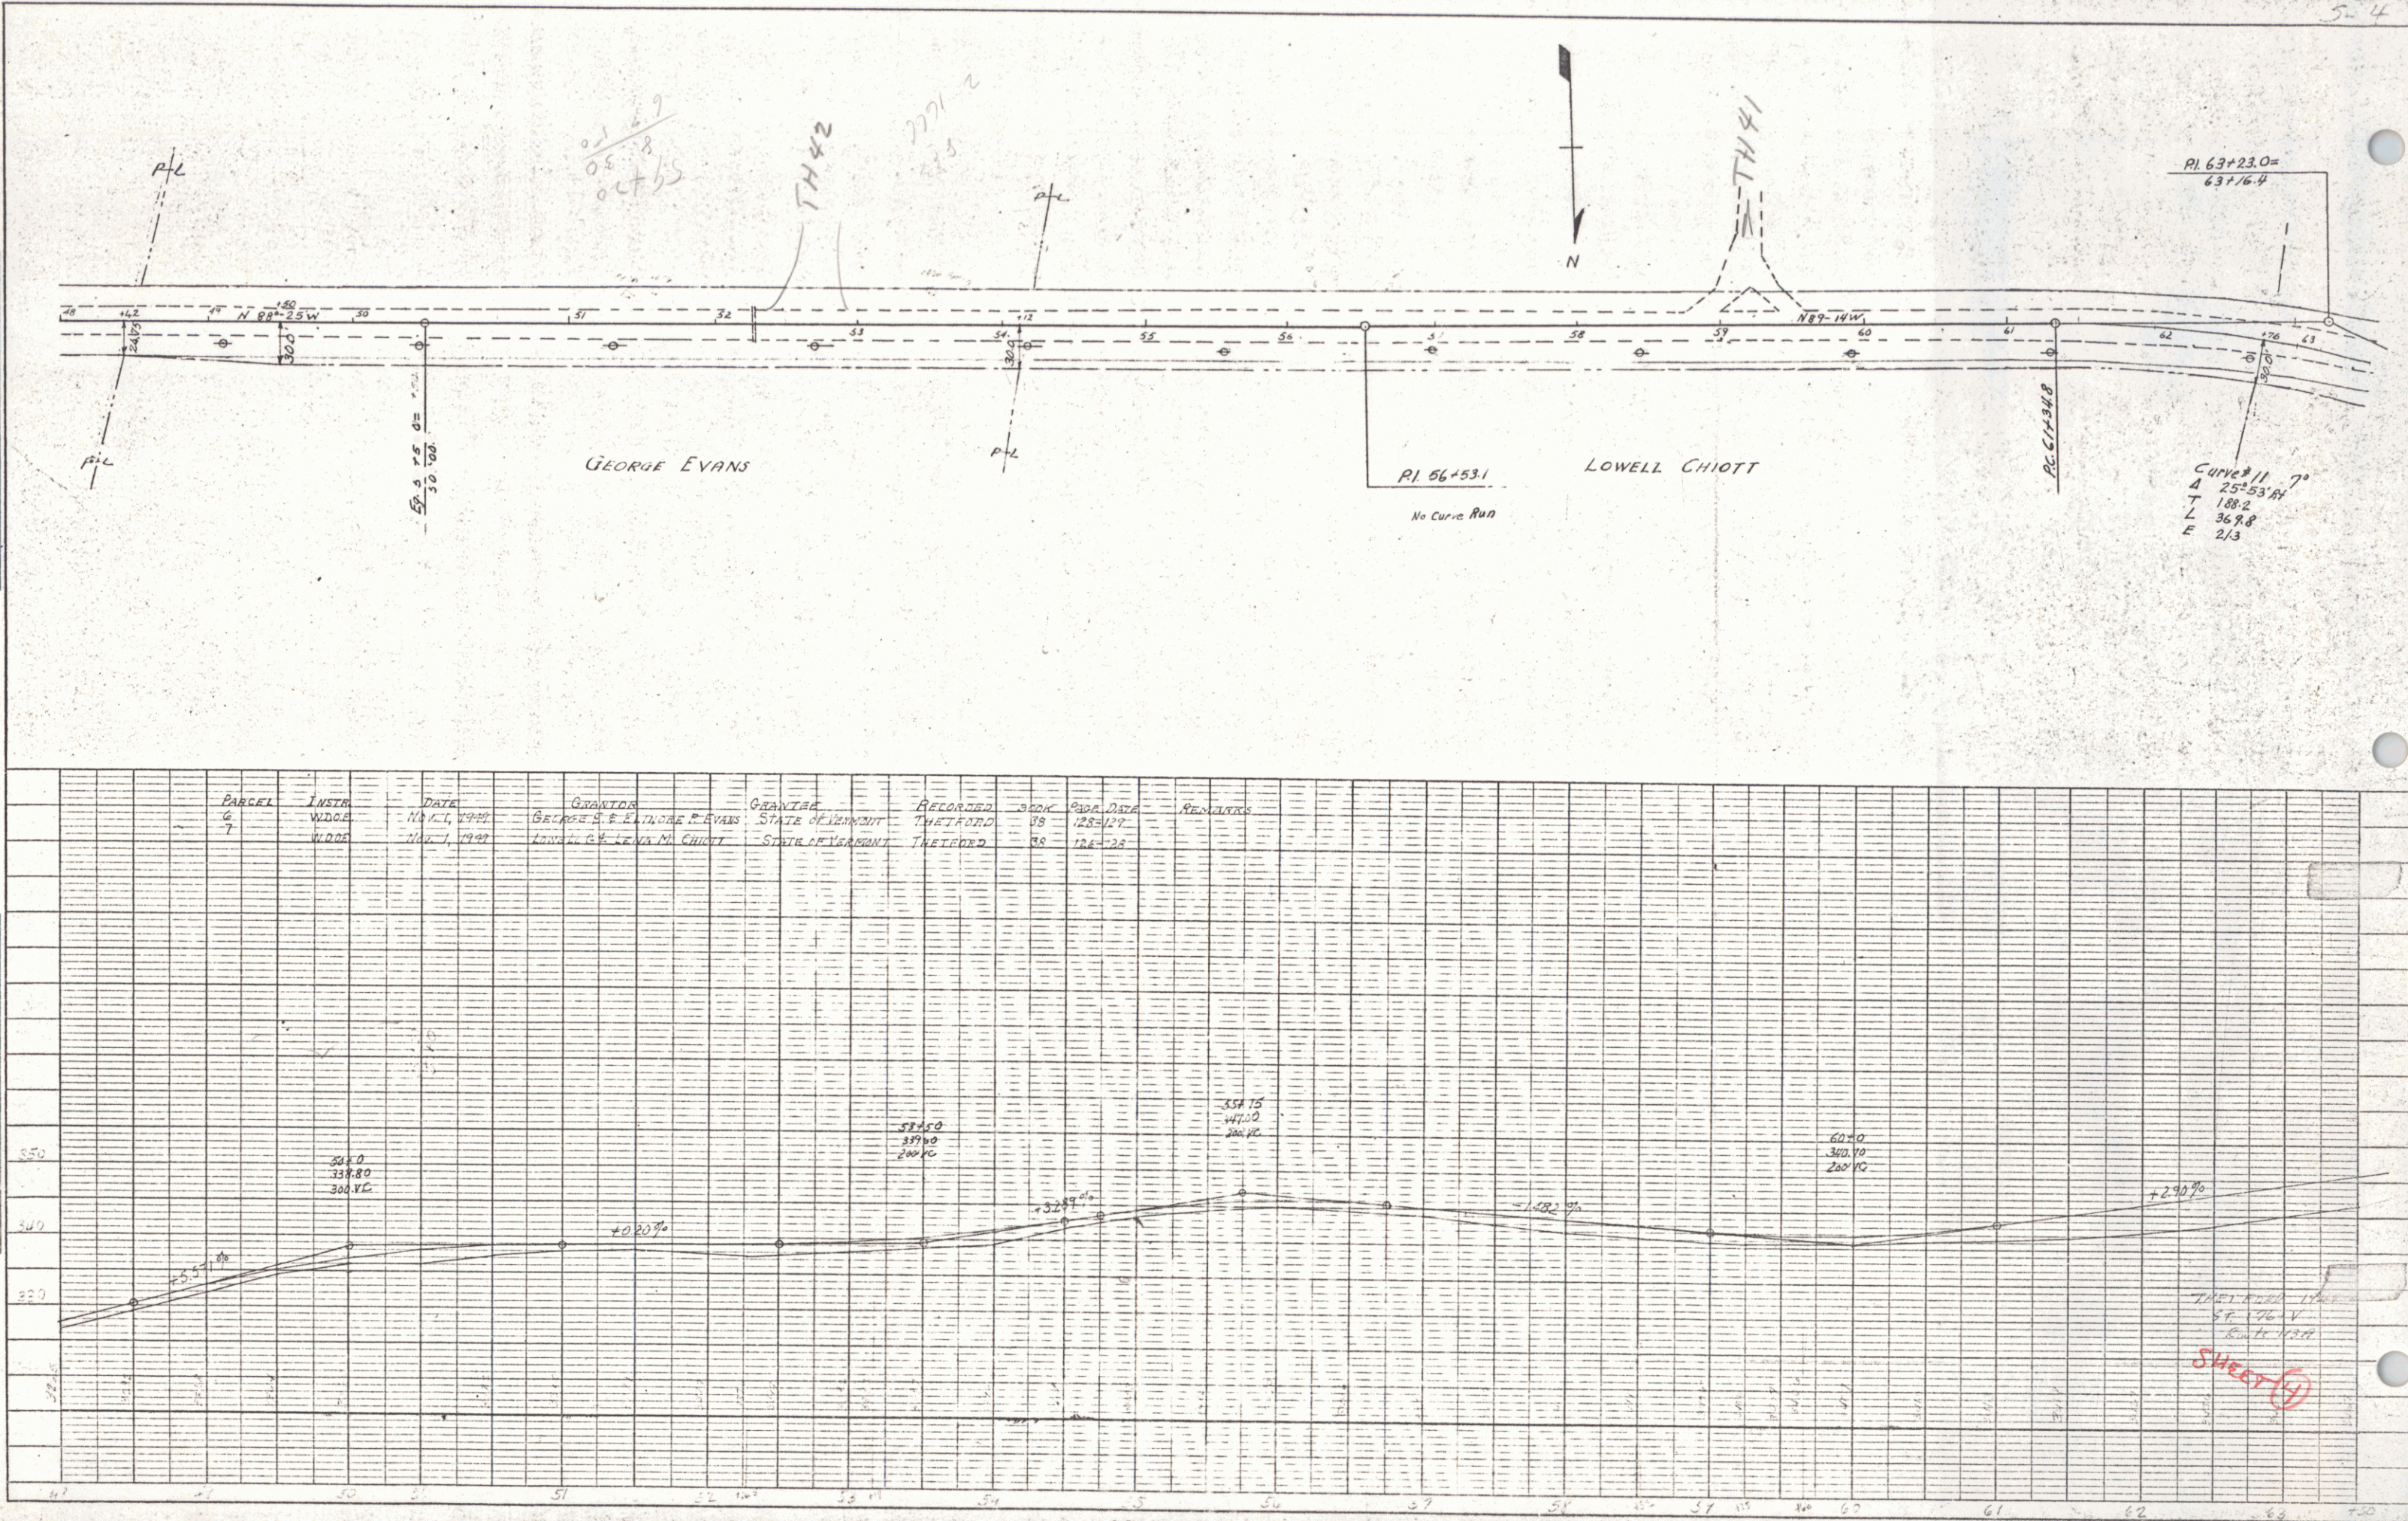

PI 63+23.0 = 637.64

Curve #11 7°
 A 25°53' 41"
 T 188.2
 L 369.8
 E 2/3

PI 56+53.1
 No Curve Run

THESE NOTES
 ARE FOR THE
 ROUTE 112.4
 SHEET 4

PLATE 1 - PLAN - PROFILE
 KUTNER & KUTNER, INC., NEW YORK

PLAN	SURVEYED	DATE
	NOTED BOOK	BY
PROFILE	SURVEYED	DATE
	NOTED BOOK	BY

PROFILE	SURVEYED	DATE
	NOTED BOOK	BY
PLAN	SURVEYED	DATE
	NOTED BOOK	BY


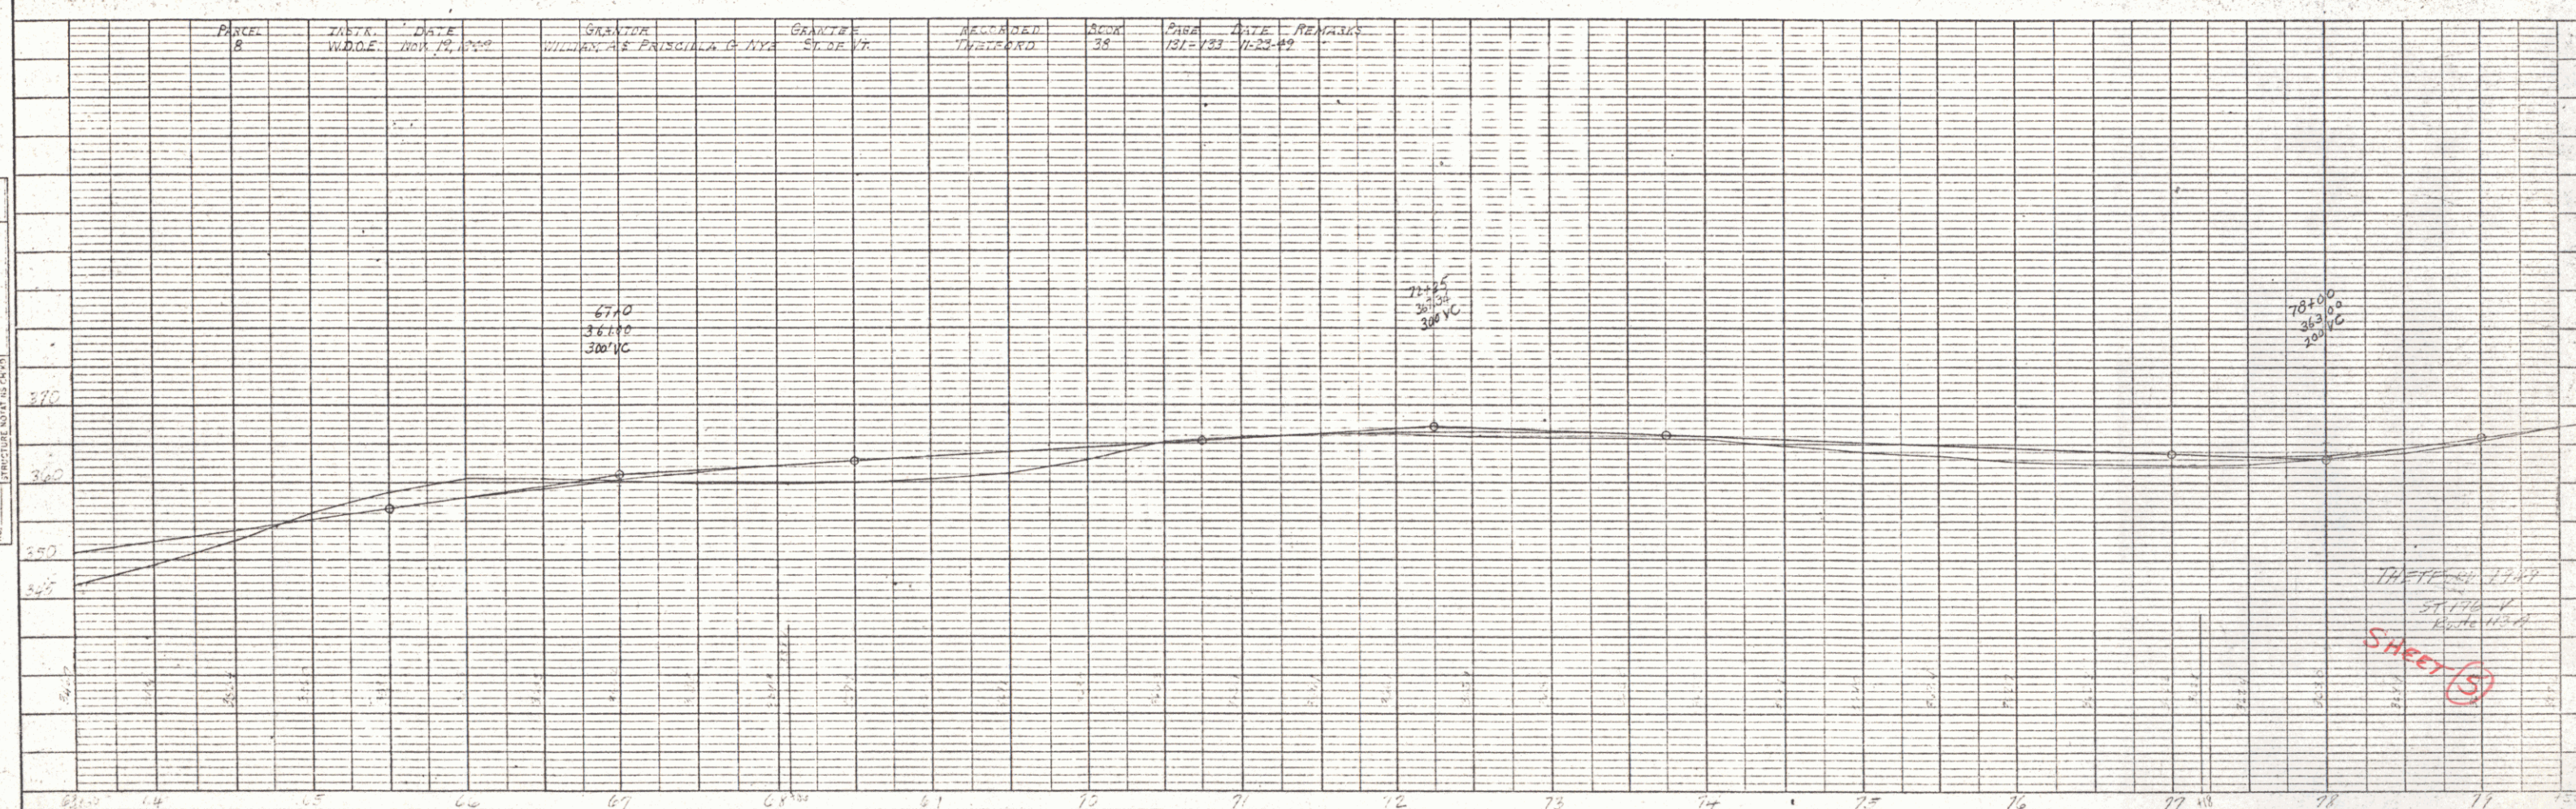


PLATE 1 - PLAN - PROFILE O.P. & A.E. STANDARD
KUTZEL & EIDER CO. NEW YORK

THREE 50' STAKES
ST. 112.6' - P
Elev. 712.6'

SHEET (5)

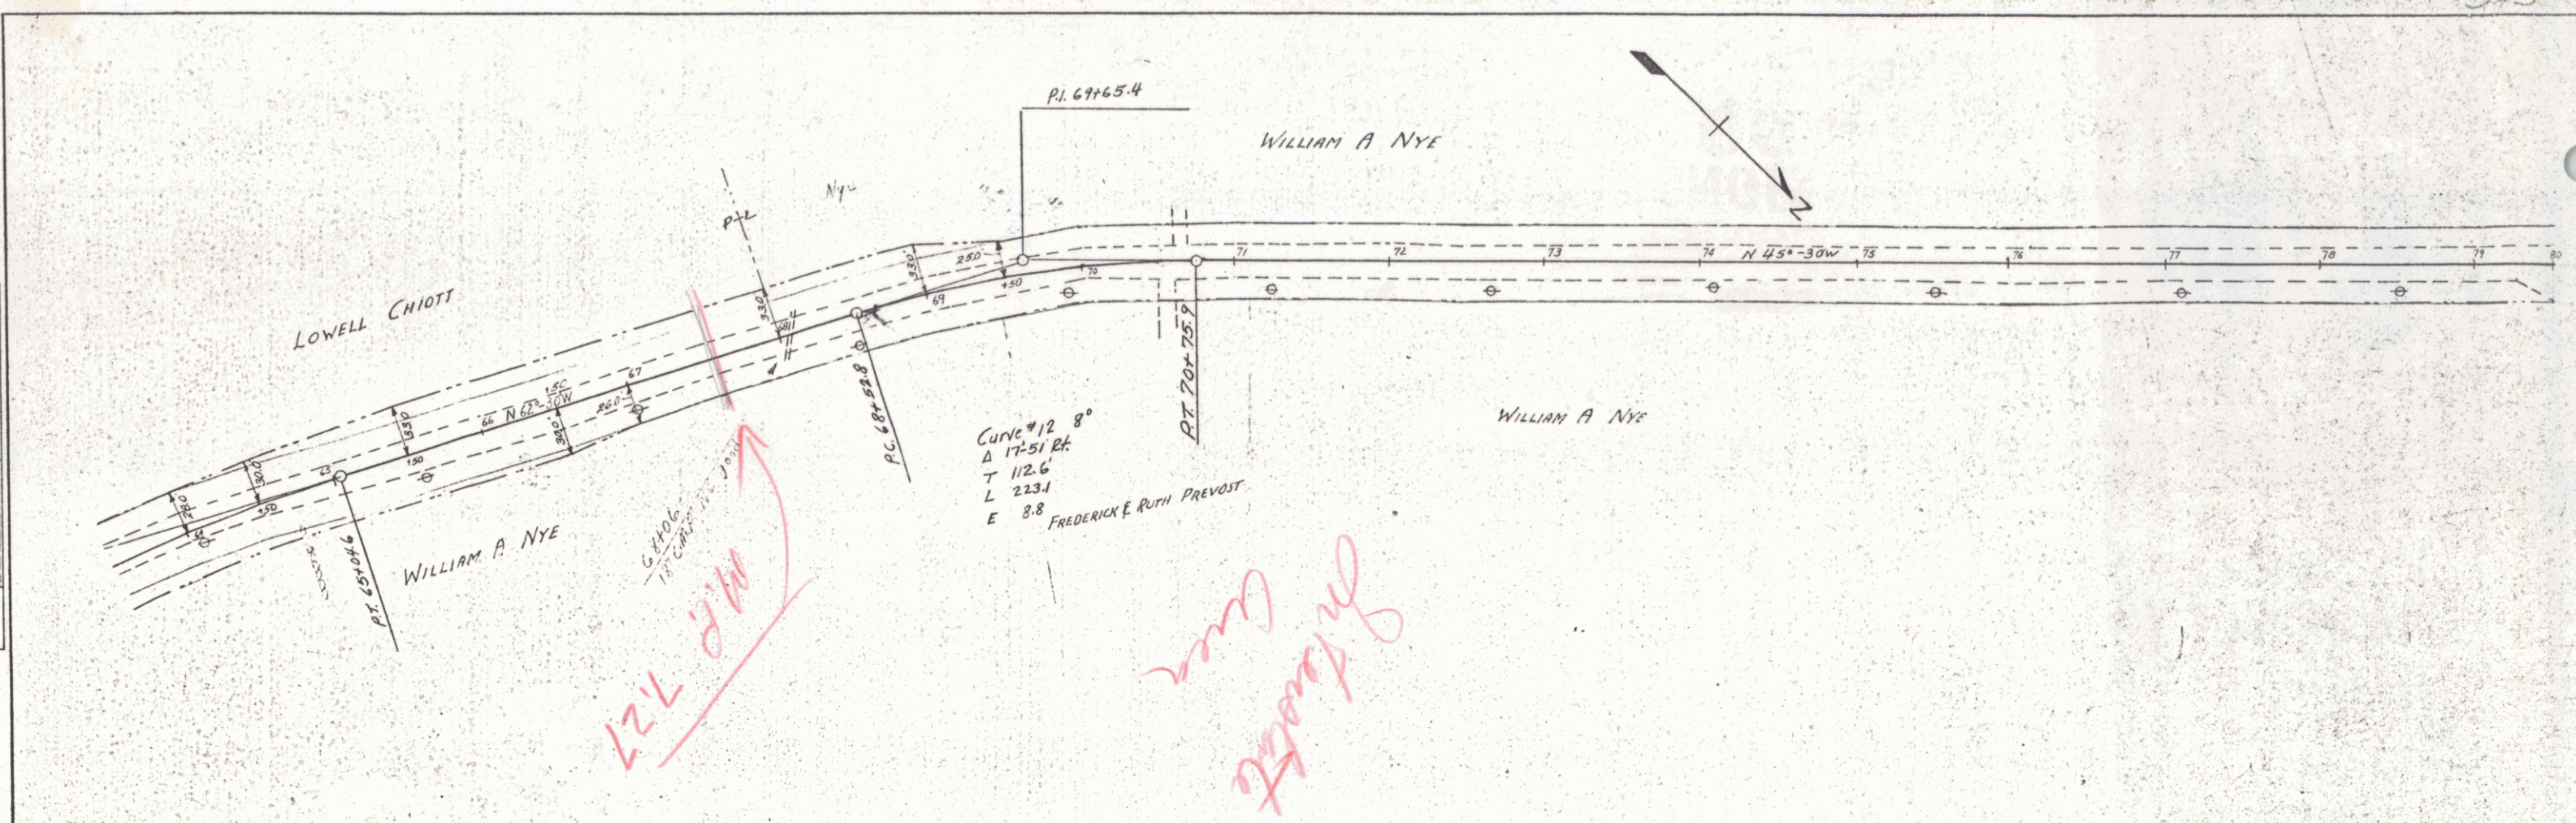