

INDEX OF SHEETS

1	TITLE PAGE
2	TYPICAL CROSS-SECTION OF IMPROVEMENT (2 1/2" BERRED GRAVEL MIXED-IN-PLACE SURFACE COURSE WITH REFINED TAR, ITEM 3-41)
3	BANKING AND WIDENING TABLES
4	QUANTITY SHEET - ITEMS
5	QUANTITY SHEET - DRAINAGE
6-13	EARTHWORK SHEETS
14-26	PLAN AND PROFILE
27	STANDARD STRUCTURE SHEET S-40 BARRICADES, SIGNS & LIGHTS
28	" S-41 ROUNDING OF SLOPES
29	" S-46-45 MARKERS
30	" S-47-45 PIPE CULVERTS
31-56	CROSS SECTIONS

STANDARD STRUCTURE SHEETS APPROVED BY THE CHIEF ENGINEER, VERMONT STATE DEPARTMENT OF HIGHWAYS.

S-40	FEB. 28, 1949
S-46-45	FEB. 28, 1949
S-47-45	FEB. 28, 1949

STATE OF VERMONT
STATE HIGHWAY DEPARTMENT

PLAN AND PROFILE OF PROPOSED
STATE HIGHWAY

SECONDARY PROJECT

TOWN OF NORTON

Pin # DOR465


COUNTY OF ESSEX
NORTON CANAAN ROAD
VERMONT ROUTE 114

BEGINNING AT A POINT APPROXIMATELY 700.0 FEET SOUTHERLY OF THE U.S. CUSTOMS BUILDING AND EXTENDING EASTERLY 16,098.0 FEET

LENGTH OF PROJECT 16,098.0 FEET = 3.049 MILES

FED. ROAD DIST. NO.	STATE	PROJ. NO.	YEAR	SHEET NO.	TOTAL SHEETS
9	VT.	209(1)		1	56

POST WAR SECONDARY

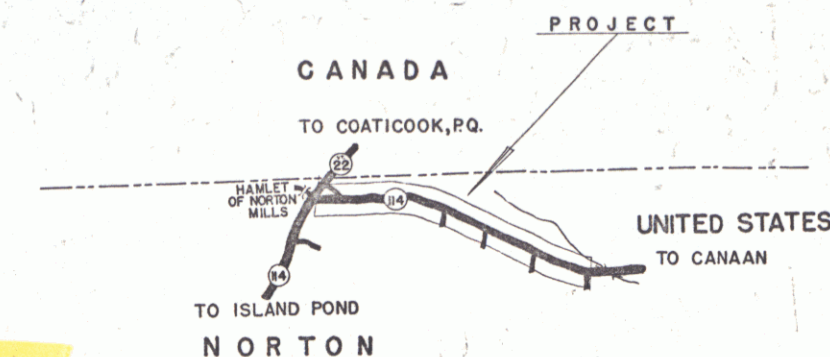

U.S.G.S. MAP REFERENCE
18° 40' 00" N 45° 00' 00" W
SCALE 1" = 1 MILE

PROJECT NAME AND NUMBER	TYPE	PAVEMENT AREA
NORTON	CR. GRAVEL MIX	35,773 S.Y.
RECORD PLANS		
MATERIALS		
CEMENT PORTLAND CEMENT	GRAVEL FROM CANADA	
LOOSE STONE		
SAND CORKINS PIT	C.R.M. FROM PROJECT	
STONE CORKINS PIT		
TAR BARNETT CO. (OLD COLONY)		
WINDSOR, MASS.		
E.C.P. VERMONT CONC. PIPE		
MONTELLIER, VERMONT		
A.C.C.M.P. NE. METAL CULVERT CO.		
CONTRACTOR W.E. DAILEY	CONTRACT DATED SEPT. 13, 1949	
RESIDENT ENGINEER P.T. BUNNETT	CONTRACT STARTED SEPT. 13, 1949	
INSPECTOR	CONTRACT COMPLETED AUG. 1, 1950	
RECORD PLANS	CONTRACT ACCEPTED AUG. 1, 1950	

ANY FURTHER INFORMATION CONCERNING FINAL QUANTITIES AMOUNTS OR OTHER DETAILS RELATIVE TO THIS PROJECT MAY BE FOUND IN EITHER THE FIELD BOOKS OR THE ESTIMATE FILE

MP 5.382
END PROJECT
STA. 16+000

APPROVED: 18 MARCH, 1949

COMMISSIONER OF HIGHWAYS
SUBMITTED BY ORDER OF THE STATE HIGHWAY B


MP 5.336
BEGIN PROJECT
STA. 5+000



18-19-20-2242-224

POST WAR SECONDARY

FED. ROAD DIST. NO.	STATE	PROJ. NO.	FISCAL YEAR	SHEET NO.	TOTAL SHEETS
9	VT.	209(1)		14	5

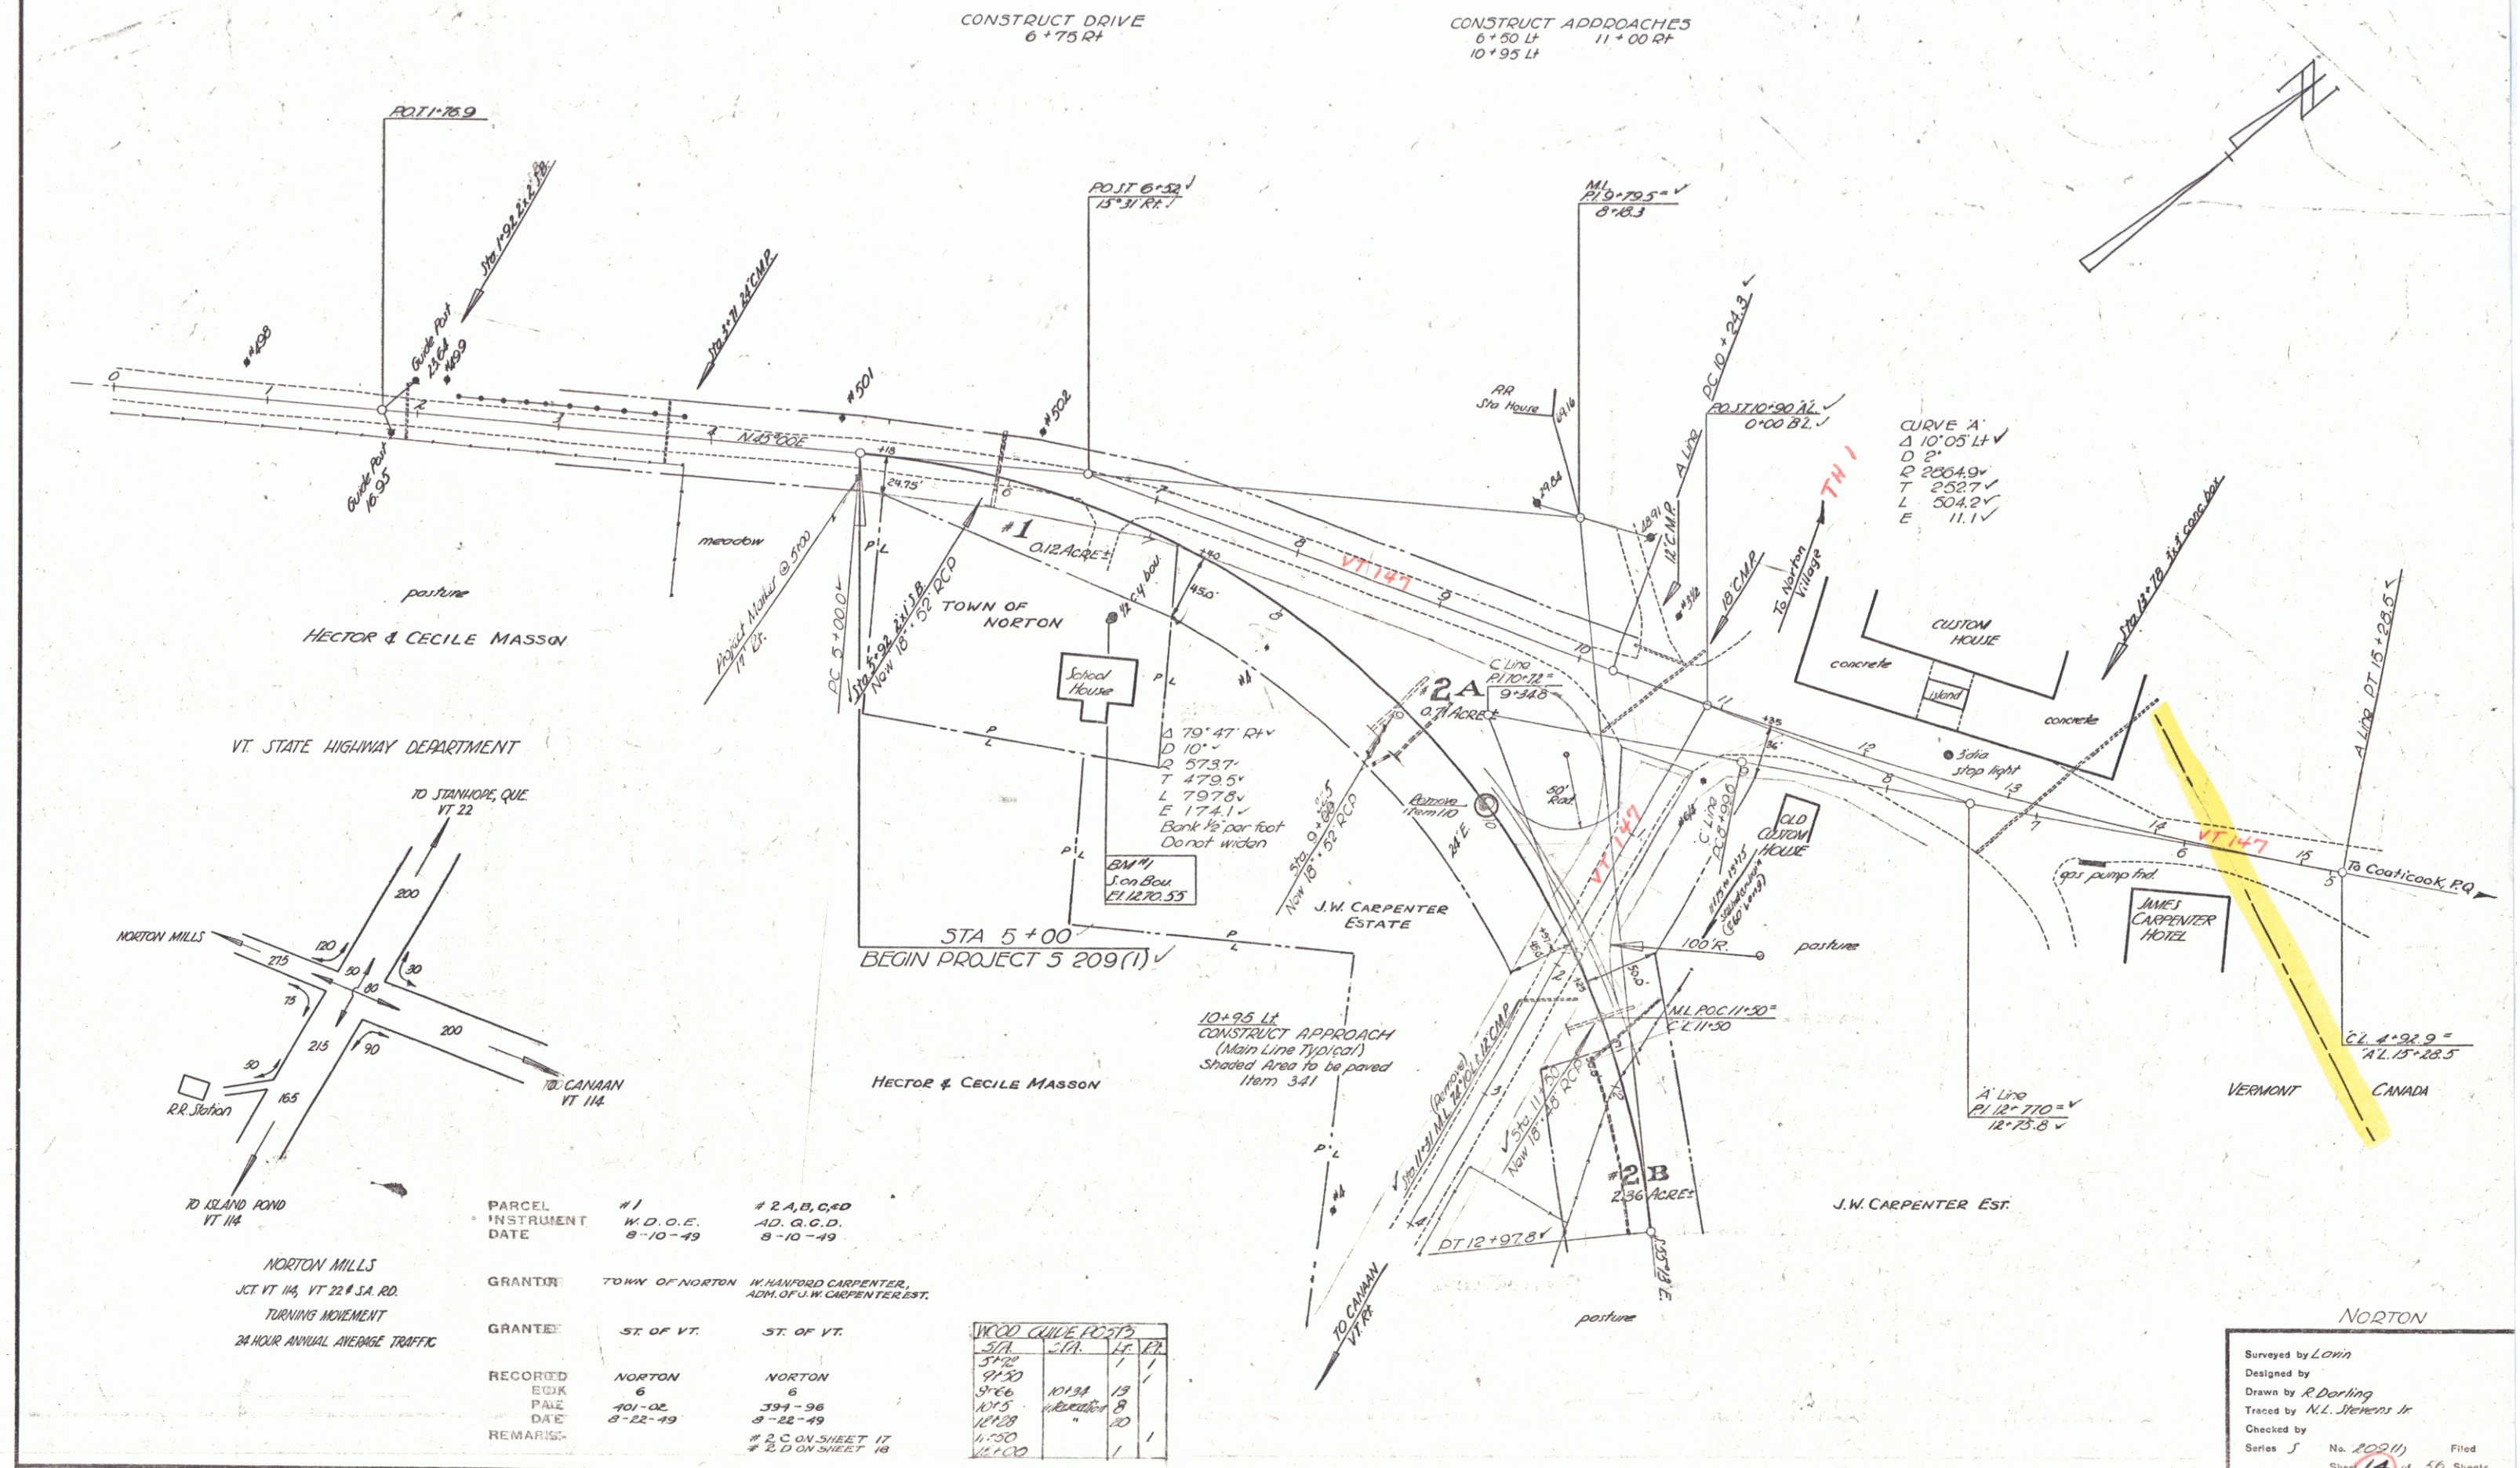

VT STATE HIGHWAY DEPARTMENT

TO STANFORD, QUE. VT 22

TO CANAAN VT 114

TO ISLAND POND VT 114

TO CANAAN VT 114

TO ISLAND POND VT 114

TO CANAAN VT 114


PARCEL	#1	#2, A, B, C, D
INSTRUMENT	W.D.O.E.	AD. G.C.D.
DATE	8-10-49	8-10-49
GRANTOR	TOWN OF NORTON	W. HANFORD CARPENTER, ADM. OF J.W. CARPENTER EST.
GRANTEE	ST. OF VT.	ST. OF VT.
RECORDED	NORTON	NORTON
BOOK	6	6
PAGE	101-02	394-36
DATE	8-22-49	8-22-49
REMARKS		#2 C ON SHEET 17 #2 D ON SHEET 19

WOOD CHURCH RD	101	11	12
3/1	1	1	1
3/2	1	1	1
3/3	1	1	1
3/31	1	1	1

Surveyed by Lamin
Designed by R. Darling
Traced by M.L. Stevens Jr.
Checked by
Series 5 No. 209(1) Filed
Sheet 14 of 56 Sheets



PLAN
 DRAWN BY: Lump
 DATE: 5/18
 CHECKED BY: Merrett Jr.
 DATE: 8/18

PROFILE
 DRAWN BY: Lump
 DATE: 5/18
 CHECKED BY: Merrett Jr.
 DATE: 8/18

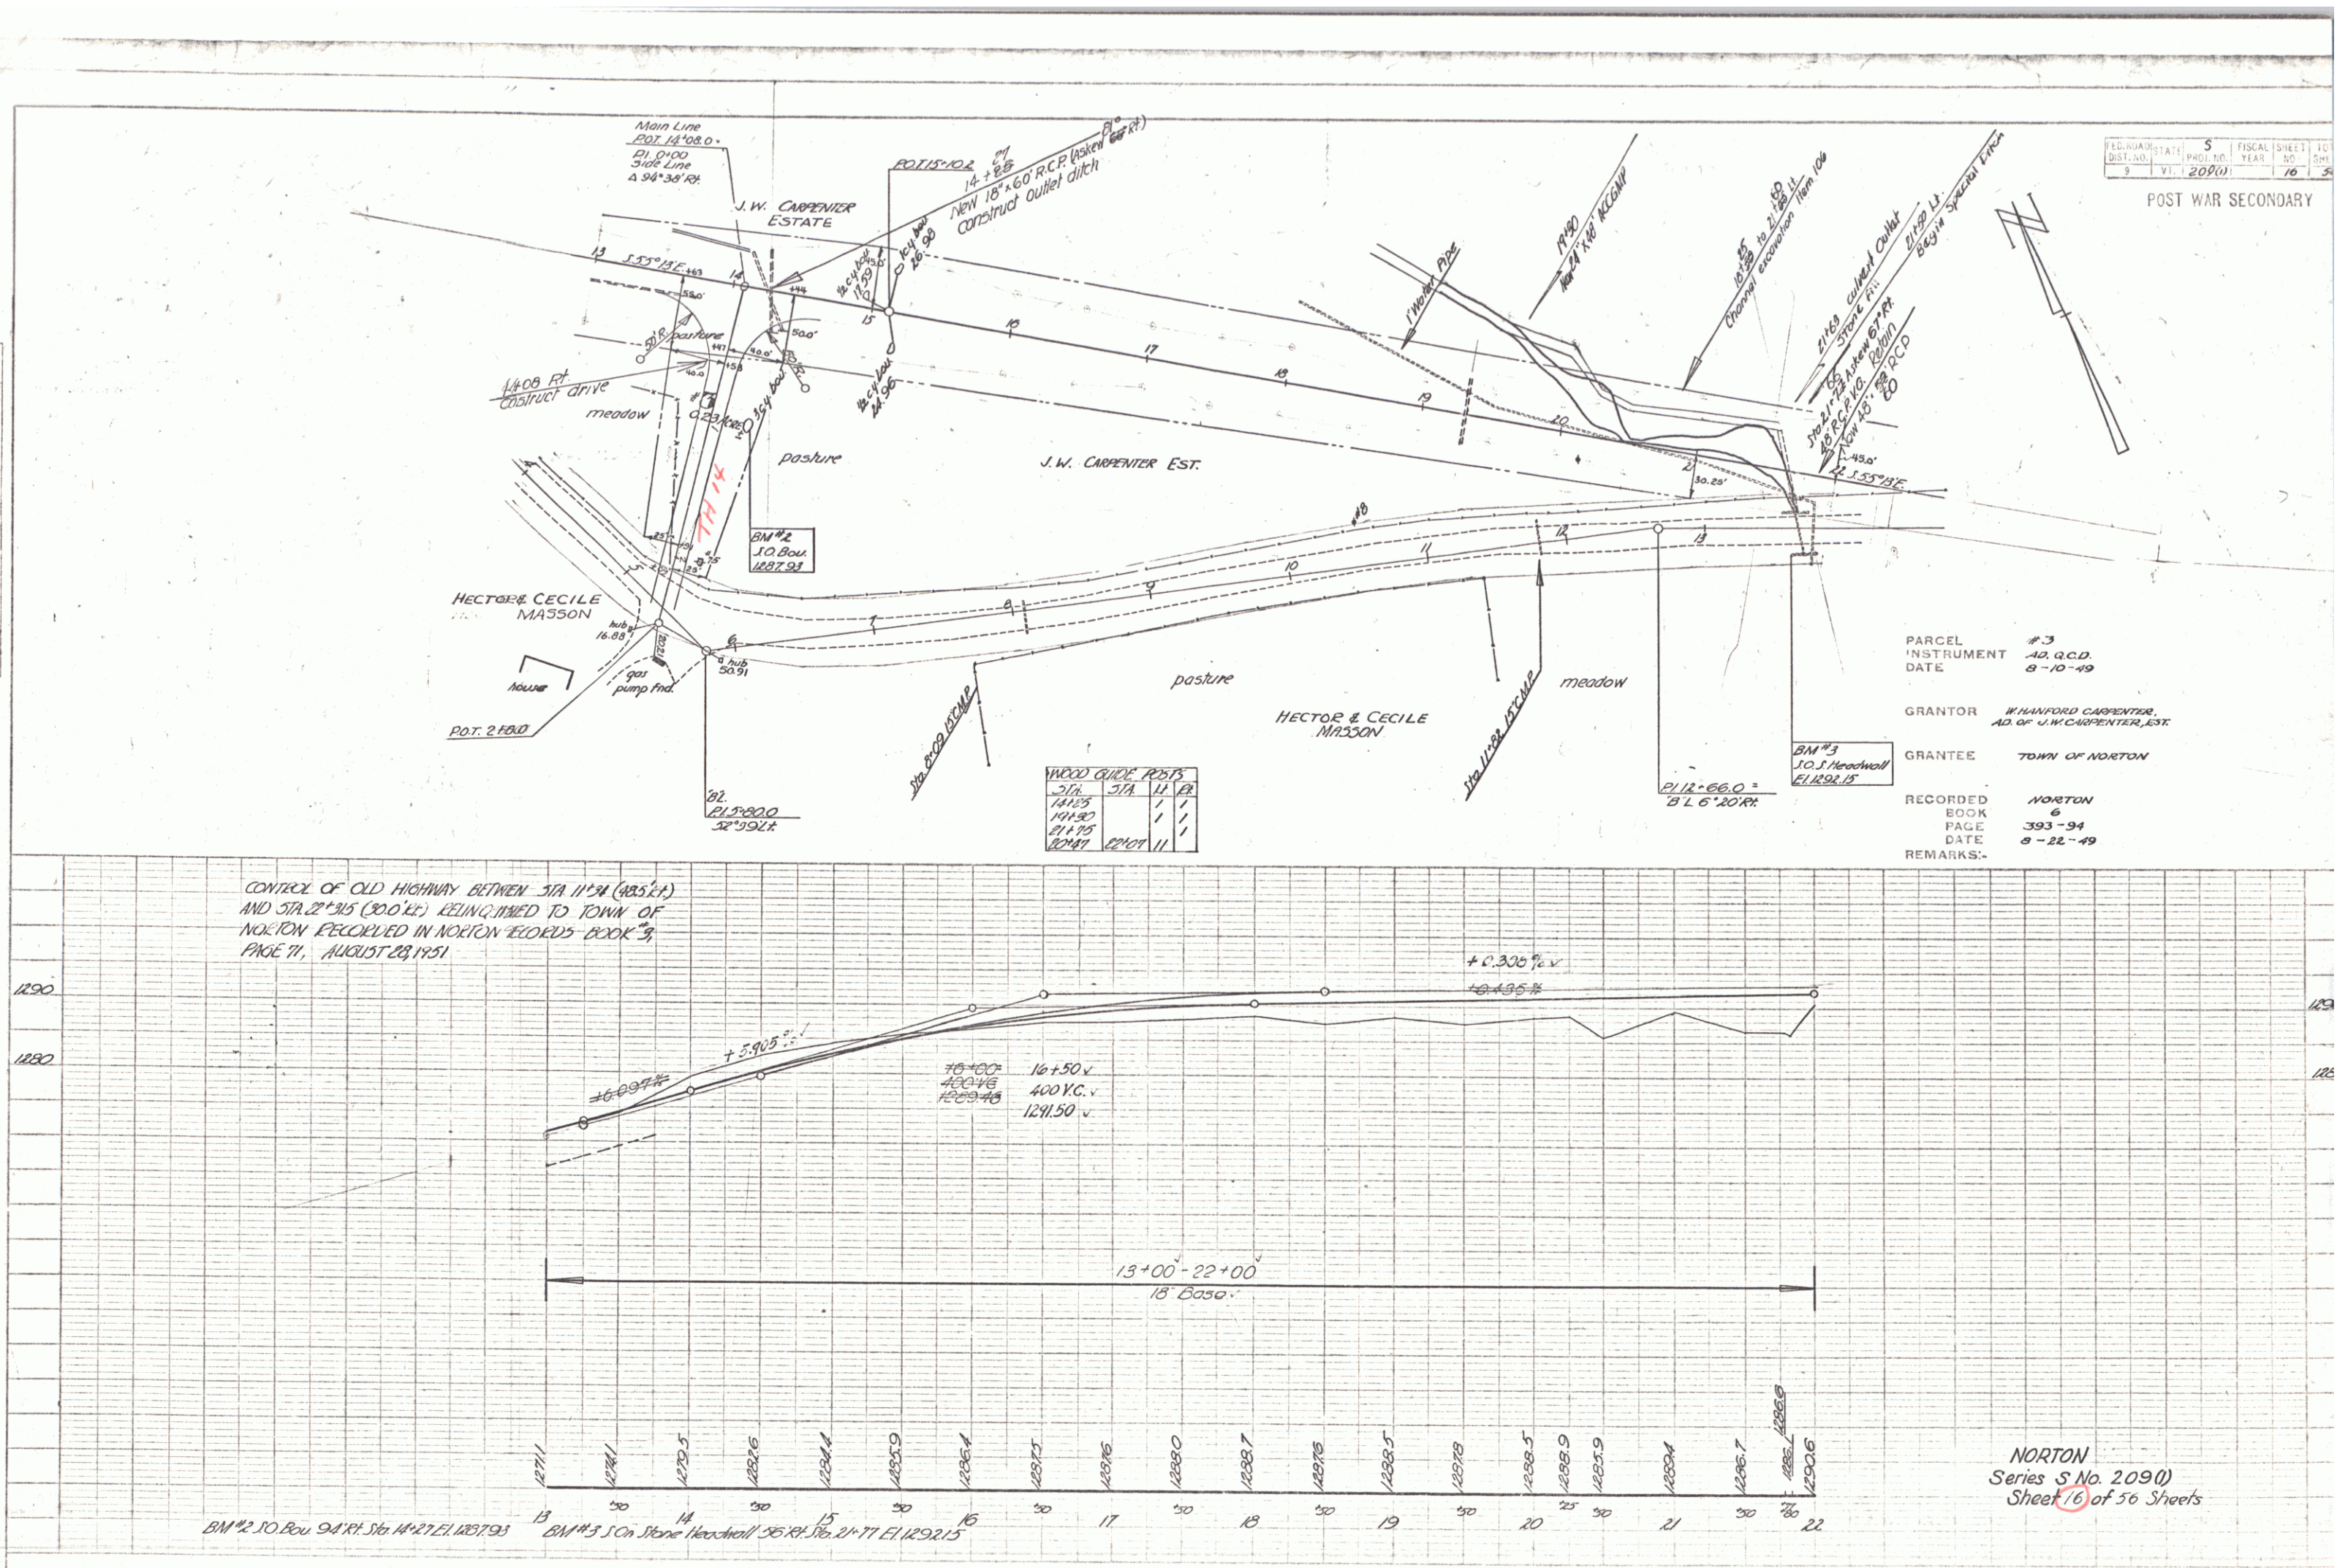




PLAN	DATE	BY
DESIGNED	6-23-40	
CHECKED		
NOTED		
NO.		


PROFILE	DATE	BY
DESIGNED	6-23-40	
CHECKED		
NOTED		
NO.		

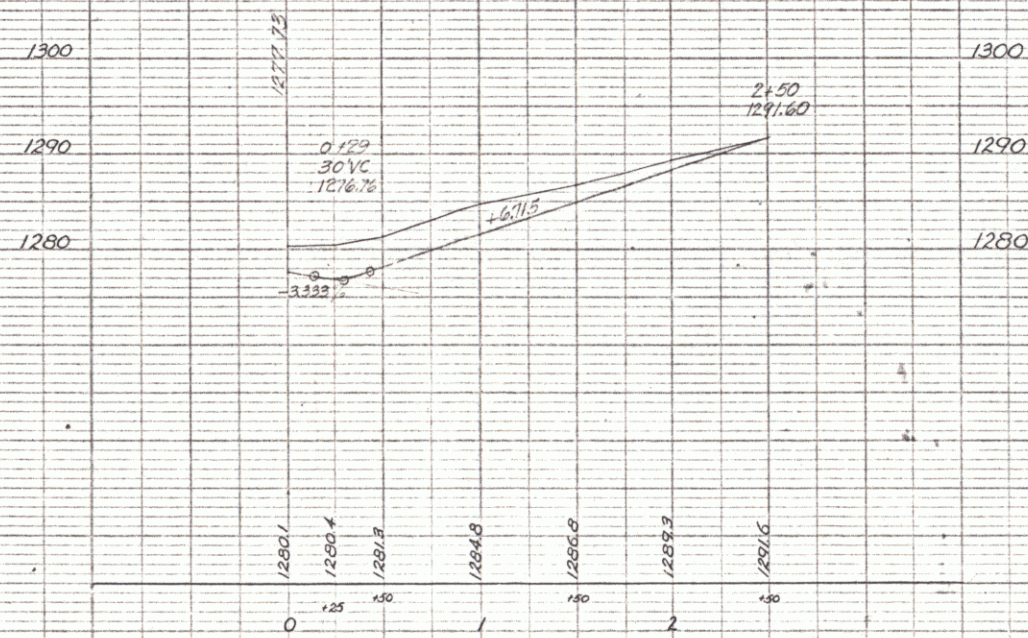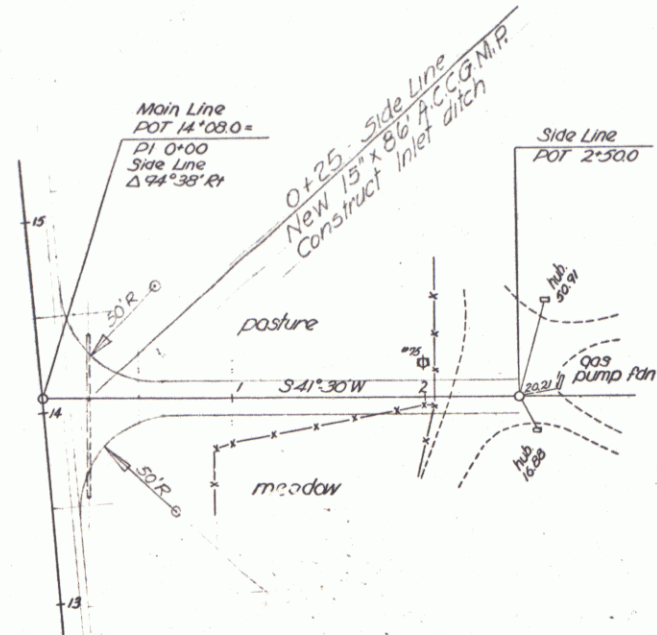

Norton
Side Line At 14+08.0 R
Series S No. 209(1)
SHEET 16A

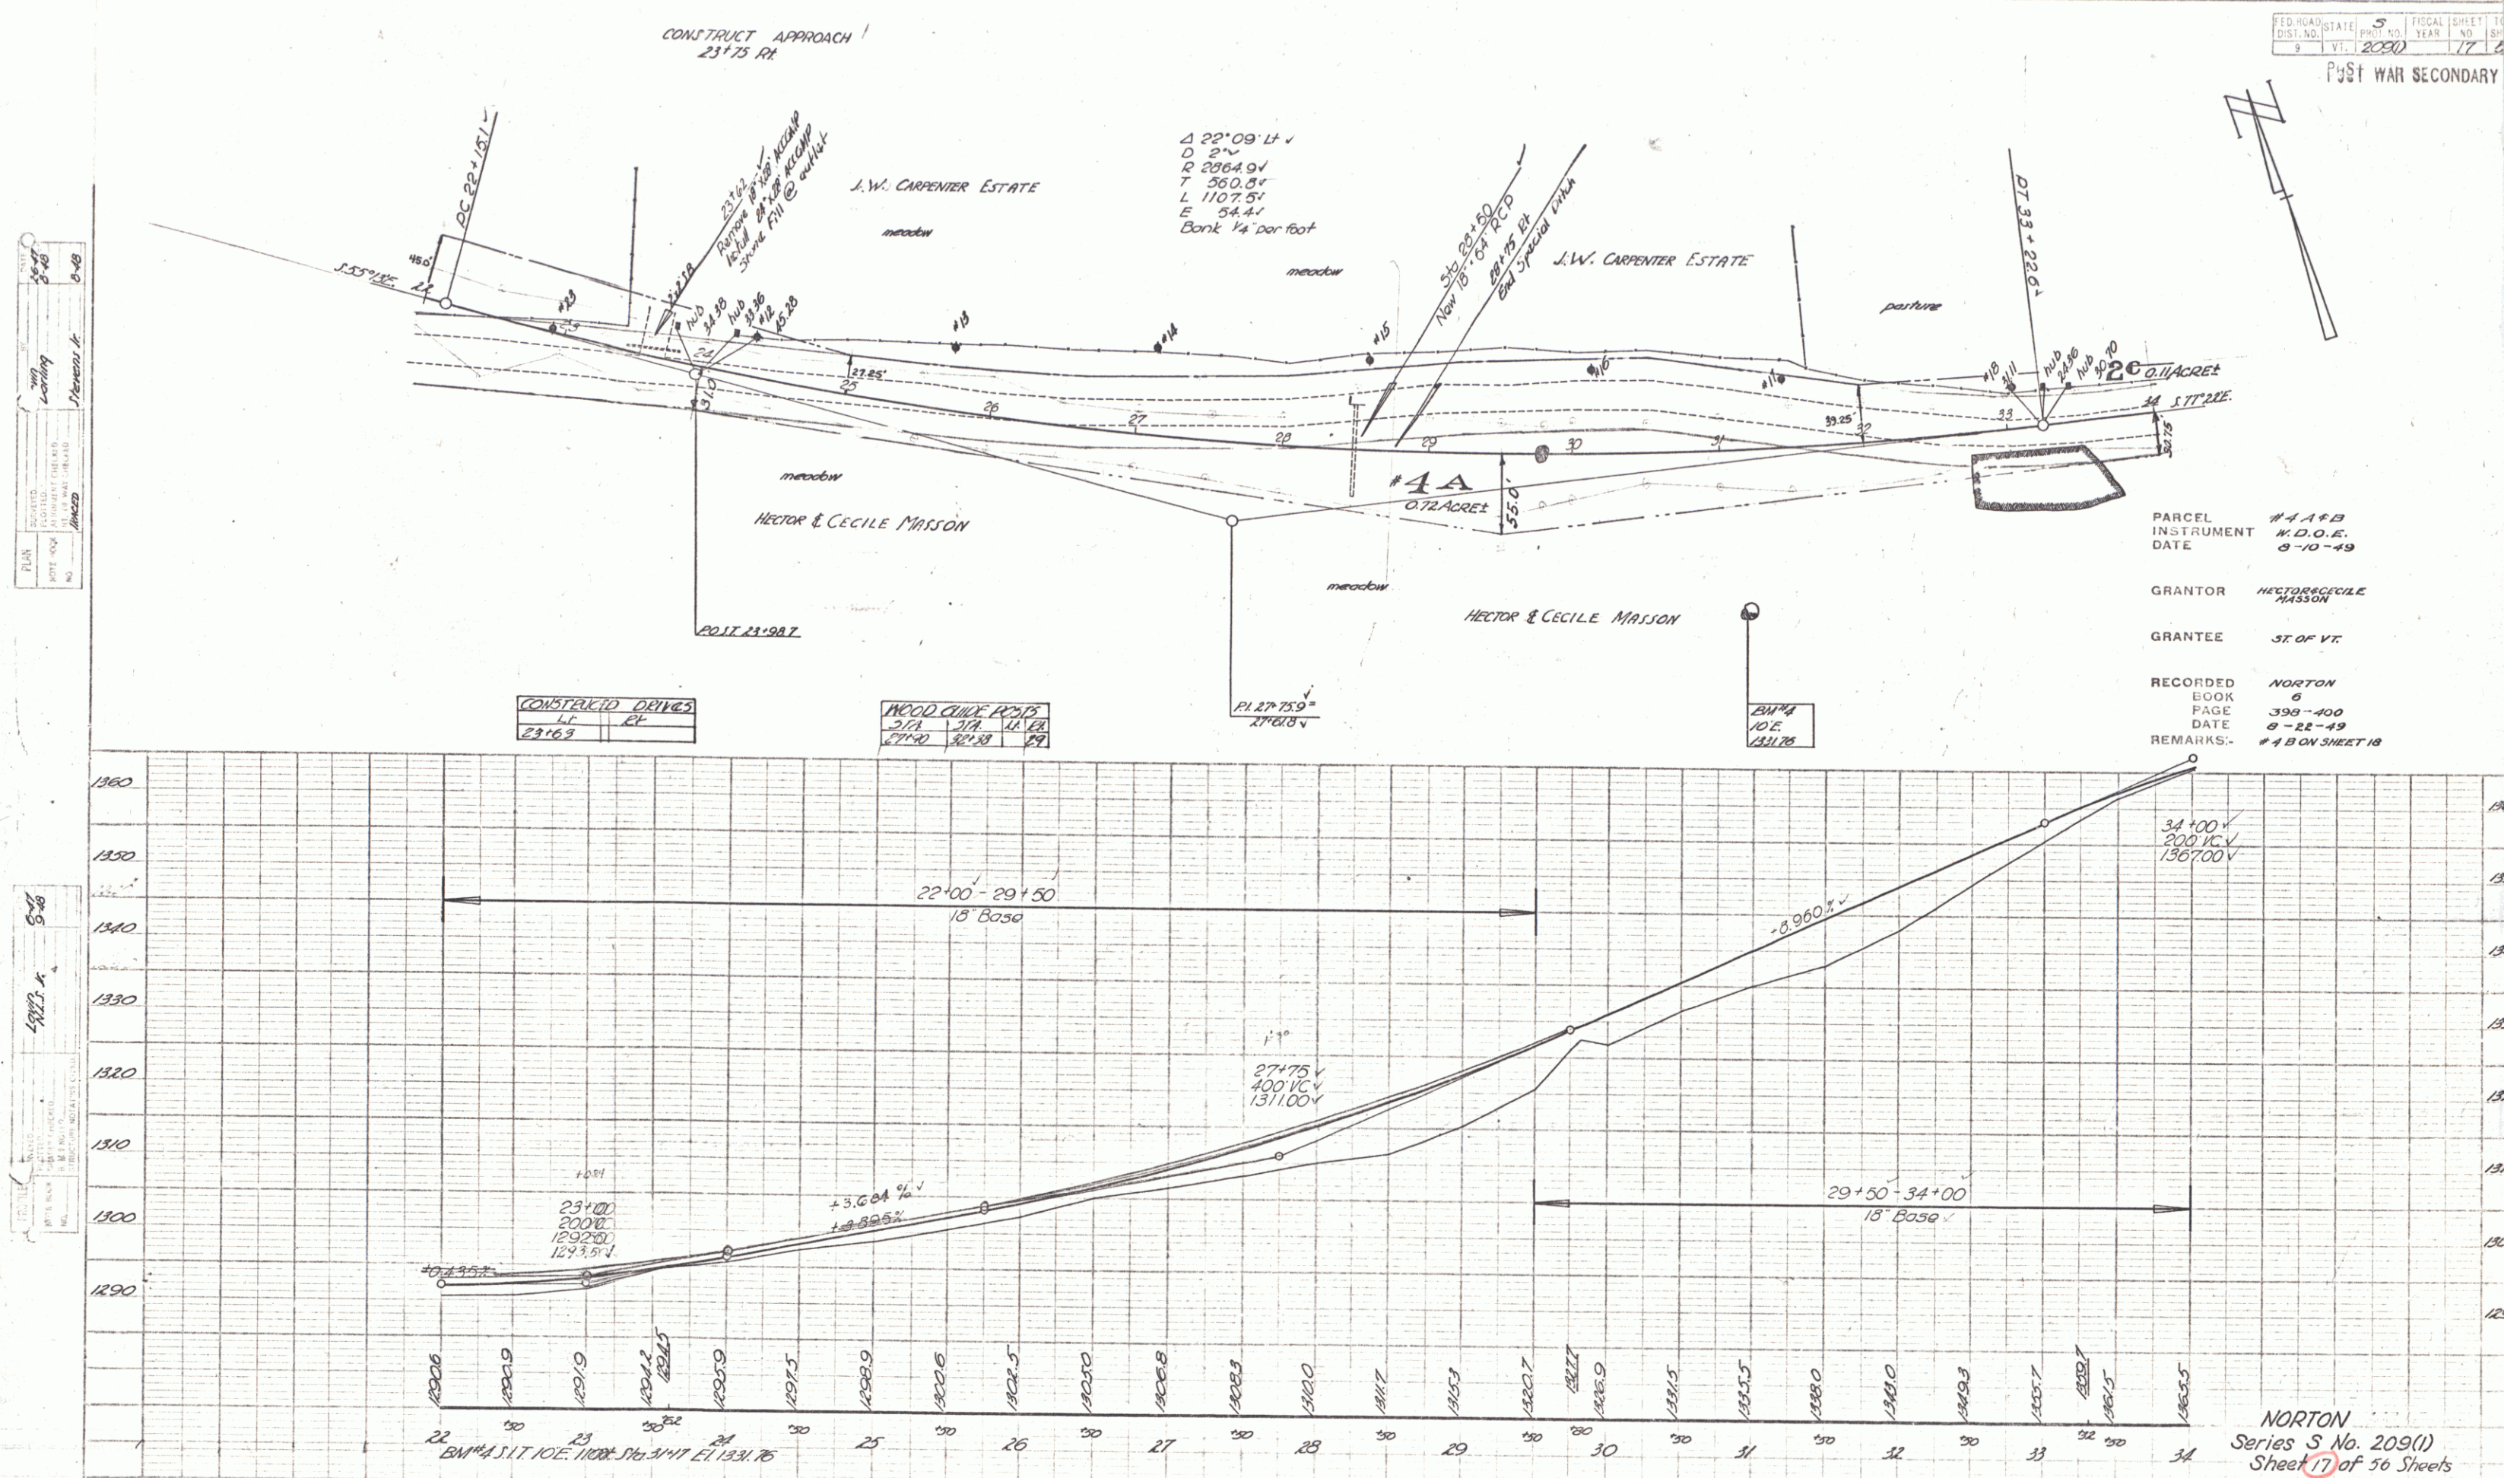


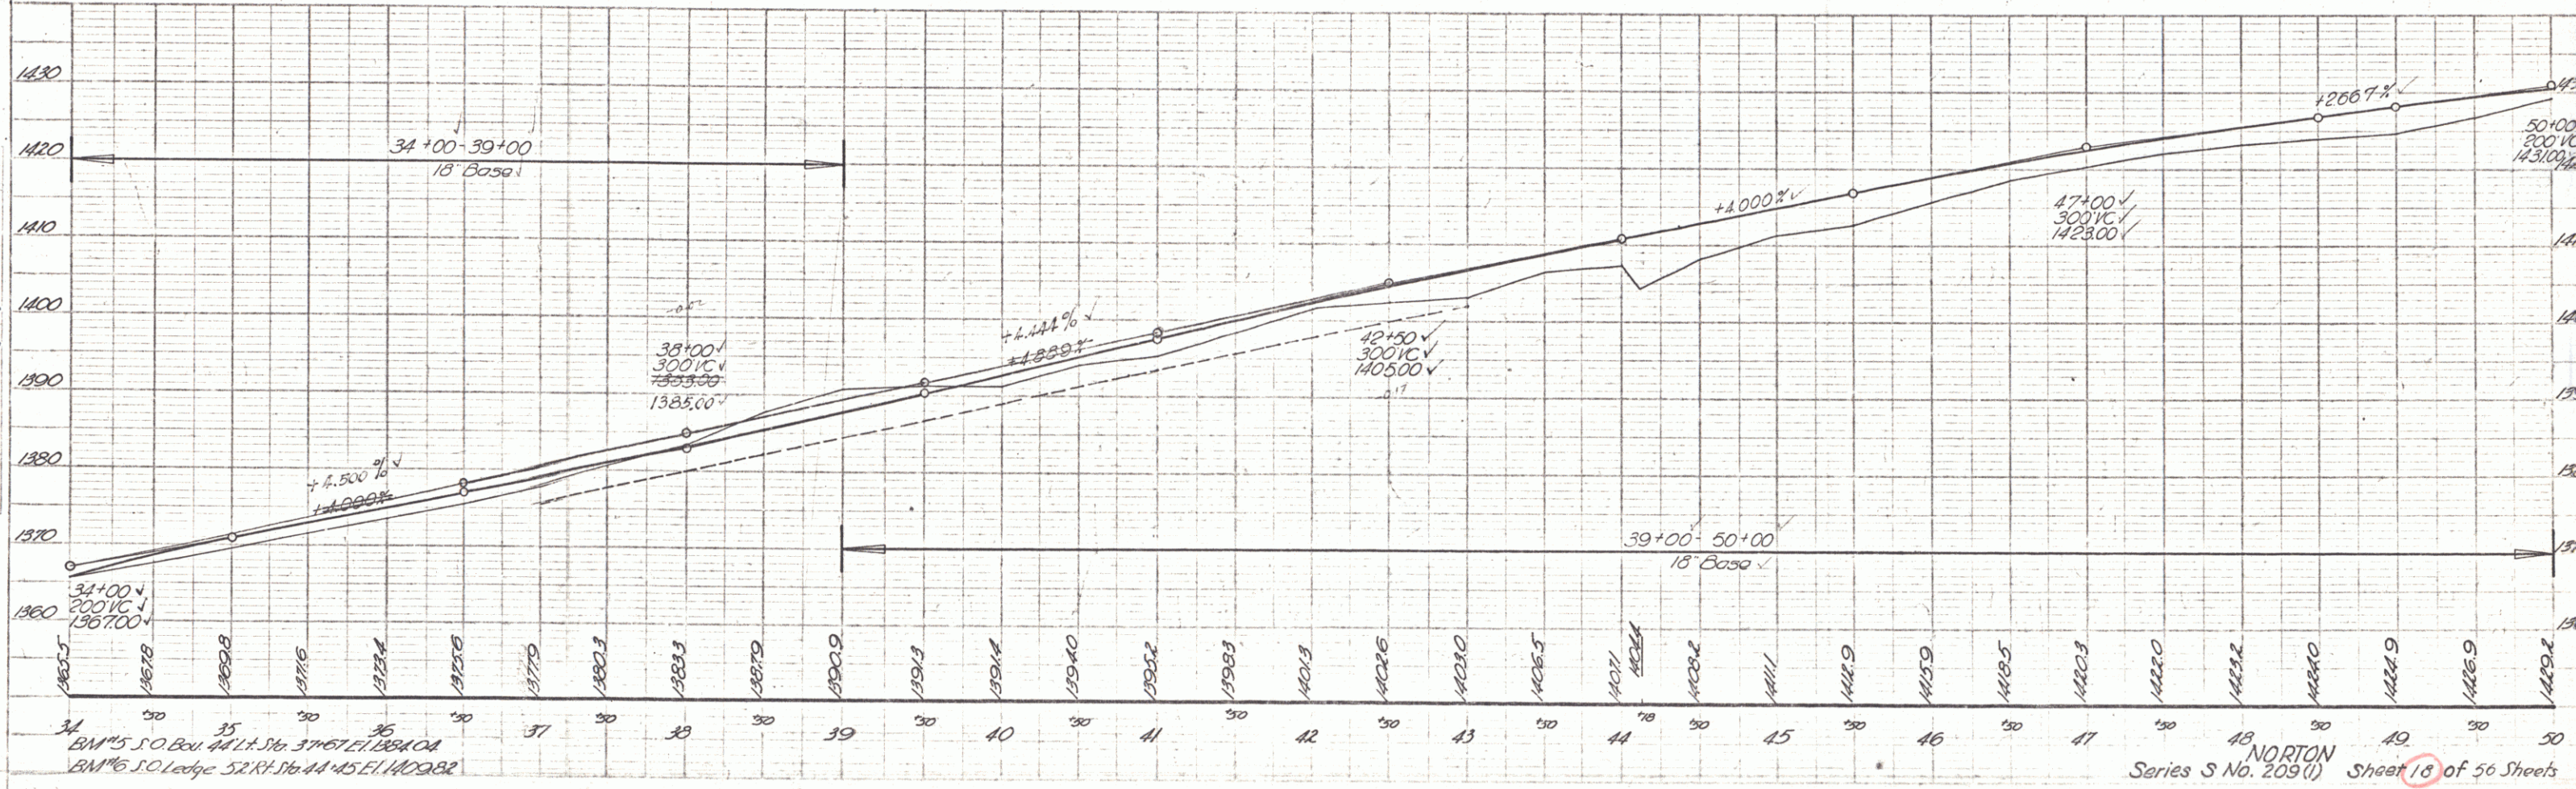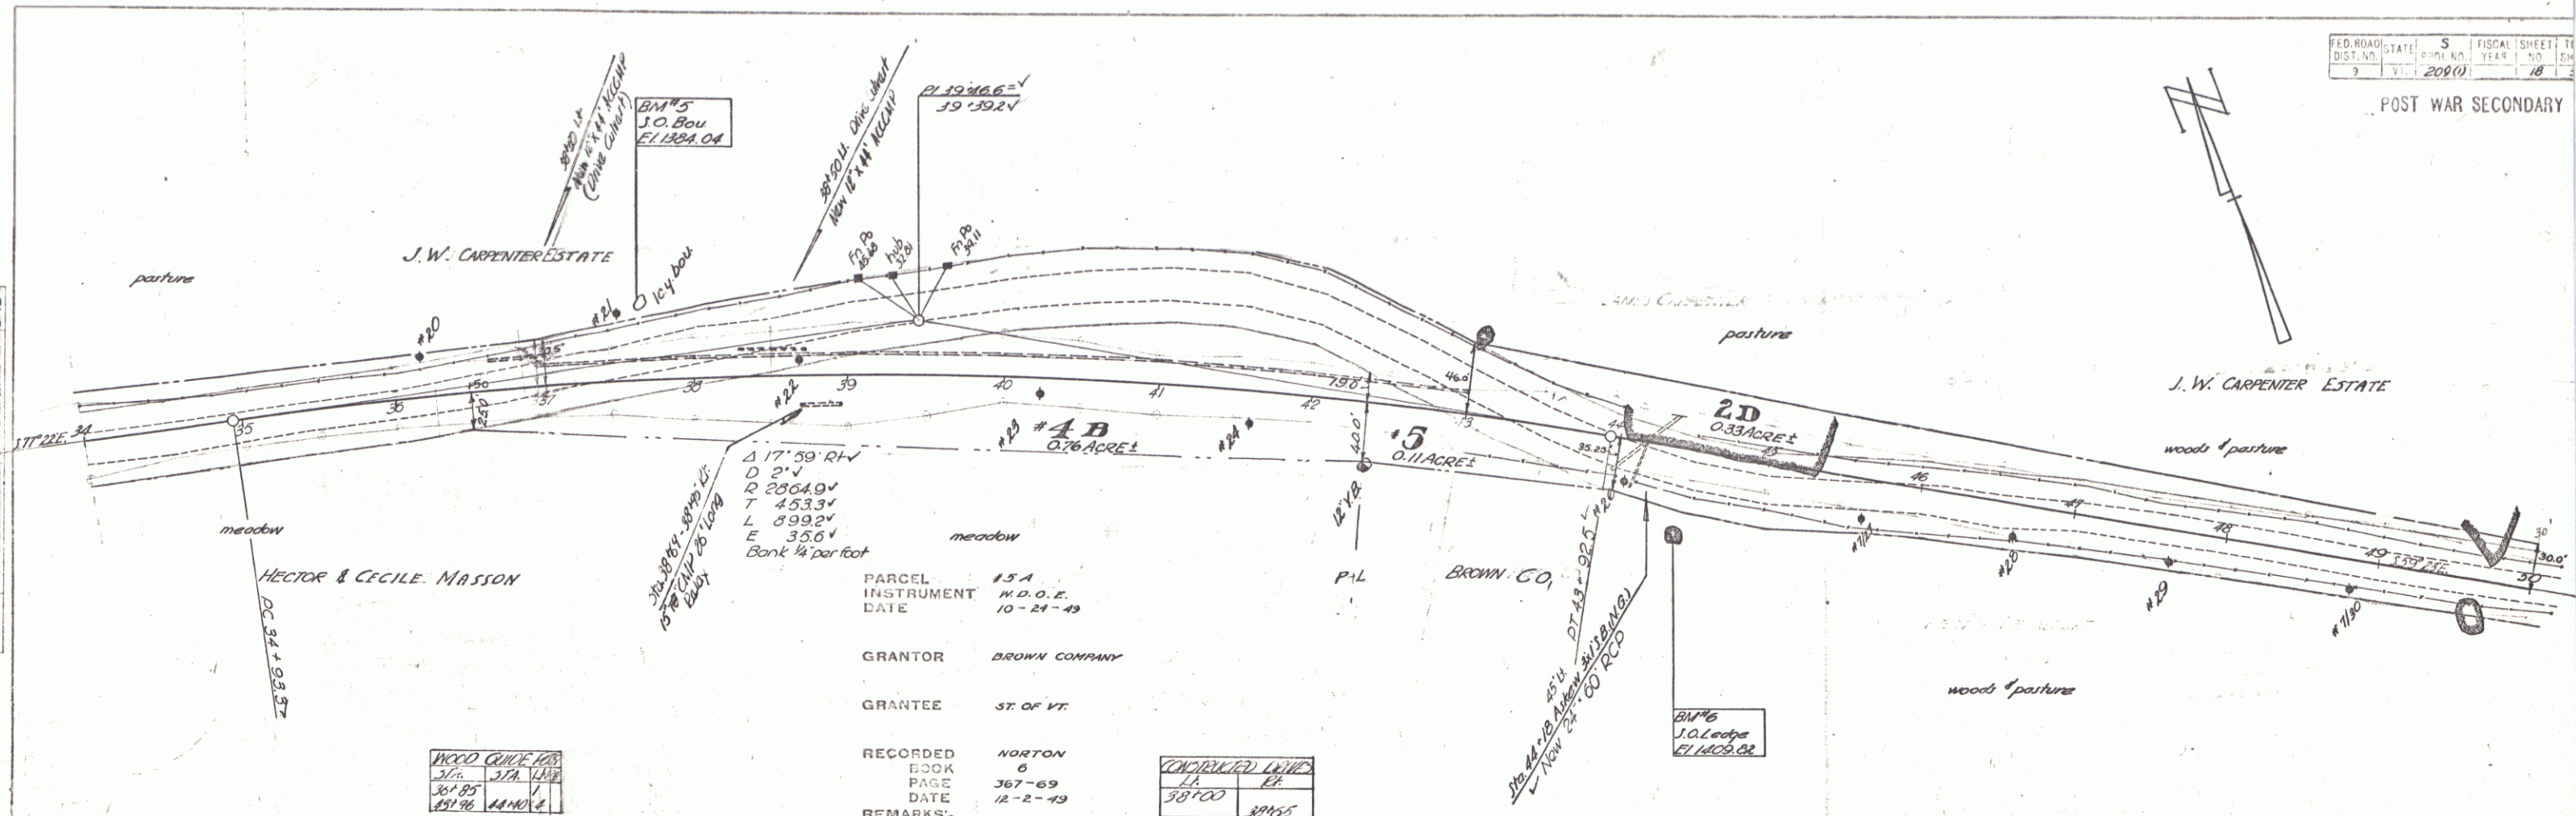

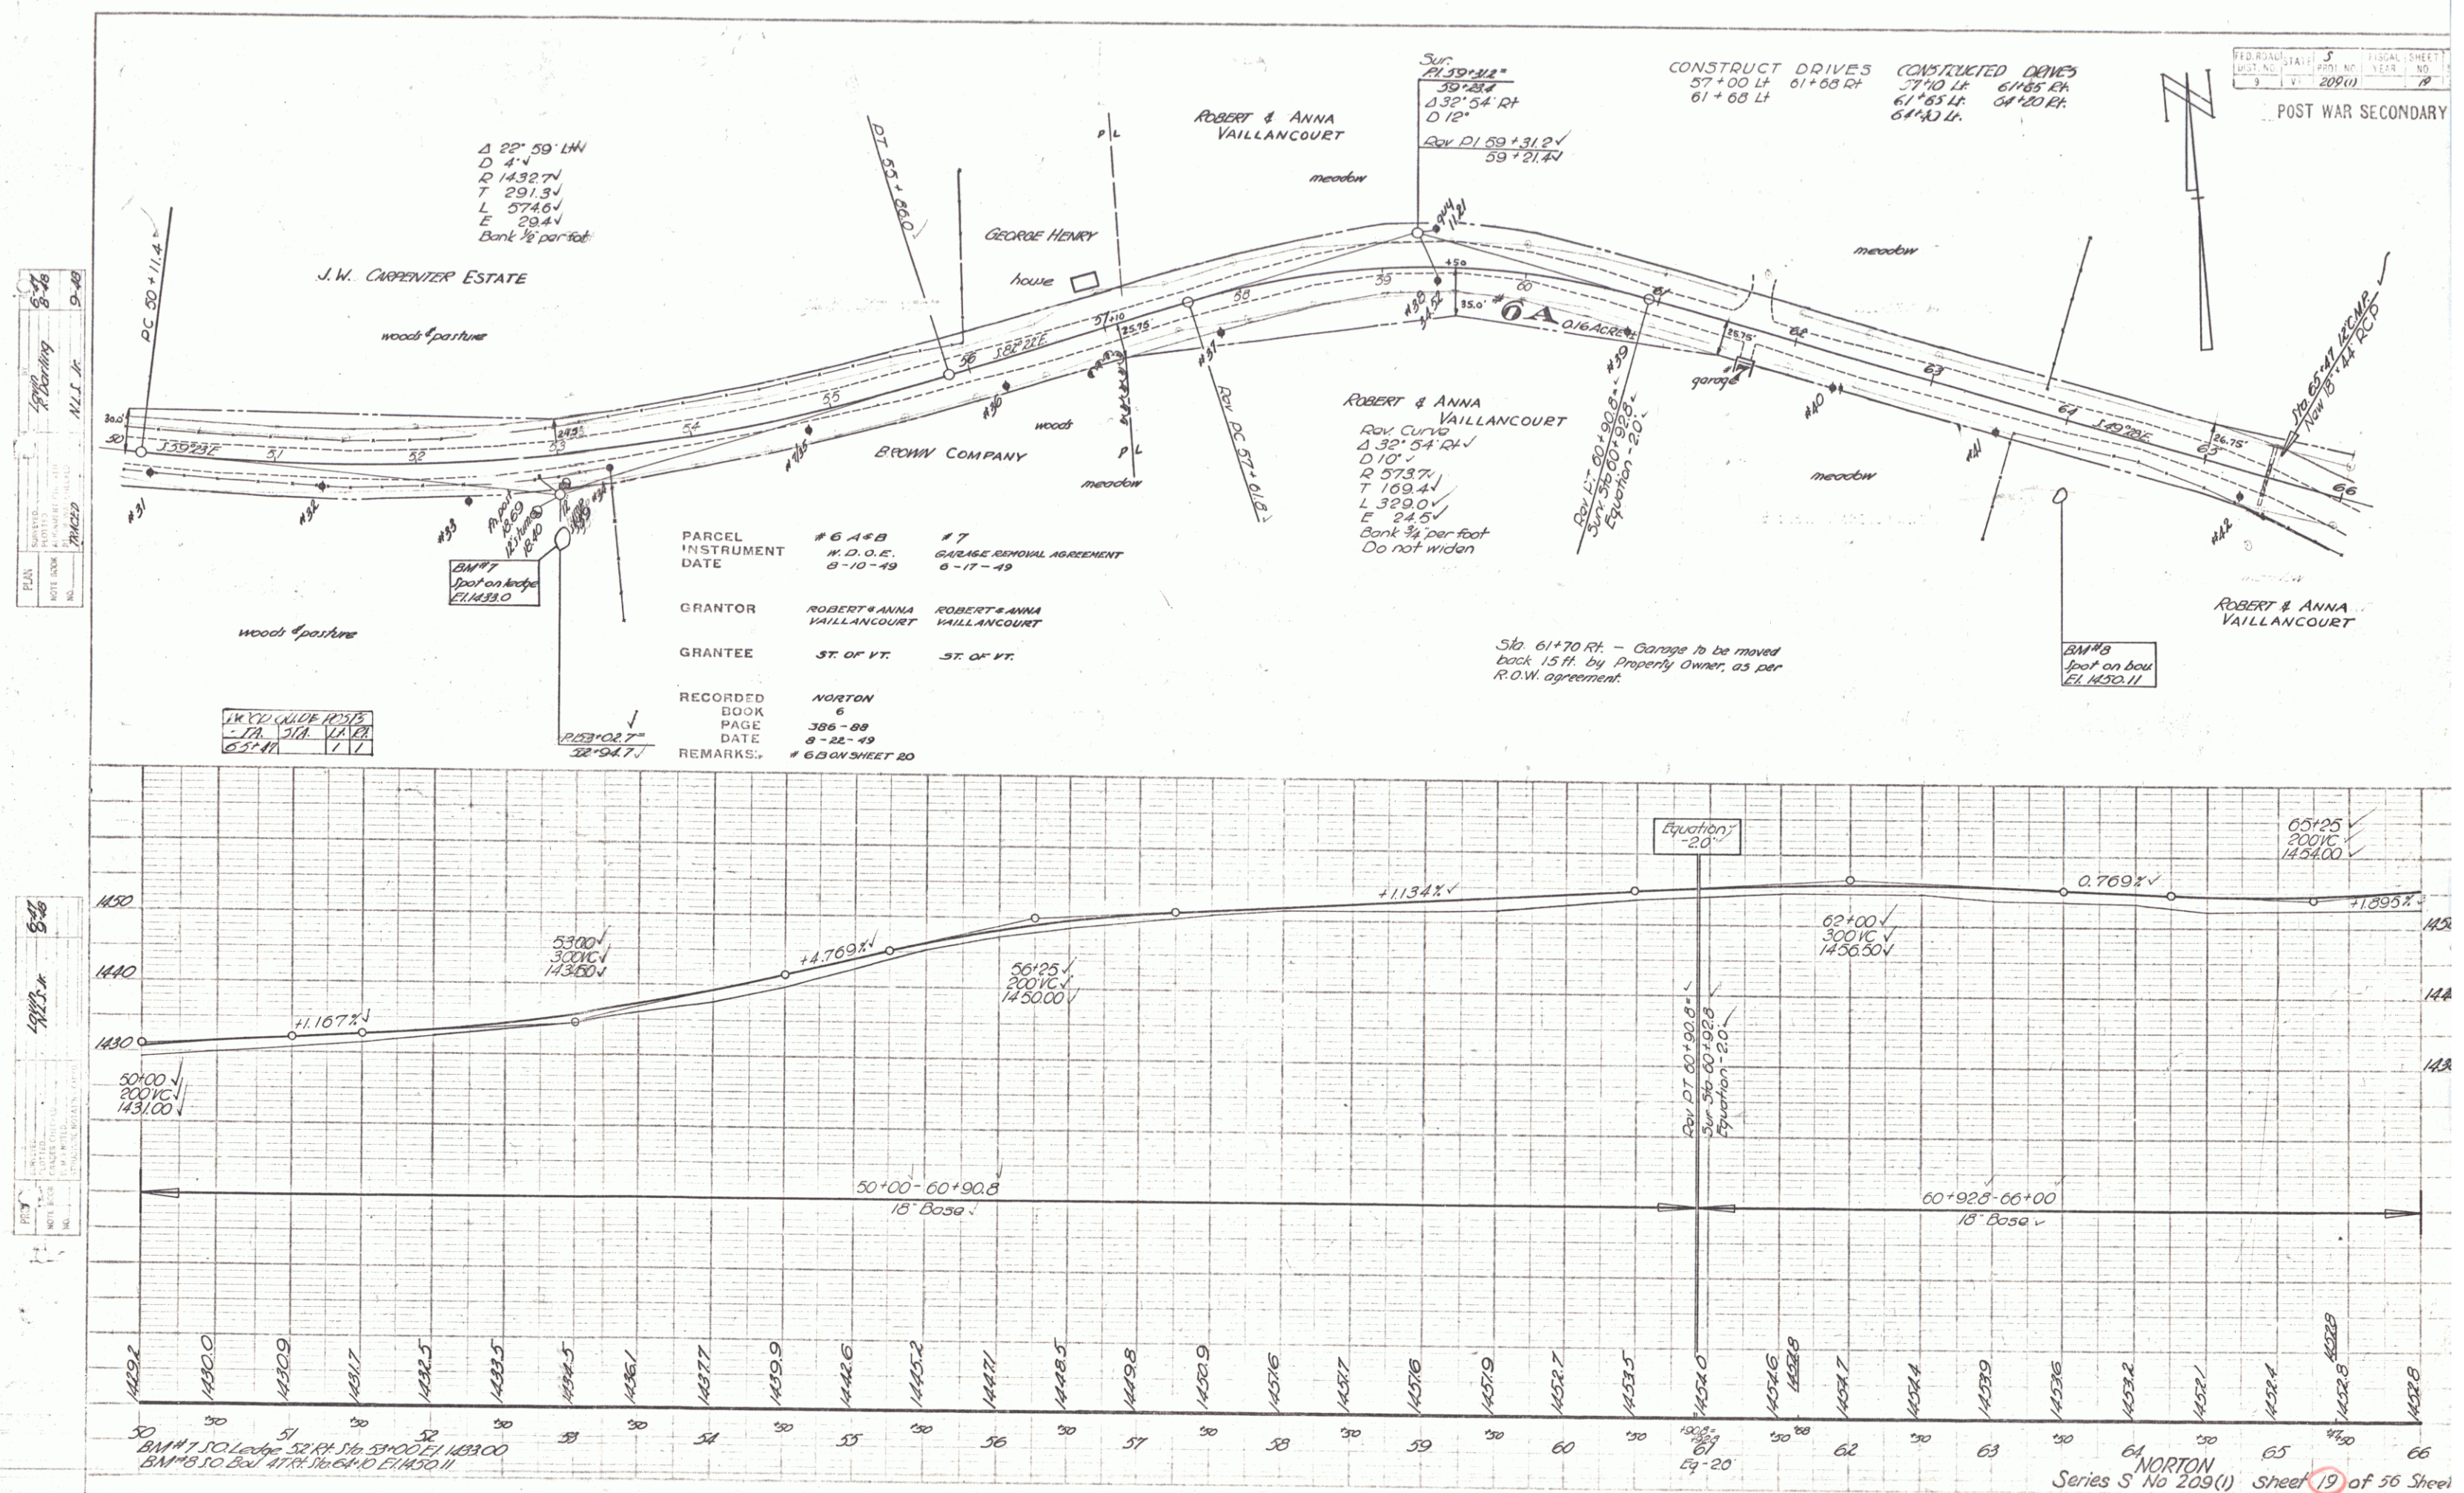

PLAN
 DATE BOOK 1940
 DRAWN BY J. J. H.
 CHECKED BY J. J. H.
 NO. 1

PROFILE
 DATE BOOK 1940
 DRAWN BY J. J. H.
 CHECKED BY J. J. H.
 NO. 1

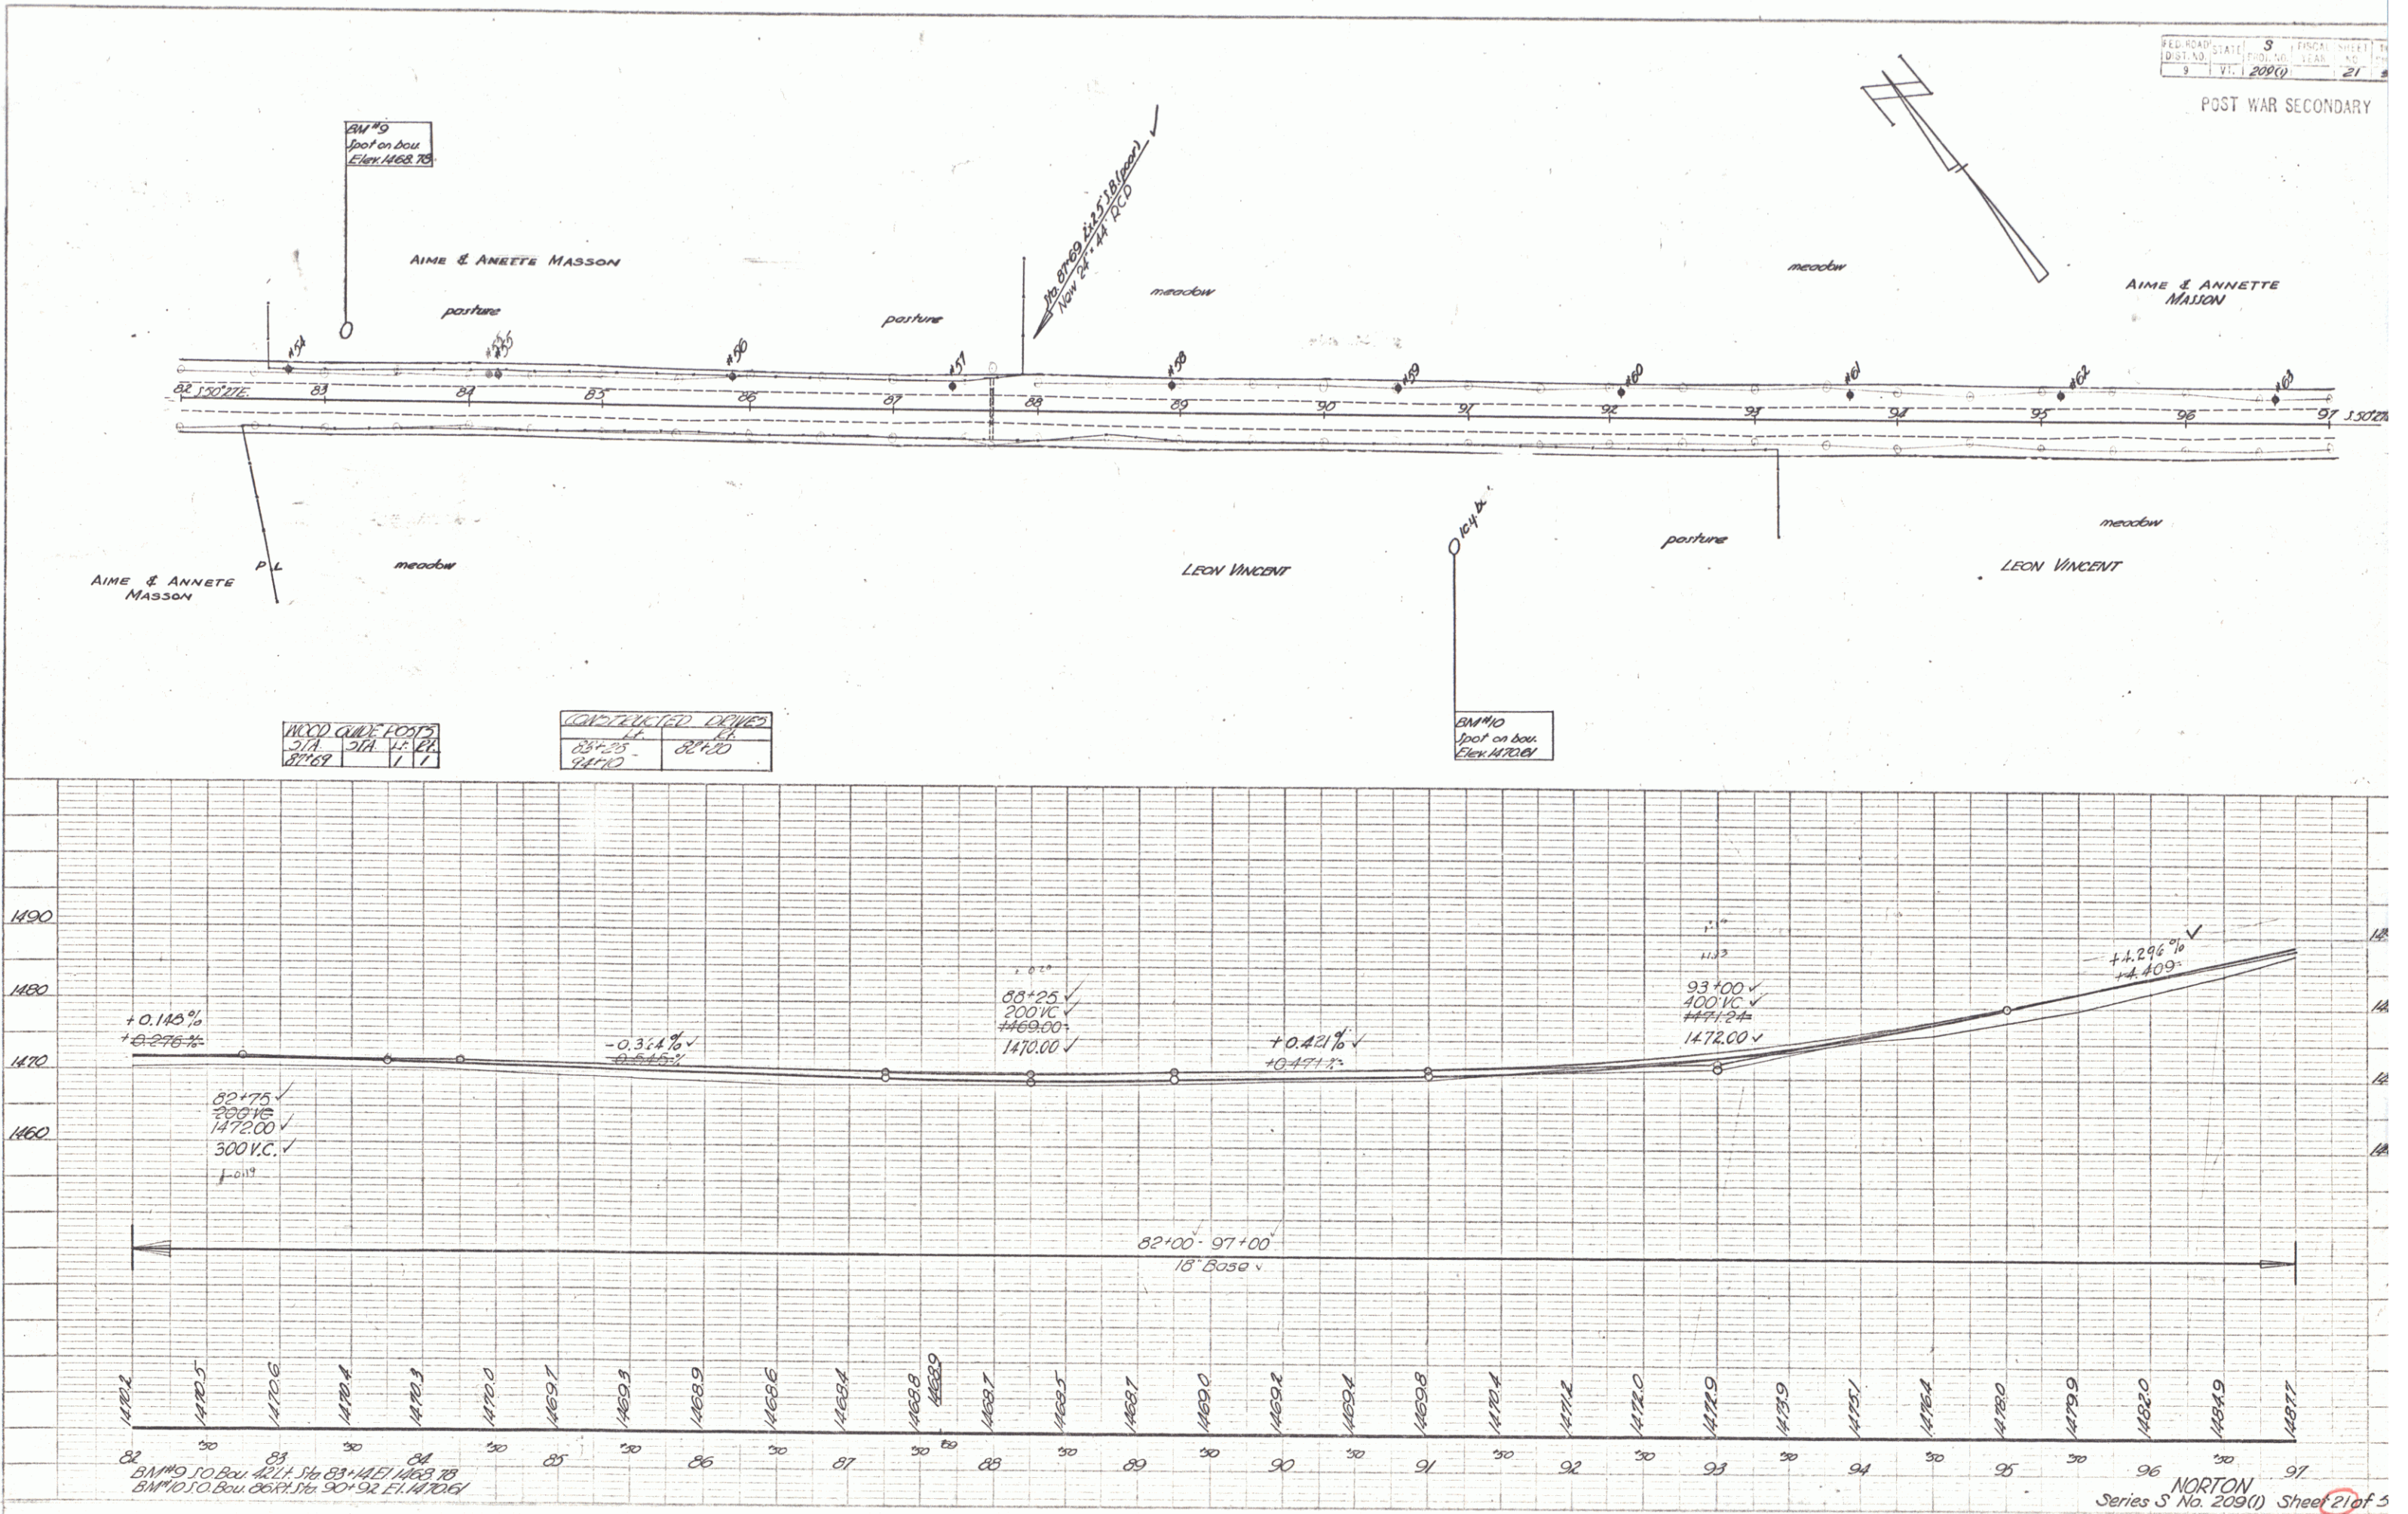

PLAN
 8-46
 9-49
 10-49
 11-49
 12-49
 1-50
 2-50
 3-50
 4-50
 5-50
 6-50
 7-50
 8-50
 9-50
 10-50
 11-50
 12-50
 1-51
 2-51
 3-51
 4-51
 5-51
 6-51
 7-51
 8-51
 9-51
 10-51
 11-51
 12-51
 1-52
 2-52
 3-52
 4-52
 5-52
 6-52
 7-52
 8-52
 9-52
 10-52
 11-52
 12-52
 1-53
 2-53
 3-53
 4-53
 5-53
 6-53
 7-53
 8-53
 9-53
 10-53
 11-53
 12-53
 1-54
 2-54
 3-54
 4-54
 5-54
 6-54
 7-54
 8-54
 9-54
 10-54
 11-54
 12-54
 1-55
 2-55
 3-55
 4-55
 5-55
 6-55
 7-55
 8-55
 9-55
 10-55
 11-55
 12-55
 1-56
 2-56
 3-56
 4-56
 5-56
 6-56
 7-56
 8-56
 9-56
 10-56
 11-56
 12-56
 1-57
 2-57
 3-57
 4-57
 5-57
 6-57
 7-57
 8-57
 9-57
 10-57
 11-57
 12-57
 1-58
 2-58
 3-58
 4-58
 5-58
 6-58
 7-58
 8-58
 9-58
 10-58
 11-58
 12-58
 1-59
 2-59
 3-59
 4-59
 5-59
 6-59
 7-59
 8-59
 9-59
 10-59
 11-59
 12-59
 1-60
 2-60
 3-60
 4-60
 5-60
 6-60
 7-60
 8-60
 9-60
 10-60
 11-60
 12-60
 1-61
 2-61
 3-61
 4-61
 5-61
 6-61
 7-61
 8-61
 9-61
 10-61
 11-61
 12-61
 1-62
 2-62
 3-62
 4-62
 5-62
 6-62
 7-62
 8-62
 9-62
 10-62
 11-62
 12-62
 1-63
 2-63
 3-63
 4-63
 5-63
 6-63
 7-63
 8-63
 9-63
 10-63
 11-63
 12-63
 1-64
 2-64
 3-64
 4-64
 5-64
 6-64
 7-64
 8-64
 9-64
 10-64
 11-64
 12-64
 1-65
 2-65
 3-65
 4-65
 5-65
 6-65
 7-65
 8-65
 9-65
 10-65
 11-65
 12-65
 1-66
 2-66
 3-66
 4-66
 5-66
 6-66
 7-66
 8-66
 9-66
 10-66
 11-66
 12-66
 1-67
 2-67
 3-67
 4-67
 5-67
 6-67
 7-67
 8-67
 9-67
 10-67
 11-67
 12-67
 1-68
 2-68
 3-68
 4-68
 5-68
 6-68
 7-68
 8-68
 9-68
 10-68
 11-68
 12-68
 1-69
 2-69
 3-69
 4-69
 5-69
 6-69
 7-69
 8-69
 9-69
 10-69
 11-69
 12-69
 1-70
 2-70
 3-70
 4-70
 5-70
 6-70
 7-70
 8-70
 9-70
 10-70
 11-70
 12-70
 1-71
 2-71
 3-71
 4-71
 5-71
 6-71
 7-71
 8-71
 9-71
 10-71
 11-71
 12-71
 1-72
 2-72
 3-72
 4-72
 5-72
 6-72
 7-72
 8-72
 9-72
 10-72
 11-72
 12-72
 1-73
 2-73
 3-73
 4-73
 5-73
 6-73
 7-73
 8-73
 9-73
 10-73
 11-73
 12-73
 1-74
 2-74
 3-74
 4-74
 5-74
 6-74
 7-74
 8-74
 9-74
 10-74
 11-74
 12-74
 1-75
 2-75
 3-75
 4-75
 5-75
 6-75
 7-75
 8-75
 9-75
 10-75
 11-75
 12-75
 1-76
 2-76
 3-76
 4-76
 5-76
 6-76
 7-76
 8-76
 9-76
 10-76
 11-76
 12-76
 1-77
 2-77
 3-77
 4-77
 5-77
 6-77
 7-77
 8-77
 9-77
 10-77
 11-77
 12-77
 1-78
 2-78
 3-78
 4-78
 5-78
 6-78
 7-78
 8-78
 9-78
 10-78
 11-78
 12-78
 1-79
 2-79
 3-79
 4-79
 5-79
 6-79
 7-79
 8-79
 9-79
 10-79
 11-79
 12-79
 1-80
 2-80
 3-80
 4-80
 5-80
 6-80
 7-80
 8-80
 9-80
 10-80
 11-80
 12-80
 1-81
 2-81
 3-81
 4-81
 5-81
 6-81
 7-81
 8-81
 9-81
 10-81
 11-81
 12-81
 1-82
 2-82
 3-82
 4-82
 5-82
 6-82
 7-82
 8-82
 9-82
 10-82
 11-82
 12-82
 1-83
 2-83
 3-83
 4-83
 5-83
 6-83
 7-83
 8-83
 9-83
 10-83
 11-83
 12-83
 1-84
 2-84
 3-84
 4-84
 5-84
 6-84
 7-84
 8-84
 9-84
 10-84
 11-84
 12-84
 1-85
 2-85
 3-85
 4-85
 5-85
 6-85
 7-85
 8-85
 9-85
 10-85
 11-85
 12-85
 1-86
 2-86
 3-86
 4-86
 5-86
 6-86
 7-86
 8-86
 9-86
 10-86
 11-86
 12-86
 1-87
 2-87
 3-87
 4-87
 5-87
 6-87
 7-87
 8-87
 9-87
 10-87
 11-87
 12-87
 1-88
 2-88
 3-88
 4-88
 5-88
 6-88
 7-88
 8-88
 9-88
 10-88
 11-88
 12-88
 1-89
 2-89
 3-89
 4-89
 5-89
 6-89
 7-89
 8-89
 9-89
 10-89
 11-89
 12-89
 1-90
 2-90
 3-90
 4-90
 5-90
 6-90
 7-90
 8-90
 9-90
 10-90
 11-90
 12-90
 1-91
 2-91
 3-91
 4-91
 5-91
 6-91
 7-91
 8-91
 9-91
 10-91
 11-91
 12-91
 1-92
 2-92
 3-92
 4-92
 5-92
 6-92
 7-92
 8-92
 9-92
 10-92
 11-92
 12-92
 1-93
 2-93
 3-93
 4-93
 5-93
 6-93
 7-93
 8-93
 9-93
 10-93
 11-93
 12-93
 1-94
 2-94
 3-94
 4-94
 5-94
 6-94
 7-94
 8-94
 9-94
 10-94
 11-94
 12-94
 1-95
 2-95
 3-95
 4-95
 5-95
 6-95
 7-95
 8-95
 9-95
 10-95
 11-95
 12-95
 1-96
 2-96
 3-96
 4-96
 5-96
 6-96
 7-96
 8-96
 9-96
 10-96
 11-96
 12-96
 1-97
 2-97
 3-97
 4-97
 5-97
 6-97
 7-97
 8-97
 9-97
 10-97
 11-97
 12-97
 1-98
 2-98
 3-98
 4-98
 5-98
 6-98
 7-98
 8-98
 9-98
 10-98
 11-98
 12-98
 1-99
 2-99
 3-99
 4-99
 5-99
 6-99
 7-99
 8-99
 9-99
 10-99
 11-99
 12-99
 1-100
 2-100
 3-100
 4-100
 5-100
 6-100
 7-100
 8-100
 9-100
 10-100
 11-100
 12-100
 1-101
 2-101
 3-101
 4-101
 5-101
 6-101
 7-101
 8-101
 9-101
 10-101
 11-101
 12-101
 1-102
 2-102
 3-102
 4-102
 5-102
 6-102
 7-102
 8-102
 9-102
 10-102
 11-102
 12-102
 1-103
 2-103
 3-103
 4-103
 5-103
 6-103
 7-103
 8-103
 9-103
 10-103
 11-103
 12-103
 1-104
 2-104
 3-104
 4-104
 5-104
 6-104
 7-104
 8-104
 9-104
 10-104
 11-104
 12-104
 1-105
 2-105
 3-105
 4-105
 5-105
 6-105
 7-105
 8-105
 9-105
 10-105
 11-105
 12-105
 1-106
 2-106
 3-106
 4-106
 5-106
 6-106
 7-106
 8-106
 9-106
 10-106
 11-106
 12-106
 1-107
 2-107
 3-107
 4-107
 5-107
 6-107
 7-107
 8-107
 9-107
 10-107
 11-107
 12-107
 1-108
 2-108
 3-108
 4-108
 5-108
 6-108
 7-108
 8-108
 9-108
 10-108
 11-108
 12-108
 1-109
 2-109
 3-109
 4-109
 5-109
 6-109
 7-109
 8-109
 9-109
 10-109
 11-109
 12-109
 1-110
 2-110
 3-110
 4-110
 5-110
 6-110
 7-110
 8-110
 9-110
 10-110
 11-110
 12-110
 1-111
 2-111
 3-111
 4-111
 5-111
 6-111
 7-111
 8-111
 9-111
 10-111
 11-111
 12-111
 1-112
 2-112
 3-112
 4-112
 5-112
 6-112
 7-112
 8-112
 9-112
 10-112
 11-112
 12-112
 1-113
 2-113
 3-113
 4-113
 5-113
 6-113
 7-113
 8-113
 9-113
 10-113
 11-113
 12-113
 1-114
 2-114
 3-114
 4-114
 5-114
 6-114
 7-114
 8-114
 9-114
 10-114
 11-114
 12-114
 1-115
 2-115
 3-115
 4-115
 5-115
 6-115
 7-115
 8-115
 9-115
 10-115
 11-115
 12-115
 1-116
 2-116
 3-116
 4-116
 5-116
 6-116
 7-116
 8-116
 9-116
 10-116
 11-116
 12-116
 1-117
 2-117
 3-117
 4-117
 5-117
 6-117
 7-117
 8-117
 9-117
 10-117
 11-117
 12-117
 1-118
 2-118
 3-118
 4-118
 5-118
 6-118
 7-118
 8-118
 9-118
 10-118
 11-118
 12-118
 1-119
 2-119
 3-119
 4-119
 5-119
 6-119
 7-119
 8-119
 9-119
 10-119
 11-119
 12-119
 1-120
 2-120
 3-120
 4-120
 5-120
 6-120
 7-120
 8-120
 9-120
 10-120
 11-120
 12-120
 1-121
 2-121
 3-121
 4-121
 5-121
 6-121
 7-121
 8-121
 9-121
 10-121
 11-121
 12-121
 1-122
 2-122
 3-122
 4-122
 5-122
 6-122
 7-122
 8-122
 9-122
 10-122
 11-122
 12-122
 1-123
 2-123
 3-123
 4-123
 5-123
 6-123
 7-123
 8-123
 9-123
 10-123
 11-123
 12-123
 1-124
 2-124
 3-124
 4-124
 5-124
 6-124
 7-124
 8-124
 9-124
 10-124
 11-124
 12-124
 1-125
 2-125
 3-125
 4-125
 5-125
 6-125
 7-125
 8-125
 9-125
 10-125
 11-125
 12-125
 1-126
 2-126
 3-126
 4-126
 5-126
 6-126
 7-126
 8-126
 9-126
 10-126
 11-126
 12-126
 1-127
 2-127
 3-127
 4-127
 5-127
 6-127
 7-127
 8-127
 9-127
 10-127
 11-127
 12-127
 1-128
 2-128
 3-128
 4-128
 5-128
 6-128
 7-128
 8-128
 9-128
 10-128
 11-128
 12-128
 1-129
 2-129
 3-129
 4-129
 5-129
 6-129
 7-129
 8-129
 9-129
 10-129
 11-129
 12-129
 1-130
 2-130
 3-130
 4-130
 5-130
 6-130
 7-130
 8-130
 9-130
 10-130
 11-130
 12-130
 1-131
 2-131
 3-131
 4-131
 5-131
 6-131
 7-131
 8-131
 9-131
 10-131
 11-131
 12-131
 1-132
 2-132
 3-132
 4-132
 5-132
 6-132
 7-132
 8-132
 9-132
 10-132
 11-132
 12-132
 1-133
 2-133
 3-133
 4-133
 5-133
 6-133
 7-133
 8-133
 9-133
 10-133
 11-133
 12-133
 1-134
 2-134
 3-134
 4-134
 5-134
 6-134
 7-134
 8-134
 9-134
 10-134
 11-134
 12-134
 1-135
 2-135
 3-135
 4-135
 5-135
 6-135
 7-135
 8-135
 9-135
 10-135
 11-135
 12-135
 1-136
 2-136
 3-136
 4-136
 5-136
 6-136
 7-136
 8-136
 9-136
 10-136
 11-136
 12-136
 1-137
 2-137
 3-137
 4-137
 5-137
 6-137
 7-137
 8-137
 9-137
 10-137
 11-137
 12-137
 1-138
 2-138
 3-138
 4-138
 5-138
 6-138
 7-138
 8-138
 9-138
 10-138
 11-138
 12-138
 1-139
 2-139
 3-139
 4-139
 5-139
 6-139
 7-139
 8-139
 9-139
 10-139
 11-139
 12-139
 1-140
 2-140
 3-140
 4-140
 5-140
 6-140
 7-140
 8-140
 9-140
 10-140
 11-140
 12-140
 1-141
 2-141
 3-141
 4-141
 5-141
 6-141
 7-141
 8-141
 9-141
 10-141
 11-141
 12-141
 1-142
 2-142
 3-142
 4-142
 5-142
 6-142
 7-142
 8-142
 9-142
 10-142
 11-142
 12-142
 1-143
 2-143
 3-143
 4-143
 5-143
 6-143
 7-143
 8-143
 9-143
 10-143
 11-143
 12-143
 1-144
 2-144
 3-144
 4-144
 5-144
 6-144
 7-144
 8-144
 9-144
 10-144
 11-144
 12-144
 1-145
 2-145
 3-145
 4-145
 5-145
 6-145
 7-145
 8-145
 9-145
 10-145
 11-145
 12-145
 1-146
 2-146
 3-146
 4-146
 5-146
 6-146
 7-146
 8-146
 9-146
 10-146
 11-146
 12-146
 1-147
 2-147
 3-147
 4-147
 5-147
 6-147
 7-147
 8-147
 9-147
 10-147
 11-147
 12-147
 1-148
 2-148
 3-148
 4-148
 5-148
 6-148
 7-148
 8-148
 9-148
 10-148
 11-148
 12-148
 1-149
 2-149
 3-149
 4-149
 5-149
 6-149
 7-149
 8-149
 9-149
 10-149
 11-149
 12-149
 1-150
 2-150
 3-150
 4-150
 5-150
 6-150
 7-150
 8-150
 9-150
 10-150
 11-150
 12-150
 1-151
 2-151
 3-151
 4-151
 5-151
 6-151
 7-151
 8-151
 9-151
 10-151
 11-151
 12-151
 1-152
 2-152
 3-152
 4-152
 5-152
 6-152
 7-152
 8-152
 9-152
 10-152
 11-152
 12-152
 1-153
 2-153
 3-153
 4-153
 5-153
 6-153
 7-153
 8-153
 9-153
 10-153
 11-153
 12-153
 1-154
 2-154
 3-154
 4-154
 5-154
 6-154
 7-154
 8-154
 9-154
 10-154
 11-154

PLAN	8-48
PROPOSED	8-48
REVISION	9-48
DATE	11-1-48
BY	W.C.B.
CHECKED	W.C.B.

PLAN	8-48
PROPOSED	8-48
REVISION	9-48
DATE	11-1-48
BY	W.C.B.
CHECKED	W.C.B.

WOOD GUIDE POSTS			
STA	STA.	Lt.	Rt.
144+57.5			1
148+68	150+60	13	
153+51.5		1	1


BM #17
Spot on road
Elev. 1612.81

BM #18
Spot on road
Elev. 1652.84

CONSTRUCT DRIVE
149+00 RT

CONSTRUCTED	149+00
149+00	149+00

POST WAR SECONDARY	
ST. NO.	5
YEAR	25

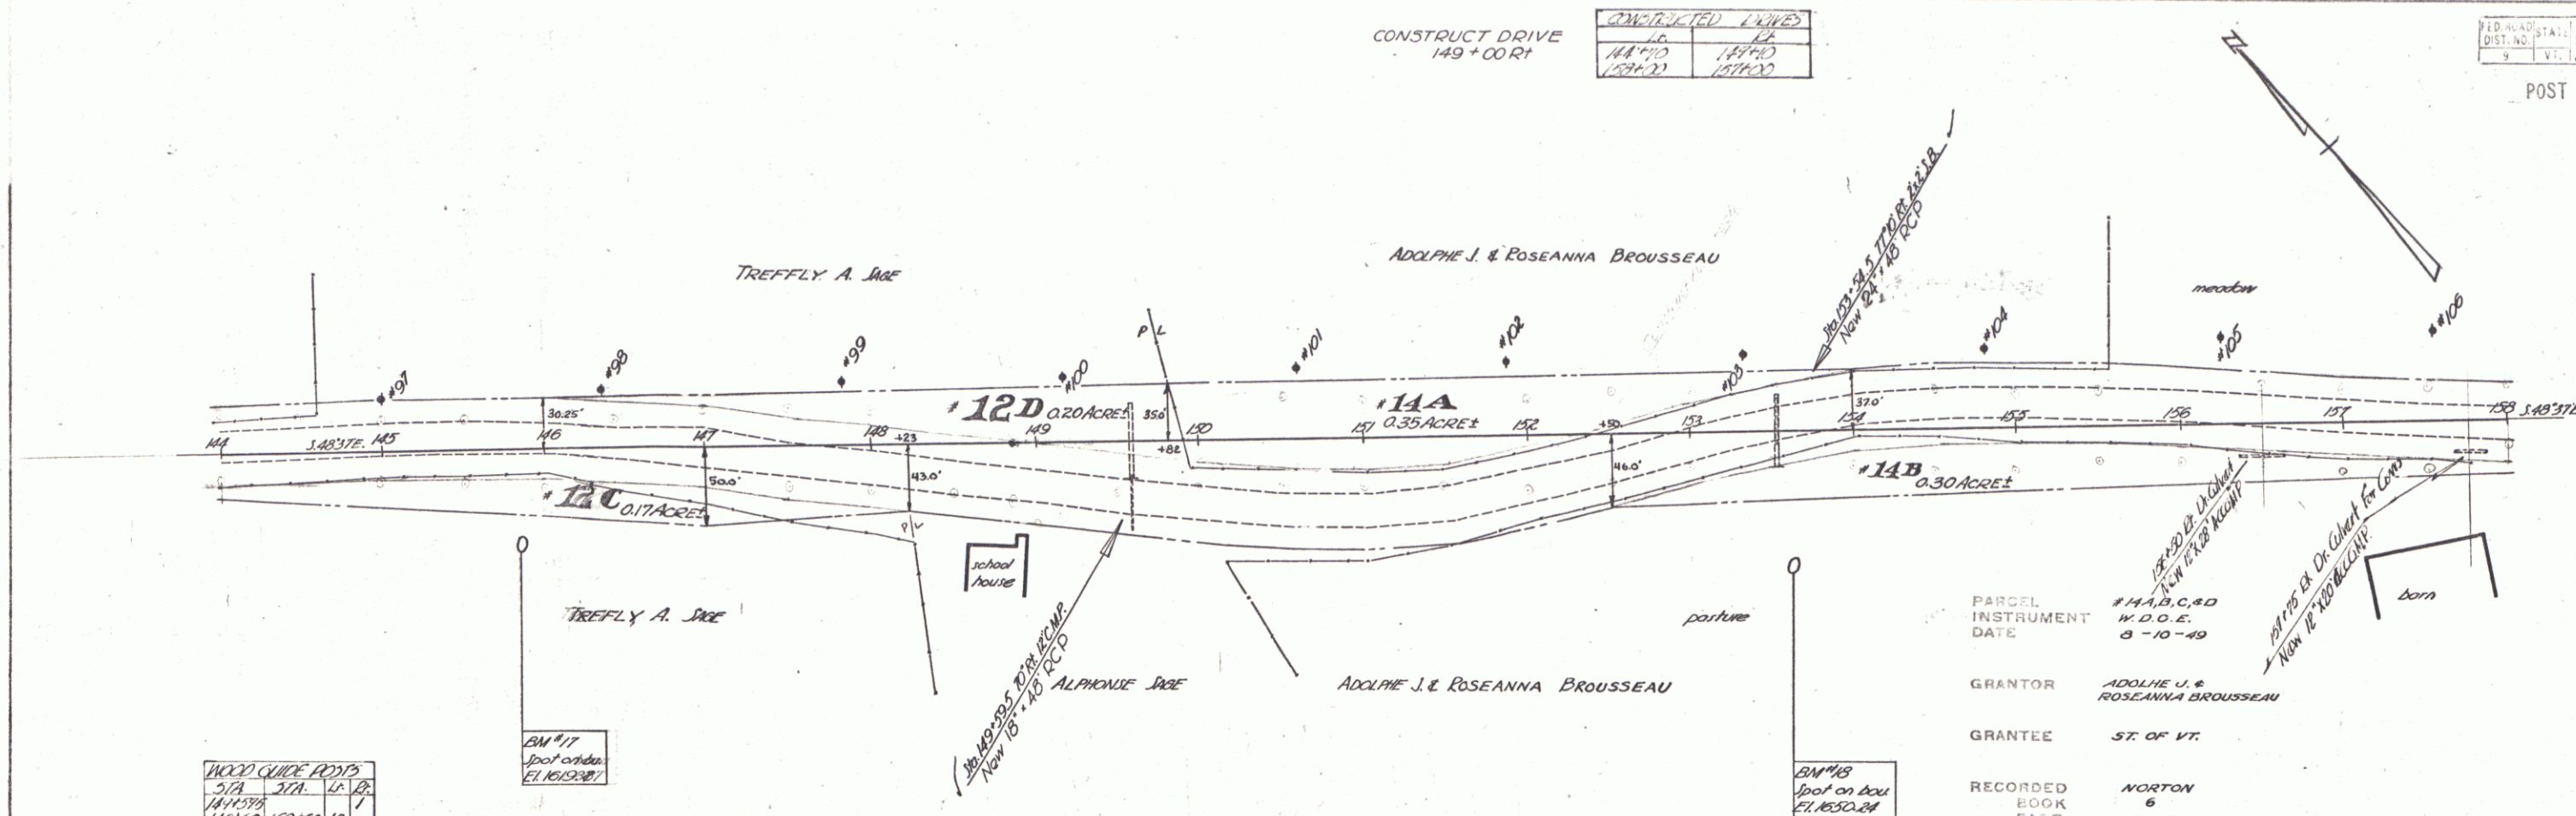

PARCEL INSTRUMENT DATE #14, B, C, D W.D.O.E. 8-10-49
GRANTOR ADOLPHE J. & ROSEANNA BROUSSEAU
GRANTEE ST. OF VT.
RECORDED BOOK 6 PAGE 308-30 DATE 9-25-49
REMARKS: #14 C/D ON SHEET 26

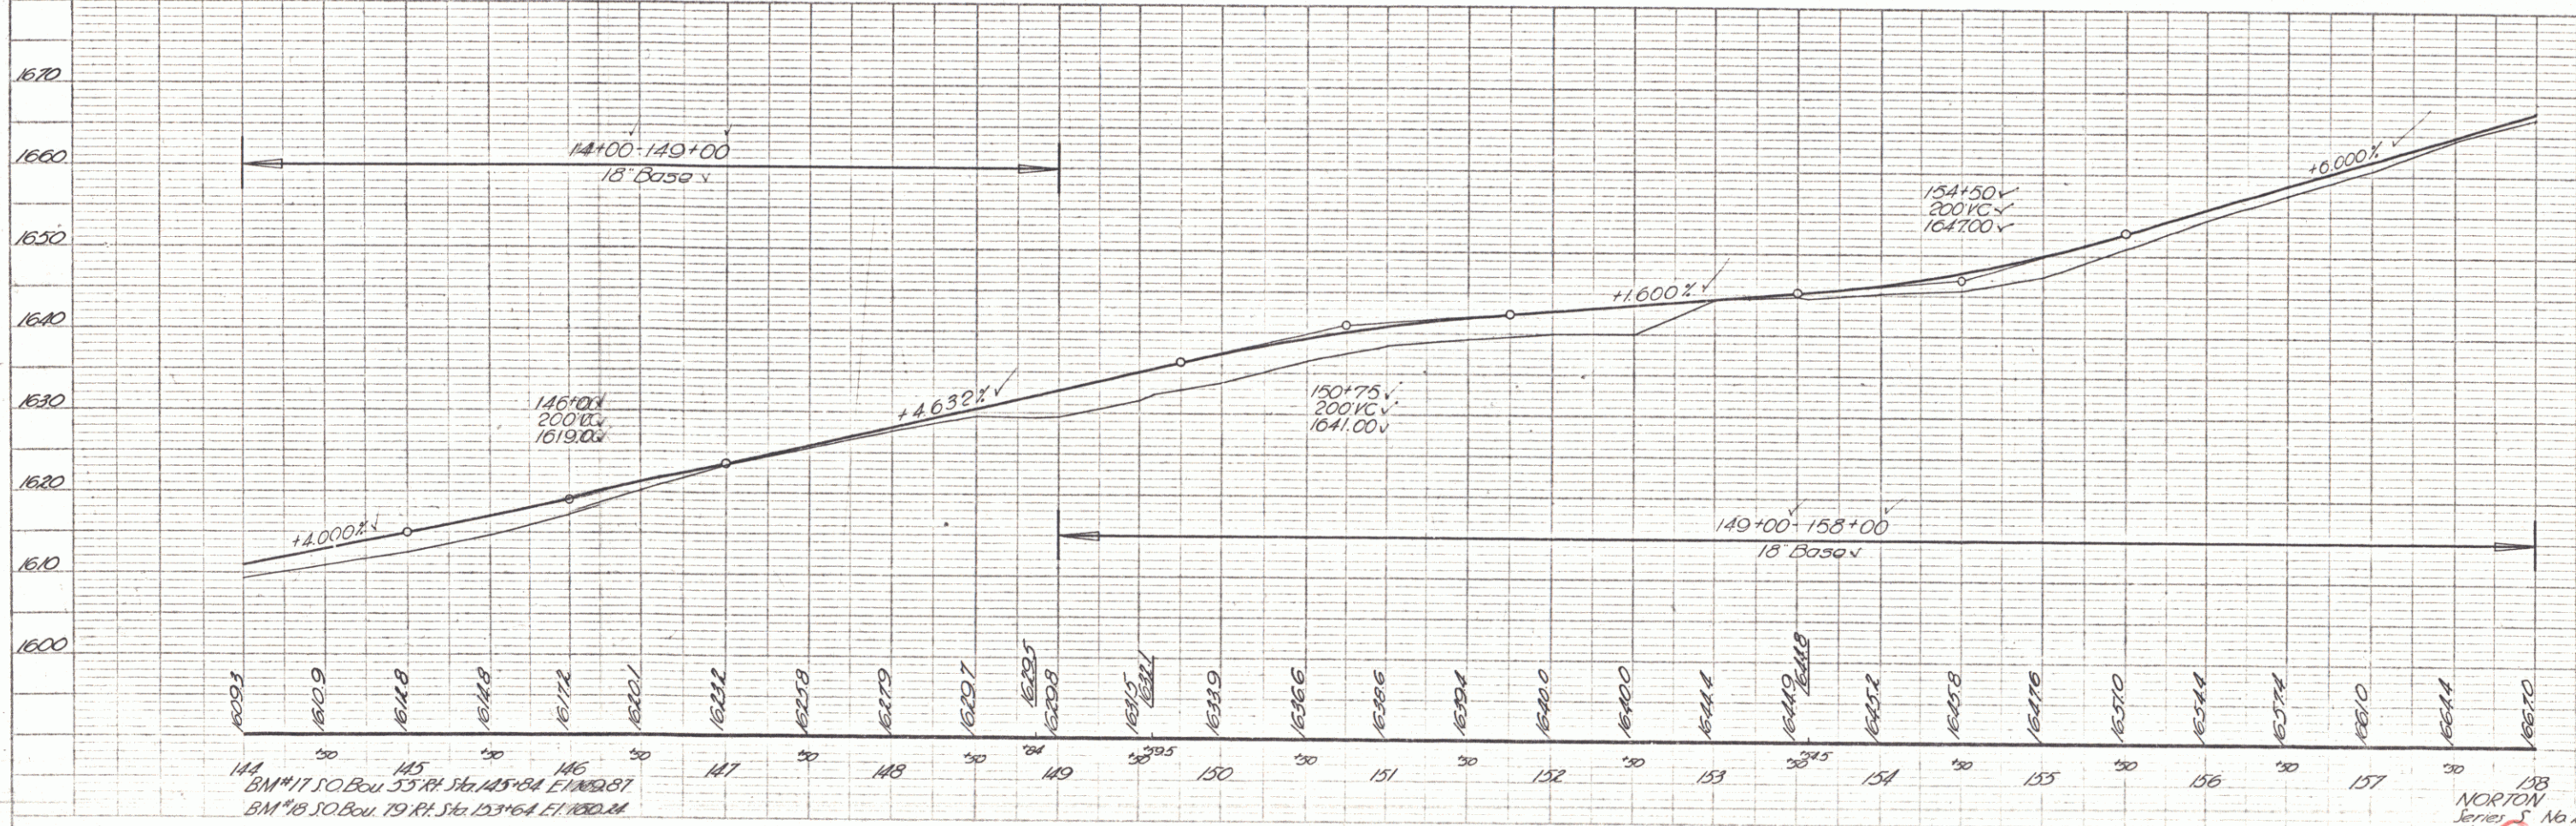


PLATE 1-PLAN-PROFILE OF S. P. R. & R. ROAD
RECORDED & INDEXED, NEW YORK

14 & 15 No. 1010
14 & 15 No. 1010

