

INDEX OF SHEETS	
SHEET NO.	TITLE PAGE
1	BANKING AND WIDENING TABLES
2	TYPICAL SECTIONS
3	TYPICAL SECTIONS
4	QUANTITY SHEET, ITEMS
5	QUANTITY SHEET, DRAINAGE
6	EARTHWORKS
7-10	PLAN AND PROFILE SHEETS
11-20	CONSTRUCTION DETAILS CD DRAINAGE & MARKERS
21	CONSTRUCTION DETAILS CD-1 DITCHES
22	CONSTRUCTION DETAILS CD-2 TYPICAL SLOPE GRADING
23	STANDARD STRUCTURE SHEET S-40 BARRICADES, SIGNS, & LIGHTS
24	STANDARD STRUCTURE SHEET S-48-46 THREE CABLE GUARD RAIL
25	CROSS SECTIONS
26-50	STANDARD STRUCTURE SHEETS APPROVED BY THE CHIEF ENGINEER, VERMONT STATE DEPARTMENT OF HIGHWAYS, JUNE 10, 1950

Hot Mix Macadam with Crushed Gravel / Asphalt Cement Item 311-B

STATE OF VERMONT DEPARTMENT OF HIGHWAYS

PROPOSED IMPROVEMENT


SECONDARY PROJECT

TOWN OF CANAAN COUNTY OF ESSEX VERMONT ROUTE 114 CANAAN-AVERILL ROAD


Pin # 00R470

BEGINNING AT THE WESTERLY END OF THE BRIDGE OVER
LEACH CREEK AND EXTENDING WESTERLY 13,549.8 FEET
LENGTH OF PROJECT 13,549.8 FT. = 2.566 MILES

FED. ROAD DIST. NO.	STATE	PROJECT NO.	YEAR	SHEET NO.	TOTAL SHEETS
1	VT	209 (3)	W.A.H.	1	59

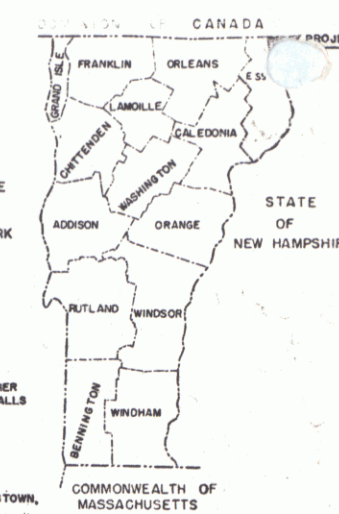

PROJECT NAME & NUMBER		TYPE	PAVEMENT AREA
CANAAN S 209 (3)		HOT MIX MACAD.	30.11 S.Y.
RECORD PLANS			
MATERIALS			
SUB-BASE OF GRAVEL	PAQUETTE PIT CLARKSVILLE, N.H.	G.R. CABLE	AM. STEEL & WIRE CO., NEW HAVEN, CONN.
CUTBACK ASPHALT	ESSO CO., EVERETT, MASS.	G.R. PAINT	BRADLEY LABS., BRATTLEBORO
R.C.P.	VT. CONC. PIPE CORP., WINDSOR	MACADAM AGG.	PAQUETTE PIT CLARKSVILLE, N.H.
ACC.G.M.P.	N.E. MET. CULVERT CO., BOSTON, MASS.	6" UNDERDRAIN	N.E. MET. CULV. CO., BOSTON, MASS.
PEN. ASPHALT	AM. BITUMULES CO. E. PROV. R.I.		
CONTRACTOR	H. J. O'CONNELL, LTD.	CONTRACT DATED	JUNE 8, 1954
RESIDENT ENGR	R. WOODWARD	CONTRACT STARTED	JUNE 15, 1954
INSPECTORS	H. MILES	CONTRACT COMPLETED	OCT. 6, 1955
RECORD PLANS	KAMBOUR-WOODWARD	CONTRACT ACCEPTED	OCT. 6, 1955

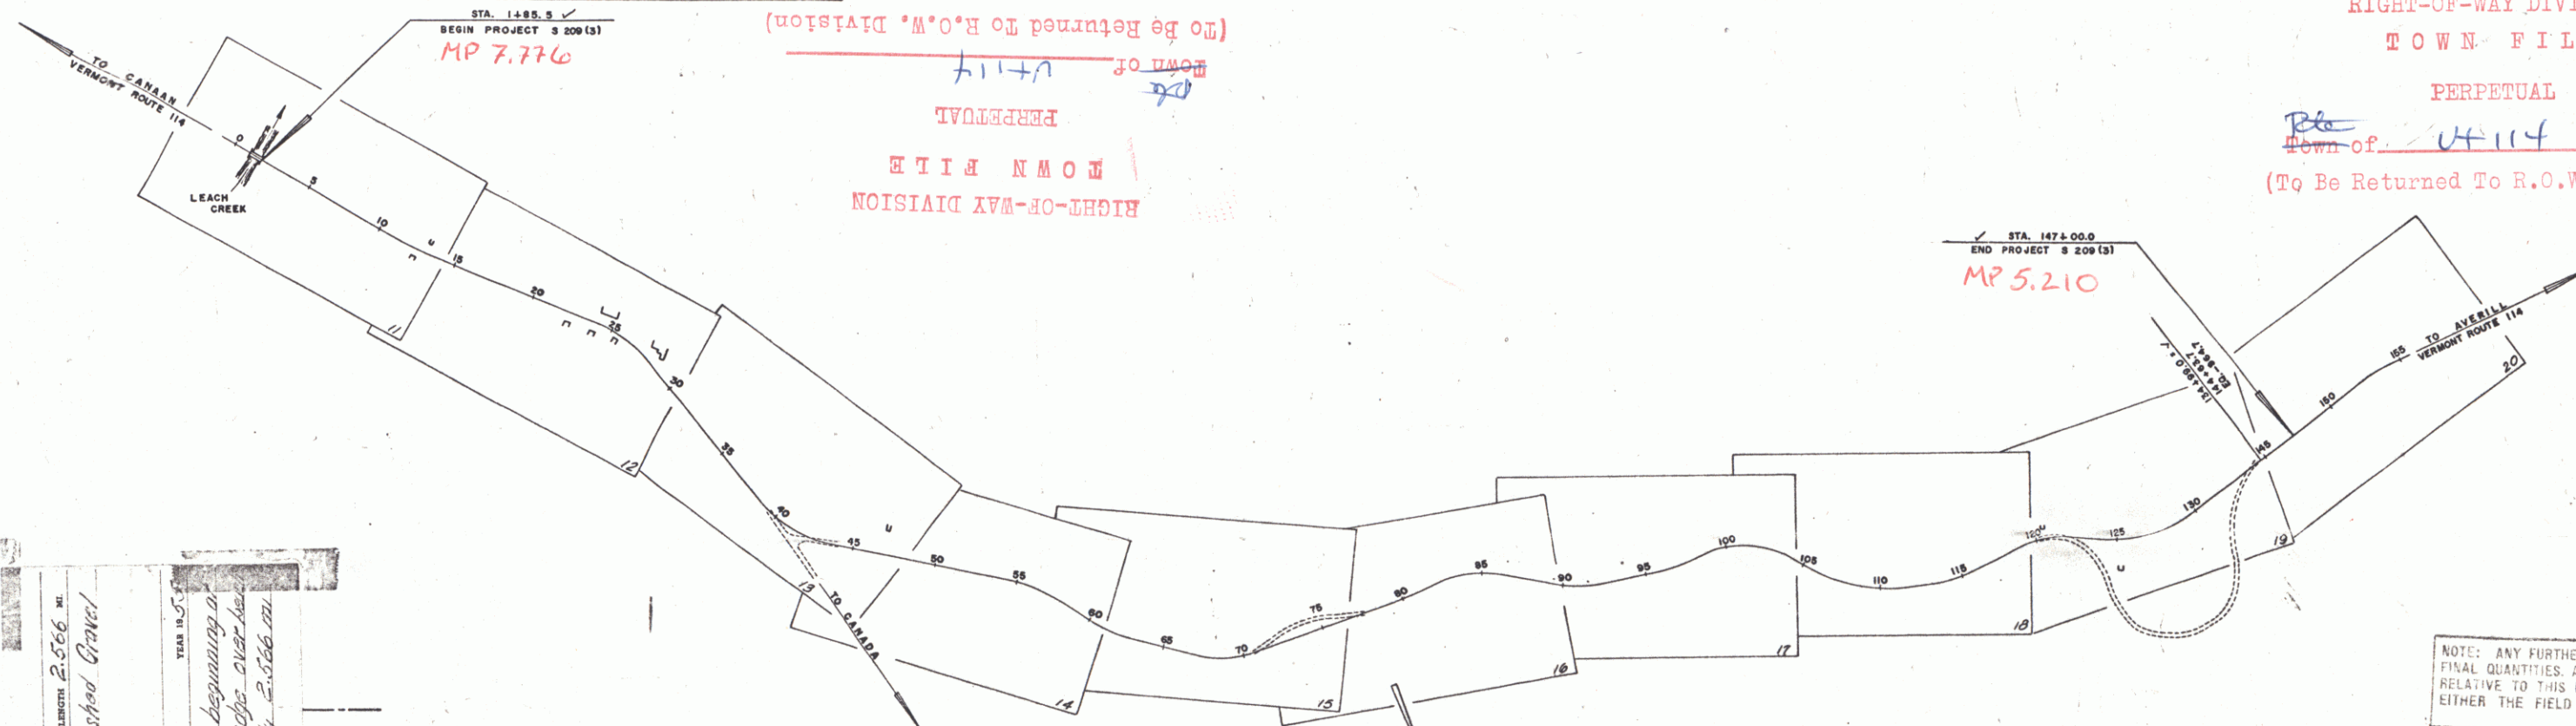

RIGHT-OF-WAY DIVISION
TOWN FILE

PERPETUAL

Be Town of Canaan
(To Be Returned To R.O.W. Division)

PROJECT: Canaan
SHEET: S 209 (3)
TYPE: Hot Mix Macadam with Crushed Gravel
CONTRACTOR: H. J. O'Connell, Ltd.
LOCATION: Canaan-Averill Road, beginning at the westerly end of the bridge over Leach Creek and extending westerly 2.566 miles

GROUND ELEVATION	DATUM	LINE
GRADE ELEVATION	DATUM	LINE
CURVE DATA		
DEFLECTION ANGLE	Δ	
DEGREE OF CURVE	D	
RADIUS OF CURVE	R	
TANGENT DISTANCE	T	
LENGTH OF CURVE	L	
EXTERNAL DISTANCE	E	
POINT OF INTERSECTION	P.I.	
POINT OF CURVE	P.C.	
POINT OF TANGENT	P.T.	
POINT ON TANGENT	P.O.T.	
POINT ON SUB-TANGENT	P.O.S.T.	

SCALES	
TITLE	1" = 500'
TYPICAL	1" = 2'
PLAN	1" = 50'
PROFILE	1" = 50'
CROSS-SECTIONS	1" = 5'

THESE PLANS ARE SUBJECT TO SUCH REVISIONS AS MAY BE REQUIRED BY THE BUREAU OF PUBLIC ROADS OR THE COMMISSIONER OF HIGHWAYS.
CONSTRUCTION IS TO BE CARRIED ON IN ACCORDANCE WITH THE PLANS AND THE STANDARD ROAD AND BRIDGE SPECIFICATIONS OF 1948, AS APPROVED JULY 25, 1949 BY THE BUREAU OF PUBLIC ROADS, INCLUDING ALL SUBSEQUENT APPROVED REVISIONS AND SUCH REVISED SPECIFICATIONS AND SPECIAL PROVISIONS AS ARE SUBMITTED WITH THE PLANS.

NOTE: ANY FURTHER INFORMATION CONCERNING FINAL QUANTITIES, AMOUNTS OR OTHER DETAILS RELATIVE TO THIS PROJECT MAY BE FOUND IN EITHER THE FIELD BOOKS OR THE ESTIMATE FILE.


DEPARTMENT OF COMMERCE
BUREAU OF PUBLIC ROADS
DISTRICT ENGINEER
APPROVED
DATE

APPROVED: [Signature] CONSTRUCTION ENGINEER DATE: 12-19-53
APPROVED: [Signature] SECONDARY ENGINEER DATE: 12-19-53
APPROVED: [Signature] DISTRICT ENGINEER DATE: 12-18-53
APPROVED: [Signature] HIGHWAY ENGINEER DATE: 12-18-53
APPROVED: [Signature] CHIEF ENGINEER DATE: 12-18-53
SUBMITTED BY: [Signature] UNDER THE STATE HIGHWAY BOARD


PROJECT S NO. 209 (3)
SHEET 1 OF 59 SHEETS

PLAN	DATE	BY	CHECKED	DATE	BY
	9/12	Alma		9/12	Alma

PROFILE	DATE	BY	CHECKED	DATE	BY
	9/12	Alma		9/12	Alma

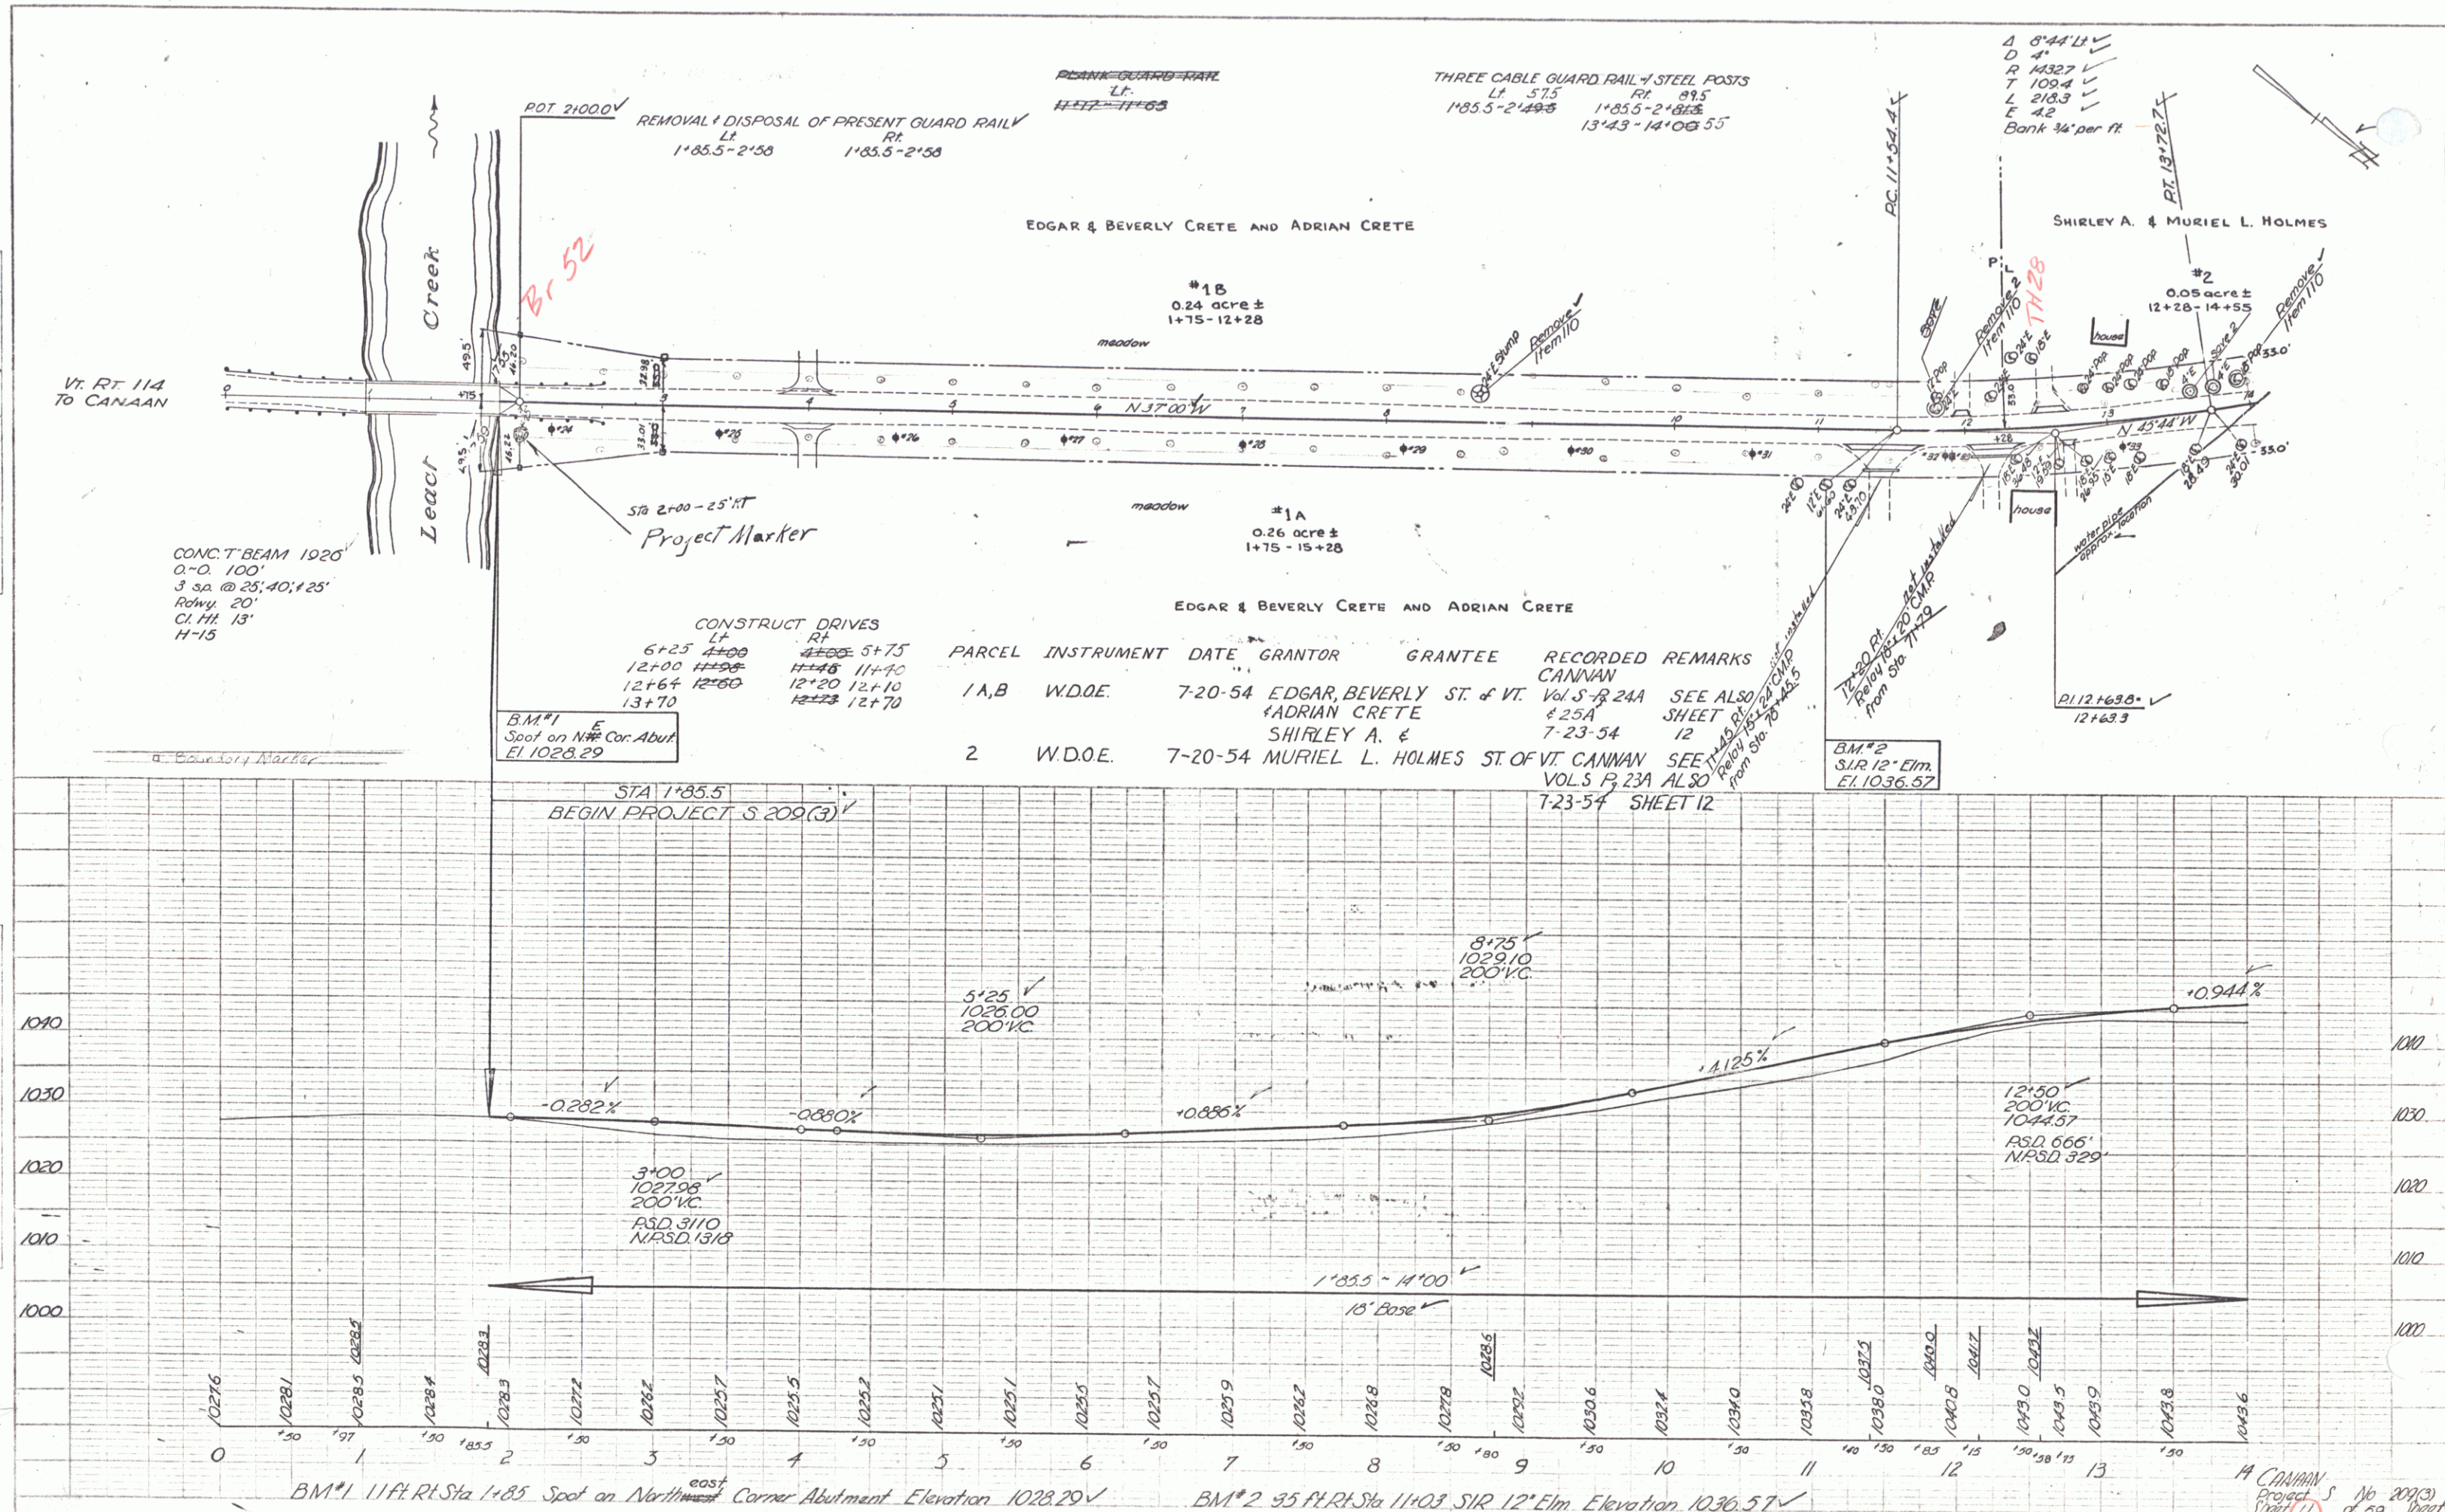

H. CANAAN
Project S No 209(3)
Sheet 1 of 59 Sheets

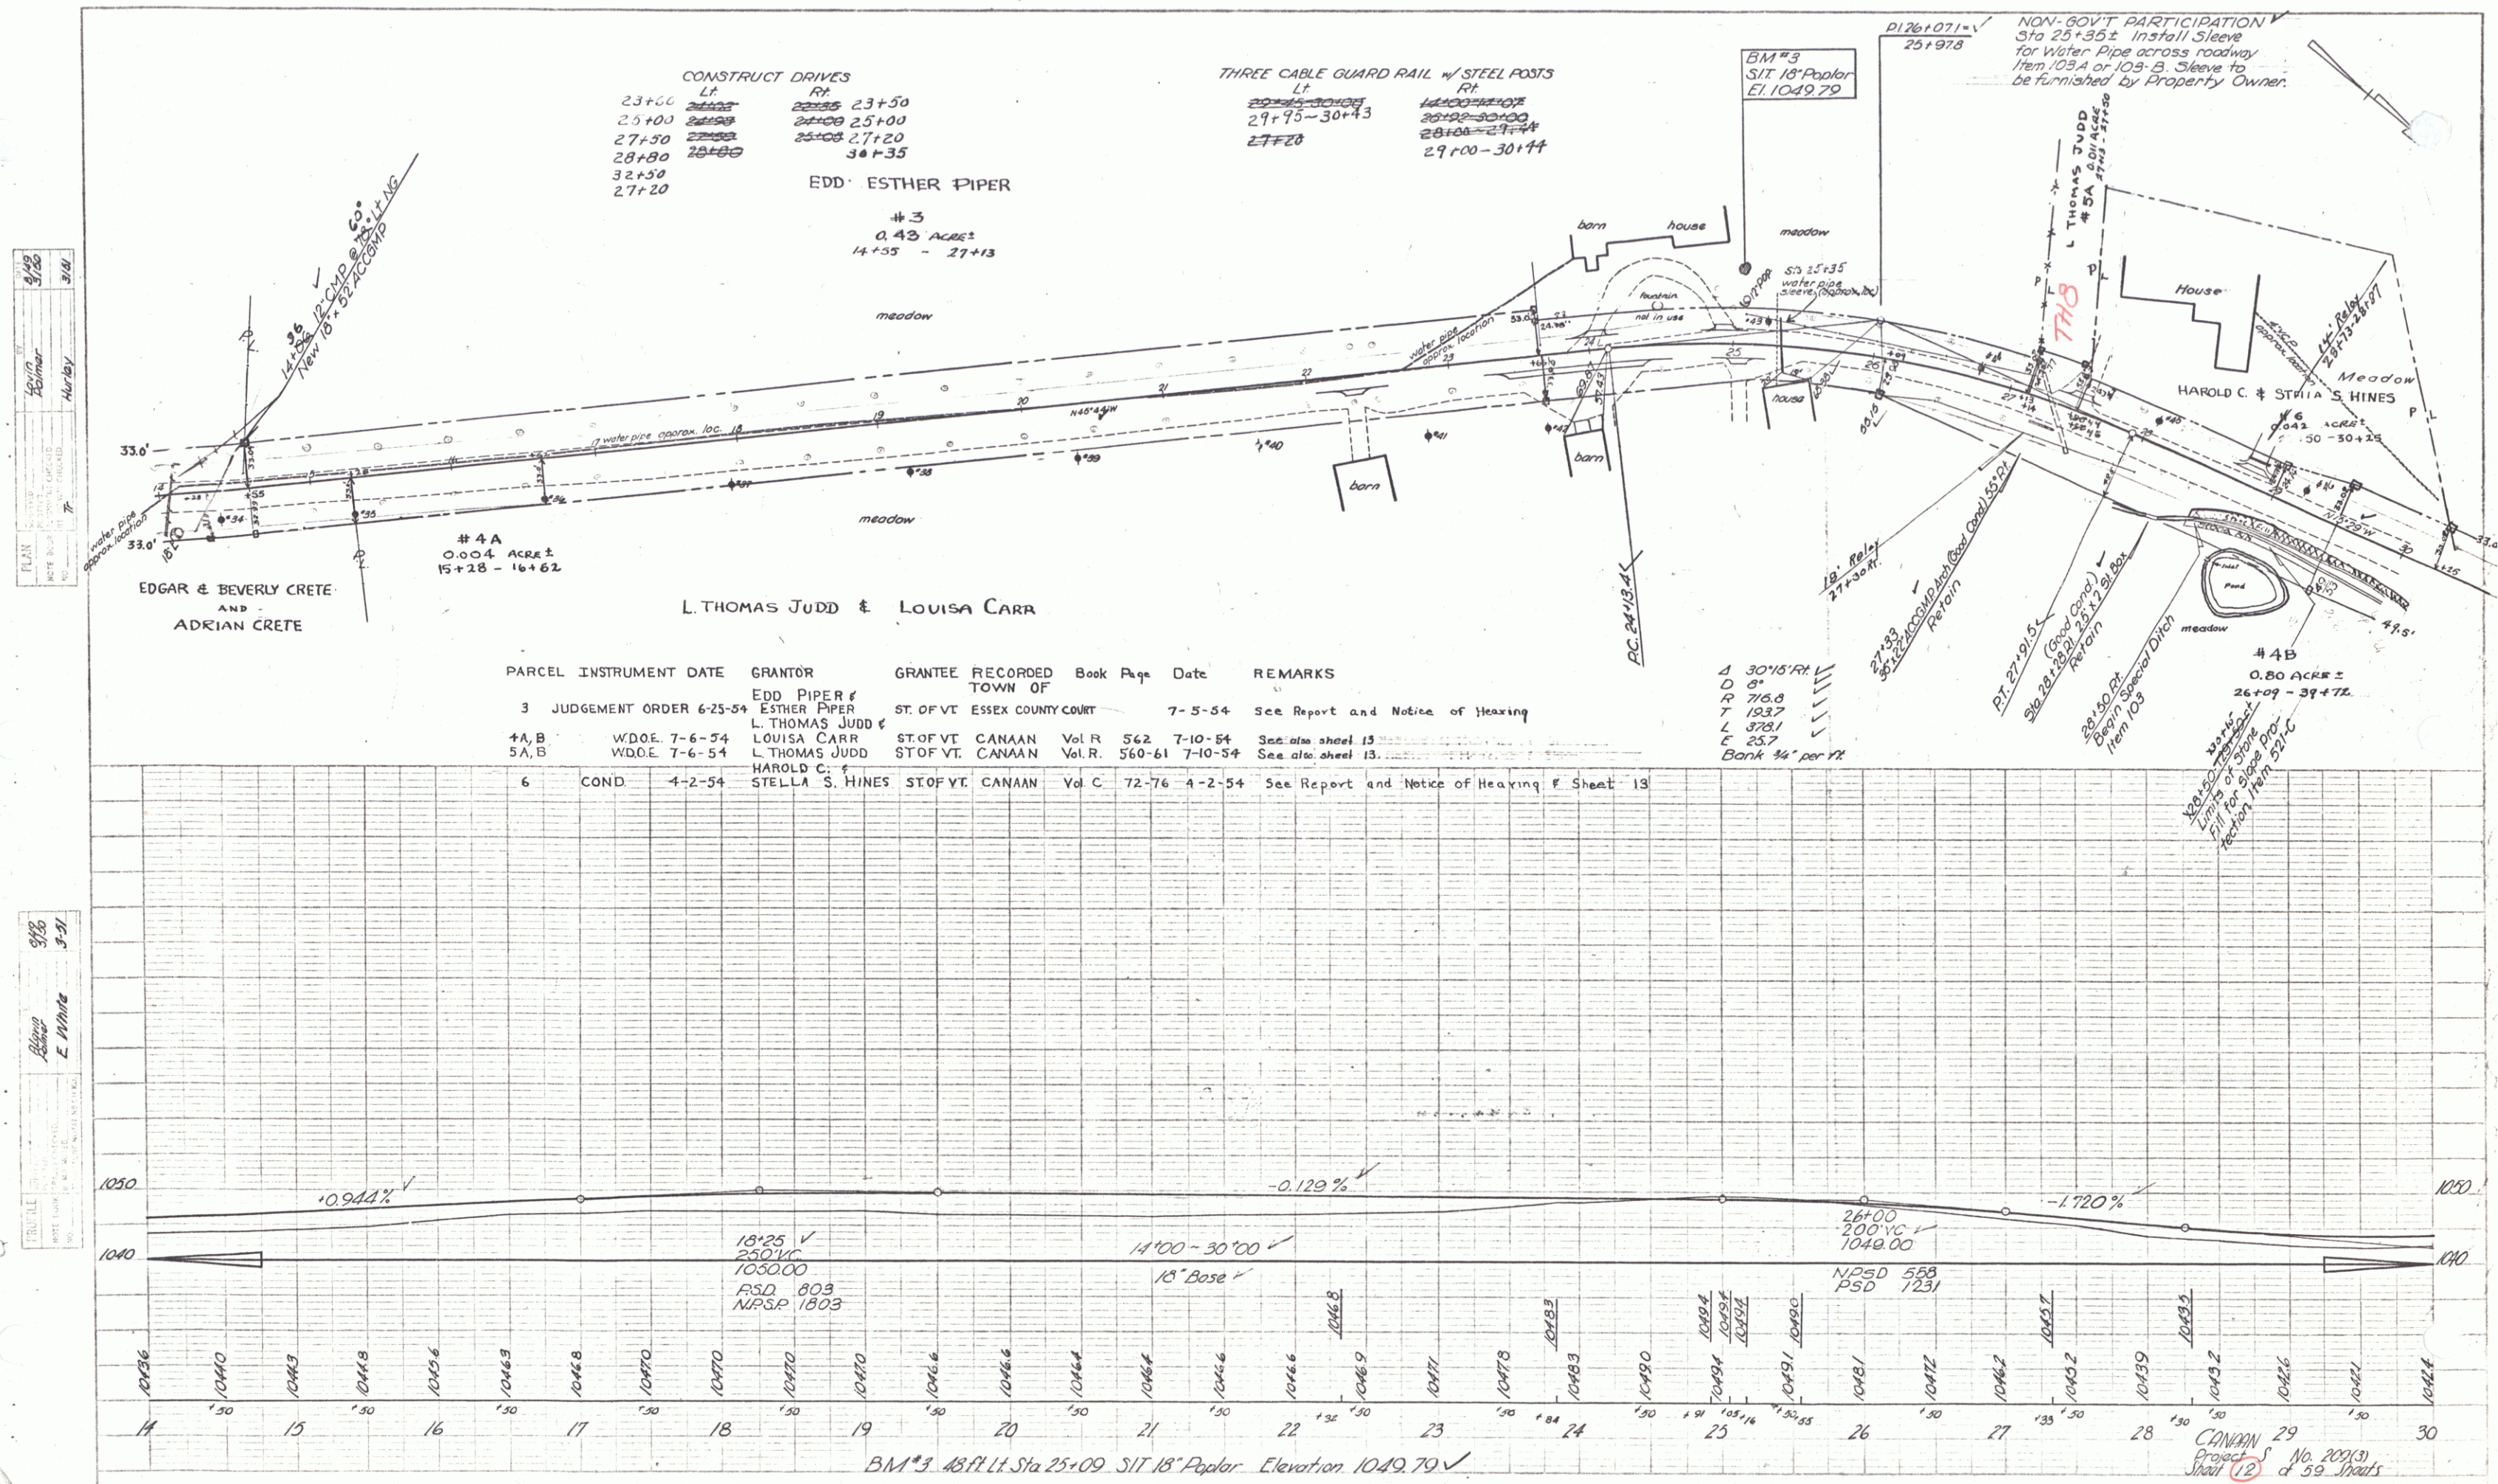

PLAN
 DATE: 10/1/54
 DRAWN BY: E. White
 CHECKED BY: S. J. White

PROFILE
 DATE: 10/1/54
 DRAWN BY: E. White
 CHECKED BY: S. J. White


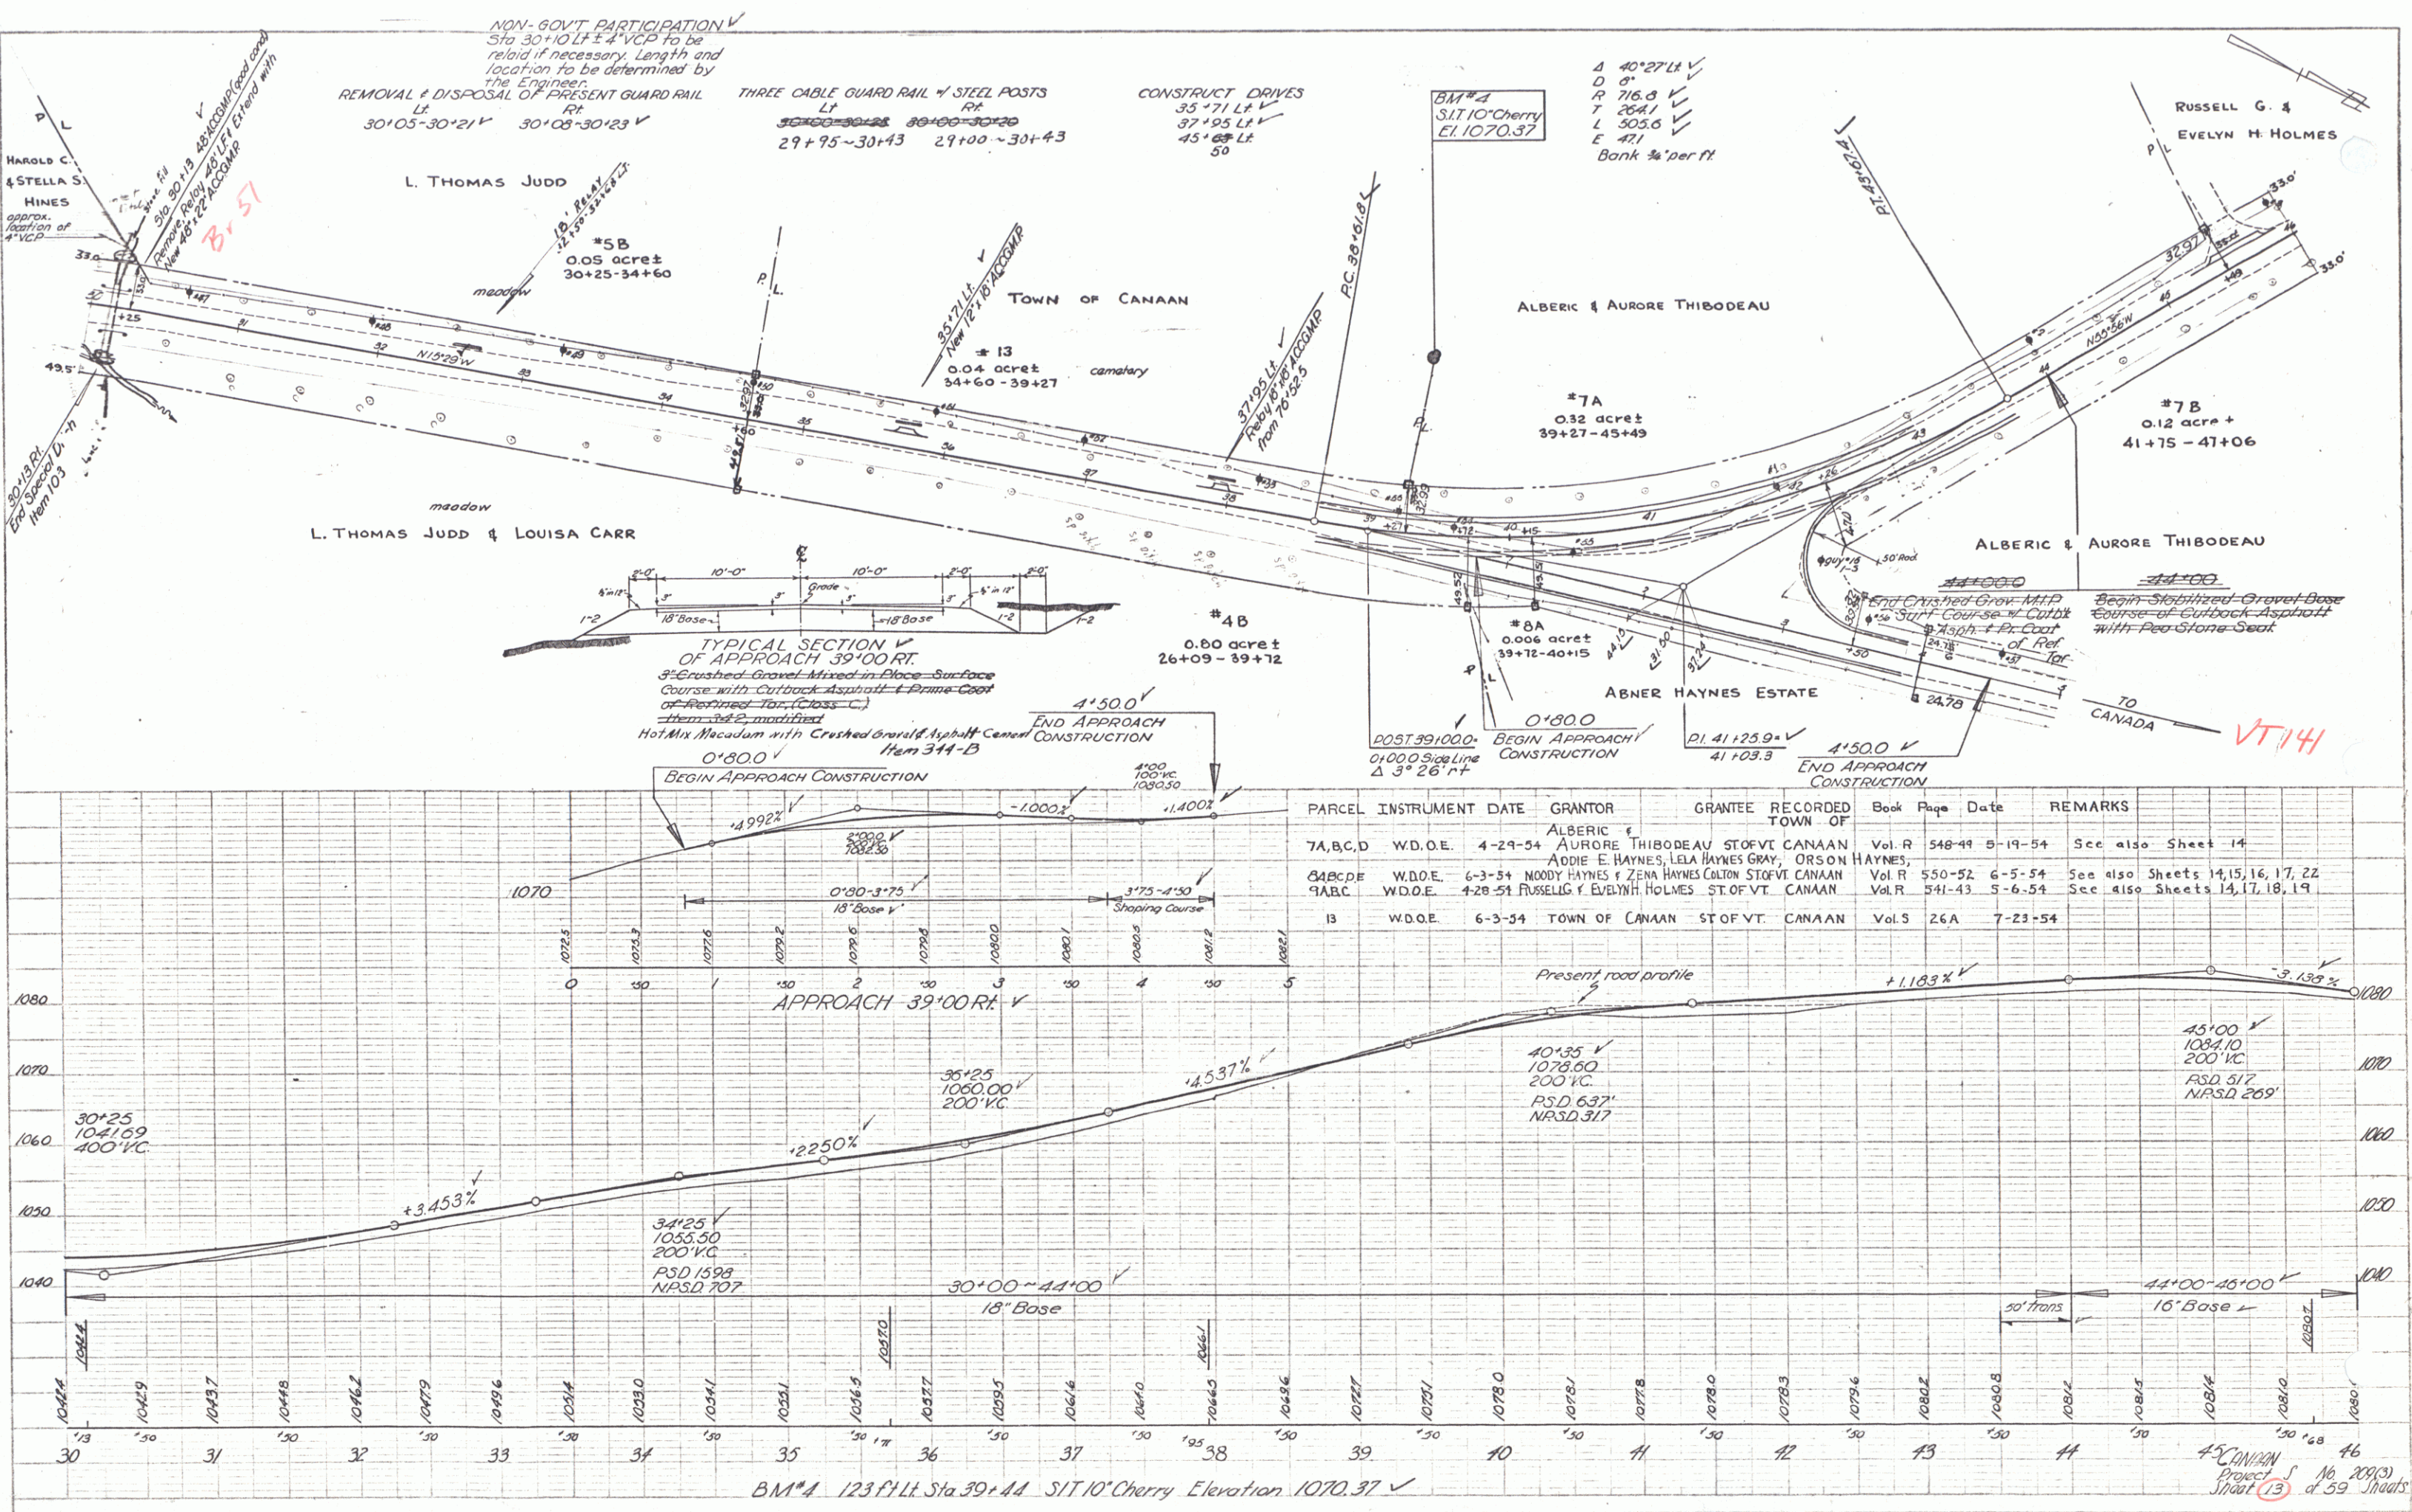


PLATE 1 - PLAN PROFILE C & T & S - 1954
 DRAWN BY: E. WHITE
 CHECKED BY: S. J. WHITE


PLAN	THRU	BY	DAYS
NOTE BOOK	PROTID	Lovin	9/49
	ALUMINUM CHECKED	Barmer	3/50
NO.	RT. QUAY CHECKED	Hurley	3/51

PROFILE	SUBMITTED	ALVIA Palmer	0188 380	3-51
NOTE BOOK	PLANTED	E. White		
	GRASS 3-6-10			
	5 M. 10-10			

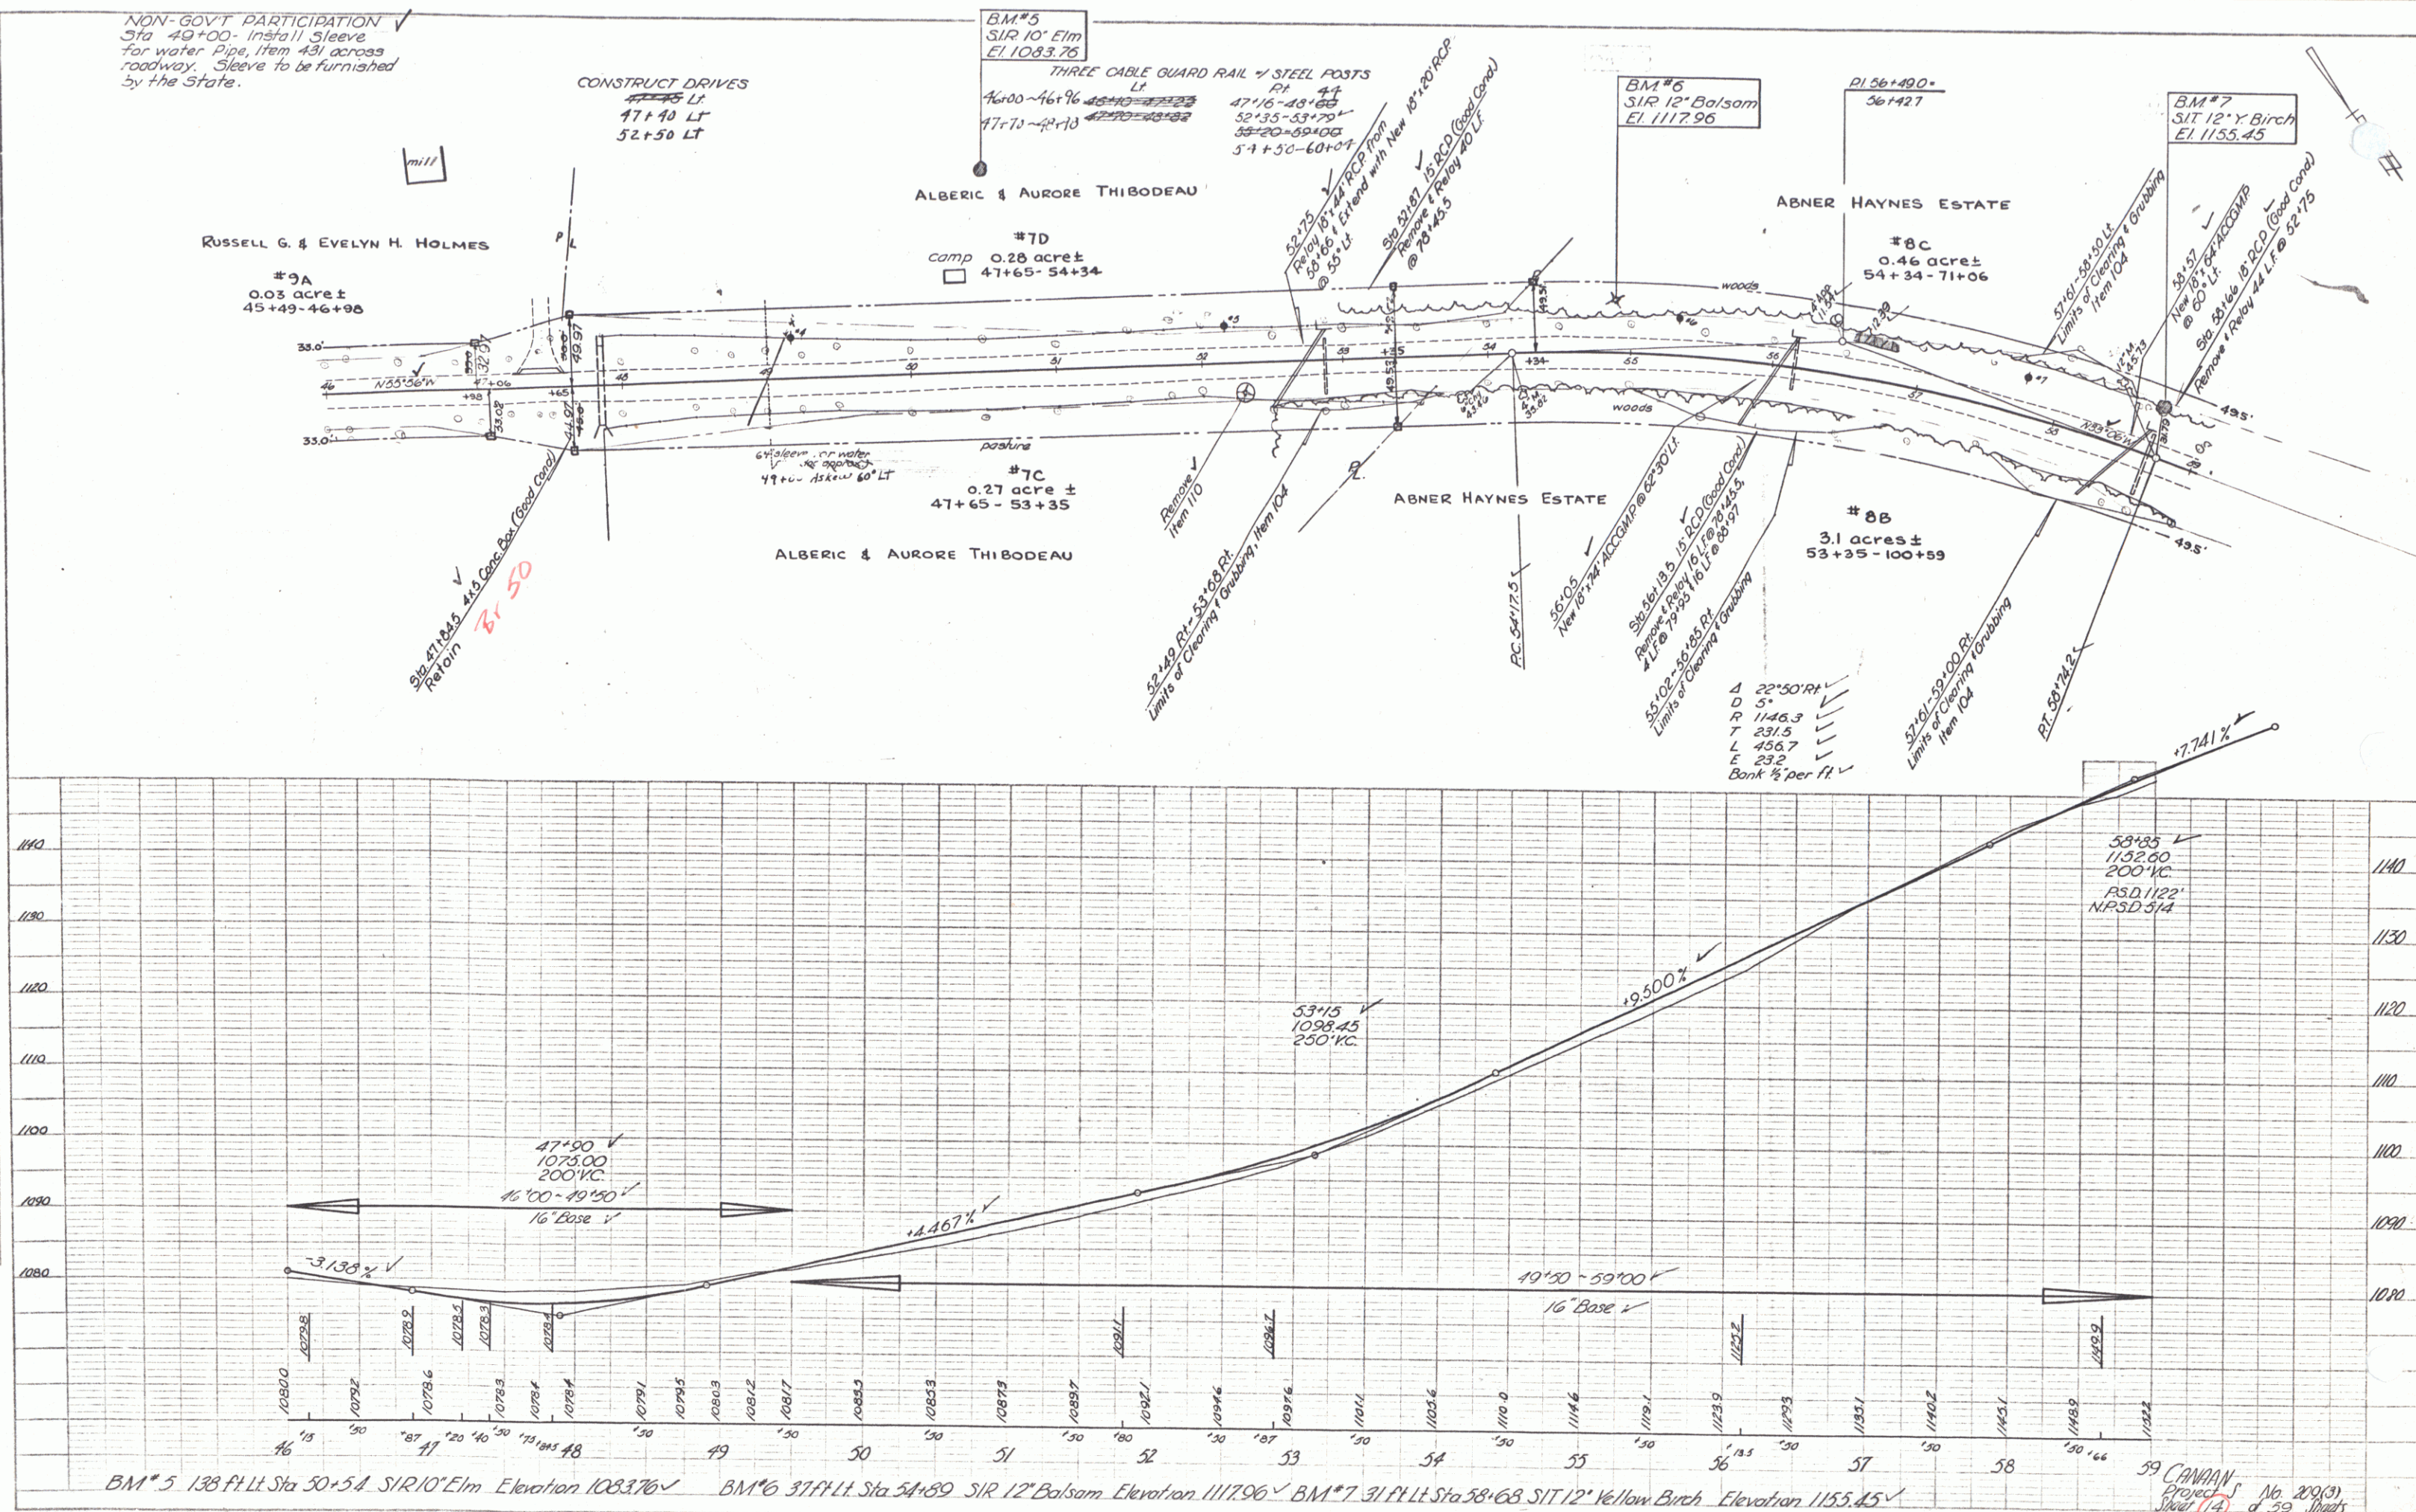


59 CANAAN
Project S No. 209(3)
Sheet 14 of 59

PLAN	3-8	3-8
DATE	10/1/58	10/1/58
BY	W. H. White	W. H. White
CHECKED		

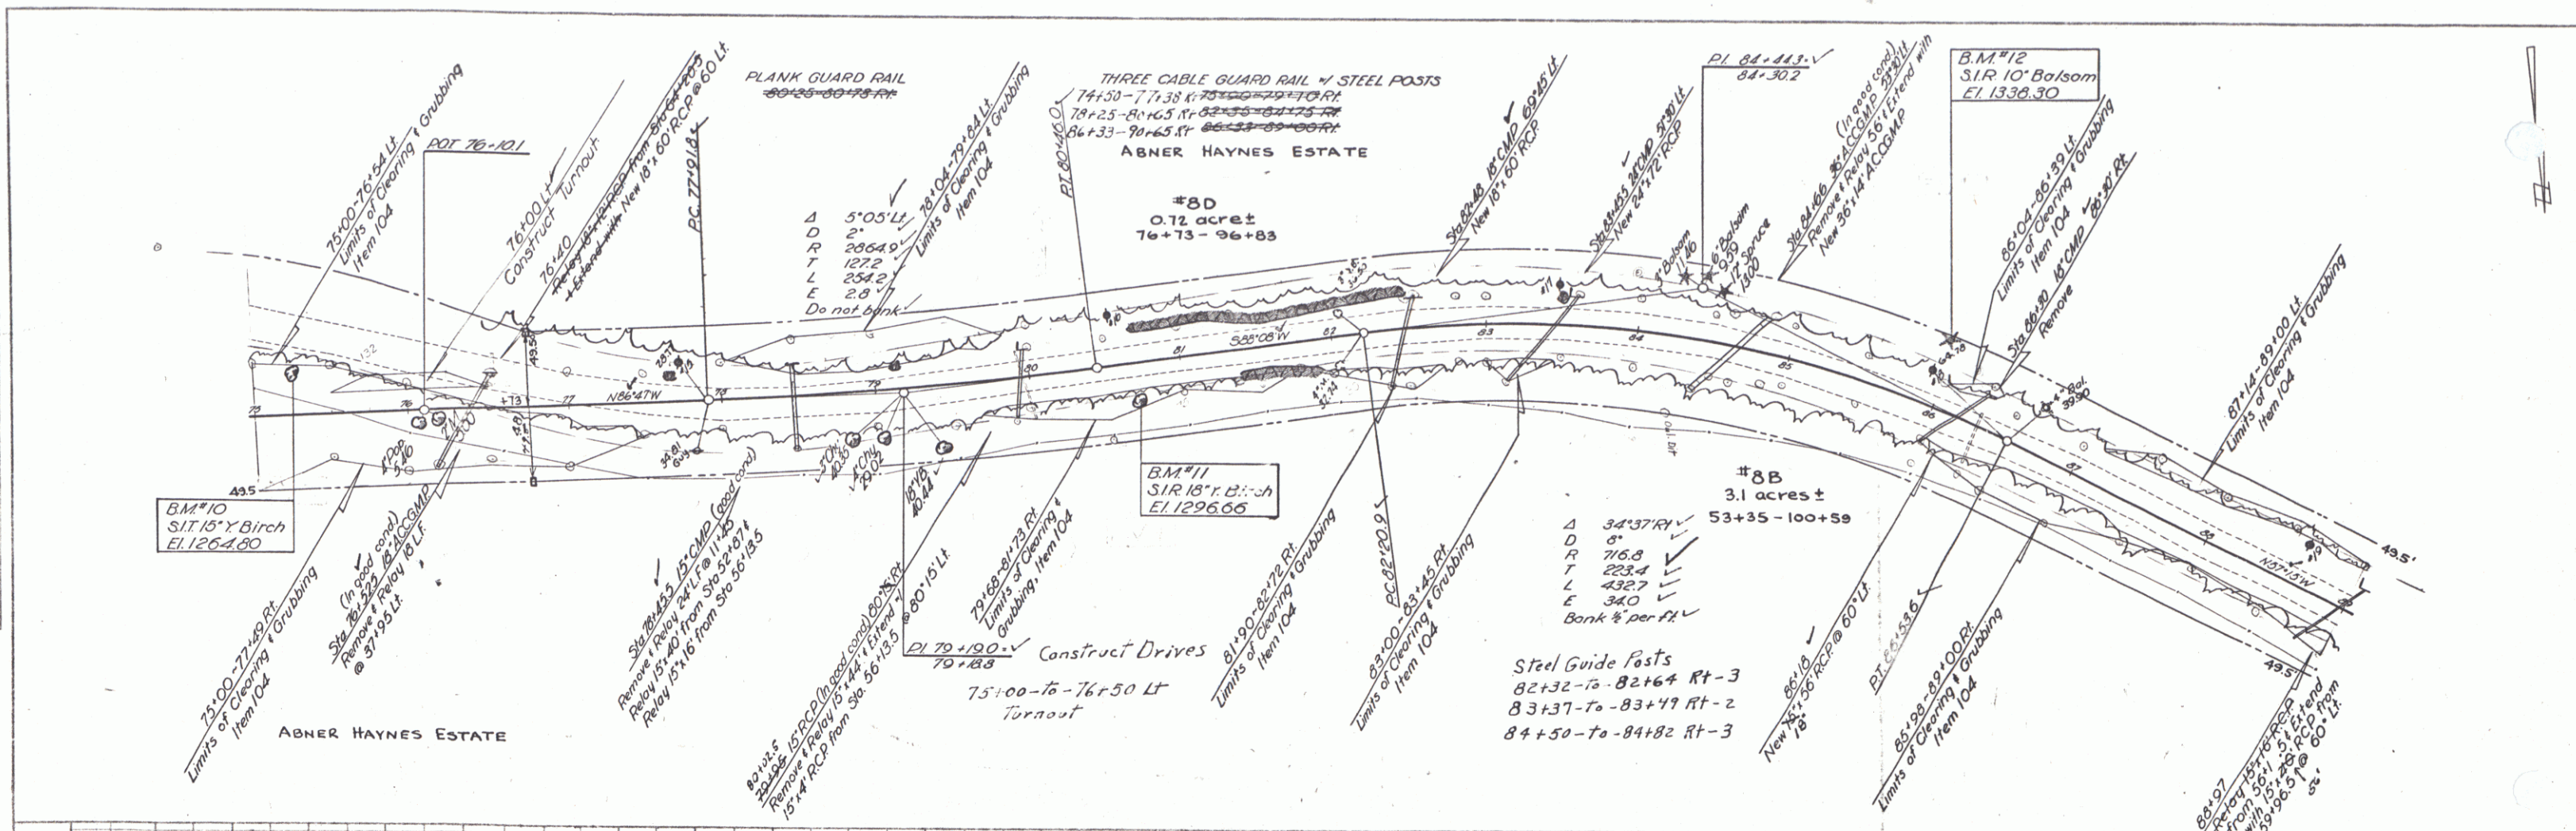

PLAN	3-8	3-8
DATE	10/1/58	10/1/58
BY	W. H. White	W. H. White
CHECKED		

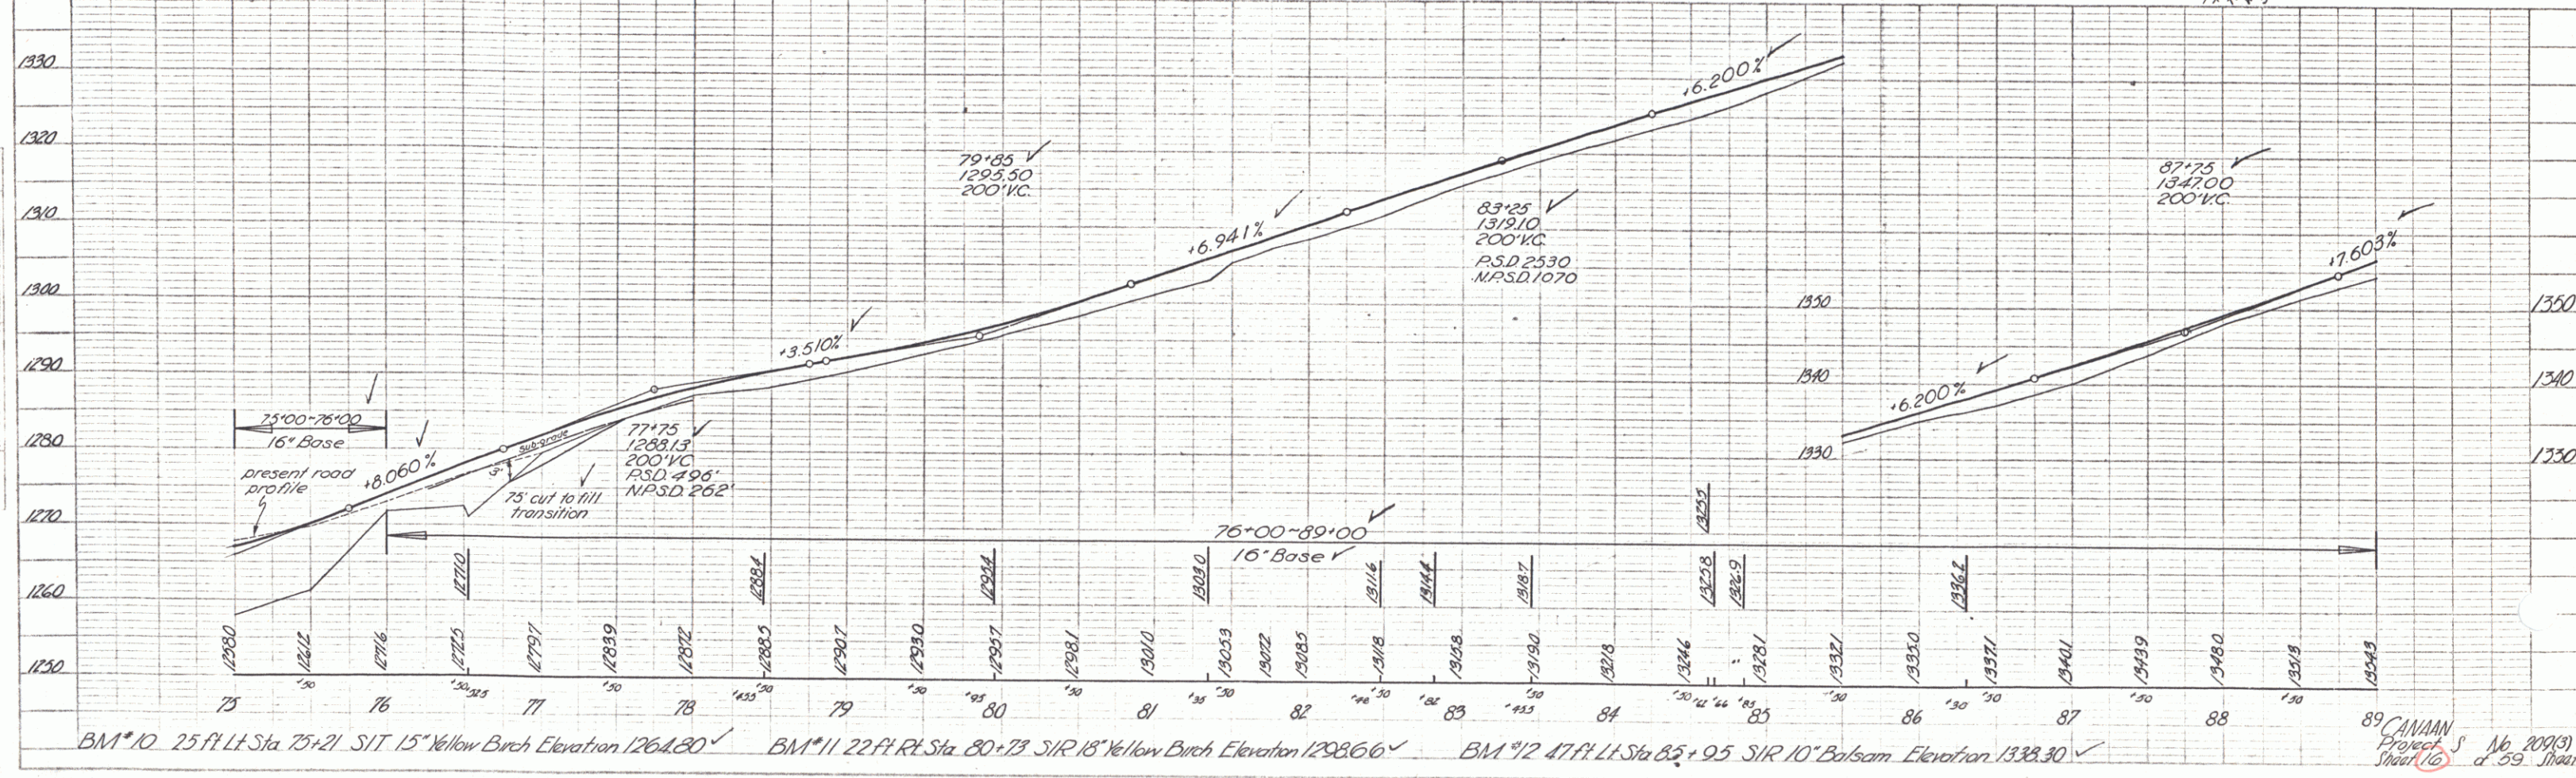

89 CANMAN
Project
Sheet 16 of 59 Sheets

