

INDEX OF SHEETS

SHEET NO. 1	TITLE PAGE
" 2	TYPICAL CROSS-SECTION OF IMPROVEMENT
" 3	BANKING AND WIDENING TABLES
" 4	QUANTITY SHEET (ITEMS)
" 5	QUANTITY SHEET (DRAINAGE)
6-12	EARTHWORK SHEETS
13-29	PLAN AND PROFILE SHEETS
30	ABUTMENT EXTENSION DETAILS
31	SUPERSTRUCTURE WIDENING DETAILS
32	P.W.A. VT. 1020-H SHEET 4 OF 13 REFERENCE
33	REINFORCING STEEL SCHEDULE
34	CONSTRUCTION DETAILS - CULVERTS
35	CONSTRUCTION DETAILS - CD-1 DITCHES
36	CONSTRUCTION DETAILS - CD-2 TYPICAL GRADING
37	CONSTRUCTION DETAILS - CD-4 GRANITE CURB
38	STANDARD STRUCTURE SHEET S-40 (BARRICADES, SIGNS & LIGHTS)
39	STANDARD STRUCTURE SHEET S-45-45 (GUARD RAIL)
40	STANDARD STRUCTURE SHEET SB-11 (BARRICADES, SIGNS AND LIGHTS)
41	STANDARD STRUCTURE SHEET SB-5-A CABLE RAIL
42	STANDARD STRUCTURE SHEET SB-20 SUPERSTRUCTURE DETAILS B, C, J
43-104	CROSS SECTIONS

STANDARD STRUCTURE SHEET APPROVED BY THE CHIEF ENGINEER, VERMONT STATE DEPARTMENT OF HIGHWAYS

S-40 JUNE 10, 1950

PROJECT NAME & NUMBER	TYPE	PAVEMENT AREA
STARKSBORO-HINESBURG F 171 (5)	MIXED IN PLACE	59,437 S.Y.
RECORD PLANS		
MATERIALS		
GRAVEL BROWN PIT-STARKSBORO. CASEY PIT3-HINESB.	CONC. AGG.	KIRBY PLANT, HINESBURG
SAND COMETTE PIT, HINESBURG	REINF. STEEL	U.S. STEEL SUPPLY CO. BOSTON
CR. GRAVEL CASS CORP. HINESBURG	CEMENT	GLENS FALLS PORT. CEM. CO. GLENS FALLS, N.Y.
TAR AM. TAR CO. SPRINGFIELD, MASS.	RCP	VT. CONC. PIPE CO. WINDSOR, VT.
ASPHALT ESSO STAN. OIL CO. EVERETT, MASS.	ACCGMP	NEW ENG. MET. CULV. CO. BOSTON
BIT. CONC. PAVEMENT BAYER & MINGOLLA PLANT	FIBRE DR. PIPE	BROWN CO. BERLIN, N.H.
GUARD RAIL AM. STEEL & WIRE CO. NEW HAVEN, CT.		
CONTRACTOR S.V. ROSSI, TORRINGTON, CONN.	CONTRACT DATED	AUG. 15, 1952
RES. ENGINEER DANIEL ALLEN	CONTRACT STARTED	AUG. 20, 1952
INSPECTOR SHERMAN GAGE	CONTRACT COMPLETED	SEPT. 30, 1953
RECORD PLANS K. EASTMAN	CONTRACT ACCEPTED	SEPT. 30, 1953

STATE OF VERMONT STATE HIGHWAY DEPARTMENT

PLAN AND PROFILE OF PROPOSED STATE HIGHWAY



FEDERAL AID PROJECT

TOWNS OF STARKSBORO-HINESBURG

COUNTIES OF ADDISON-CHITTENDEN
VERMONT ROUTE 116
STARKSBORO-HINESBURG ROAD

BEGINNING AT A POINT 17973 FEET SOUTH OF THE STARKSBORO-HINESBURG TOWN LINE AND EXTENDING NORTHERLY 24,295.5 FT.

LENGTH OF ROADWAY 24,241.5 FT. = 4.591 MILES
LENGTH OF BRIDGE 54.0 FT. = 0.010 MILE
LENGTH OF PROJECT 24,295.5 FT. = 4.601 MILES

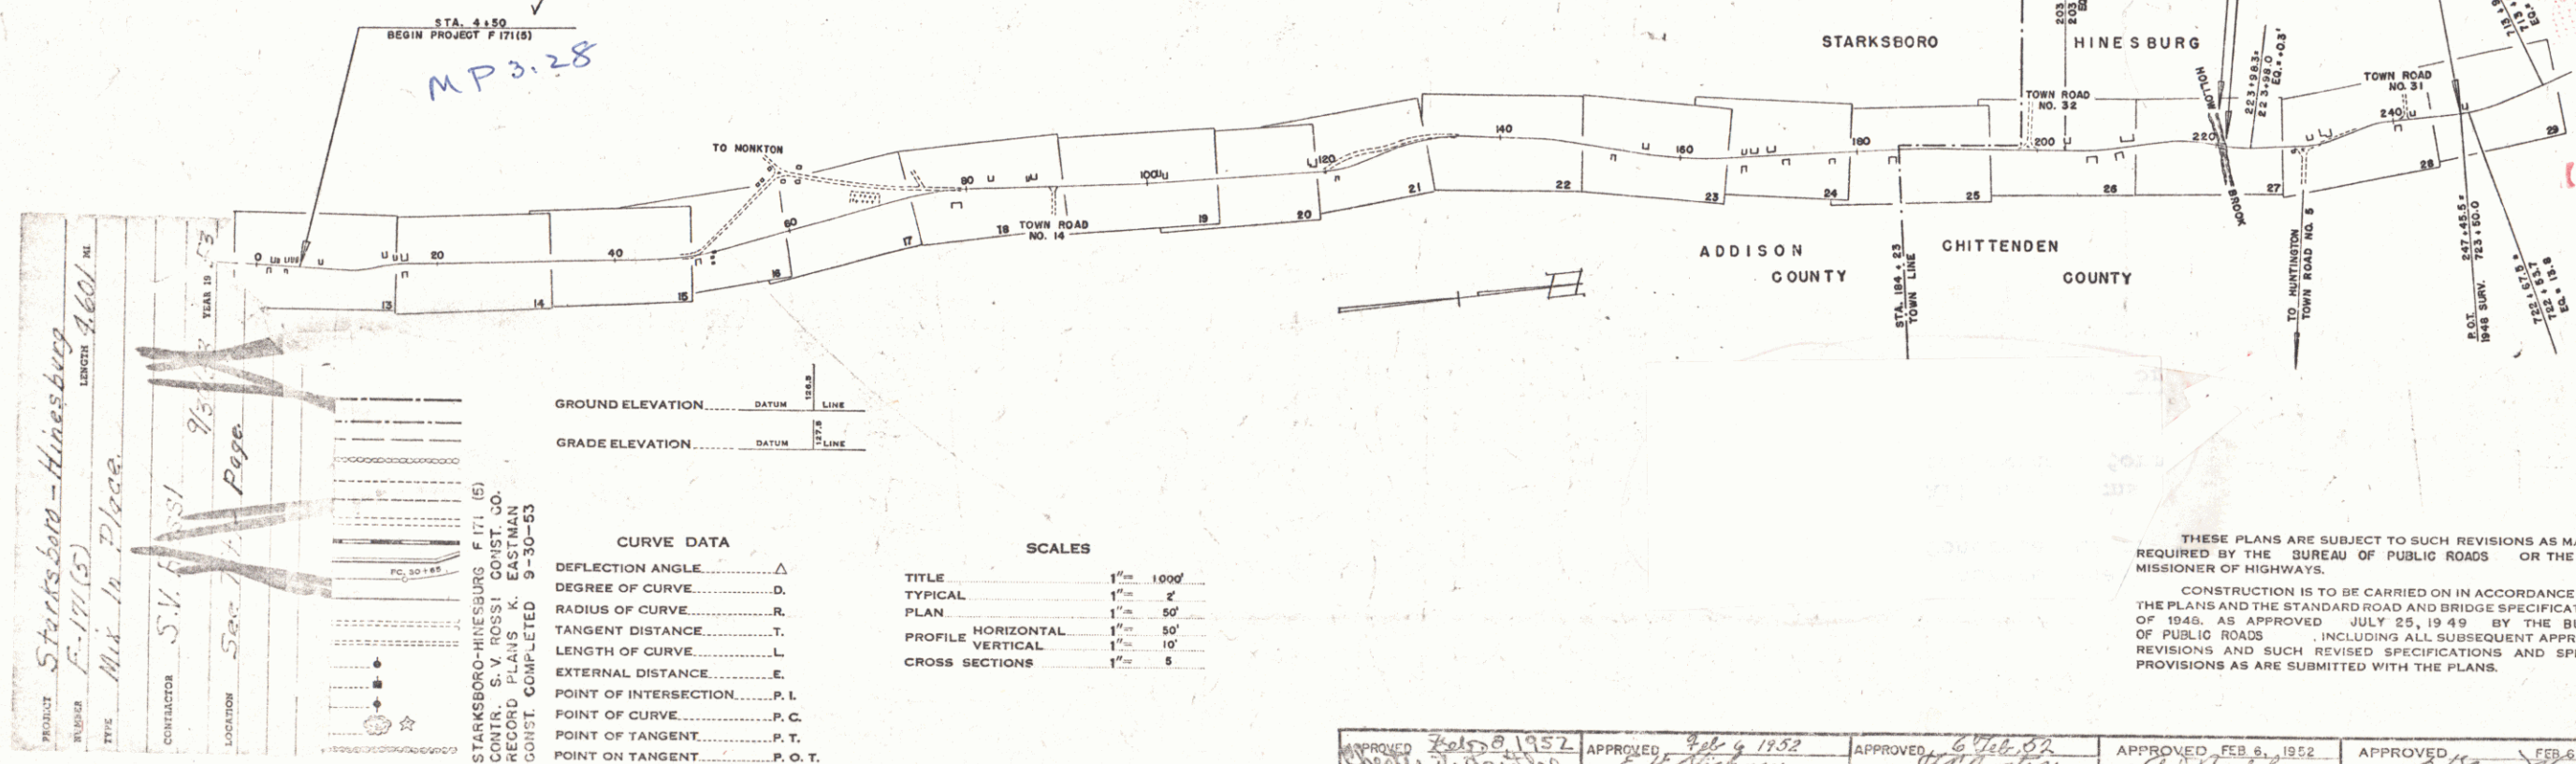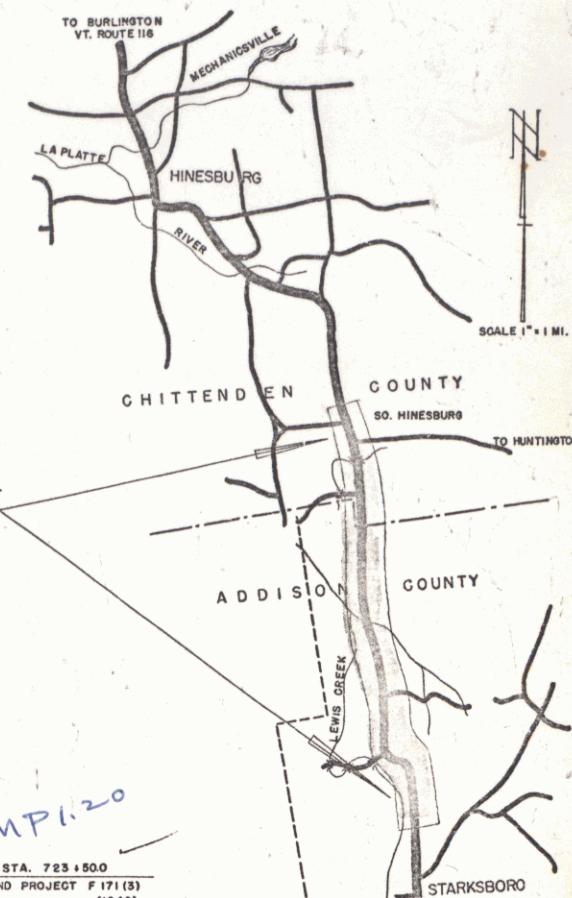

RIGHT-OF-WAY TO BE DEDICATED
TOWN FILE
PERPETUAL
Town of Starksboro
(To Be Returned To R.O.W. Division)

APPROVED: H. H. August
FEB. 6, 1952

CHIEF ENGINEER
SUBMITTED BY ORDER OF THE STATE HIGHWAY BOARD

NOTE: ANY FURTHER INFORMATION CONCERNING THIS PROJECT SHOULD BE OBTAINED FROM THE FIELD ENGINEER OF THE DISTRICT.

Pin # 00R496

DEPARTMENT OF CONSUMER BUREAU OF PUBLIC ROADS

RECOMMENDED FOR APPROVAL

DISTRICT ENGINEER DATE

APPROVED

DIVISION ENGINEER DATE

THESE PLANS ARE SUBJECT TO SUCH REVISIONS AS MAY BE REQUIRED BY THE BUREAU OF PUBLIC ROADS OR THE COMMISSIONER OF HIGHWAYS.


CONSTRUCTION IS TO BE CARRIED ON IN ACCORDANCE WITH THE PLANS AND THE STANDARD ROAD AND BRIDGE SPECIFICATIONS OF 1948, AS APPROVED JULY 25, 1949 BY THE BUREAU OF PUBLIC ROADS, INCLUDING ALL SUBSEQUENT APPROVED REVISIONS AND SUCH REVISED SPECIFICATIONS AND SPECIAL PROVISIONS AS ARE SUBMITTED WITH THE PLANS.

APPROVED Feb 8 1952 DISTRICT ENGINEER
APPROVED Feb 9 1952 DISTRICT ENGINEER
APPROVED Feb 8 1952 CONSTRUCTION ENGINEER
APPROVED Feb 8 1952 BRIDGE ENGINEER
APPROVED Feb 8 1952 HIGHWAY ENGINEER

PROJECT F No. 171 (5) FILED
SHEET 1 OF 104




PLAN	DATE	BY	CHKD
PLAN	5/1/52	HURLEY	HURLEY
NOTE BOOK	DATE	BY	CHKD
NOTE BOOK	5/1/52	HURLEY	HURLEY

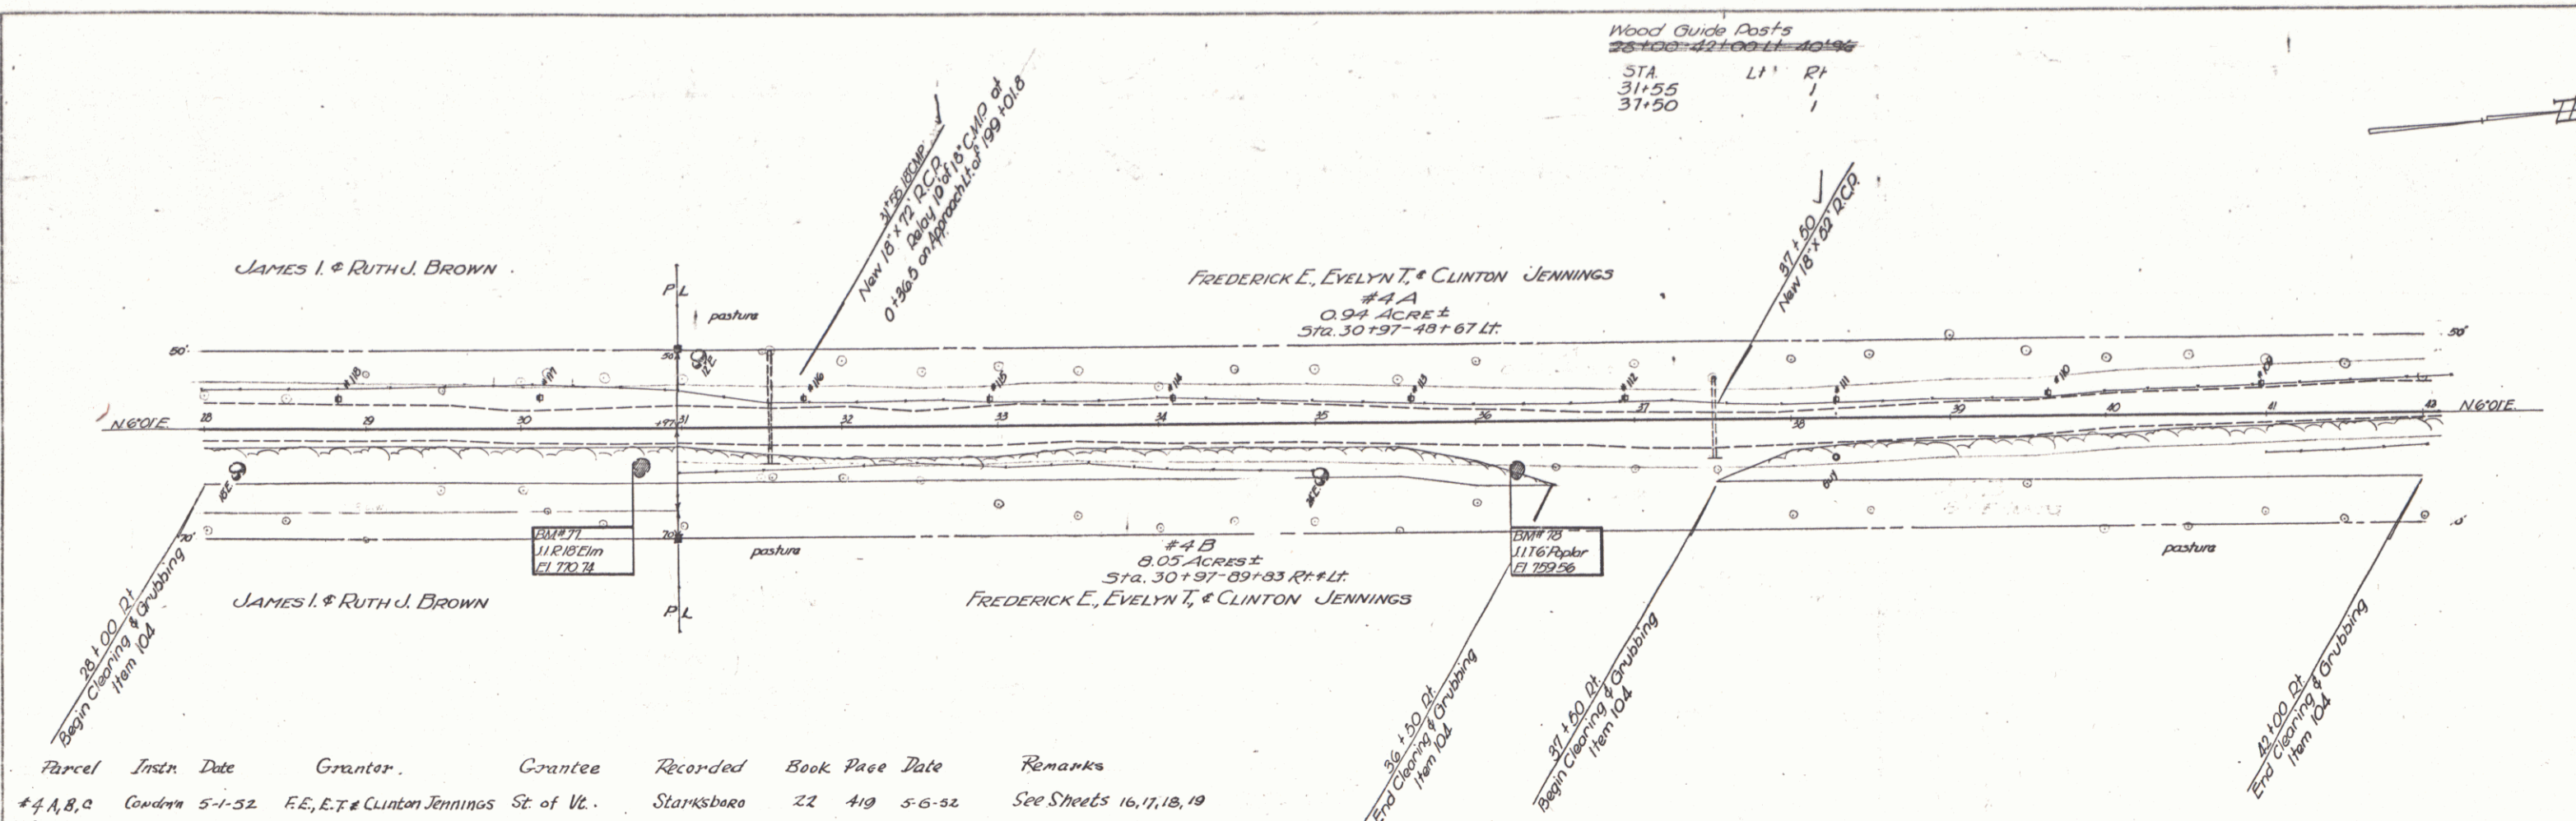

Parcel	Instr.	Date	Grantor	Grantee	Recorded	Book	Page	Date	Remarks
#4 A, B, C	Condemn	5-1-52	F.E., E.T. & Clinton Jennings	St of Va.	Starksboro	22	419	5-6-52	See Sheets 16, 17, 18, 19



PROFILE	DATE	BY	CHKD
PROFILE	5/1/52	HURLEY	HURLEY
NOTE BOOK	DATE	BY	CHKD
NOTE BOOK	5/1/52	HURLEY	HURLEY

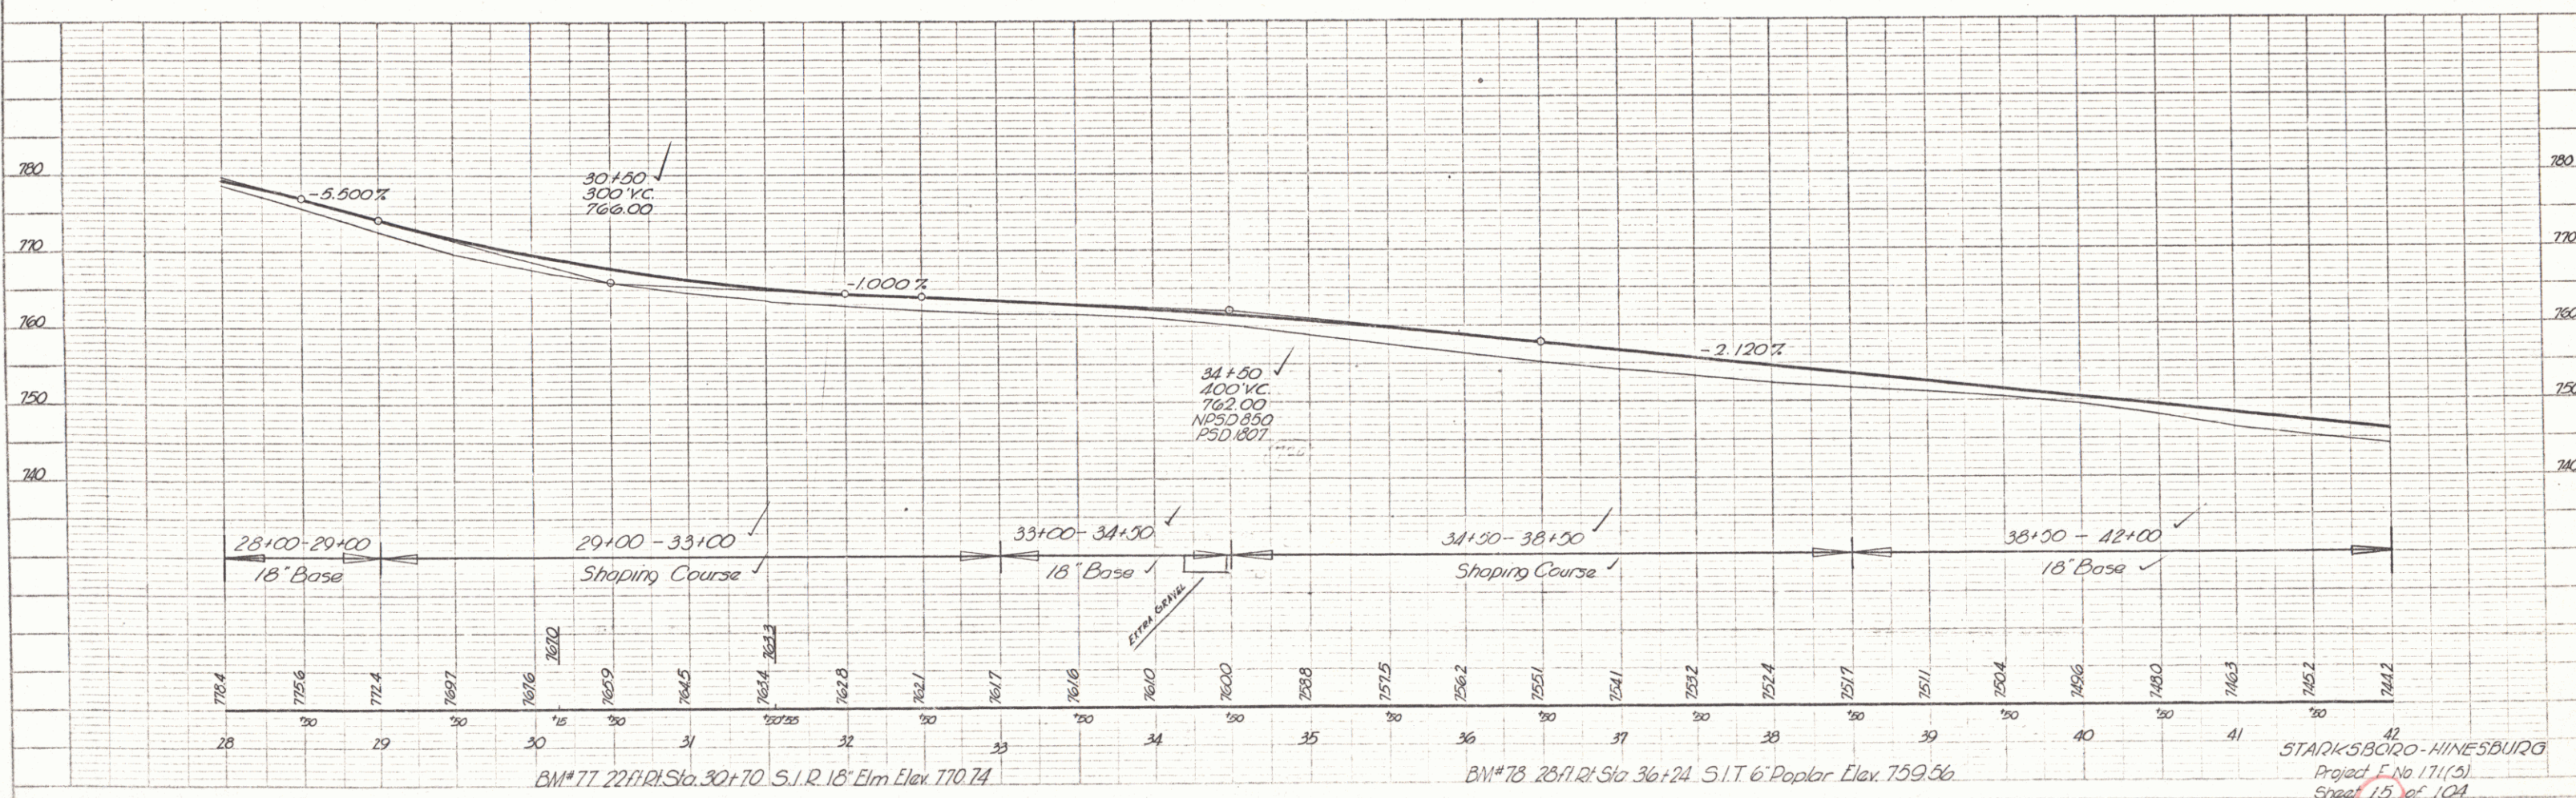


STARKSBORO - WINESBURG
Project No. 171(5)
Sheet 15 of 104

Construct Drives



<i>LT.</i>	<i>RT.</i>
77+00	78+13 ✓
82+00	
83+00	
87+00	
89+00	
75+00	
82+22	
83+12	
87+36	
R 88+45	

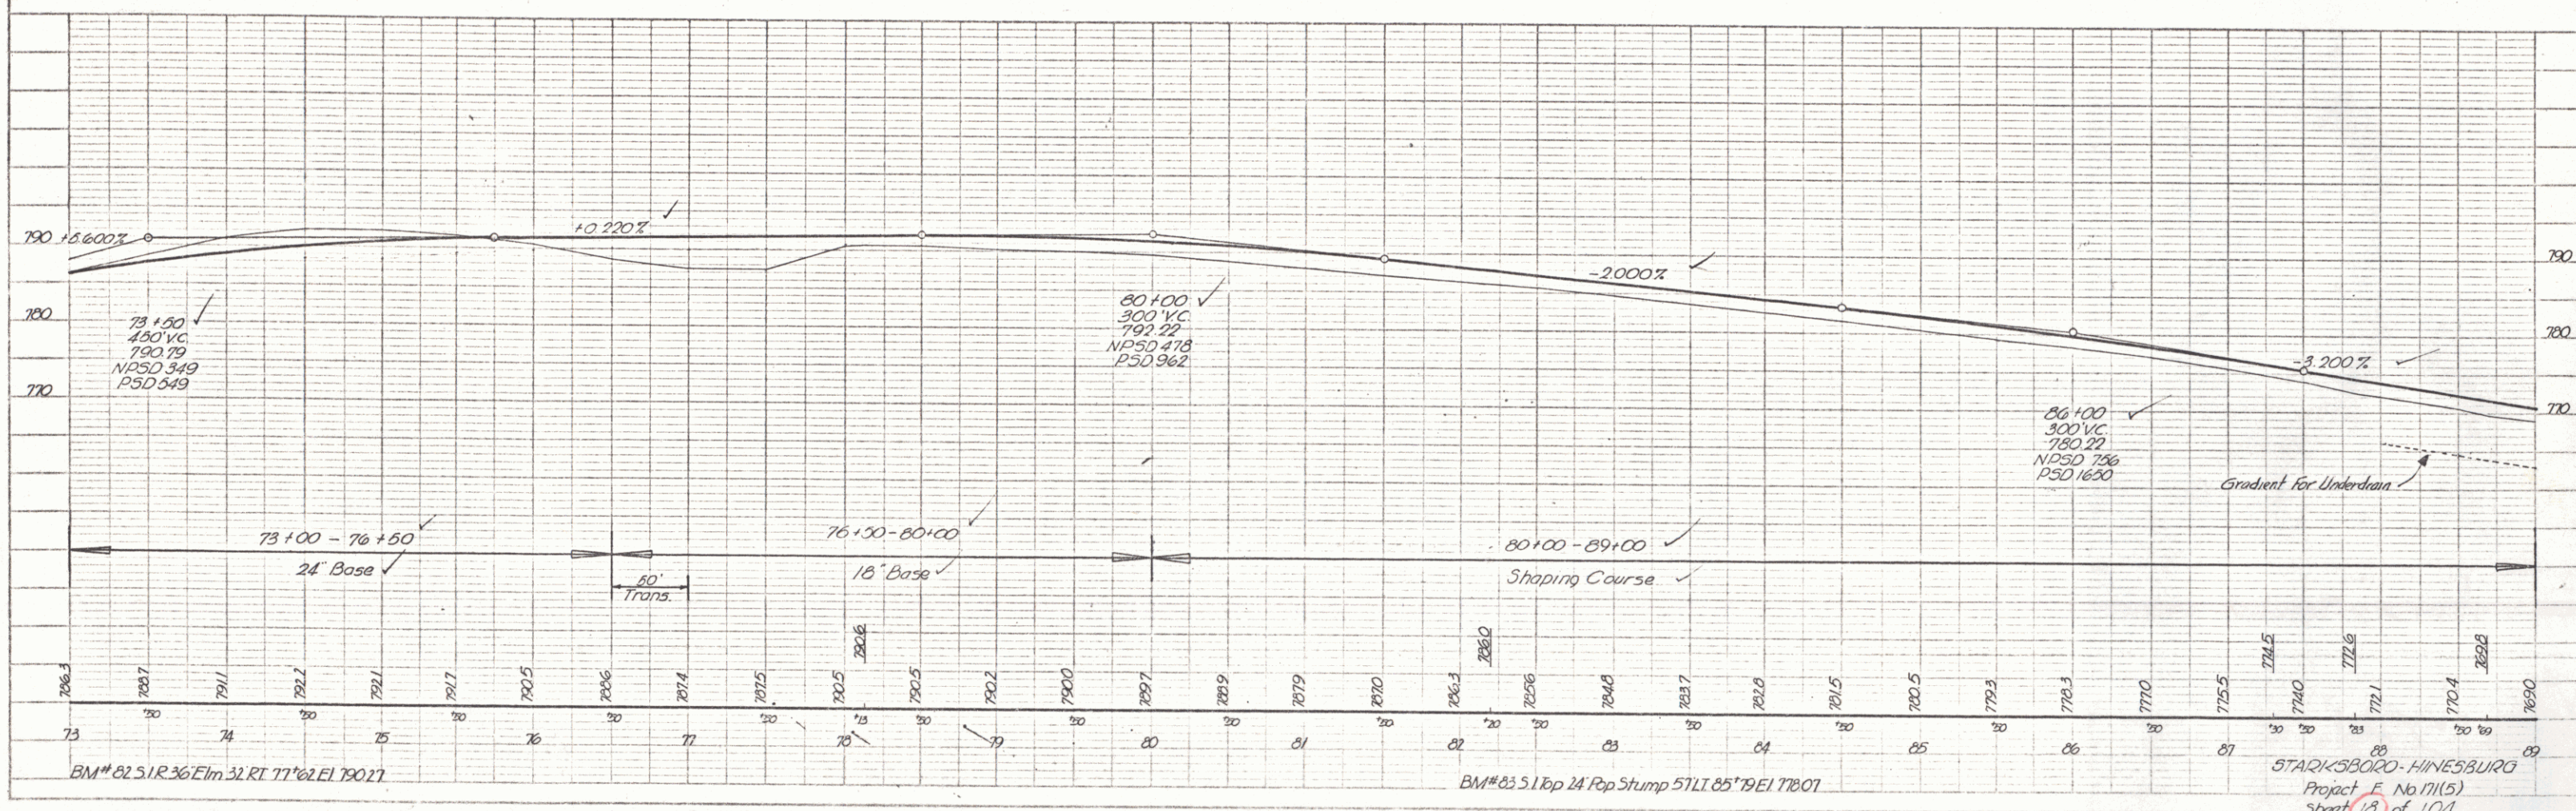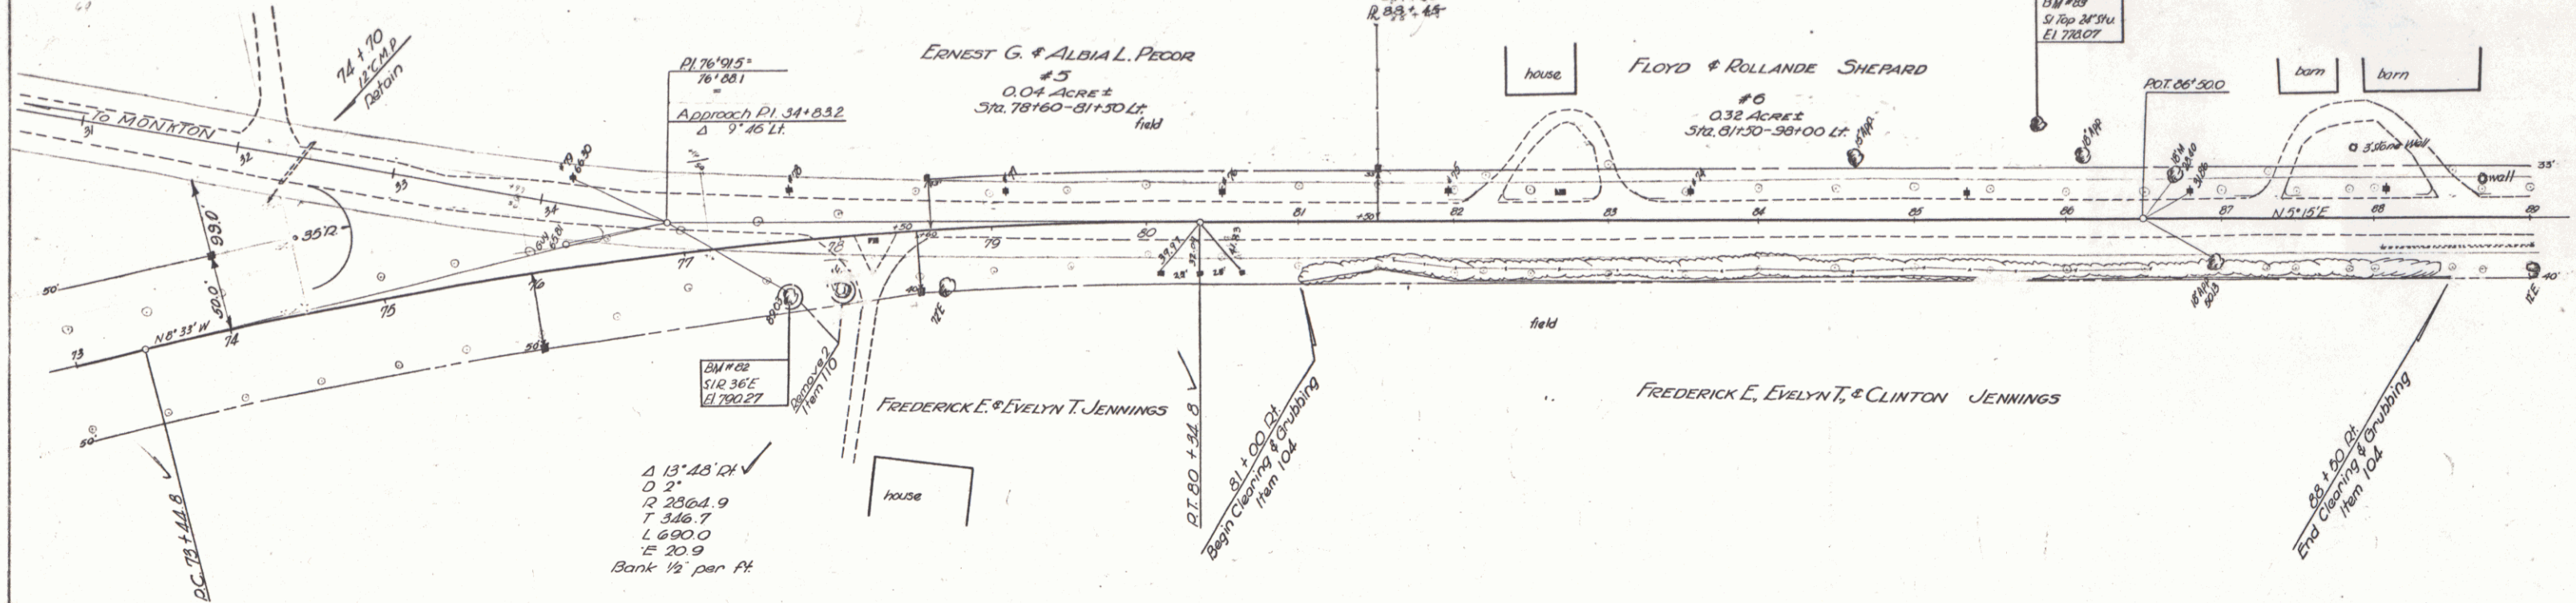


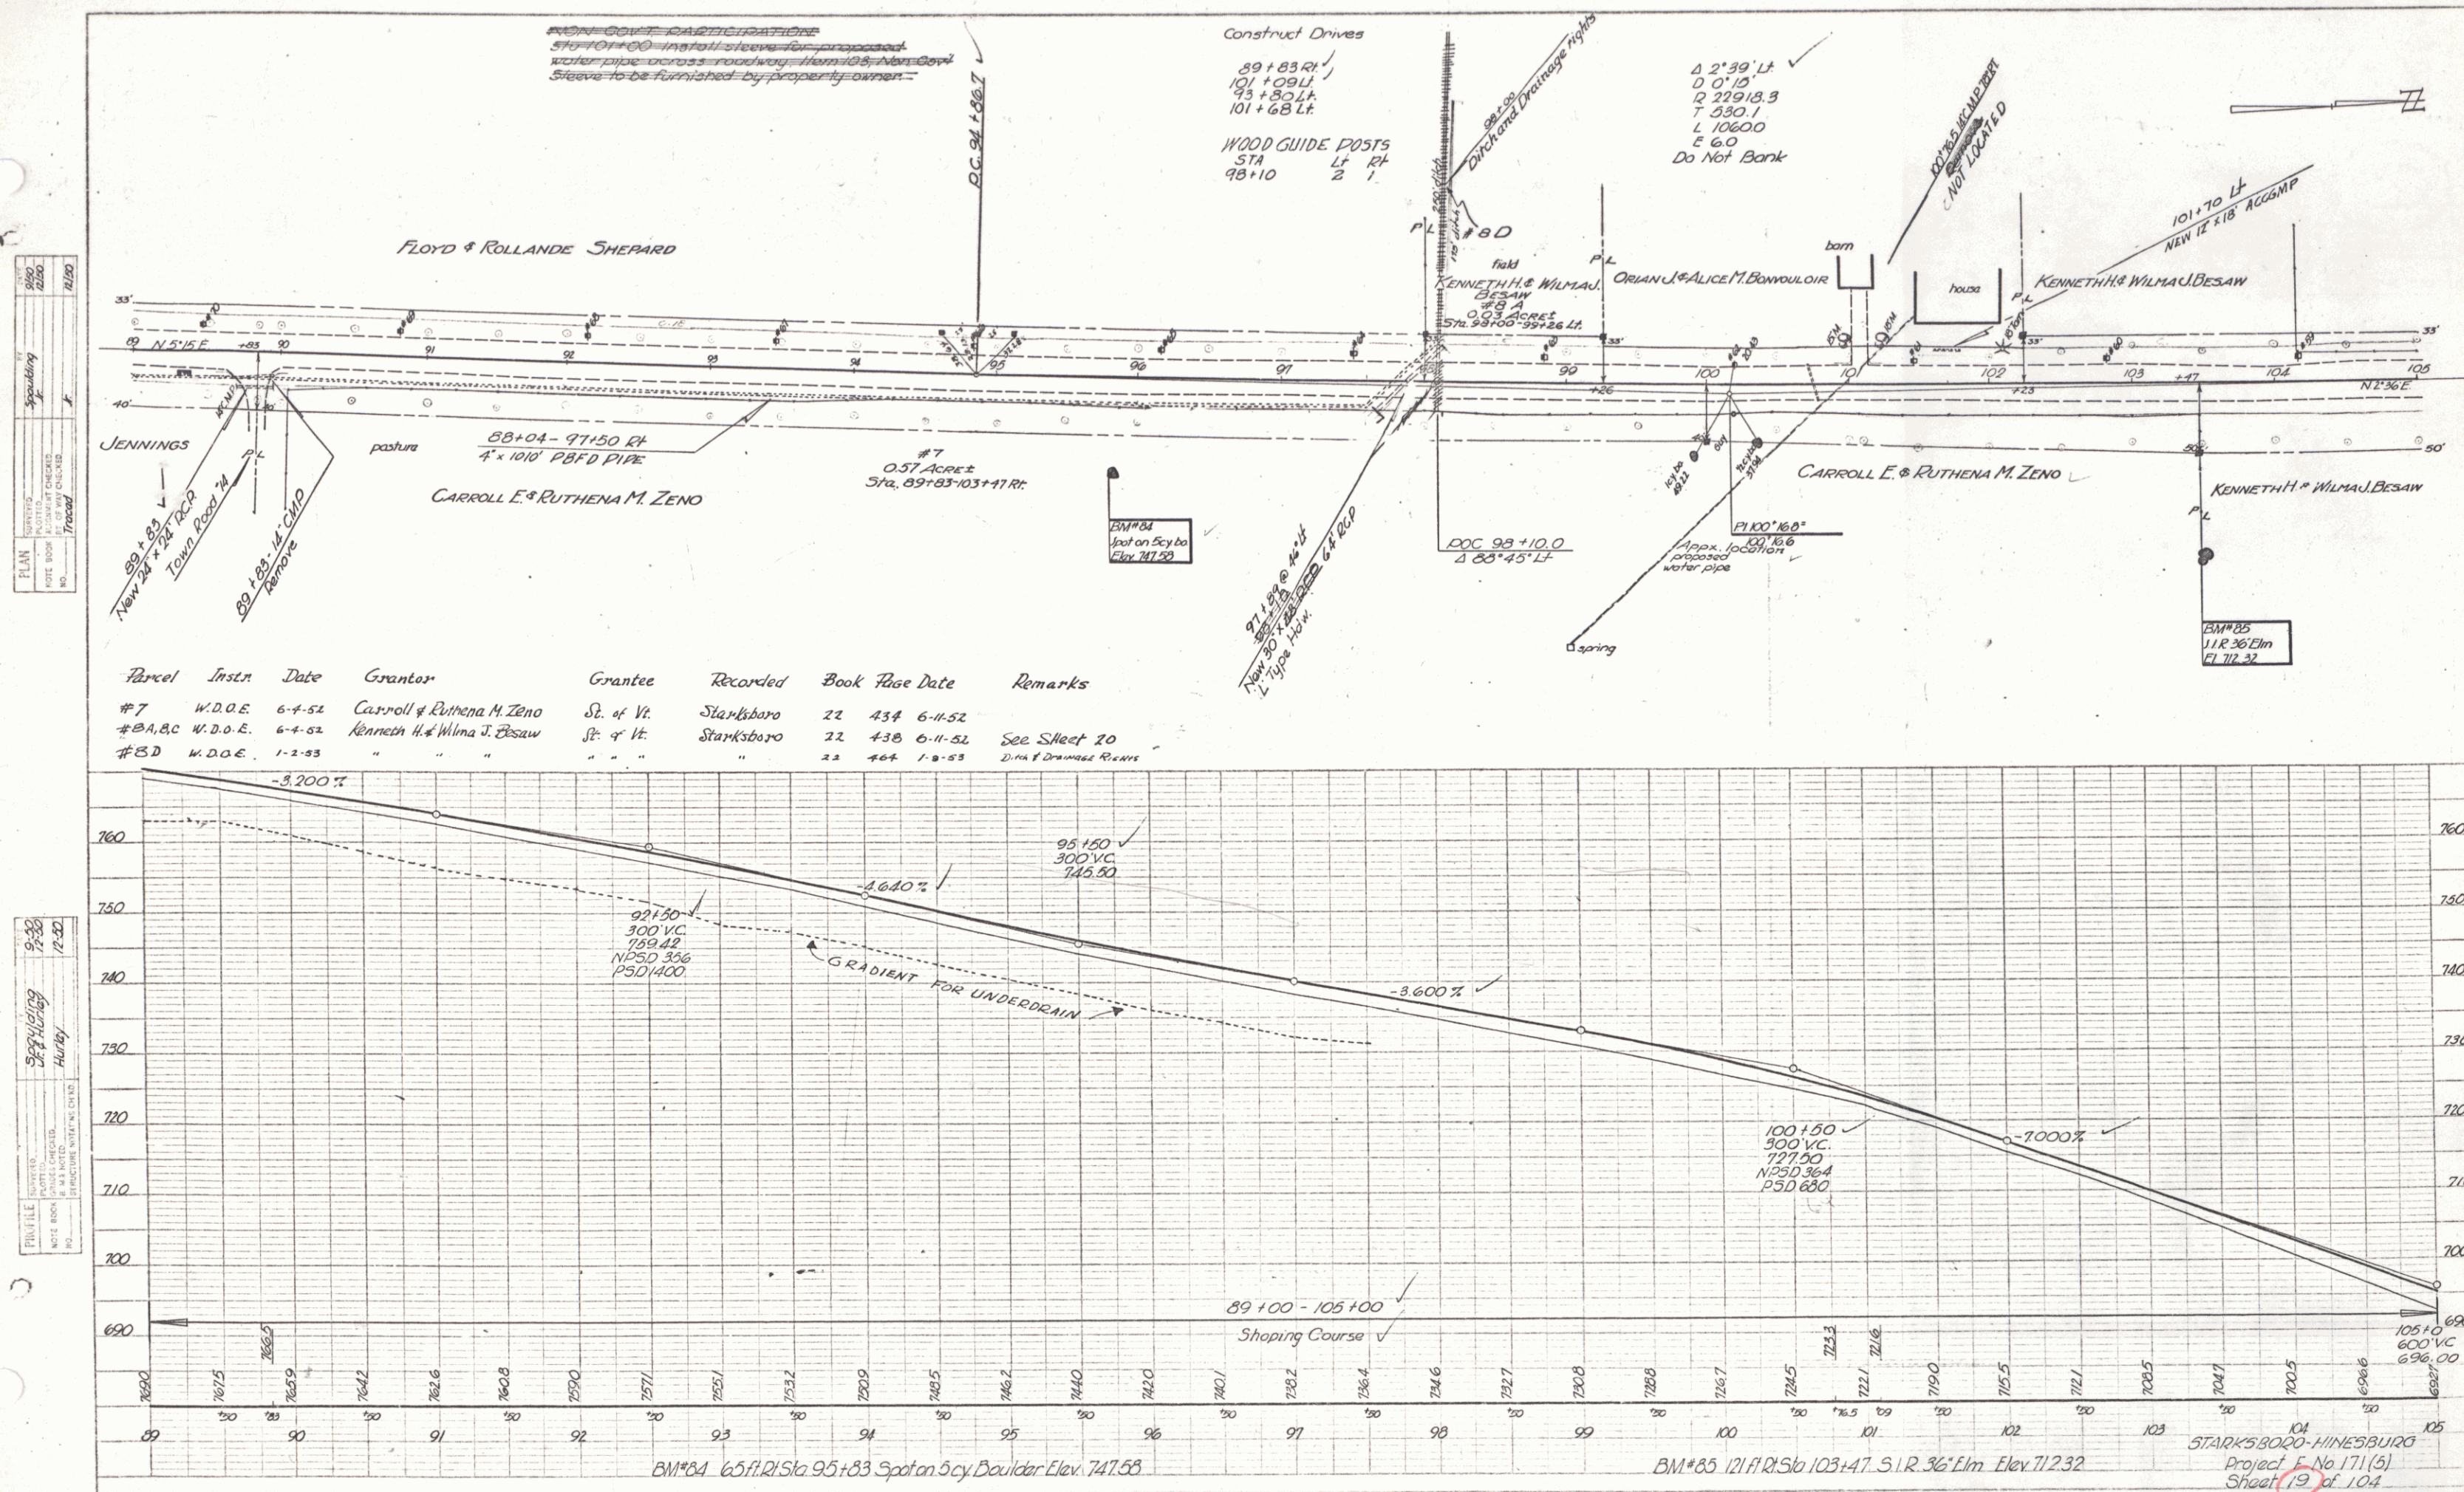

PLAN	DATE	BY	CHKD	APP'D
11/20	11/20	11/20	11/20	11/20
11/20	11/20	11/20	11/20	11/20
11/20	11/20	11/20	11/20	11/20
11/20	11/20	11/20	11/20	11/20

THWILL	DATE	BY	CHKD	APP'D
11/20	11/20	11/20	11/20	11/20
11/20	11/20	11/20	11/20	11/20
11/20	11/20	11/20	11/20	11/20
11/20	11/20	11/20	11/20	11/20

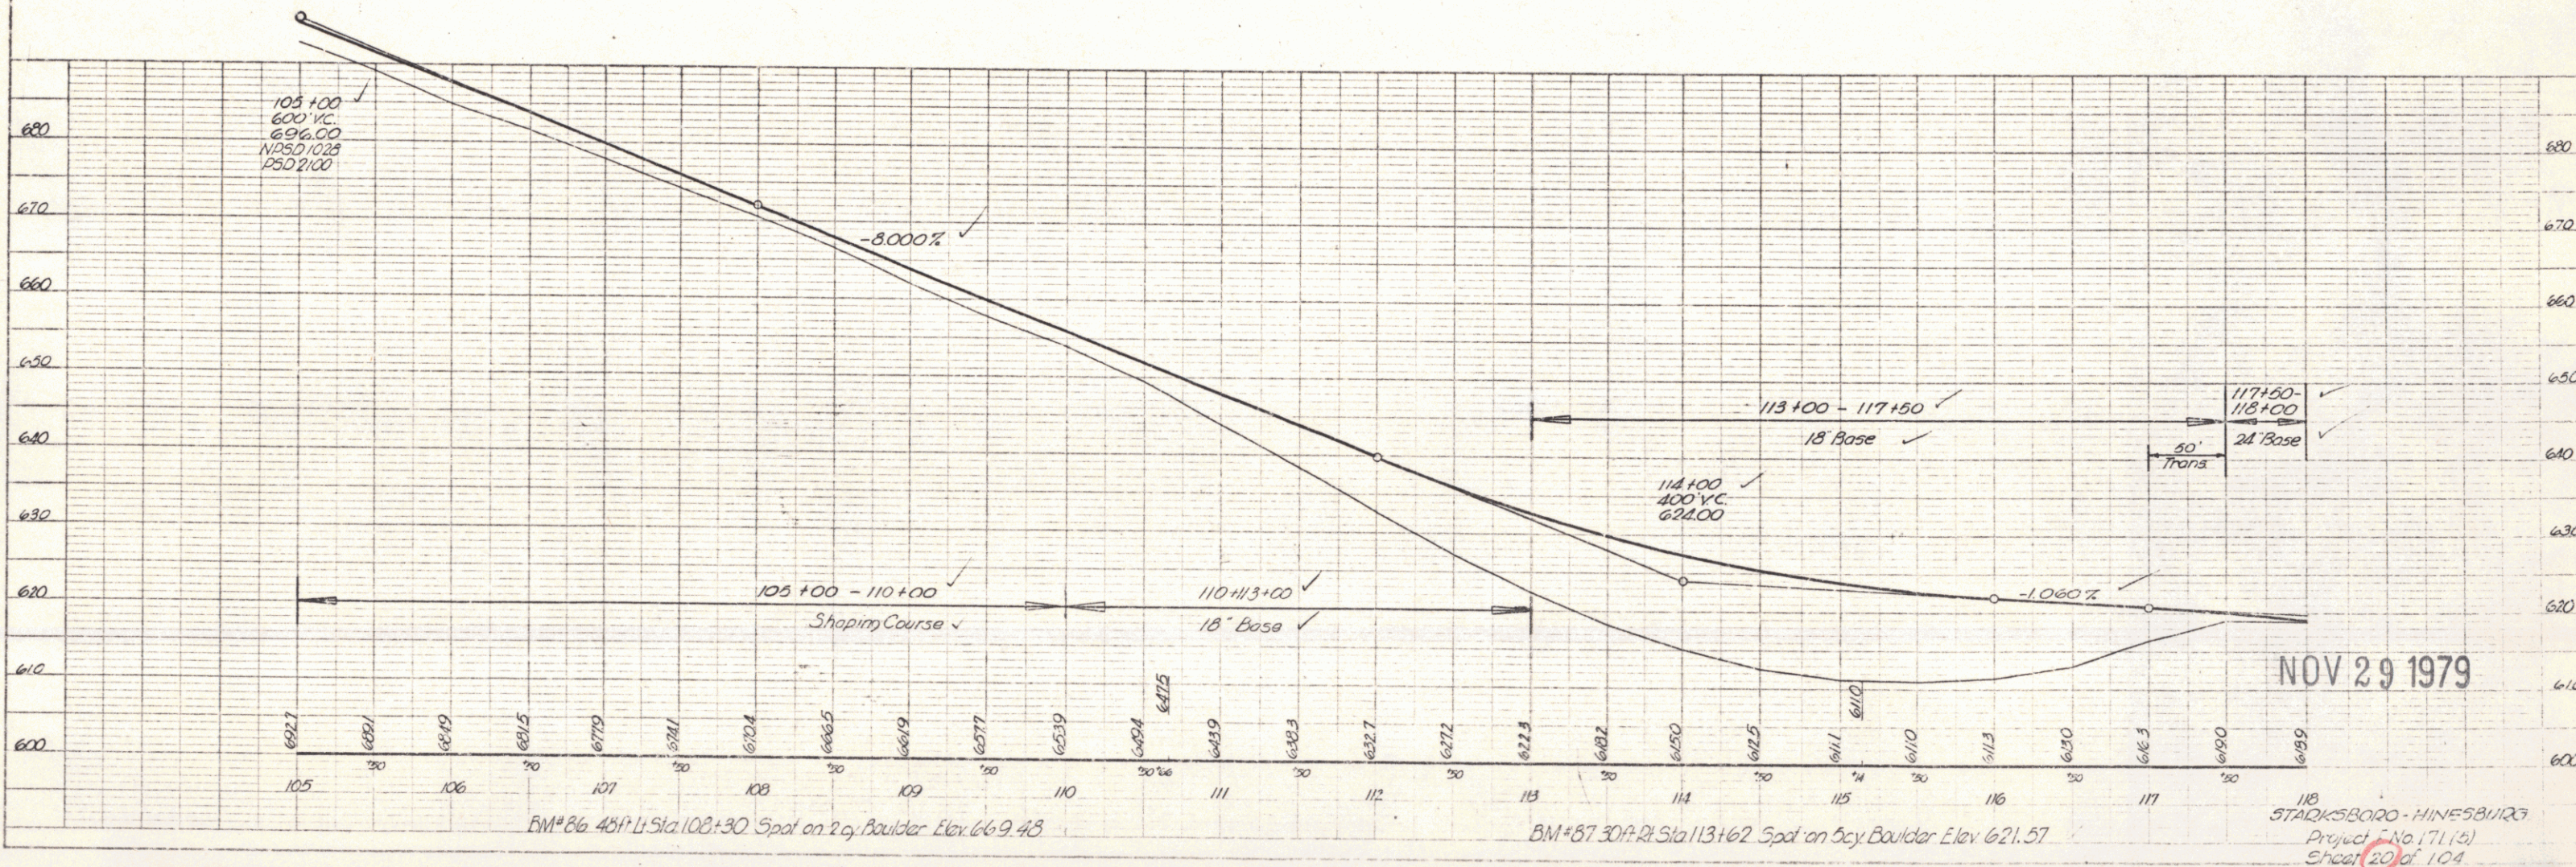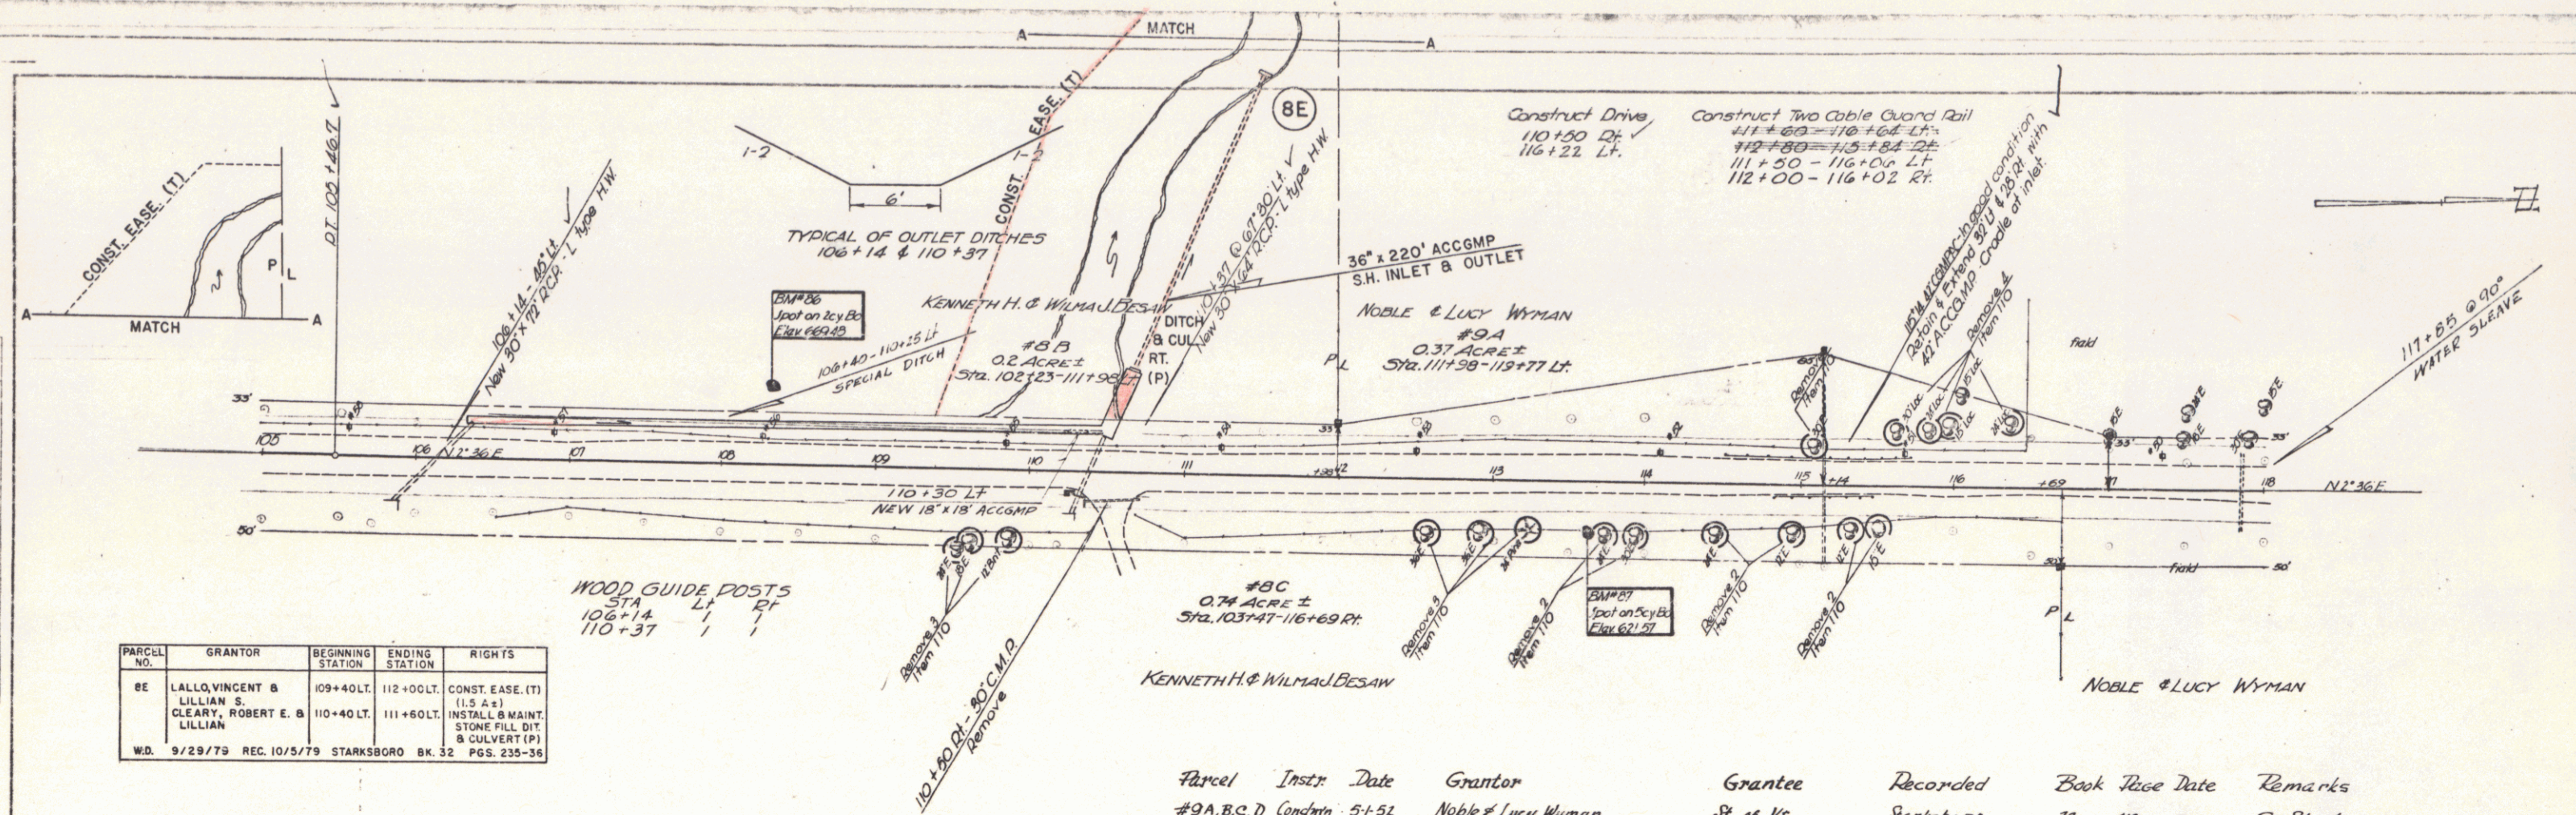

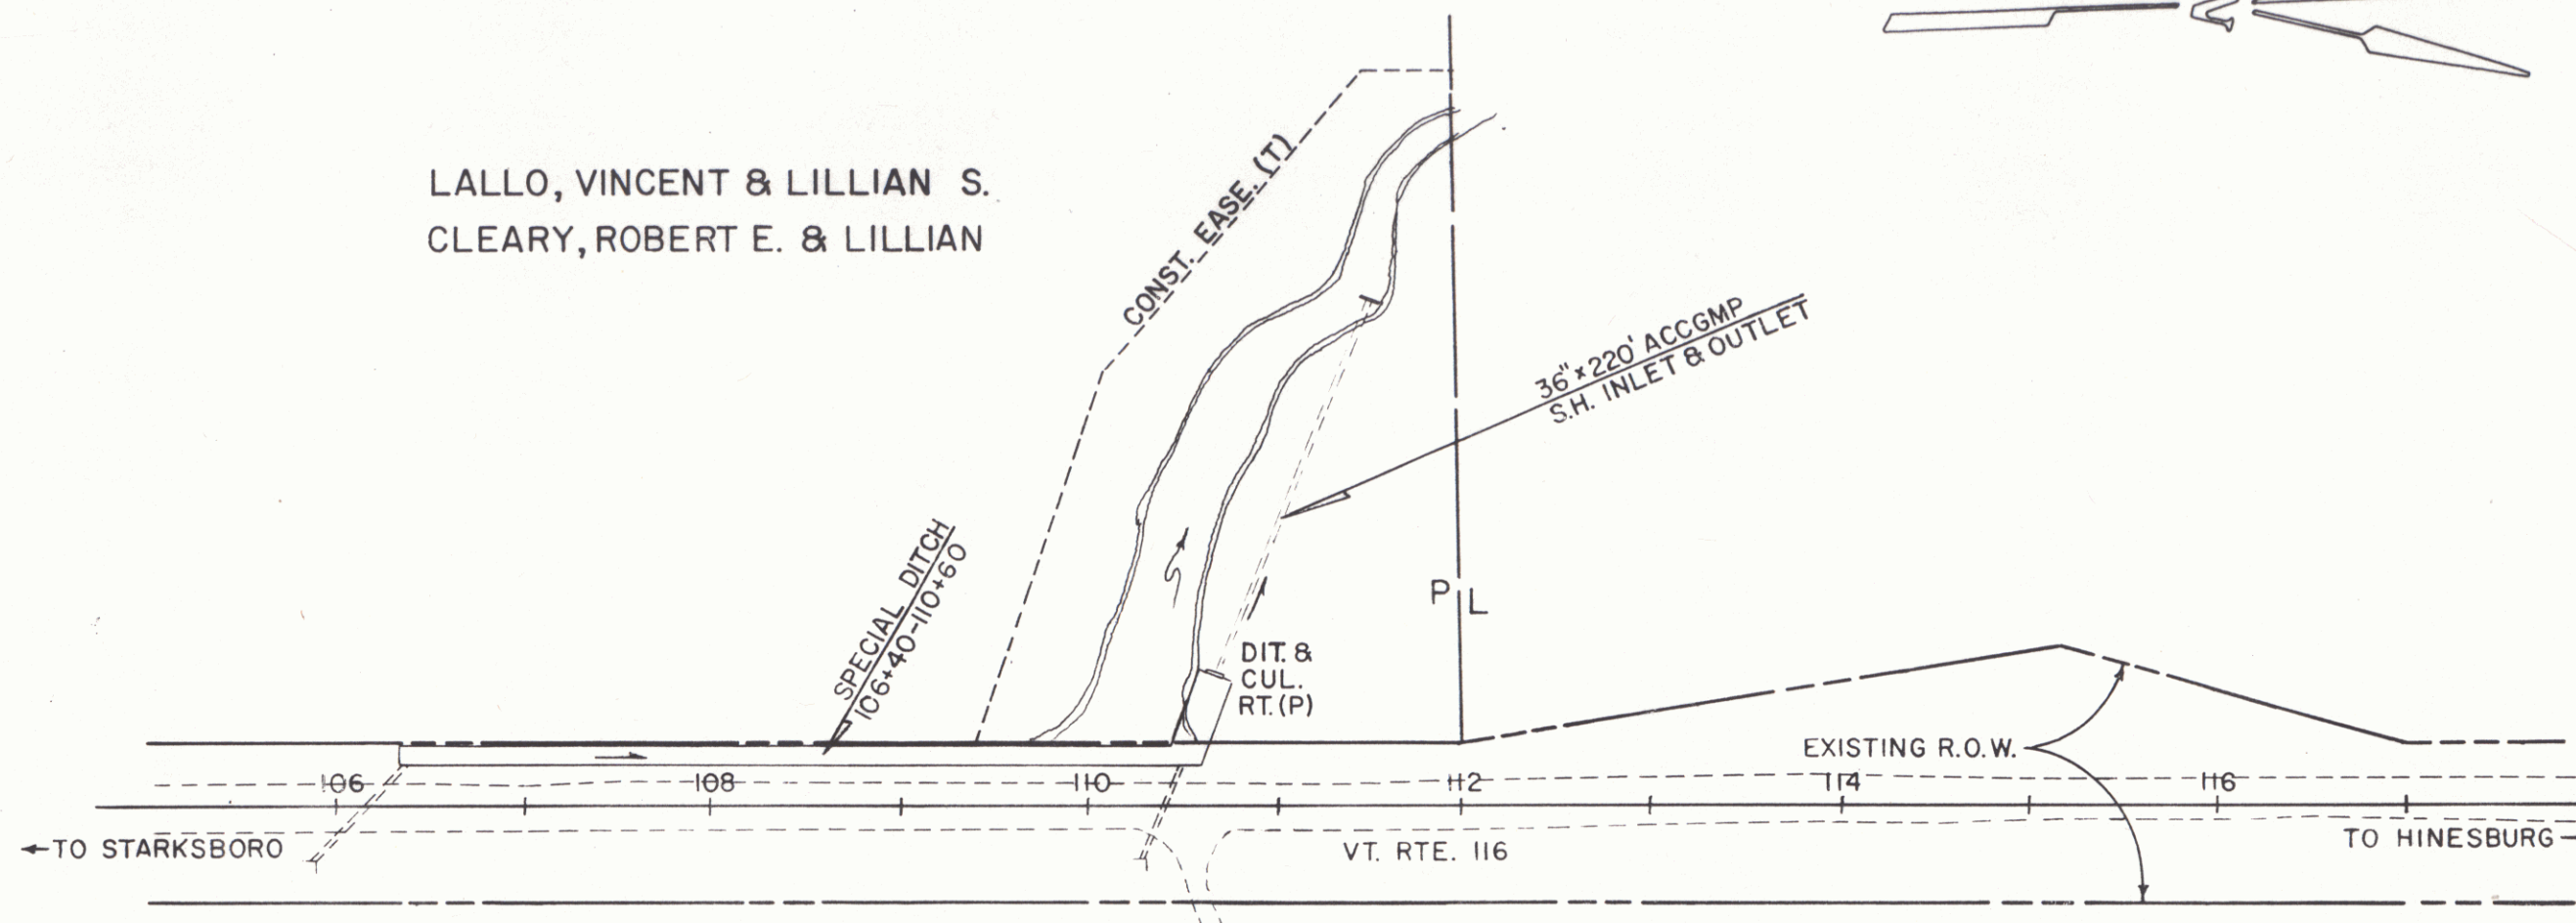


By WD on 9/29/79 RECORDED 10/5/79 IN STARKSBORO

T.C. OFFICE BK 32/235-36

MP 0527


GRANTOR	BEGINNING STATION	ENDING STATION	RIGHTS
LALLO, VINCENT & LILLIAN S. CLEARY, ROBERT E. & LILLIAN	109+40 LT. 110+40 LT.	112+00 LT. 111+60 LT.	CONST. EASE. (T) (1.5 A±) INSTALL & MAINT. STONE FILL, DIT. & CULVERT (P)

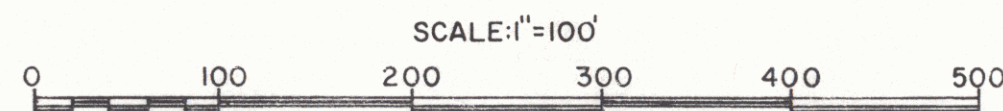


REF: SHEET 20 OF 104.

STATE OF VERMONT AGENCY OF TRANSPORTATION		
STARKSBORO - HINESBURG		
PROJECT	F 171 (5)	20A
APPROX. SCALE	1"=100'	DATE 7-19-79
DRAWN BY S.J.B.		10



PLAN	DATE	BY	CHKD
REVISIONS			
NO. 1	12-50	Spaulding	12-50
NO. 2	12-50	Spaulding	12-50
NO. 3	12-50	Spaulding	12-50
NO. 100	12-50	Spaulding	12-50

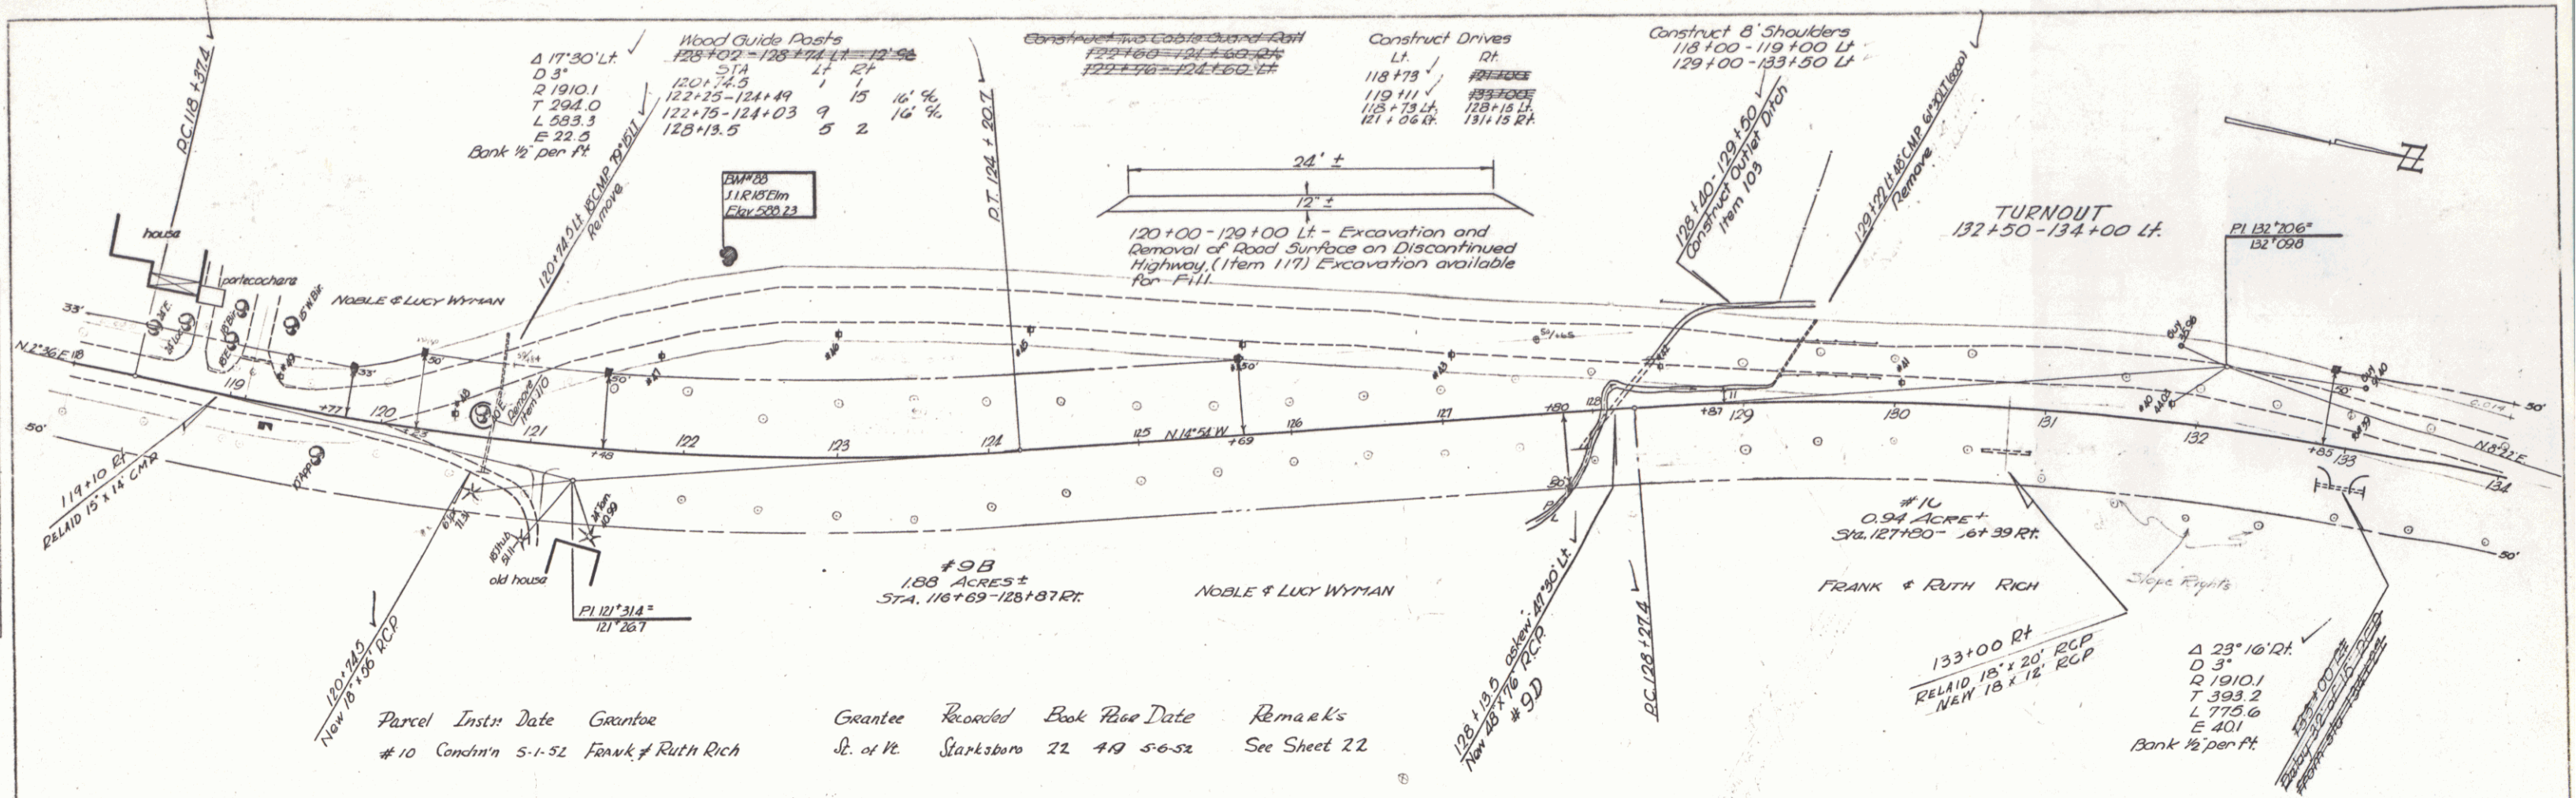

PROFILE	DATE	BY	CHKD
REVISIONS			
NO. 1	12-50	Spaulding	12-50
NO. 2	12-50	Spaulding	12-50
NO. 3	12-50	Spaulding	12-50
NO. 100	12-50	Spaulding	12-50


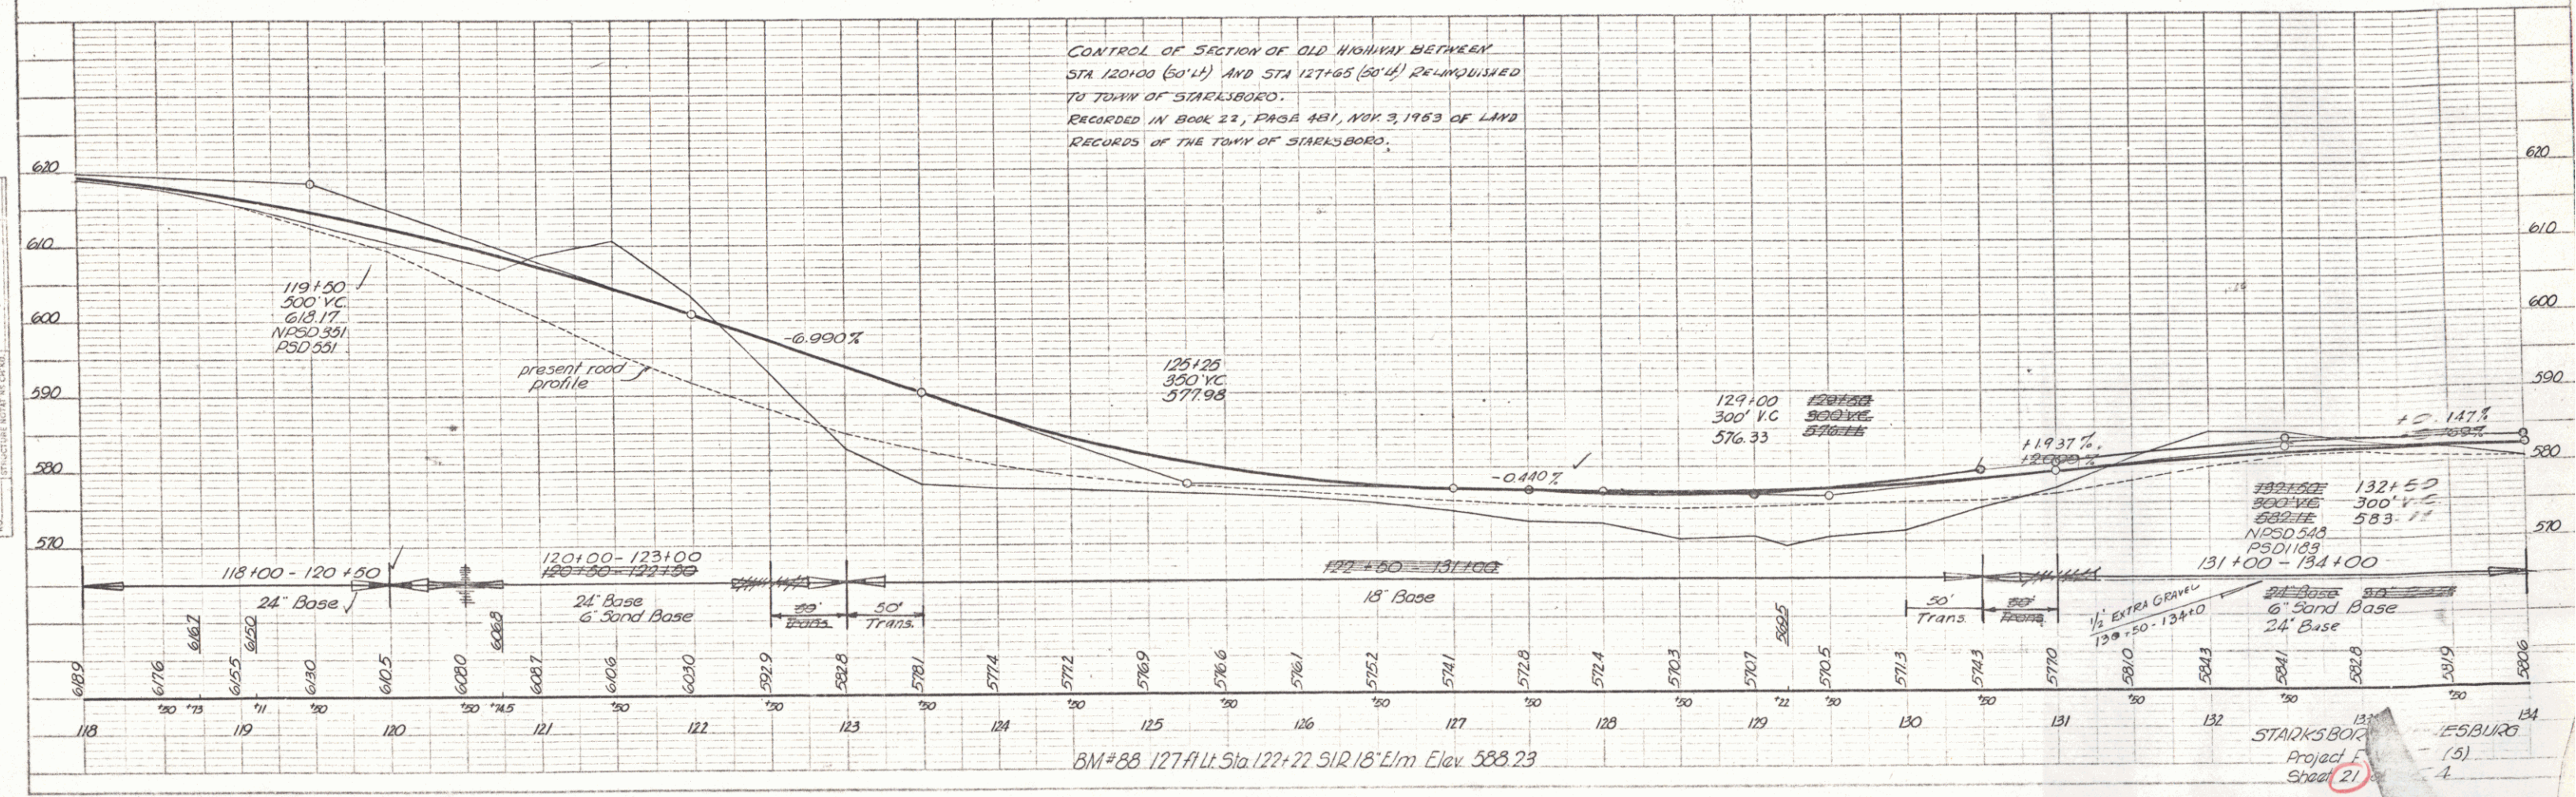


DATE	9-30 12-30
BY	Spaulding Jr. & Hurley Hurley
PROPERTY	
SURVIVED	
PLANTED	
GRASSES CHECKED	
B.M. NOTED	
GRAPICURE NOTATIONS CHD.	
PROFILE	
NOTE BOOK	
NO.	

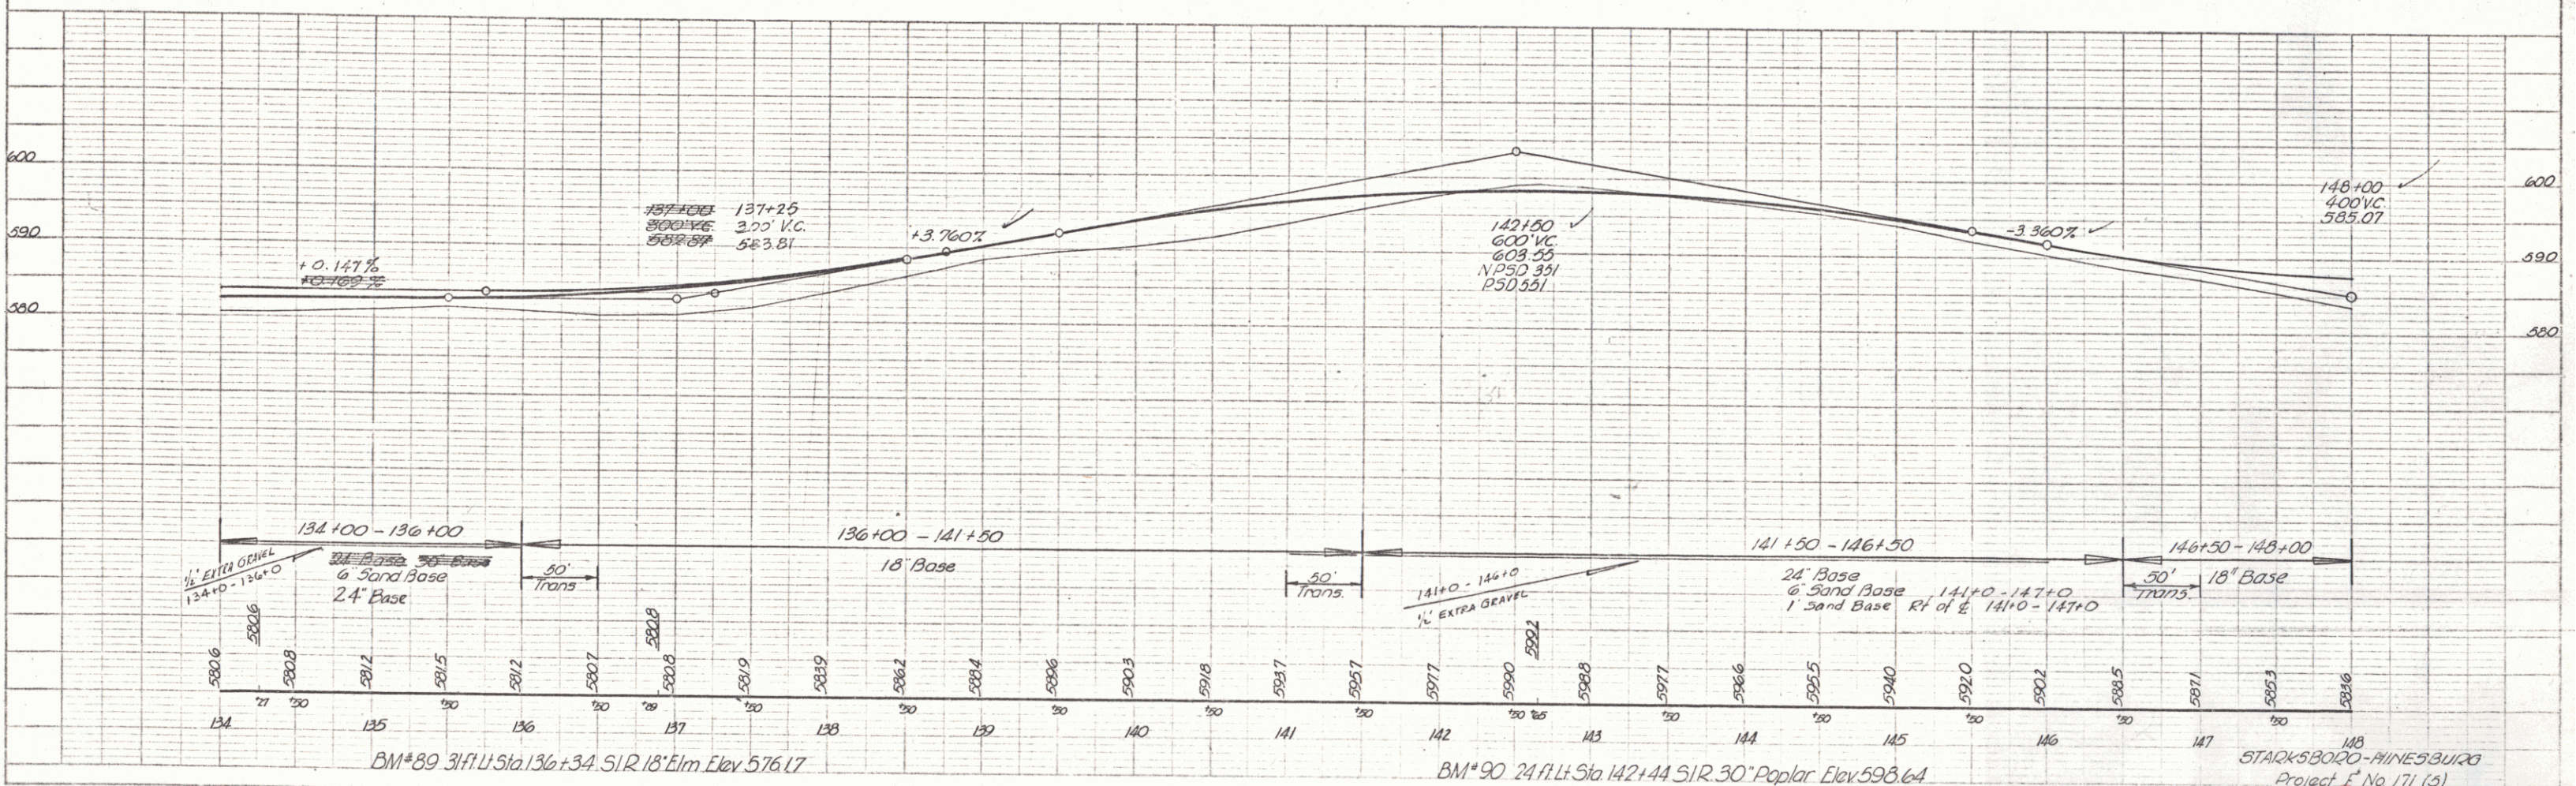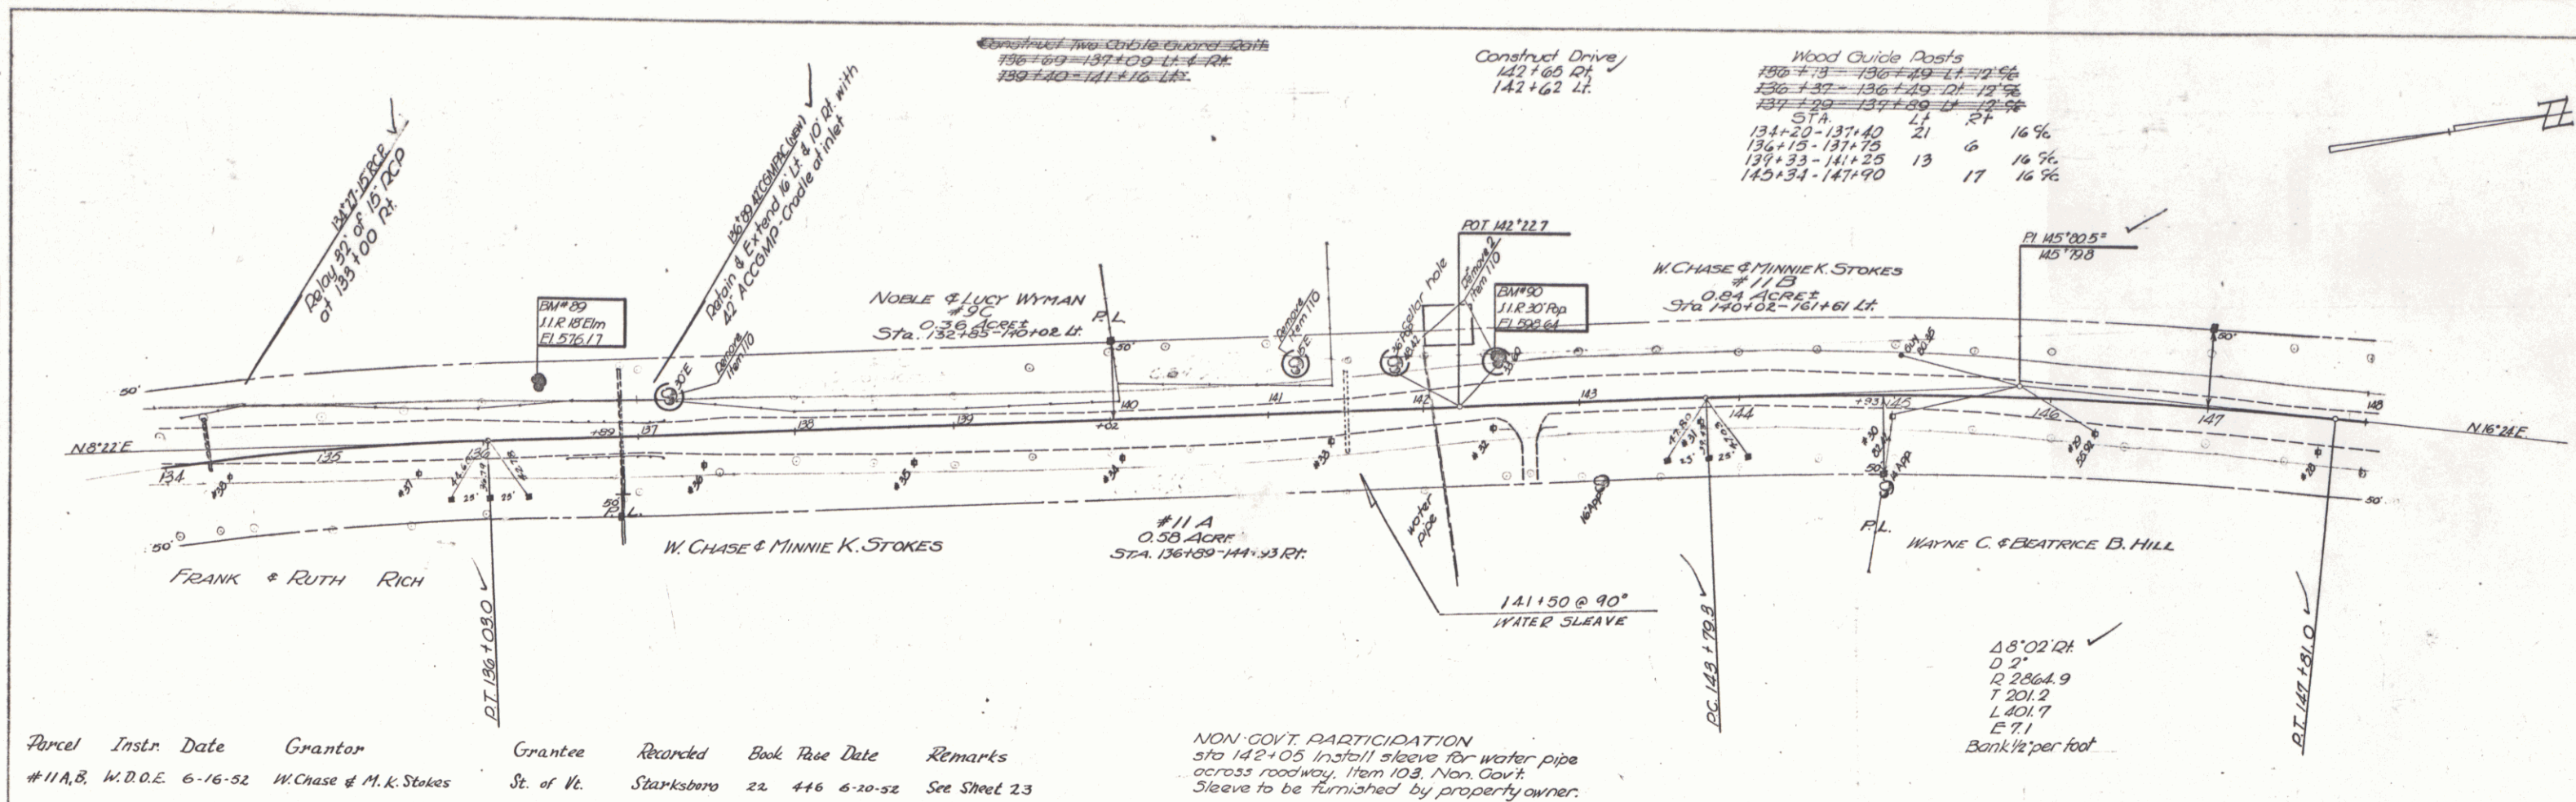

PLAN	DATE	BY	CHECKED	DATE
11/20	11/20	11/20	11/20	11/20
11/20	11/20	11/20	11/20	11/20
11/20	11/20	11/20	11/20	11/20


PROFILE	DATE	BY	CHECKED	DATE
11/20	11/20	11/20	11/20	11/20
11/20	11/20	11/20	11/20	11/20
11/20	11/20	11/20	11/20	11/20

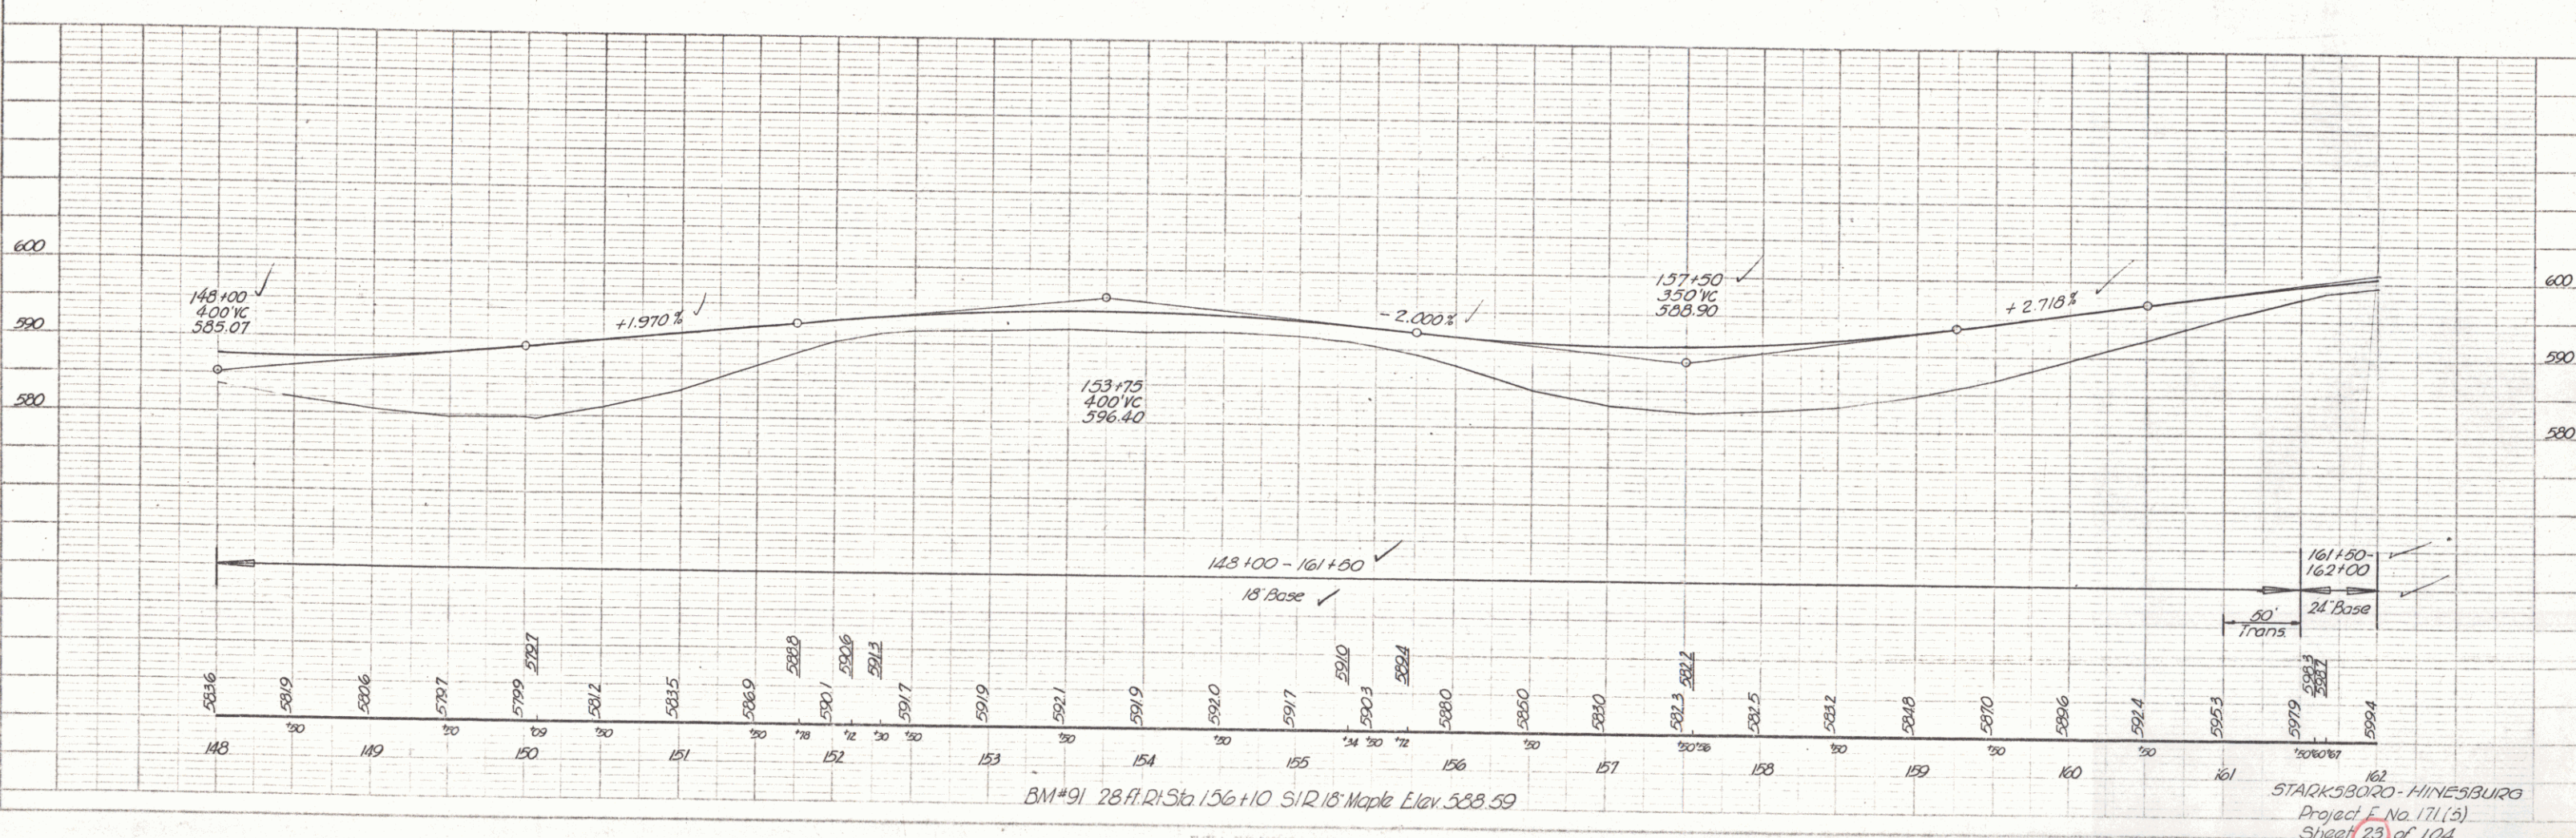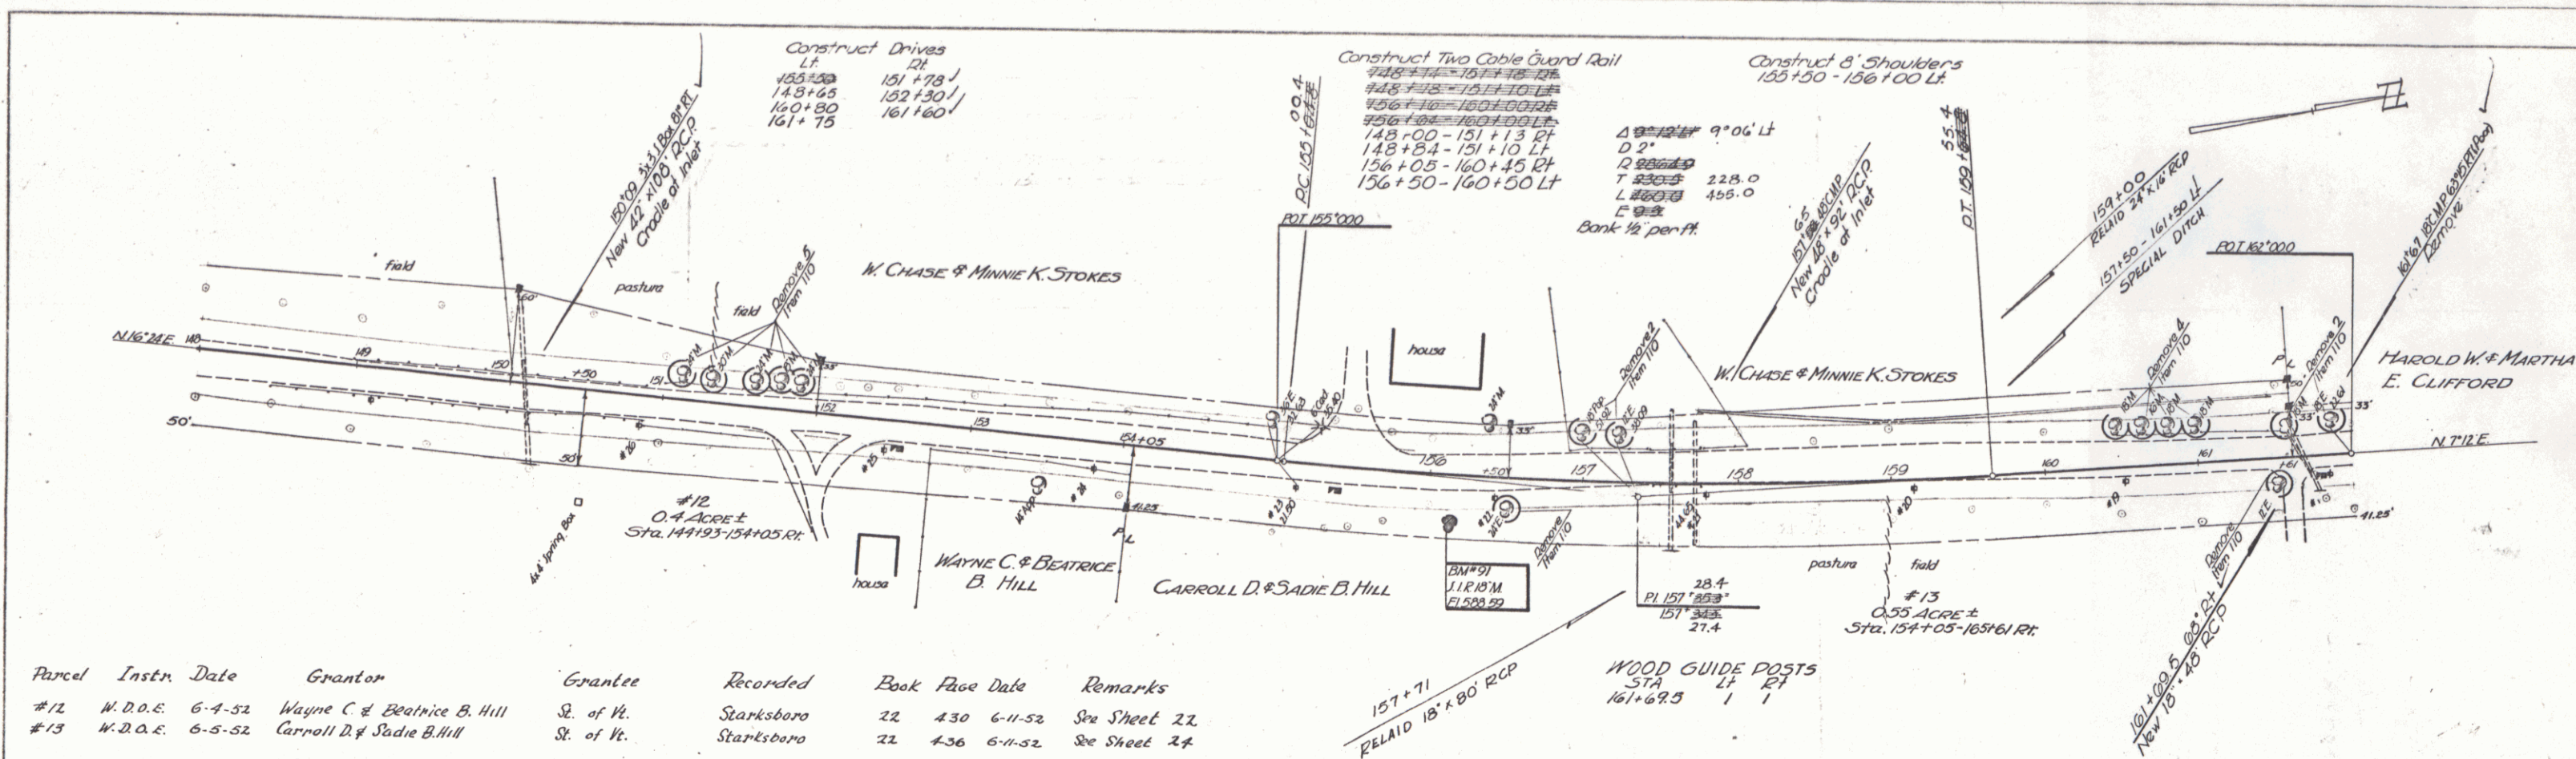

BM#91 28 ft. 21 St. 156+10 S/R 18' Maple Elev. 588.59


STARKSBORO - HINESBURG
Project No. 171(5)
Sheet 23 of 104

PLAN	9/30
DATE	9/30
BY	Spaulding
CHECKED	12/30
BY	12/30

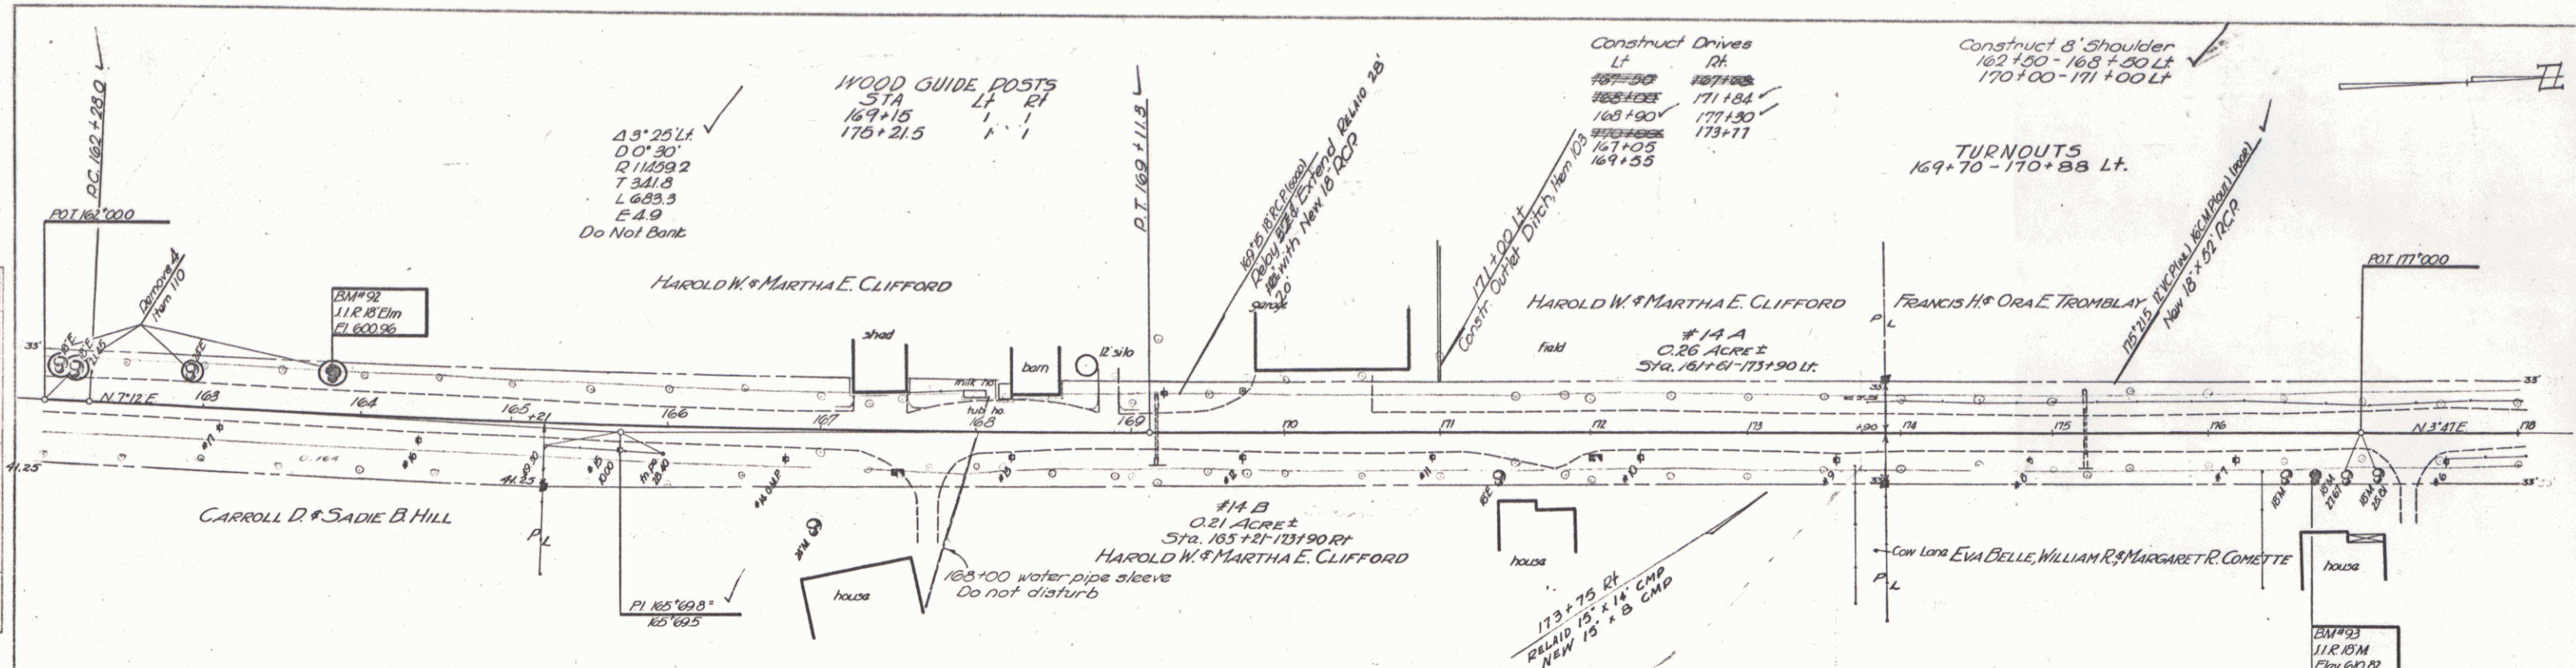

Parcel	Instr.	Date	Grantor	Grantee	Recorded	Book	Page	Date	Remarks
#14 A, B	W.D.O.E.	6-16-52	Harold W. & Martha E. Clifford	St. of Va.	Sparksboro	22	442	6-20-52	See Sheet 23

PROFILE	9/30
DATE	9/30
BY	Spaulding
CHECKED	12/30
BY	12/30

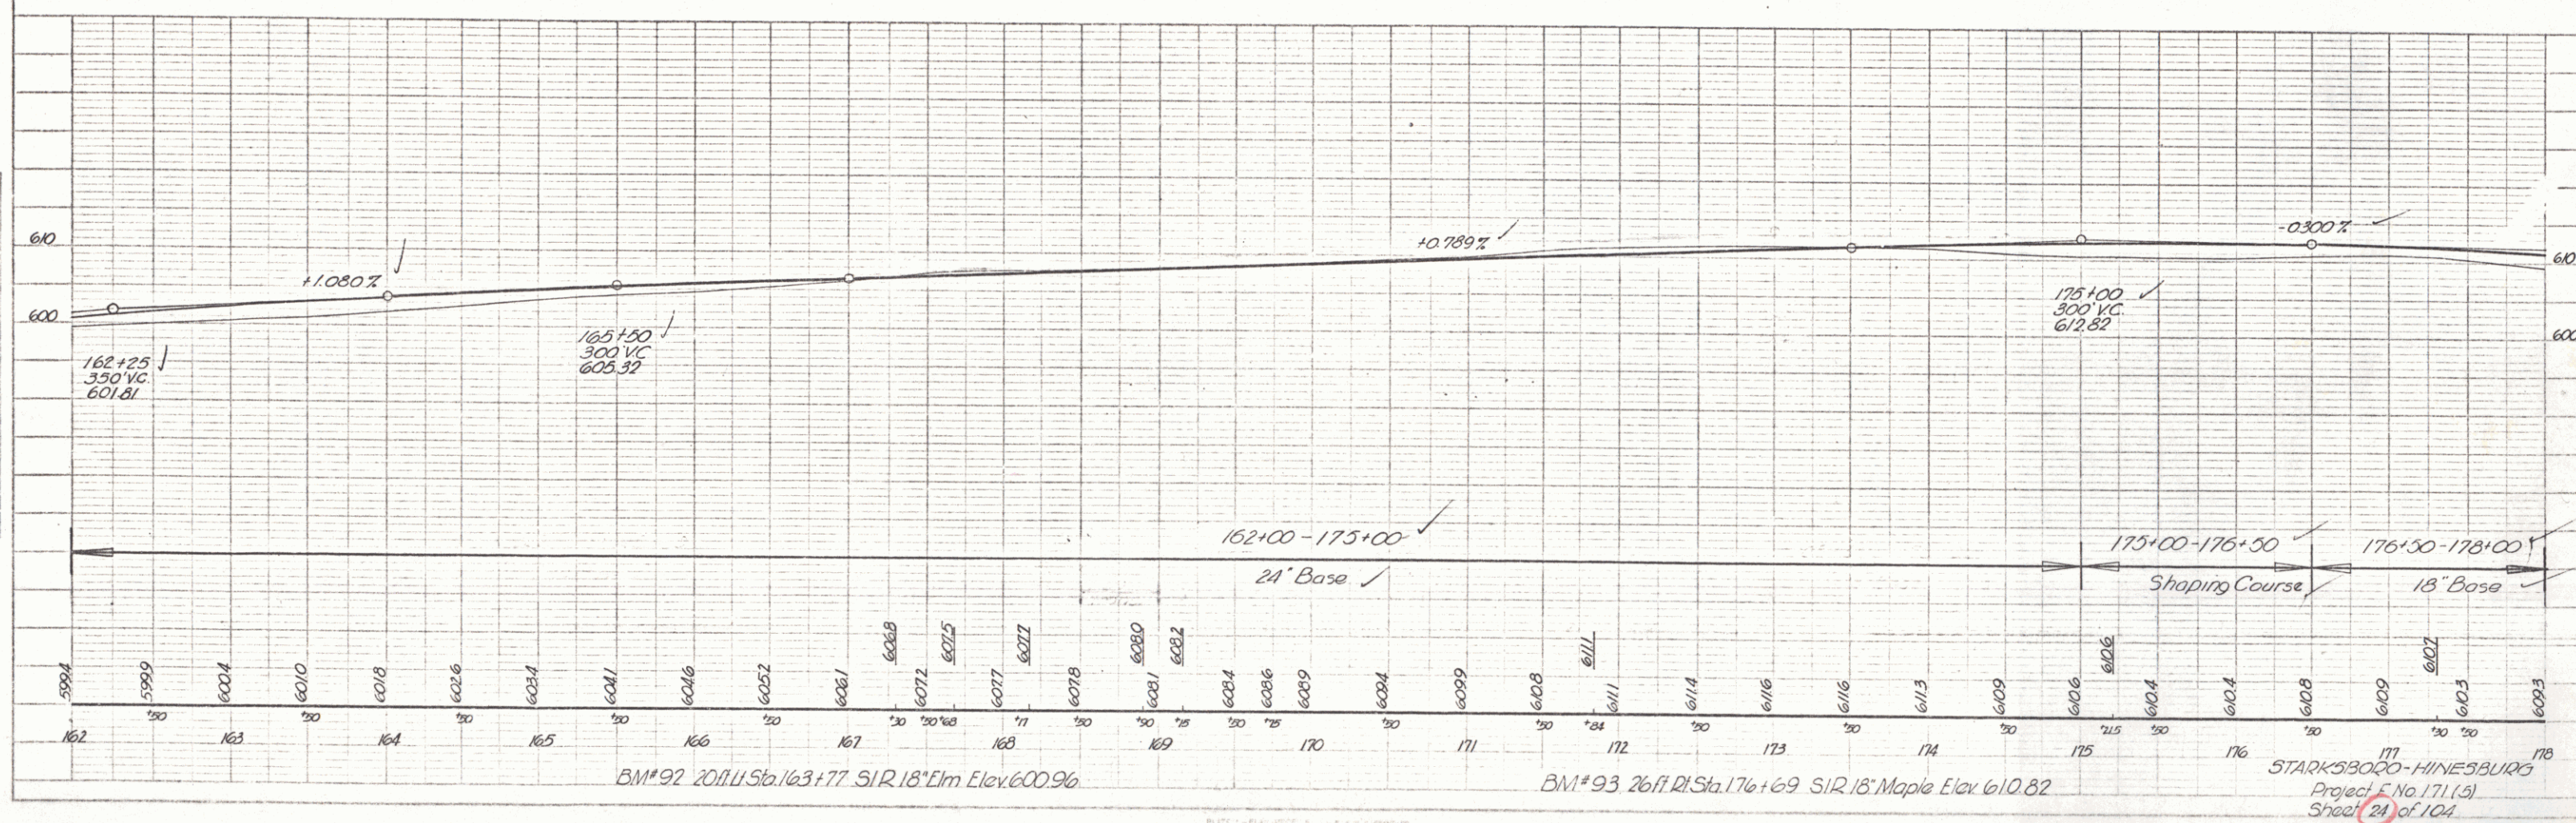

Parcel	Instr.	Date	Grantor	Grantee	Recorded	Book	Page	Date	Remarks
#15	W.D.O.E.	7-2-52	Francis H. & Ora E. Tromblay	St. of Vt.	Starksboro	22	440	7-5-52	See Sheets 24, 26
#16	W.D.O.E.	6-17-52	E.B. W.R. & M.R. Comette	St. of Vt.	Hinesburg	29	242	8-18-52	See Sheets 26, 27
#17	W.D.O.E.	6-17-52	Rollin C. & Jessie A. Place	St. of Vt.	Starksboro	22	450	6-10-52	
					Hinesburg	29	194	7-1-52	
					Starksboro	22	452	6-28-52	
					Hinesburg	29	193	7-1-52	


CONSTRUCT DRIVES

Construct 8' Shoulders
185+50 - 191+50 Lt.
193+50 - 199+00 Lt.


Wood Guide Posts

Sta.	Lt.	Rt.	16.96
181+50 - 183+90	10	6	
183+50 - 183+30	1	1	
184+77.5	2	2	
192+01.5			

PLAN
NOTED
RECORD
NO.

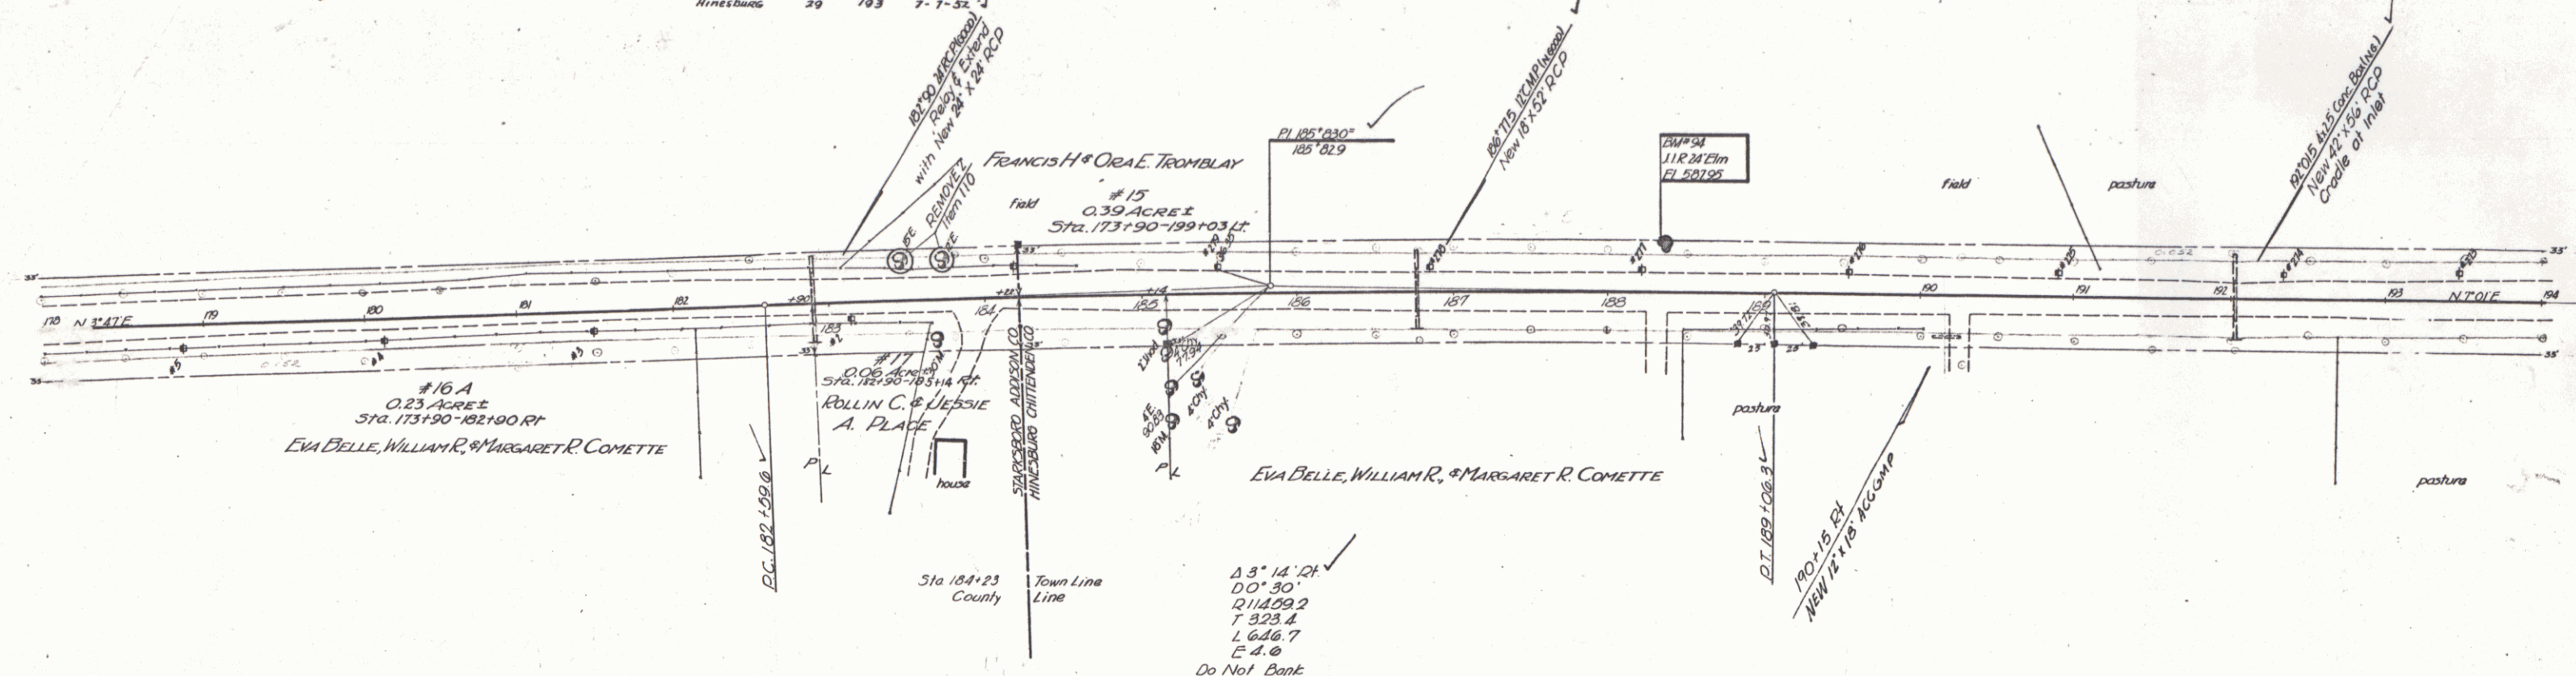

PROFILE
NOTED
RECORD
NO.

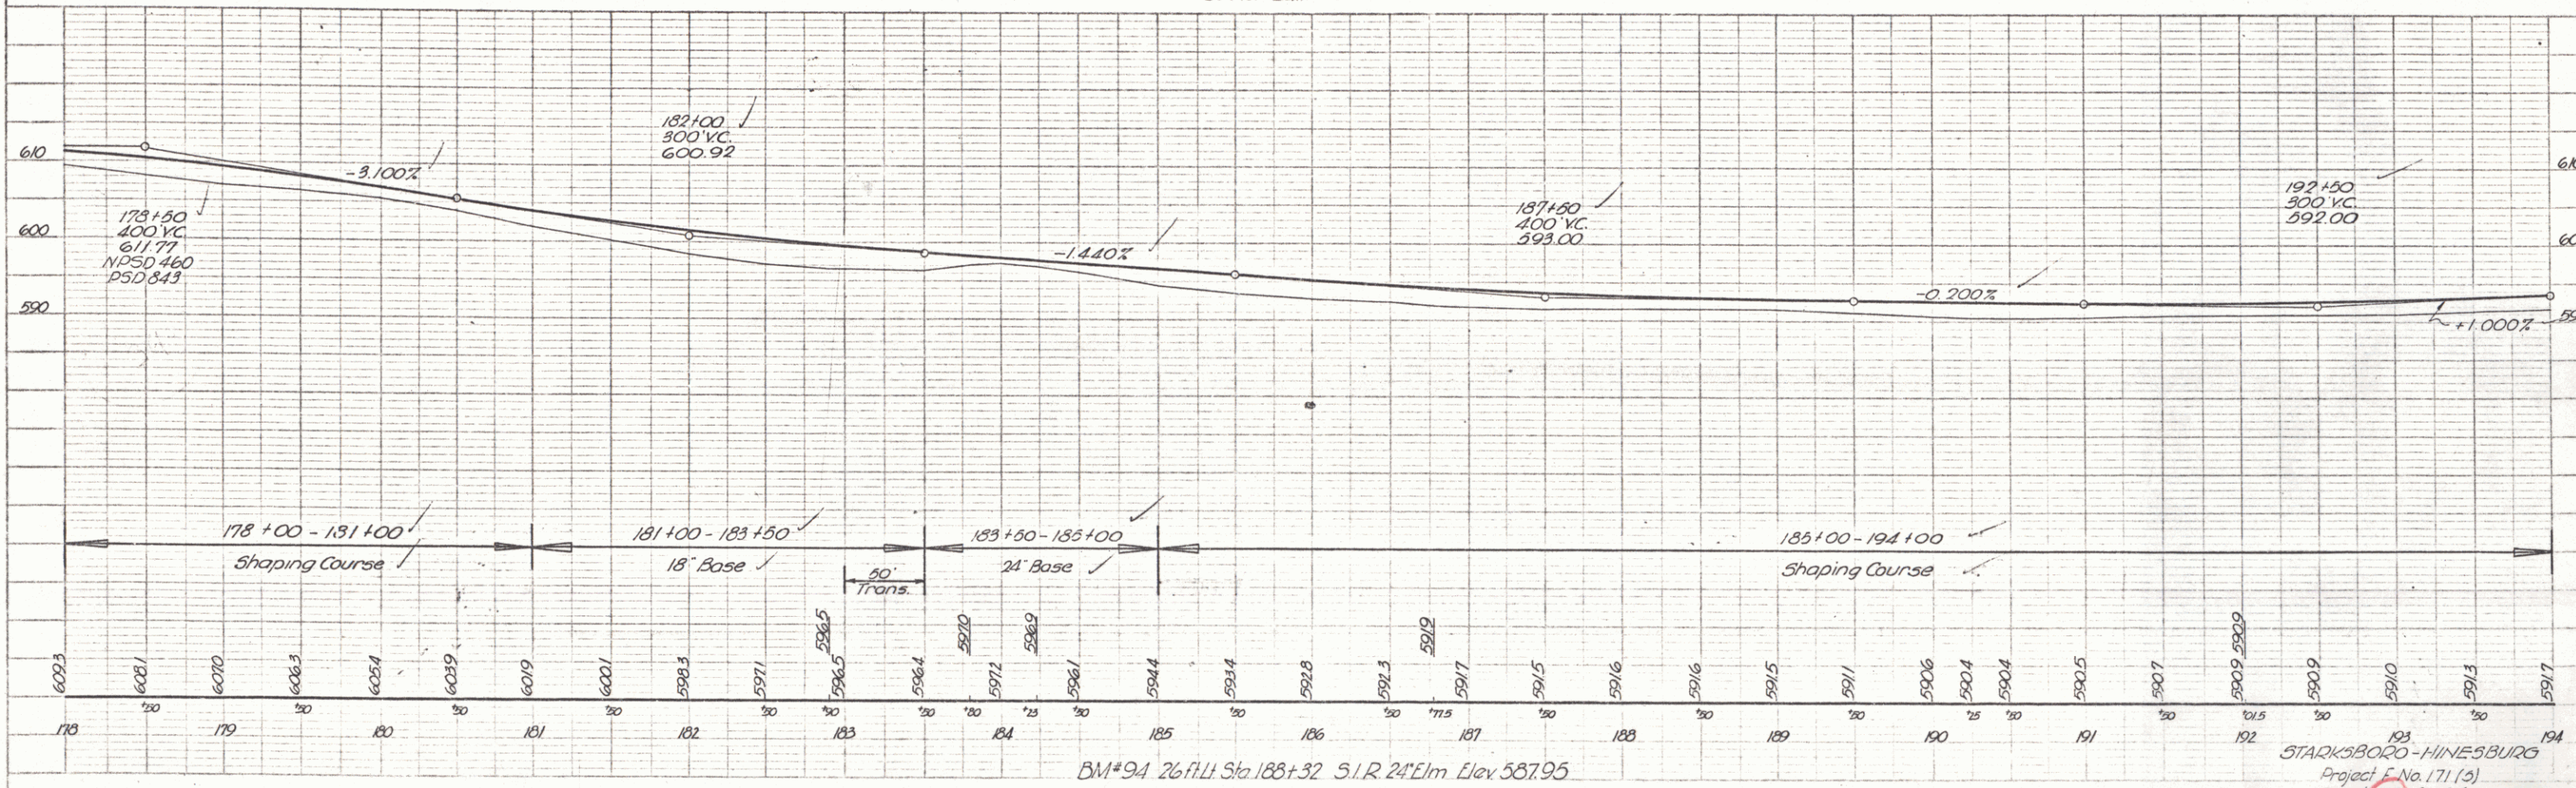


BM*94 26 ft. Li Sta 188+32 S.I.R. 24' Elm Elev 587.95

STARKSBORO-HINESBURG
Project E No. 171 (3)
Sheet 25 of 104

PLAN	DATE	BY	CHECKED	DATE
1/25/50	1/25/50	1/25/50	1/25/50	1/25/50
1/25/50	1/25/50	1/25/50	1/25/50	1/25/50
1/25/50	1/25/50	1/25/50	1/25/50	1/25/50

PROFILE	DATE	BY	CHECKED	DATE
1/25/50	1/25/50	1/25/50	1/25/50	1/25/50
1/25/50	1/25/50	1/25/50	1/25/50	1/25/50
1/25/50	1/25/50	1/25/50	1/25/50	1/25/50

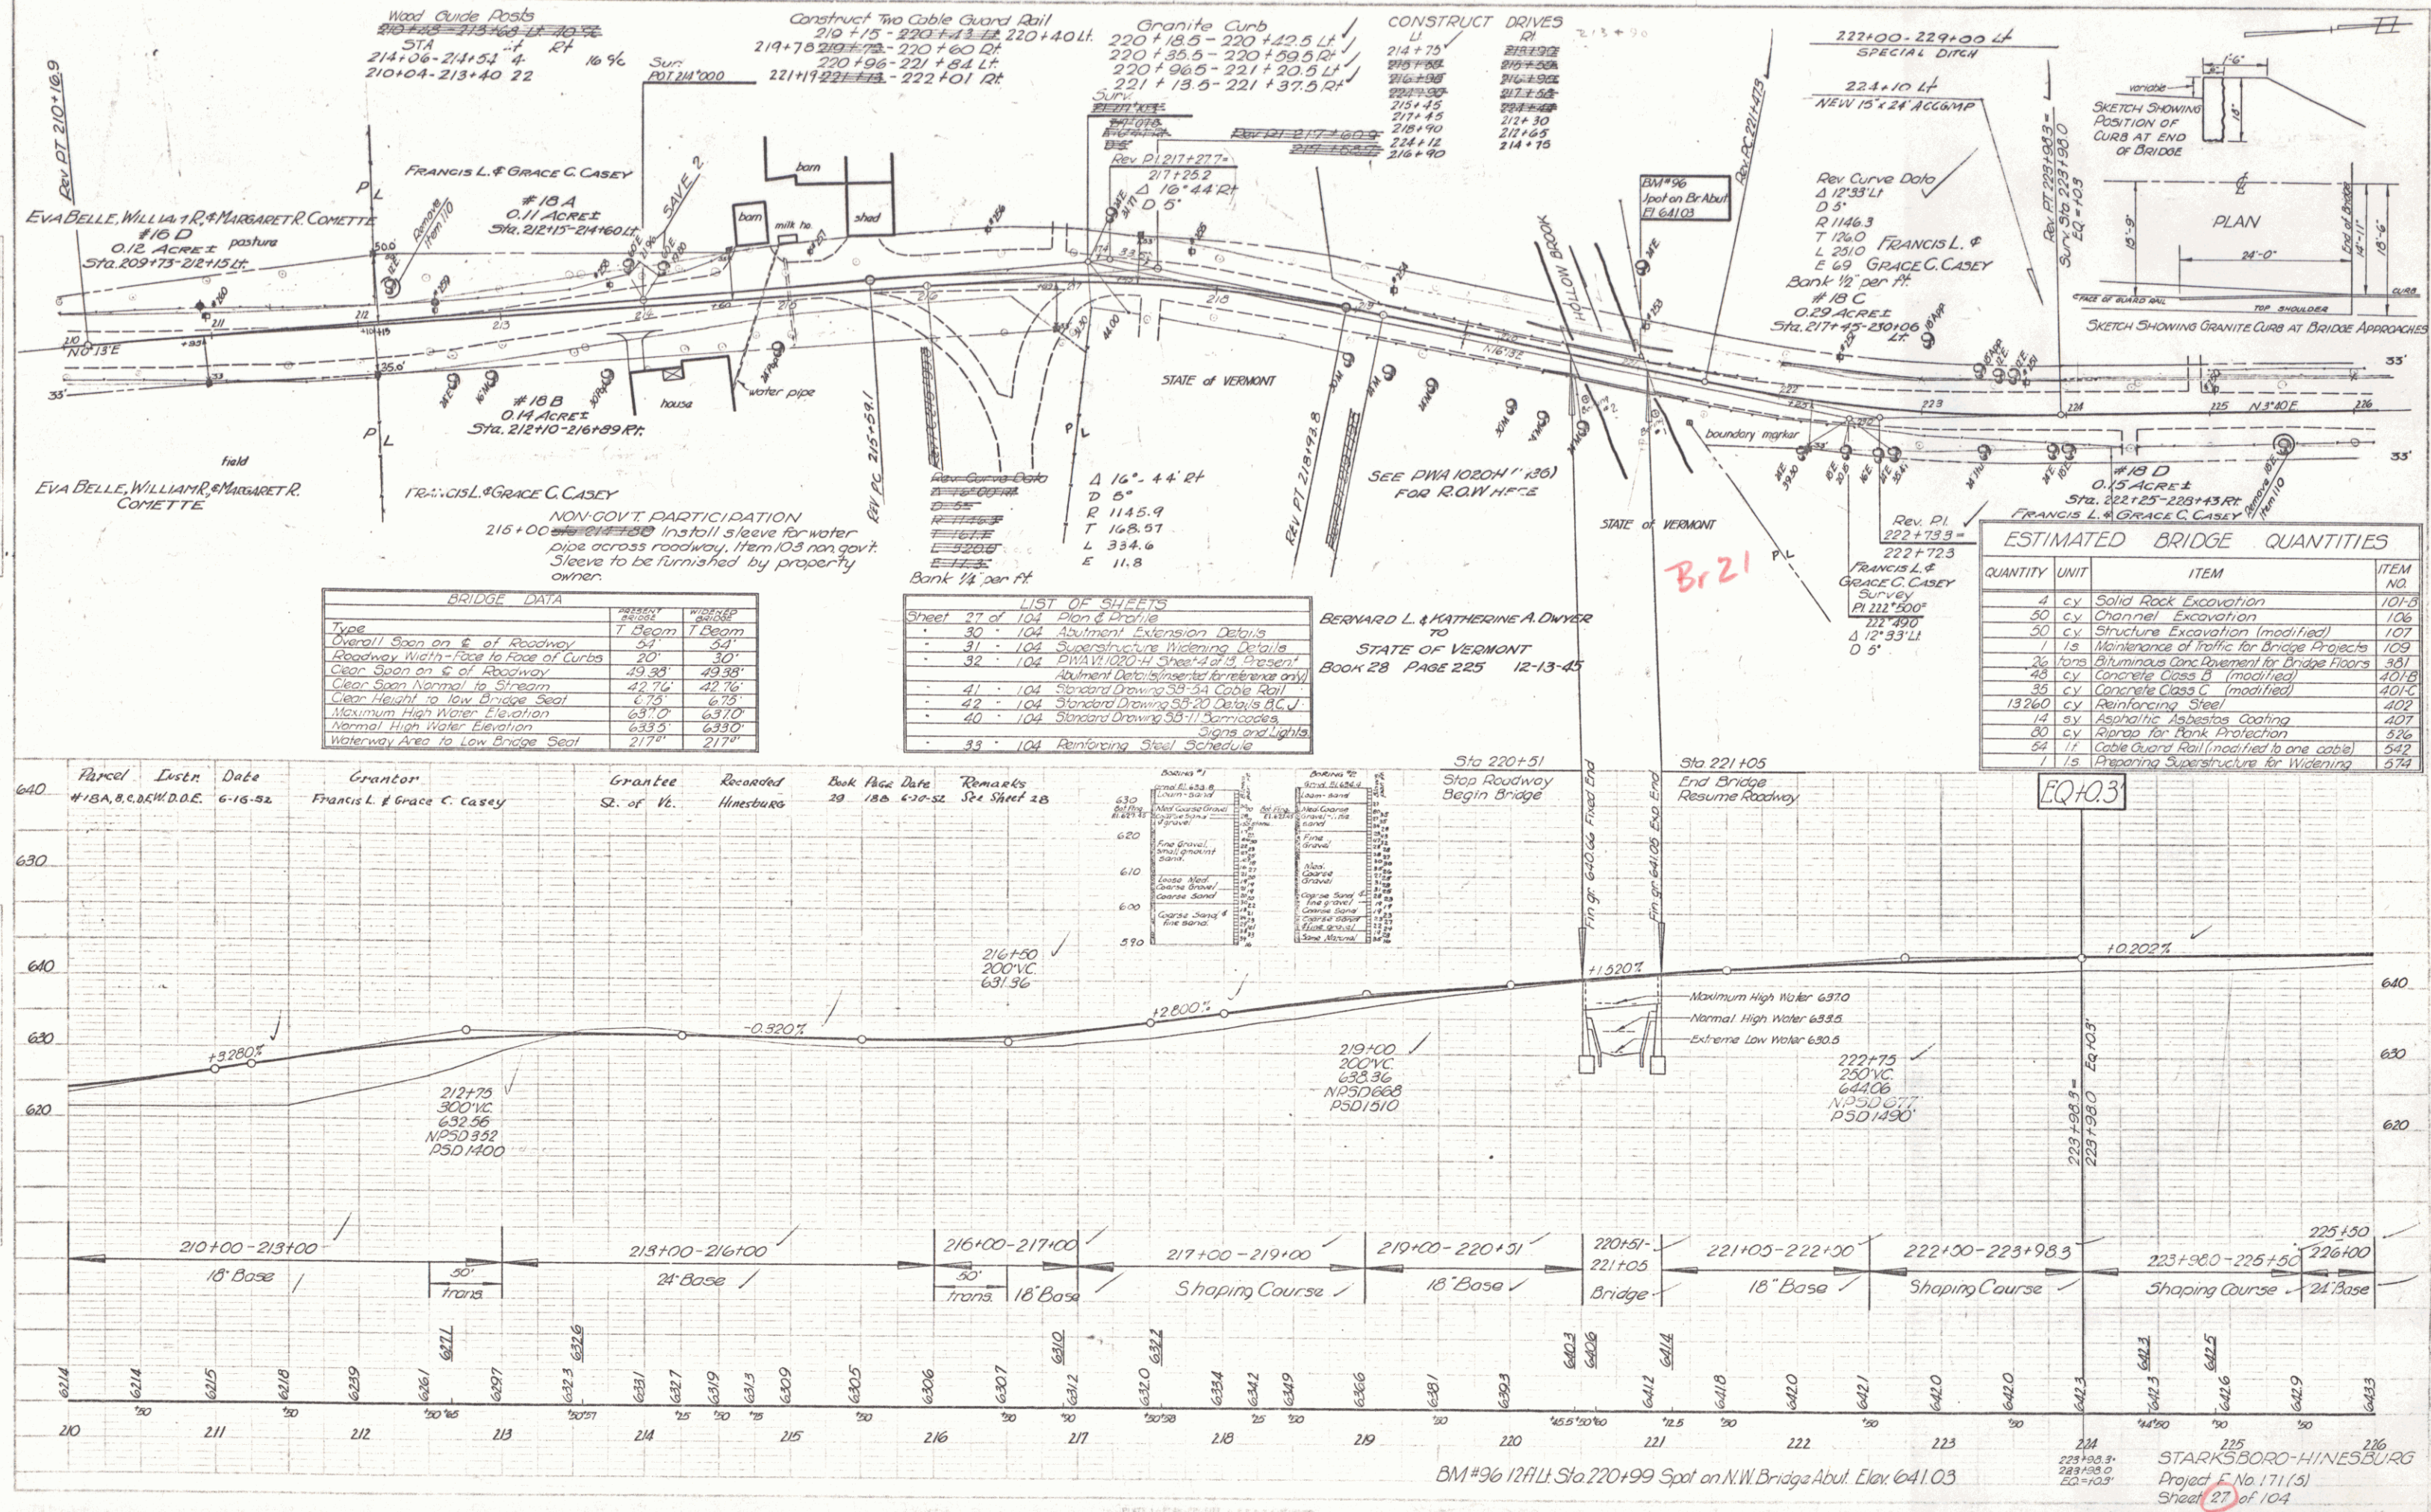

PLAN
 1/2" = 100'
 1/4" = 100'
 1/8" = 100'

PROF. LE
 1/2" = 10'
 1/4" = 10'

