


STATE OF VERMONT
STATE HIGHWAY DEPARTMENT
—•—
PLAN AND PROFILE OF PROPOSED
STATE HIGHWAY
NATIONAL RECOVERY SECONDARY PROJECT

FROM ITS INTERSECTION WITH THE BURLINGTON
- MONTPELIER ROAD SOUTHERLY 6592 MILES TO
THE HOUSE OF FRANK MAXWELL
LENGTH OF PROJECT = 34808.0 FT.
= 6.592 MILES

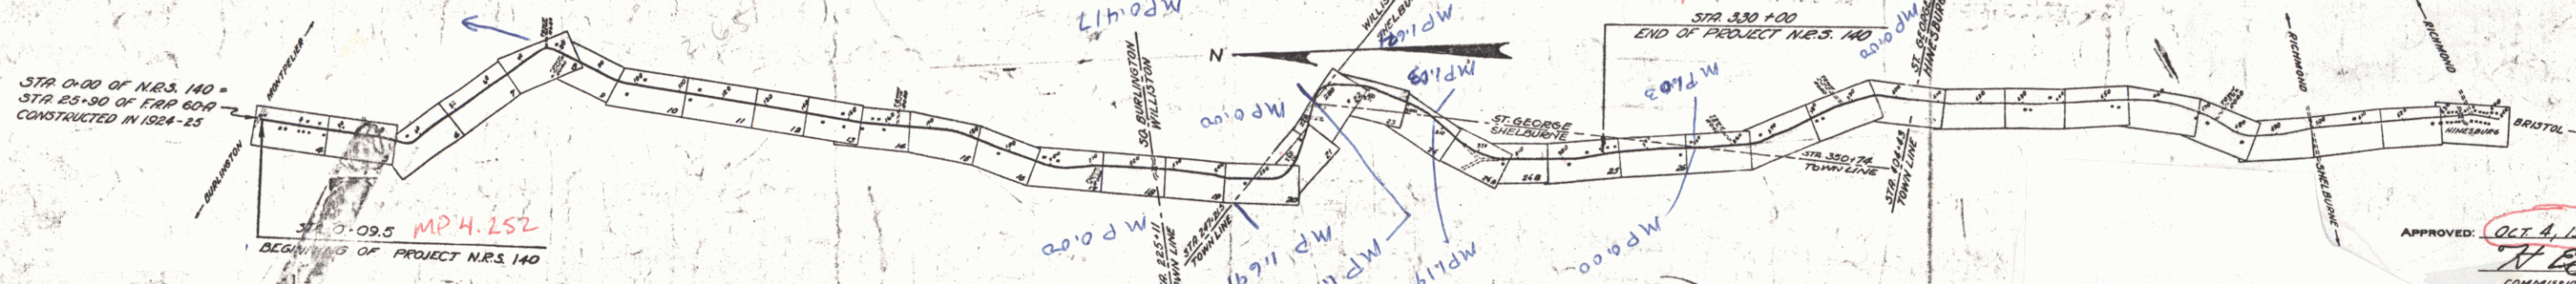

Pin# 00R502
Route VT116

GROUND ELEVATION.....	DATUM	LINE
GRADE ELEVATION.....	DATUM	LINE

CURVE DATA	
DEFLECTION ANGLE.....	Δ
DEGREE OF CURVE.....	D
RADIUS OF CURVE.....	R
TANGENT DISTANCE.....	T
LENGTH OF CURVE.....	L
EXTERNAL DISTANCE.....	E
POINT OF INTERSECTION.....	P. I.
POINT OF CURVE.....	P. C.
POINT OF TANGENT.....	P. T.
POINT ON TANGENT.....	P. O. T.

SCALES	
TITLE	1" = 2000'
PLAN	1" = 50'
PROFILE HOR.	1" = 50'
VERT.	1" = 10'
CROSS SECTIONS	1" = 5'

- Note -

These plans are subject to such revisions as may be required by the Bureau of Public Roads or the Commissioner of Highways.

Contractors shall conform to the plans in accordance with the standard road and bridge specifications of 1930 with all subsequent approved revisions and such specifications and special provisions as are submitted with the plans.

Attention of contractors is called to the fact that the State Highway Board reserves the right to reject or agree to such revisions. Same contract price, same cost of extension not to exceed 25% of the amount of contract.



RECOMMENDED [REDACTED]
[REDACTED]
DISTRICT ENGINEER BUREAU OF PUBLIC ROADS

RECOMMENDED FOR APPROVAL [REDACTED]
[REDACTED]
CHIEF ENGINEER BUREAU OF PUBLIC ROADS

APPROVED [REDACTED]
[REDACTED]
DIRECTOR - BUREAU OF PUBLIC ROADS

CORRECT: OCT. 4, 1932
A. J. Rumsala
ROAD ENGINEER

SERIES NRS. NO. 140 FILED
SHEET 1 OF 29

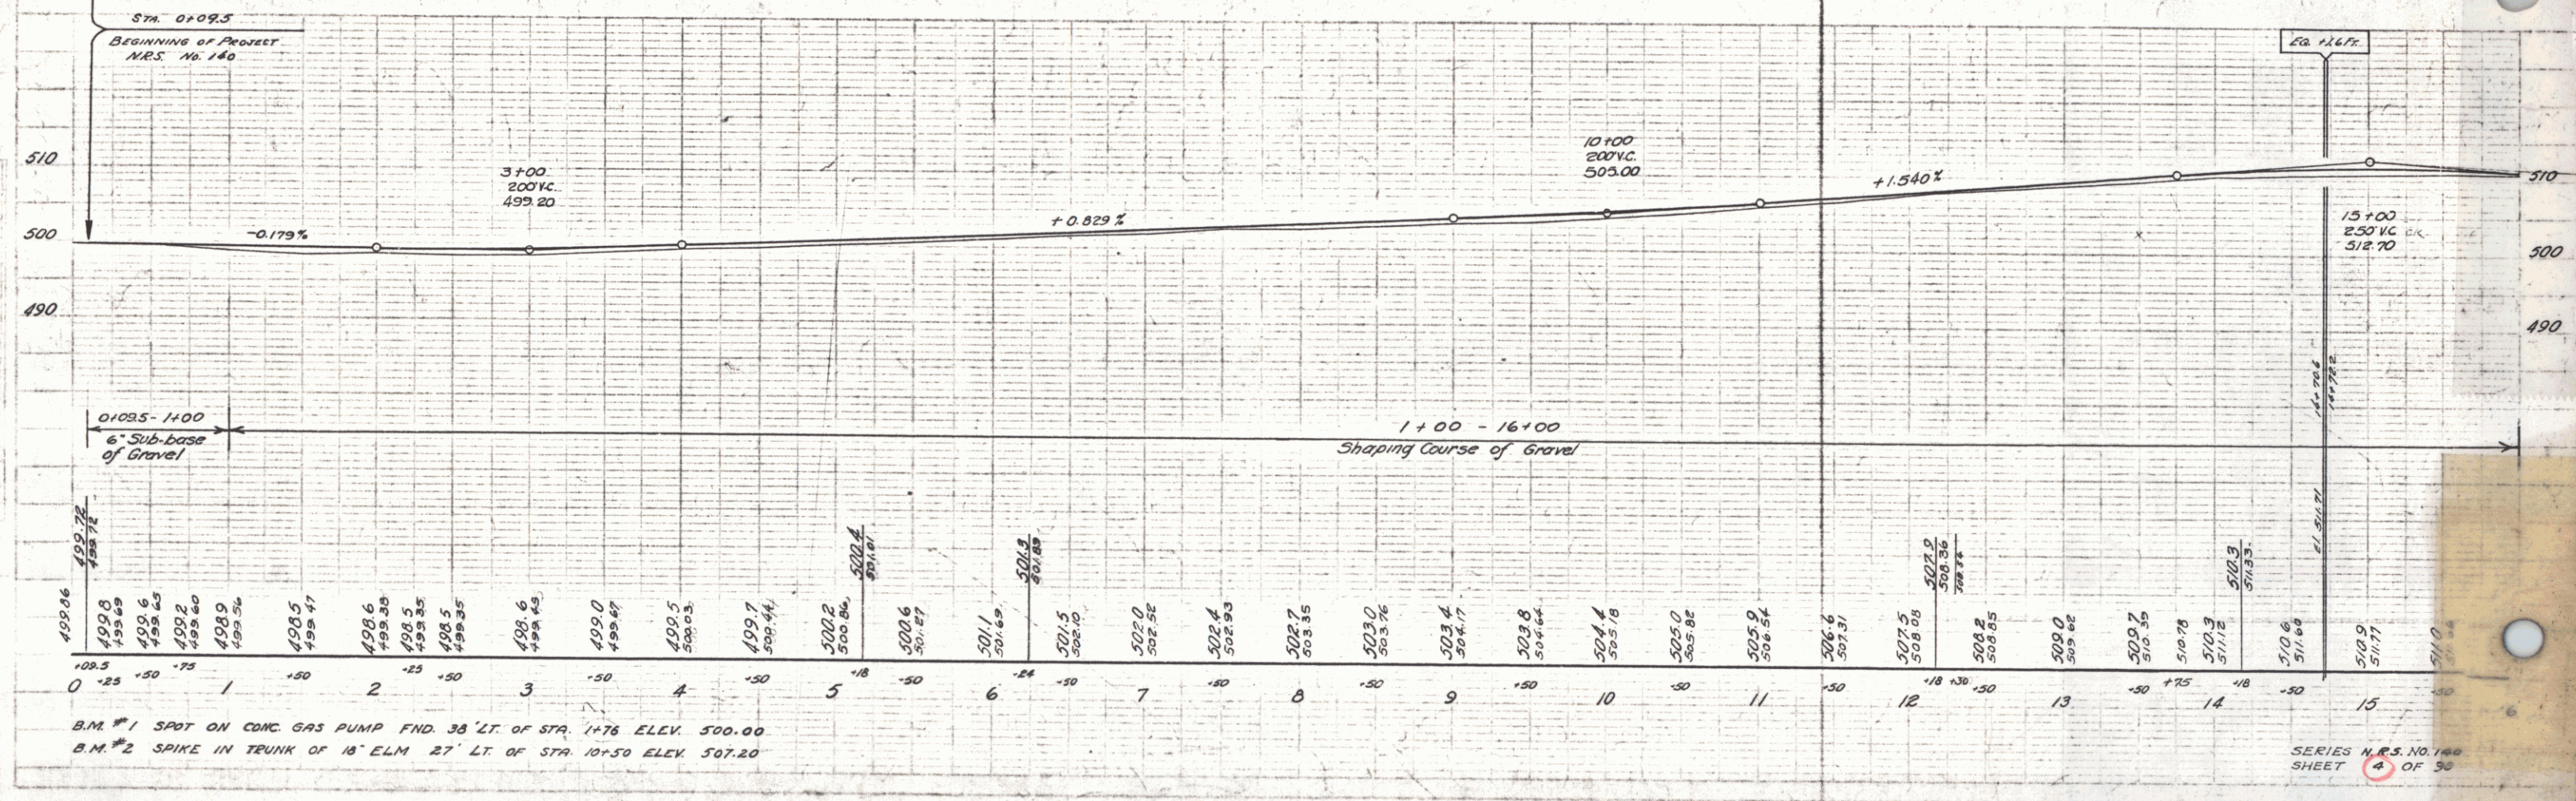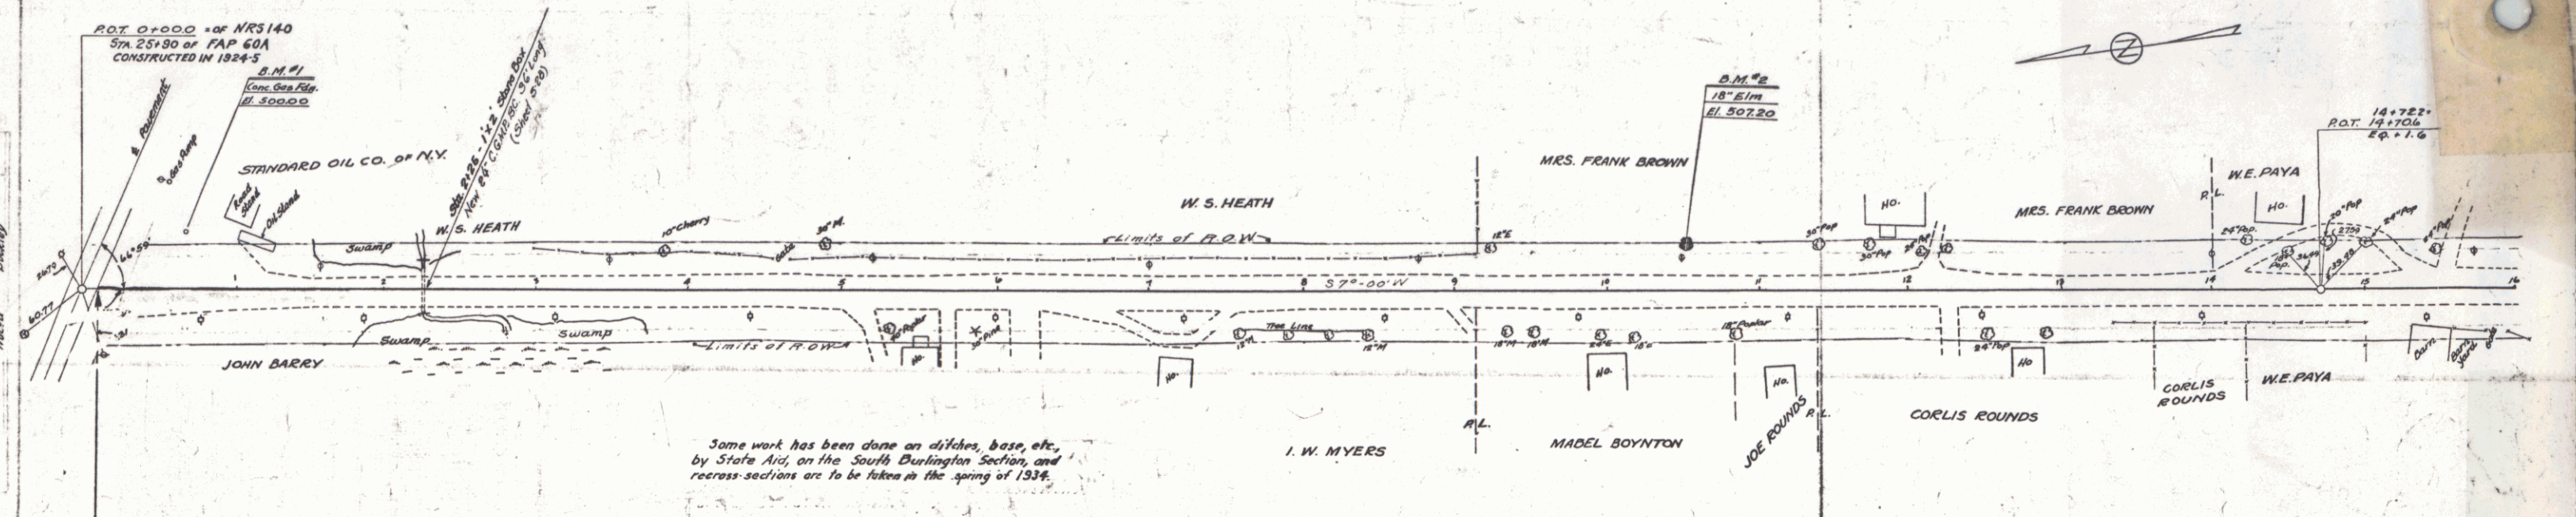




B.M. #1 SPOT ON CONC. GAS PUMP FND. 38' LT. OF STA. 1+76 ELEV. 500.00
 B.M. #2 SPIKE IN TRUNK OF 18' ELM. 27' LT. OF STA. 10+50 ELEV. 507.20

PLAN
 1/4" = 100'
 1/8" = 200'
 1/16" = 400'
 1/32" = 800'
 1/1099511629376" = 27487790734400'
 1/2199023258752" = 54975581468800'
 1/4398046517504" = 109951162937600'
 1/8796093035008" = 219902325875200'
 1/11972621430437213892276635478936570393527931818606592" = 299315535760930347306915886973414259838198295465164800'
 1/23945242860874427784553270957873140787055863637213184" = 598631071521860694613831773946828519676396590930329600'
 1/47890485721748855569106541915746281574111727274426368" = 1197262143043721389227663547893657039352793181860659200'
 1/95780971443497711138213083831492563148223454548852736" = 2394524286087442778455327095787314078705586363721318400'
 1/191561942886995422276426167662985126296446909097705472" = 4789048572174885556910654191574628157411172727442636800'
 1/383123885773990844552852335325970252592893818195410944" = 9578097144349771113821308383149256314822345454885273600'
 1/766247771547981689105704670651940505185787636390821888" = 19156194288699542227642616766298512629644690909770547200'
 1/1532495543095963378211409341303881010371575272781643776" = 38312388577399084455285233532597025259289381819541094400'
 1/3064991086191926756422818682607762020743150545563287552" = 766247771547

PLAN
 J.J. & MARY BARRY
 D.J. MILLHAM
 W.H. MURDOCK
 3.0' ± 6.0'

PROFILE
 P.D. WOOD
 P. MILLHAM
 48+00 - 64+00
 Shaping Course of Gravel


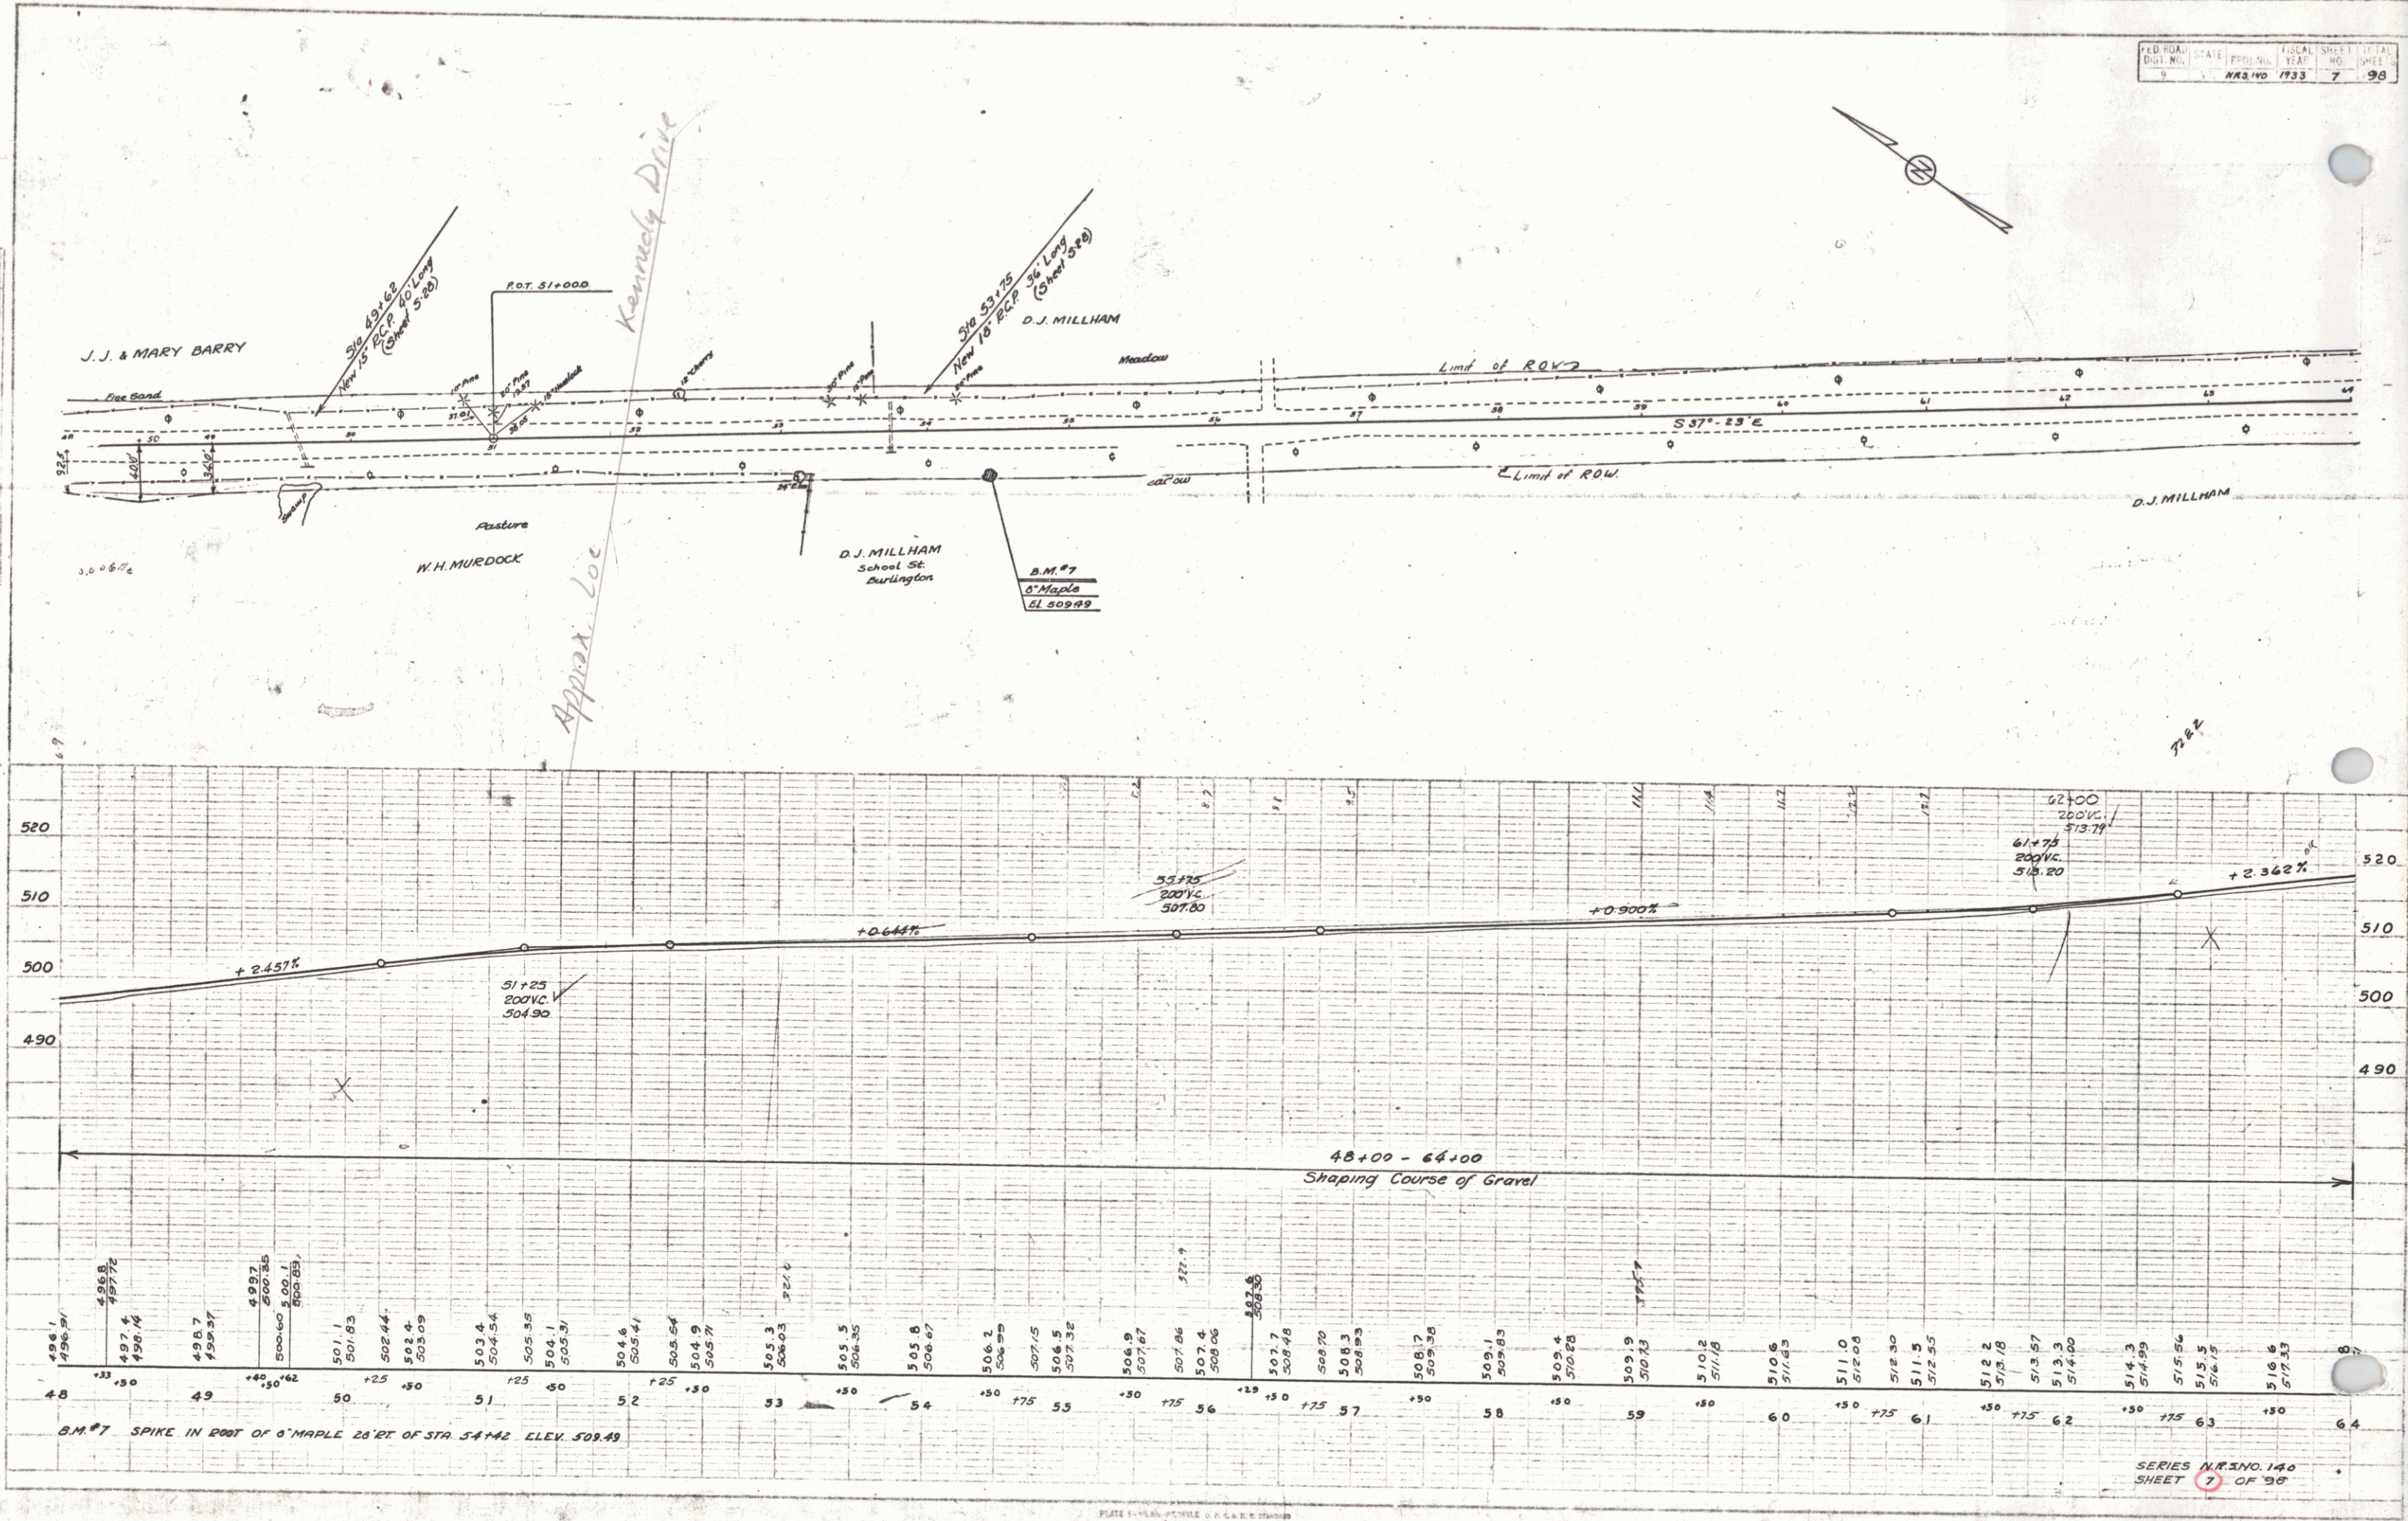


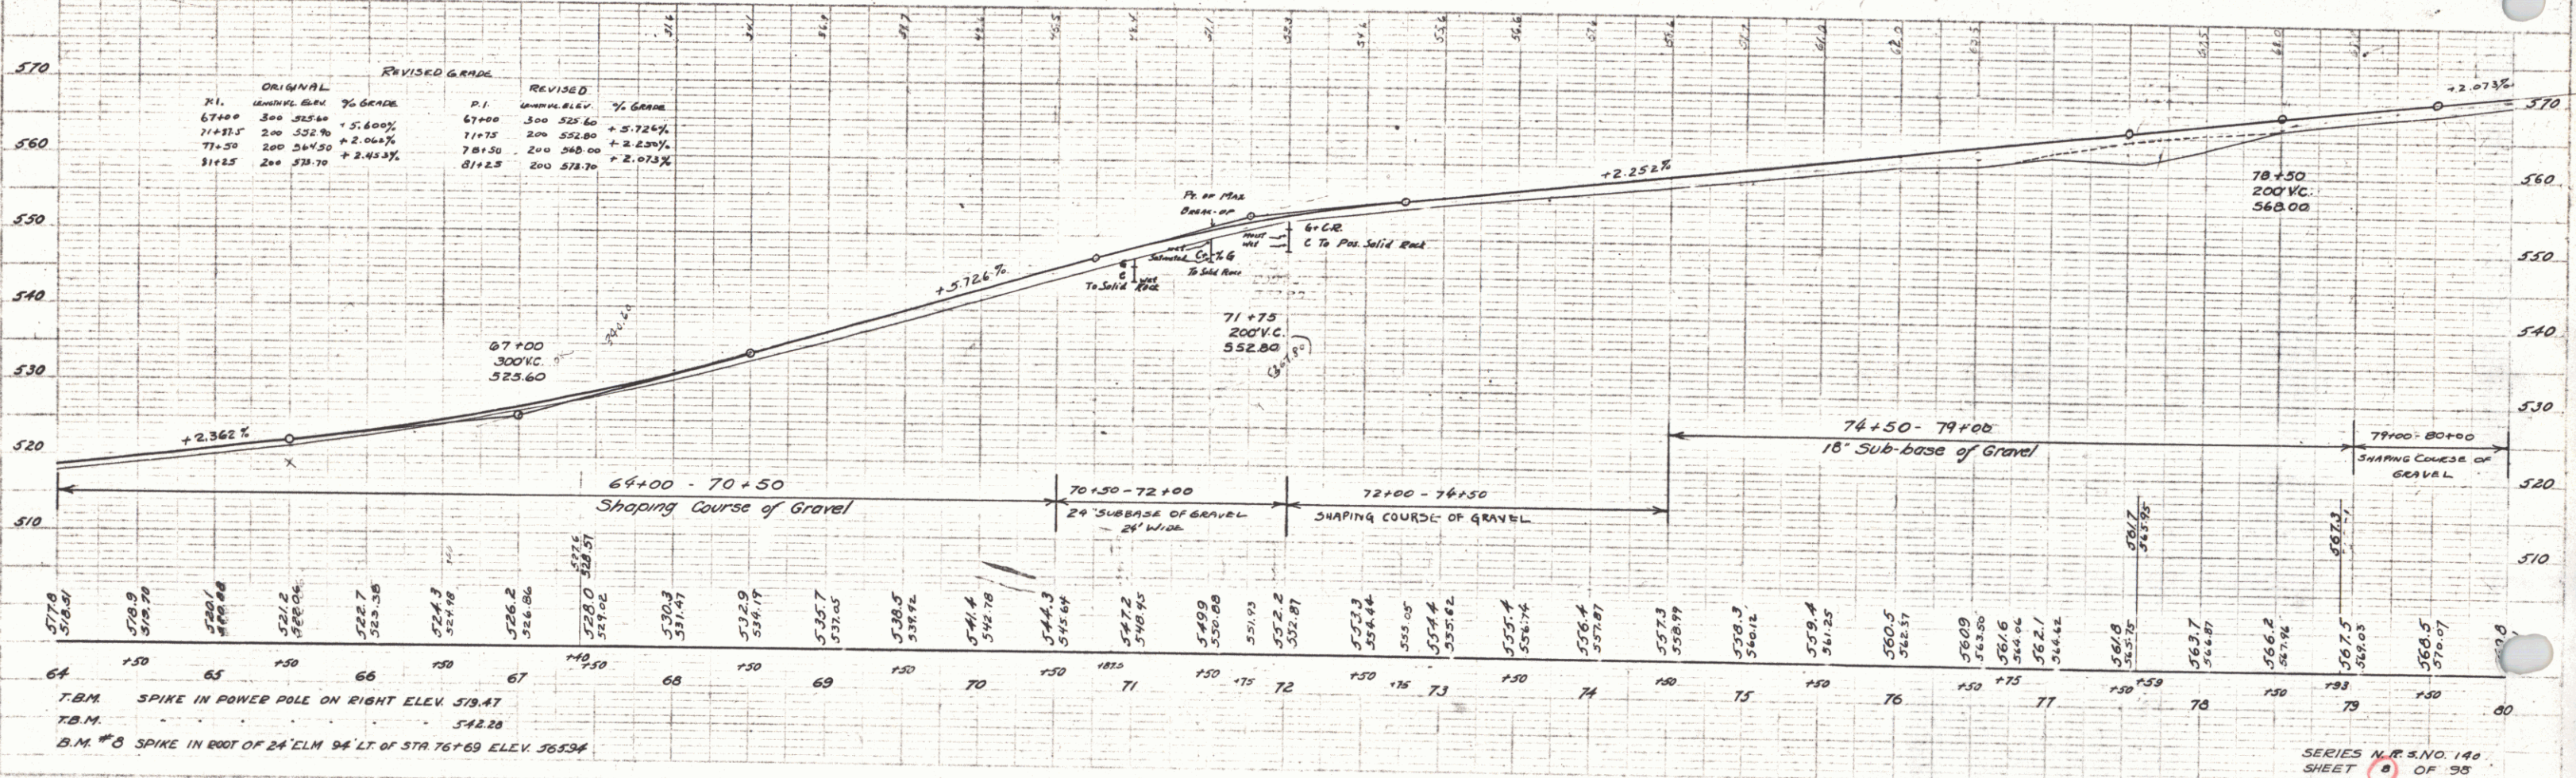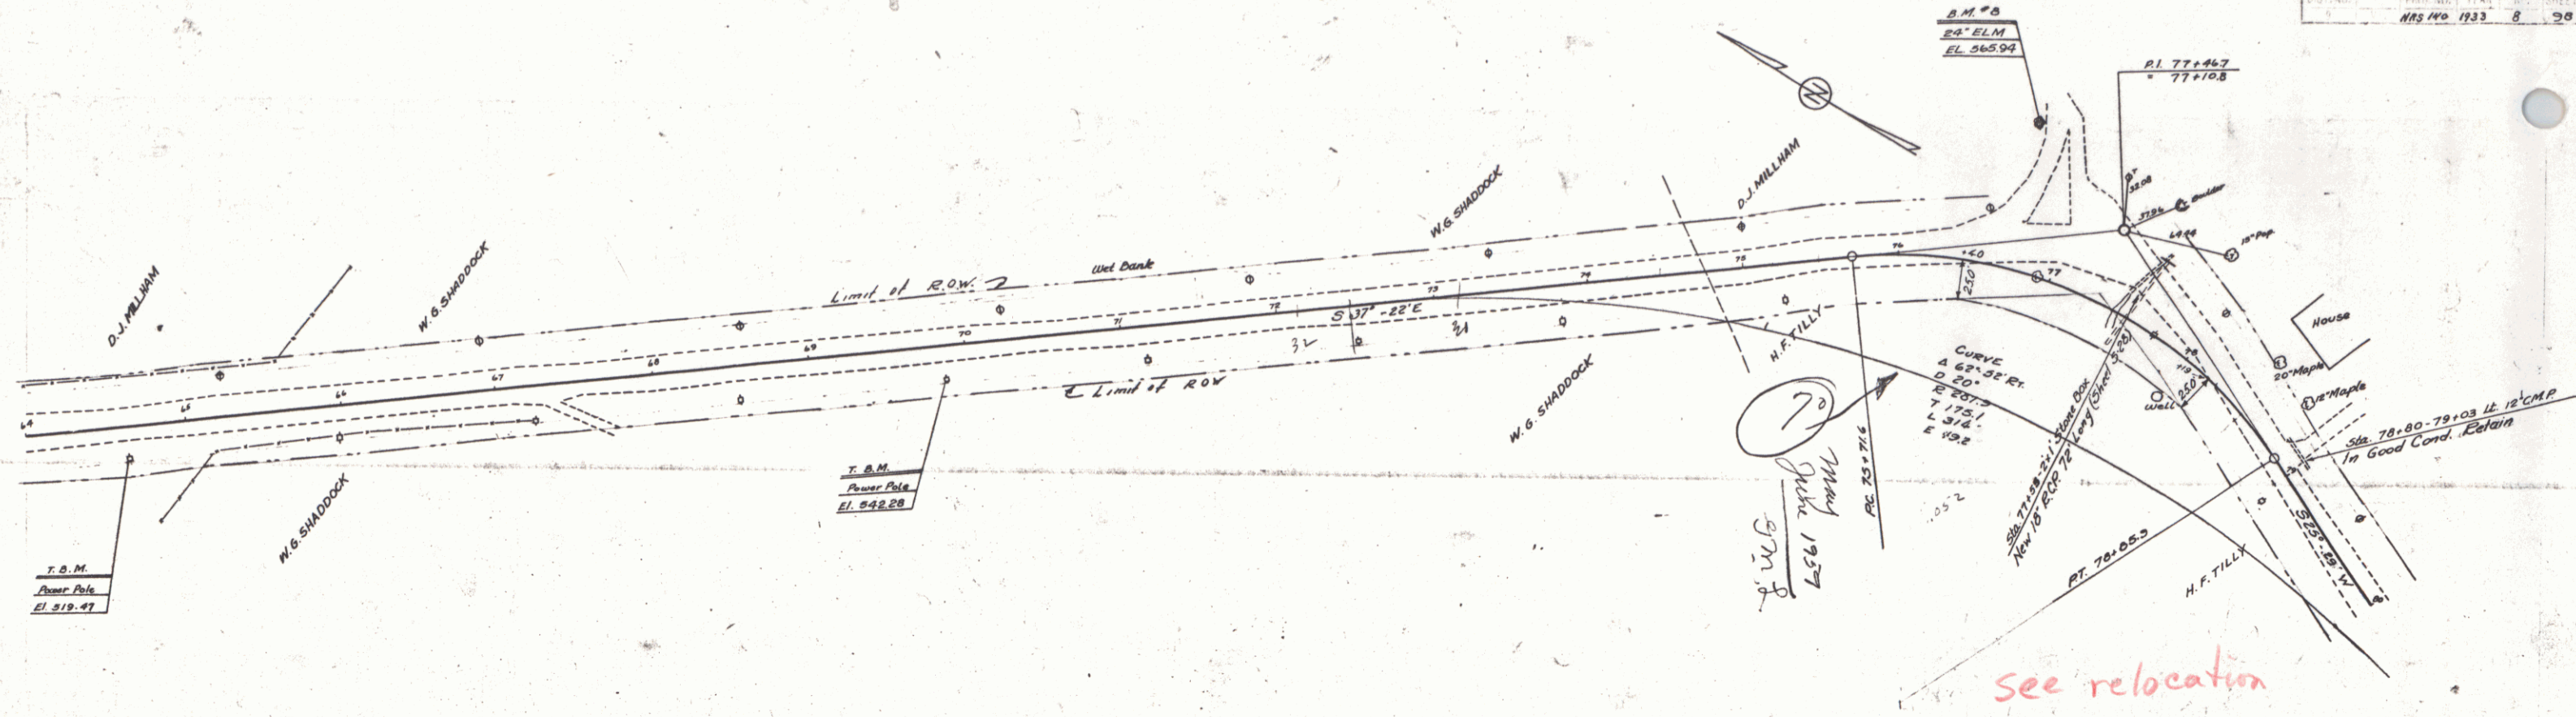

T.B.M. SPIKE IN POWER POLE ON RIGHT ELEV. 519.47
 T.B.M. 542.28
 B.M. #8 SPIKE IN ROOT OF 24' ELM 94' LT. OF STA 76+69 ELEV. 535.38

PLAN
 1" = 40' HORIZ.
 1" = 10' VERT.
 1" = 1" CURVE
 1" = 1" GRADE



SECTION
 1" = 10' HORIZ.
 1" = 1' VERT.
 1" = 1" CURVE
 1" = 1" GRADE

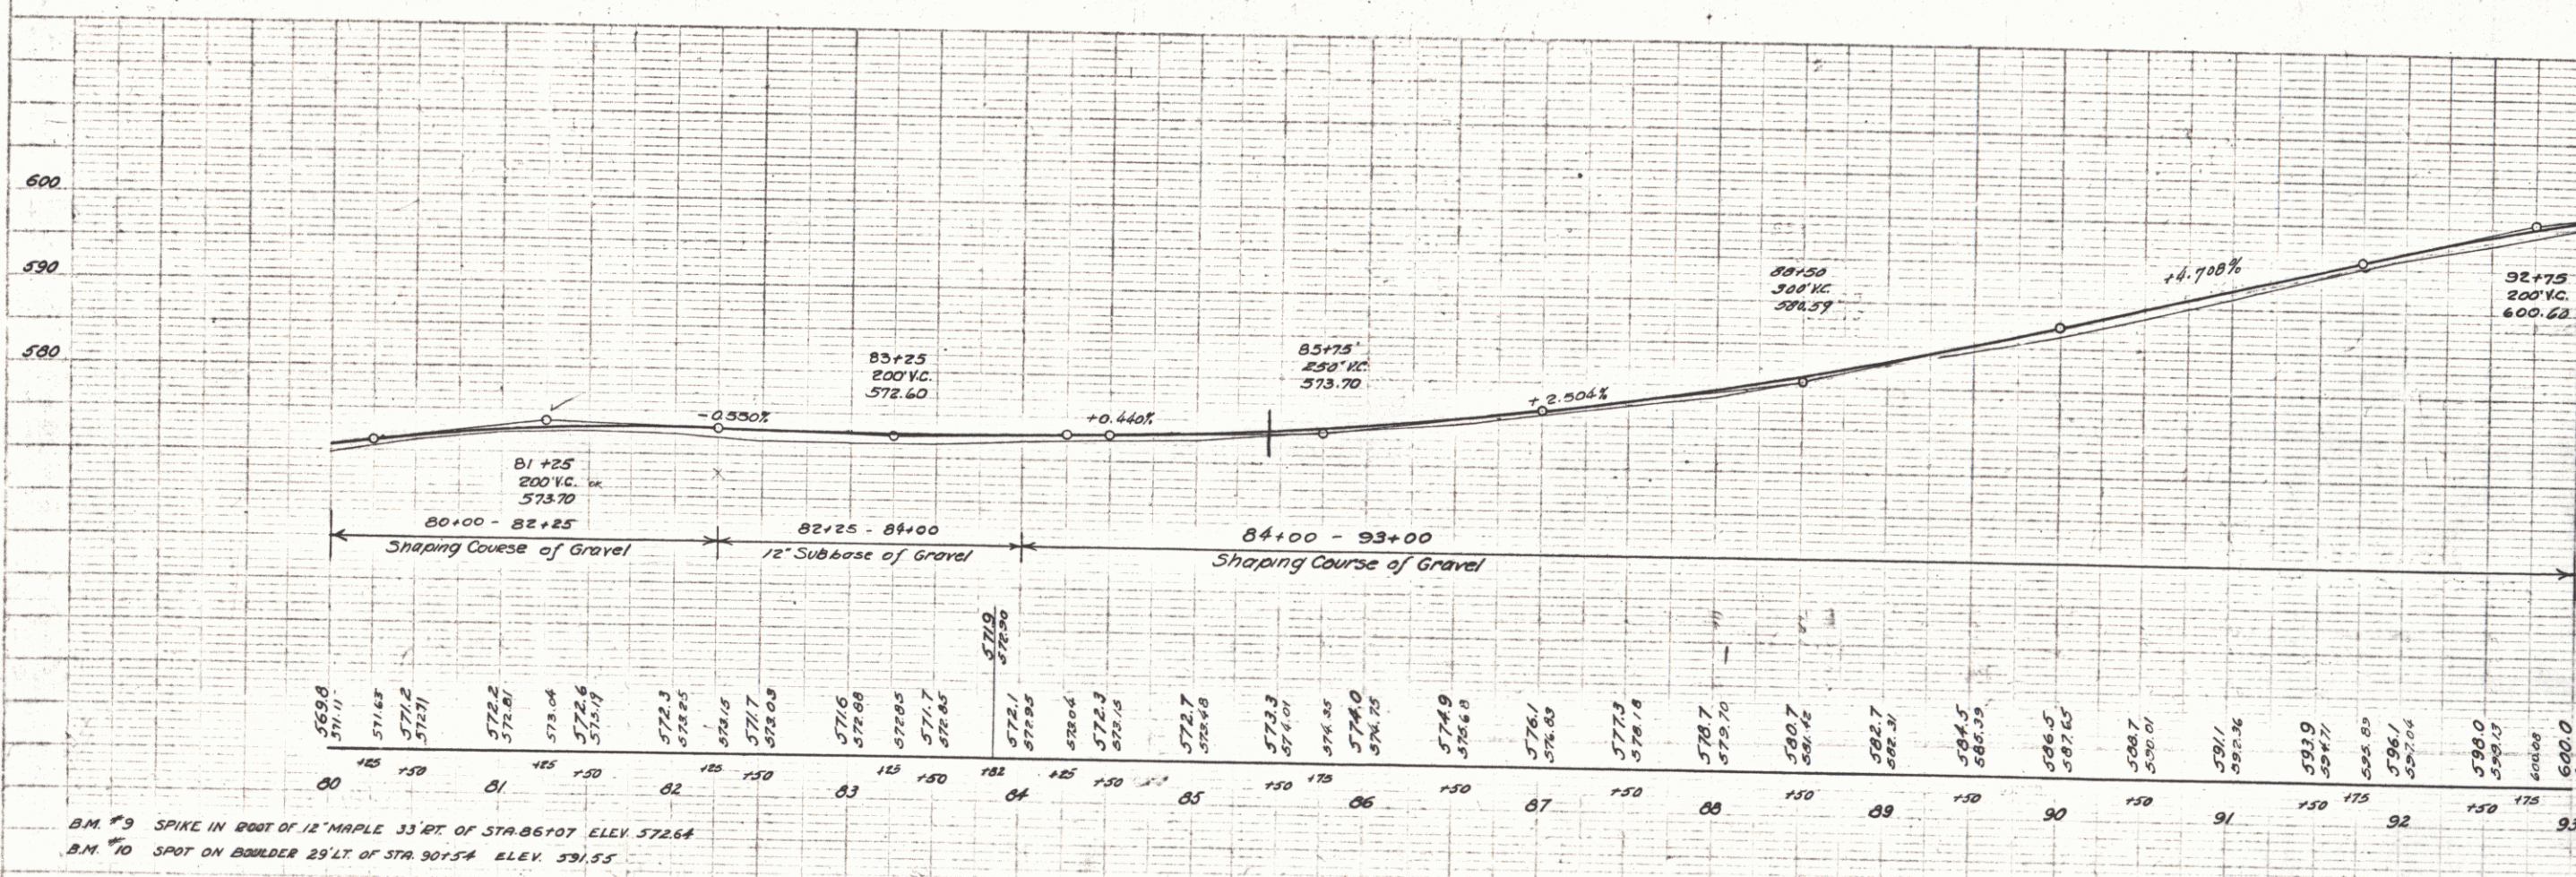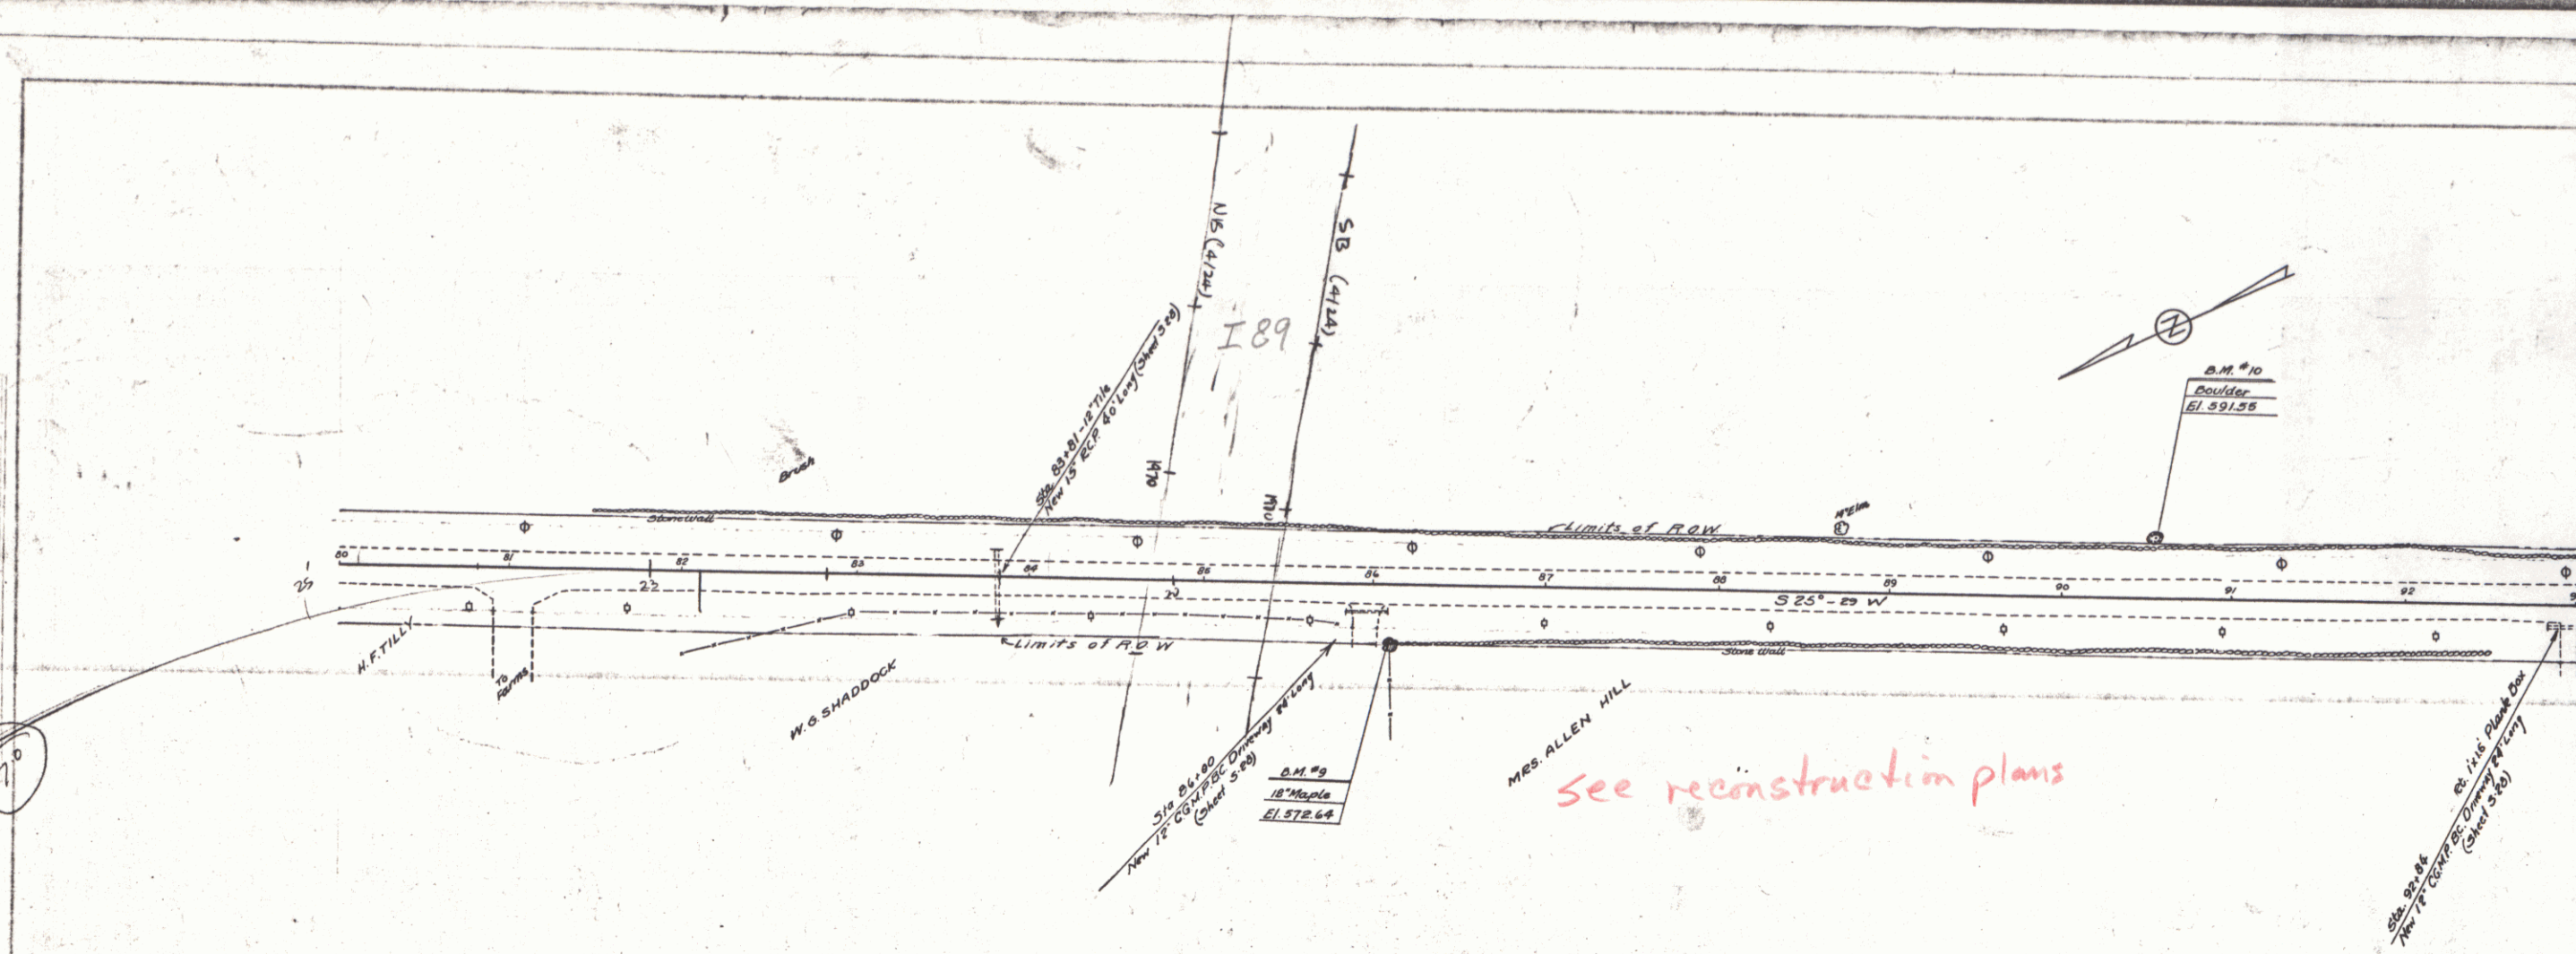



B.M. #9 SPIKE IN ROOT OF 12" MAPLE 33' RT. OF STA. 86+07 ELEV. 572.64
 B.M. #10 SPOT ON BOULDER 29' LT. OF STA. 90+54 ELEV. 591.55

PLAN
NOTE: SEE ADJUSTED C.E. NO. 103 170 1933 10 193

PROFILES
NOTE: SEE ADJUSTED C.E. NO. 103 170 1933 10 193

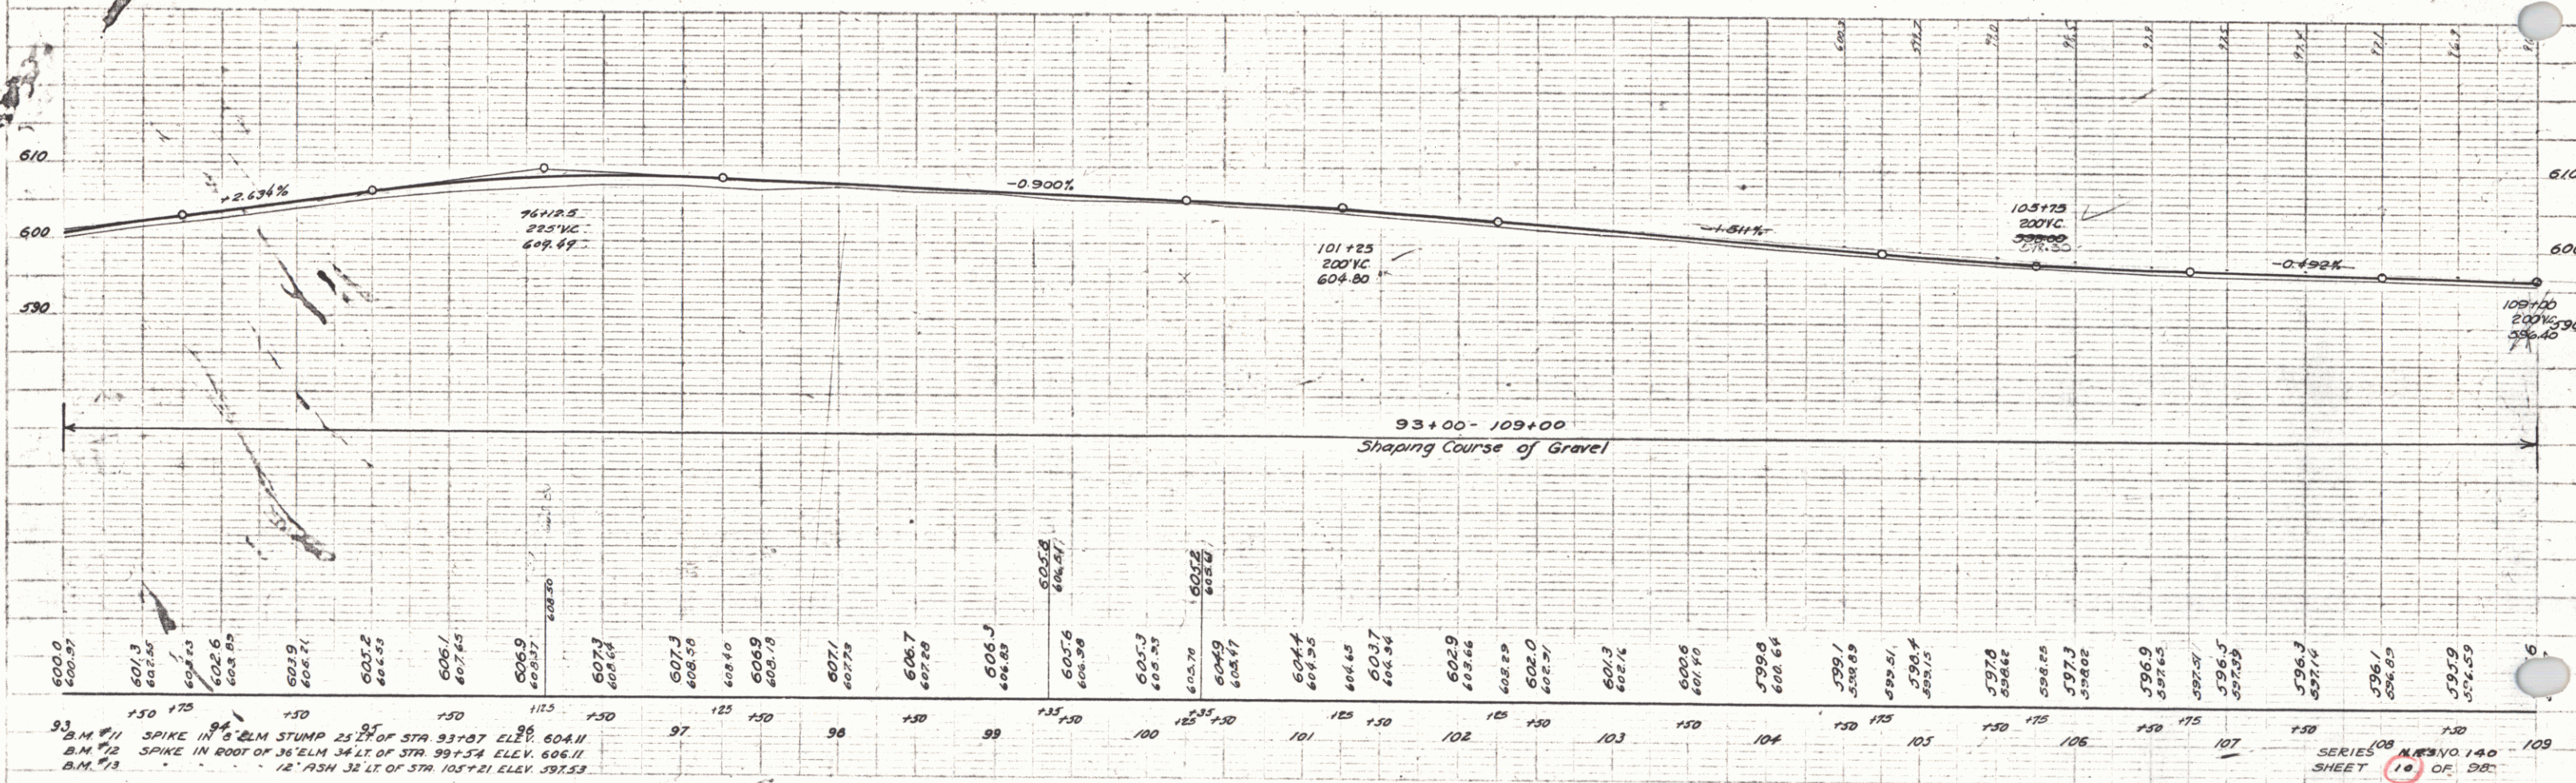
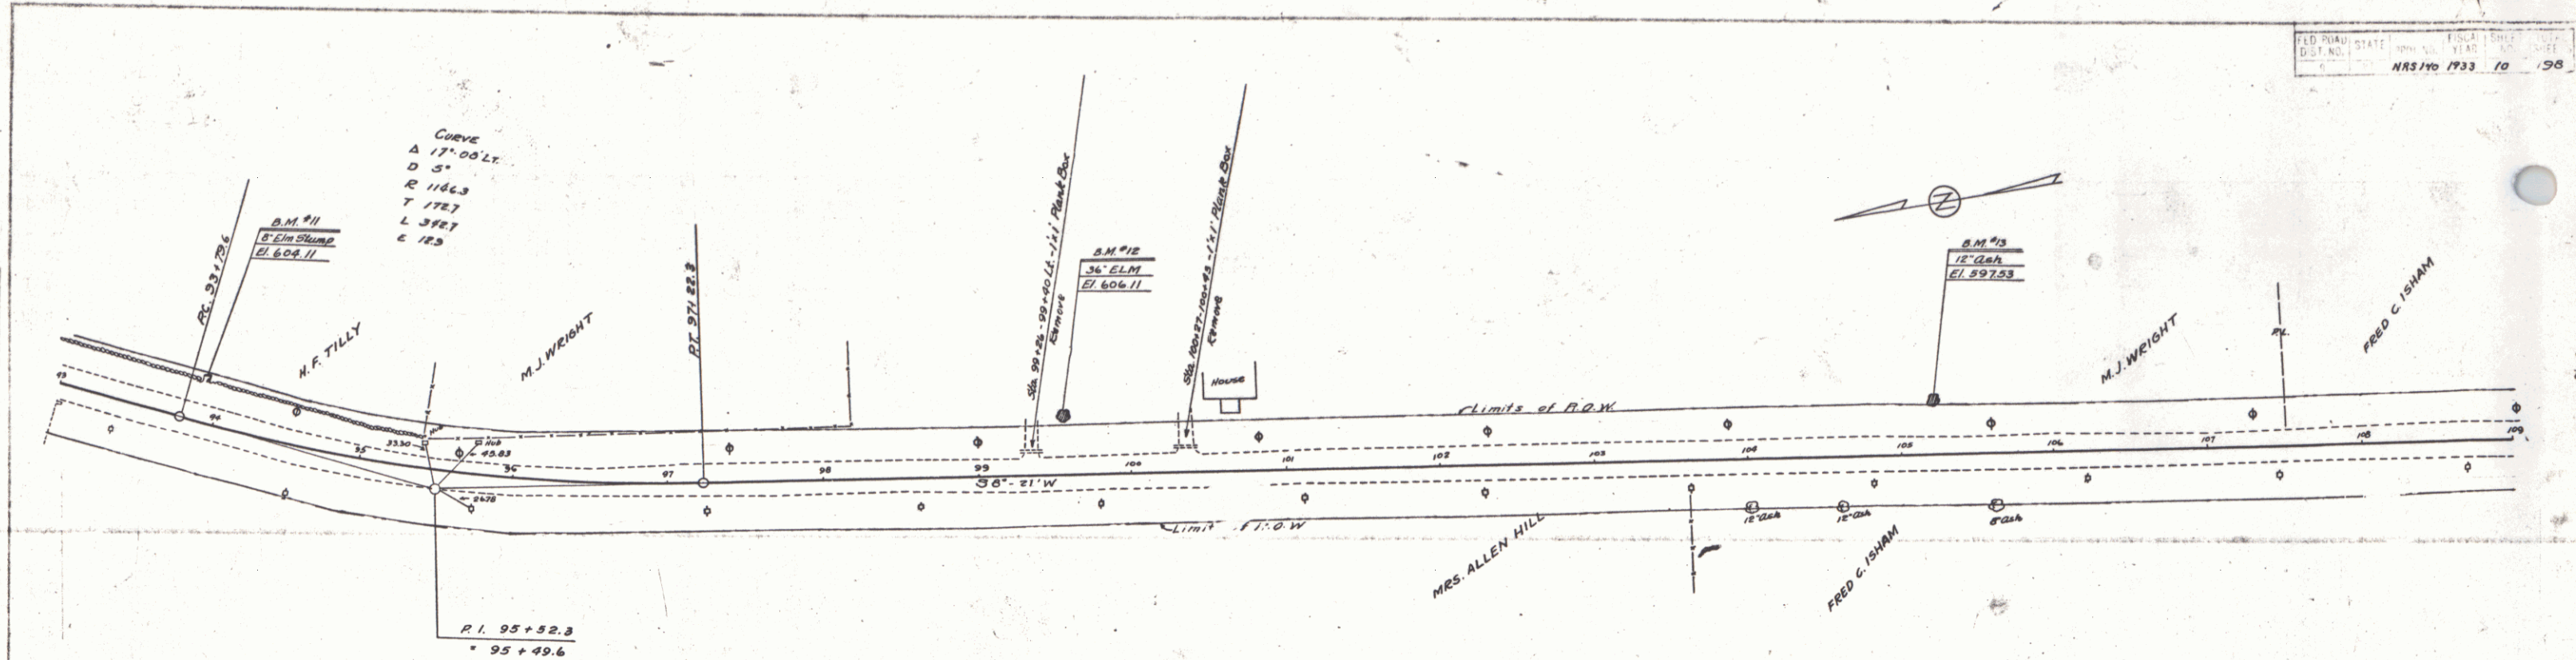


93 B.M. #11 SPIKE IN 6" ELM STUMP 25' LT. OF STA. 93+07 ELEV. 604.11
 B.M. #12 SPIKE IN ROOT OF 36" ELM 34' LT. OF STA. 99+54 ELEV. 606.11
 B.M. #13 12" ASH 32' LT. OF STA. 105+21 ELEV. 597.53

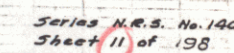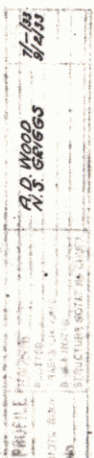

PLAN
NOTE BOOK
125+00-137+00



125+00-137+00

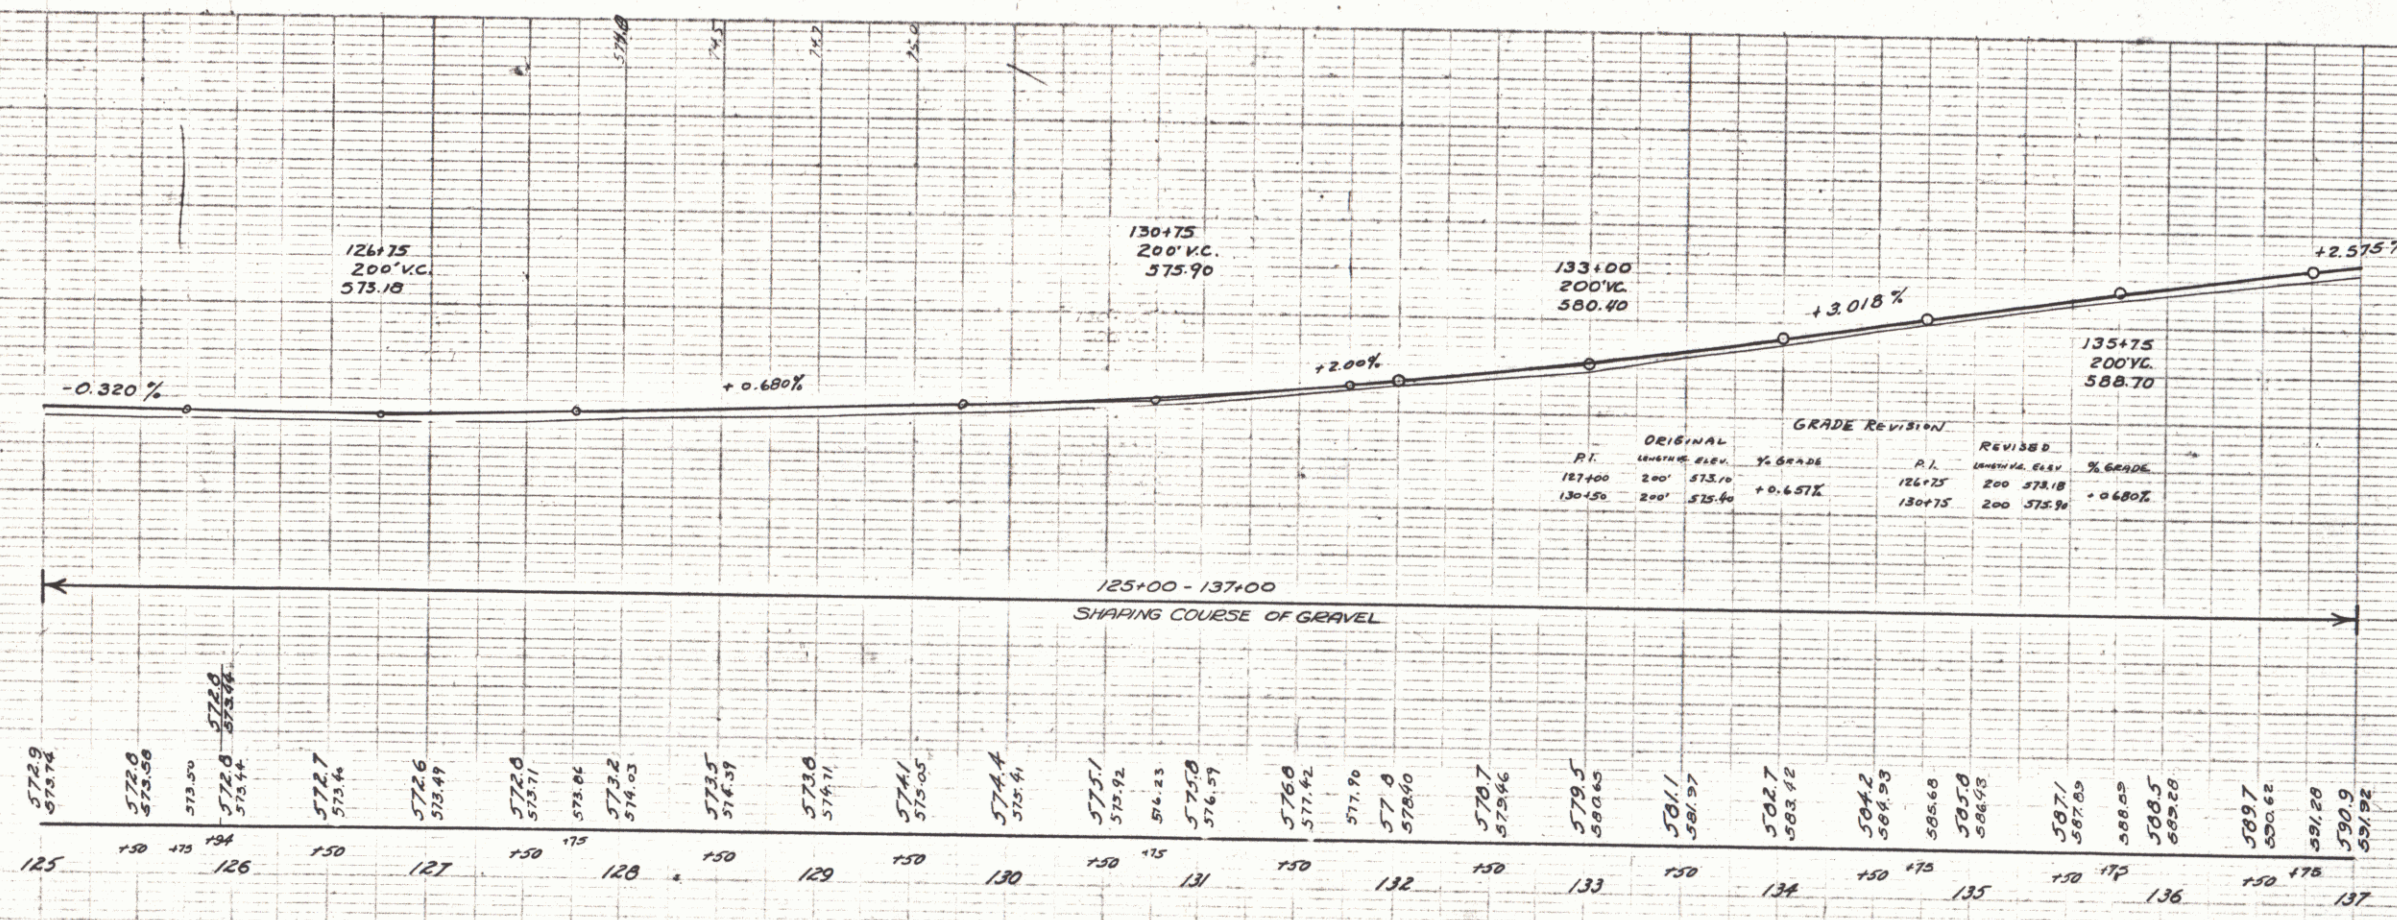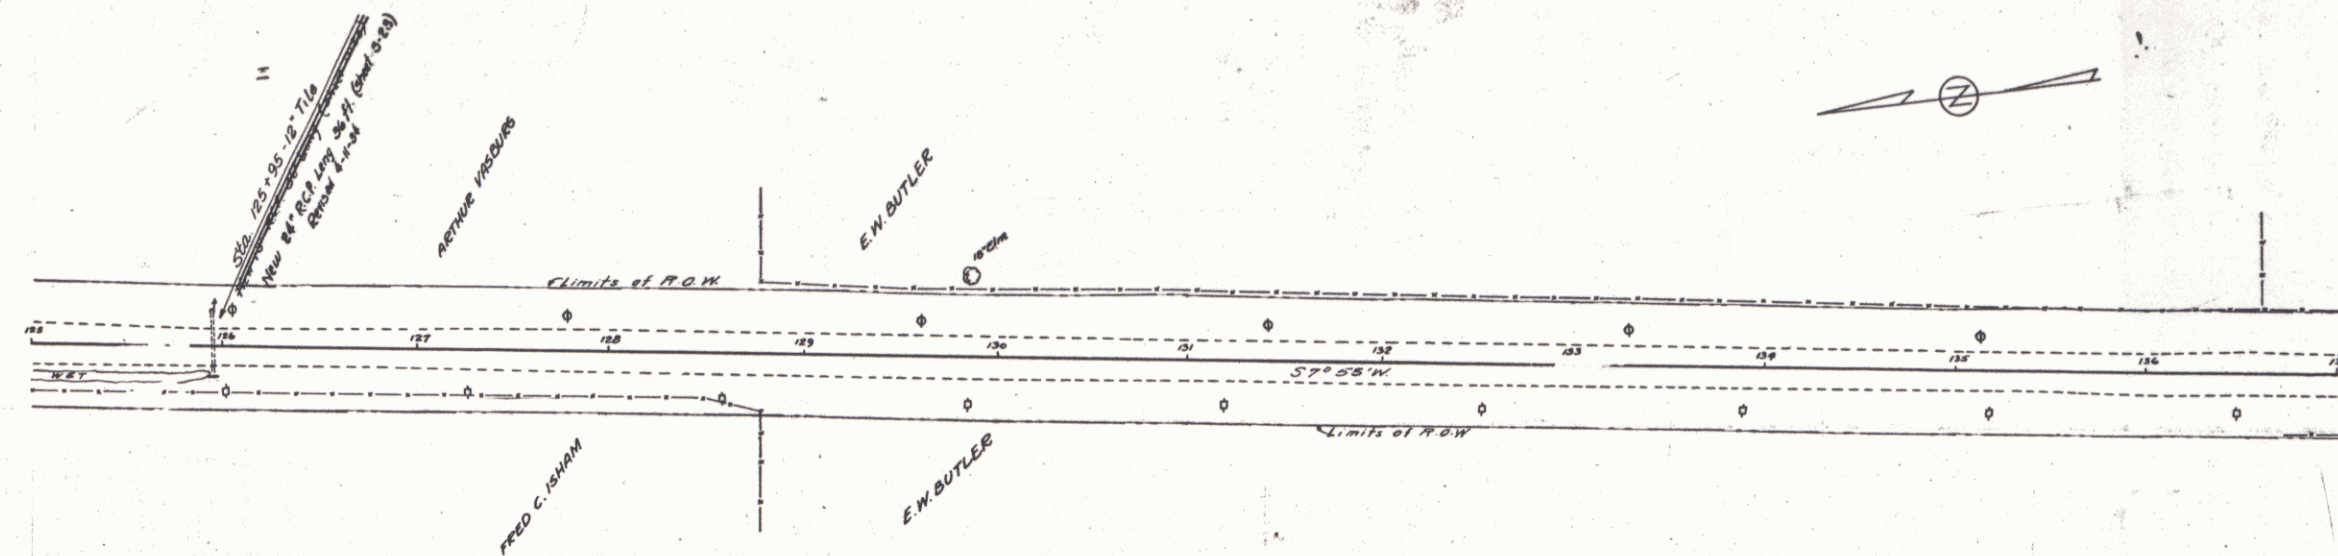

SERIES N.R.S. No. 140
SHEET 13 of 98

PLAN
 DRAWN BY
 CHECKED BY
 DATE


12.11.33
 13.6.66
 13.6.66

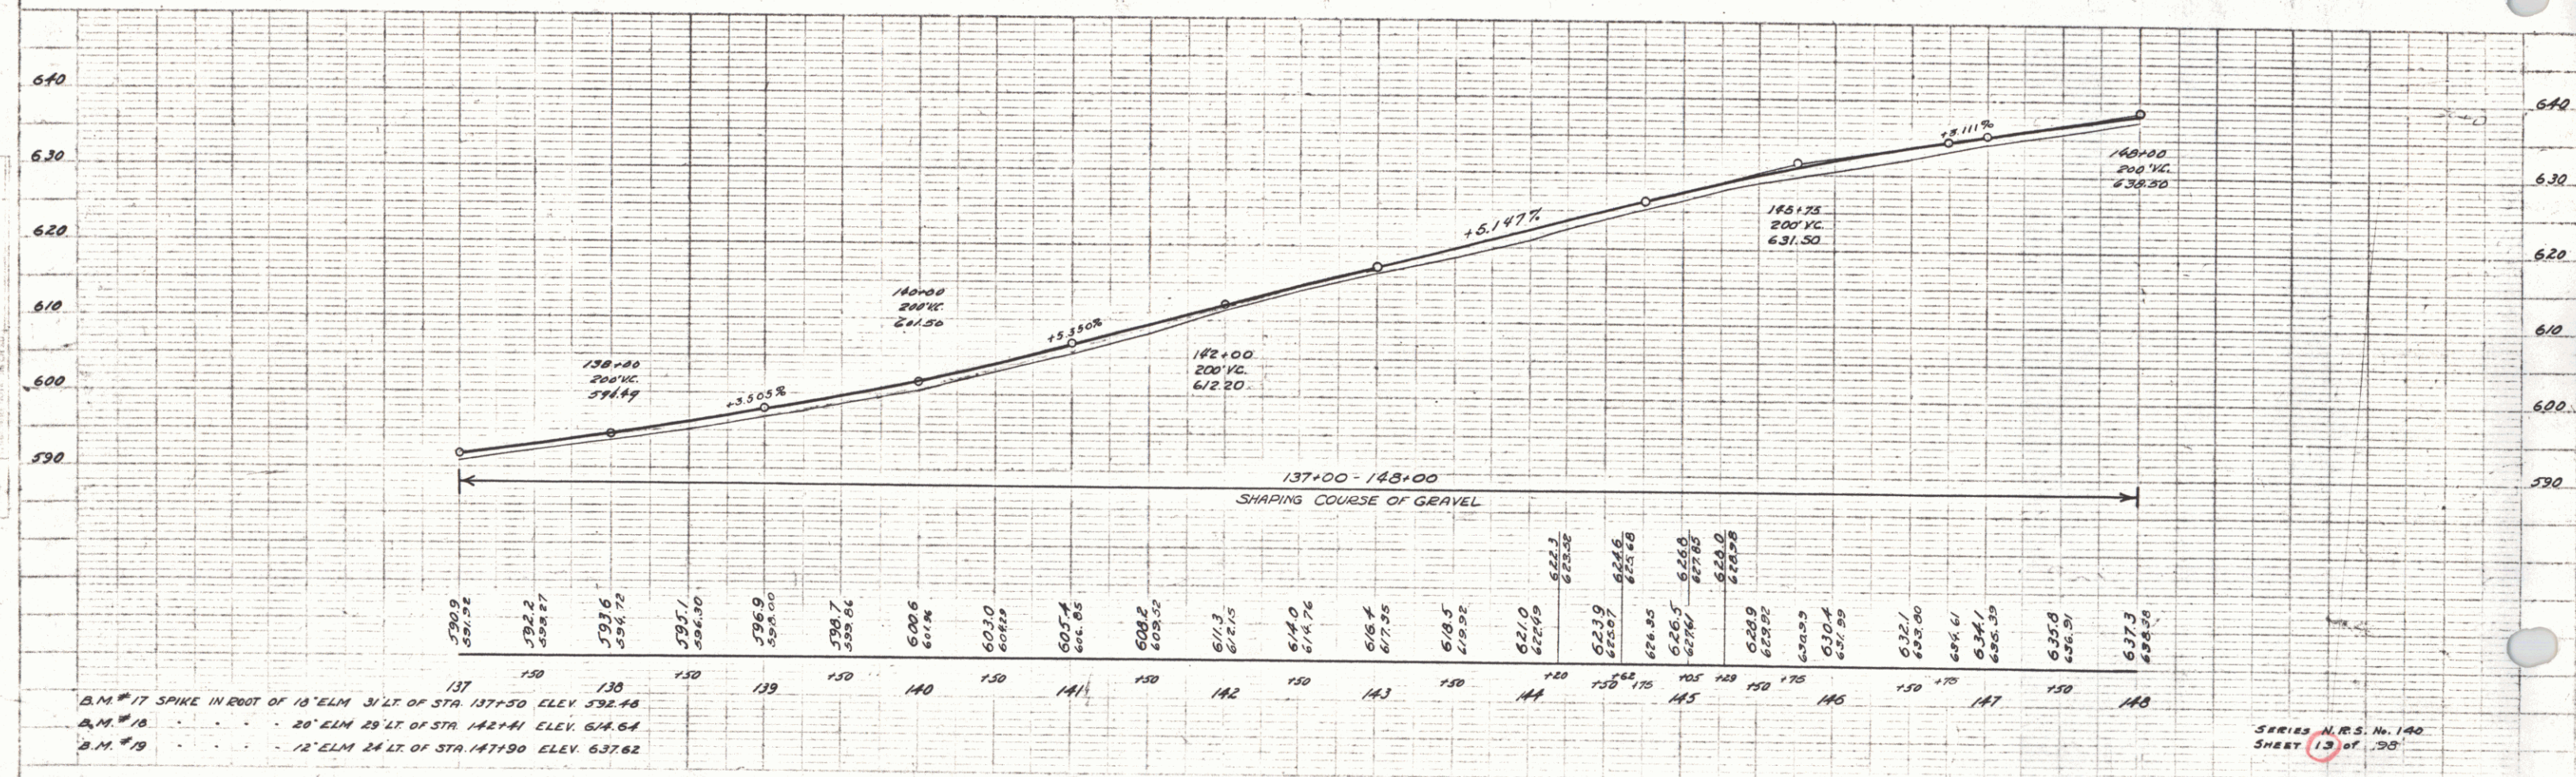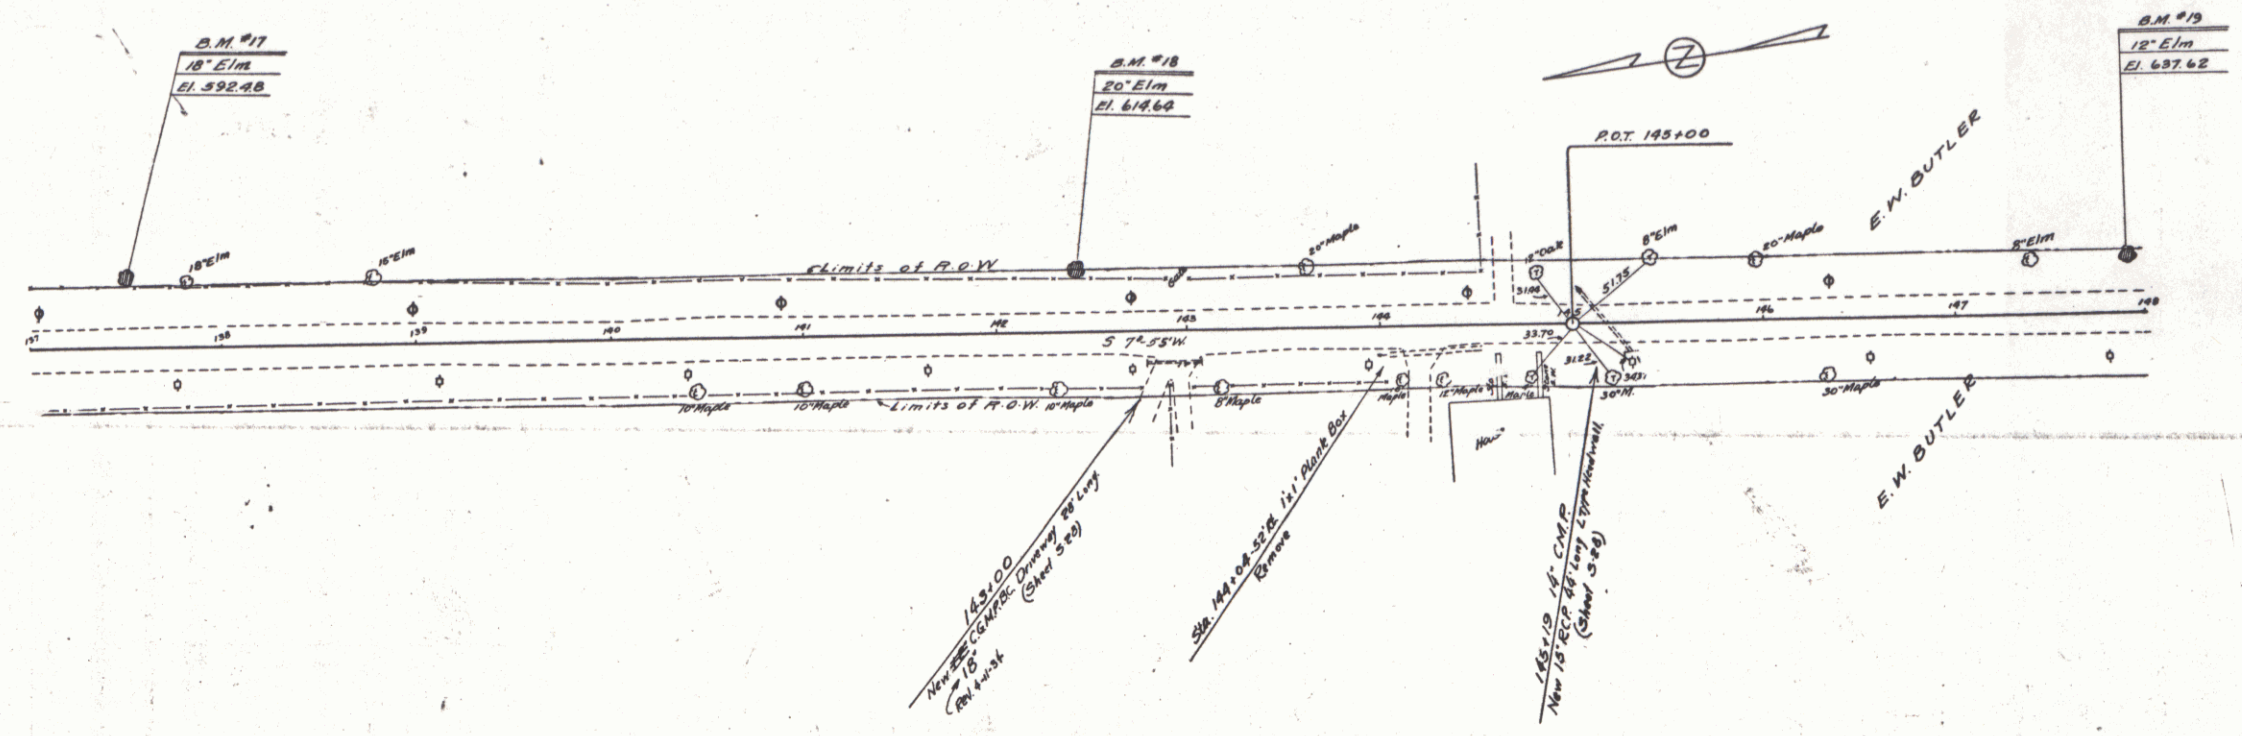

B.M. #17 SPIKE IN ROOT OF 18' ELM 31' LT. OF STA. 137+50 ELEV. 592.48
 B.M. #18 20' ELM 29' LT. OF STA. 142+41 ELEV. 614.64
 B.M. #19 12' ELM 24' LT. OF STA. 147+90 ELEV. 637.62

PLAN
 SHOWING
 GRADE
 AND
 ELEVATION
 OF
 THE
 ROAD
 AND
 ADJACENT
 LANDS
 AND
 BUILDINGS
 AND
 OTHER
 FEATURES
 OF
 THE
 AREA
 AND
 THE
 LOCATION
 OF
 THE
 ROAD
 AND
 THE
 ADJACENT
 LANDS
 AND
 BUILDINGS
 AND
 OTHER
 FEATURES
 OF
 THE
 AREA


ELEVATION
 OF
 THE
 ROAD
 AND
 ADJACENT
 LANDS
 AND
 BUILDINGS
 AND
 OTHER
 FEATURES
 OF
 THE
 AREA

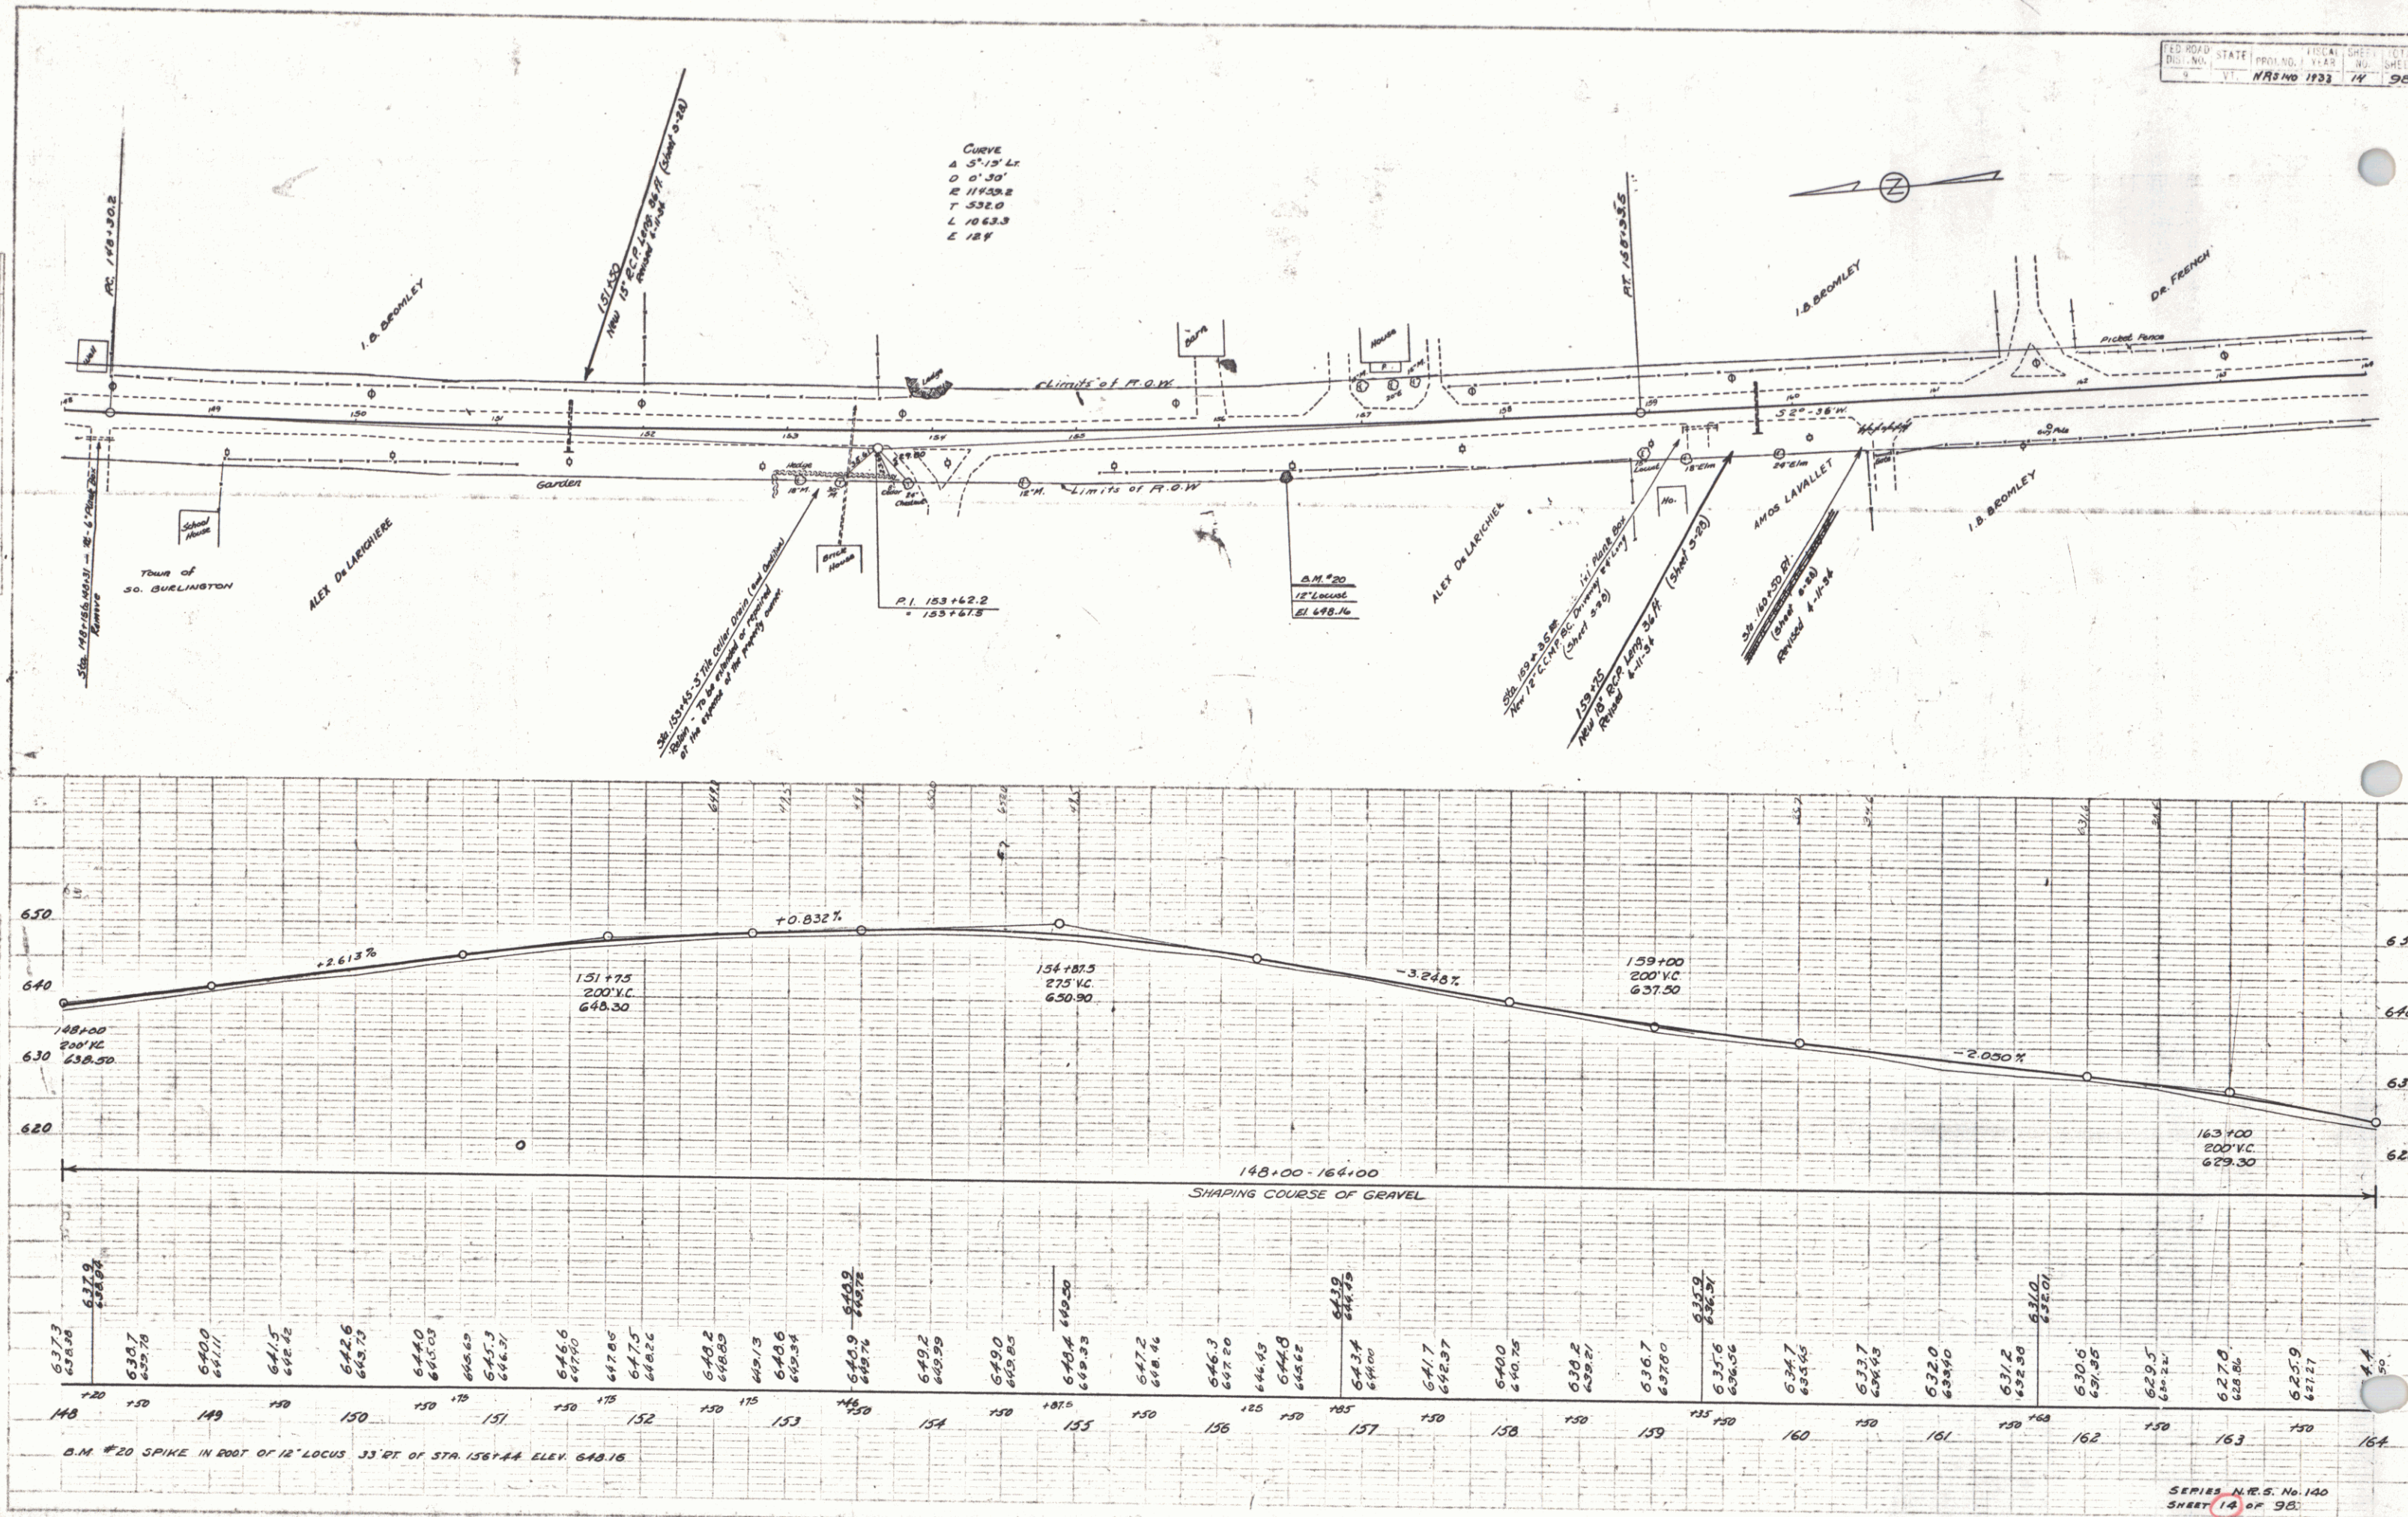




PLAN
 1" = 40'
 1" = 40'



SECTION
 1" = 10'
 1" = 10'

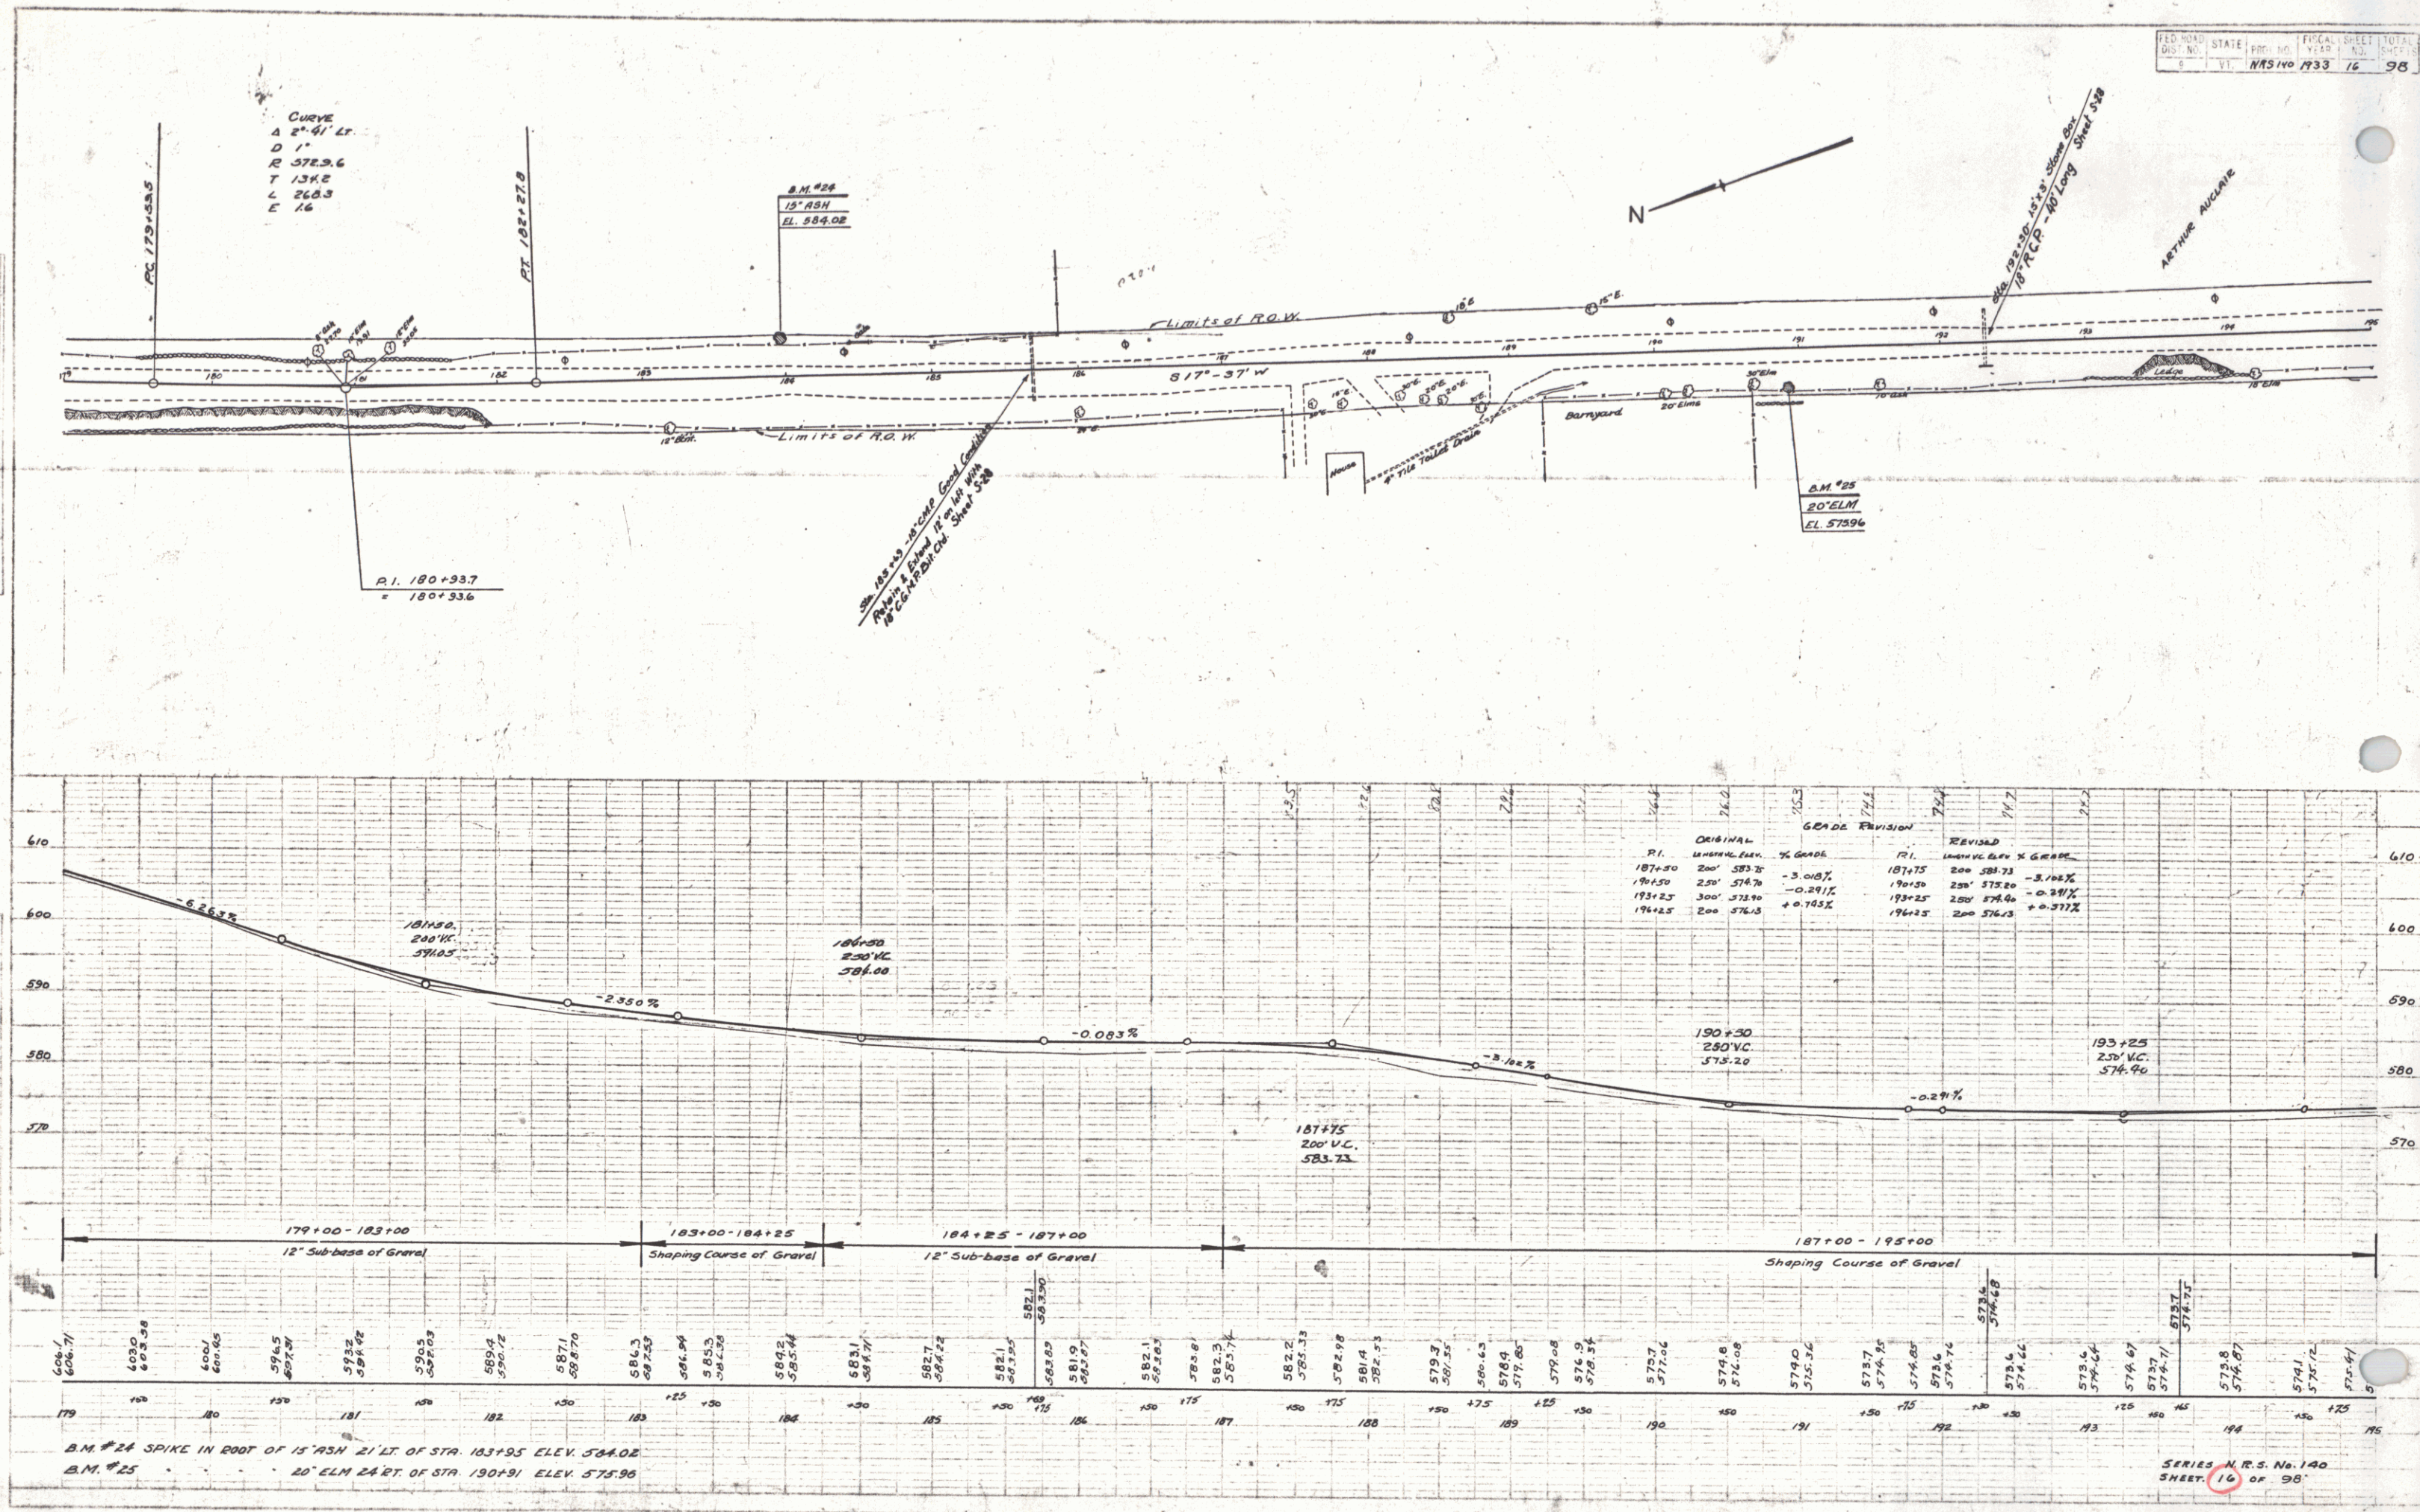


PLAN
DATE BOOK
BY
CHECKED BY
APPROVED BY

PLAN
DATE BOOK
BY
CHECKED BY
APPROVED BY


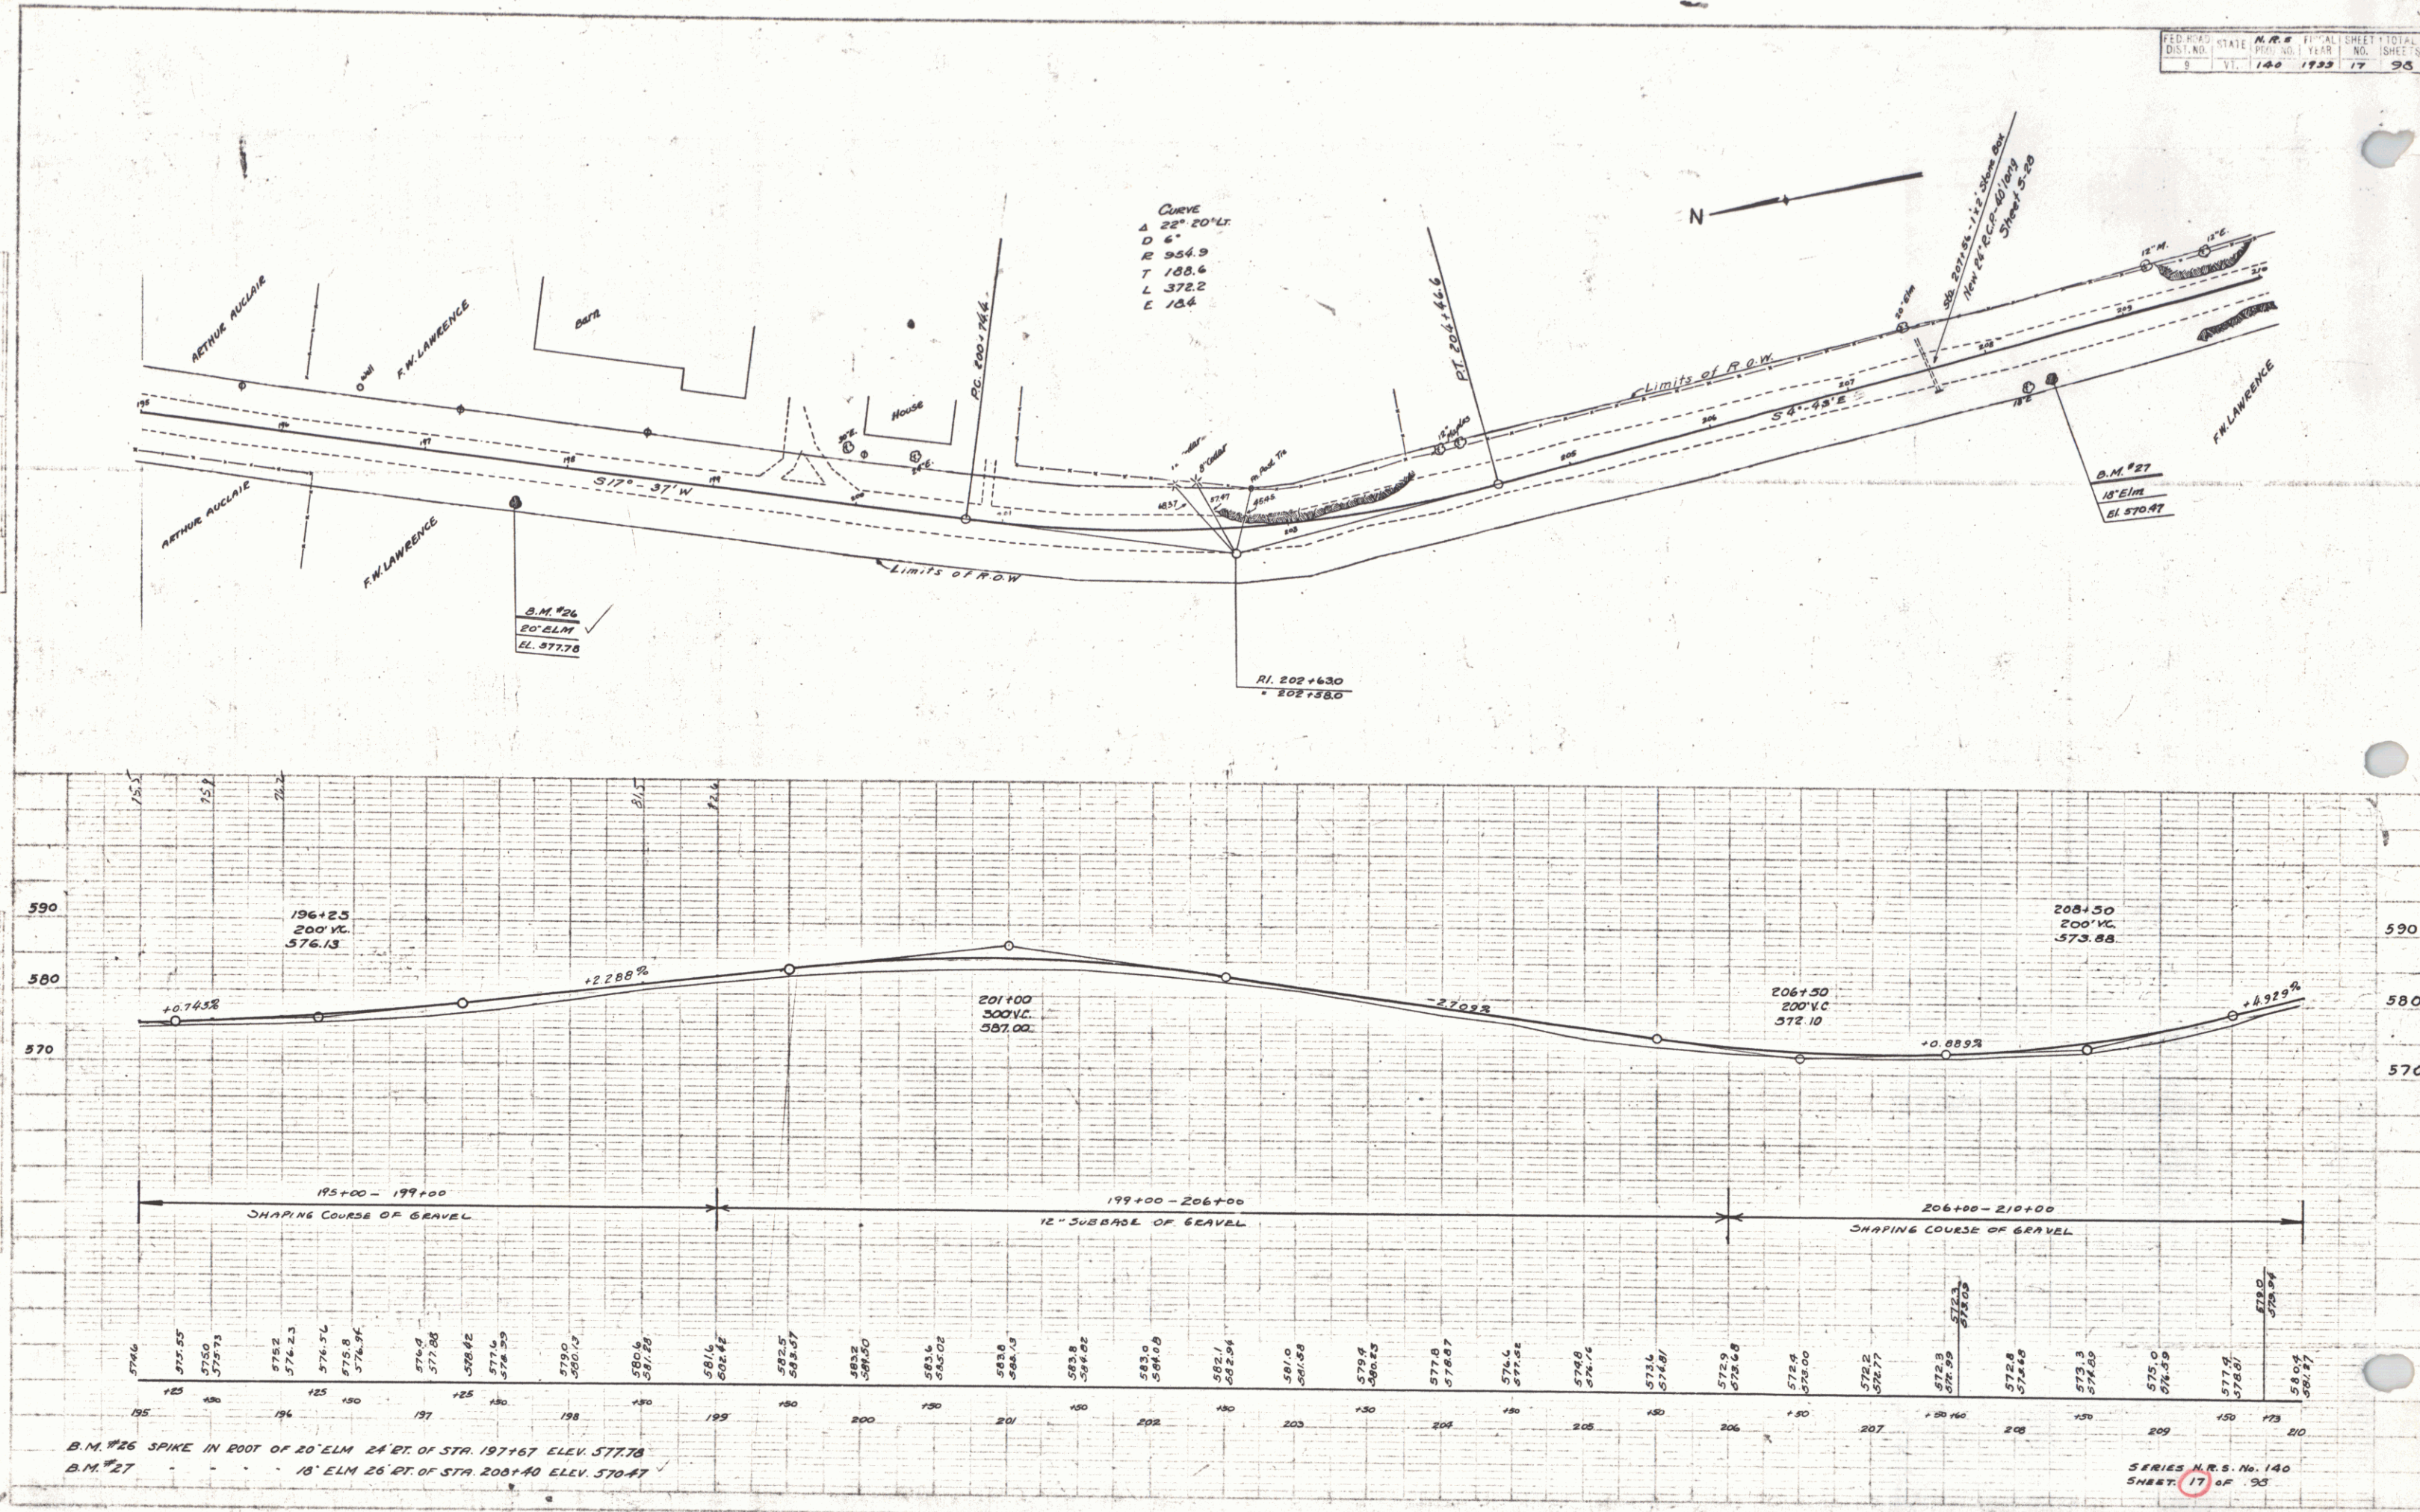


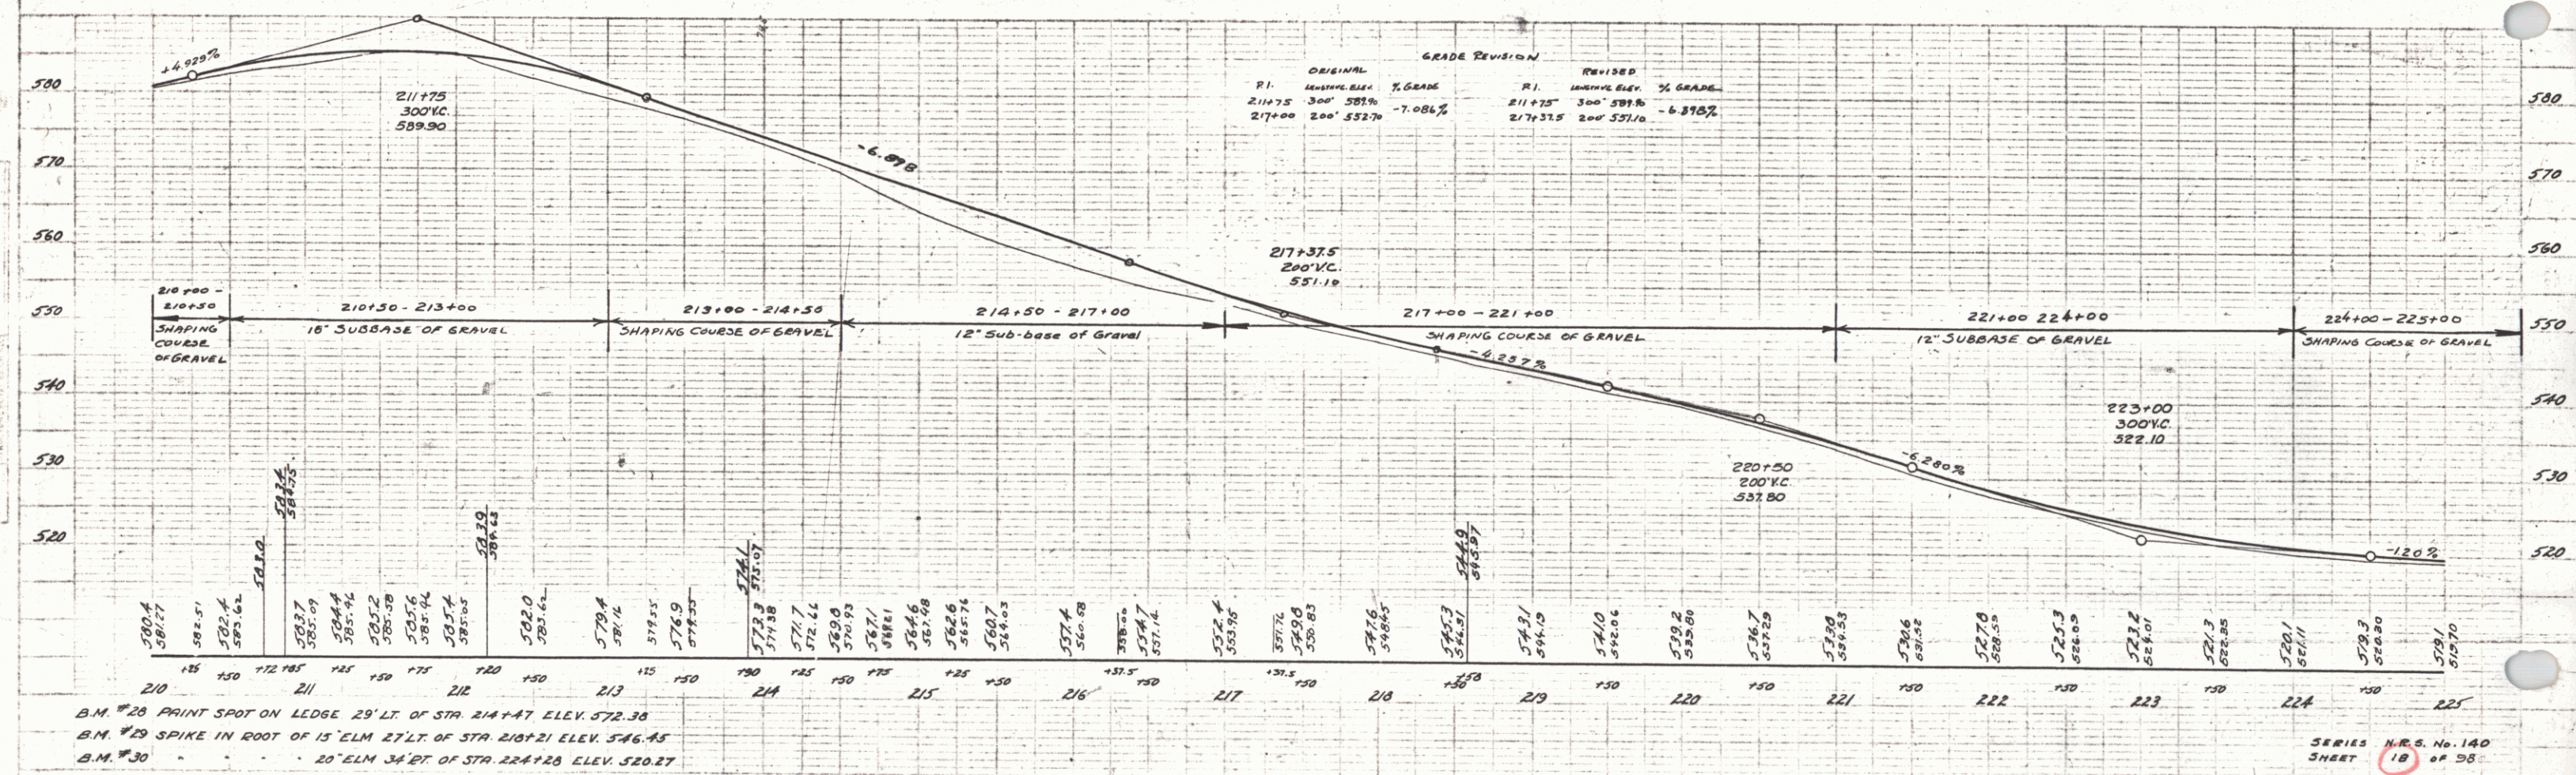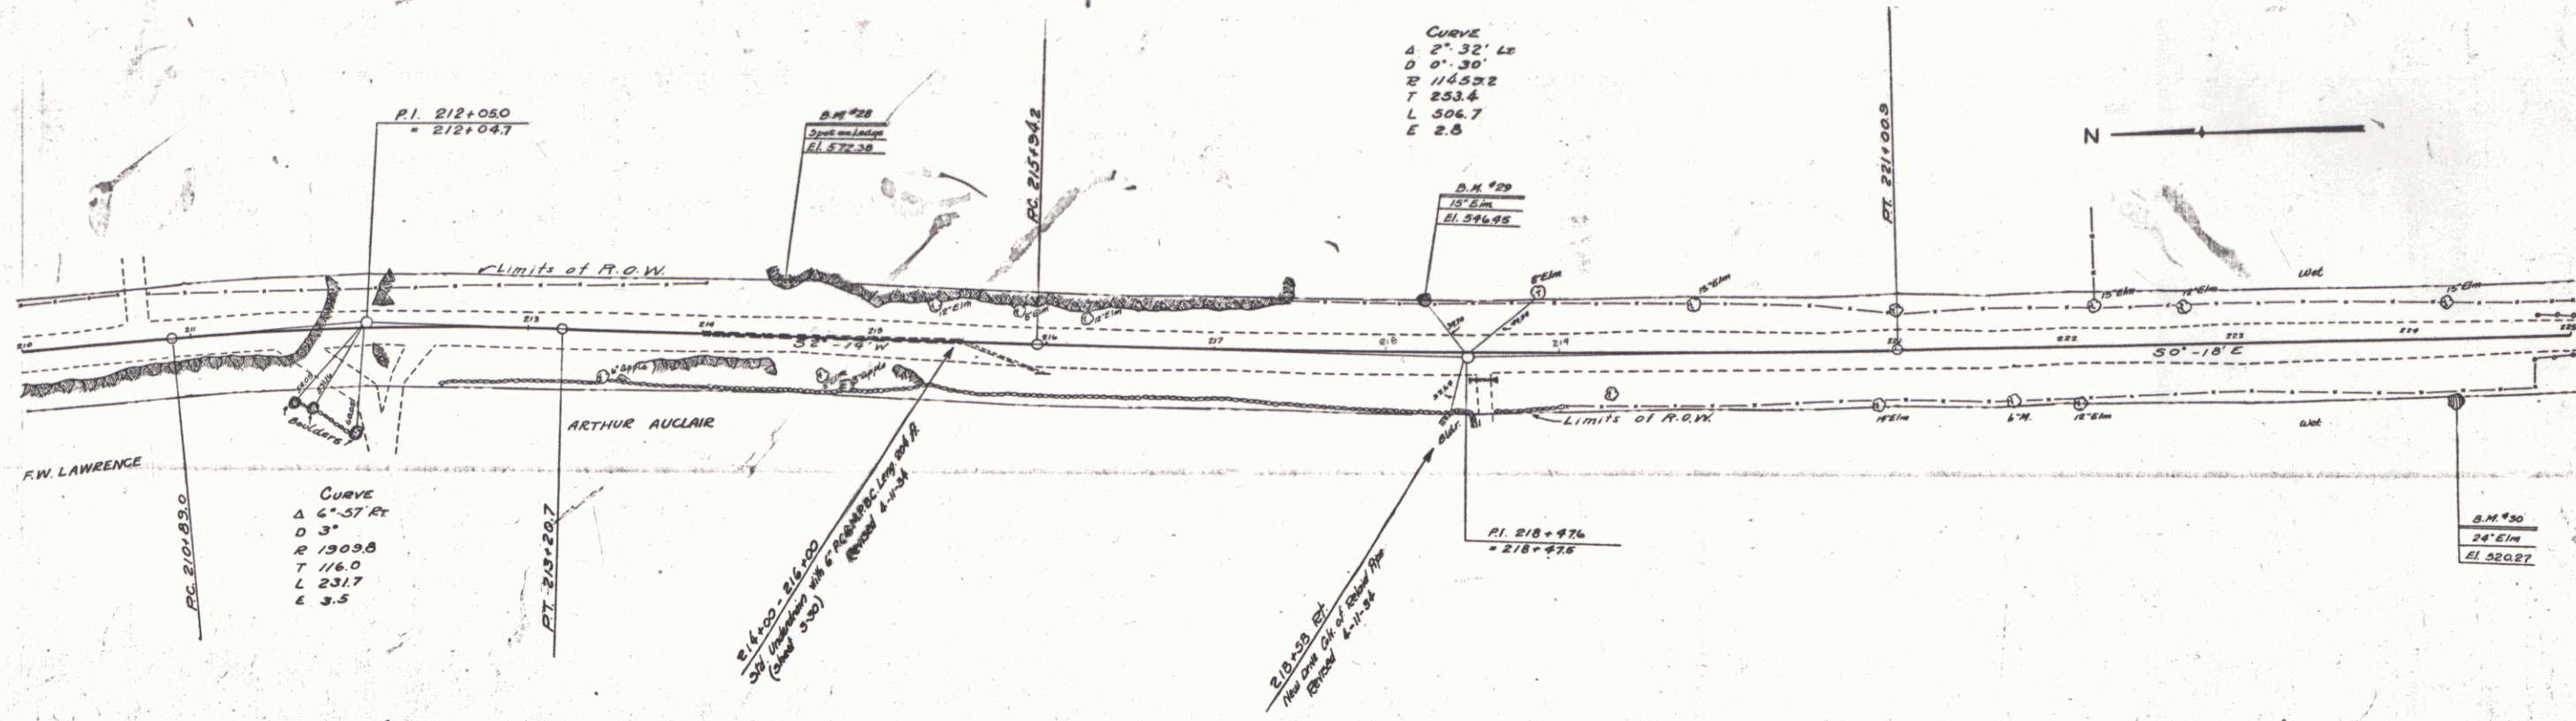

B.M. #28 PRINT SPOT ON LEDGE 29' LT. OF STA. 214+47 ELEV. 572.38
 B.M. #29 SPIKE IN ROOT OF 15' ELM 27' LT. OF STA. 218+21 ELEV. 546.45
 B.M. #30 20' ELM 34' RT. OF STA. 224+26 ELEV. 520.27

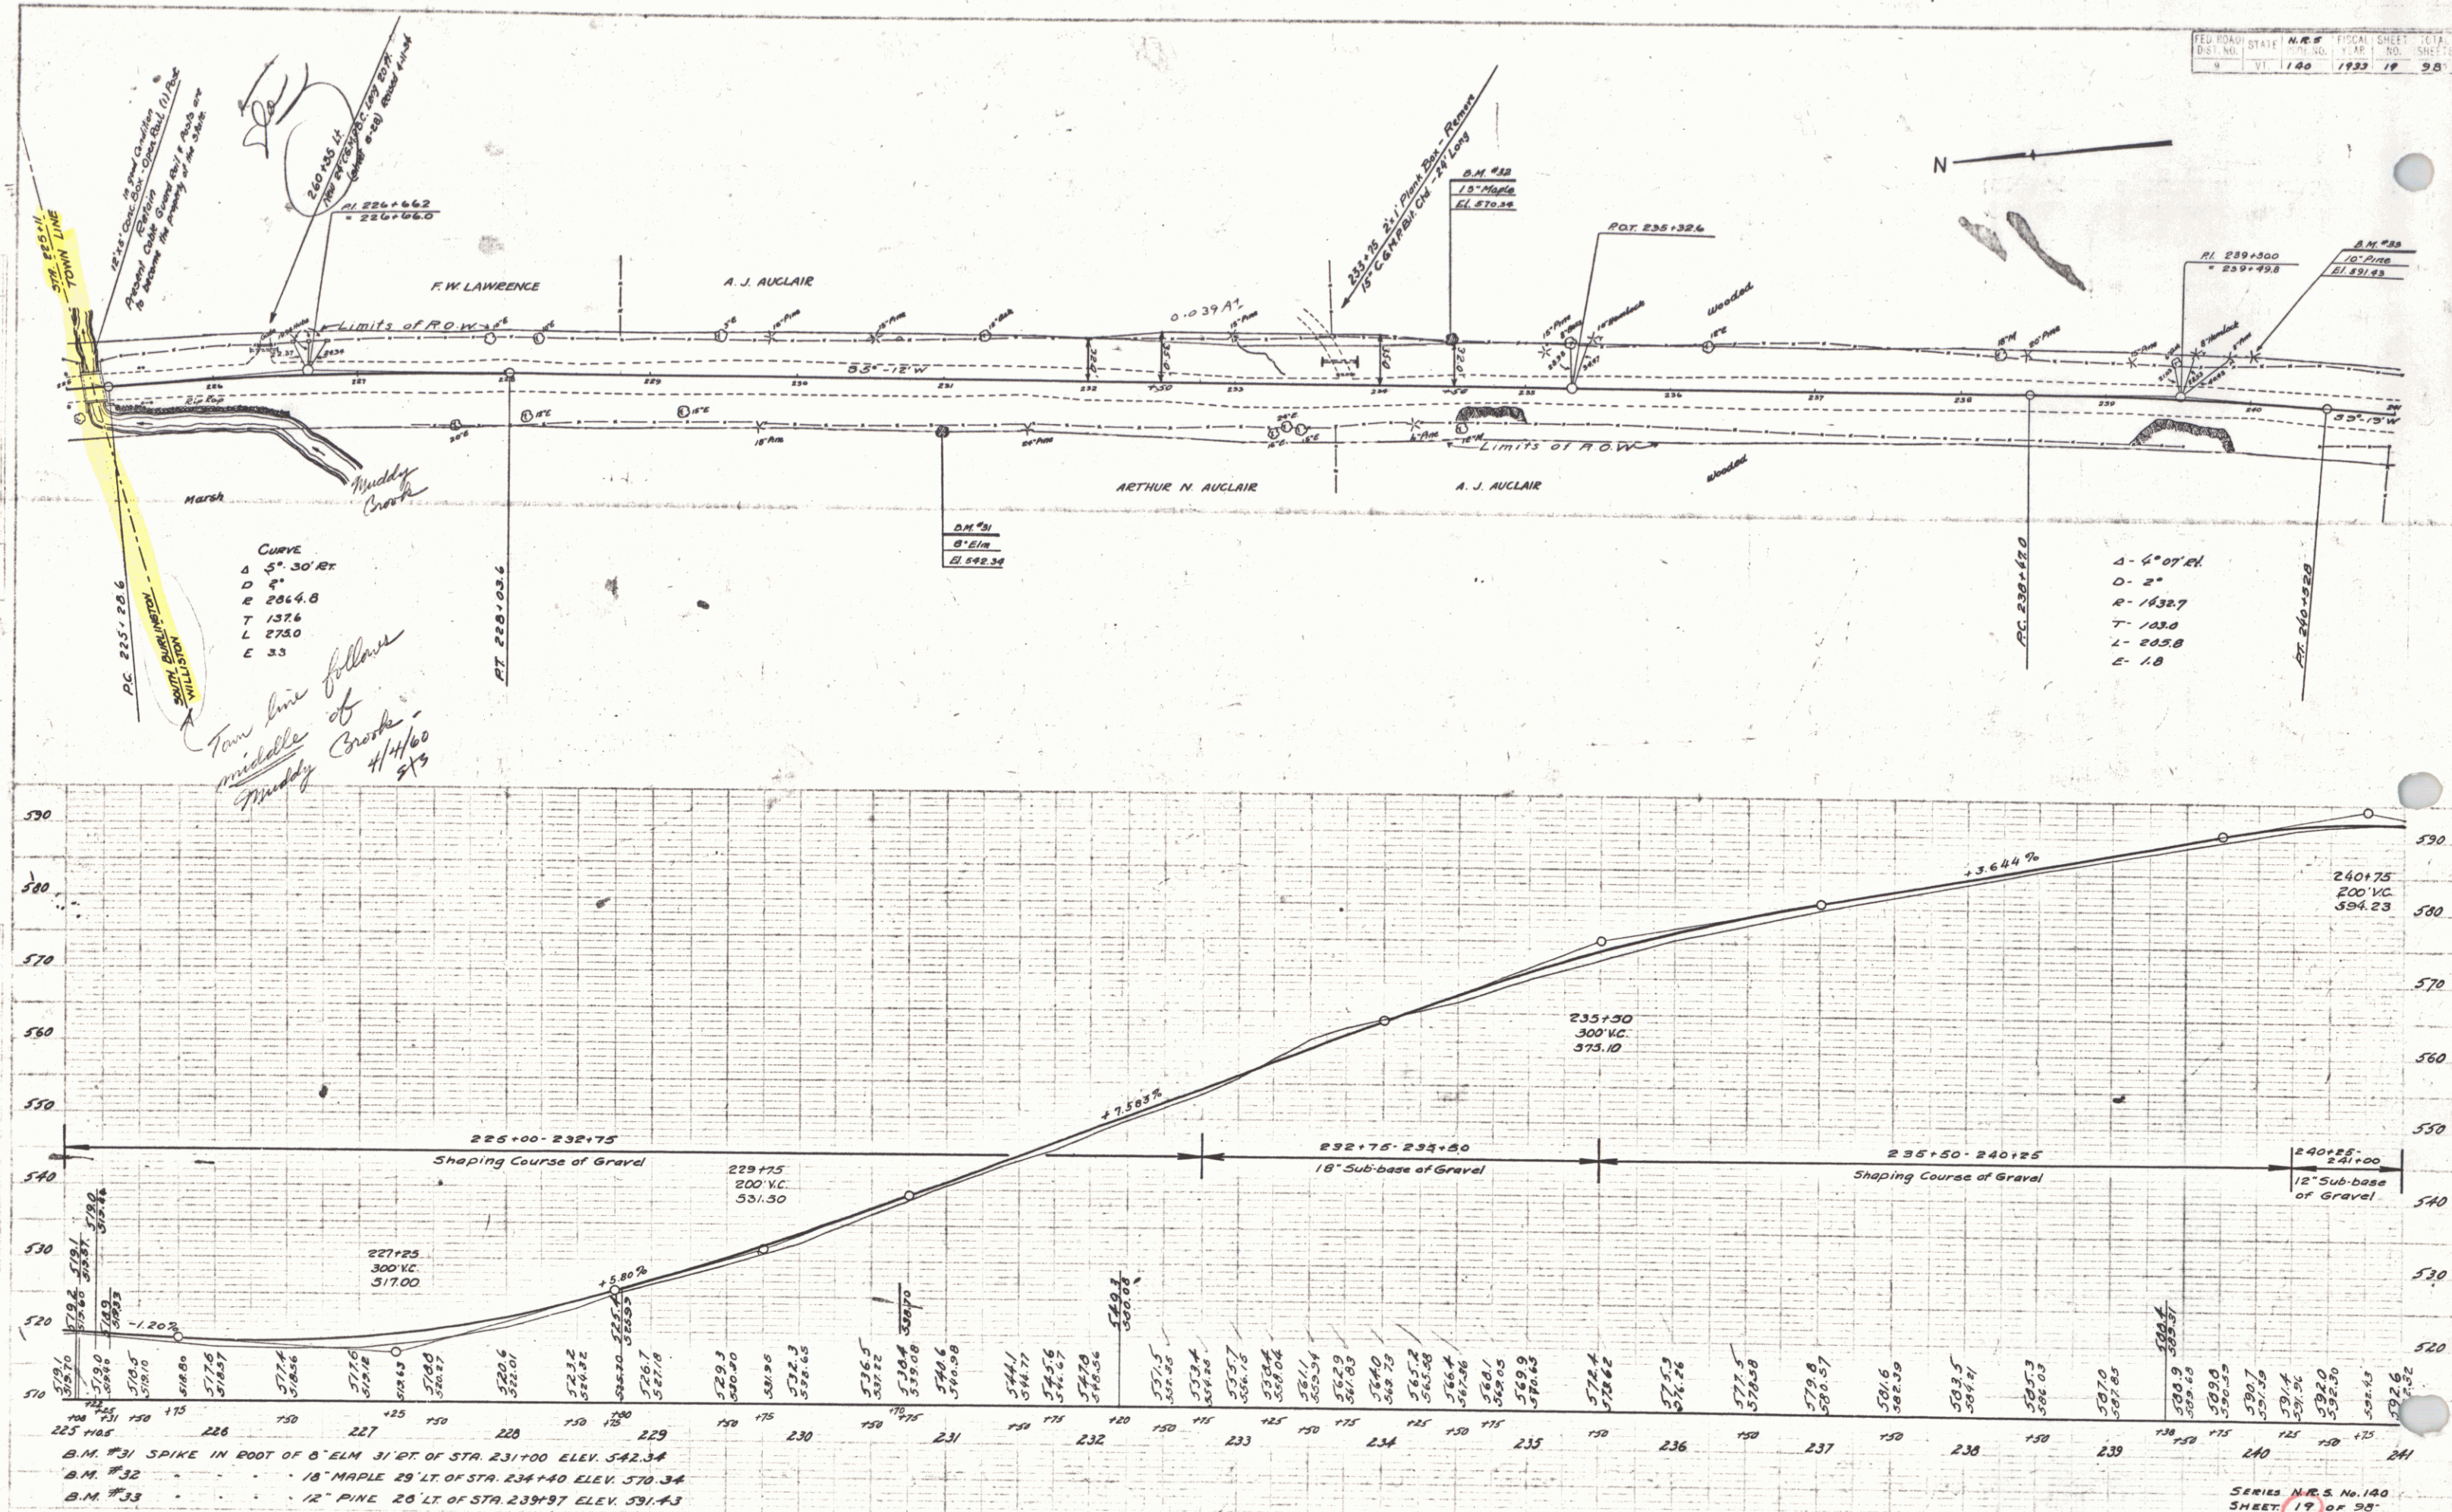




WOOD
 BACLEY
 BIGELOW
 TRACER
 1933

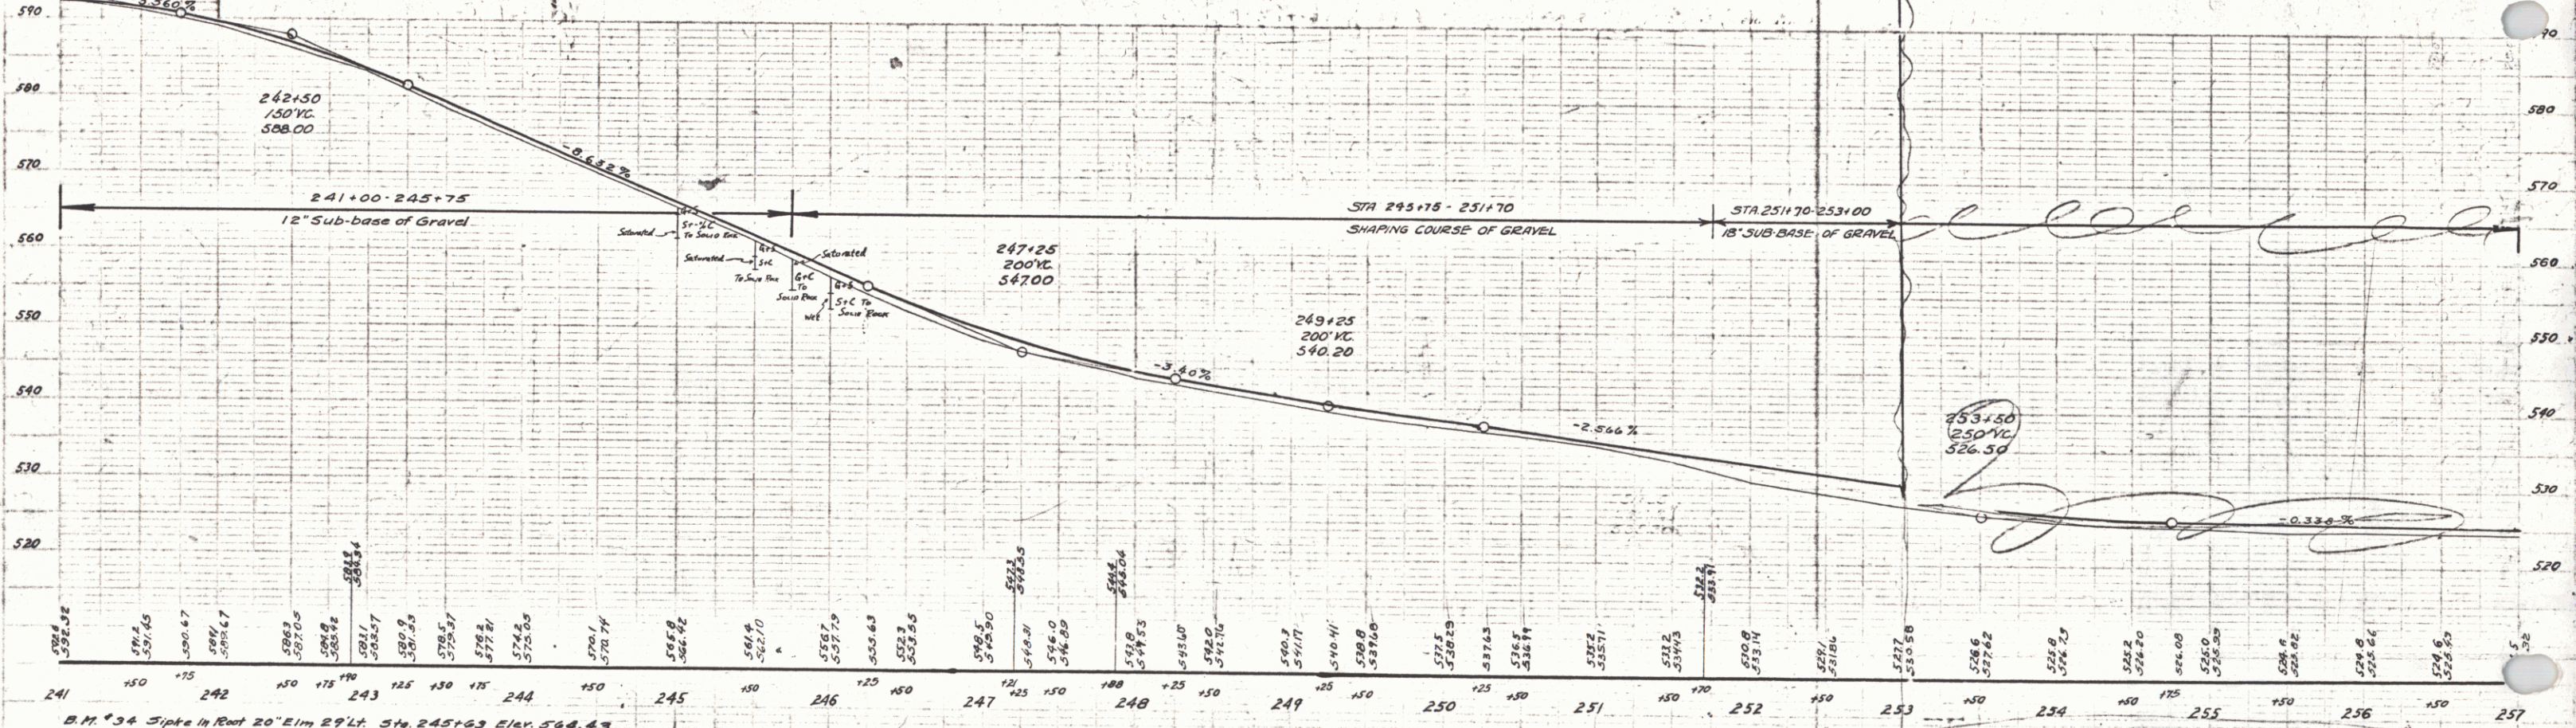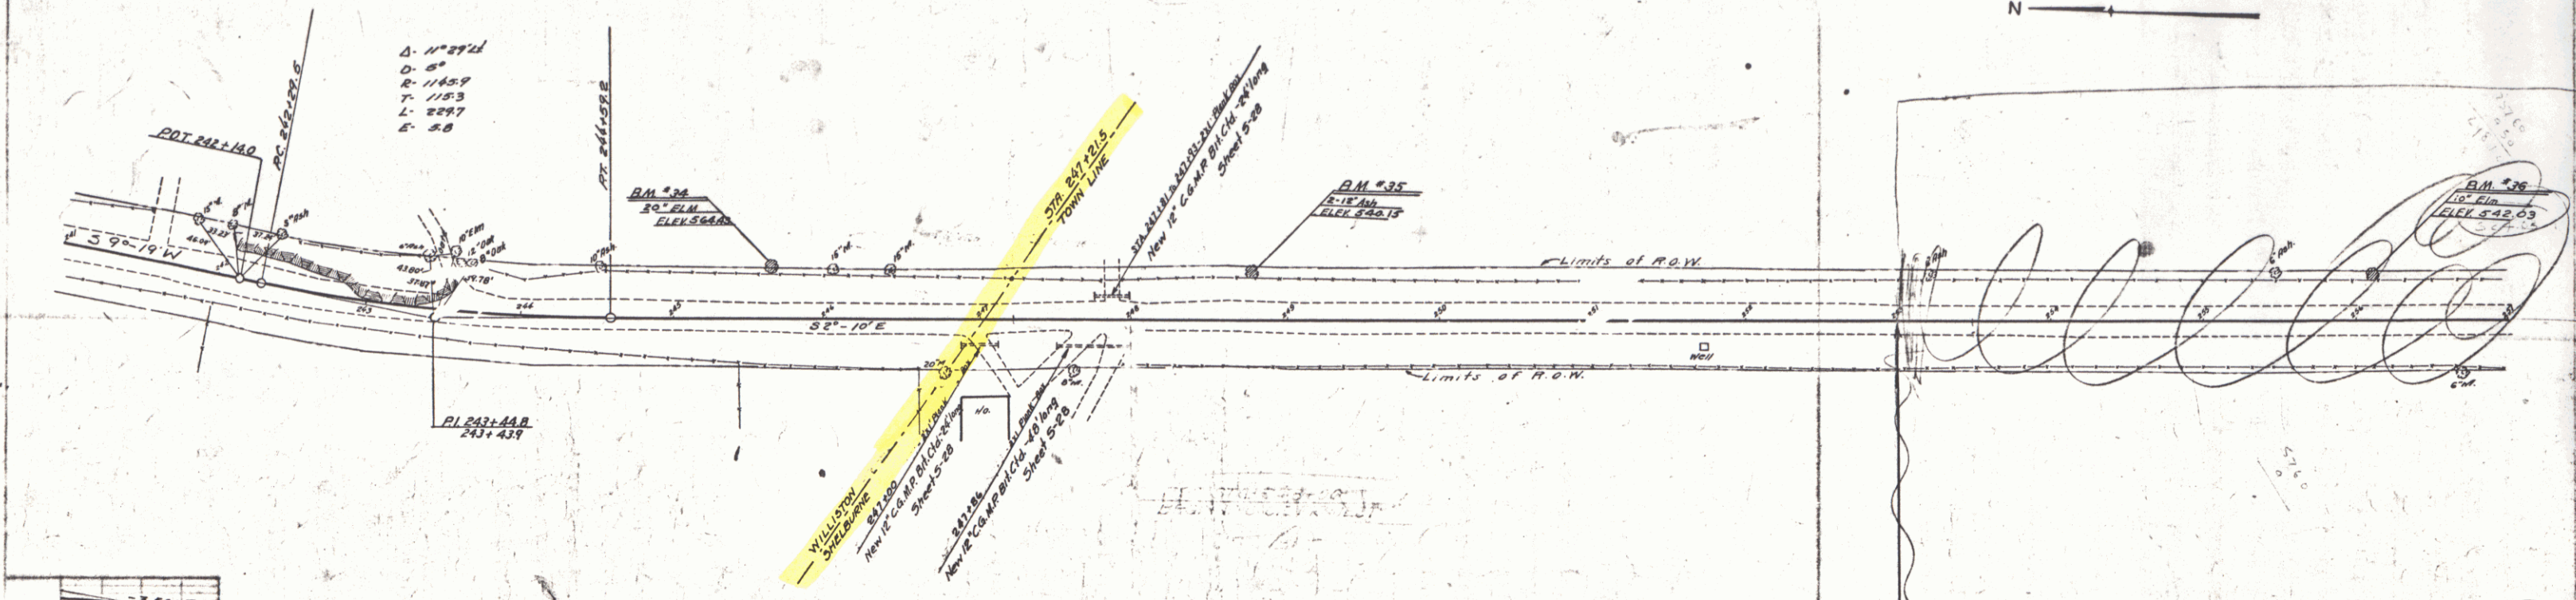

B.M. 34 5' pipe in Root 20" Elm 29' Lt. Sta. 245+63 Elev. 548.43
 B.M. 33 12" Turn Rod-26' Lt. Sta. 248+75 Elev. 540.15

SERIES N.H. 5-140
 SHEET 100F 20


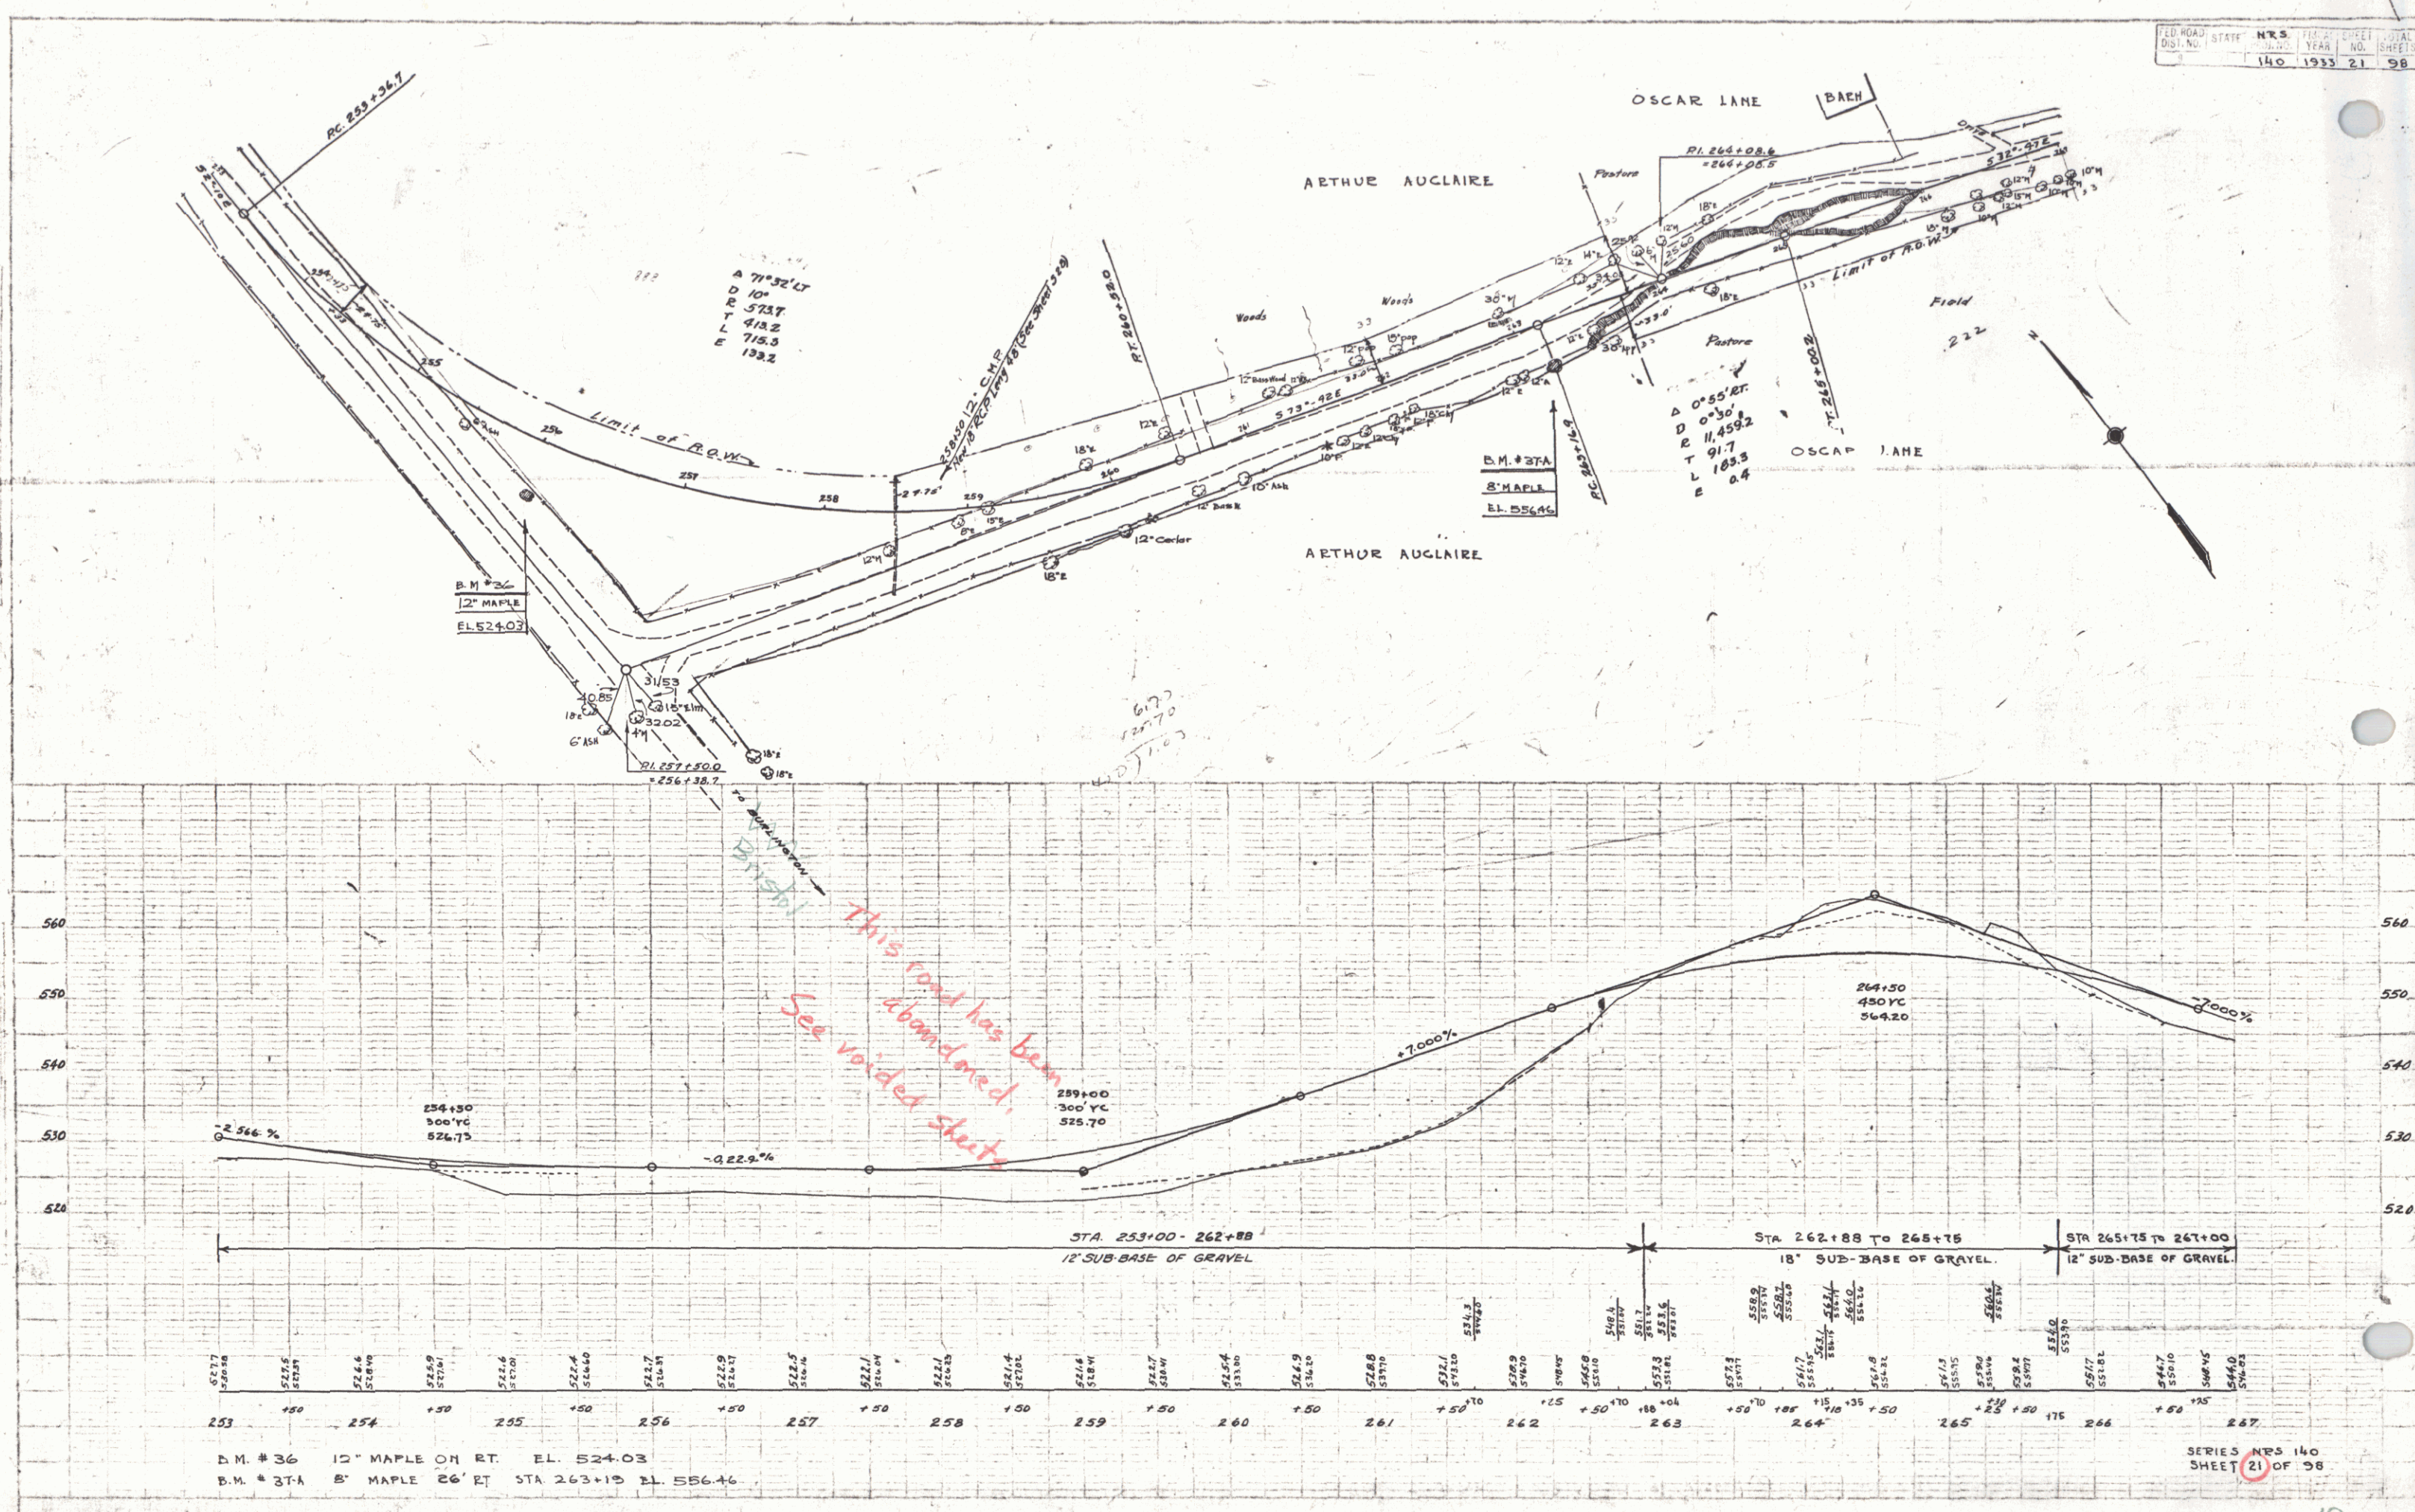


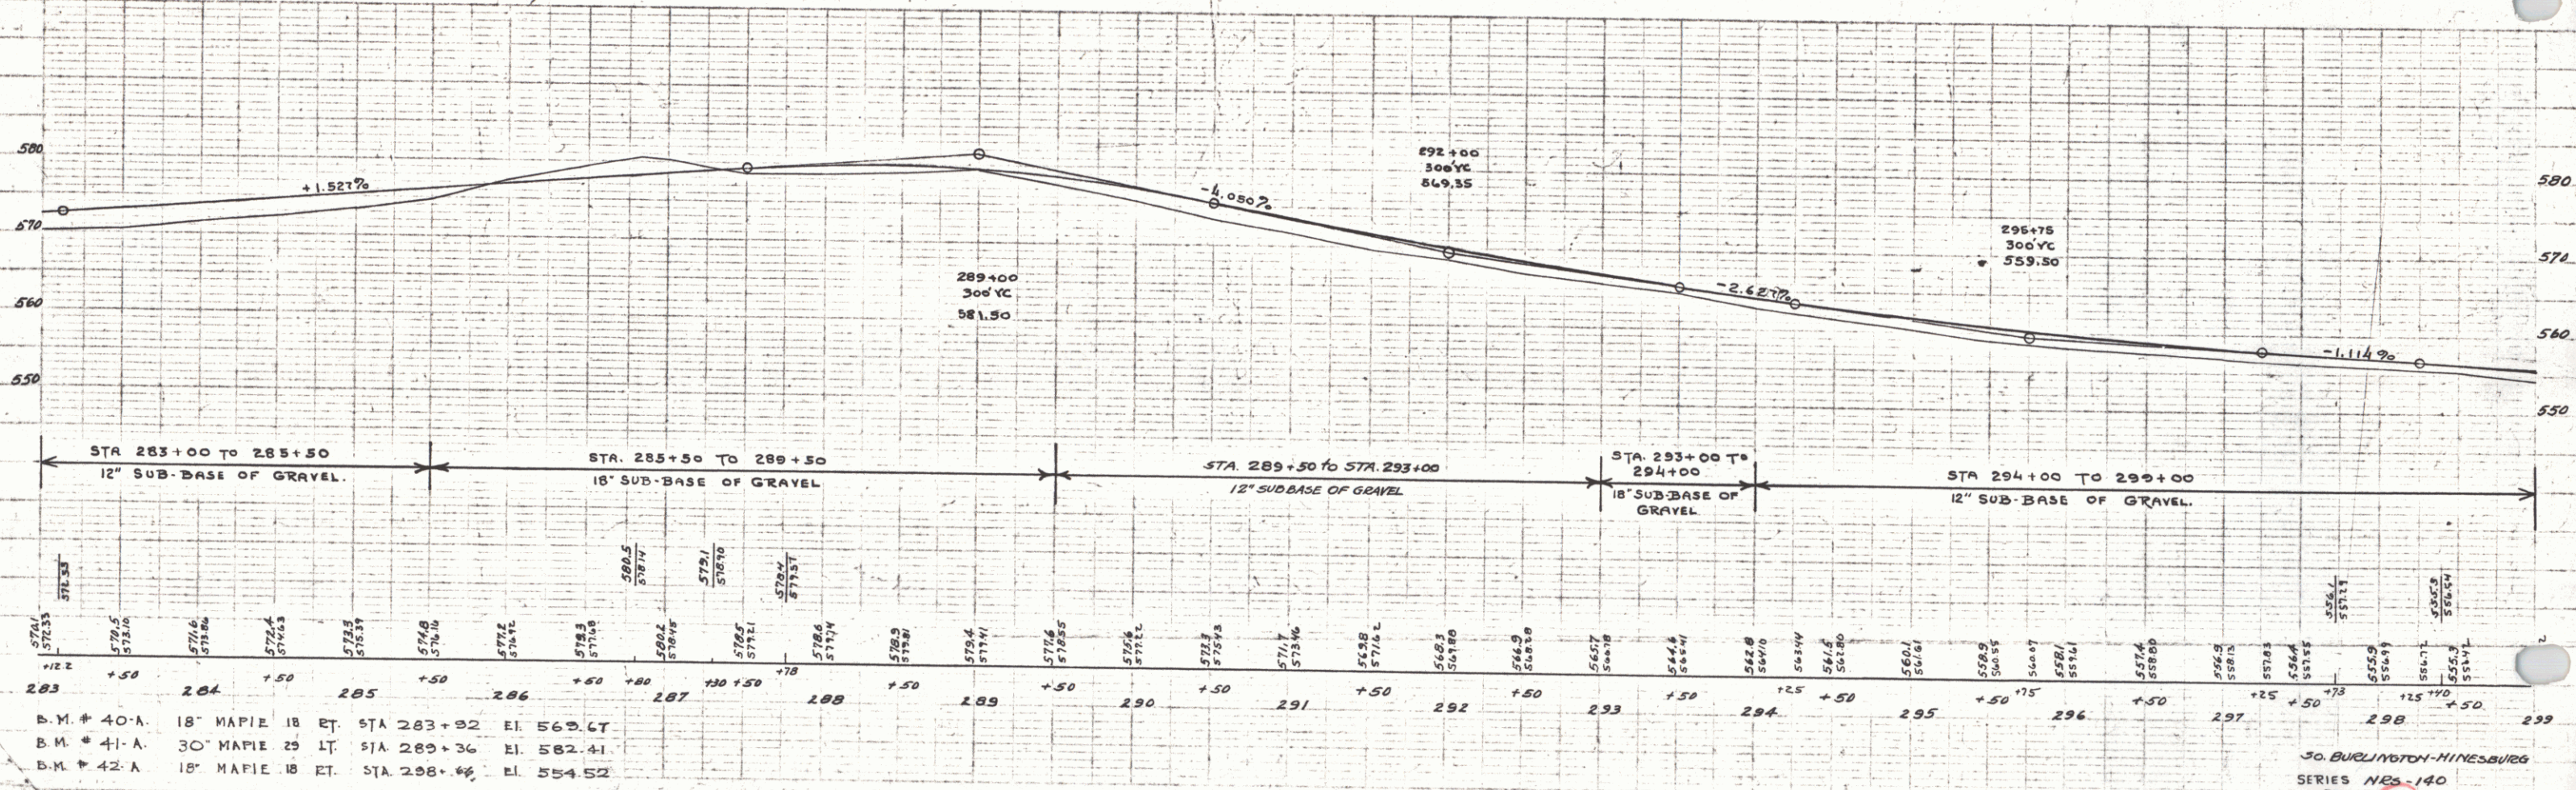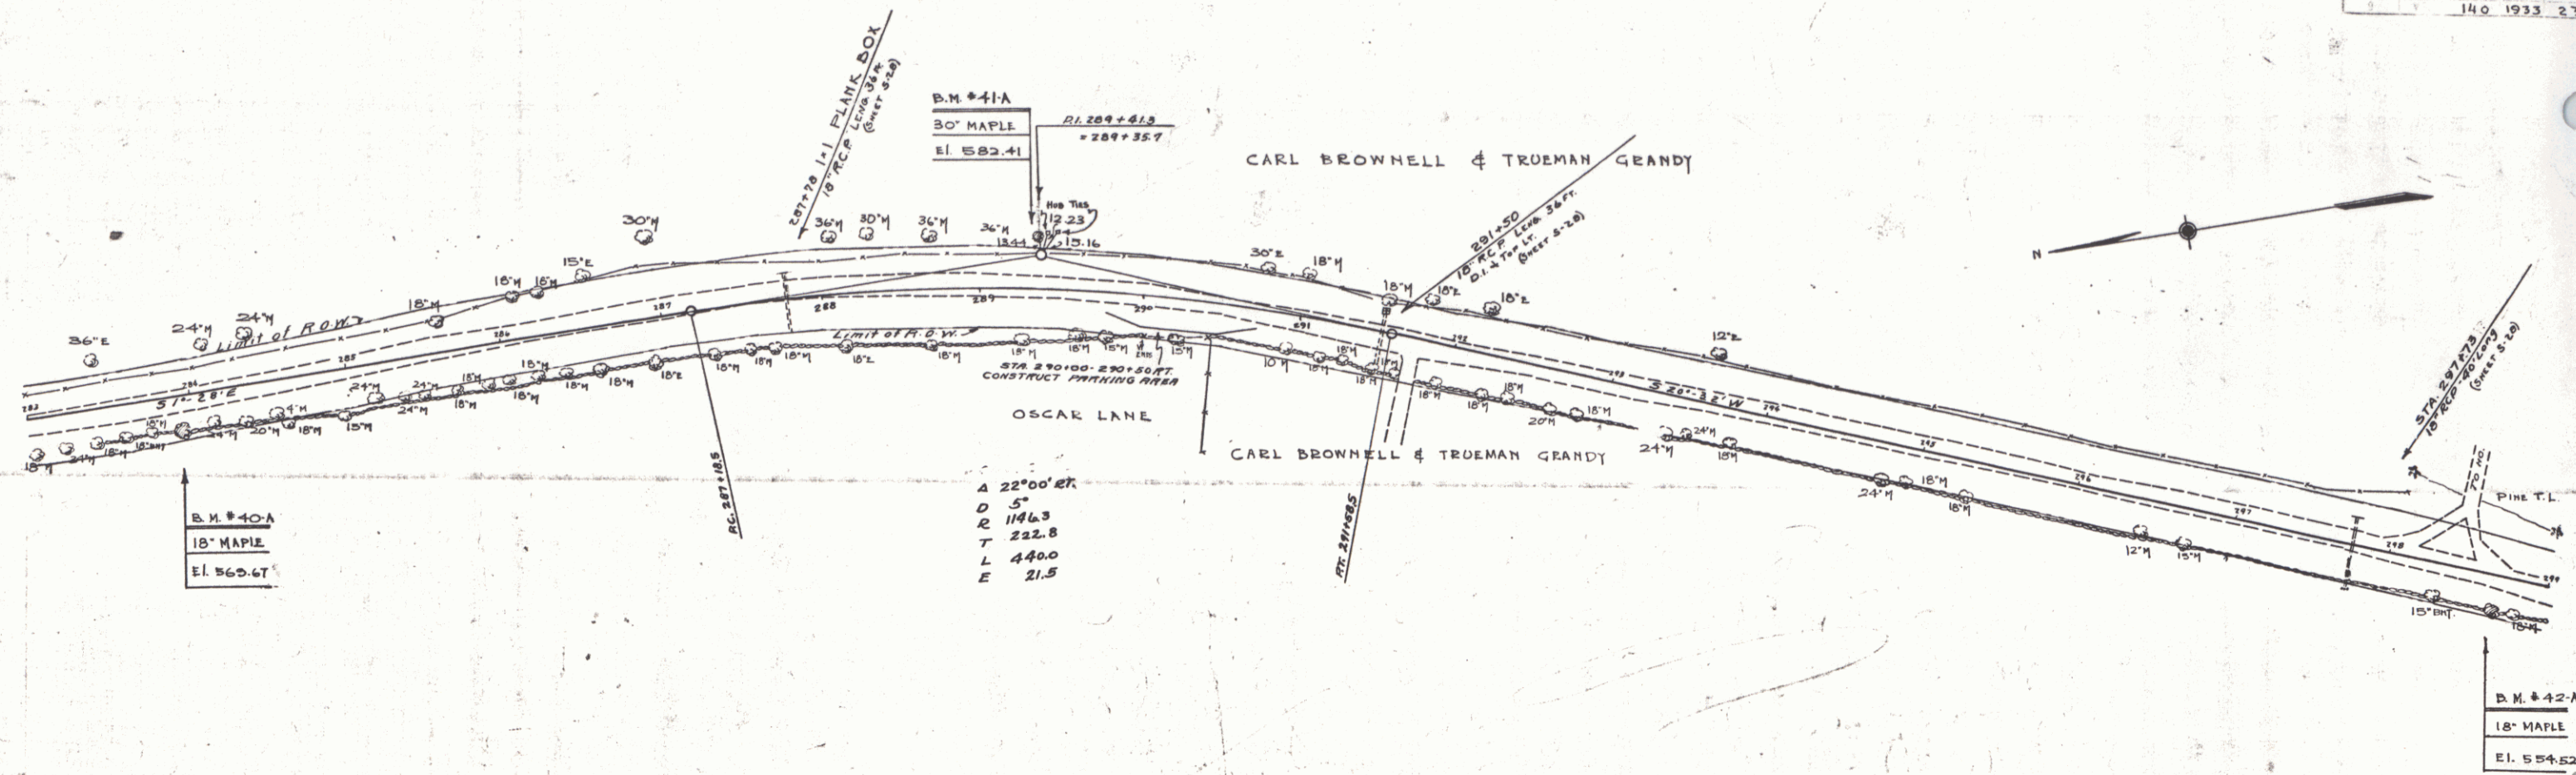


B.M. # 40-A	18" MAPLE	18" ET	STA 283+32	EL. 565.47
B.M. # 41-A	30" MAPLE	29" IT	STA 289+36	EL. 582.41
B.M. # 42-A	18" MAPLE	18" ET	STA 298+46	EL. 554.52

PLAN
 SCALE: 1" = 40'
 DATE: 10/1/33
 DRAWN BY: [illegible]
 CHECKED BY: [illegible]

ELEVATION
 SCALE: 1" = 10'
 DATE: 10/1/33
 DRAWN BY: [illegible]
 CHECKED BY: [illegible]

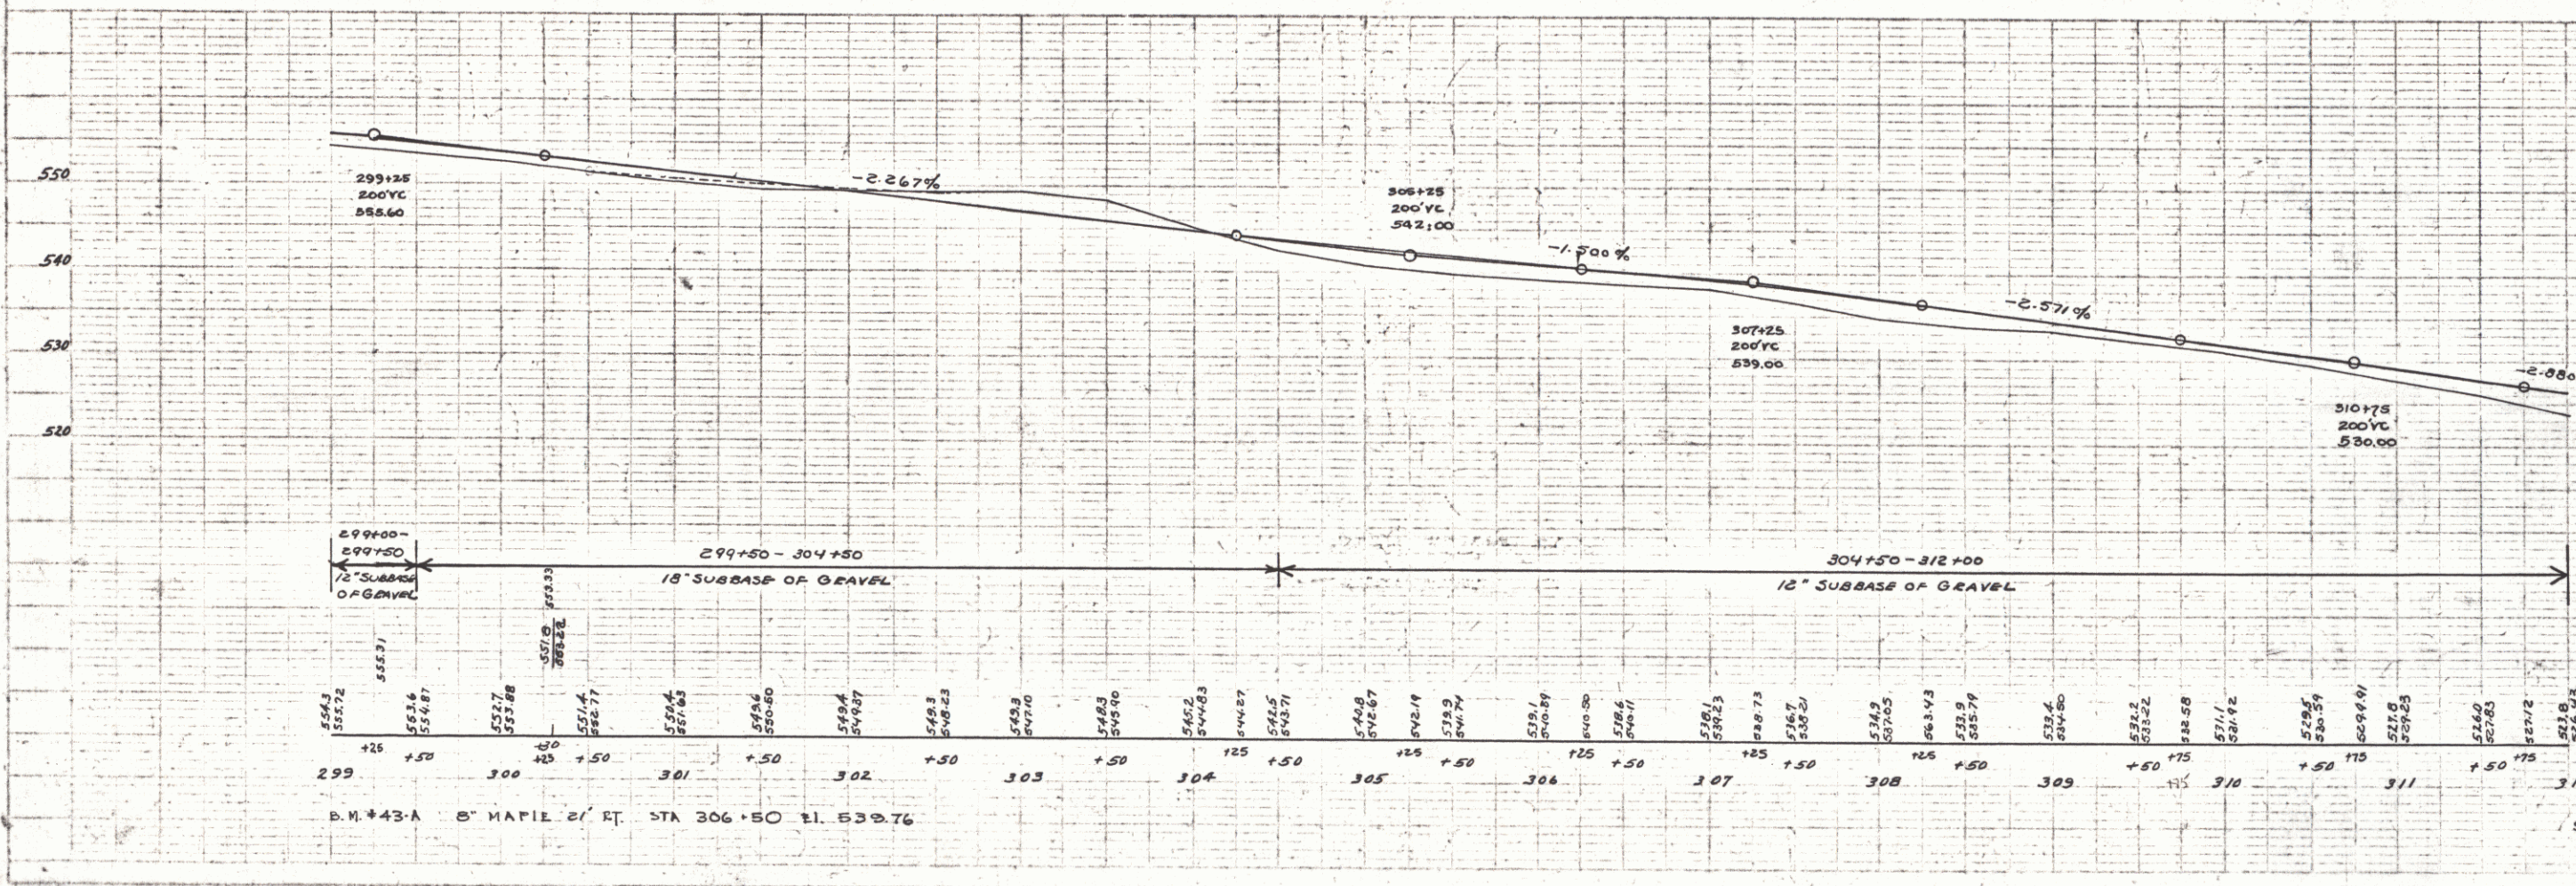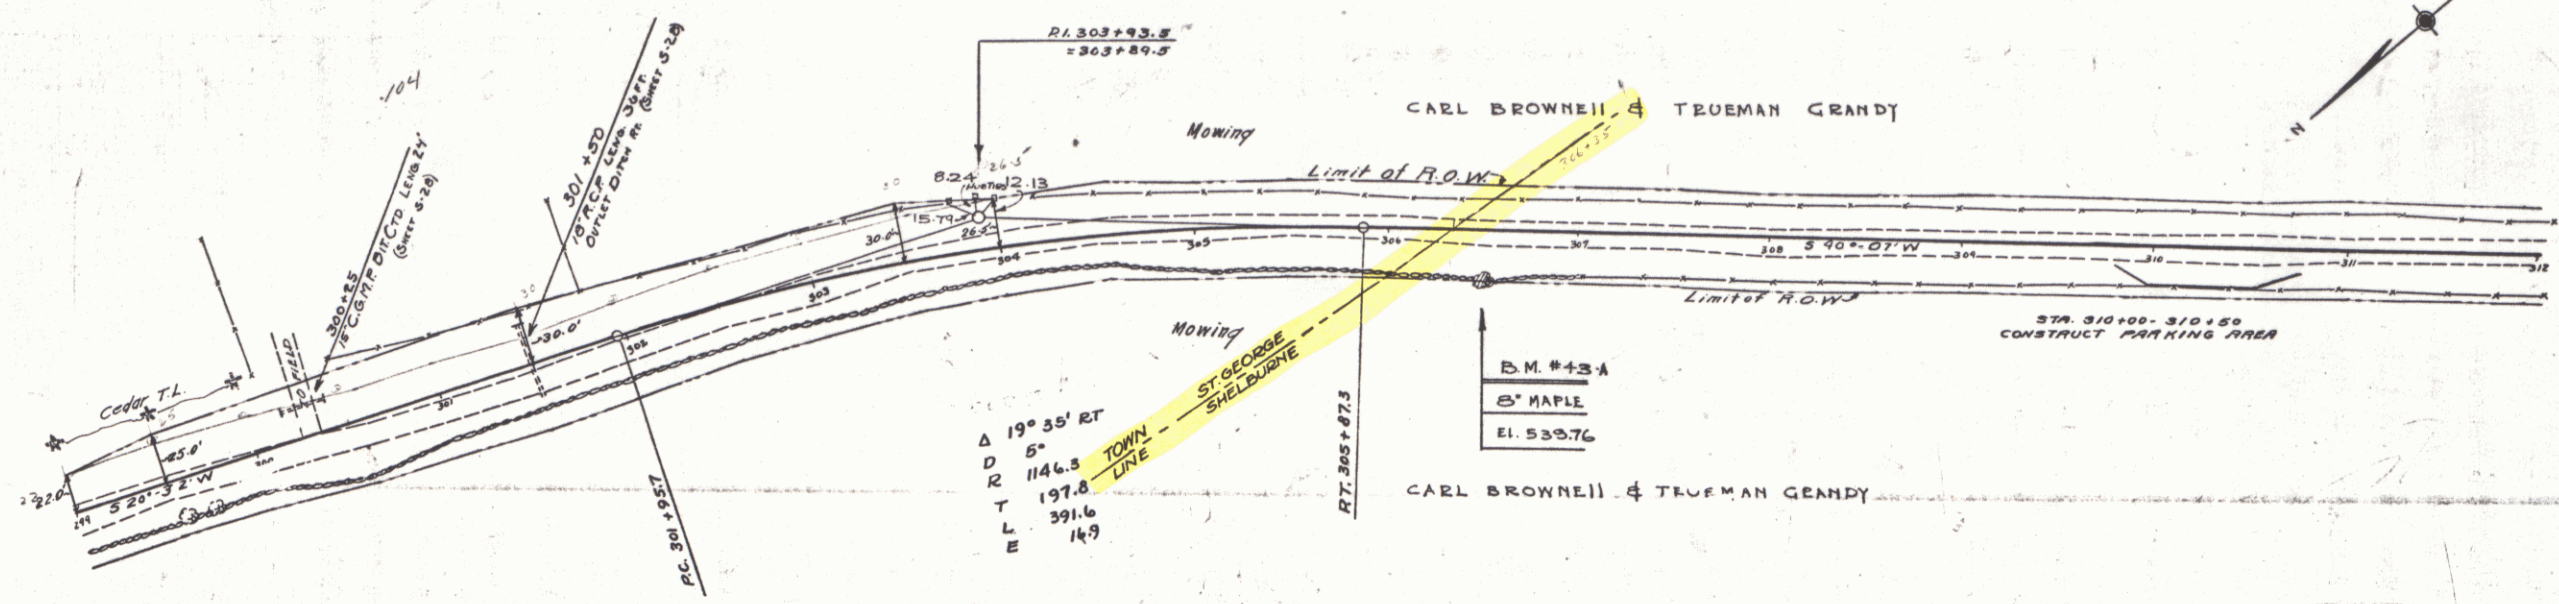

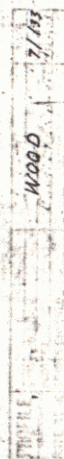



SERIES N.R.S. No. 140
SHEET 24 OF 98





SERIES NRS 140
Sheet 22 of 98

PLAN
WOOD
BUCKLEY
BUELOW
9/10/33
TRACED

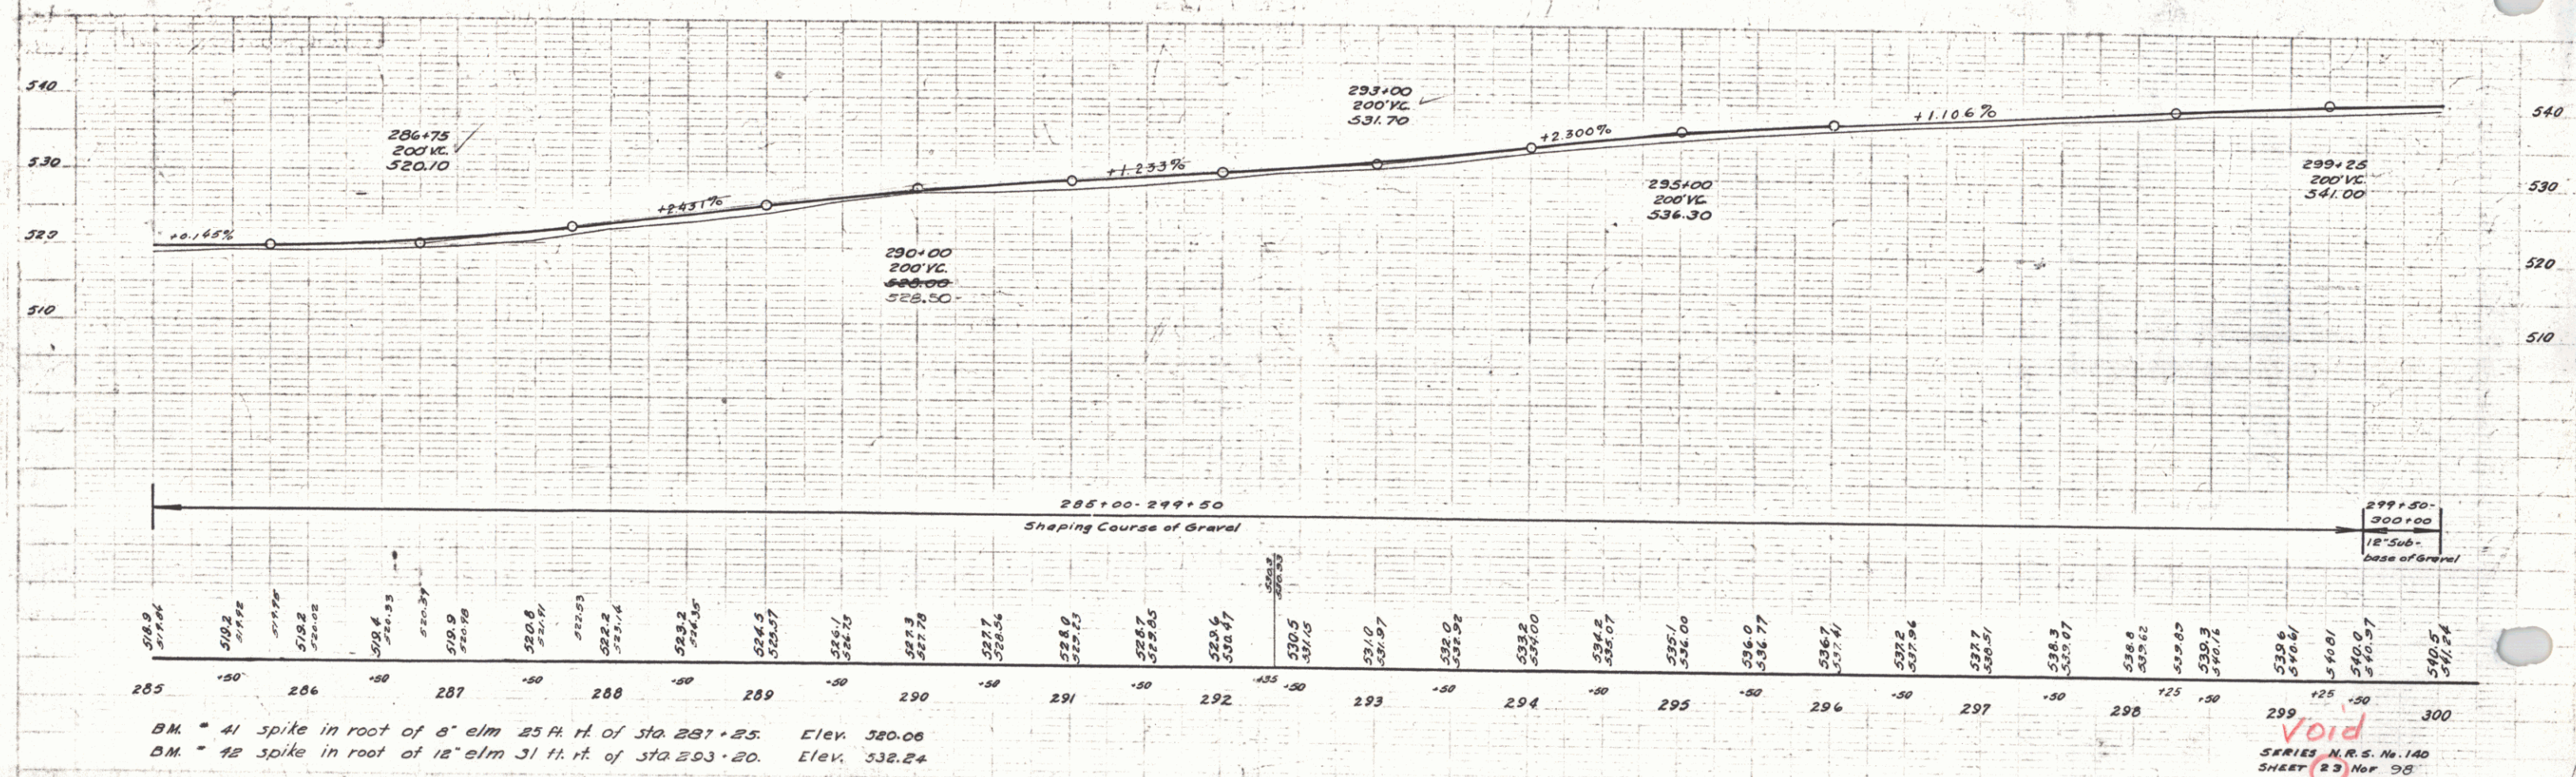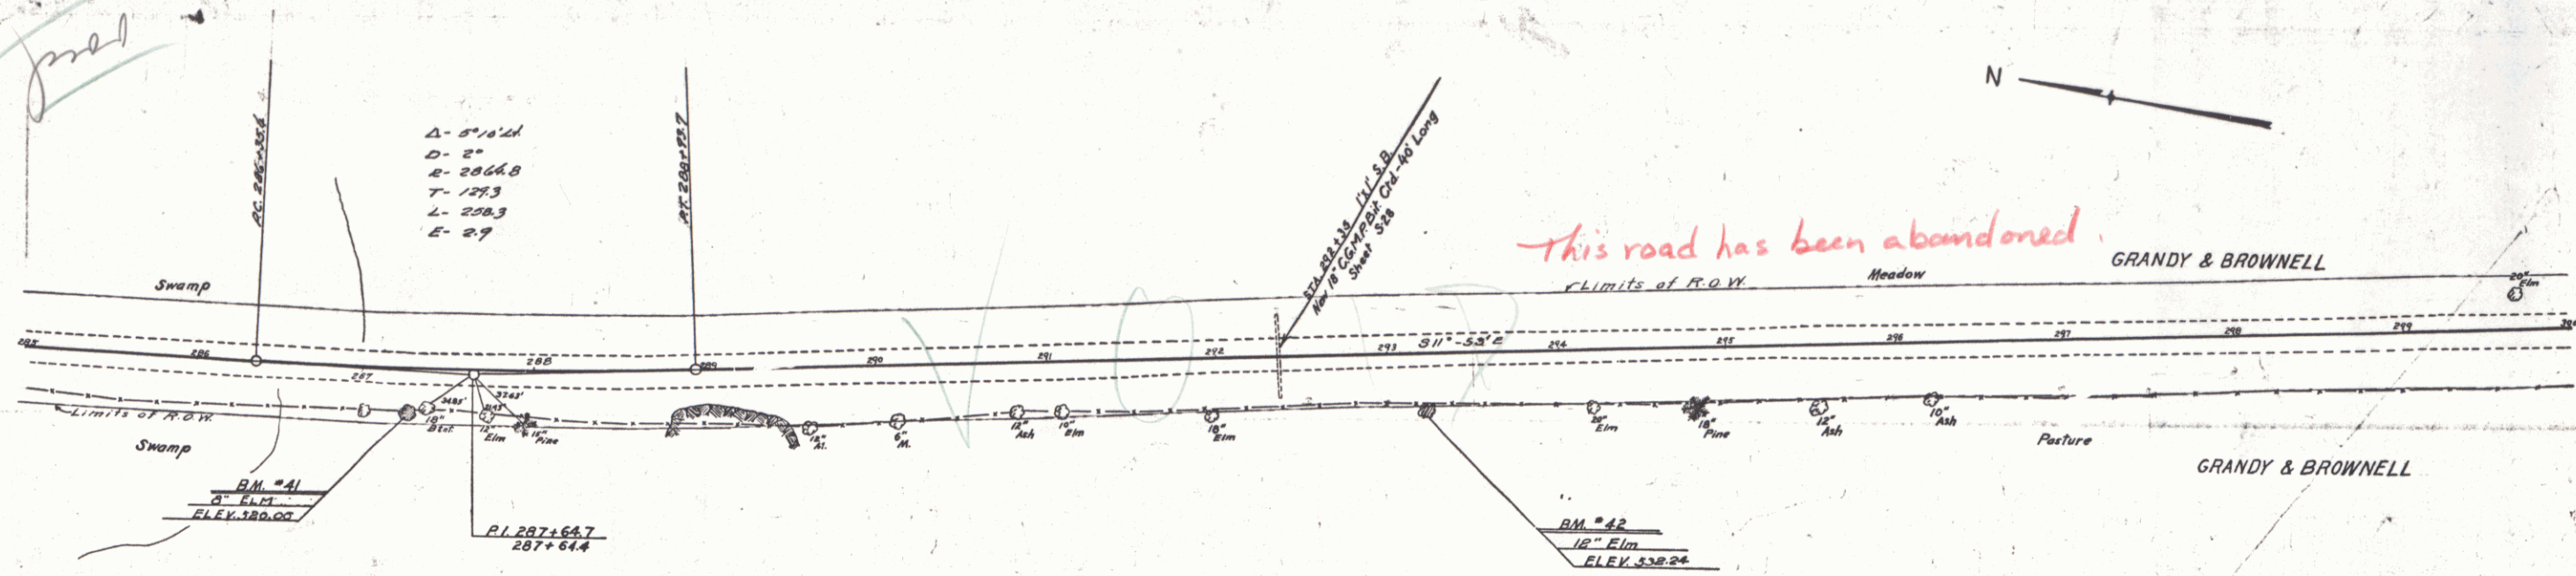

BM. = 41 spike in root of 8" elm 25 ft. ht. of sta 287+25. Elev. 520.00
 BM. = 42 spike in root of 12" elm 31 ft. ht. of sta 293+20. Elev. 532.24

VOID
 SERIES N.R.S. No. 140
 SHEET 23 Nov 35