

1	TITLE PAGE	
2	TYPICAL CROSS SECTION OF IMPROVEMENT (	DOUBLE TACK COAT OF REFINED TAR
3	QUANTITY SHEET (ITEMS)	WITH PEASTONE SEAL, ITEM 312-A
4	QUANTITY SHEET (DRAINAGE)	
5-9	EARTHWORK SHEETS	
10-24	PLAN & PROFILE SHEETS	
25	ROADWAY STANDARD SHEET RS 56-1 (BANKING TABLES)	
26	" " RS 56-3 (MARKERS)	
27	" " RS 56-4 (DRAINAGE)	
28	" " RS 56-10 (TWO CABLE GUARD RAIL)	
29	" " RS 56-12 (BARRICADES, SIGNS & LIGHTS)	
30	STA. 250+74.5 NEW 126" X 92" C.G.M. PLATE PIPE	
31	STA. 390+29.0 NEW 9' X 4'-8 1/2" X 62" C.G.M. PLATE ARCH	
32		
33	REINFORCING STEEL SCHEDULE FOR STA. 390+29	
34-73	CROSS SECTION SHEETS	

STATE OF VERMONT
DEPARTMENT OF HIGHWAYS

PROPOSED IMPROVEMENT

FEDERAL AID
SECONDARY PROJECT


TOWNS OF JERICHO & RICHMOND

COUNTY OF CHITTENDEN

ESSEX JCT. ~ RICHMOND ROAD

VERMONT ROUTE 117

BEGINNING AT THE ESSEX - JERICO TOWN LINE AND EXTENDING
SOUTHERLY 3.528 MILES ✓
LENGTH OF PROJECT 18,573.6 FEET = 3.518 MILES

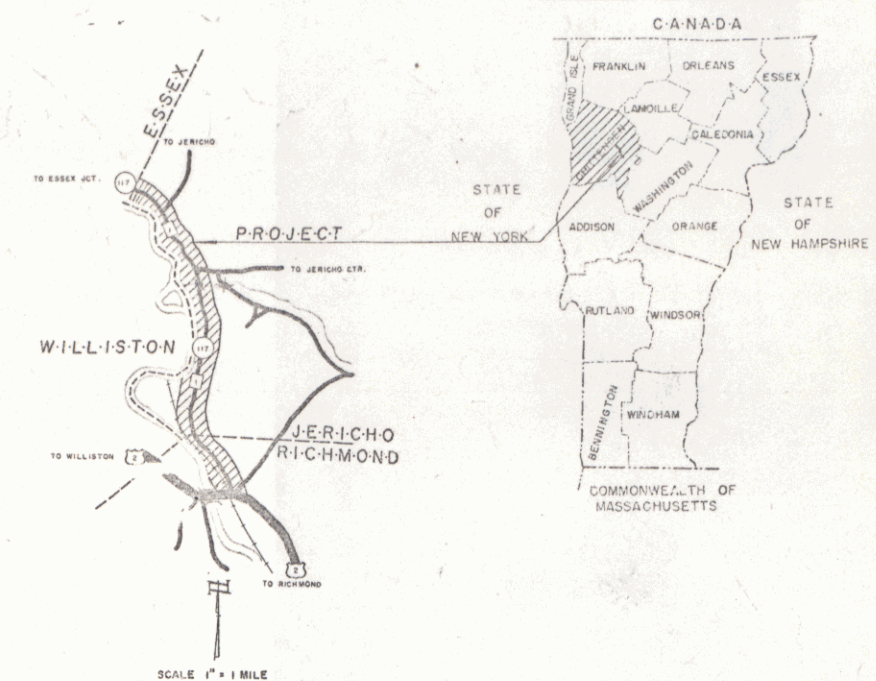


RIGHT-OF-WAY DIVISION

TOWN FILE

PERPETUAL

Plc
Town of 4117

(To Be Returned To R.O.W. Division)

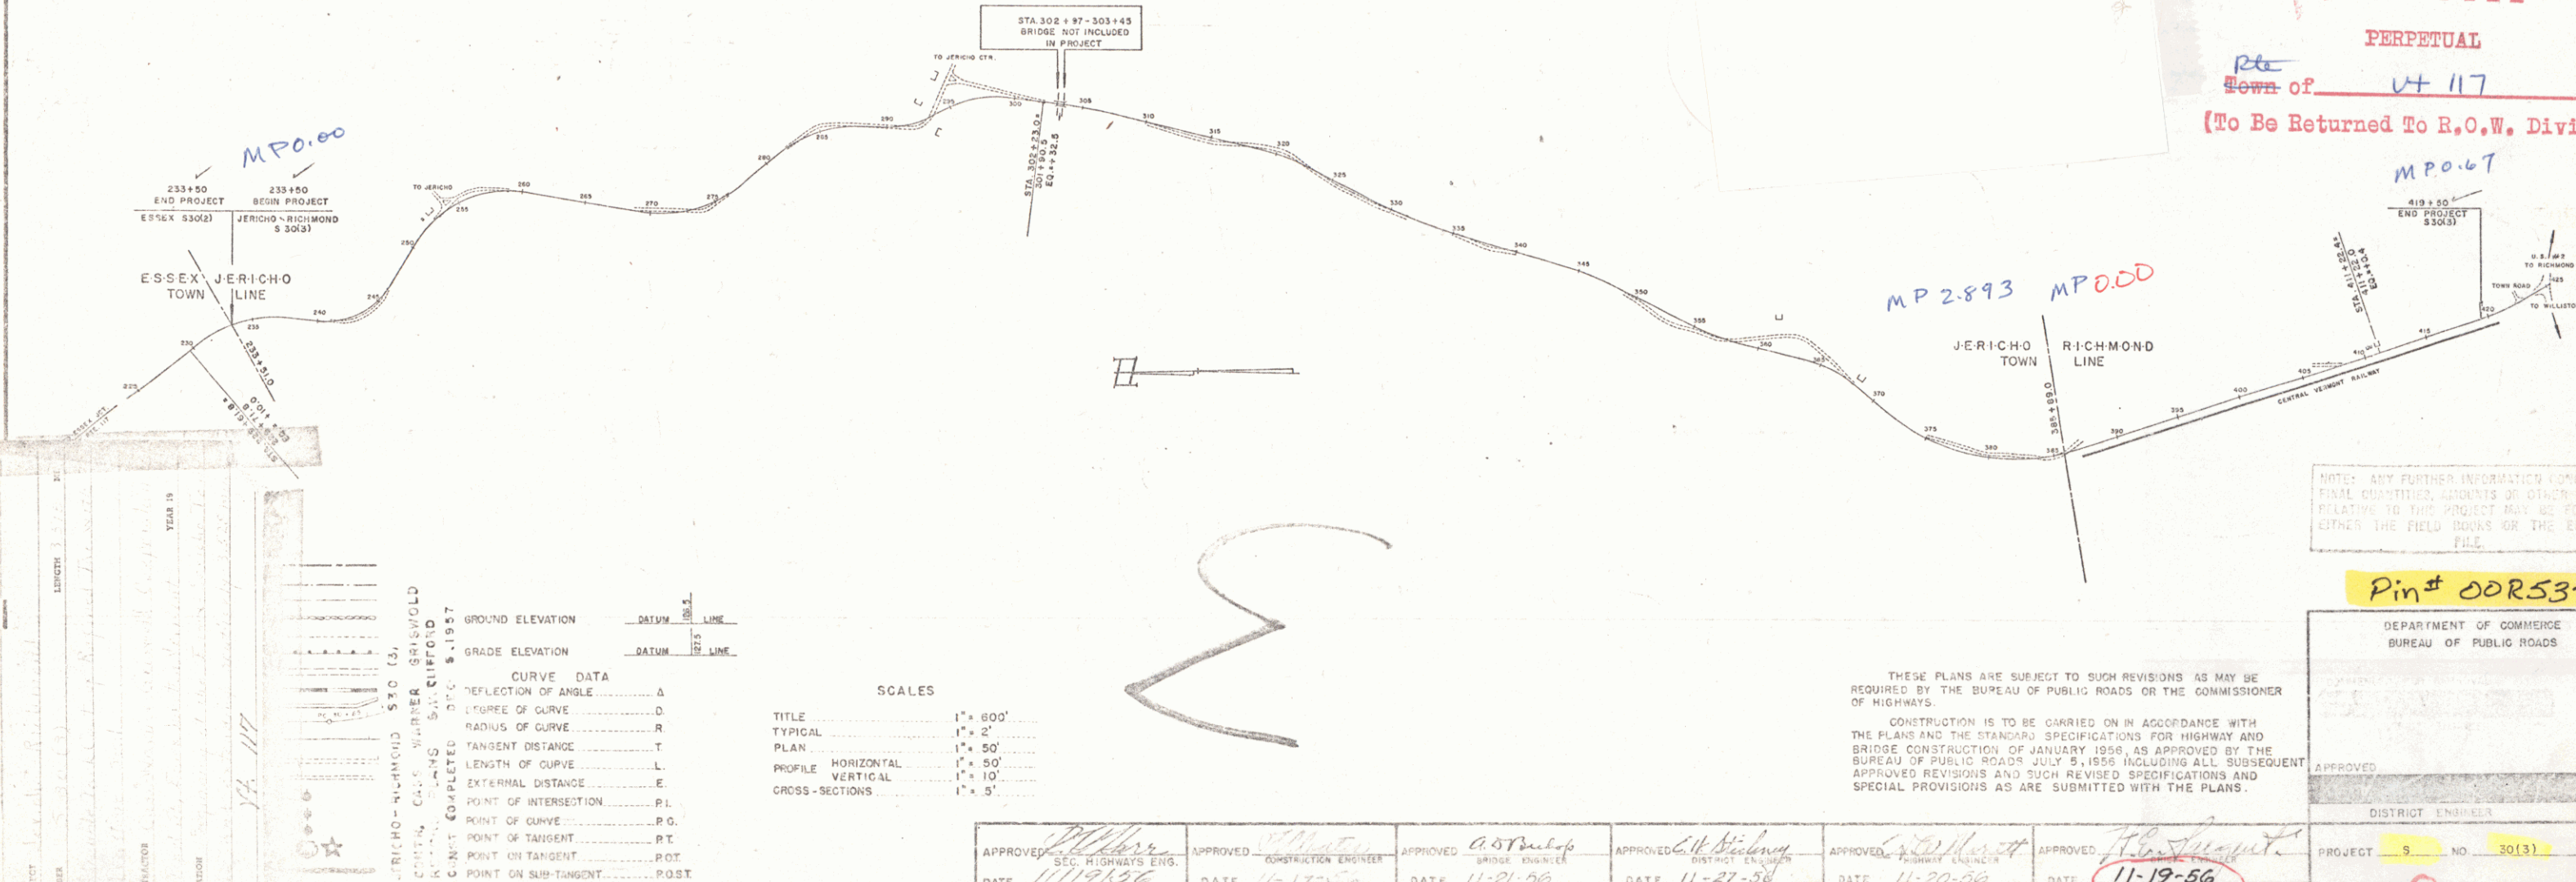

Pin# 00R532

DEPARTMENT OF COMMERCE
BUREAU OF PUBLIC ROADS

THESE PLANS ARE SUBJECT TO SUCH REVISIONS AS MAY BE
REQUIRED BY THE BUREAU OF PUBLIC ROADS OR THE COMMISSIONER
OF HIGHWAYS.


CONSTRUCTION IS TO BE CARRIED ON IN ACCORDANCE WITH THE PLANS AND THE STANDARD SPECIFICATIONS FOR HIGHWAY AND BRIDGE CONSTRUCTION OF JANUARY 1956, AS APPROVED BY THE BUREAU OF PUBLIC ROADS JULY 5, 1956 INCLUDING ALL SUBSEQUENT APPROVED REVISIONS AND SUCH REVISED SPECIFICATIONS AND SPECIAL PROVISIONS AS ARE SUBMITTED WITH THE PLANS.

DISTRICT ENGINEER DATE

PROJECT S NO. 30(3)


SHEET 1 OF 79 SHEETS

117

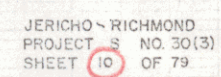

DATE	12/74
BY	JR
CHECKED	JR
APPROVED	JR
TRACED	JR



DATE	12/74
BY	JR
CHECKED	JR
APPROVED	JR
TRACED	JR

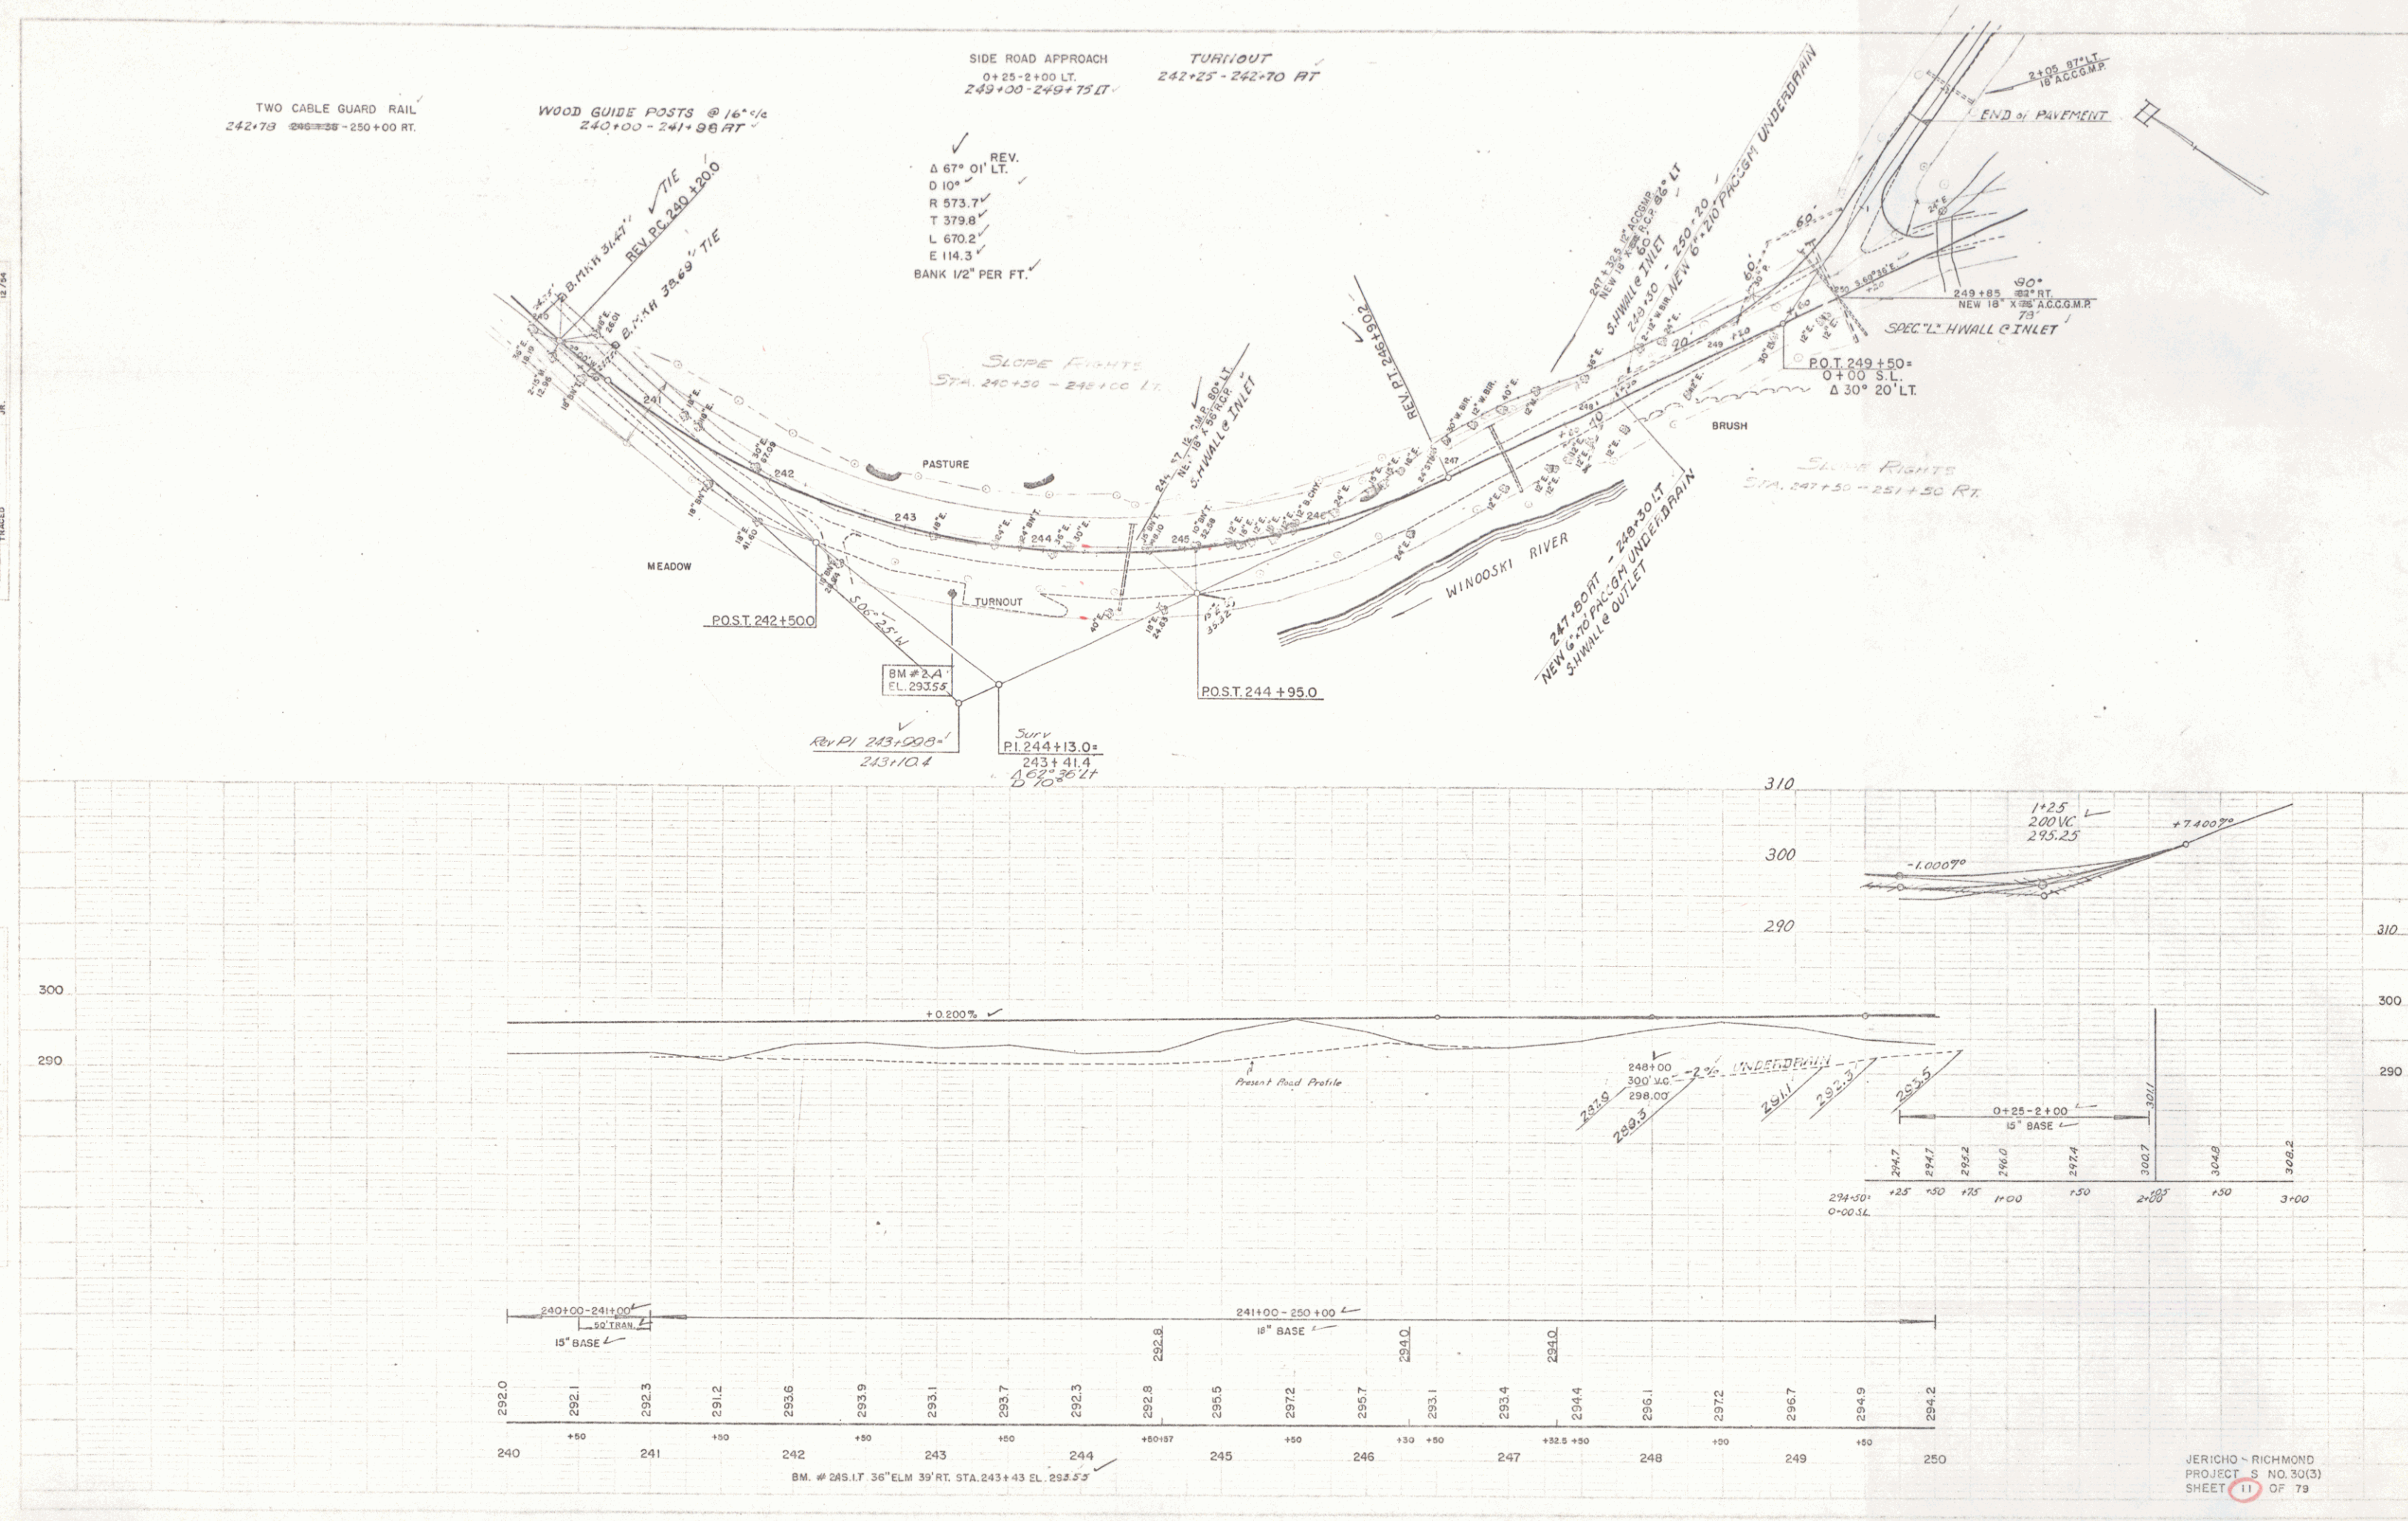



JERICHO - RICHMOND
PROJECT S NO. 30(3)
SHEET 11 OF 79


PLAN
 DATE 10/1/55
 DRAWN BY J. R. SUMNER
 CHECKED BY J. R. SUMNER
 TRACED BY J. R. SUMNER


PROFILE
 DATE 10/1/55
 DRAWN BY J. R. SUMNER
 CHECKED BY J. R. SUMNER
 TRACED BY J. R. SUMNER

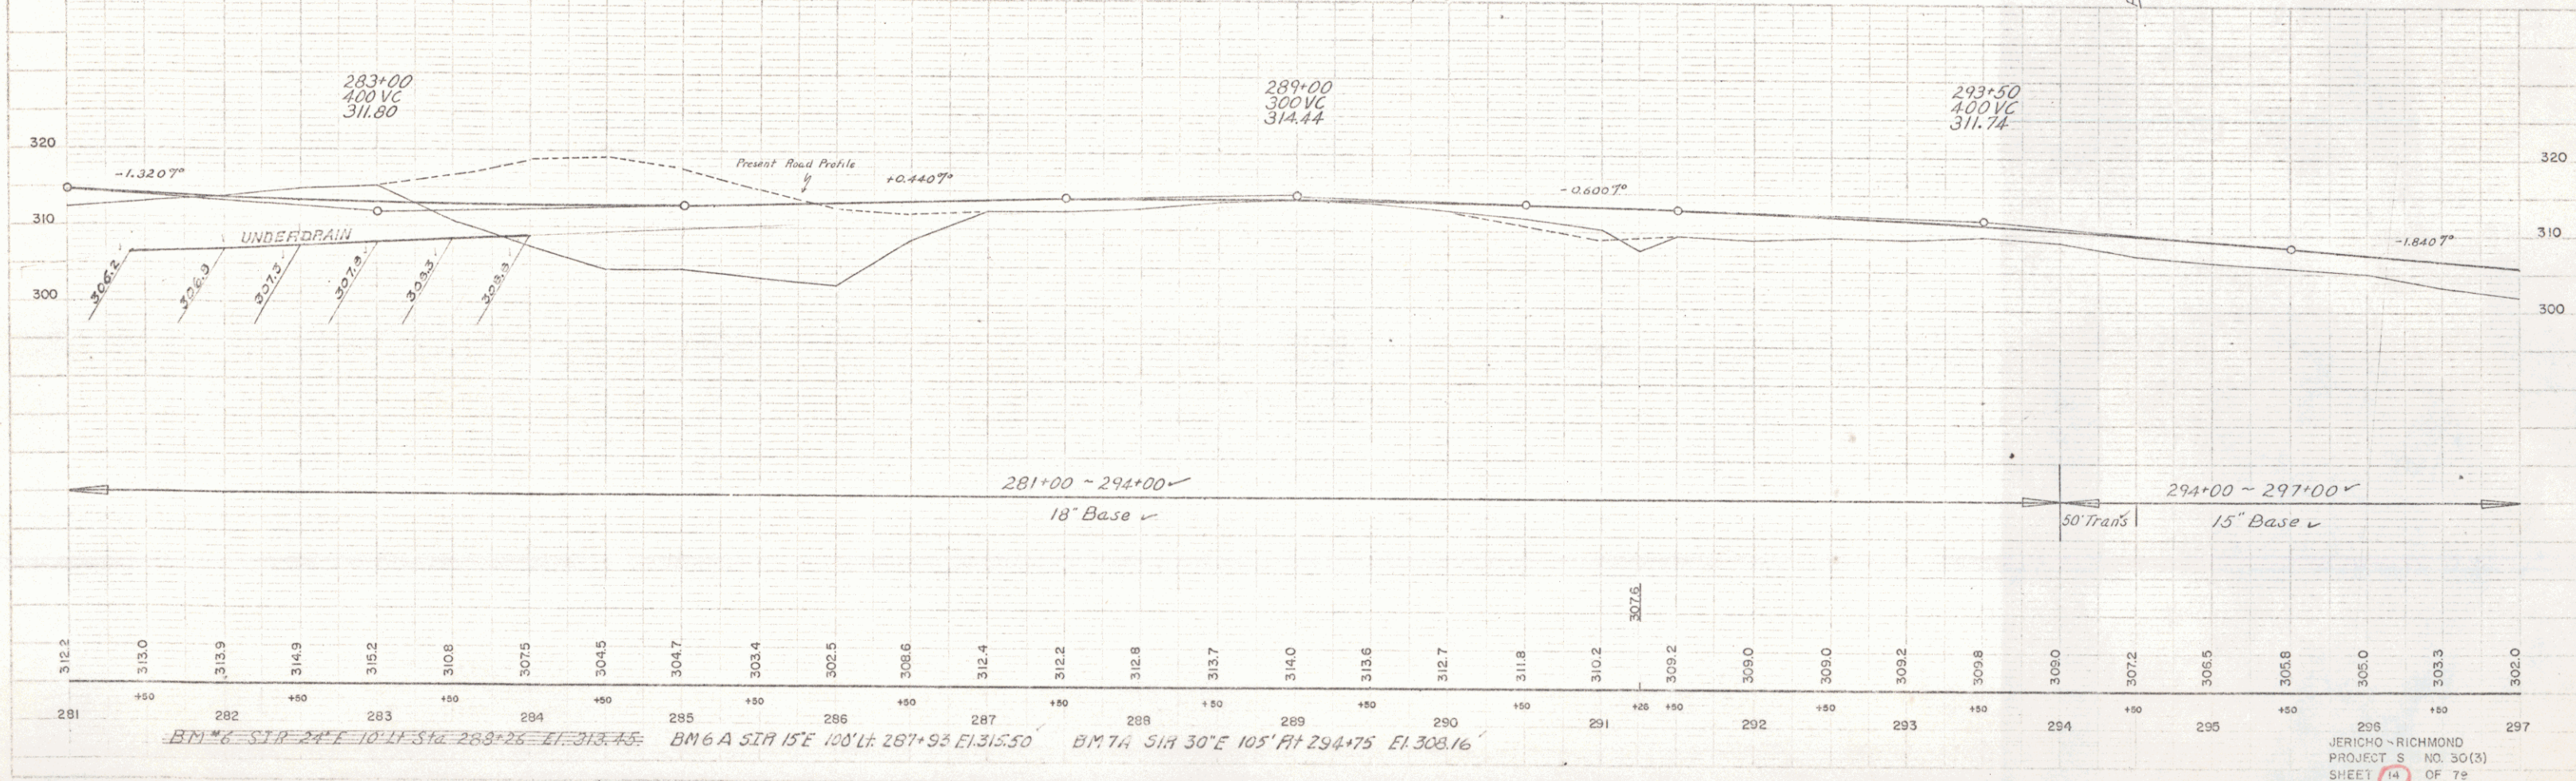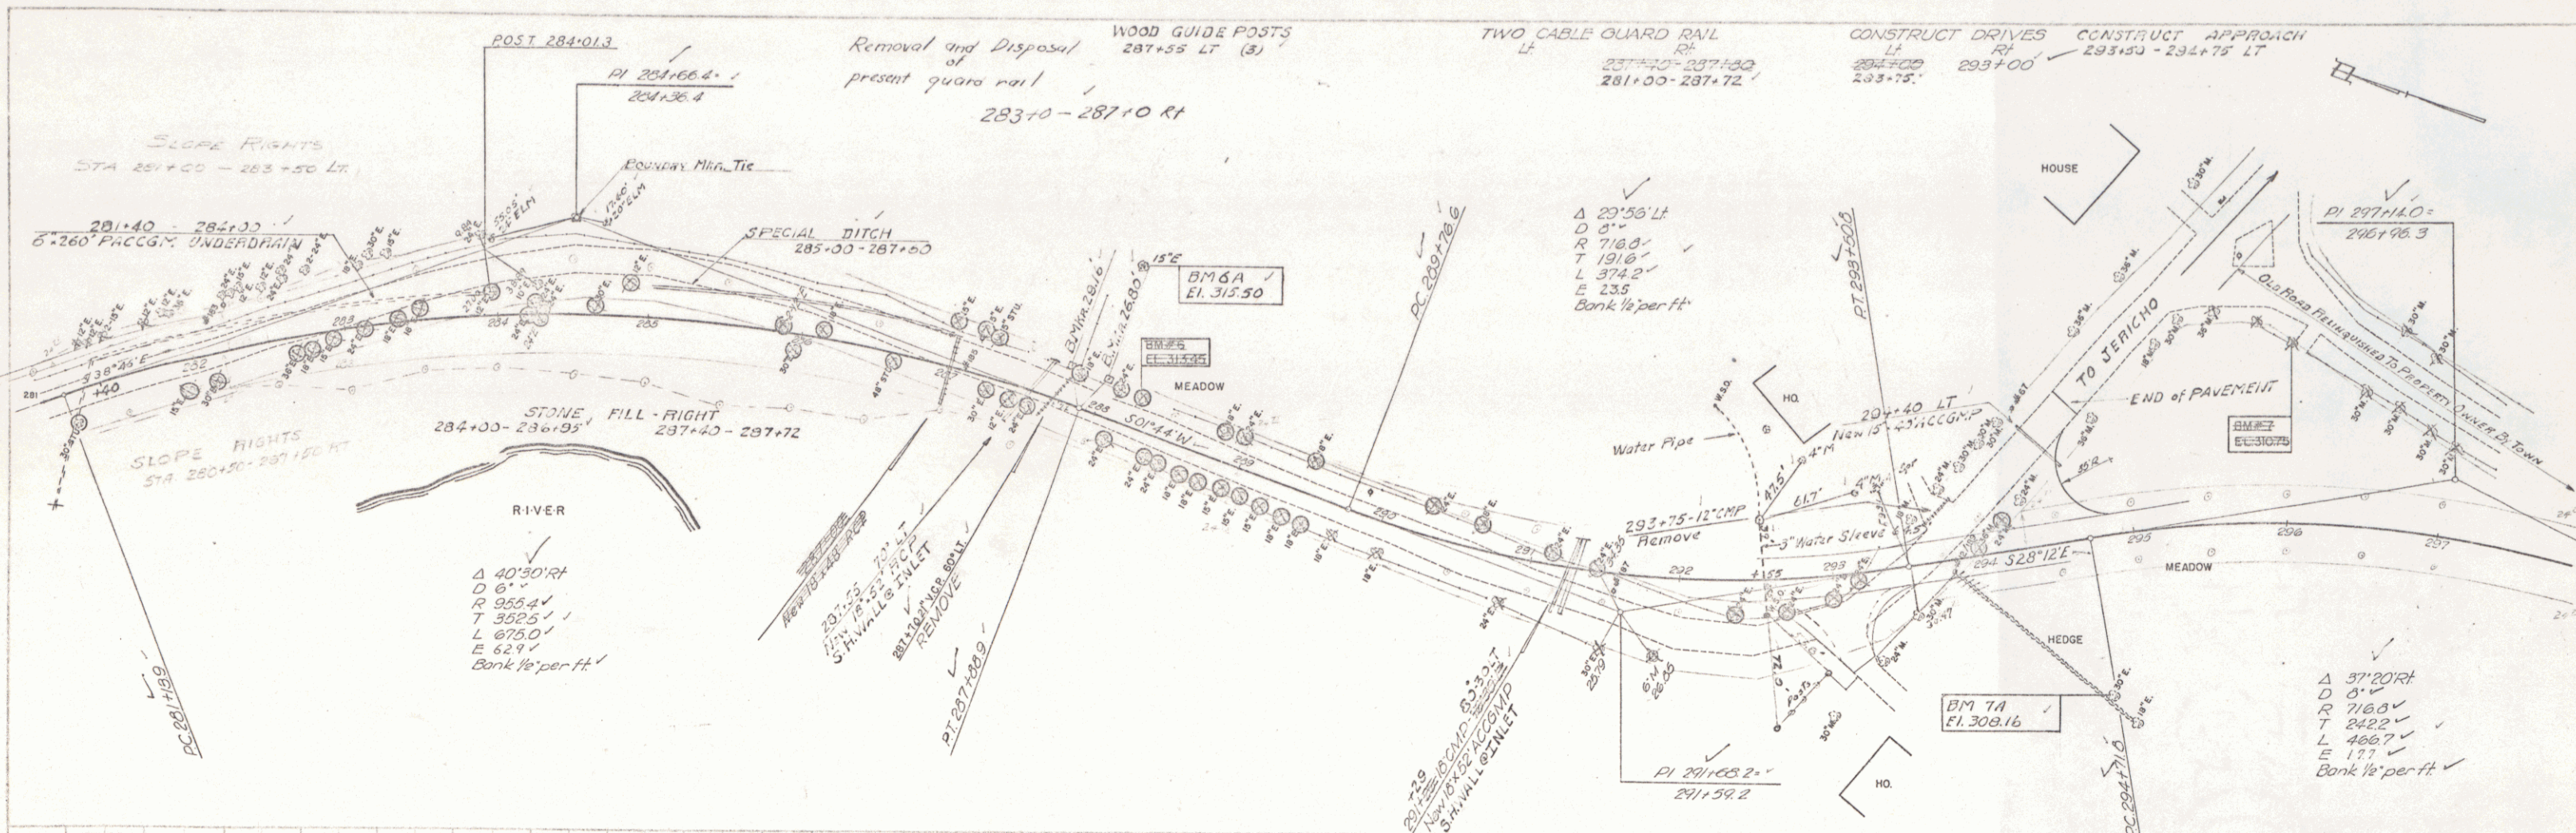

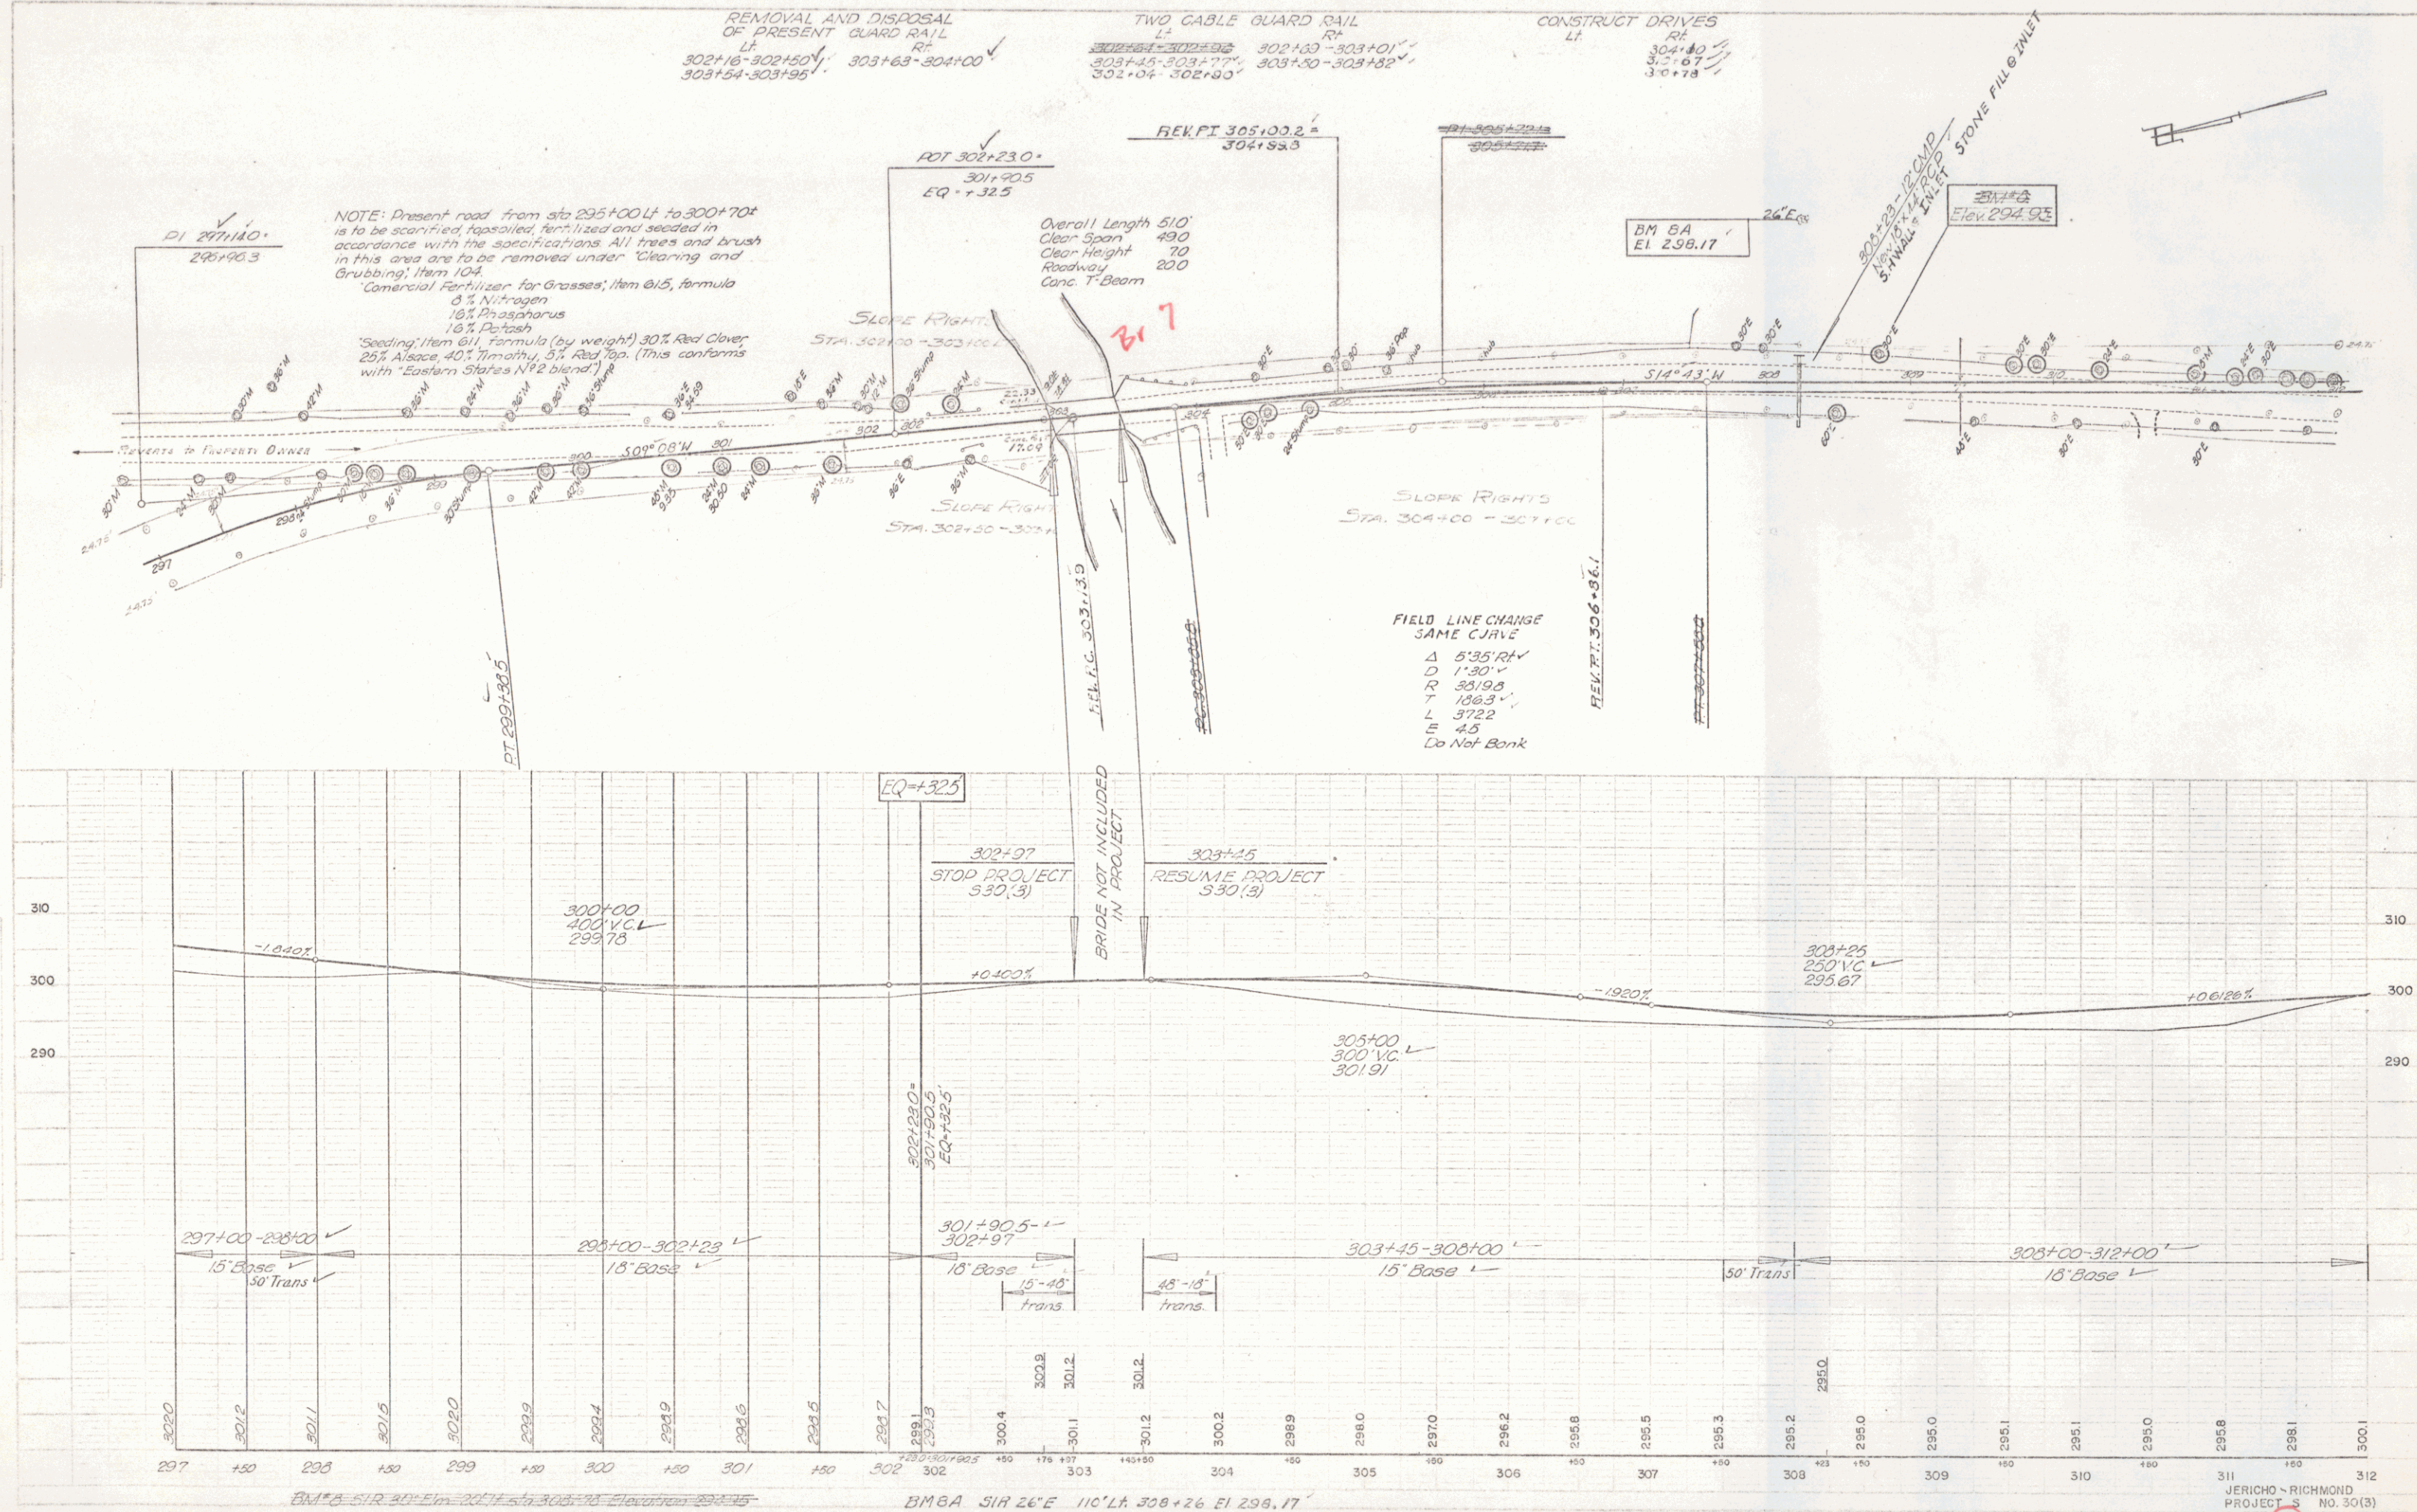

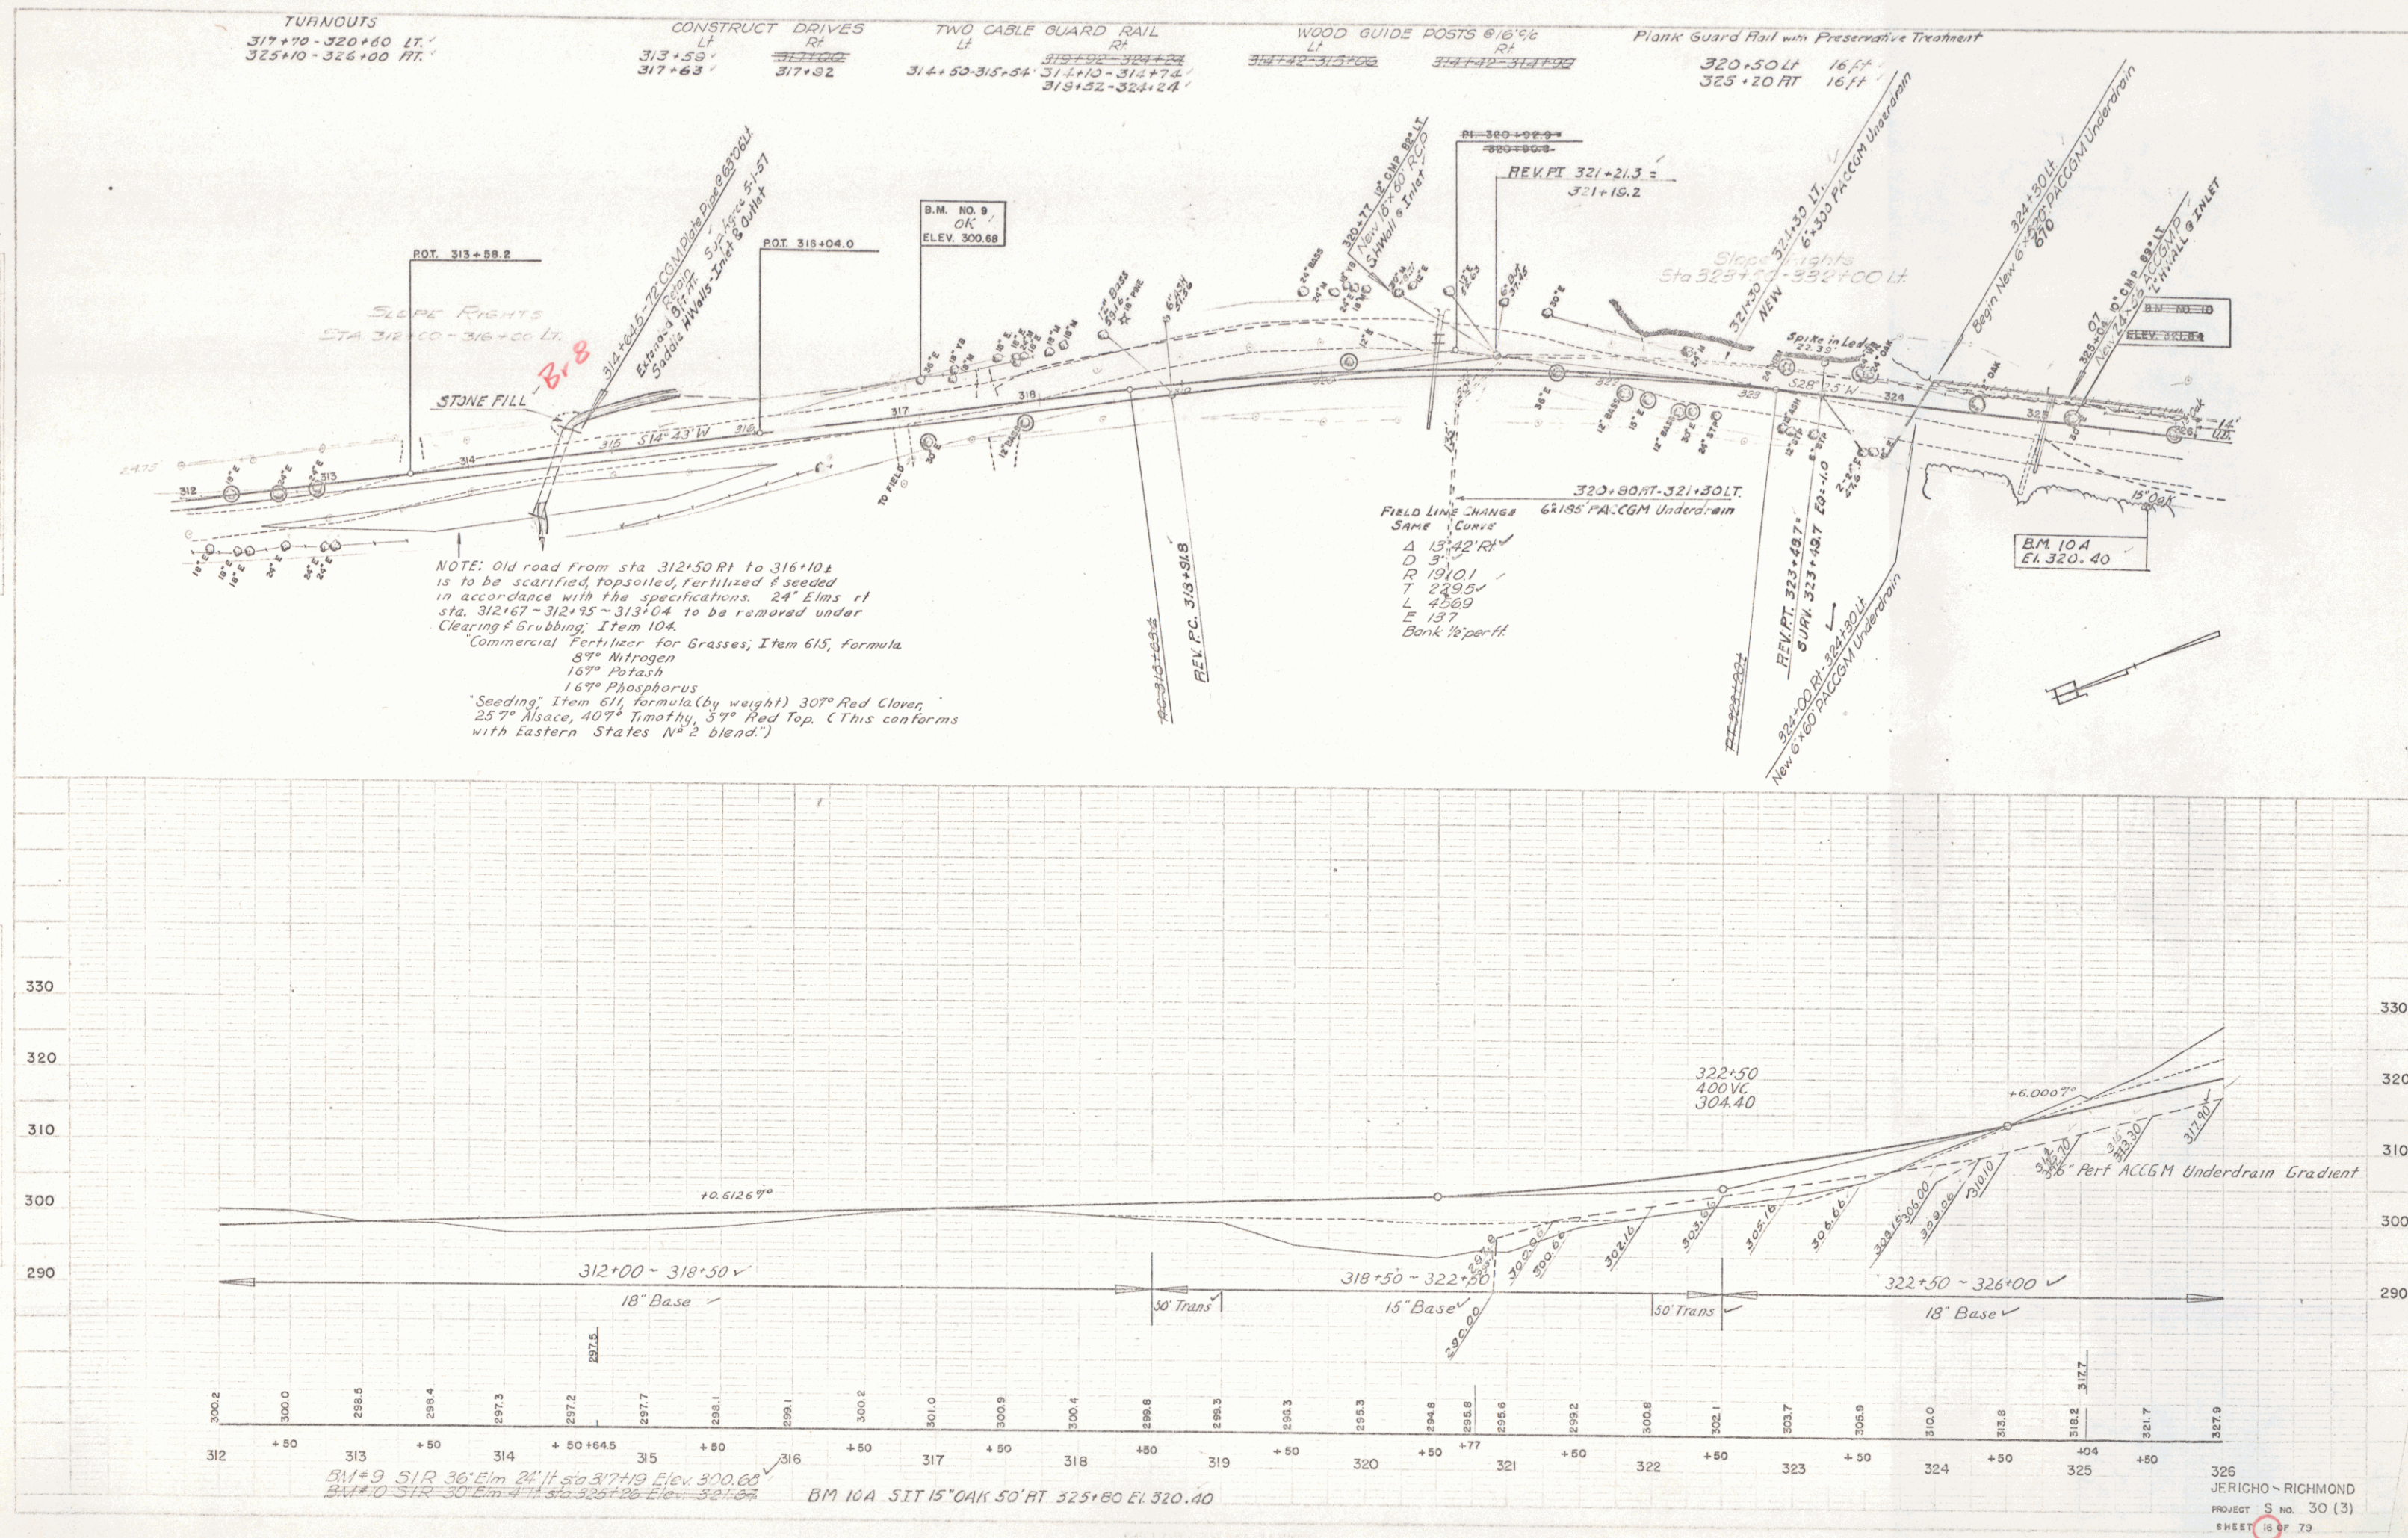


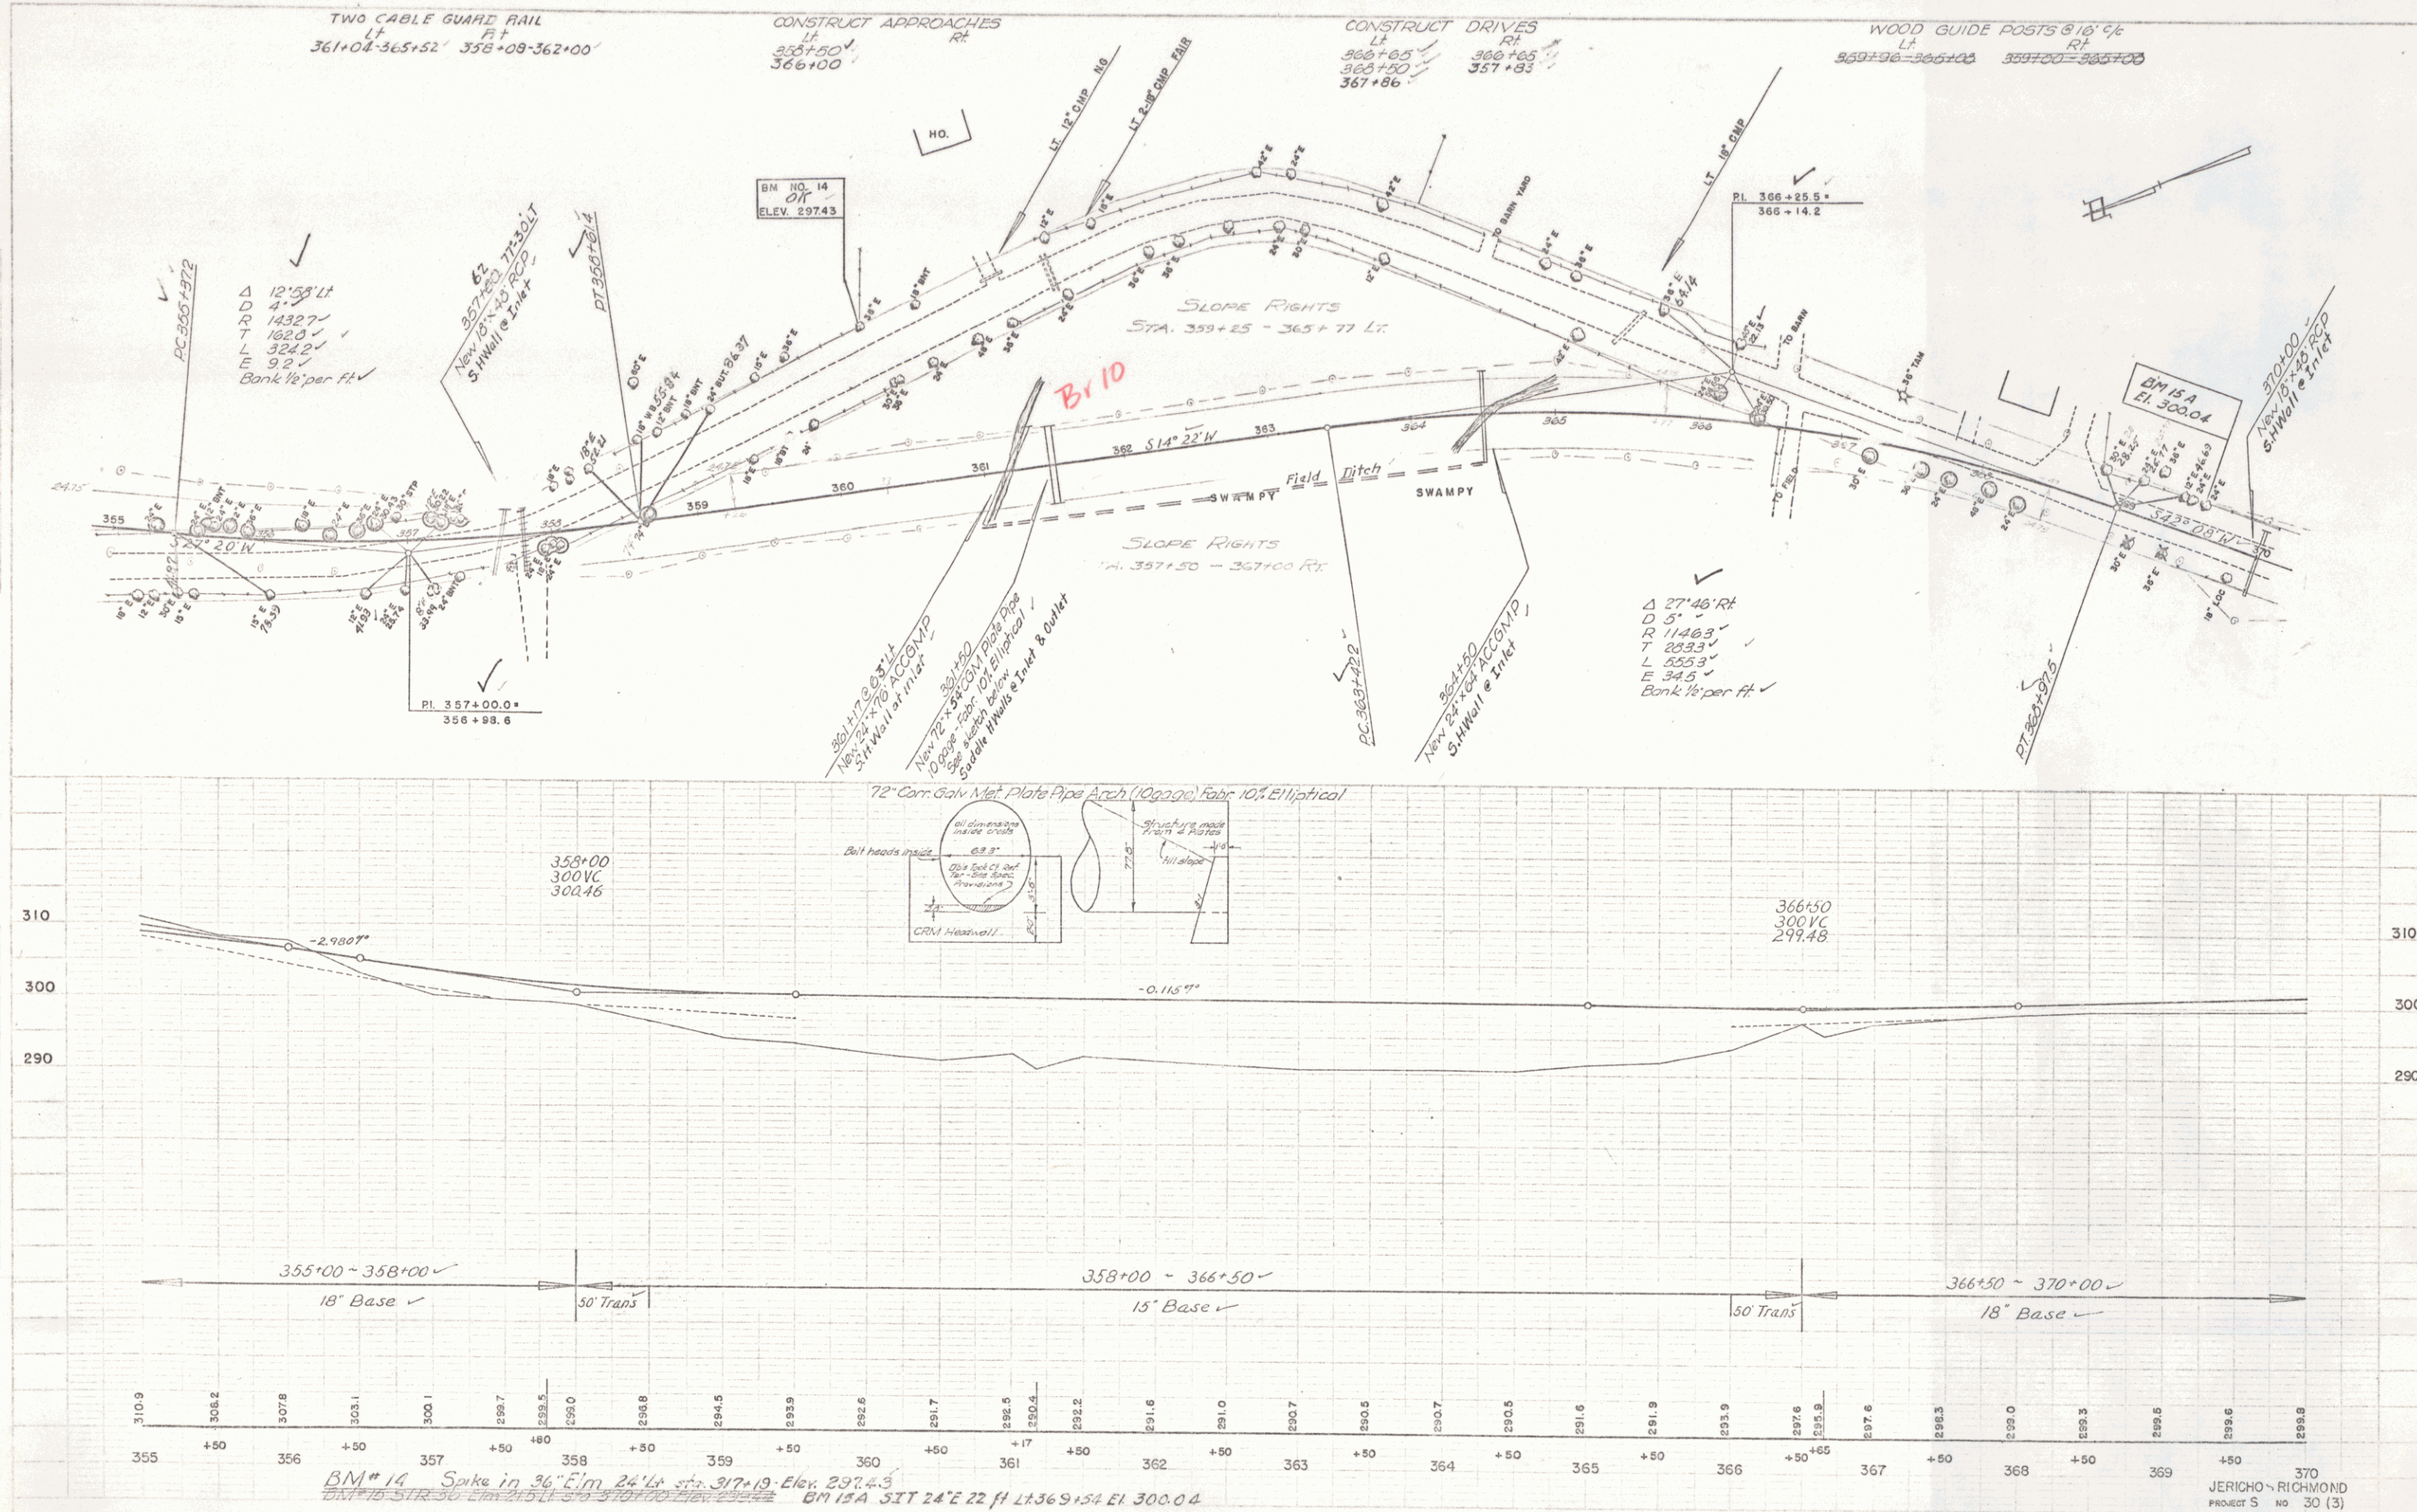

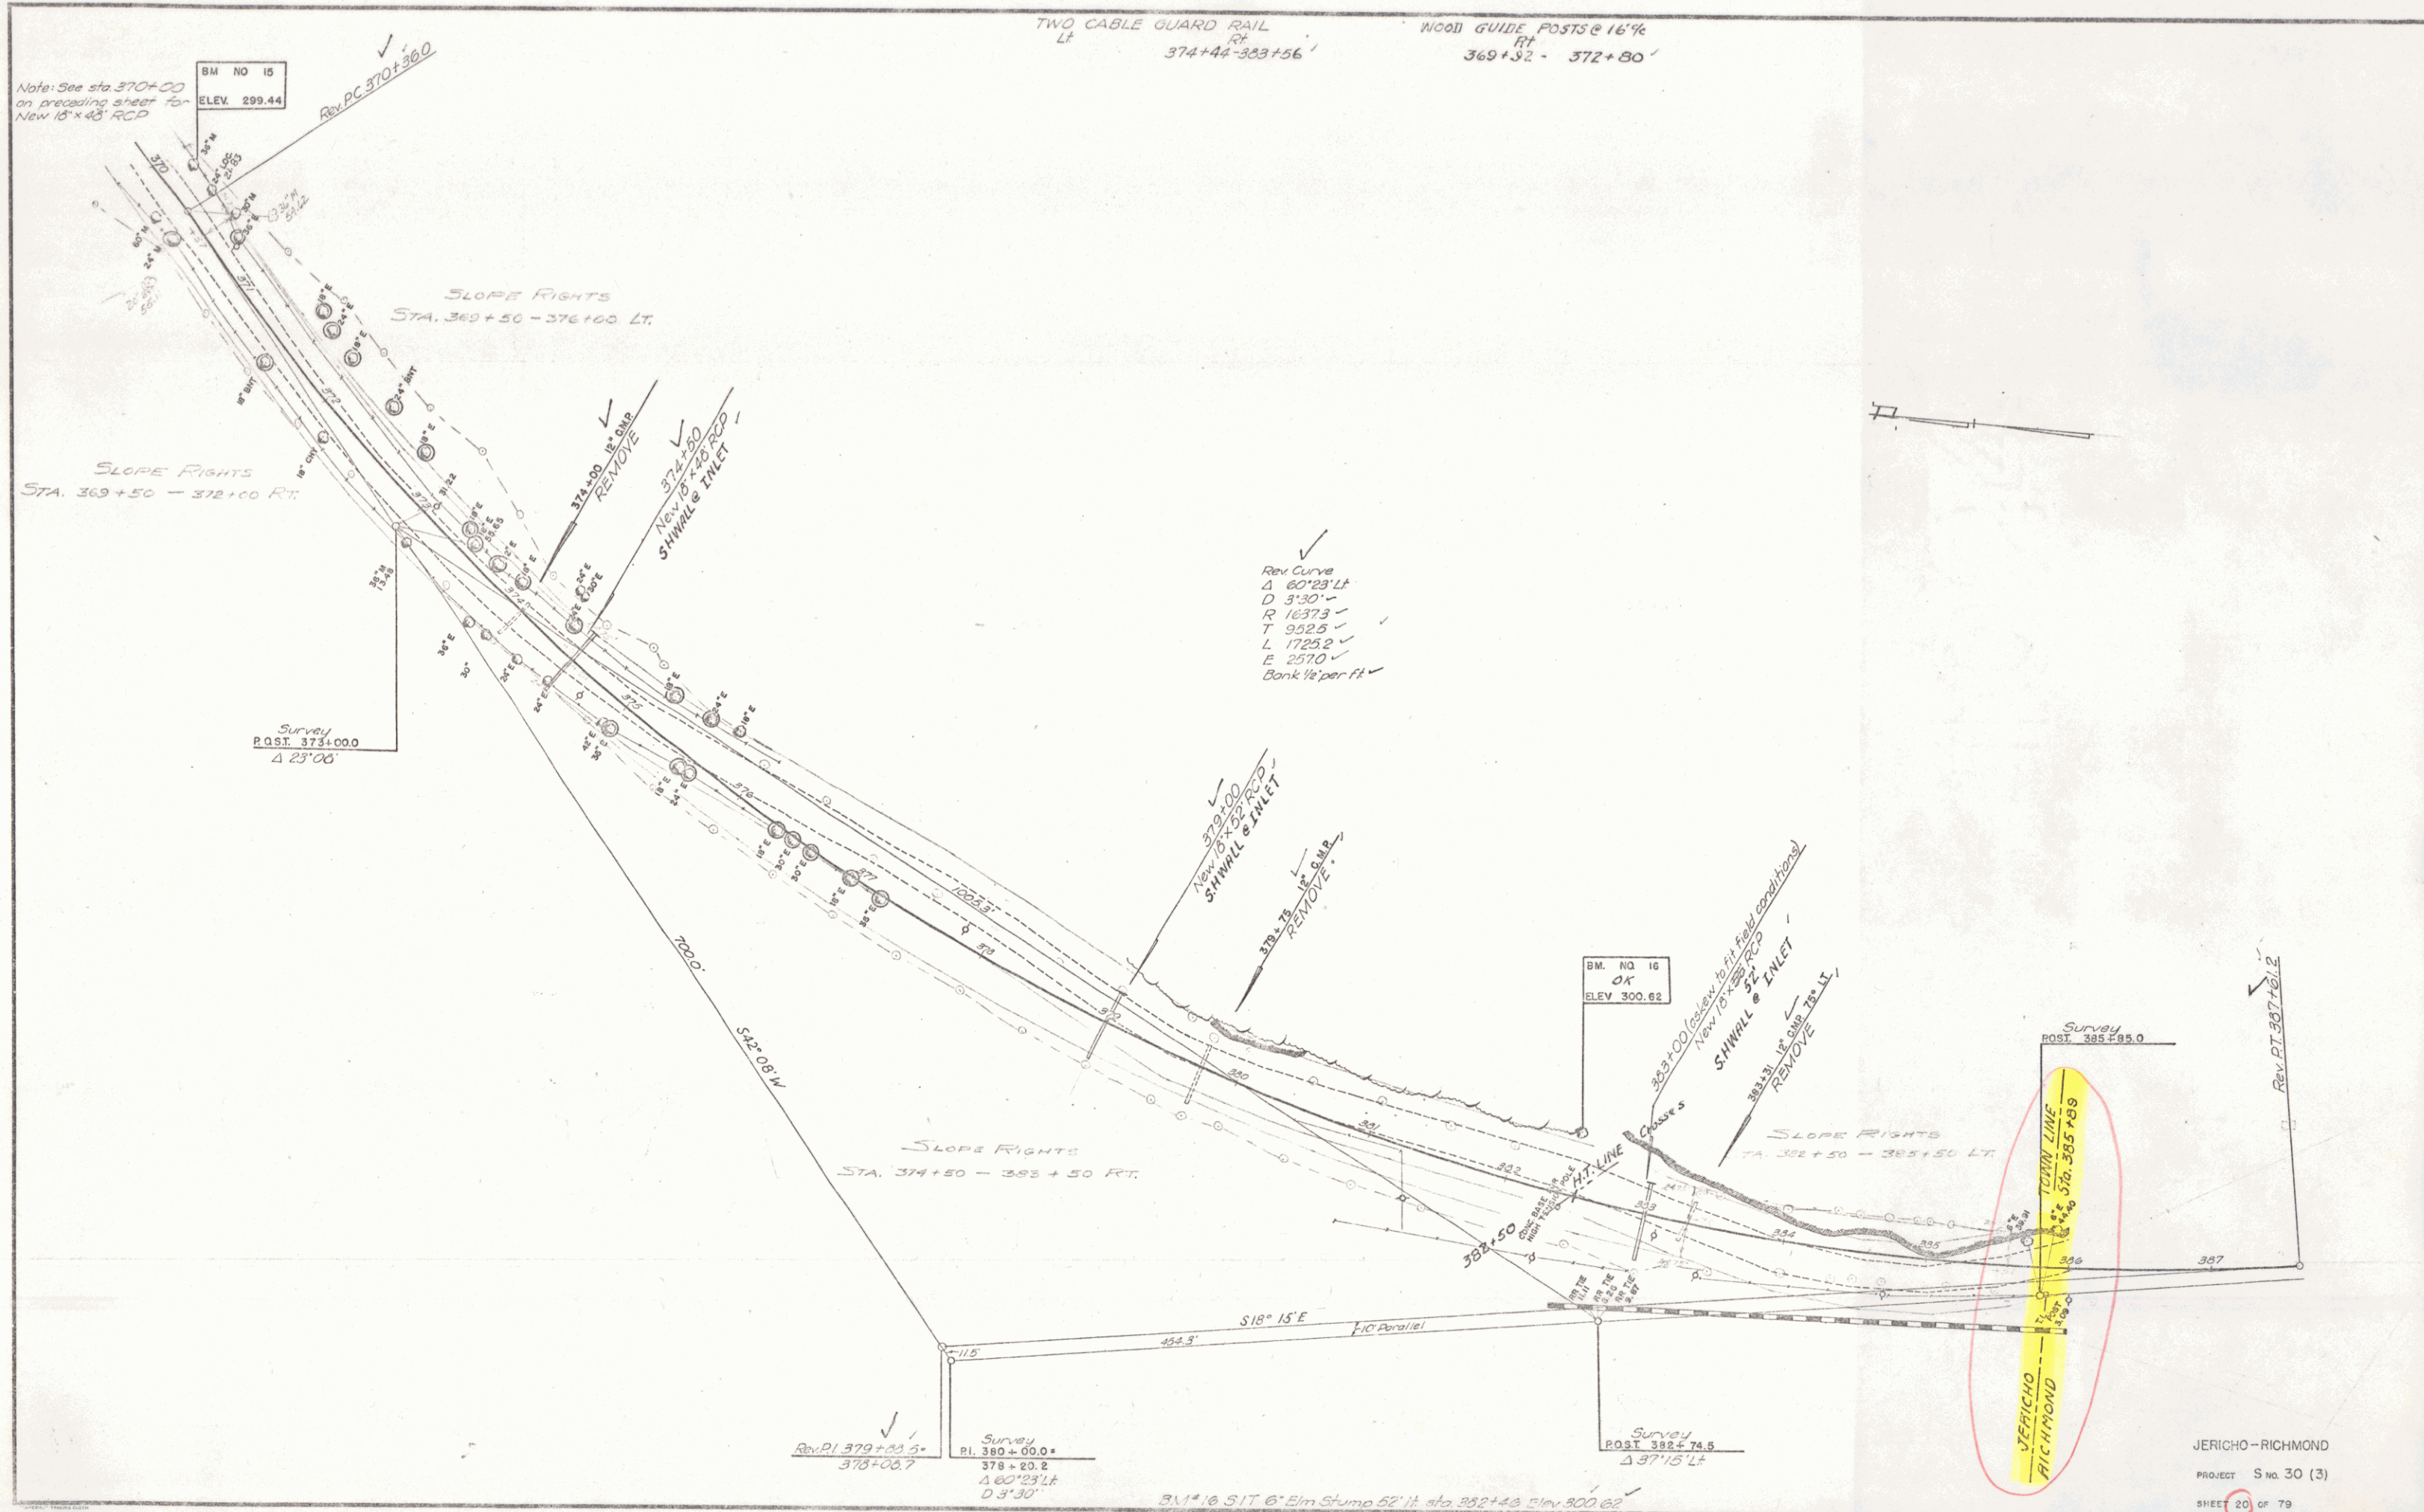


PLAN
 DATE 2008
 BY J. J. J. J. J.

PROFILE
 DATE 2008
 BY J. J. J. J. J.

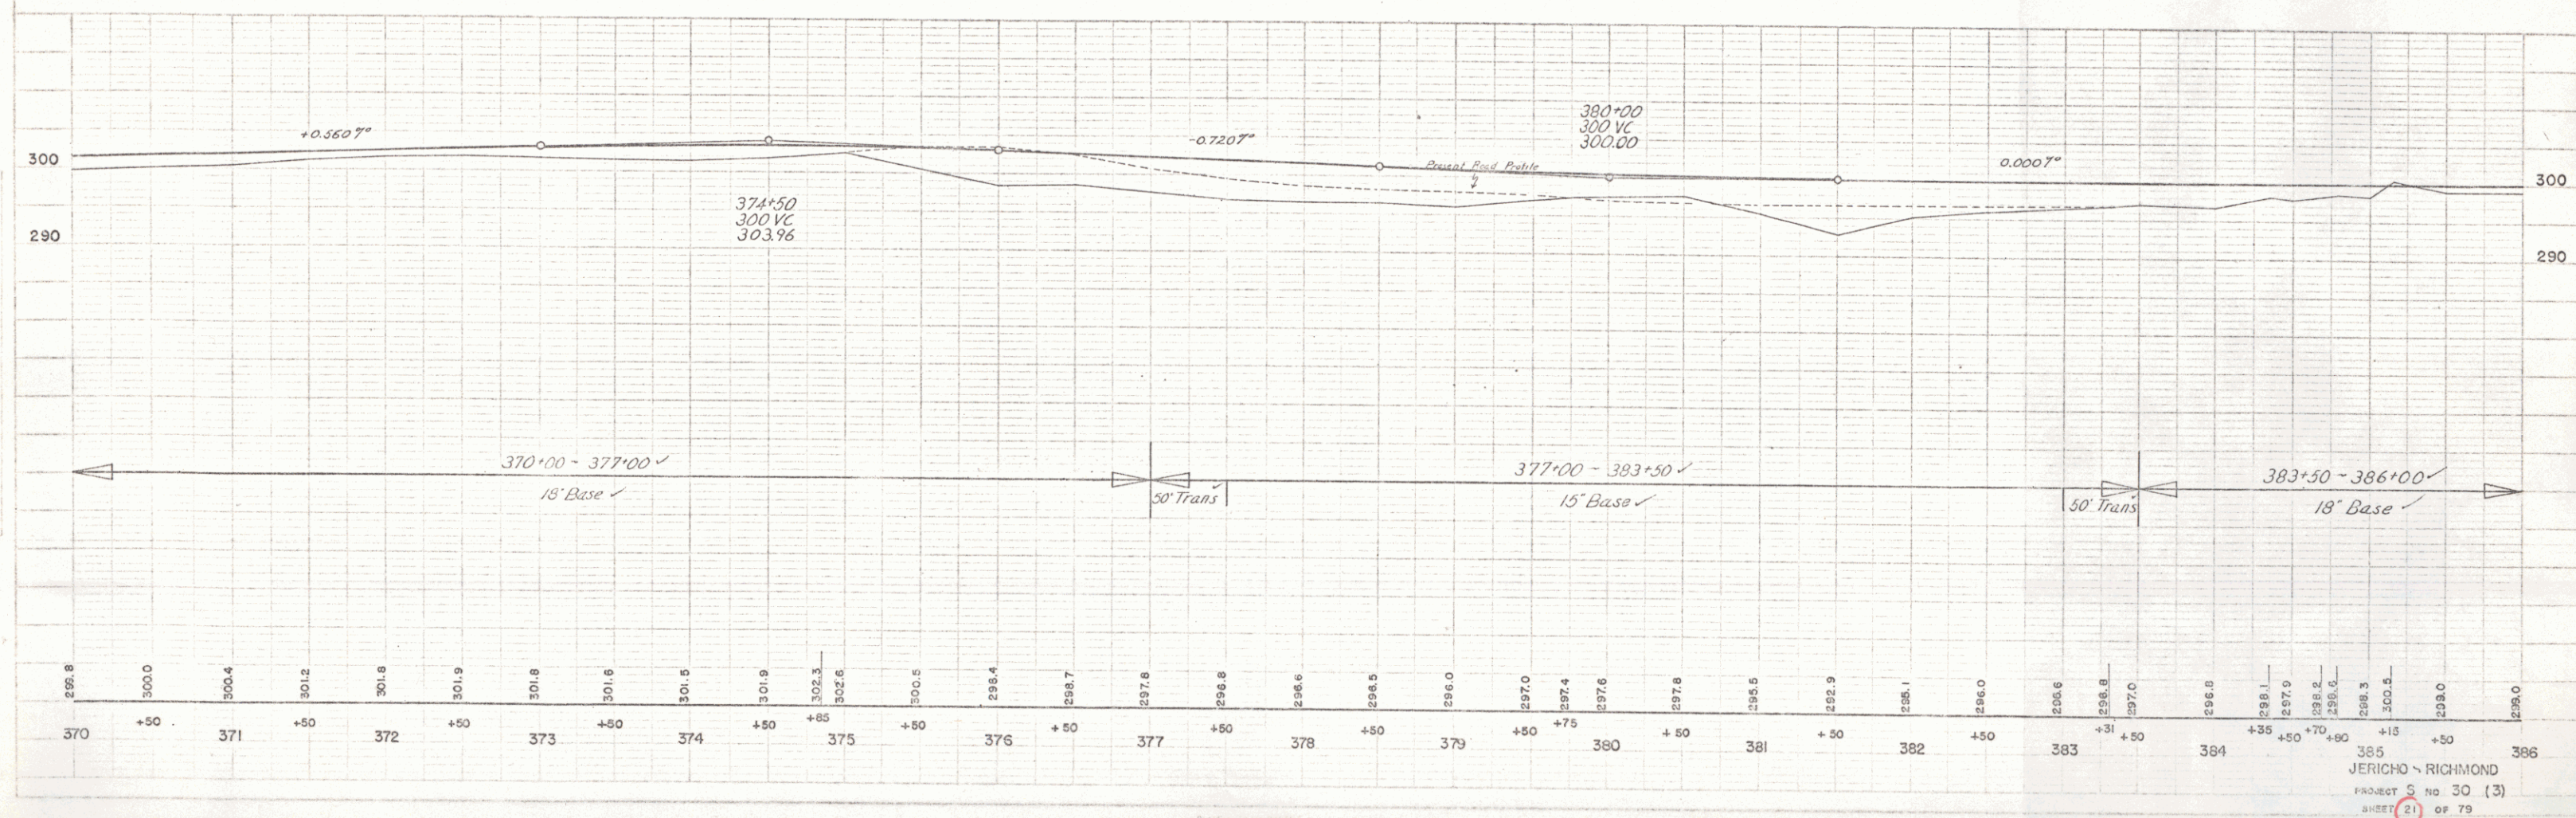


385
 JERICHO - RICHMOND
 PROJECT 5 NO 30 (3)
 SHEET 21 OF 79

PLAN
 SHEET NO. 30(3)
 PROJECT NO. 5
 DATE 1/28
 DRAWN BY AGS
 CHECKED BY

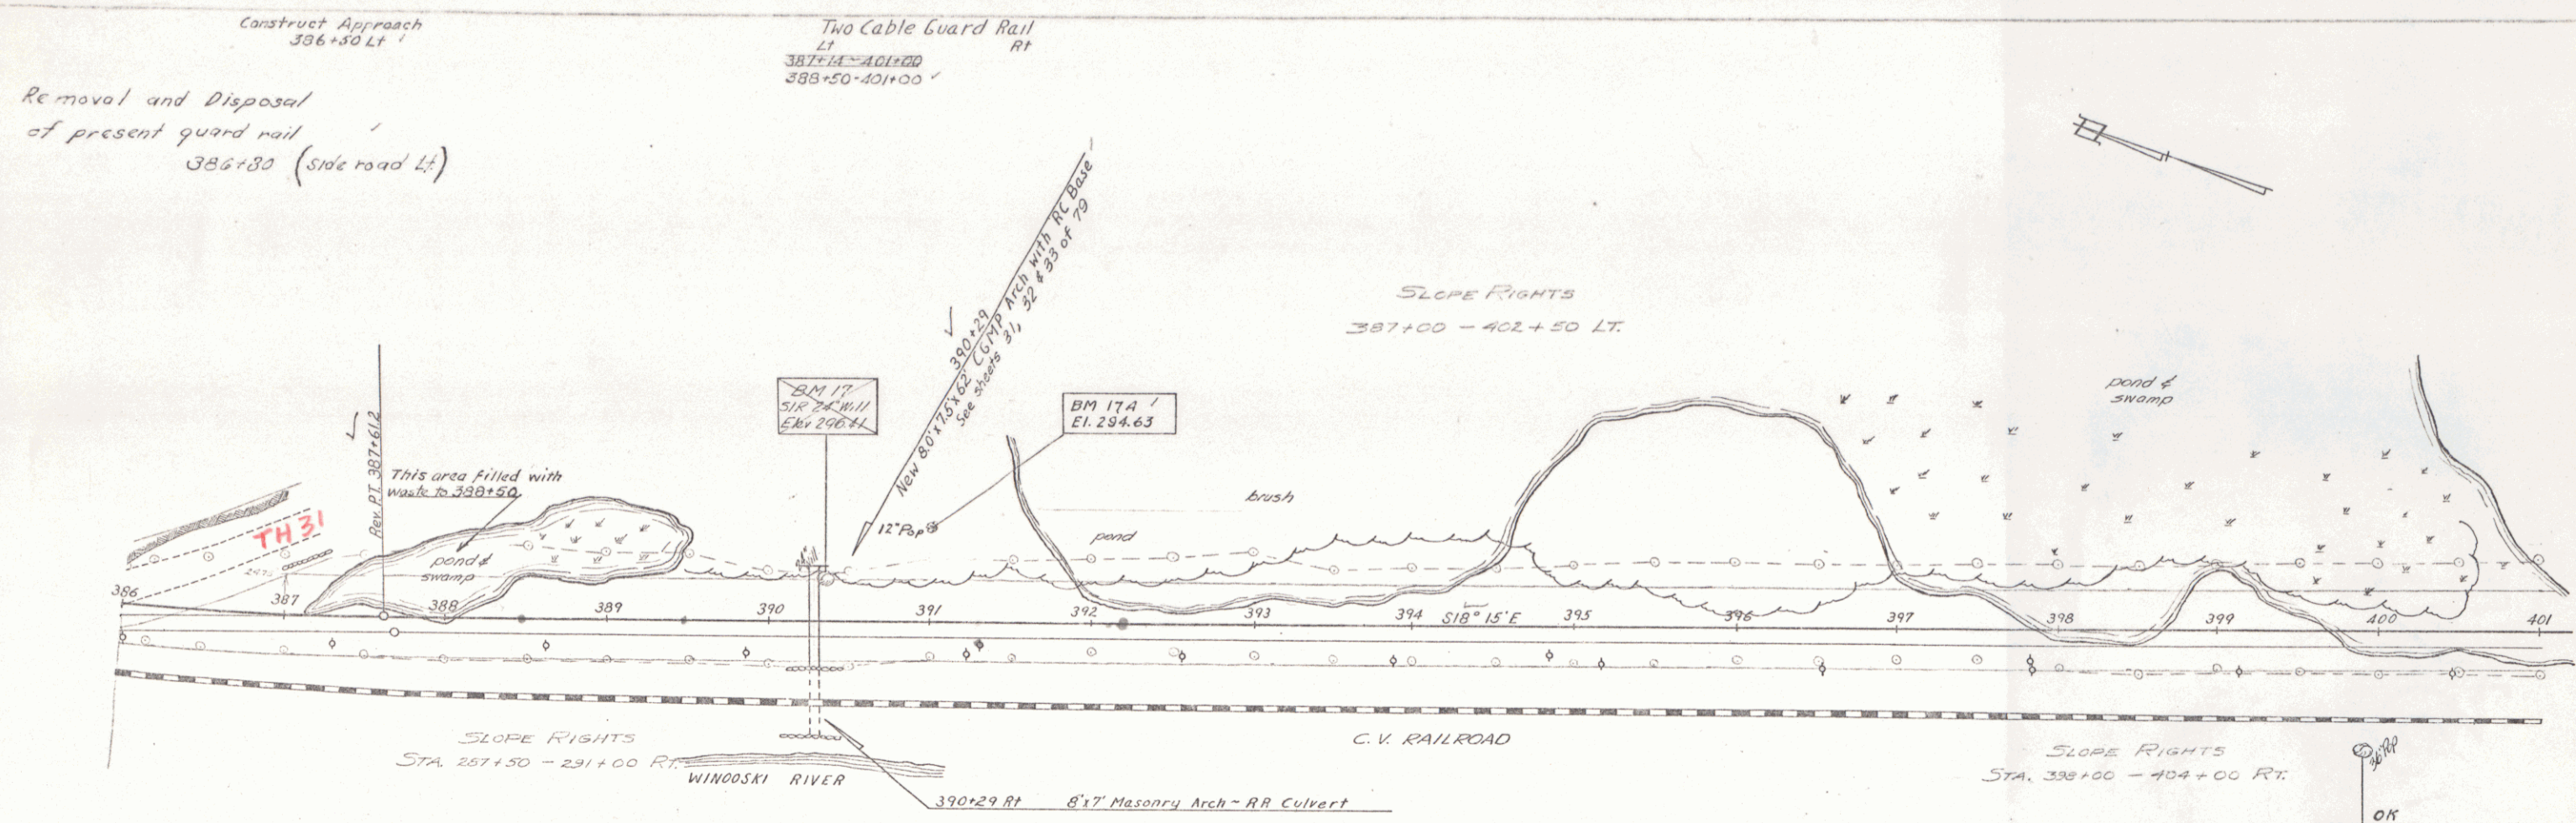



ACQUIRED FROM LOUIS A. & LILLIAN L. MARTELL
BY W.D. DATED APRIL 29, 1963 & RECORDED IN BK. 25 PG. 193.

STATE OF VERMONT TO
R.L. AND M.E. RODGERS BY
QCD ON 9/13/78 IN BK 35/71
MP 0005

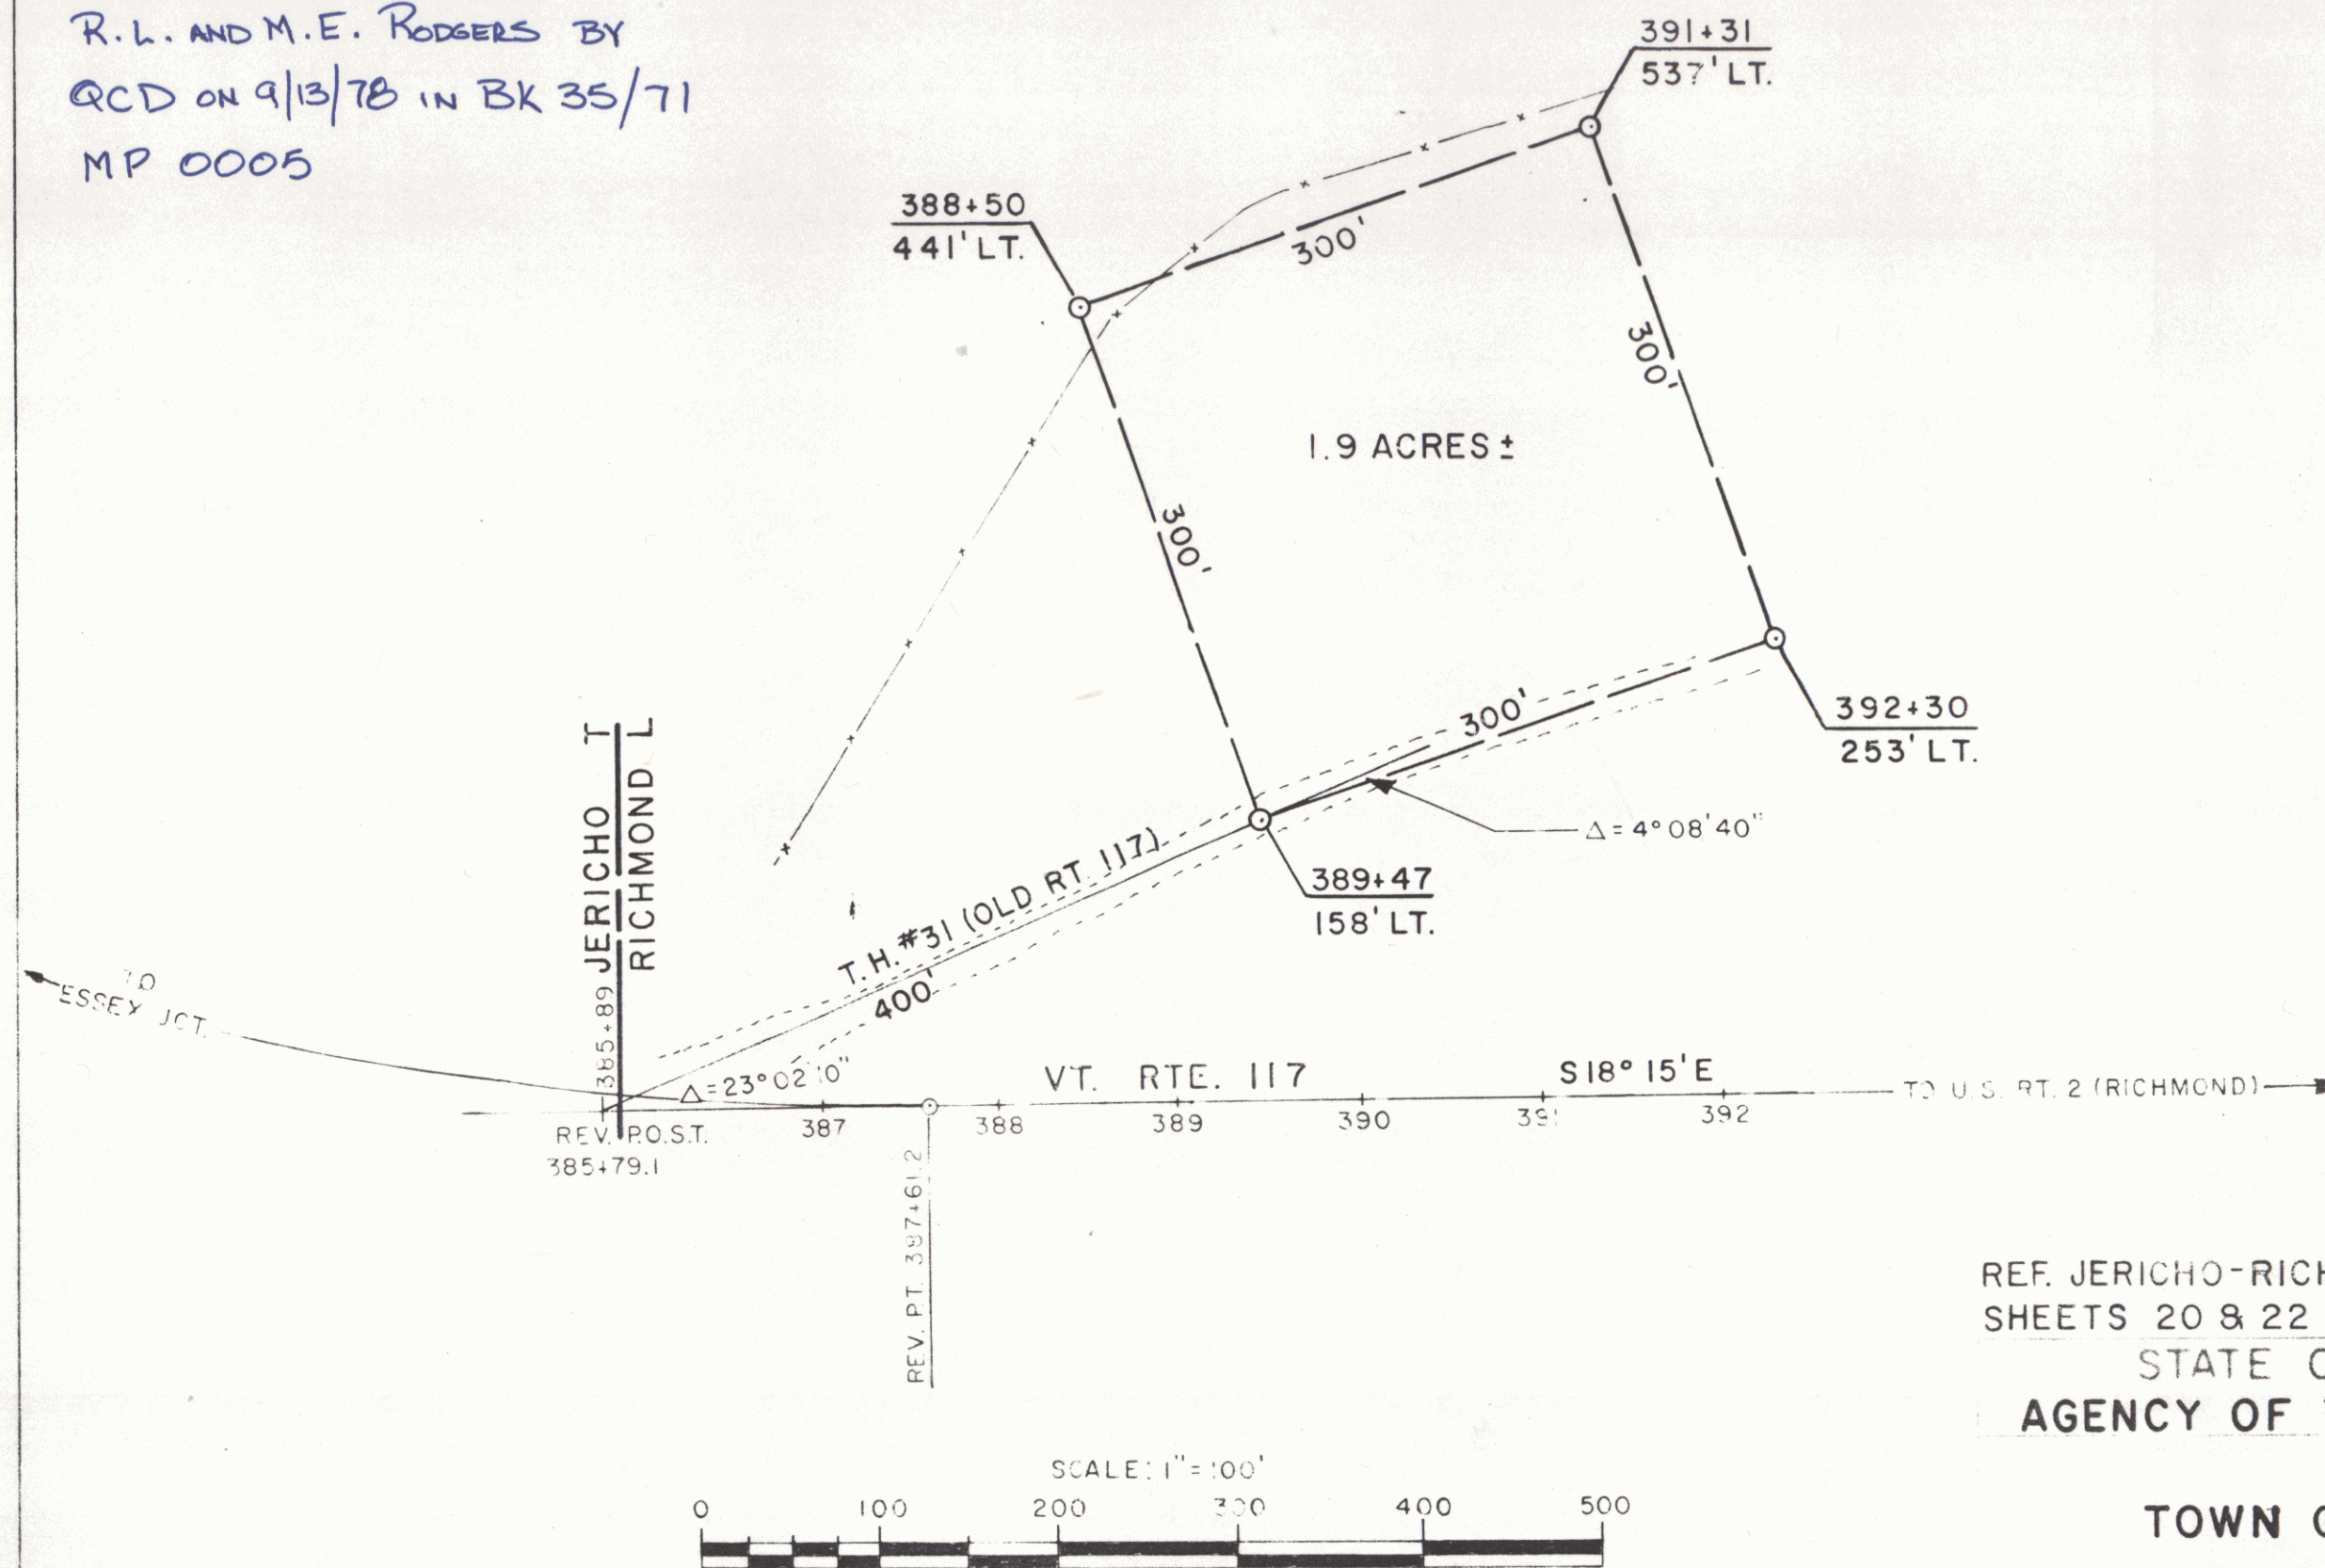

REF. JERICHO-RICHMOND S 30 (3)
SHEETS 20 & 22 OF 79
STATE OF VERMONT
AGENCY OF TRANSPORTATION
TOWN OF RICHMOND

DATE 8-9-78
DRAWN BY
P. J. HARDY

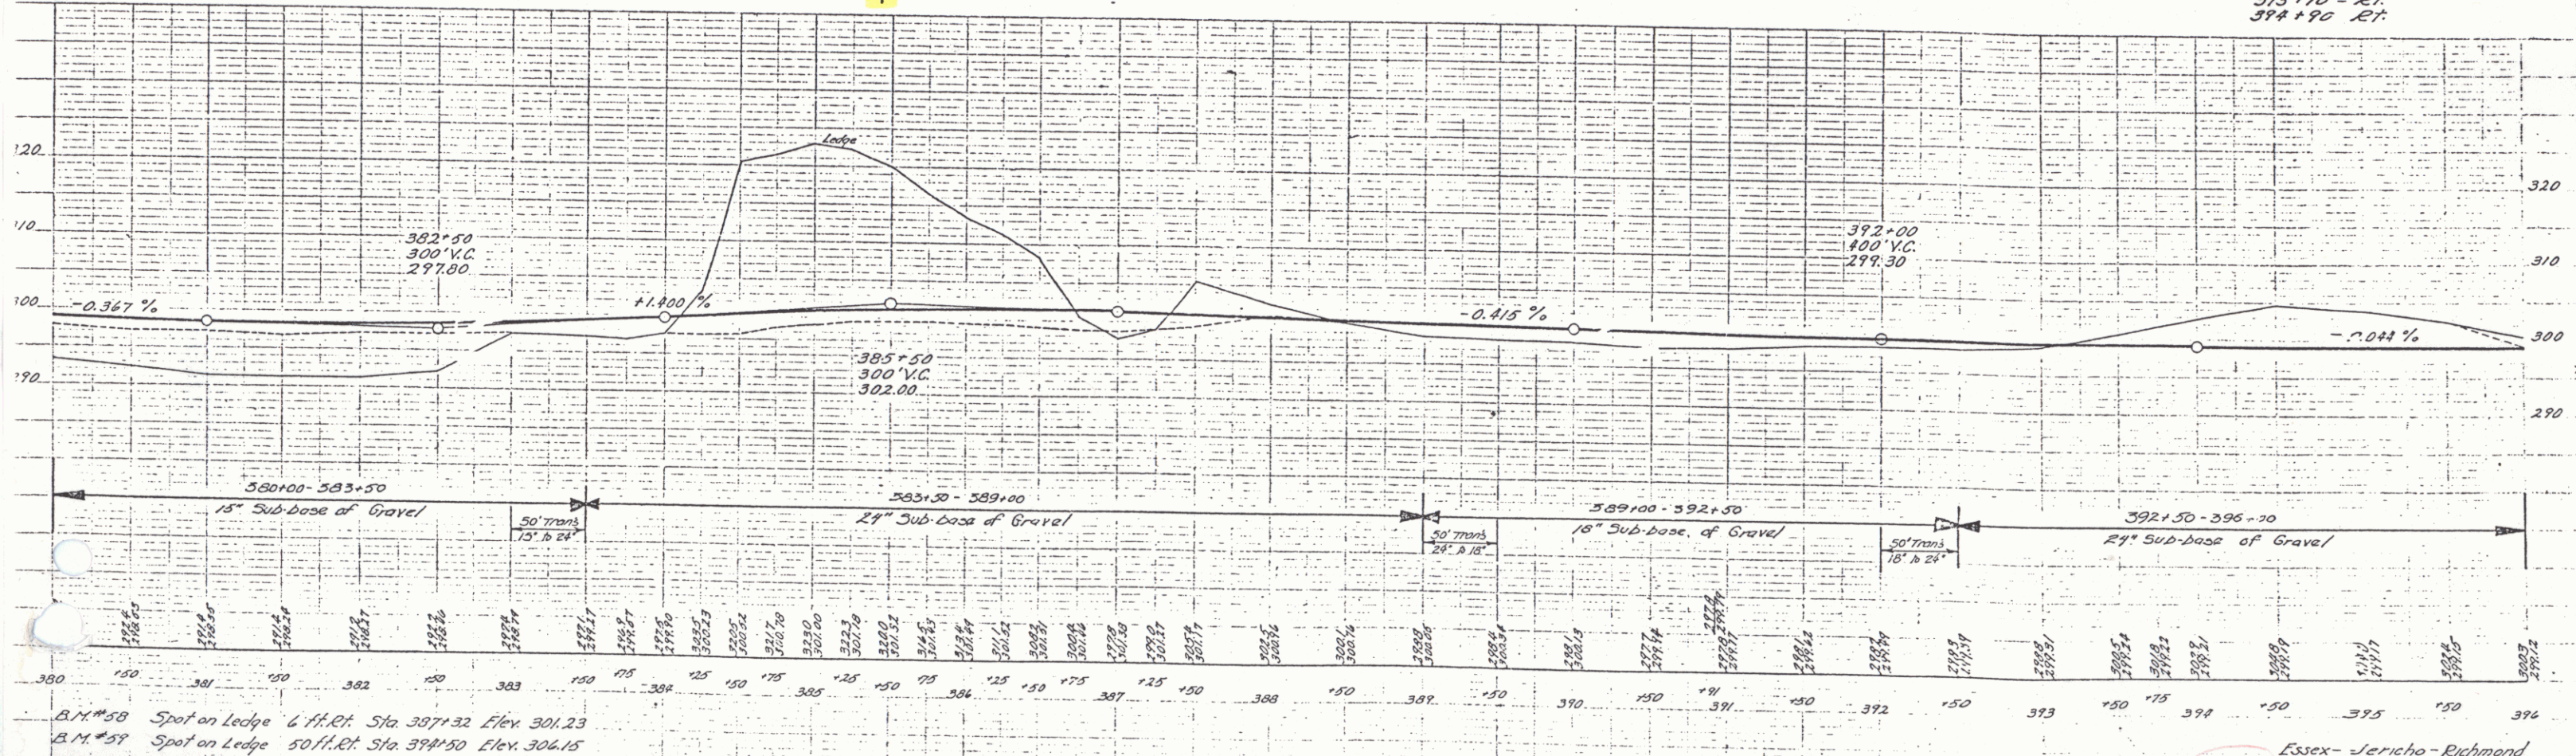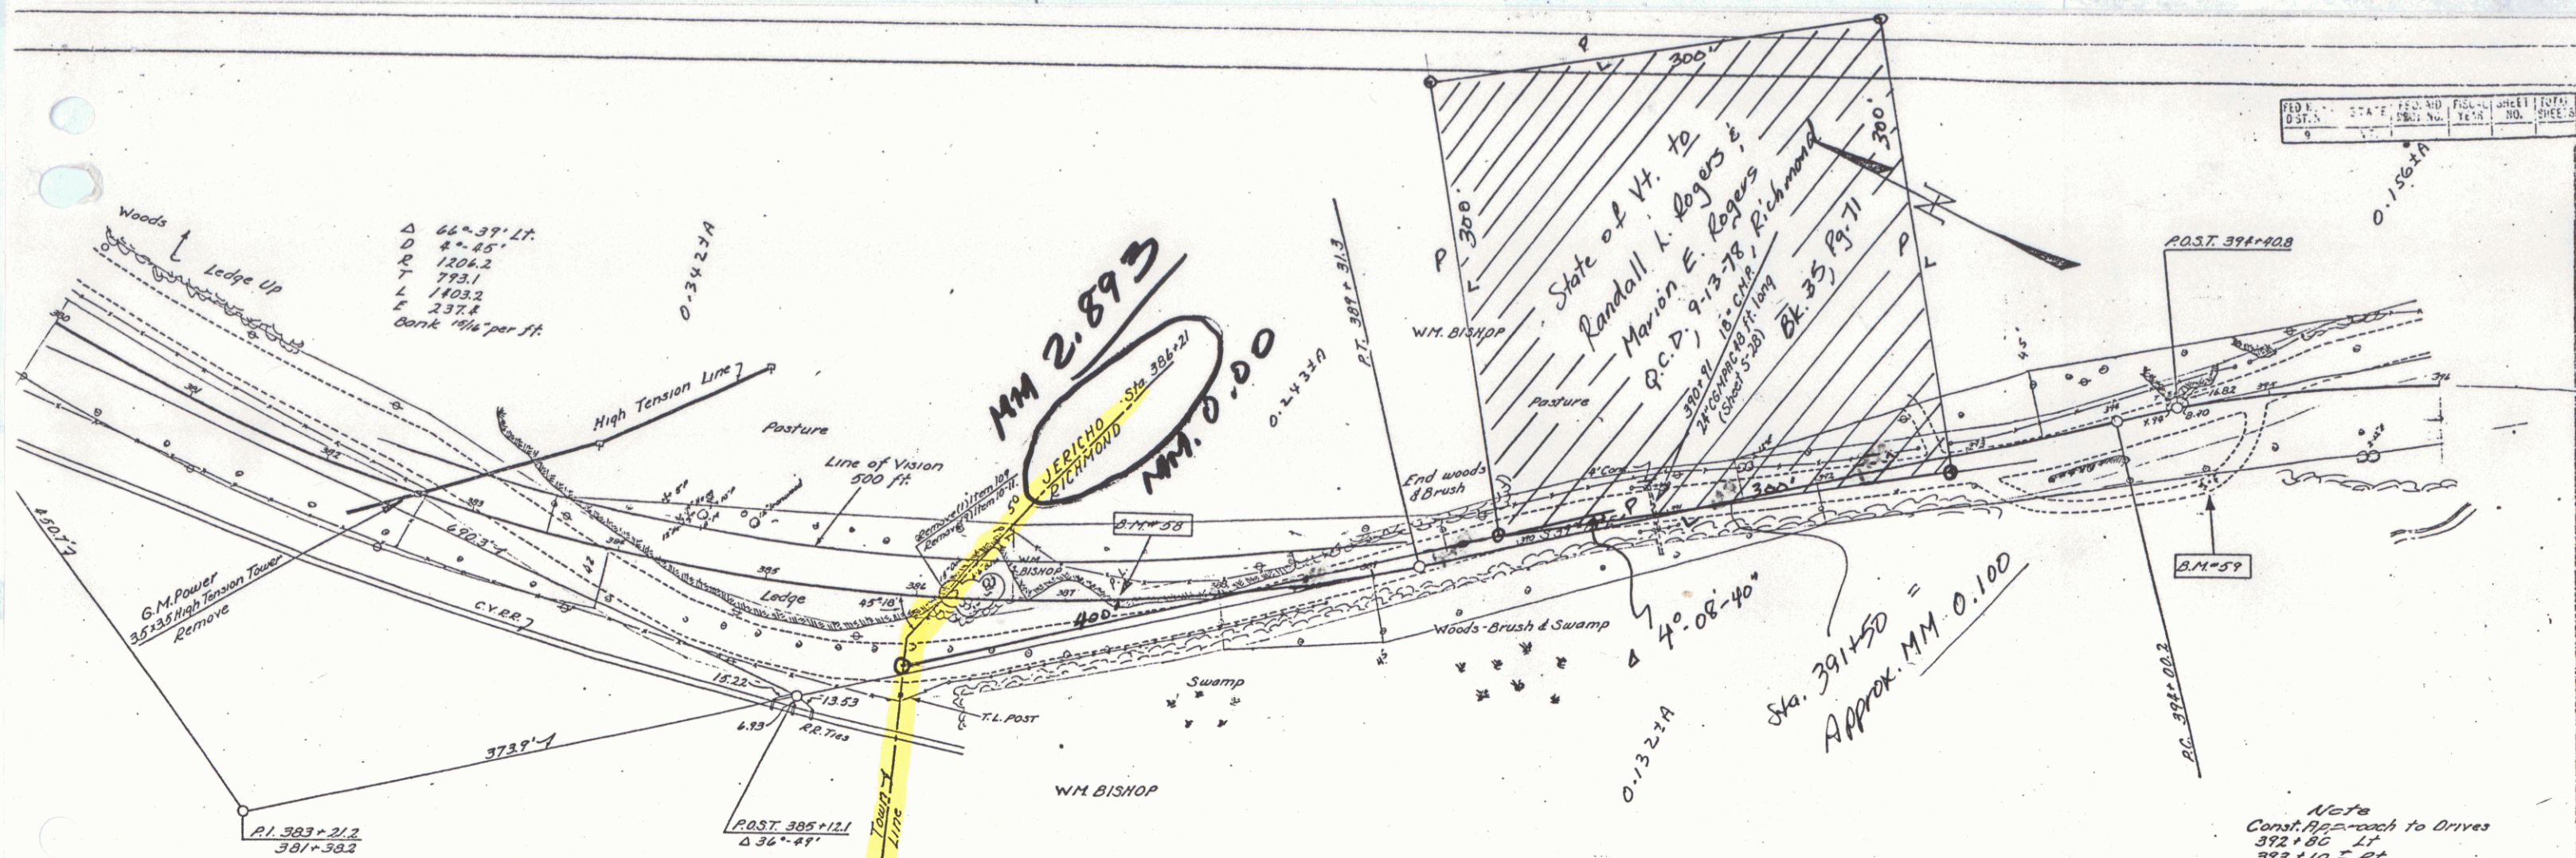

Spot on Ledge 6 ft. Rt. Sta. 397+32 Elev. 301.23
 Spot on Ledge 50 ft. Rt. Sta. 394+50 Elev. 306.15

Essex - Jericho - Richmond
 Sheet 22B of 240 A
 16

