


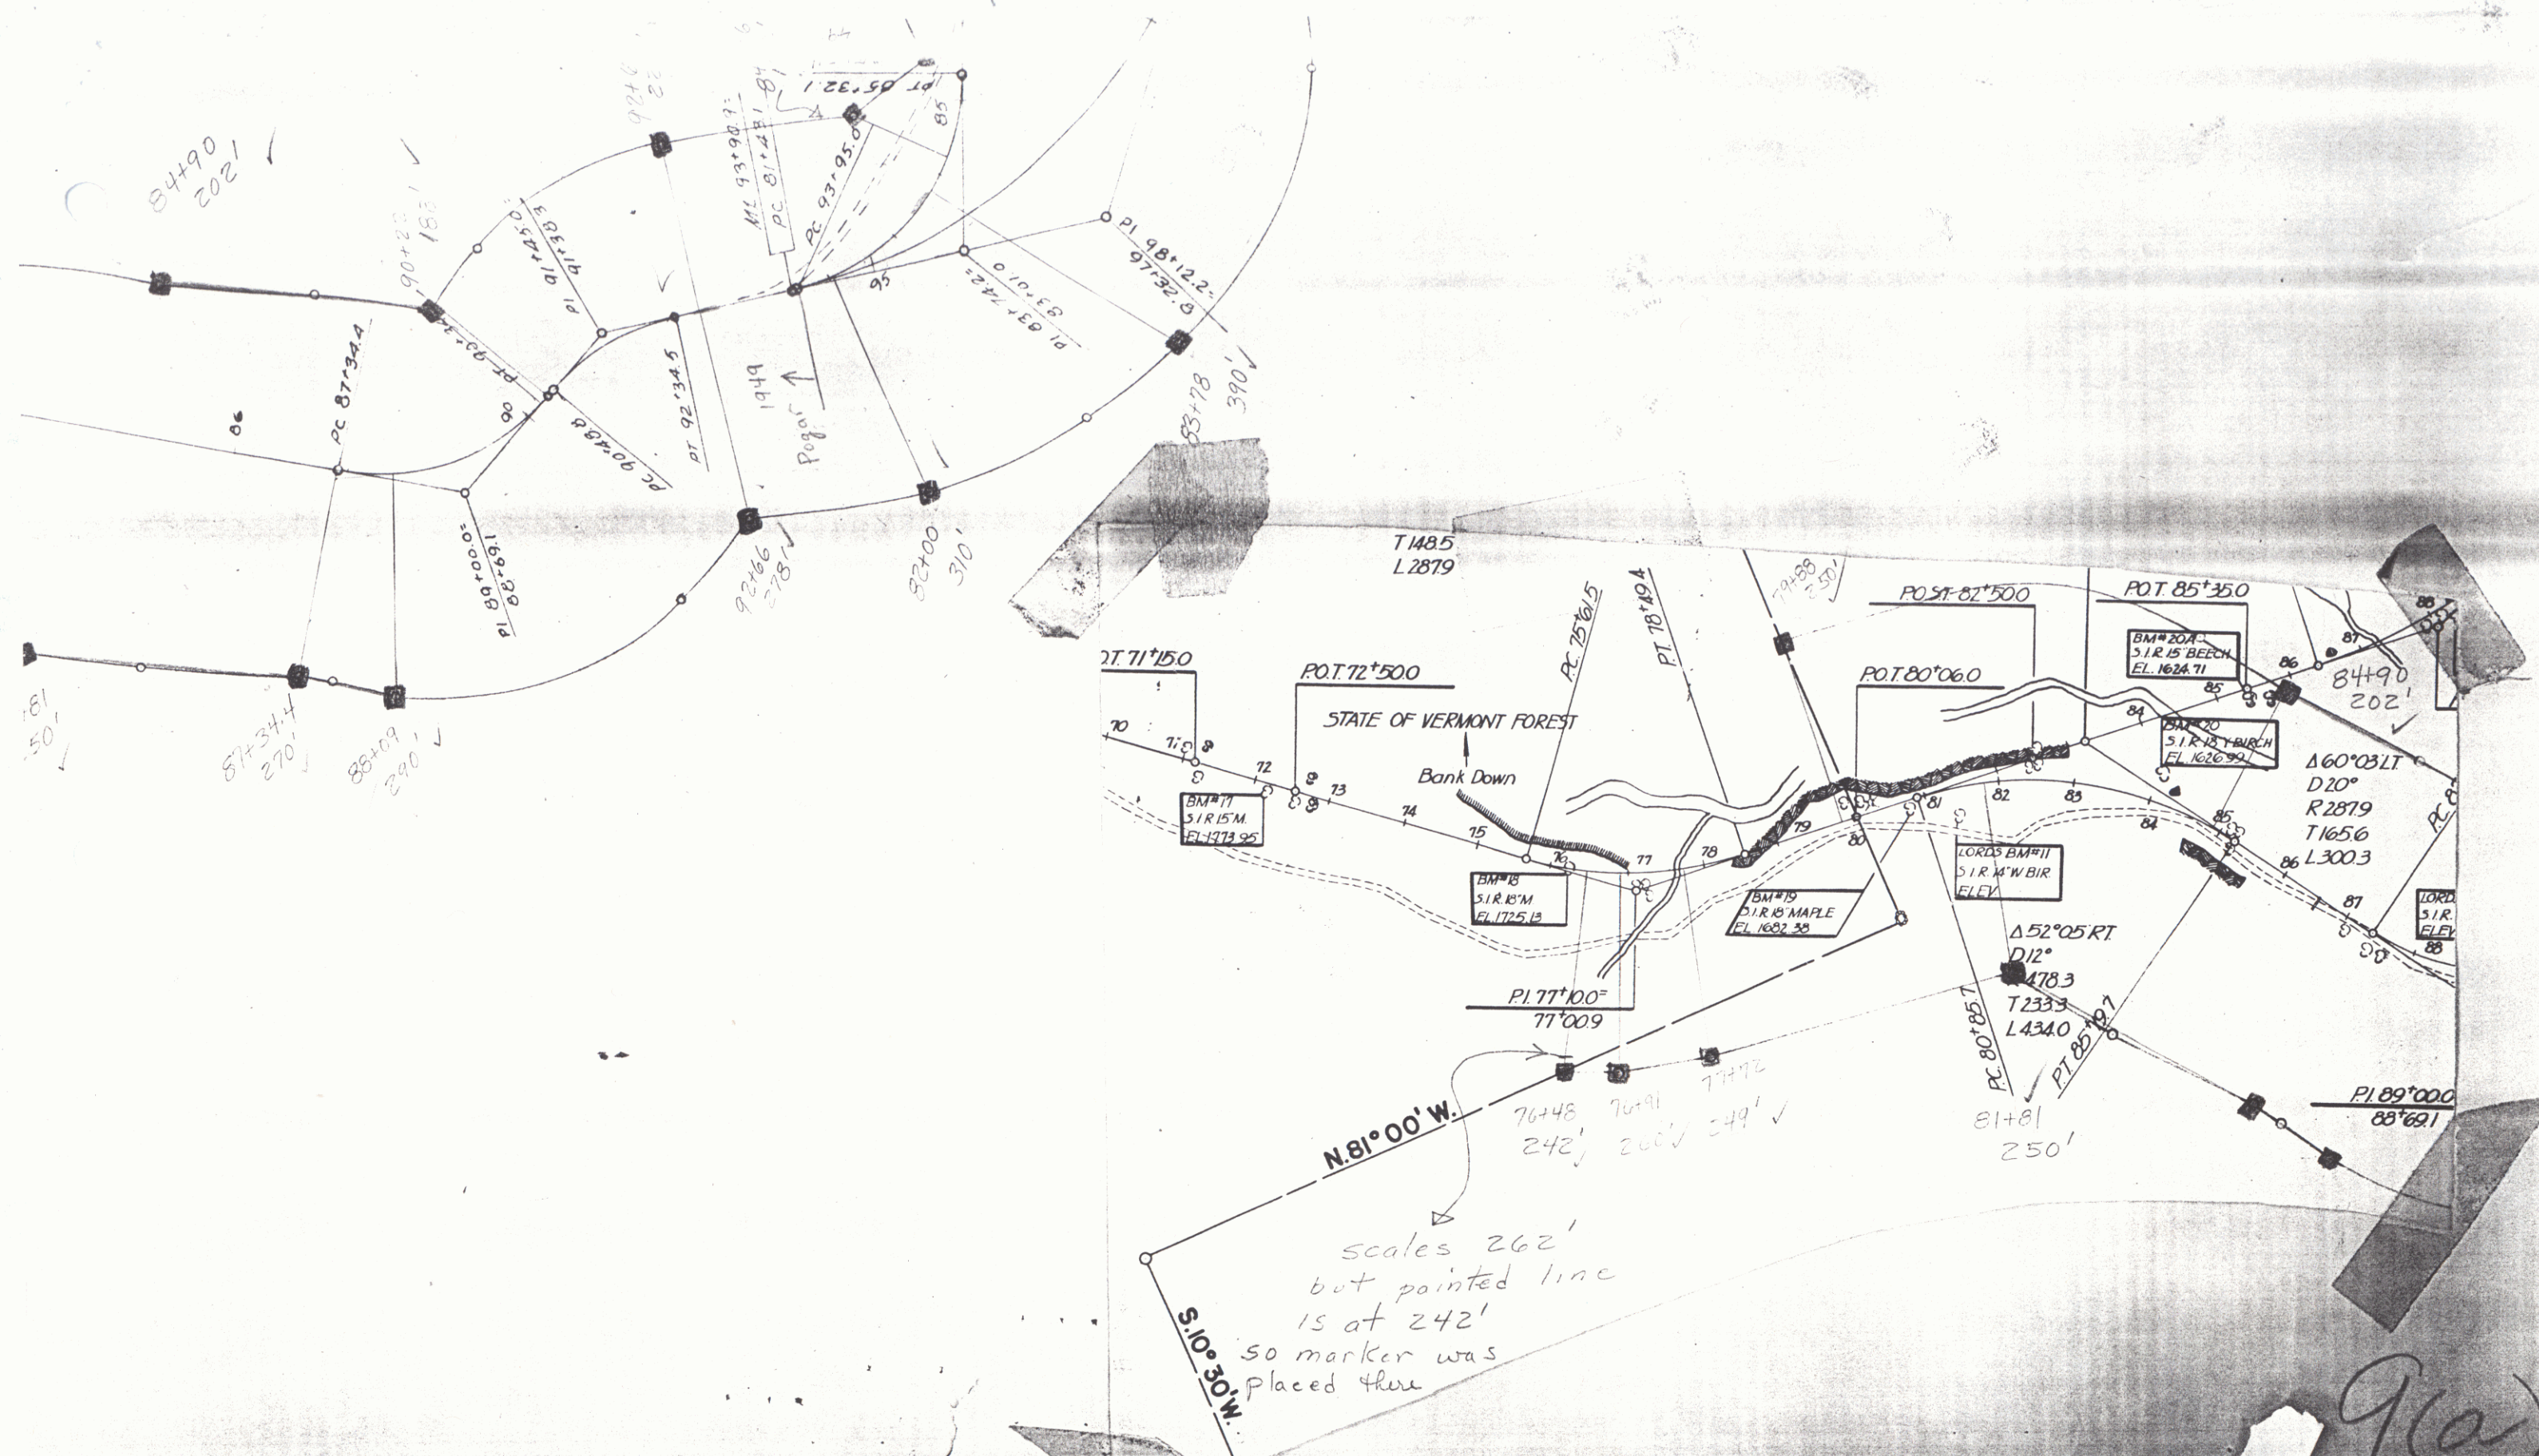

SHEET 4

41