


12

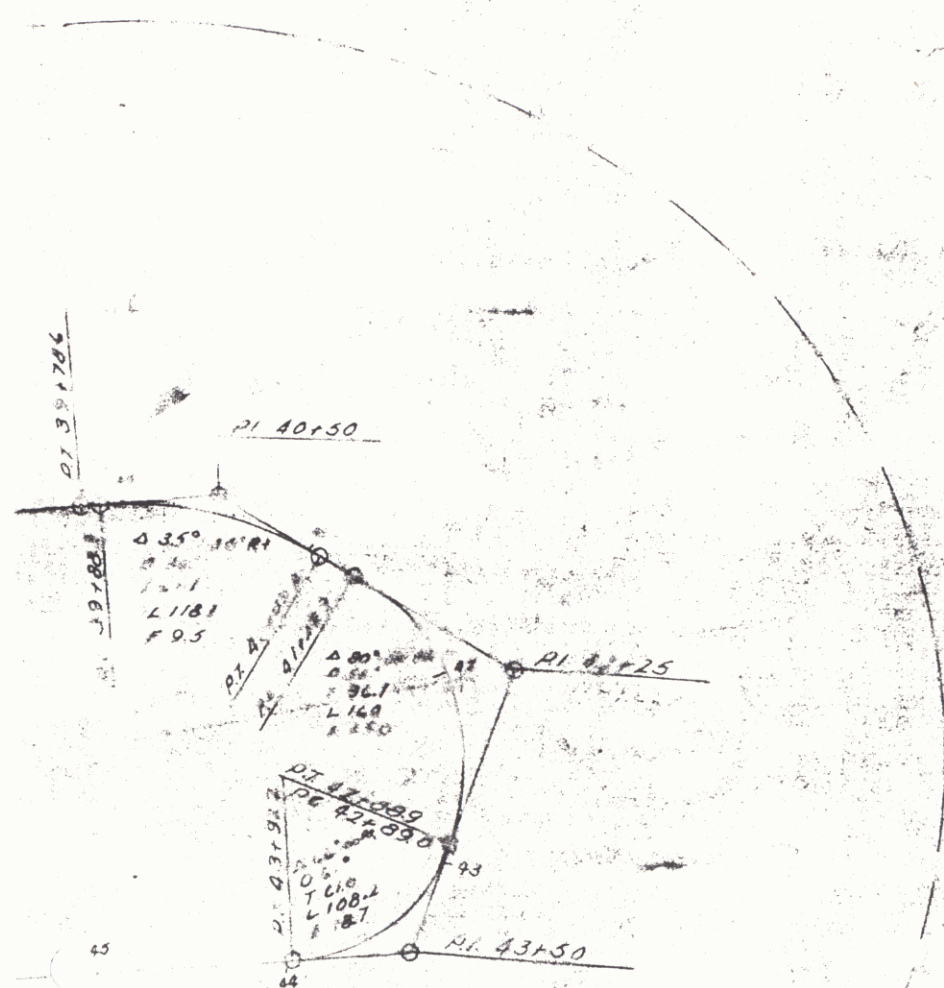

PARCEL INSTR

#14
Q.C.
Q.C.
Q.C.

A.O.
A.O.
Q.C.
Q.C.

Q.C.

SHEET 43 Q.C.D.

43