



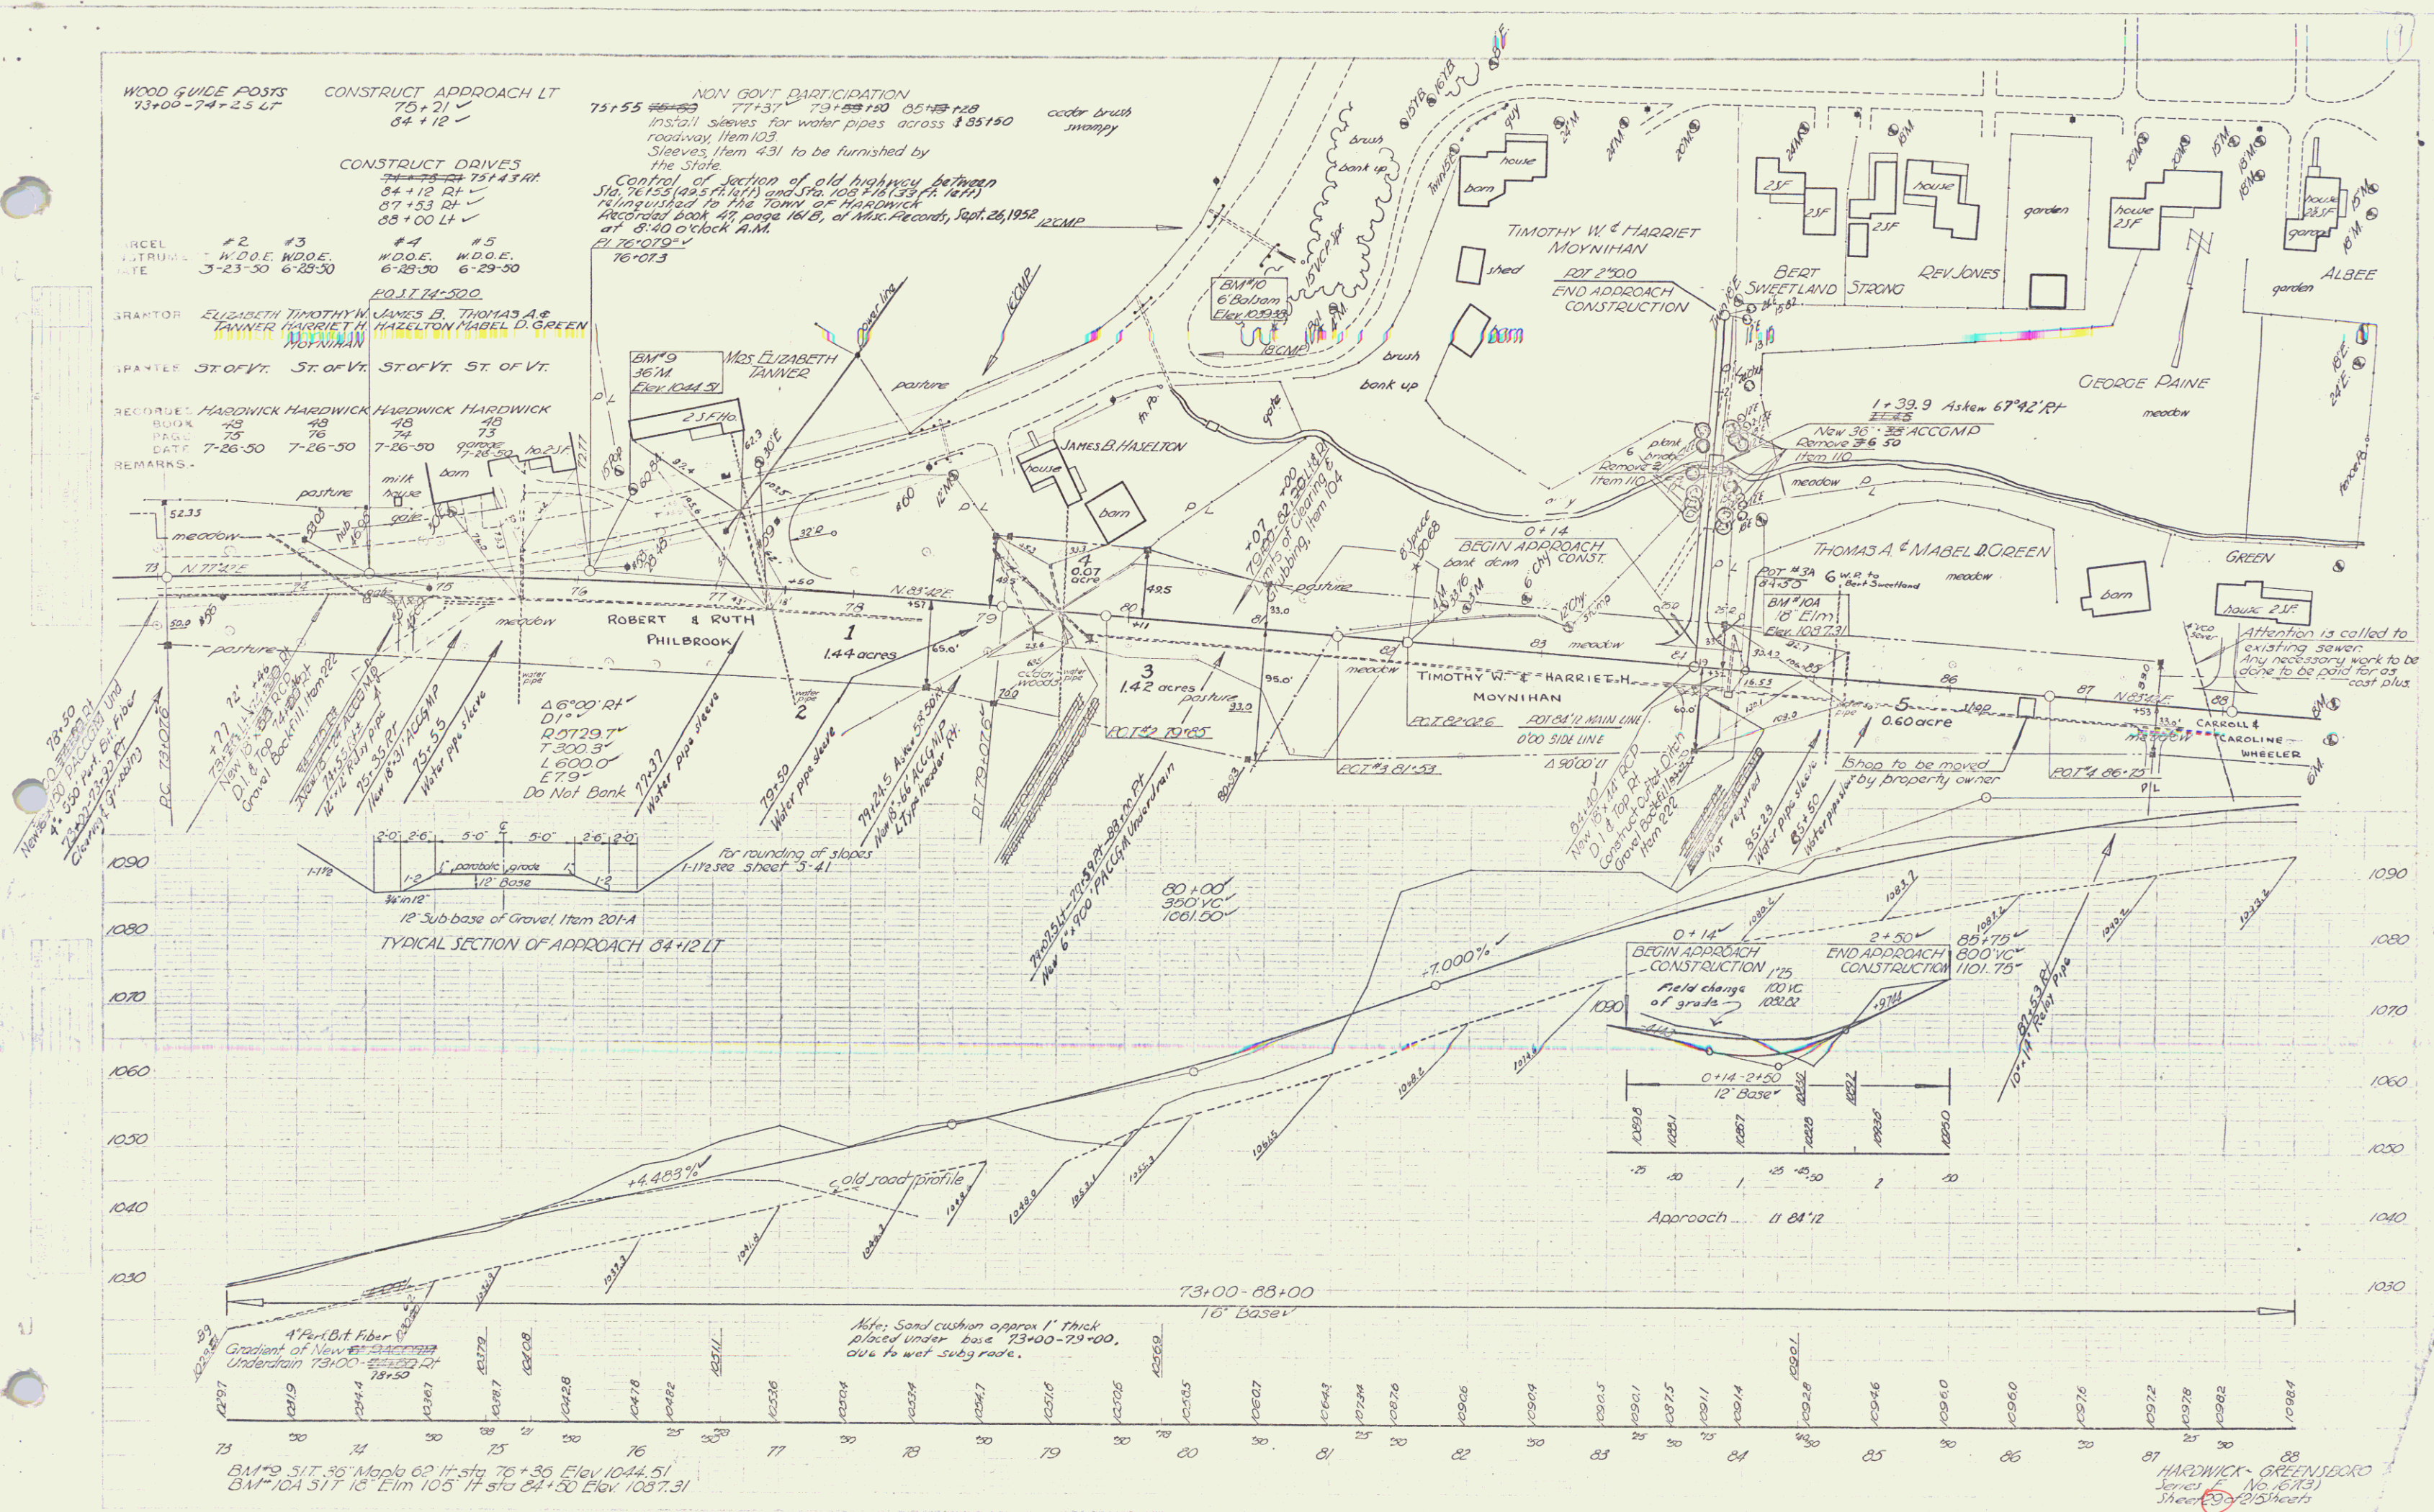


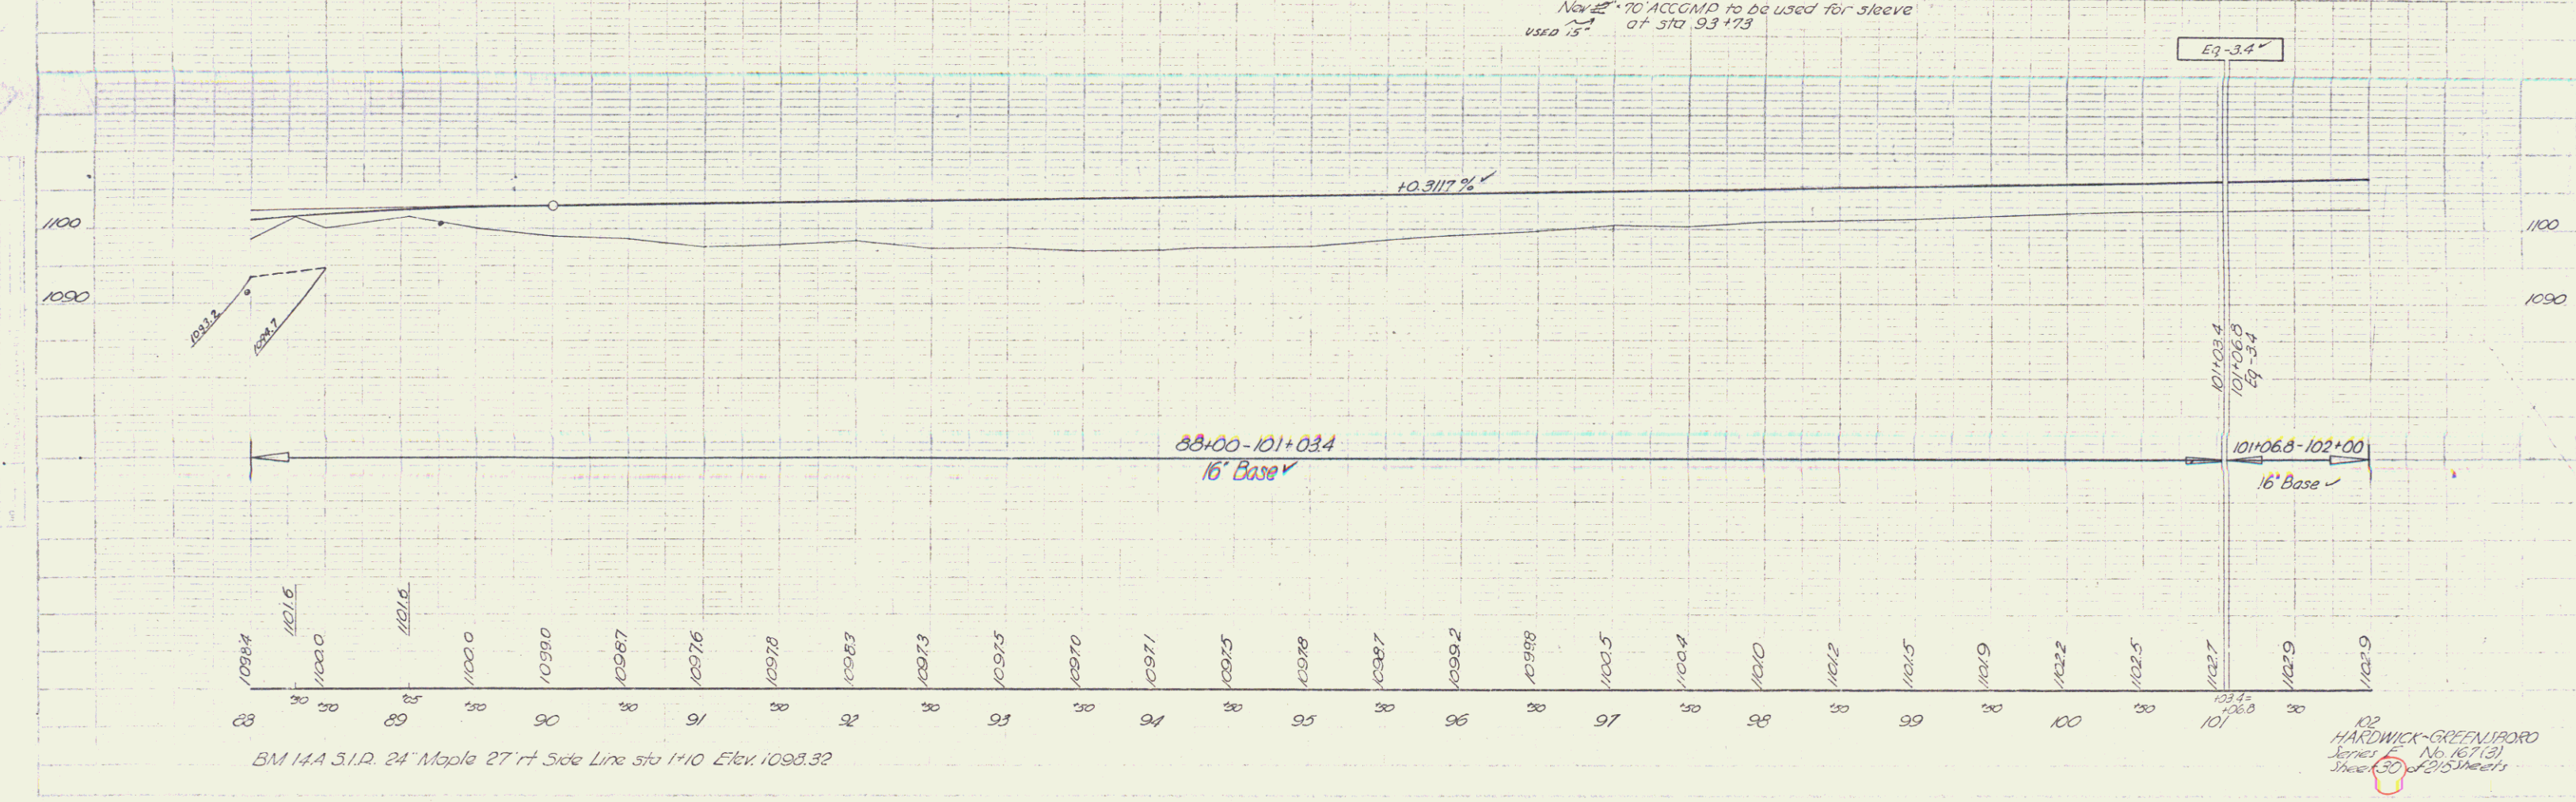

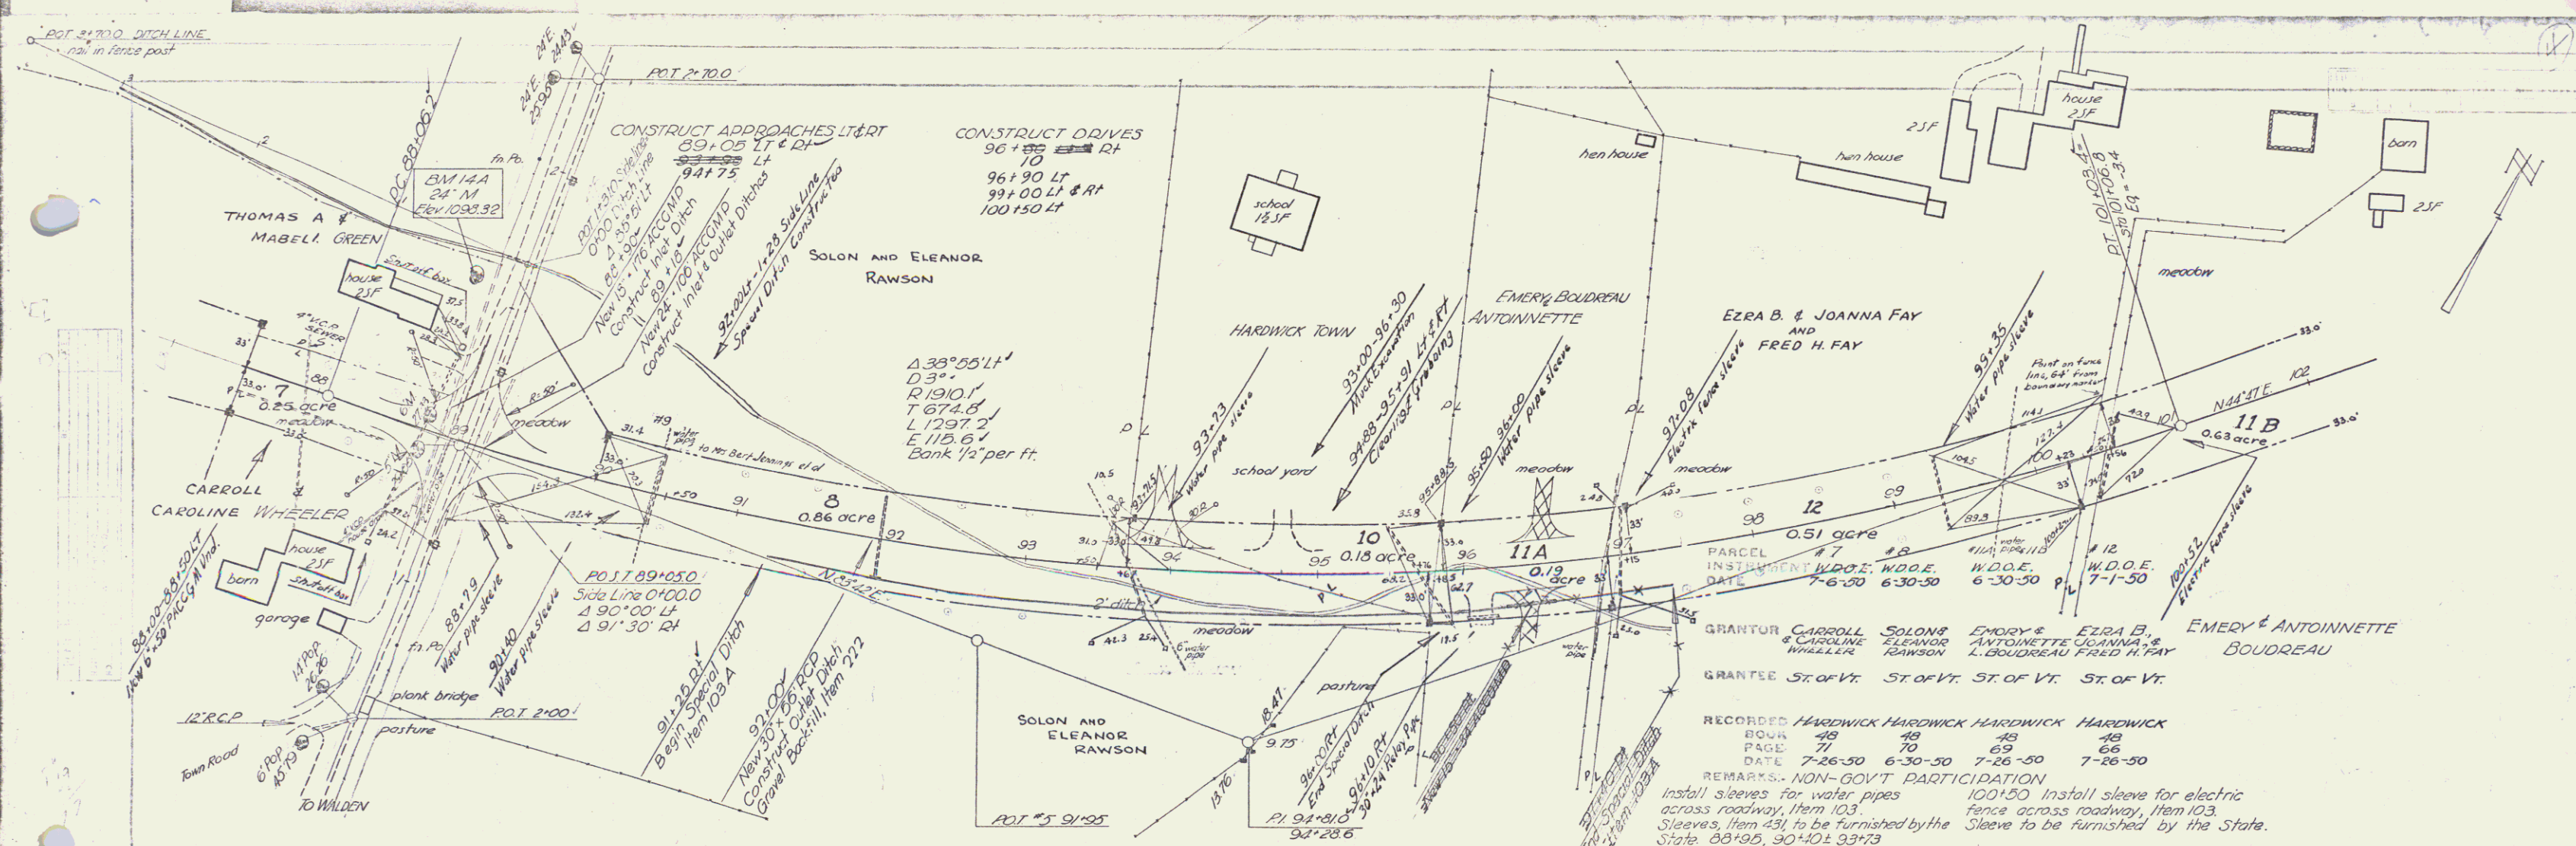


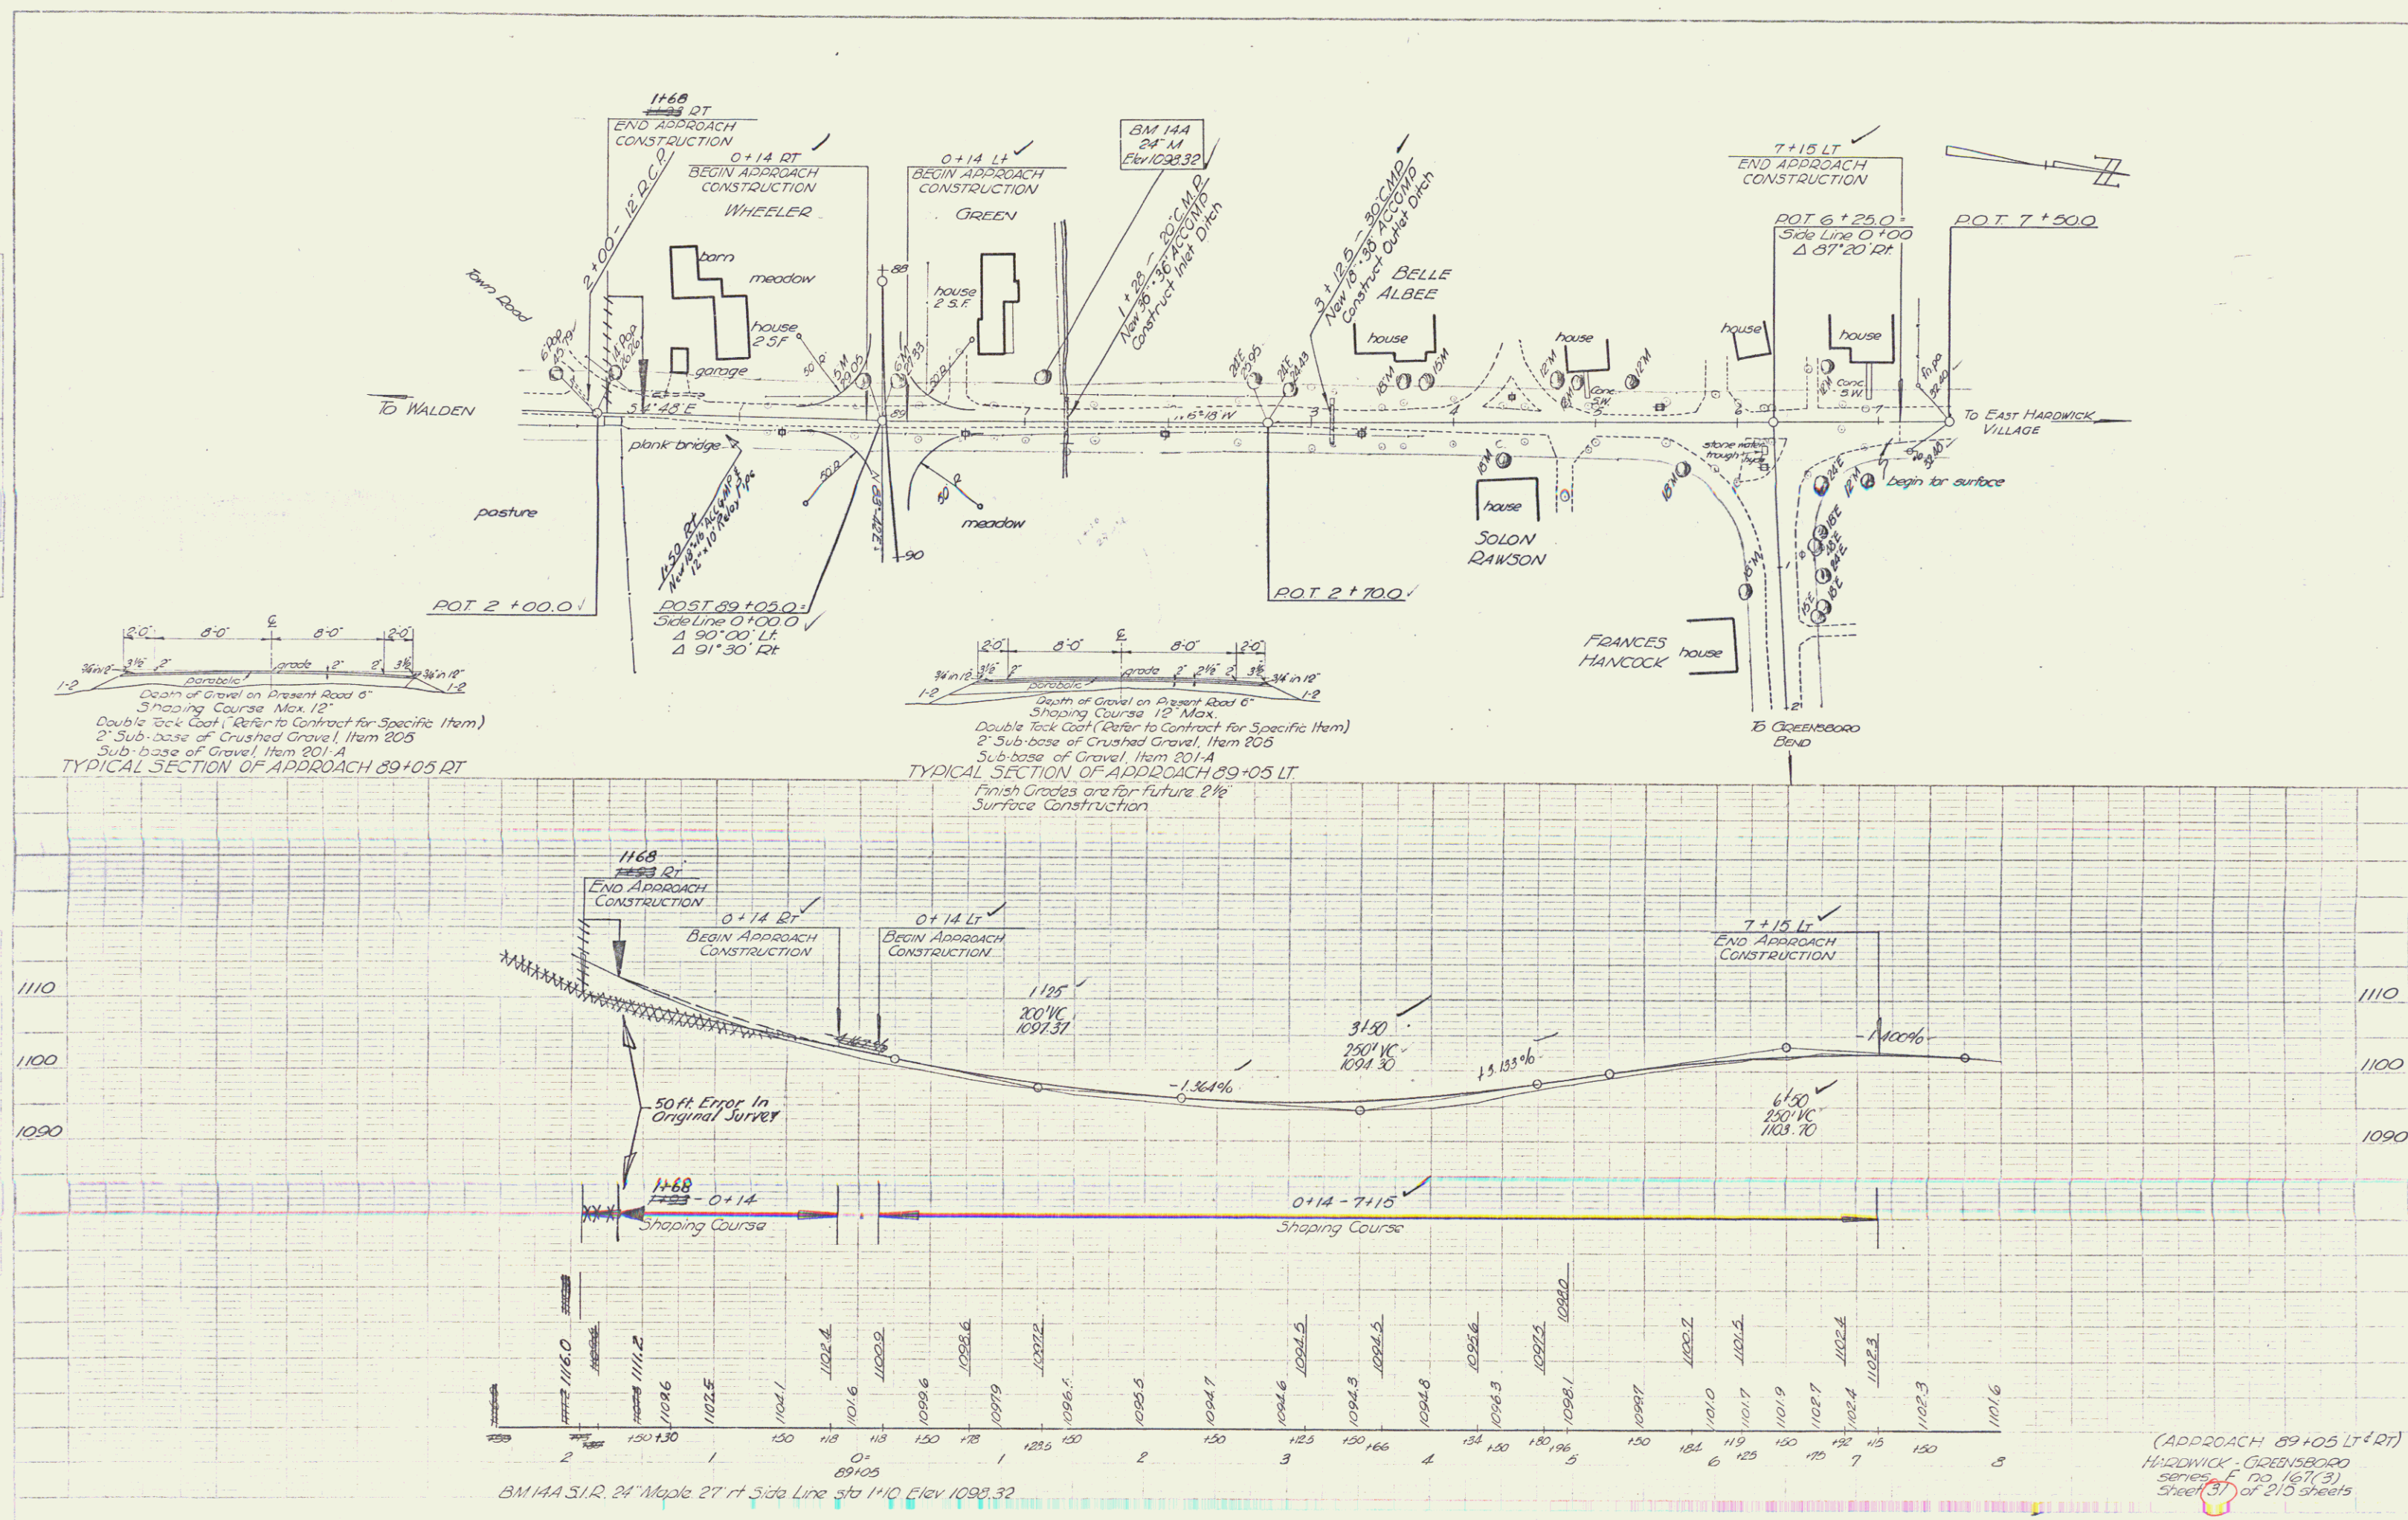



PLAN	114+50
SECTION	114+50
DATE	7-26-50
BY	W. J. H. H.
CHECKED	W. J. H. H.
APPROVED	W. J. H. H.


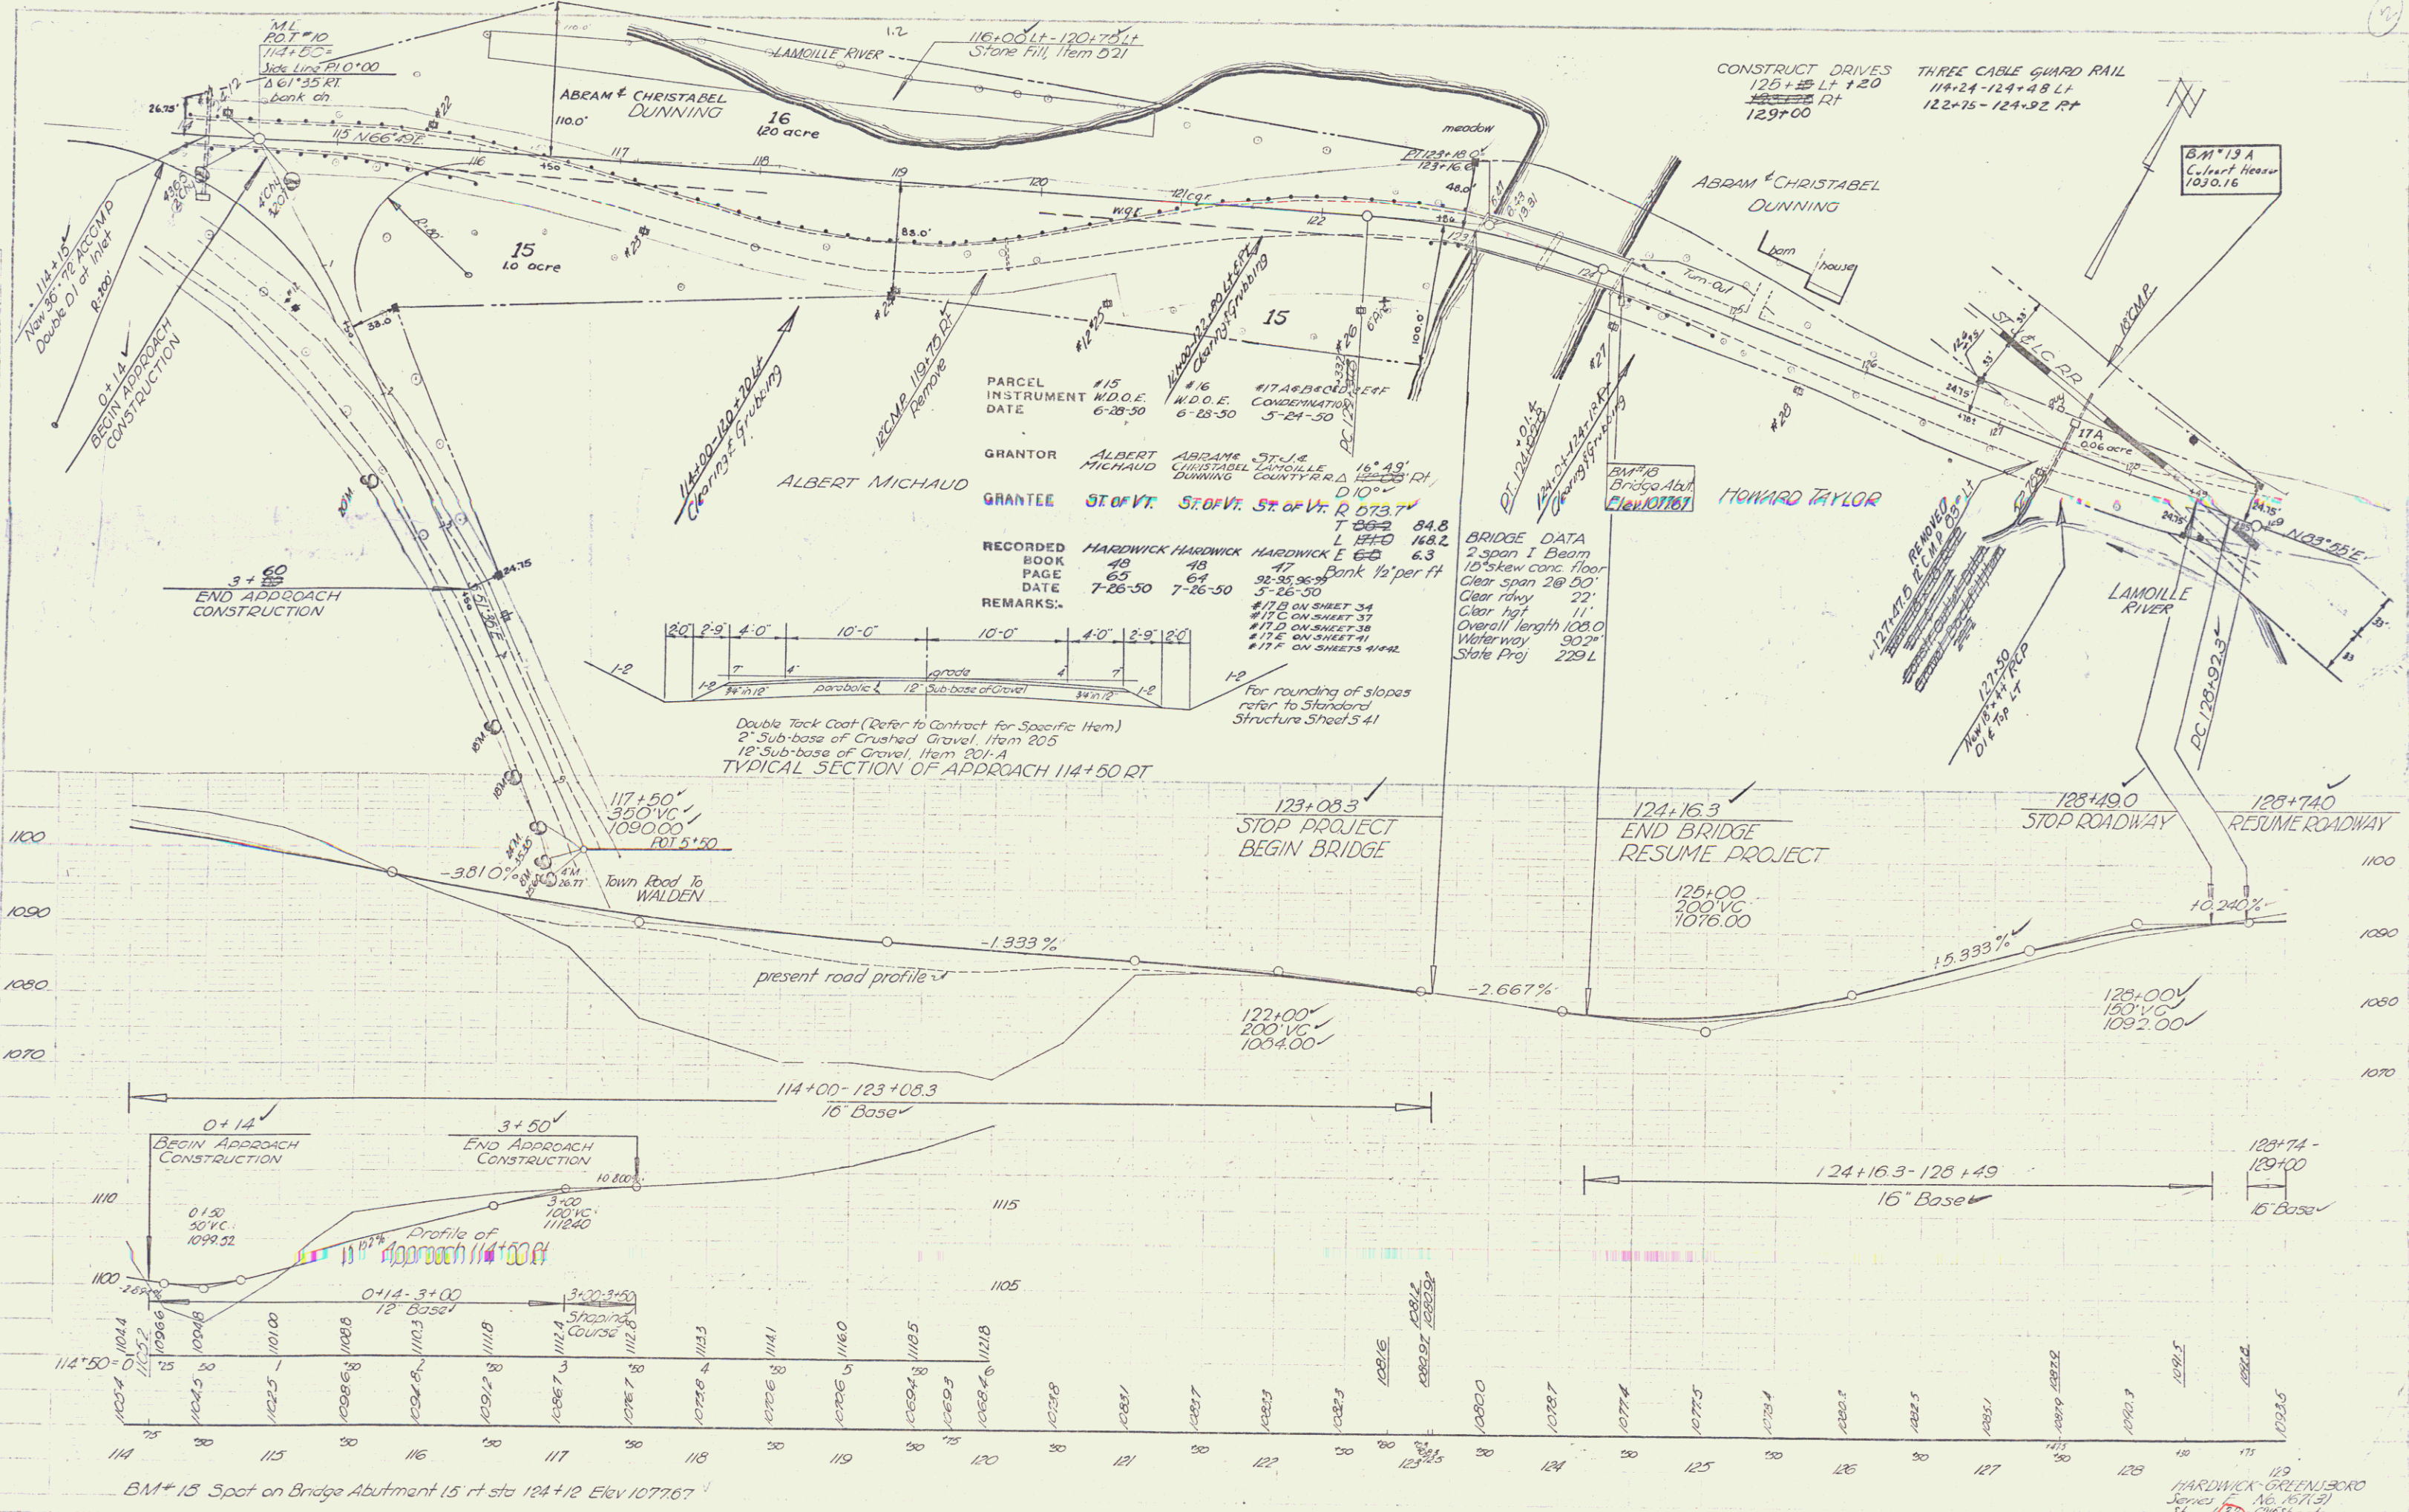


HARDWICK GREENSBORO
Series F No. 157 (3)
Sheet 33 of 75 sheets

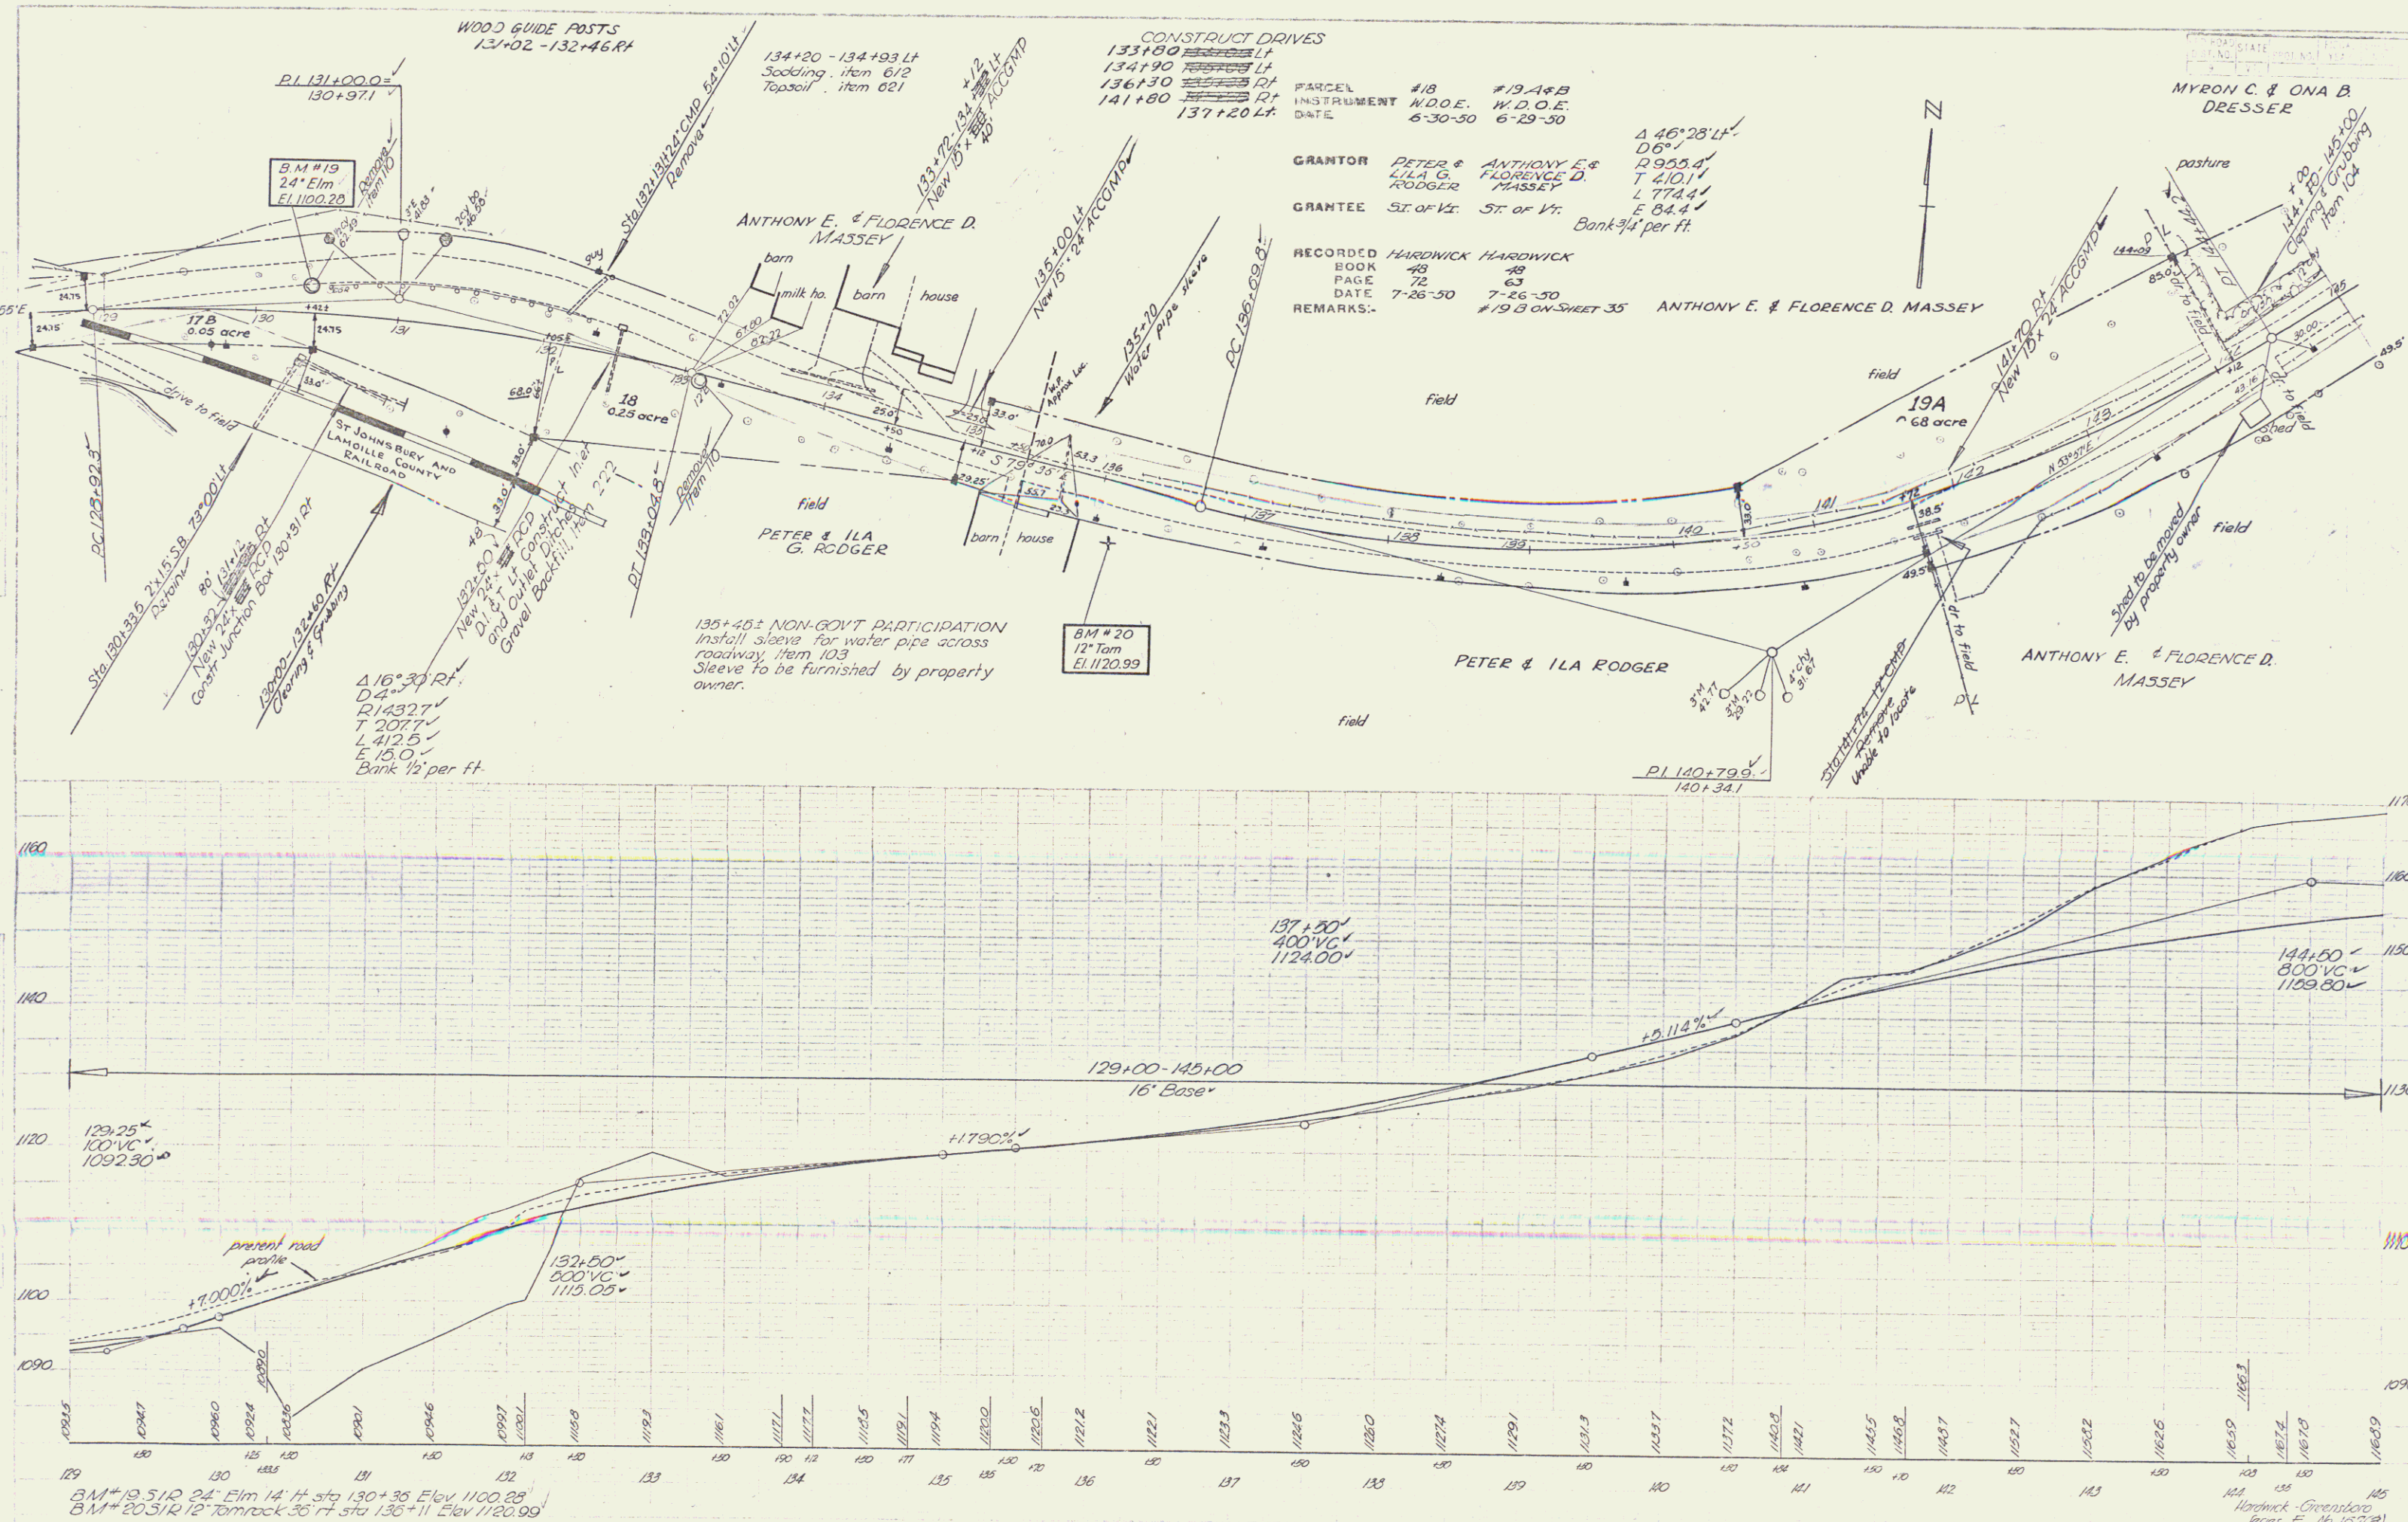


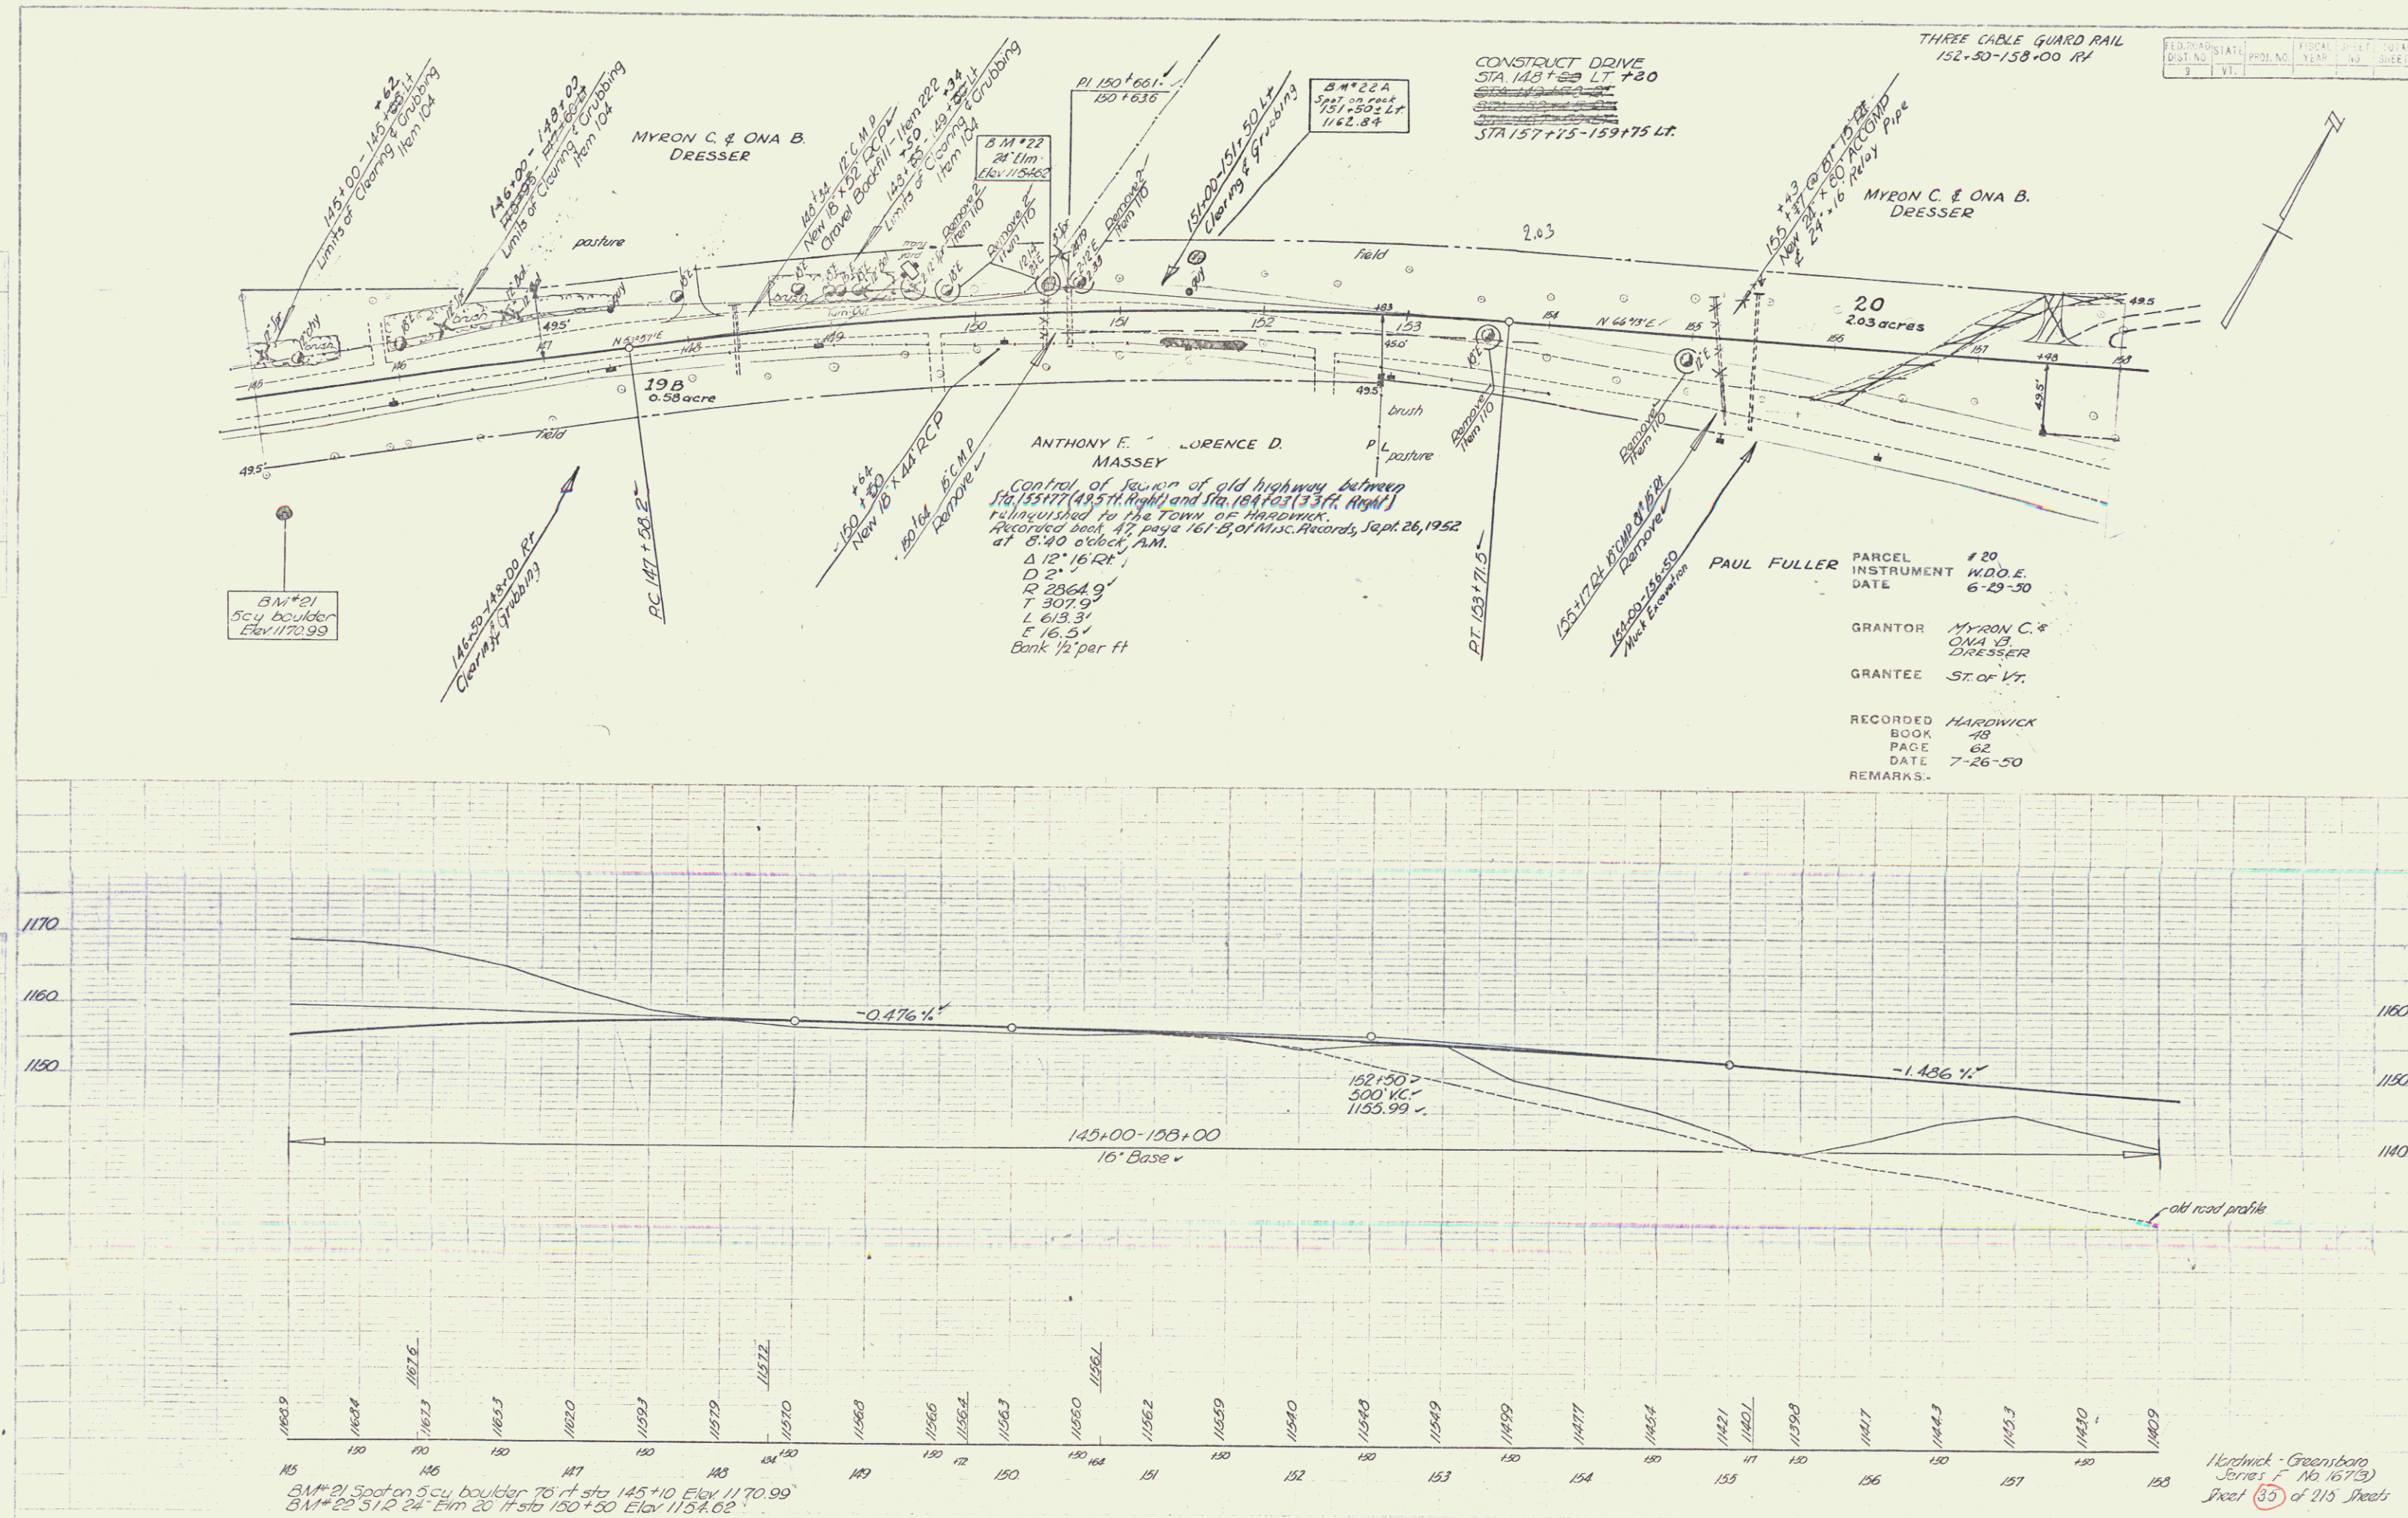

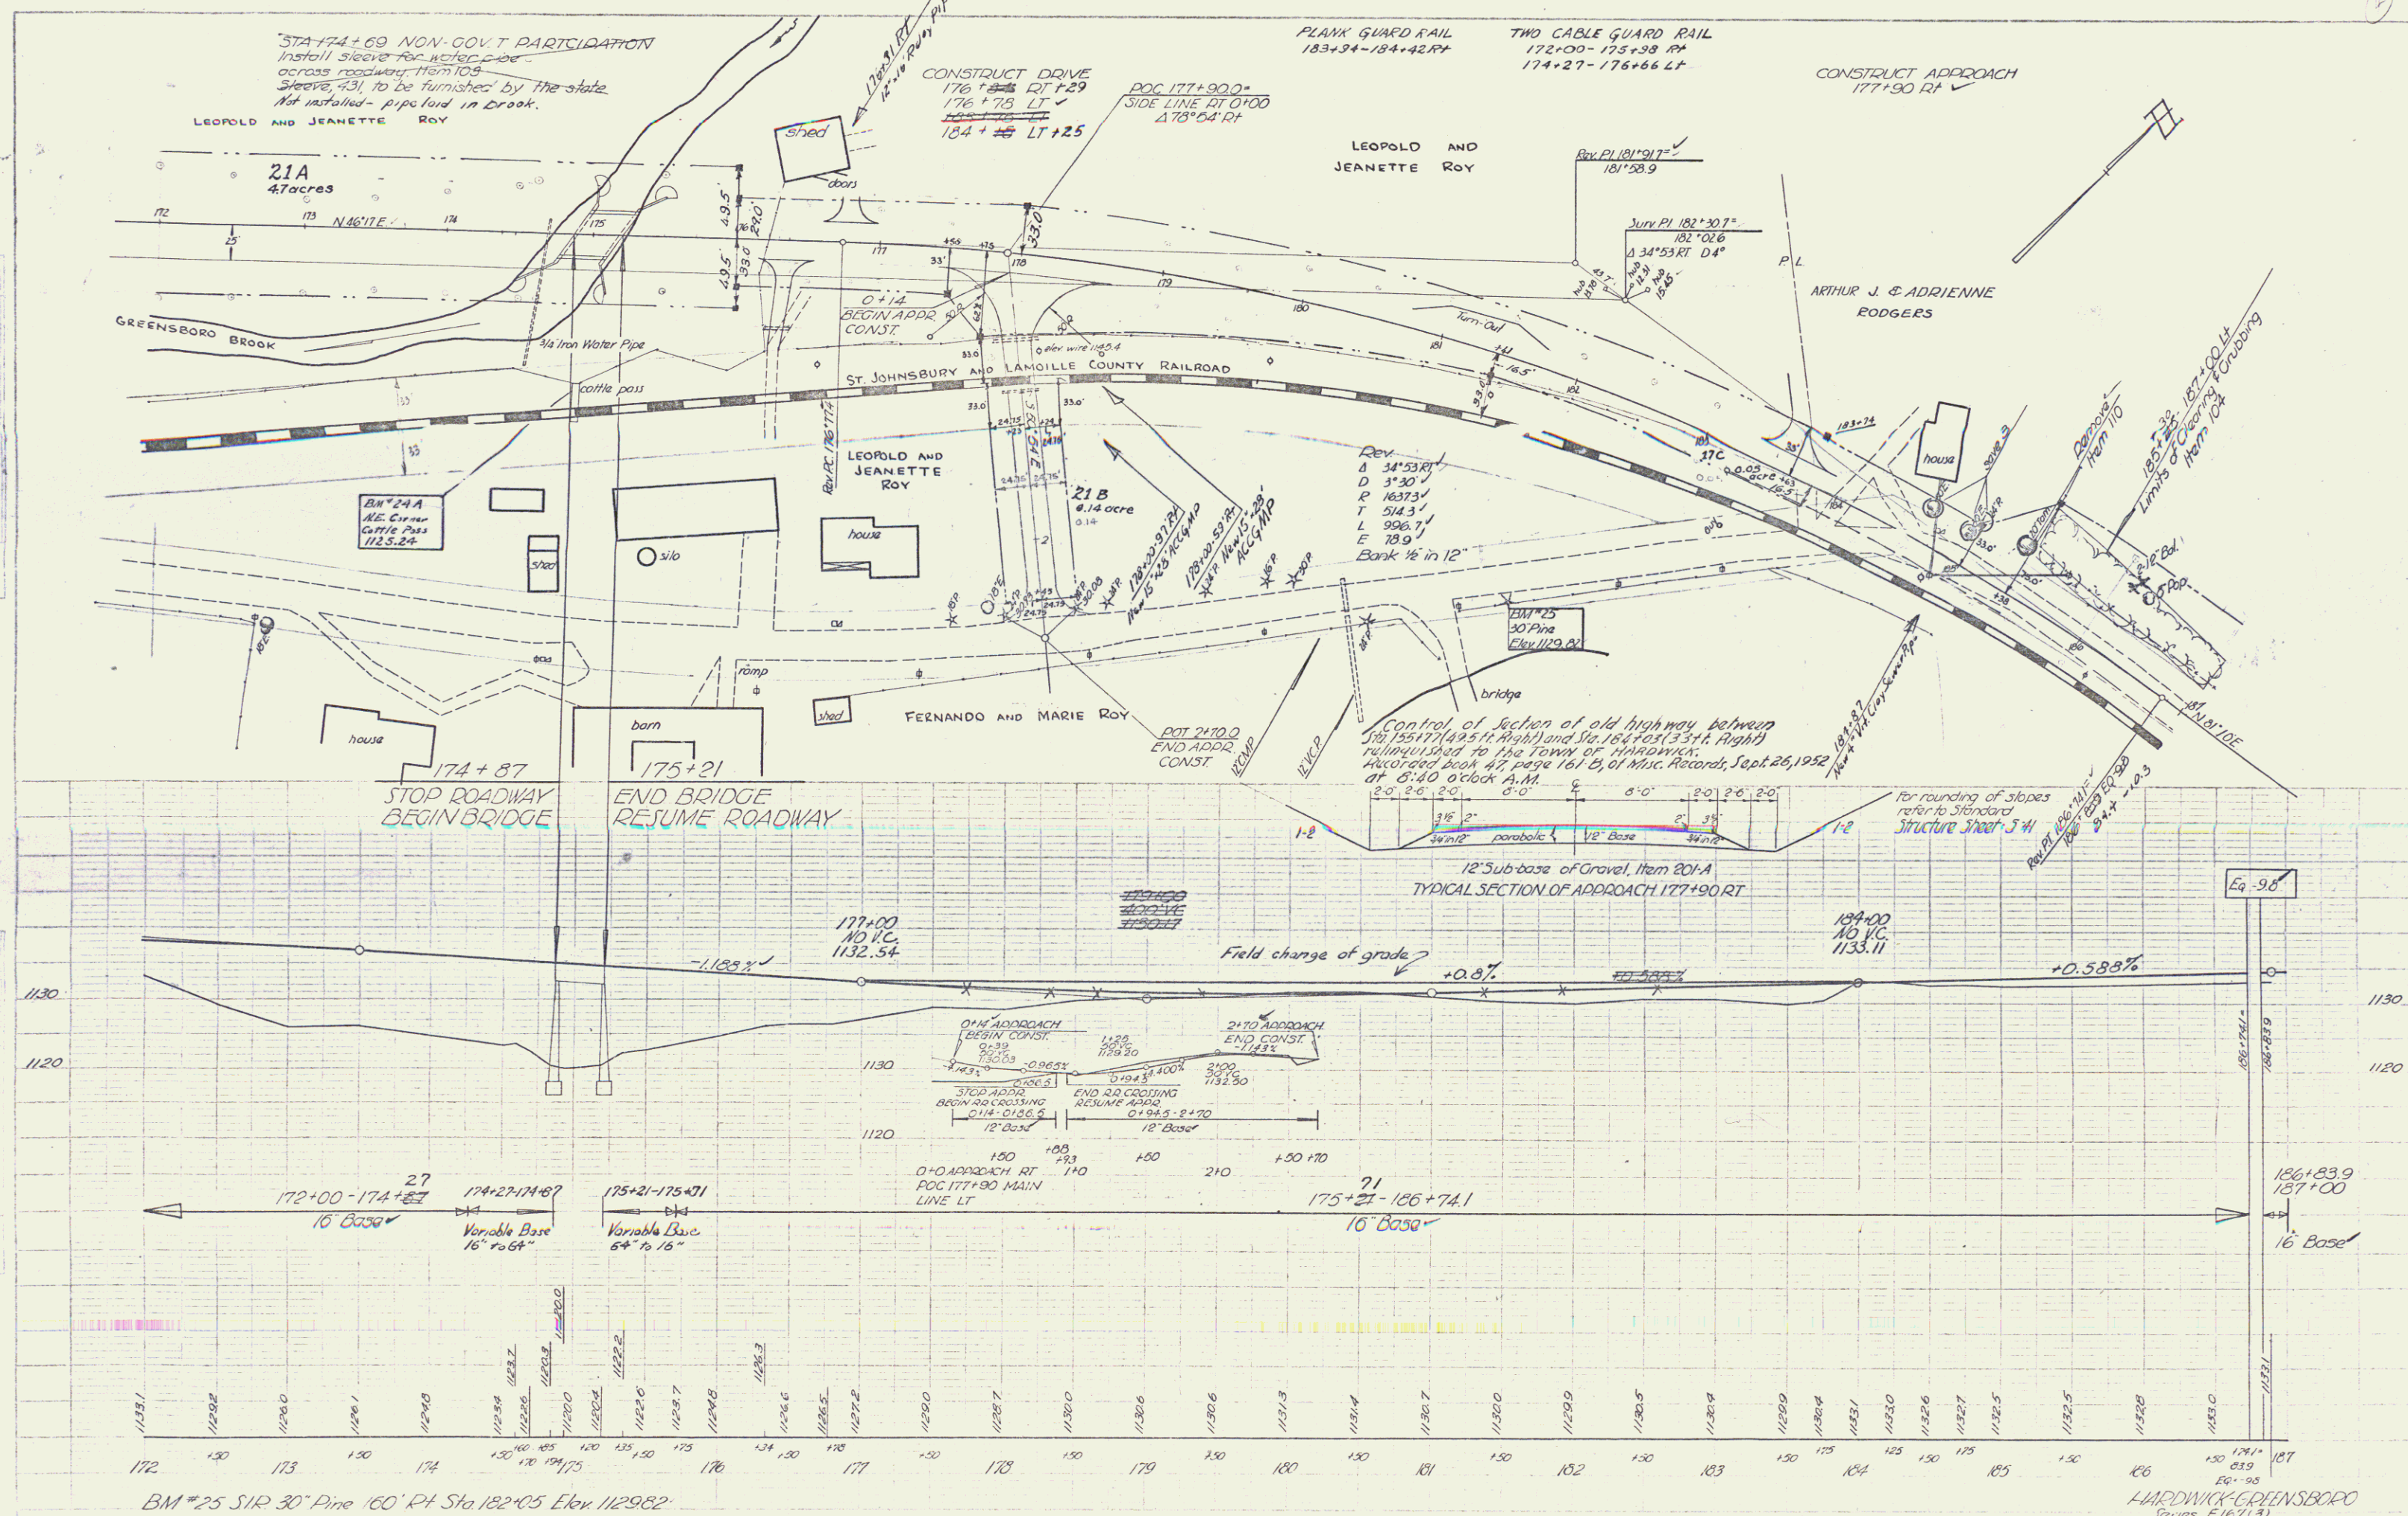

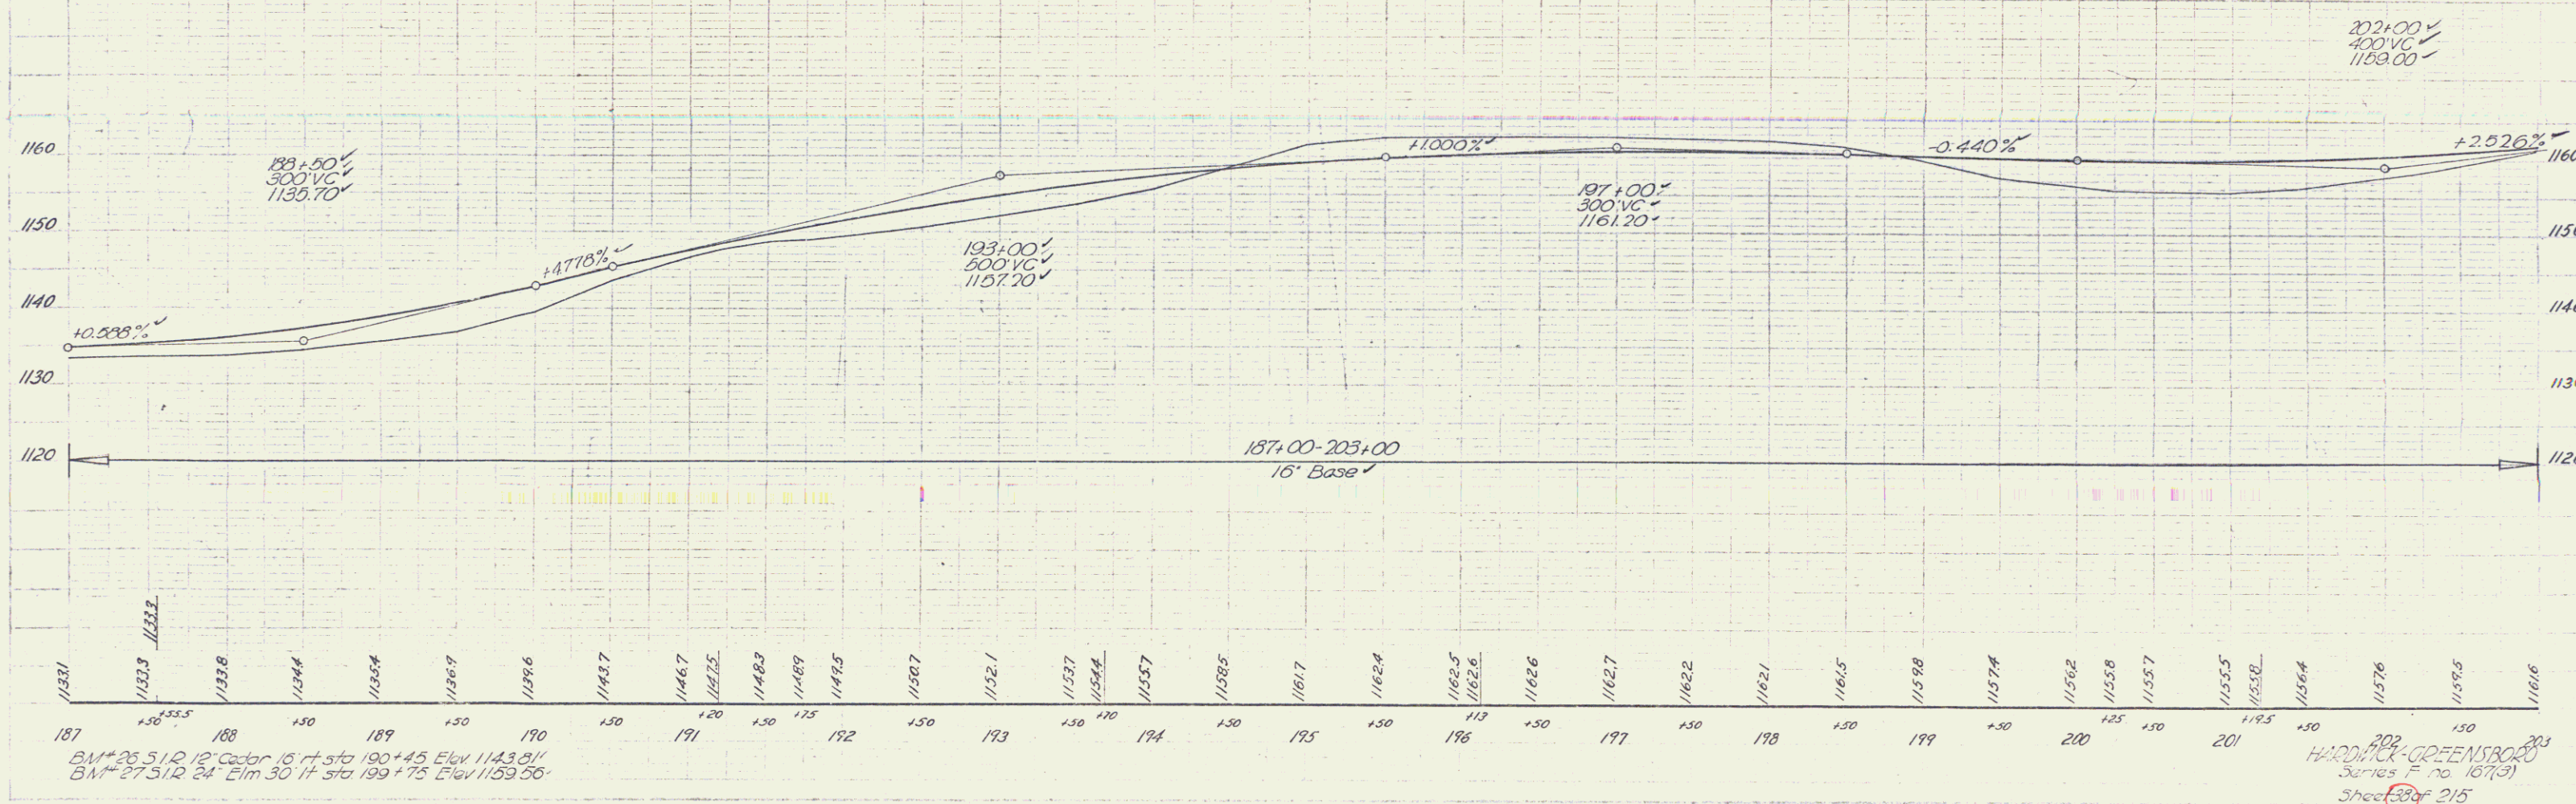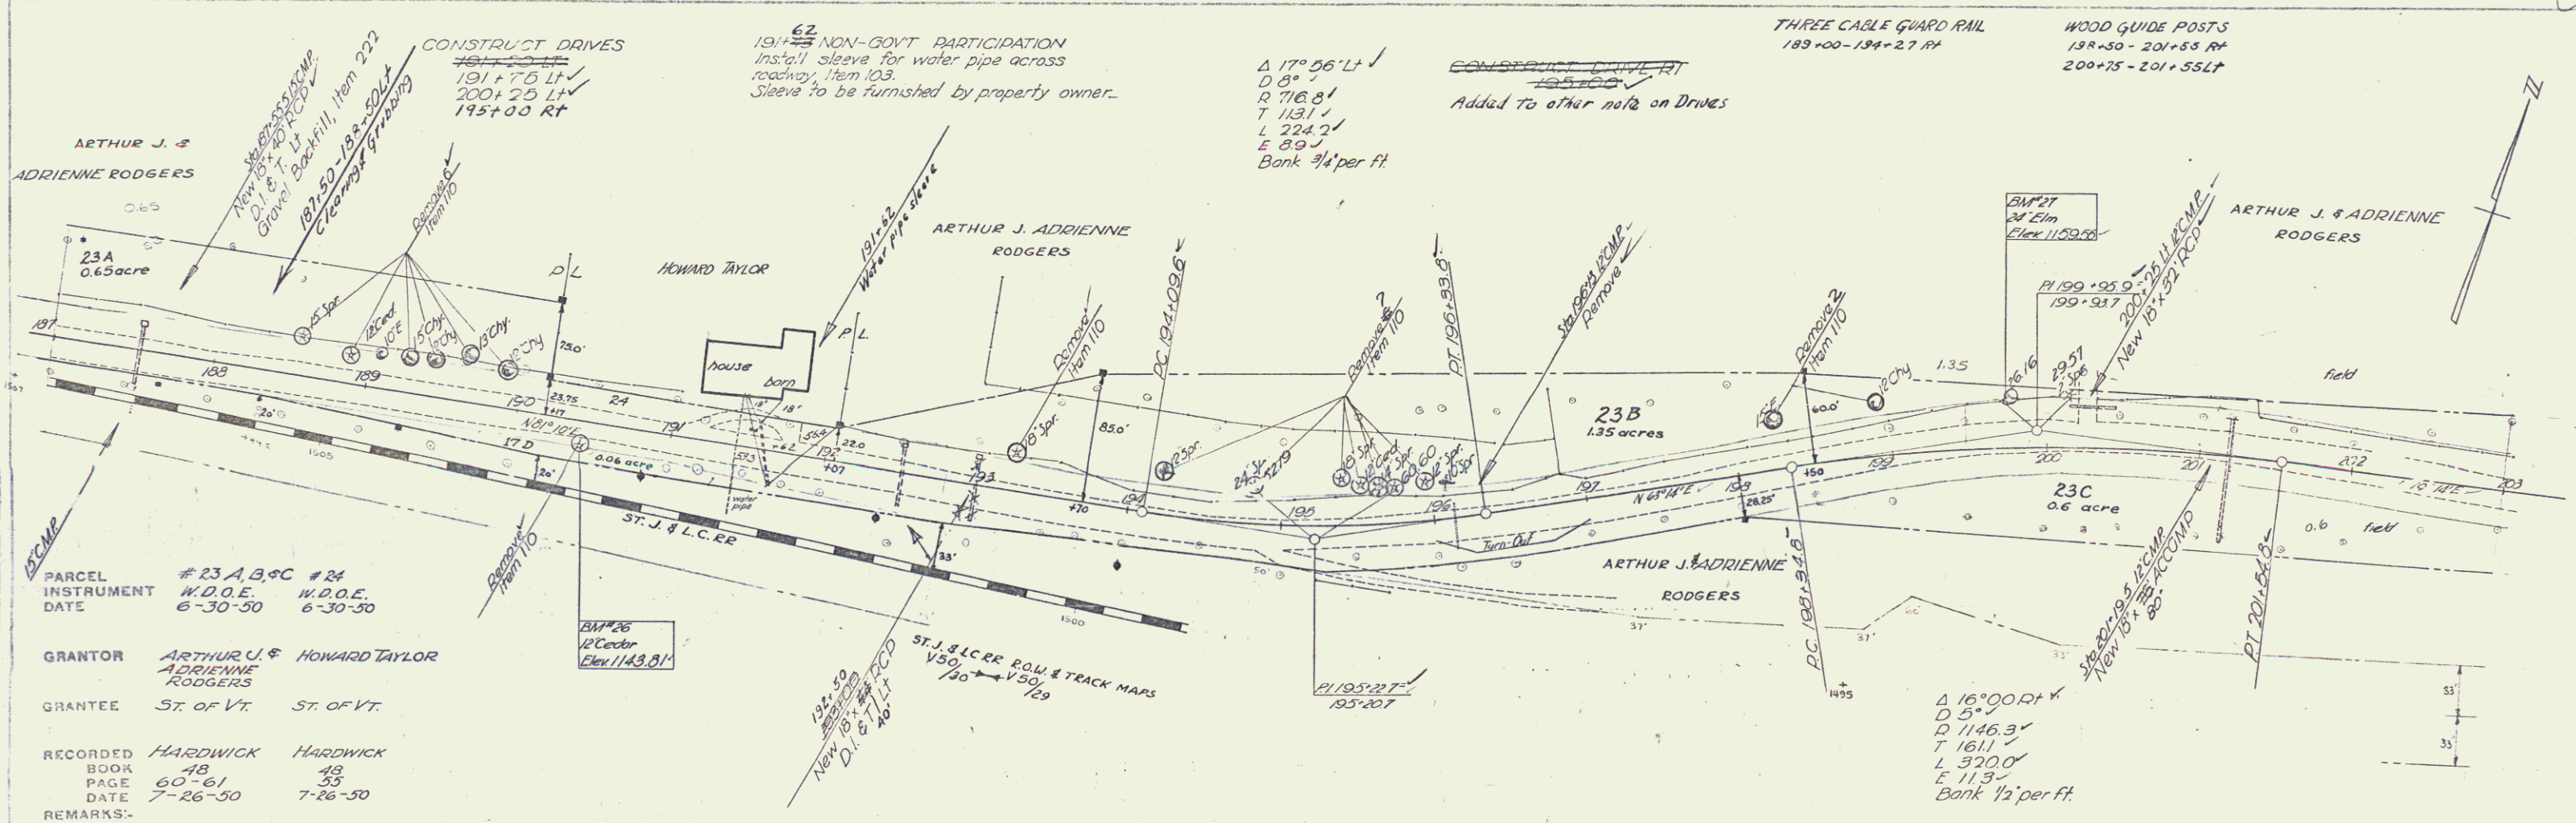

PAC. ROAD DIST. NO.	STATE	PROJ. NO.	FISCAL YEAR	SHEET NO.	TOTAL SHEETS
9	VT.				

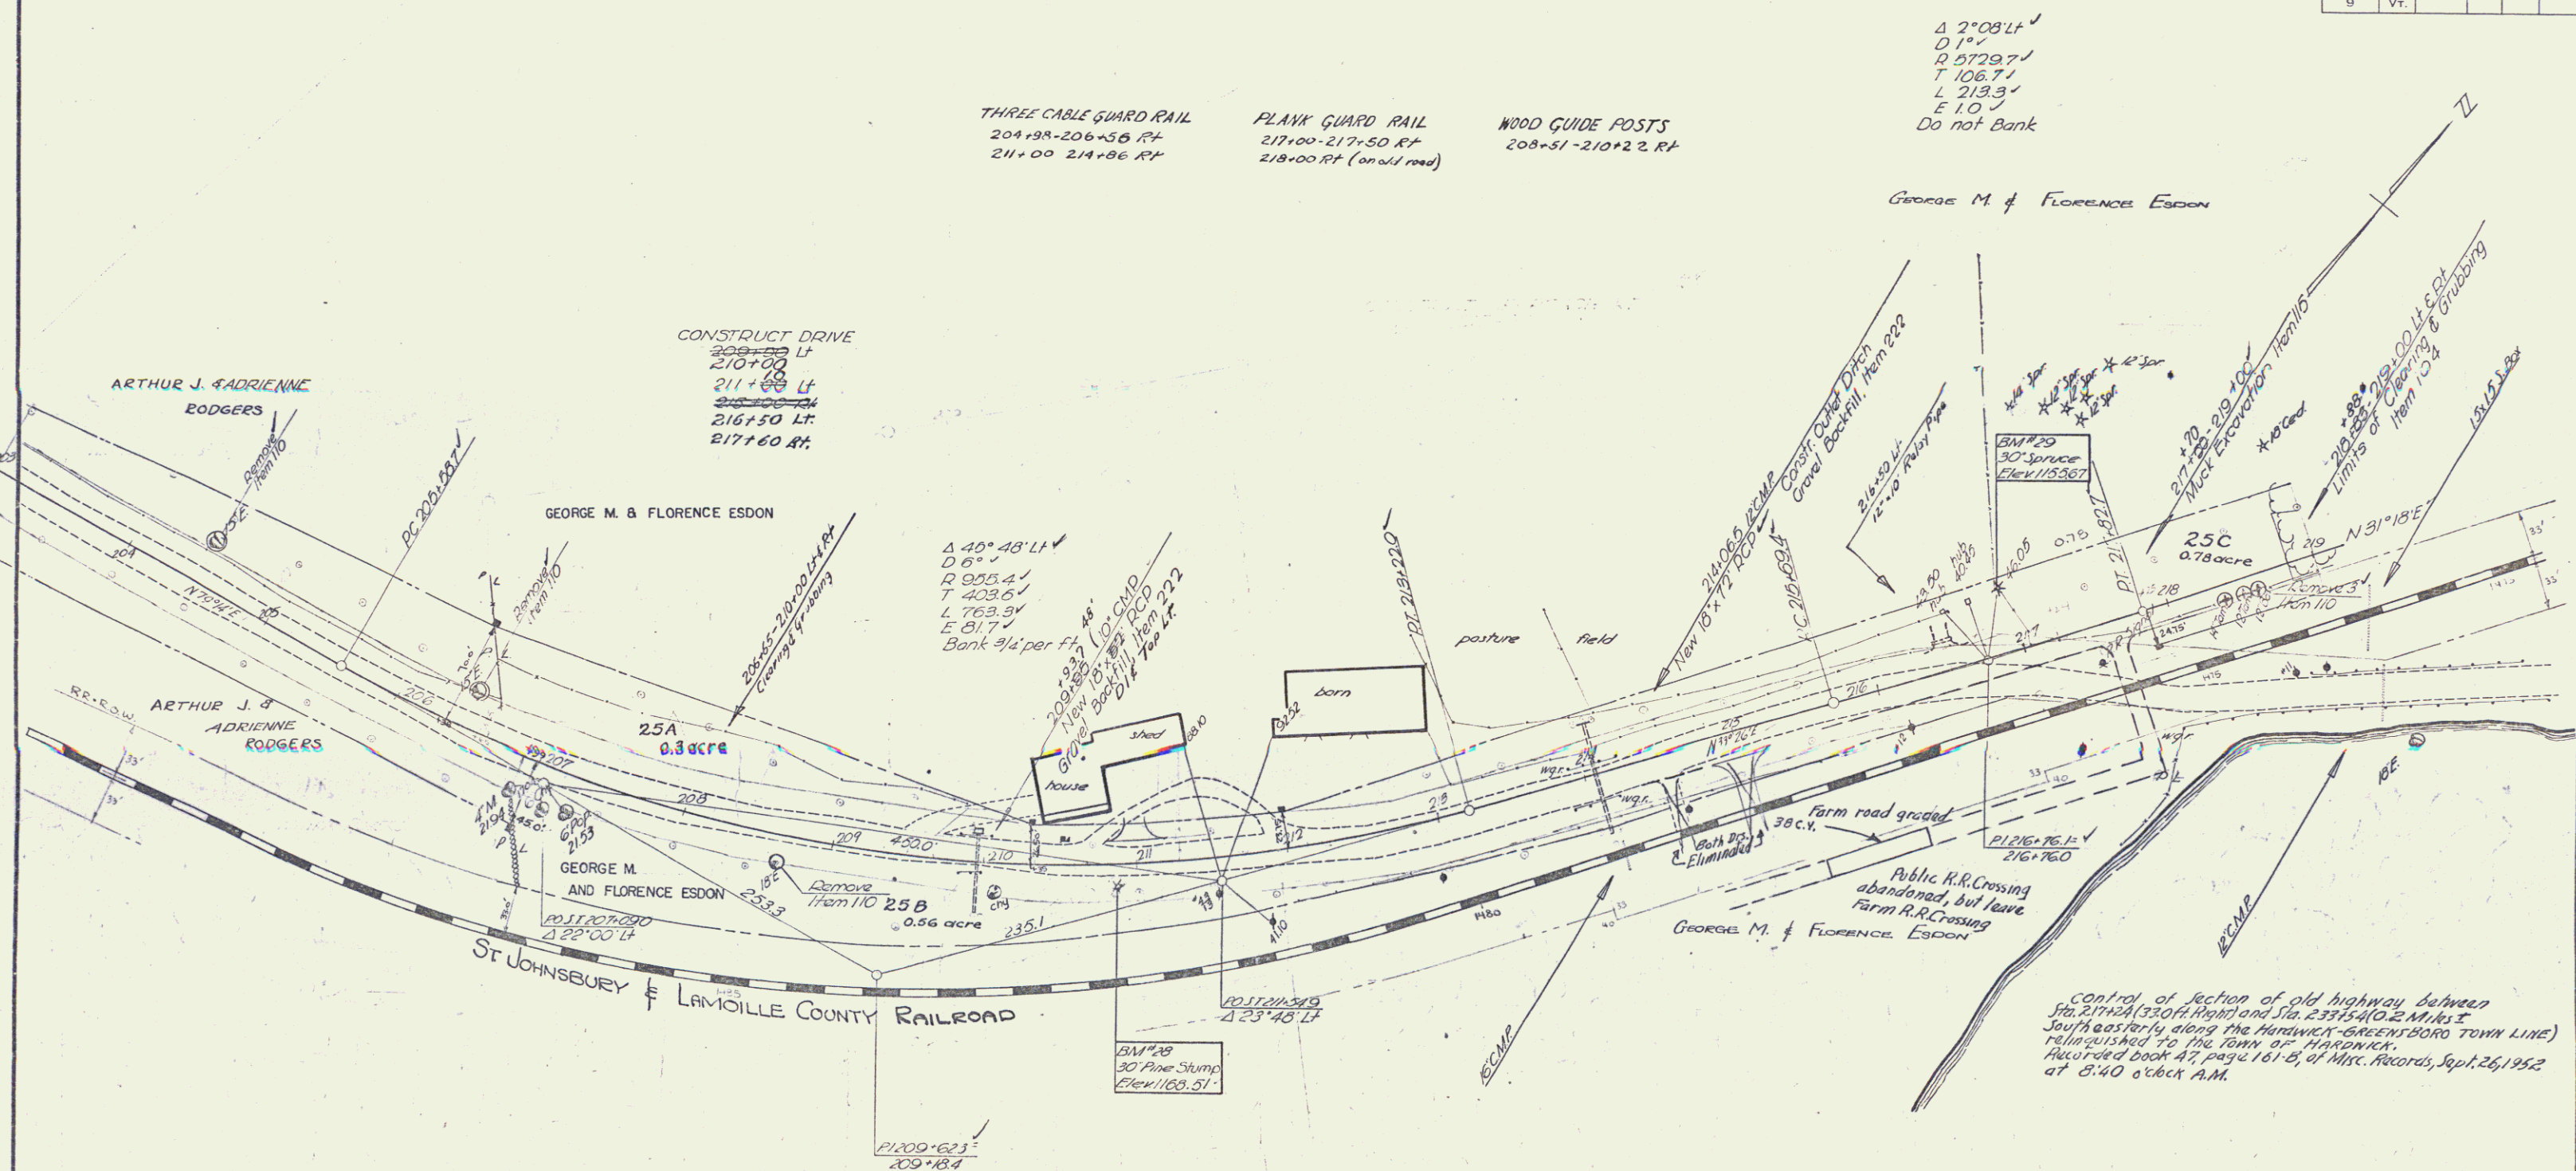


PARCEL #25
INSTRUMENT W.D.O.E.
DATE 6-29-50


GRANTOR GEORGE M.
FLORENCE ESDON
GRANTEE ST. OF VT.

RECORDED HARDWICK
BOOK 43
PAGE 54
DATE 7-26-50

HARDWICK-GREENSBORO
Surveyed by Spaulding
Designed by
Drawn by
Traced by N. Stevens Jr.
Checked by
Series F No. 167(3) Filed
Sheet 19 of 215 Sheets


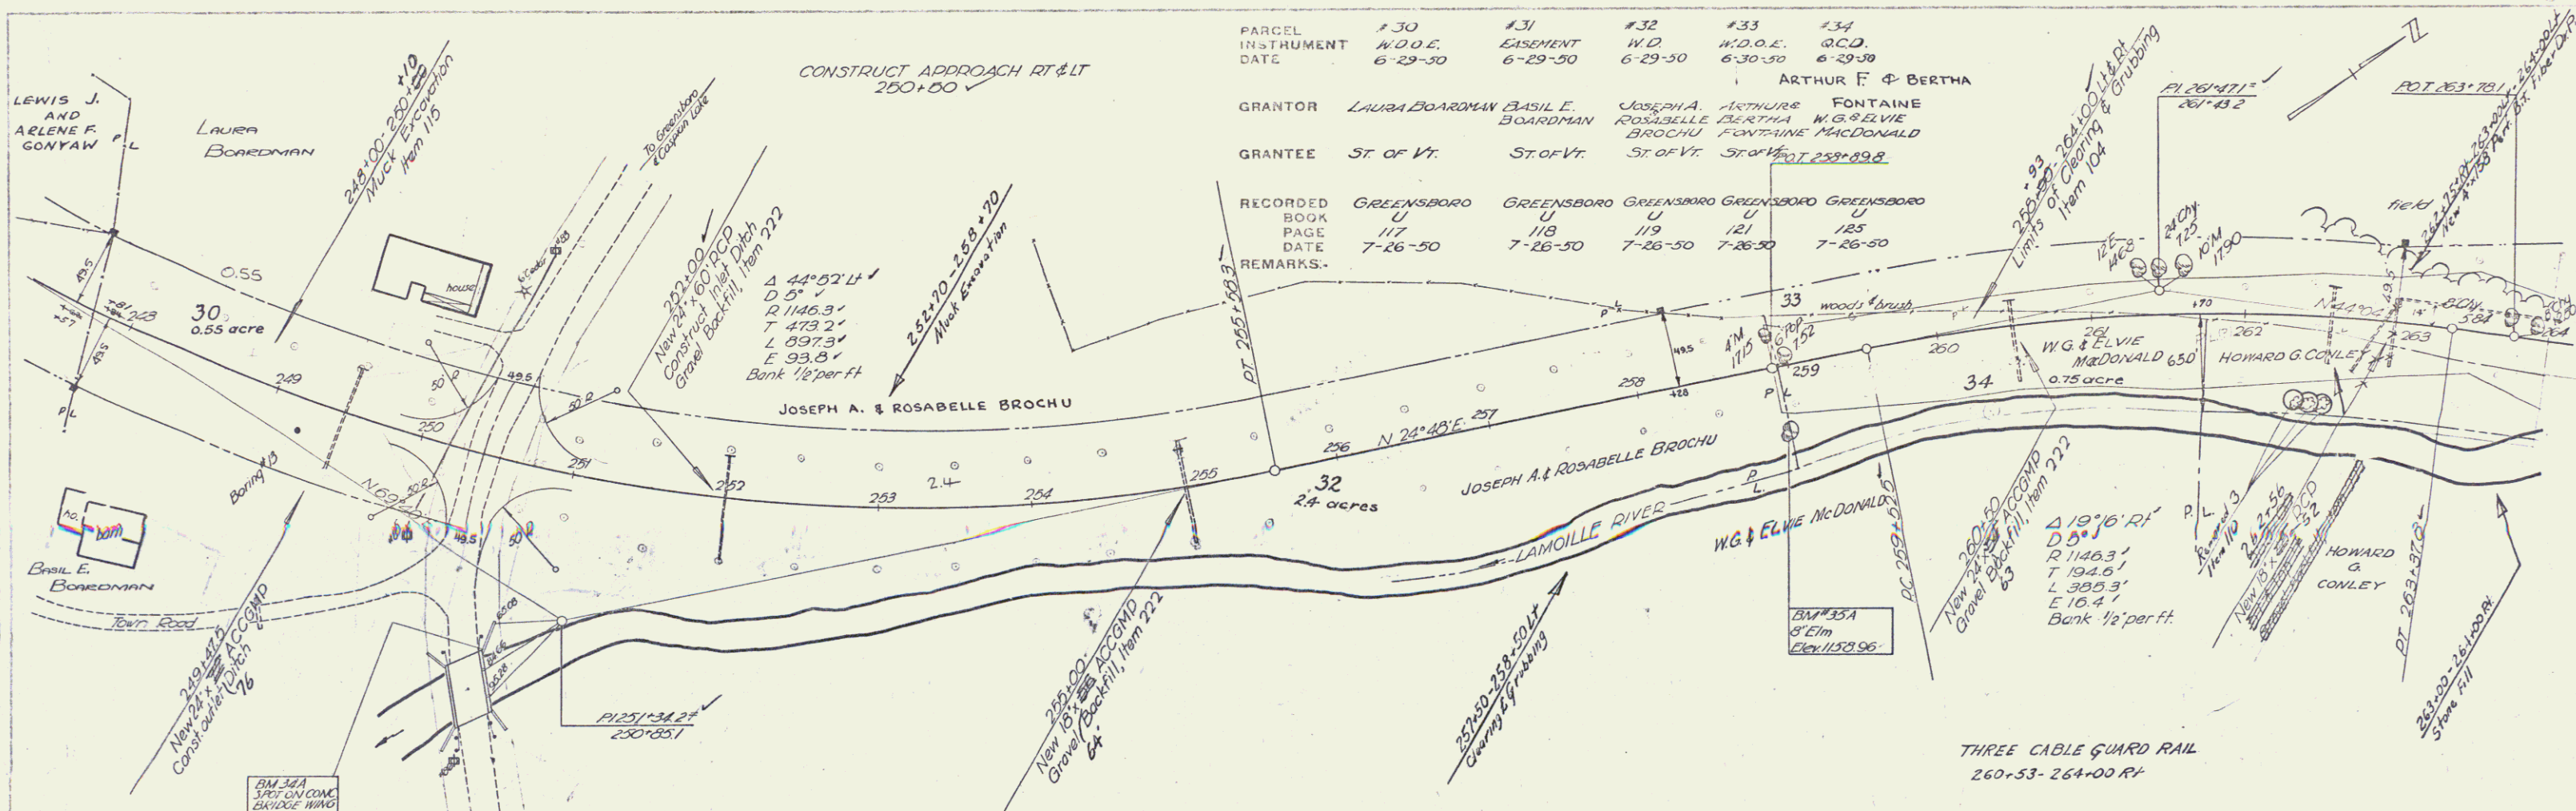



PARGEL	#30	#31	#32	#33	#34
INSTRUMENT	N.D.O.E.	EASEMENT	N.D.	N.D.O.E.	G.C.D.
DATE	6-29-50	6-29-50	6-29-50	6-30-50	6-29-50
GRANTOR	ARTHUR F. & BERTHA				
GRANTEE	ST. OF VT.	ST. OF VT.	ST. OF VT.	ST. OF VT.	ST. OF VT.
RECORDED BOOK	GREENSBORO	GREENSBORO	GREENSBORO	GREENSBORO	GREENSBORO
PAGE	117	118	119	121	125
DATE	7-26-50	7-26-50	7-26-50	7-26-50	7-26-50
REMARKS					

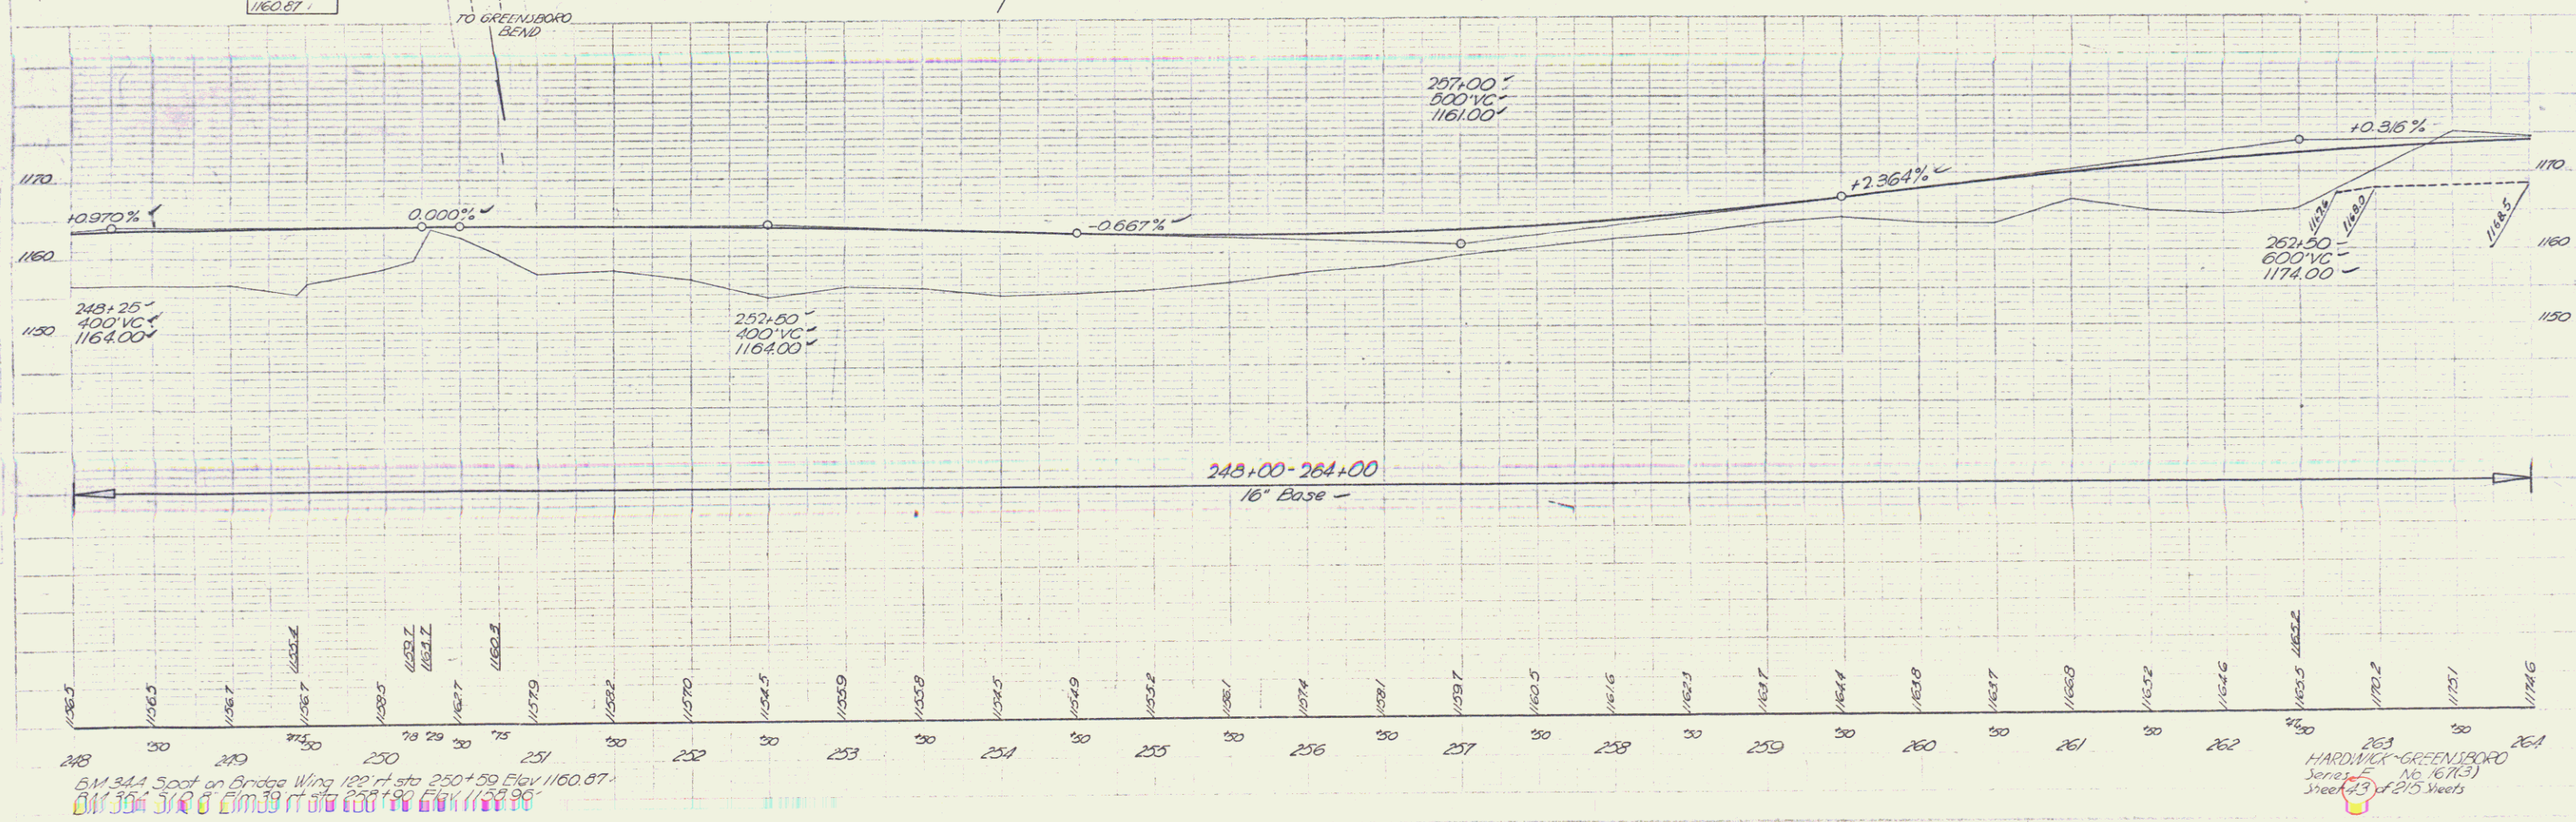

BM 344 Spot on Bridge Wing 122 ft. sta 250+59 Elev 1160.87
BM 344 Spot on Bridge Wing 122 ft. sta 250+59 Elev 1160.87


HARDWICK-GREENSBORO
Series No. 167(3)
Sheet 43 of 210 Sheets

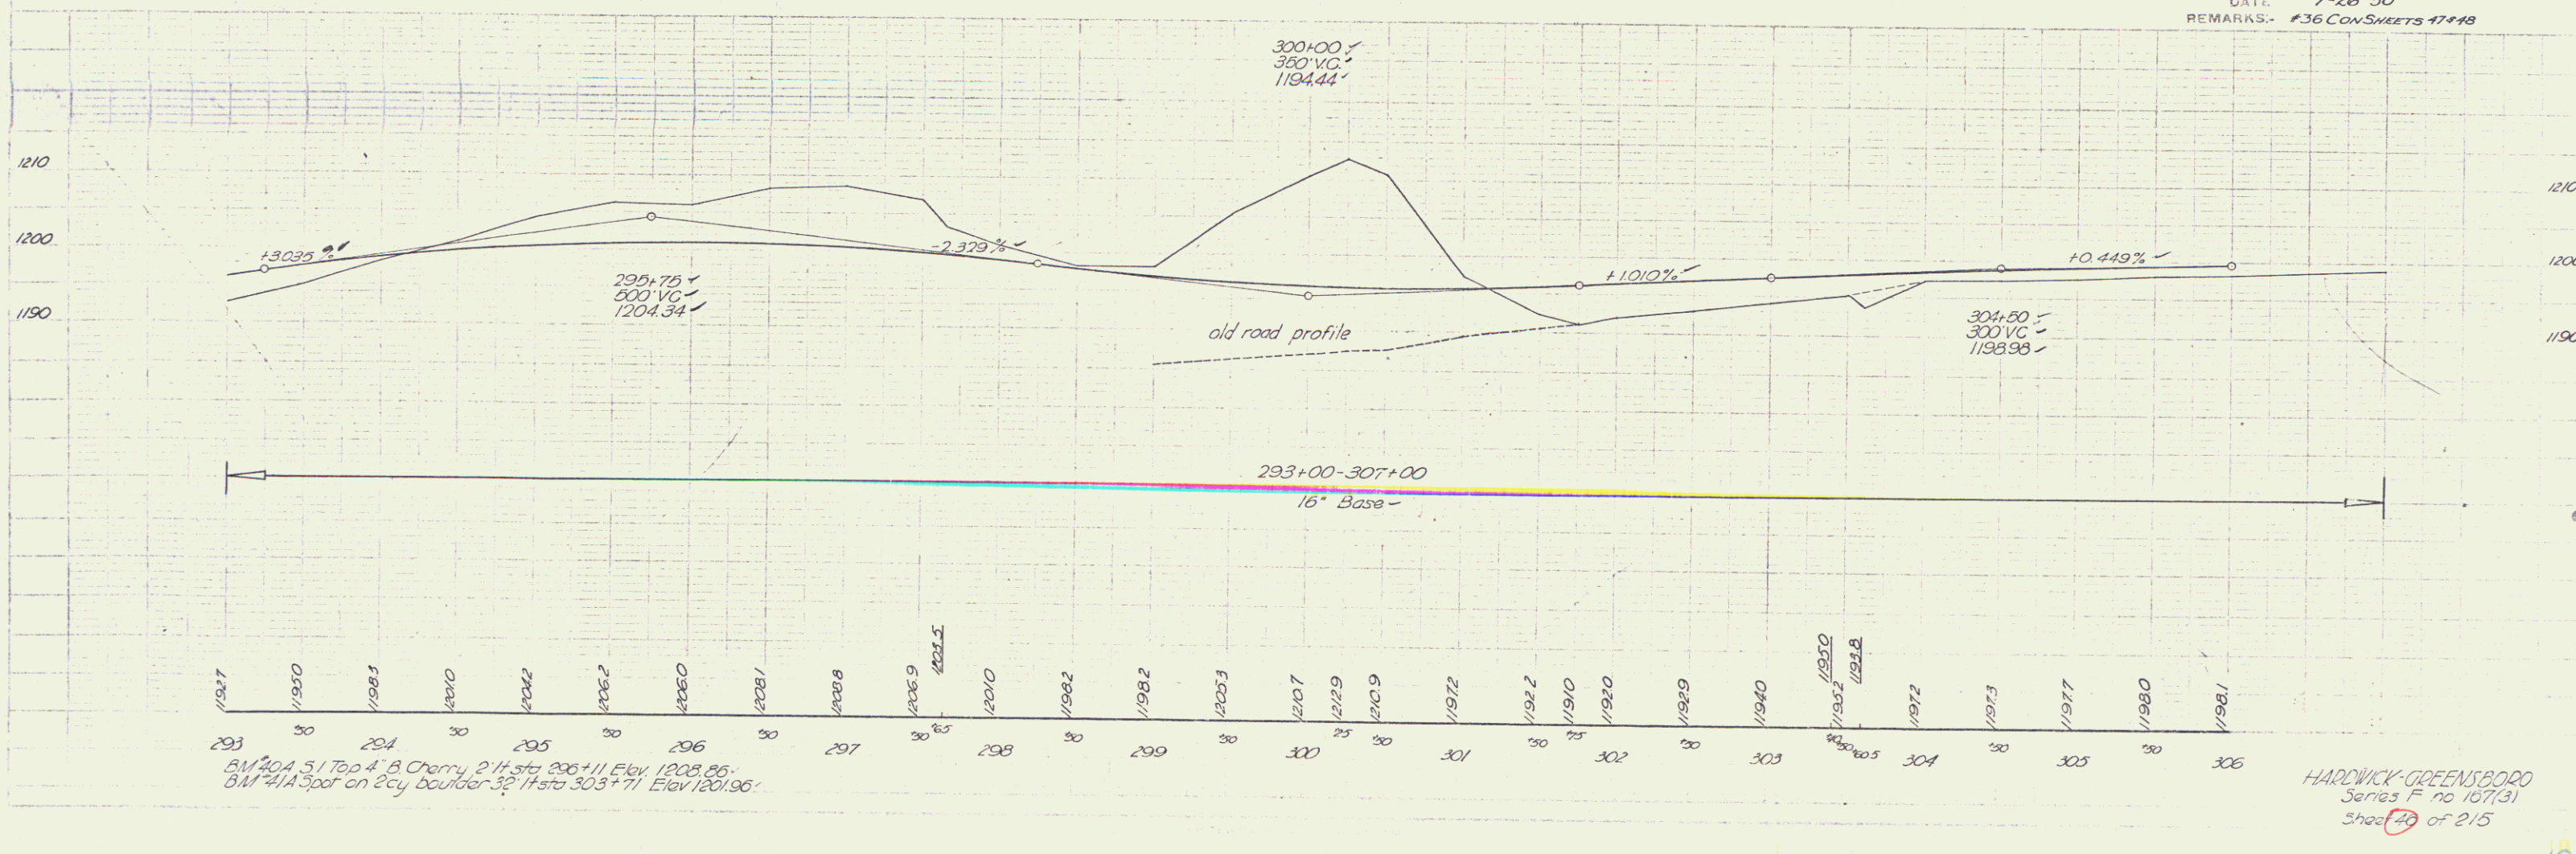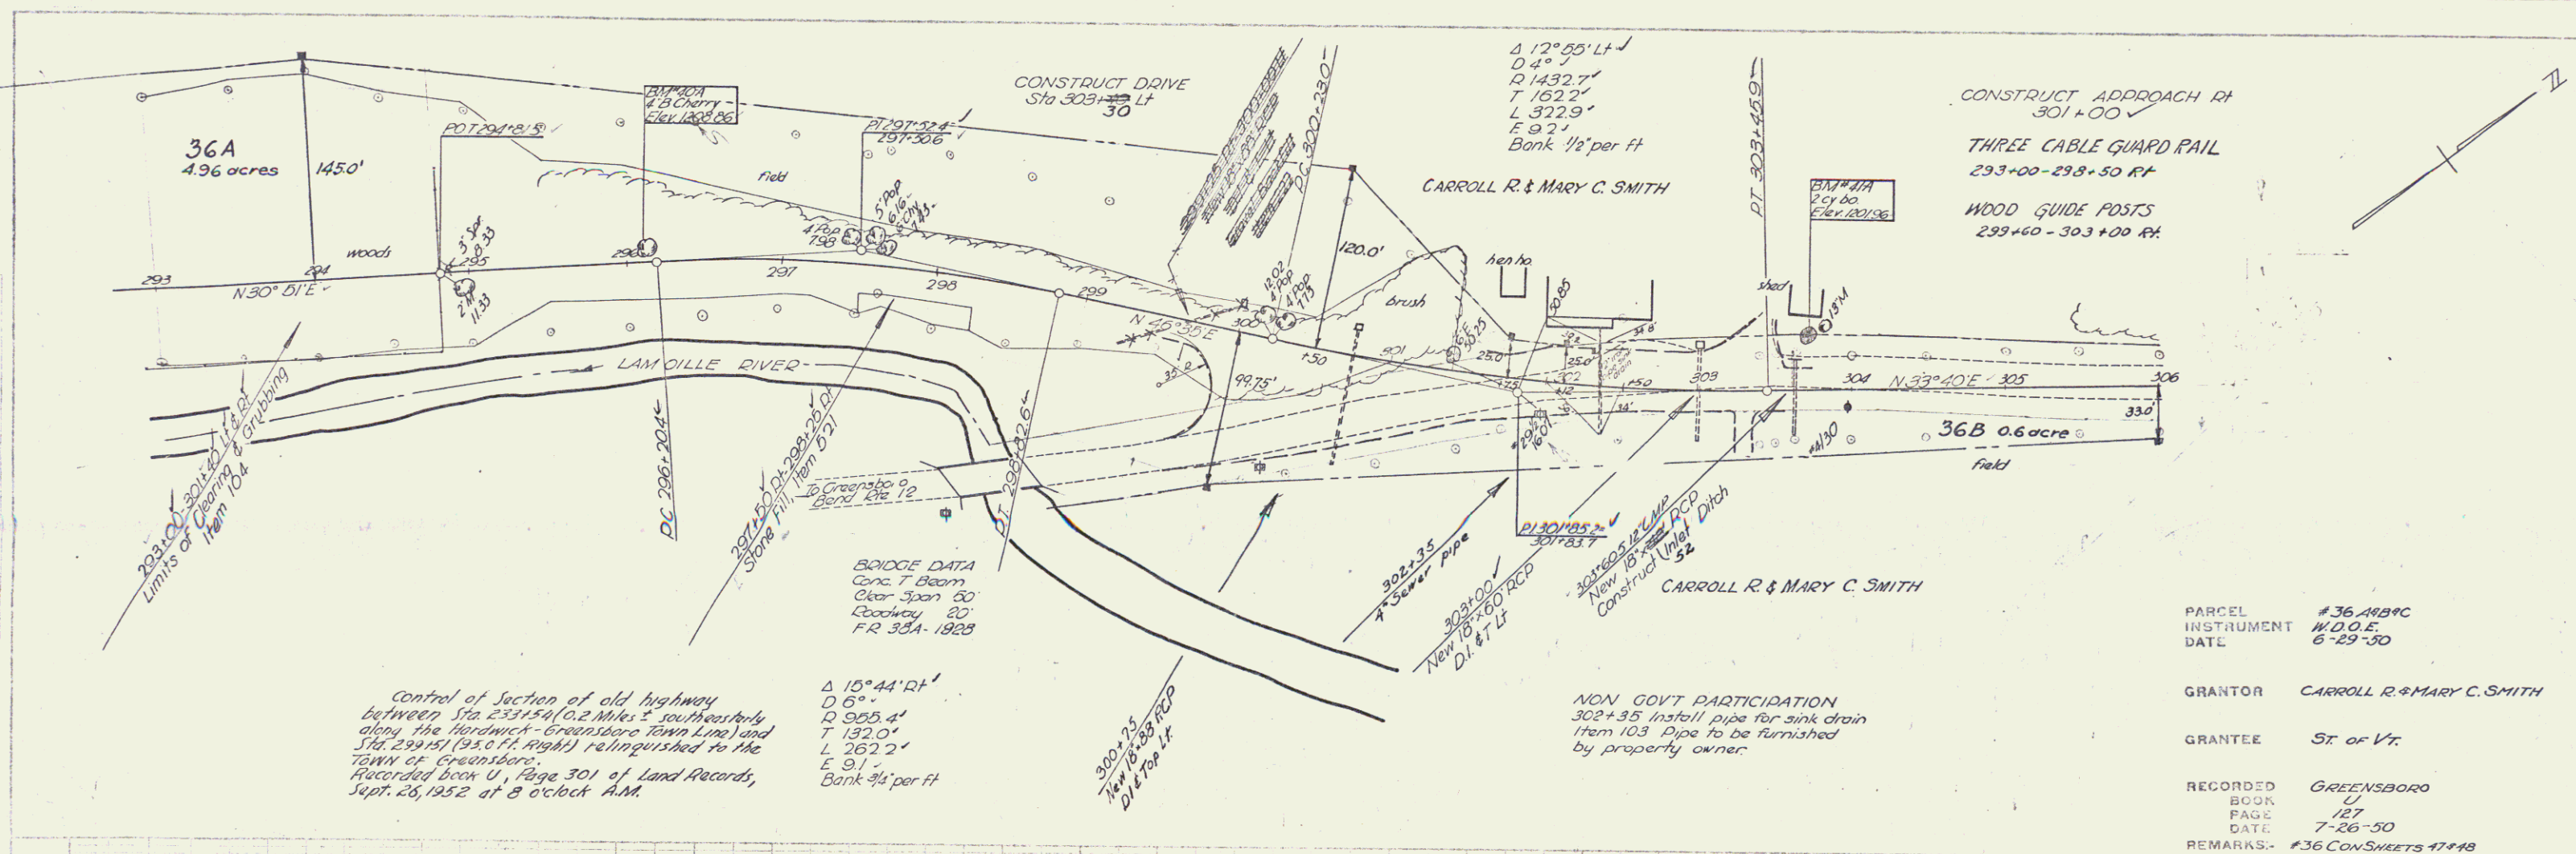

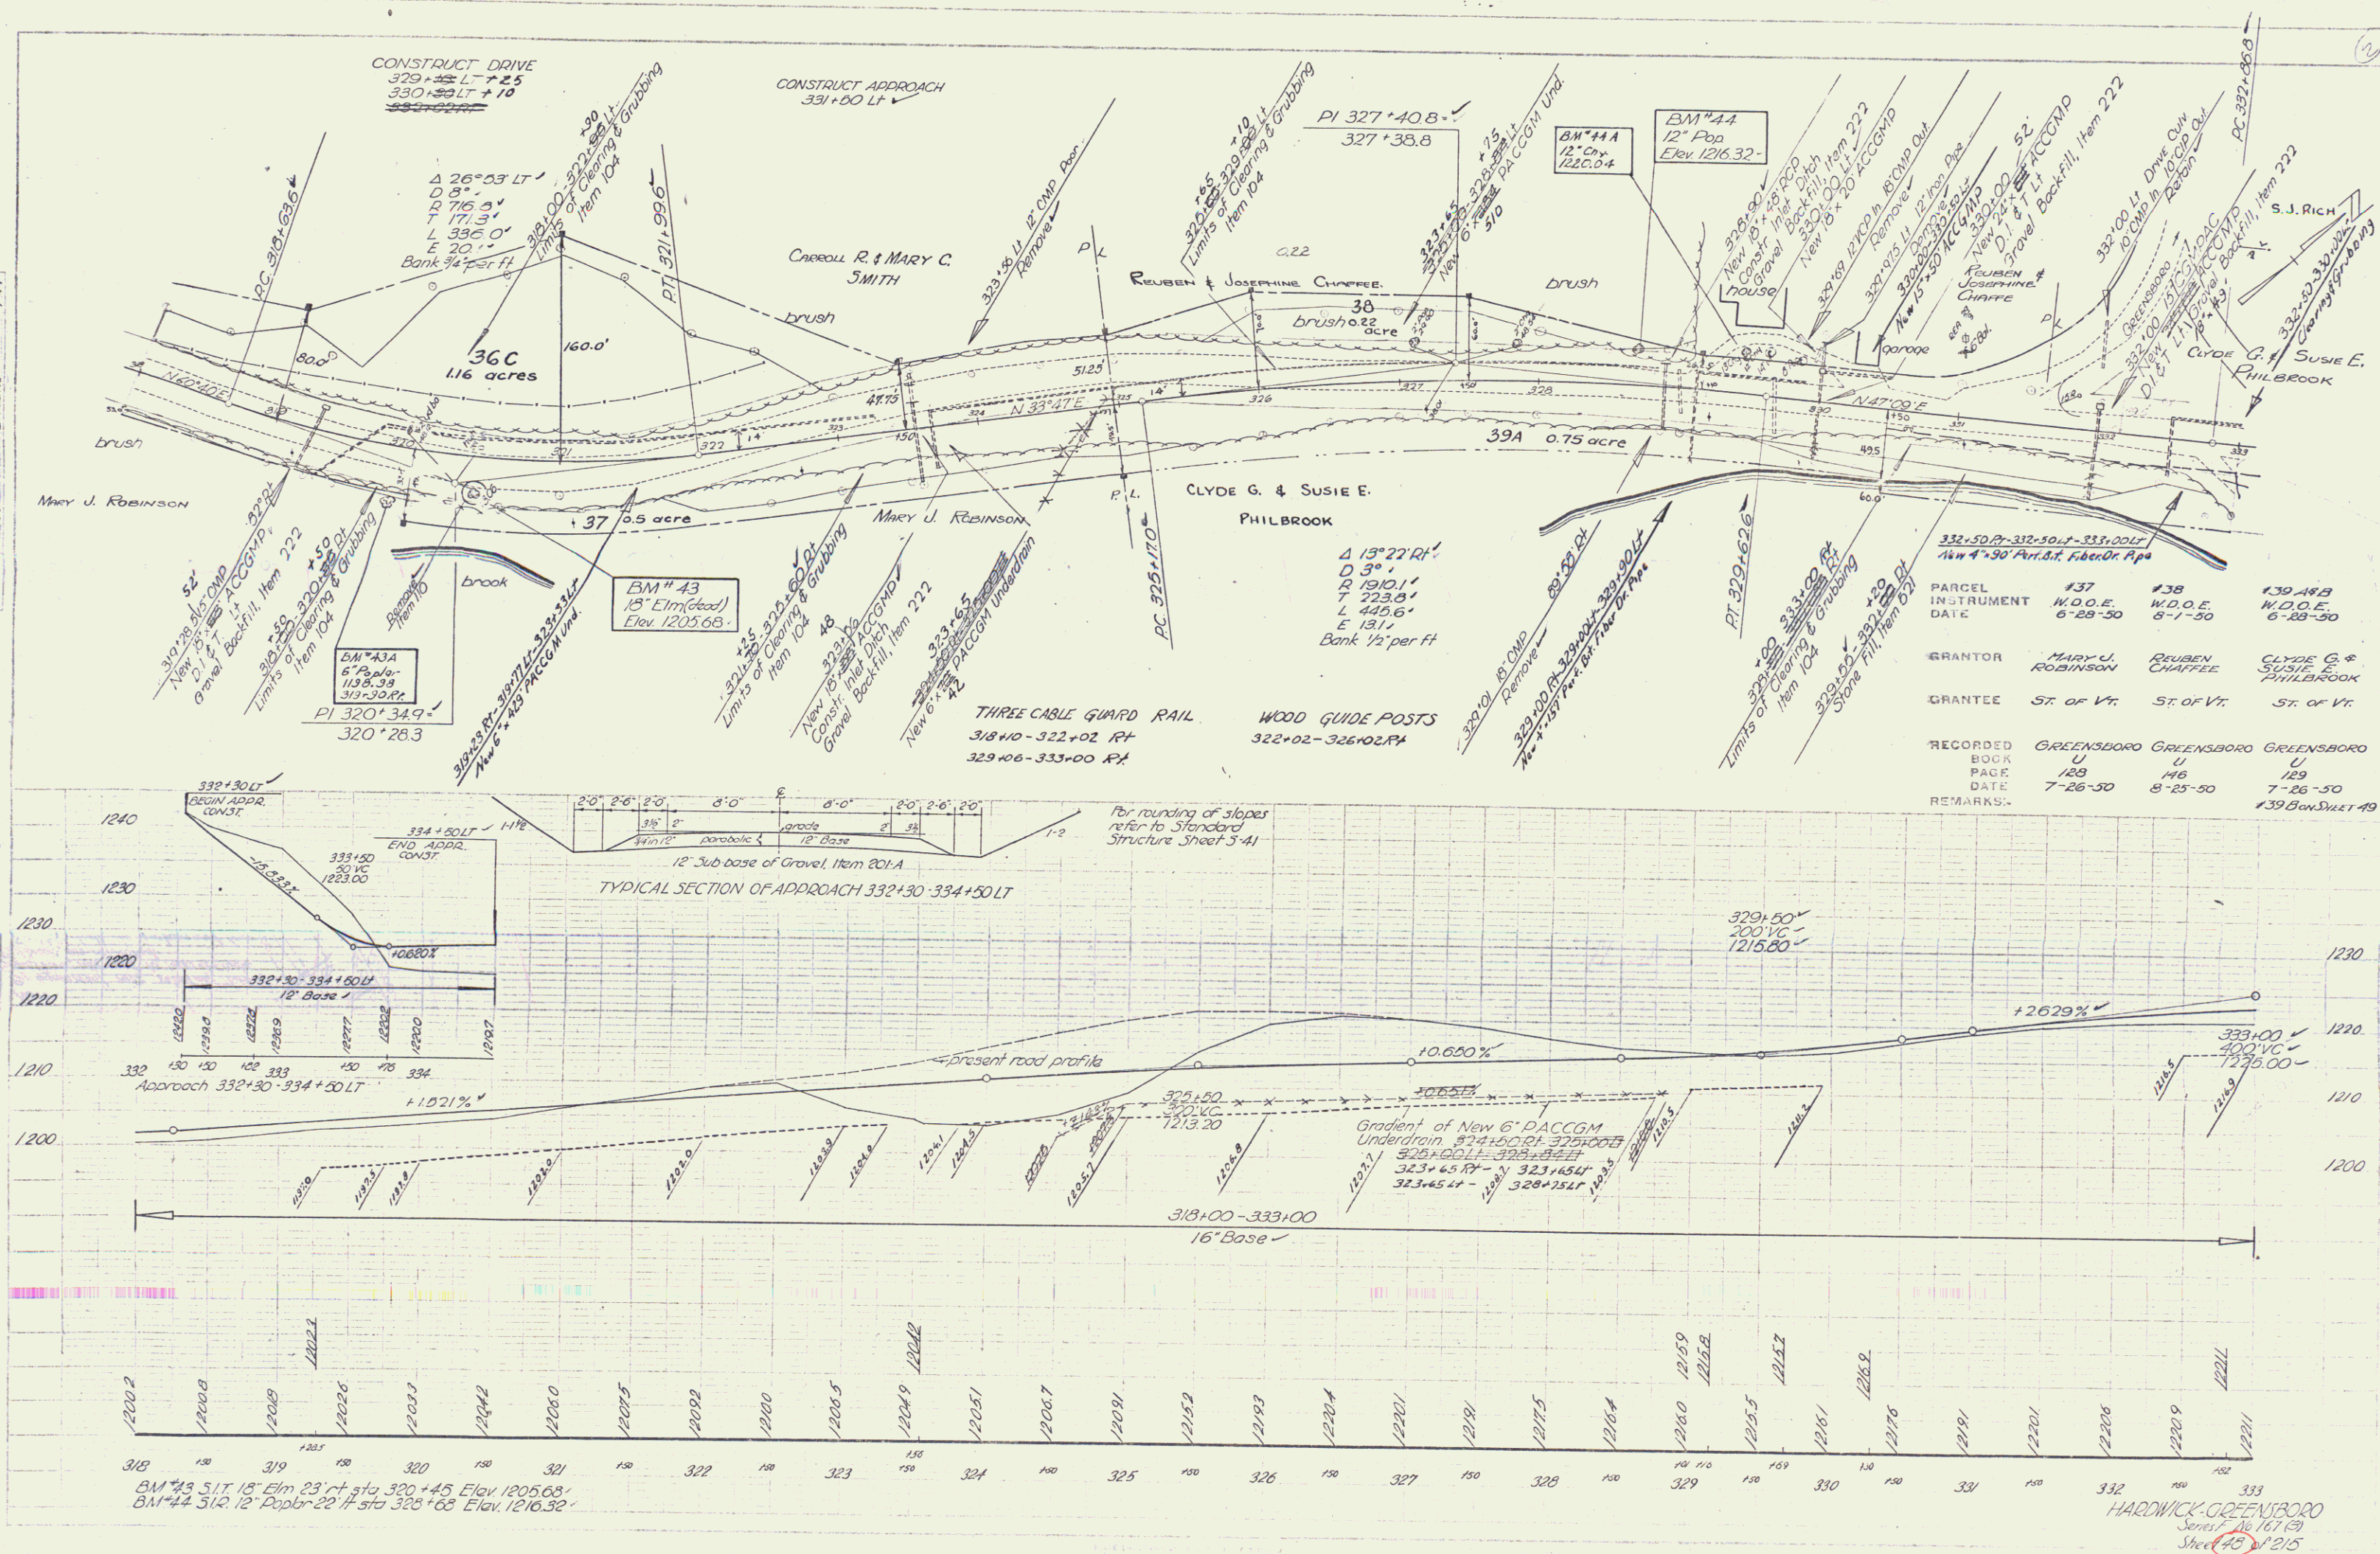

Scale
1" = 100'
1" = 100'

Scale
1" = 100'
1" = 100'

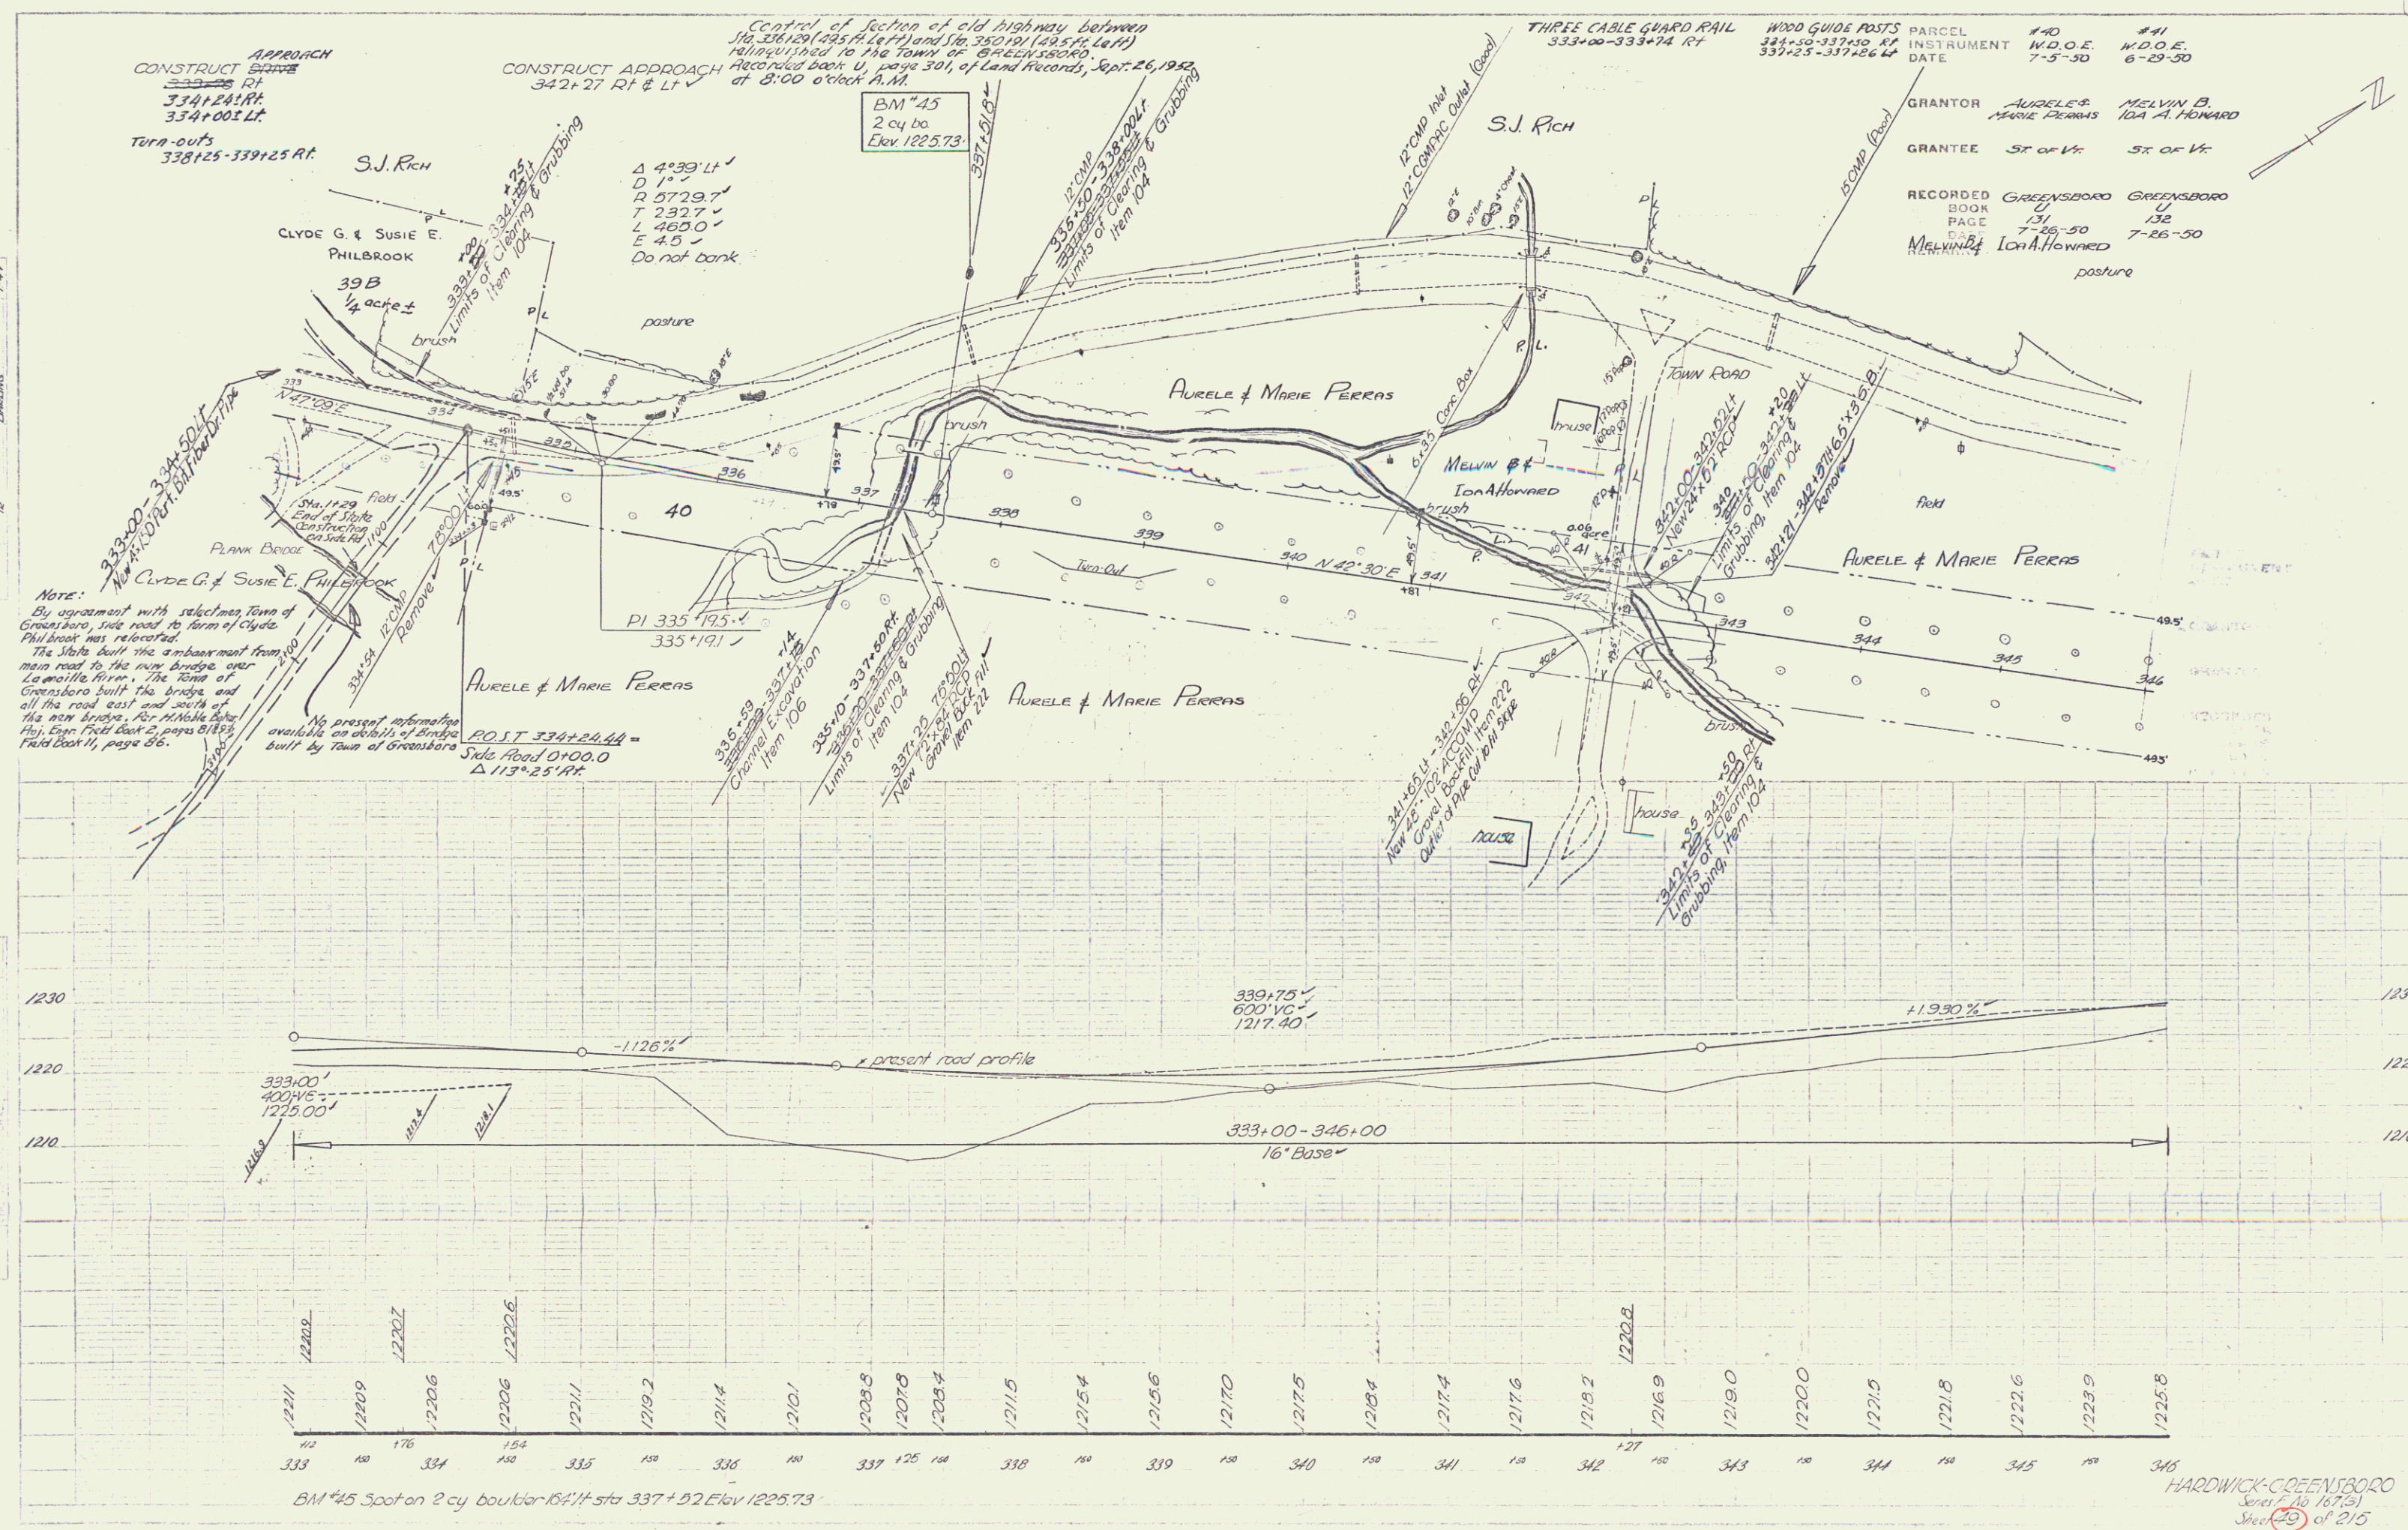

GRANTOR	AURELE & MARIE PERREAS	MELVIN B. & IDA A. HOWARD
GRANTEE	ST of VT	ST of VT
RECORDED BOOK	GREENSBORO 131	GREENSBORO 132
PAGE	7-25-50	7-25-50
DATE	7-25-50	7-25-50

THREE CABLE GUARD RAIL
351+58-353+00 RT

WOOD GUIDE POSTS
350+00-350+36 RT
350+00-354+12 LT

BM #46
24" Stump
Elev 1236.33

Approach
POT 2+00.0

pasture

MELVIN SHAWNEE
IDA A. HOWARD

12' O.M.P. DRAIN 10' V.C. 10' DRAIN

12' Sub-base of Gravel
TYPICAL SECTION OF APPROACH 349+30 LT
Control of Section of old highway between
Sta 336+29 (485 ft. left) and Sta 350+91 (425 ft. left)
Relinquished to the Town of GREENSBORO,
Recorded Book U, page 301, of Land Records, Sept. 26, 1952
at 8:00 o'clock A.M.
Jack & Olga O. Gomes

pasture

TURNOUT CONSTRUCTED
355+00-355+50 RT

16° 49' LT
D 4°
R 1432.7
T 211.8
L 420.4
E 10.3
Bank 1/2 per ft

12' O.M.P. DRAIN 10' V.C. 10' DRAIN

12' O.M.P. DRAIN 10' V.C. 10' DRAIN


12' O.M.P. DRAIN 10' V.C. 10' DRAIN

12' O.M.P. DRAIN 10' V.C. 10' DRAIN


12' O.M.P. DRAIN 10' V.C. 10' DRAIN

12' O.M.P. DRAIN 10' V.C. 10' DRAIN

PLAN
DATE: 7-26-50
BY: J. B. BROWN
CHECKED: J. B. BROWN
APPROVED: J. B. BROWN

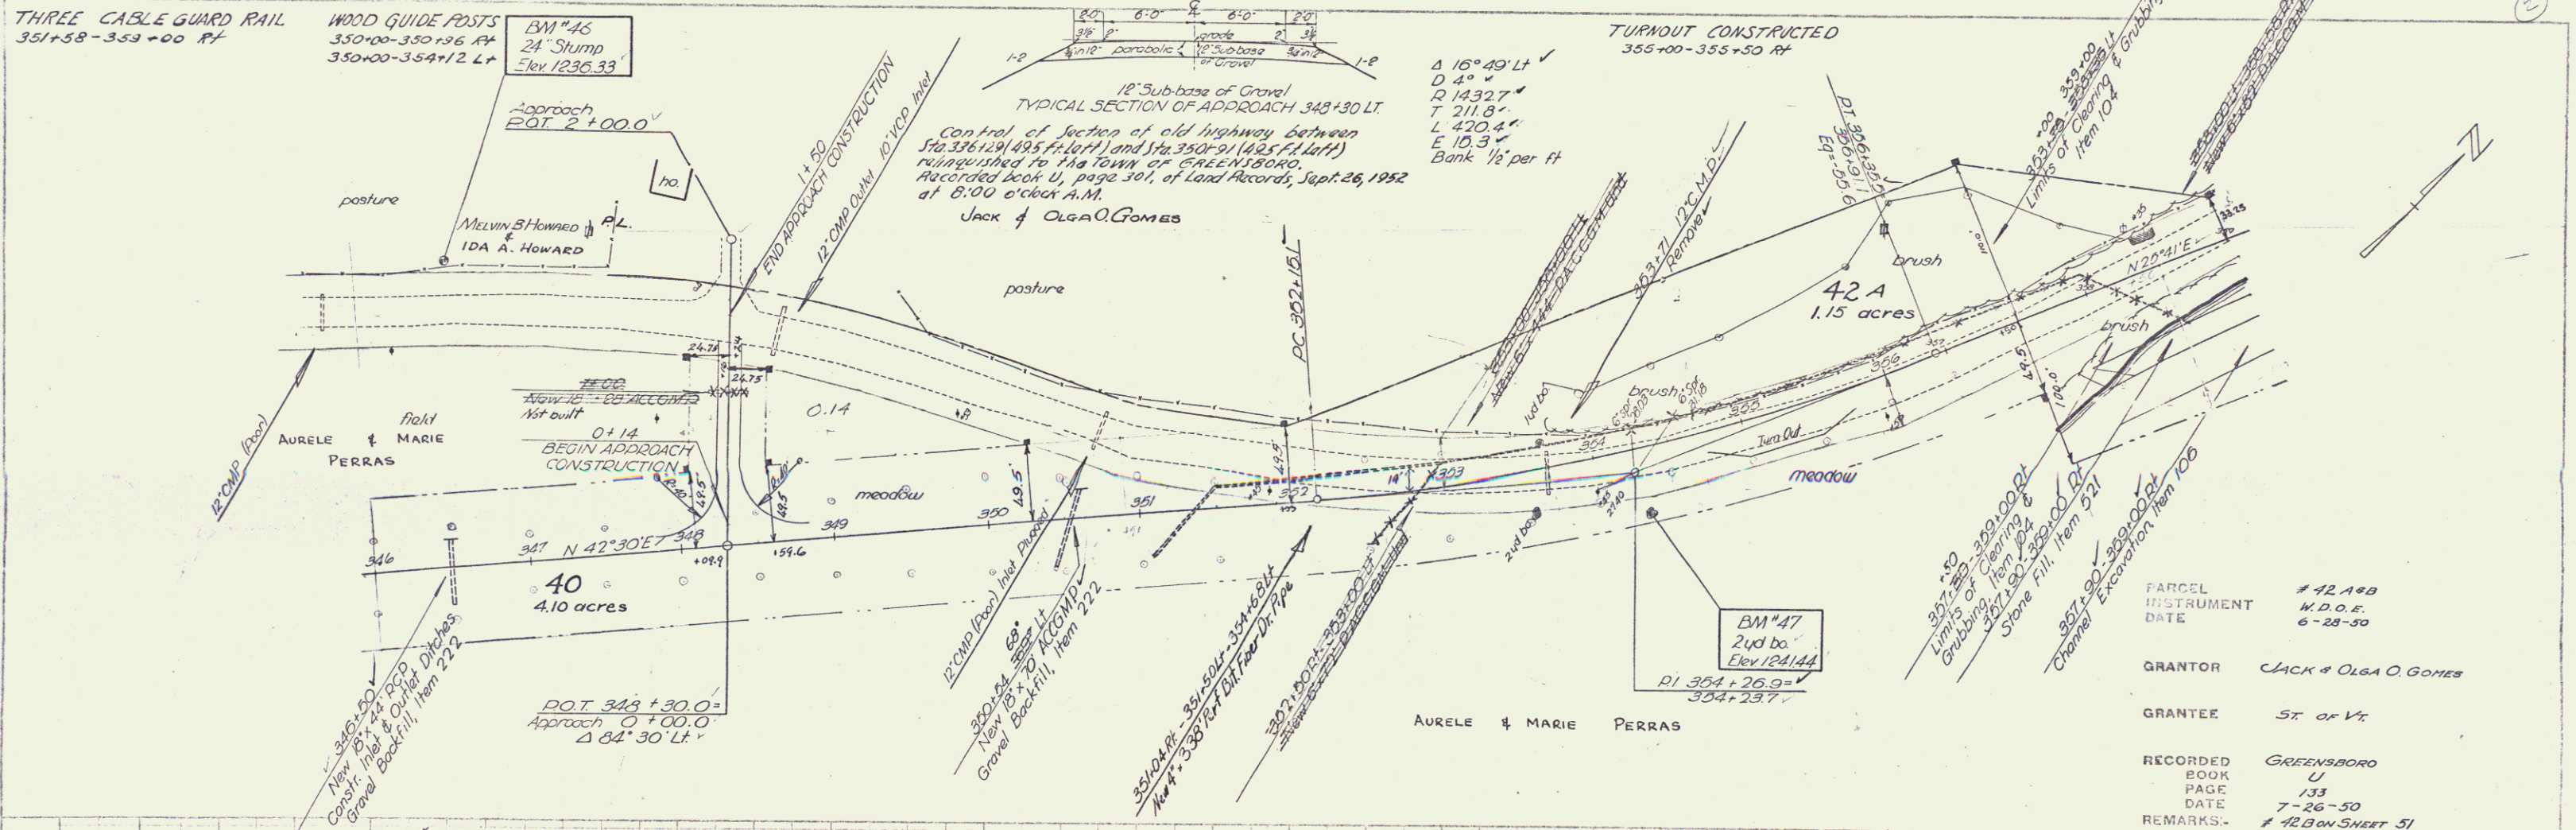

PARCEL INSTRUMENT # 42 A+B
DATE W.D.O.E. 6-28-50
GRANTOR JACK & OLGA O. GOMES
GRANTEE ST. OF VT.
RECORDED BOOK GREENSBORO
PAGE 133
DATE 7-26-50
REMARKS: # 42 BOW SHEET 51

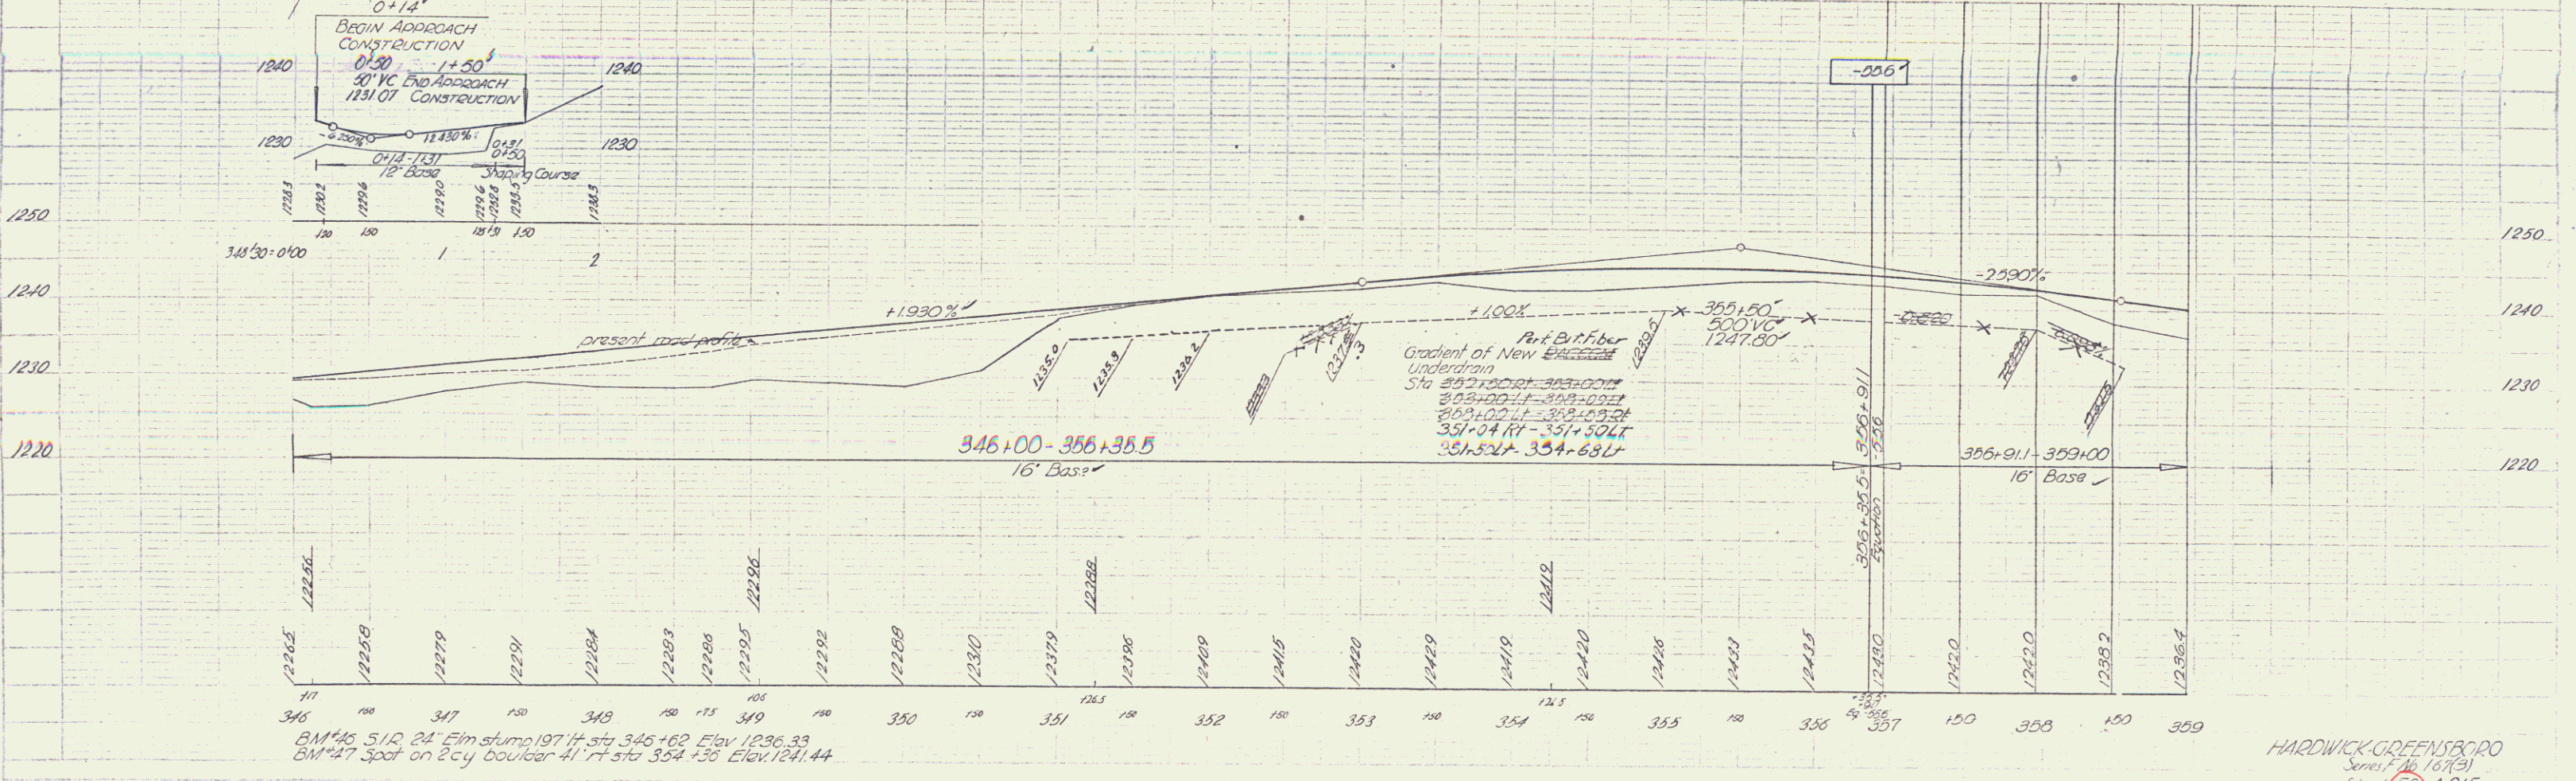

BM #46 51/2 24" Elm stump 197 ft. sta 346+62 Elev 1236.33
BM #47 Spot on 2-y boulder 41 ft sta 354+35 Elev 1241.44

HARDWICK-GREENSBORO
Sheet 50 of 215

PLAN
Scale: 1" = 40'
Sheet No. 1 of 1
Date: 10/1/54
By: J. B. Smith
Checked: J. B. Smith

748
945
S. B. Smith
10/1/54

