

STANDARD STRUCTURE SHEET APPROVED BY THE CHIEF
ENGINEER, VERMONT STATE DEPARTMENT OF HIGHWAY.

S-40 JUNE 10, 1950

STATE OF VERMONT
DEPARTMENT OF HIGHWAYS

PROPOSED IMPROVEMENT

STATE PROJECT

TOWNS OF LONDONDERRY-WESTON

COUNTIES OF WINDHAM-WINDSOR
VERMONT ROUTE 8
LONDONDERRY-WESTON ROAD

BEGINNING AT A POINT 2,072.0 FEET SOUTH OF THE LONDONDERRY-
WESTON TOWN LINE AND EXTENDING NORTHERLY 11,272.7 FEET. ✓
(EXCLUDING BRIDGE) 3

LENGTH OF PROJECT ✓ 11,215.7 FEET = 2.124 MILES ✓

GROUND ELEVATION		DATE	NO.	LINE
GRADE ELEVATION		DATE	NO.	LINE
CURVE DATA				
DEFLECTION OF ANGLE		A		
DEGREE OF CURVE		D		
RADIUS OF CURVE		R		
TANGENT DISTANCE		T		
LENGTH OF CURVE		L		
EXTERNAL DISTANCE		E		
POINT OF INTERSECTION		PI		
POINT OF CURVE		PG		
POINT OF TANGENT		PT		
POINT ON TANGENT		POF		
POINT ON SUB-TANGENT		POST		

SCALES		
TITLE		50
TYPICAL		2
PLAN		5
PROFILE	HORIZONTAL	5
	VERTICAL	11
CROSS-SECTIONS		

London derry
Weston

MP. 7.²⁵ to 7.65
mp. 0.0 to 1.5⁷⁴

RIGHT-OF-WAY DIVISION
TOWN FILE
PERPETUAL
Town of U R te. 100


THESE PLANS ARE SUBJECT TO SUCH REVISIONS AS MAY BE
REQUIRED BY THE BUREAU OF PUBLIC ROADS OR THE COMMISSIONER
OF HIGHWAYS.


CONSTRUCTION IS TO BE CARRIED ON IN ACCORDANCE WITH THE PLANS AND THE STANDARD ROAD AND BRIDGE SPECIFICATIONS OF 1948, AS APPROVED JULY 25, 1949 BY THE BUREAU OF PUBLIC ROADS, INCLUDING ALL SUBSEQUENT APPROVED REVISIONS AND SUCH REVISED SPECIFICATIONS AND SPECIAL PROVISIONS AS ARE SUBMITTED WITH THE PLANS.

NOTE: ANY FURTHER INFORMATION CONCERNING
FINAL QUANTITIES, AMOUNTS OR OTHER DETAILS
RELATIVE TO THIS PROJECT MAY BE FOUND IN
EITHER THE FIELD BOOKS OR THE ESTIMATED
FILE.

DEPARTMENT OF COMMERCE
BUREAU OF PUBLIC ROADS


APPROVED _____
DISTRICT ENGINEER _____ DATE _____
PROJECT ST NO 242 (L)
SHEET 1 OF 47 SHEETS

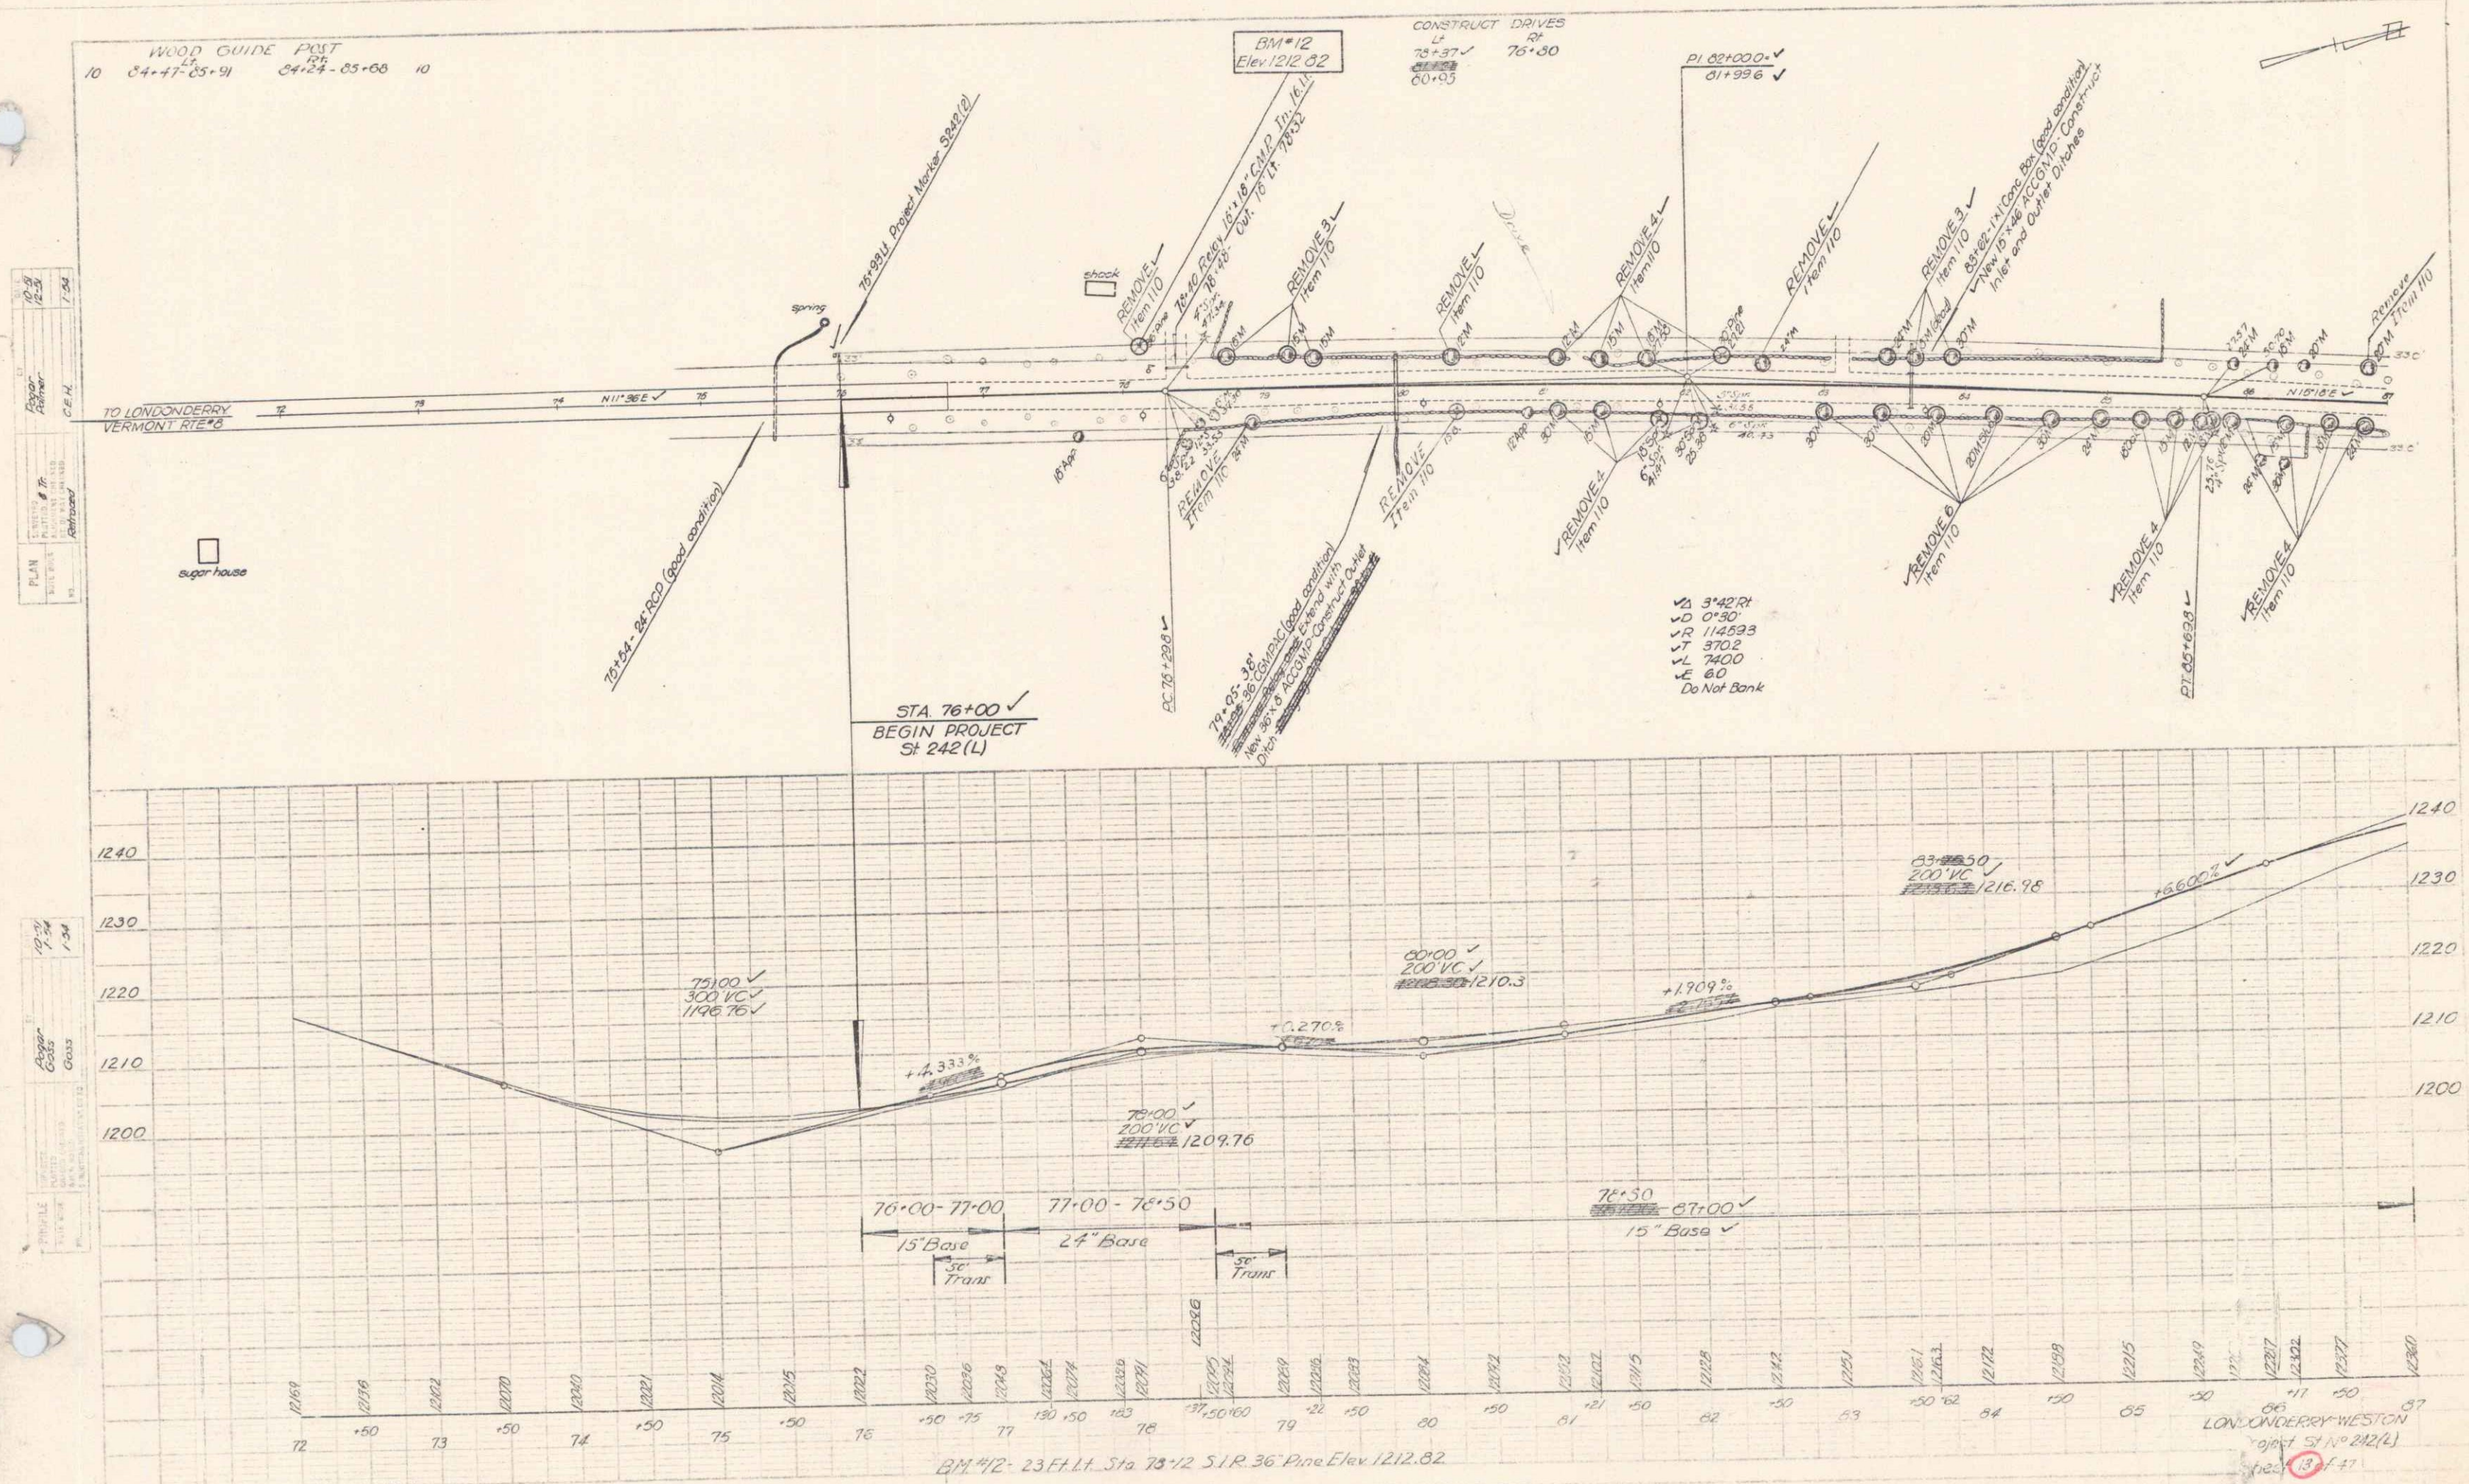


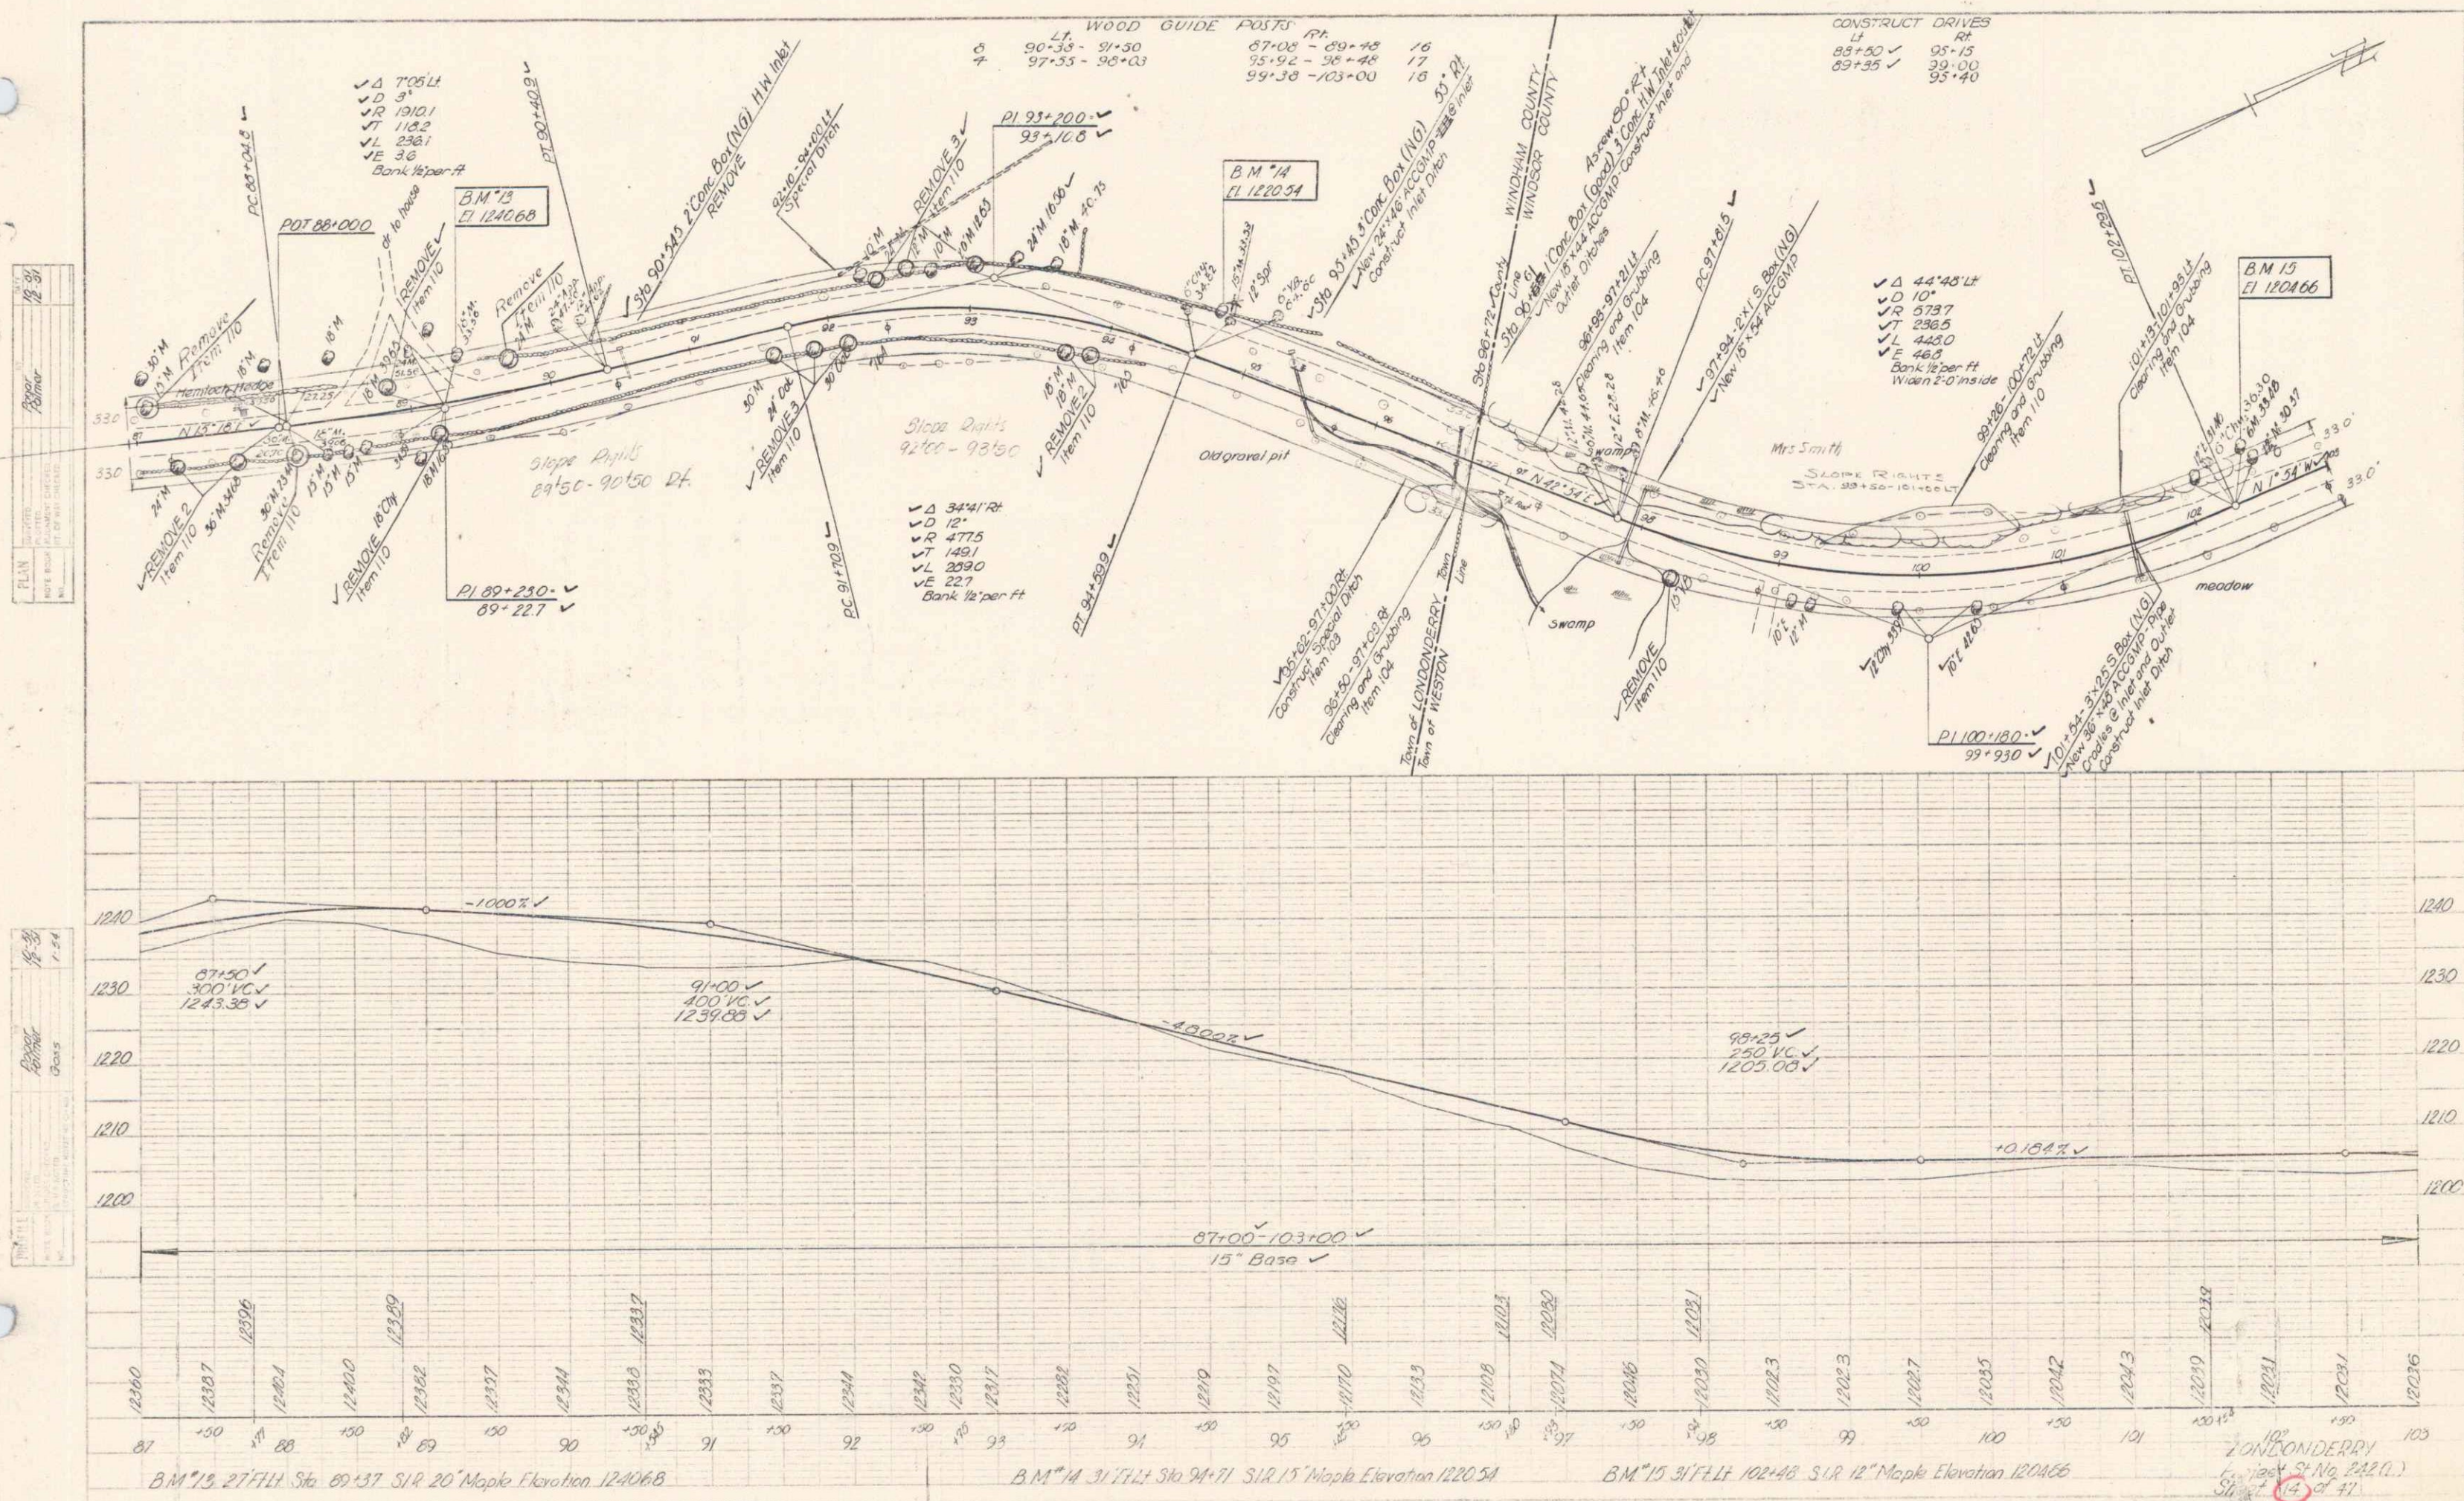



PLAN
 DATE 10/23/54
 BY [Signature]
 CHECKED [Signature]
 APPROVED [Signature]

PROFILE
 DATE 10/23/54
 BY [Signature]
 CHECKED [Signature]
 APPROVED [Signature]

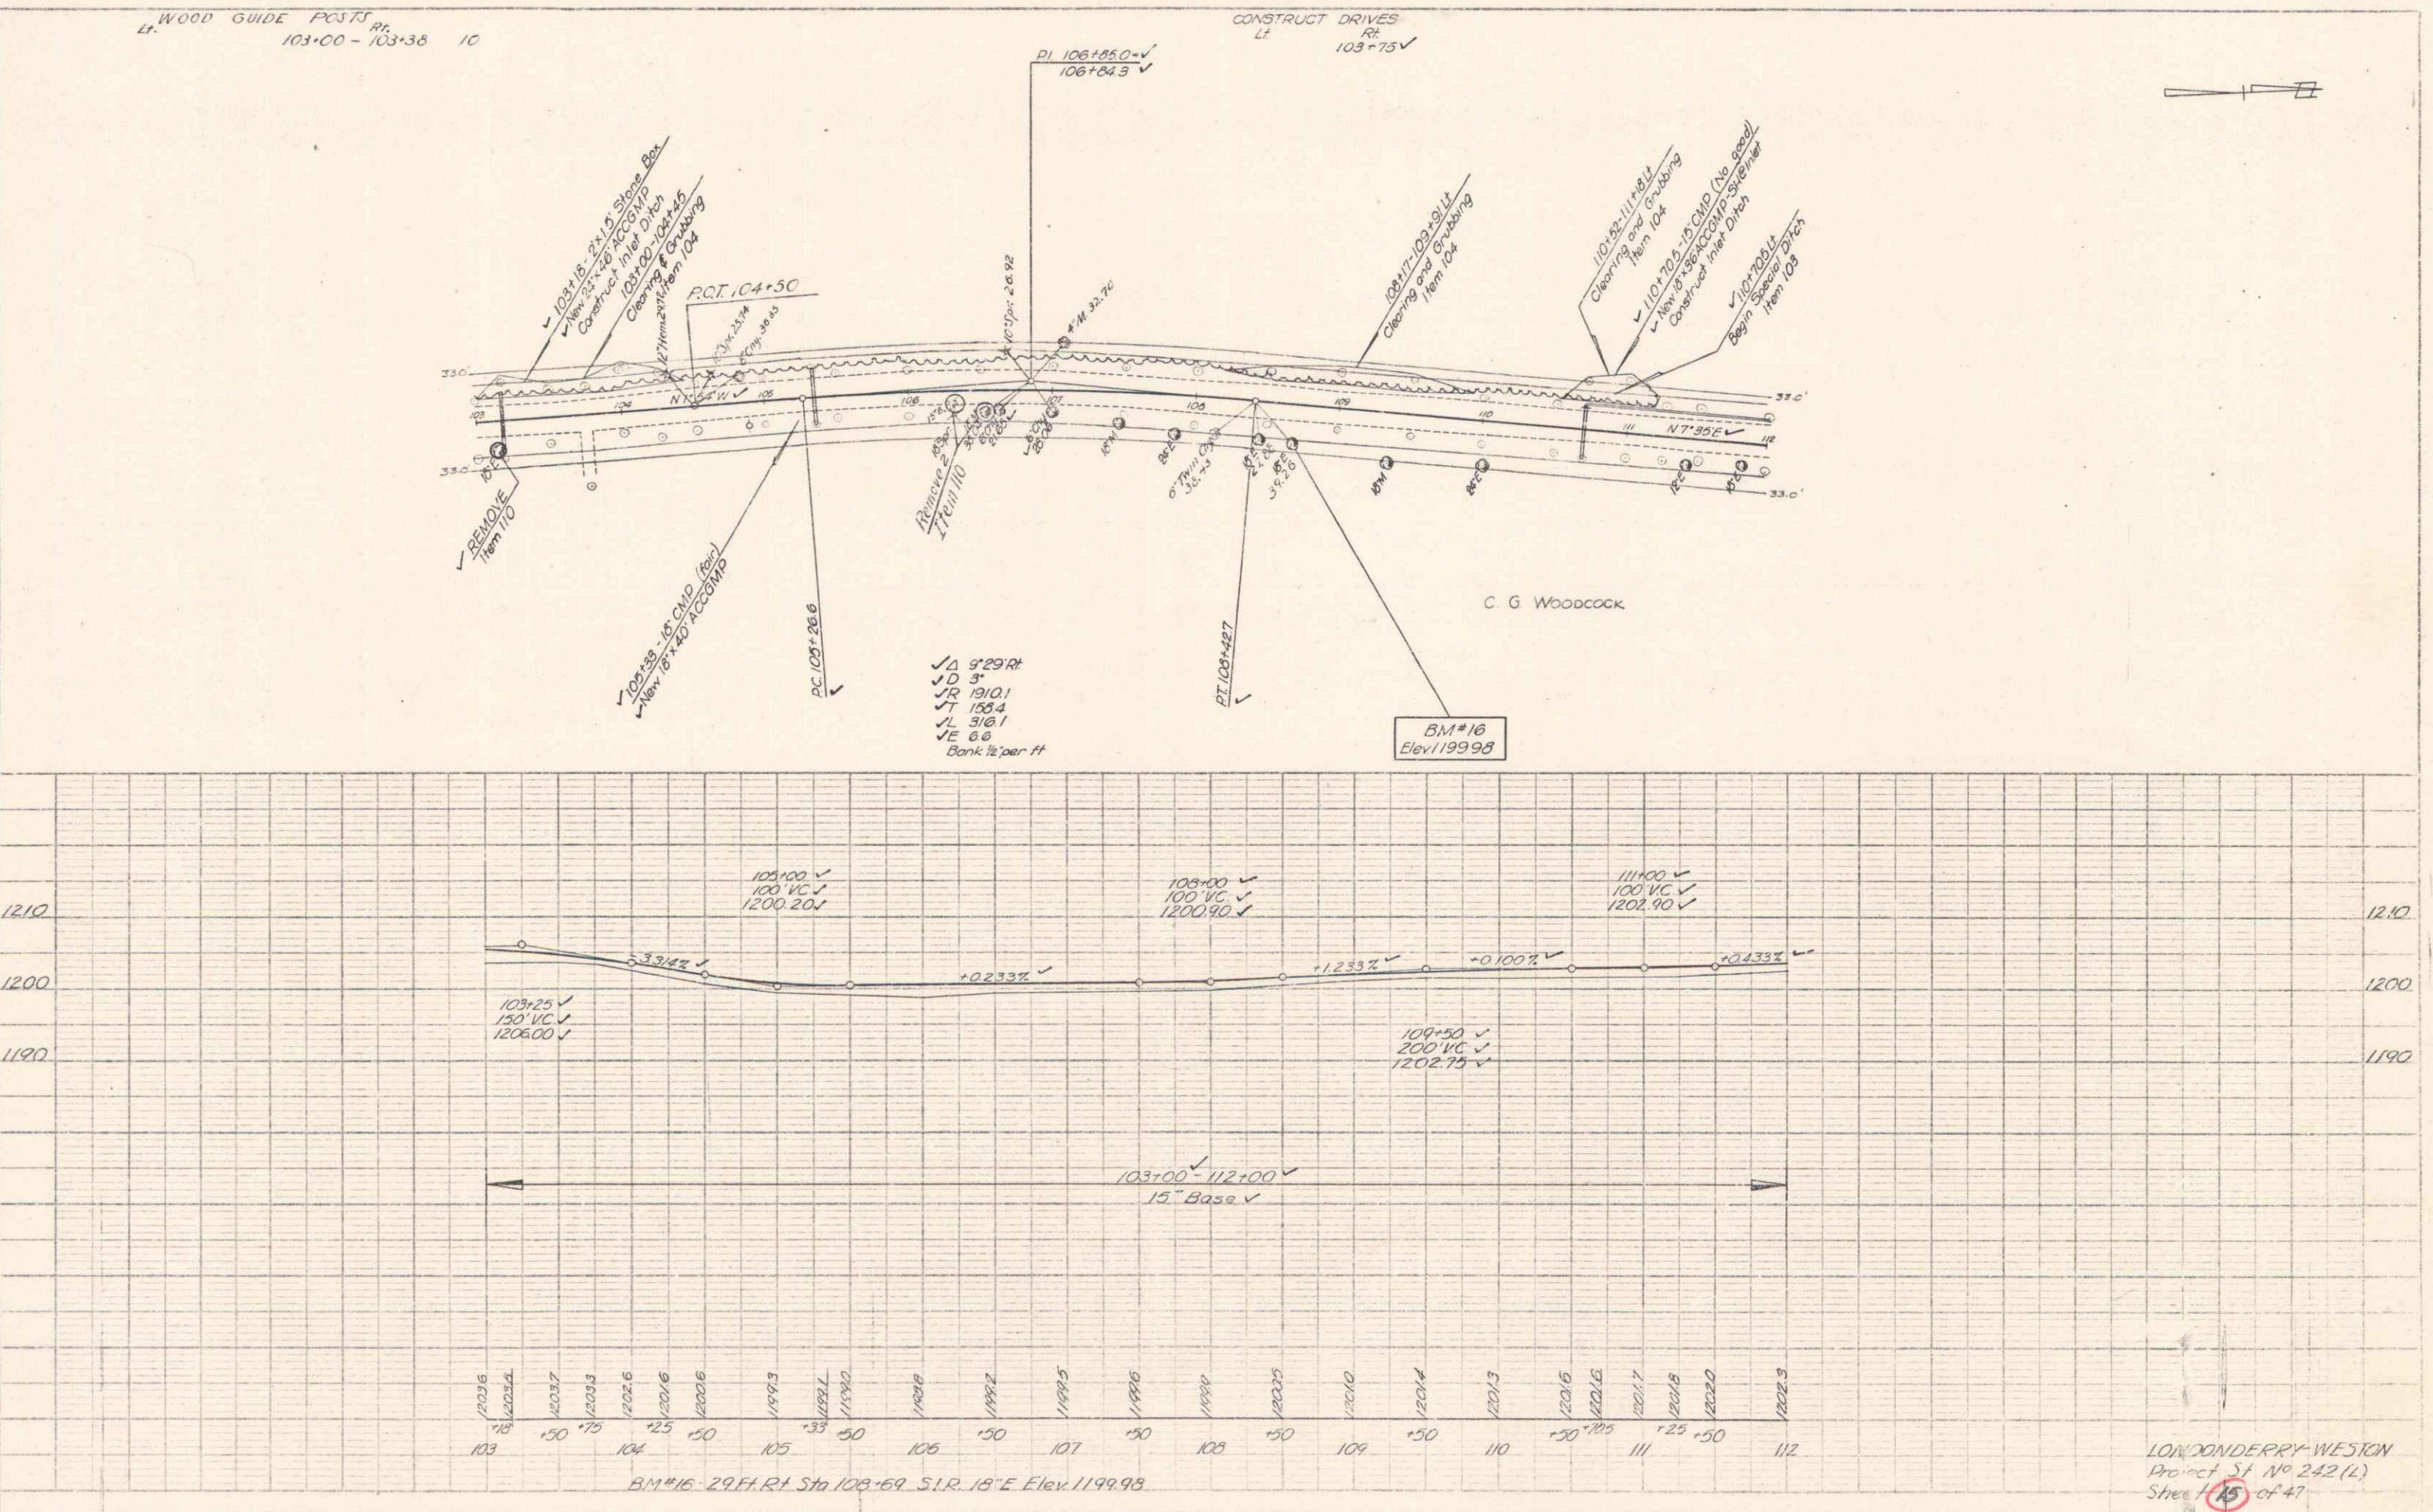



Bridge Information
from Route log
Cone, T. Beam 2. 1929
55' x 9.8' Rdy 20'
O.A. 59.5' H-15
wtng. 539 #'

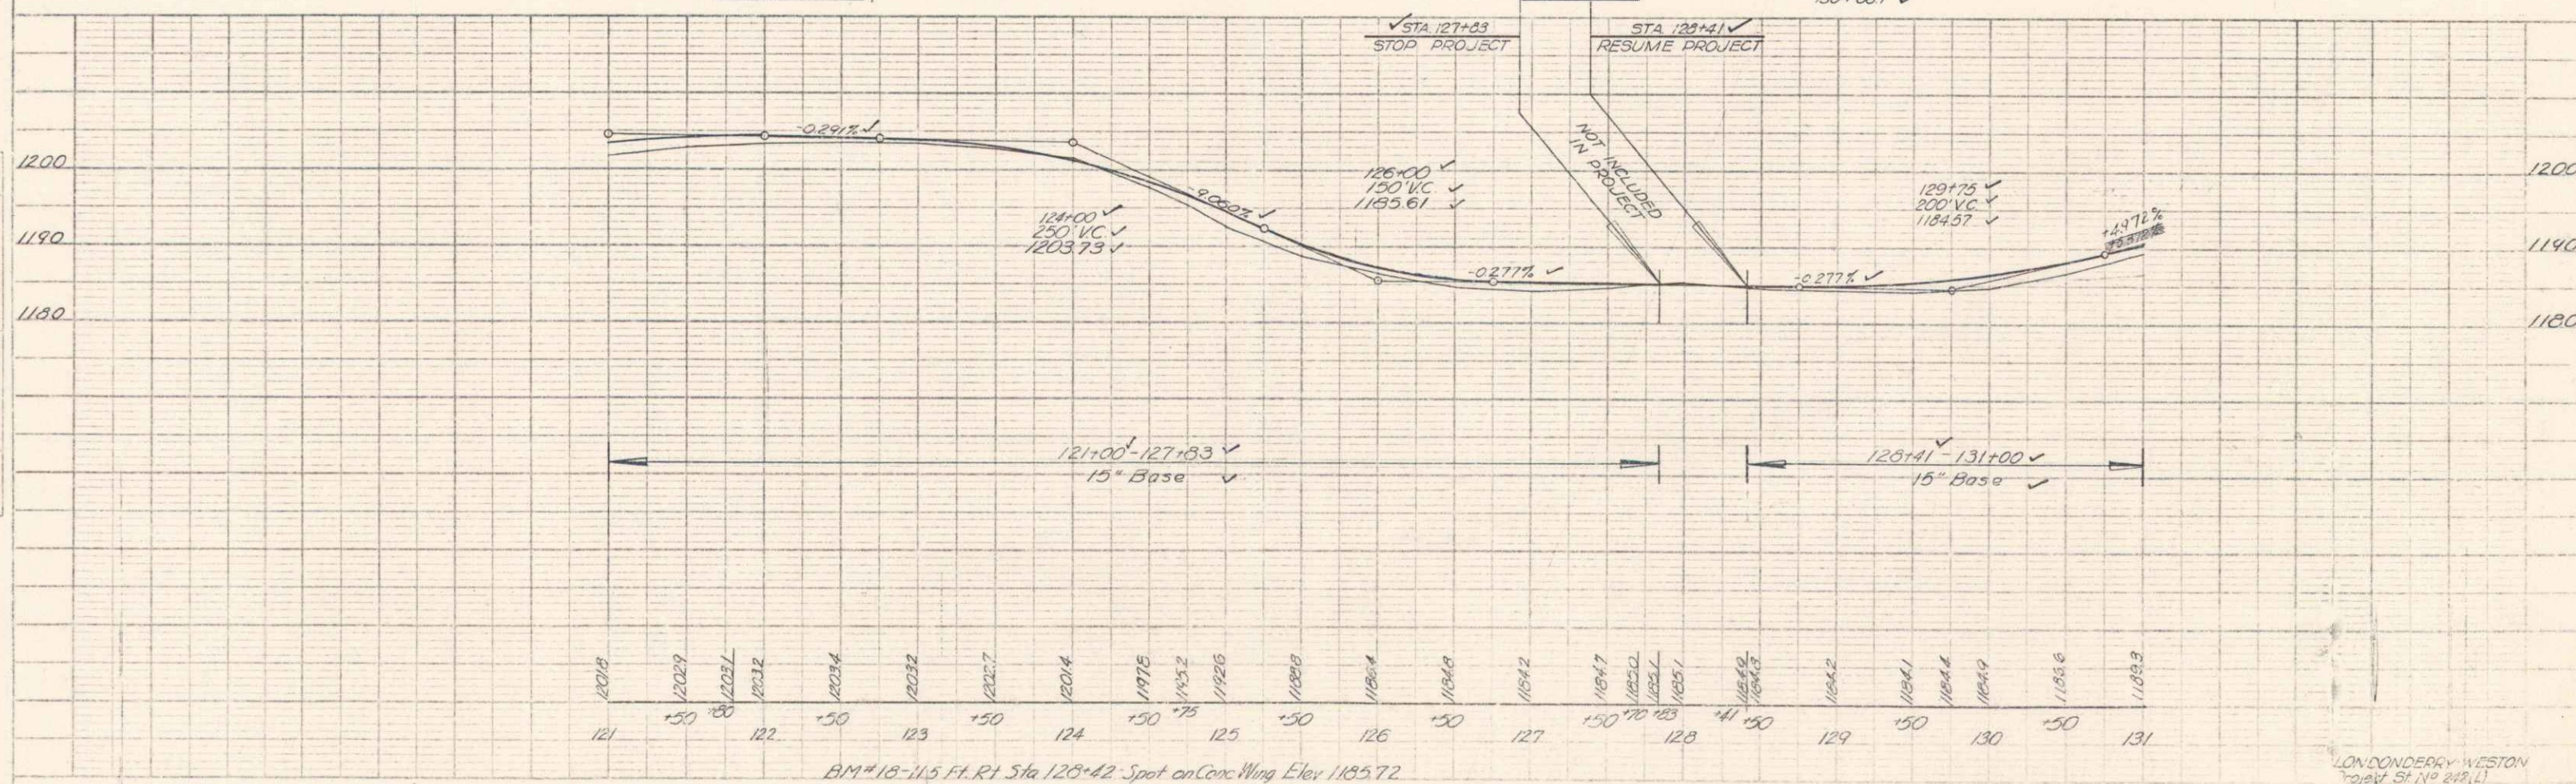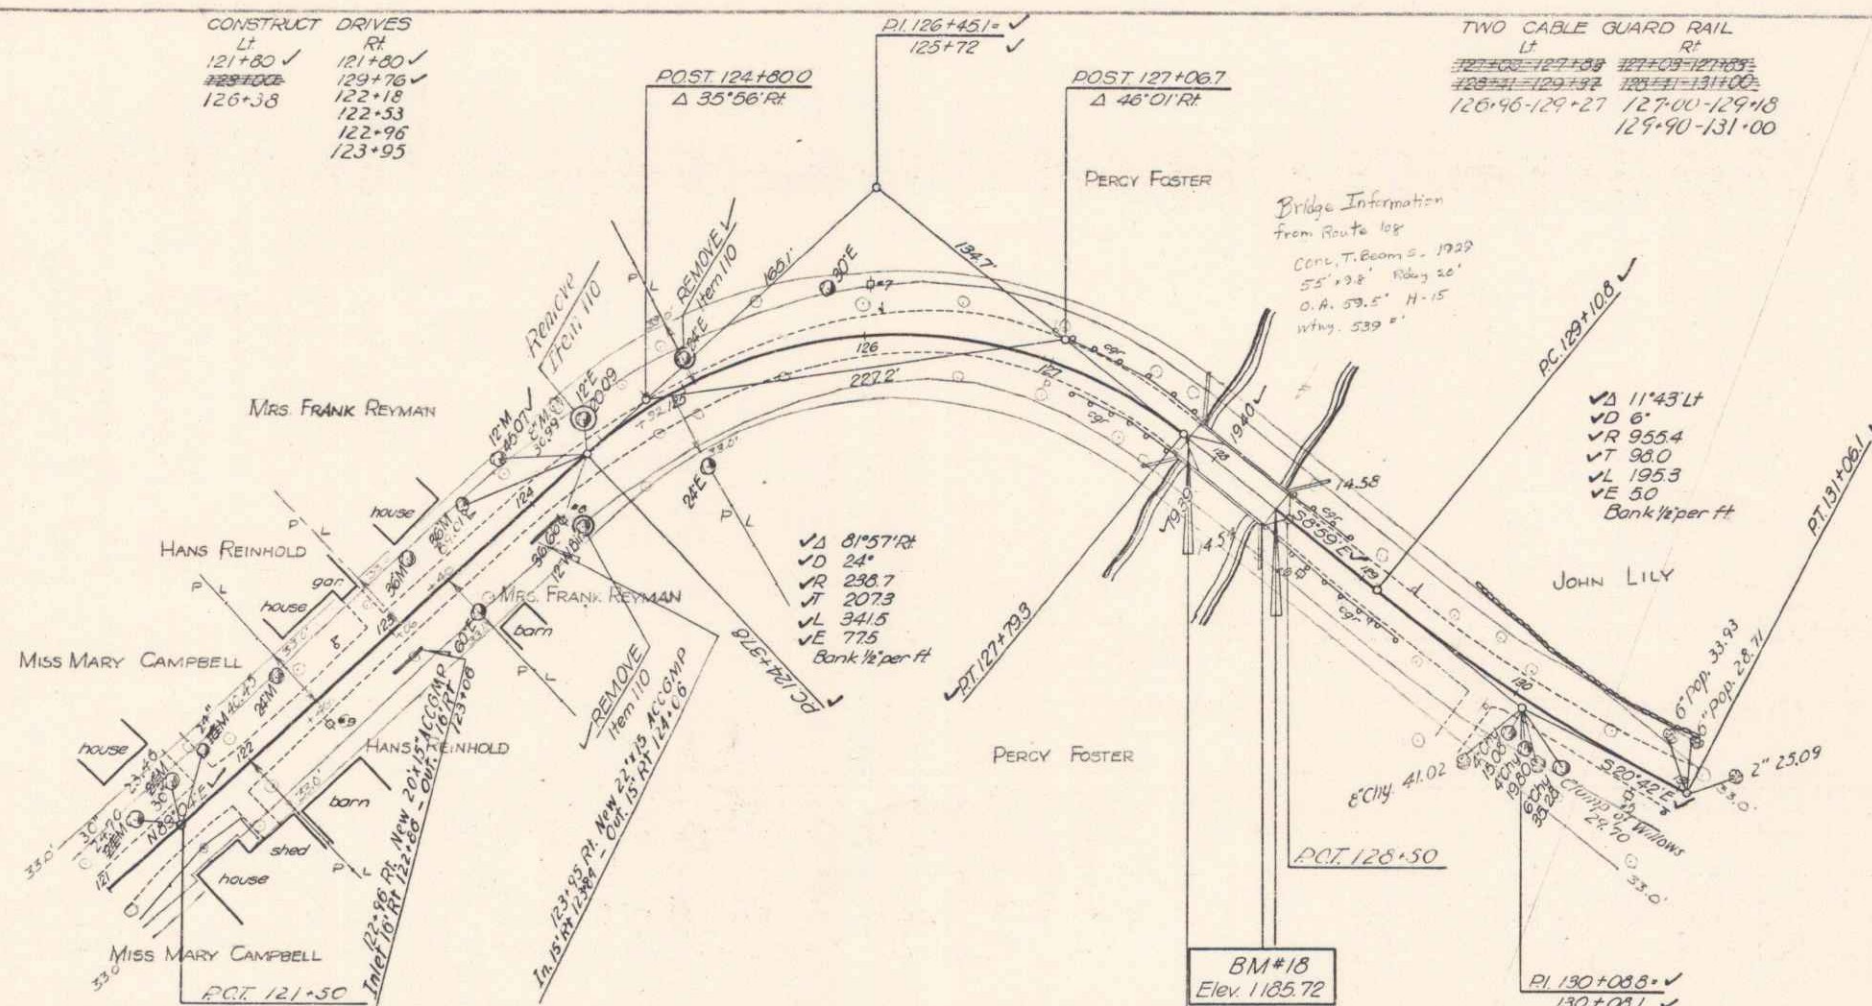

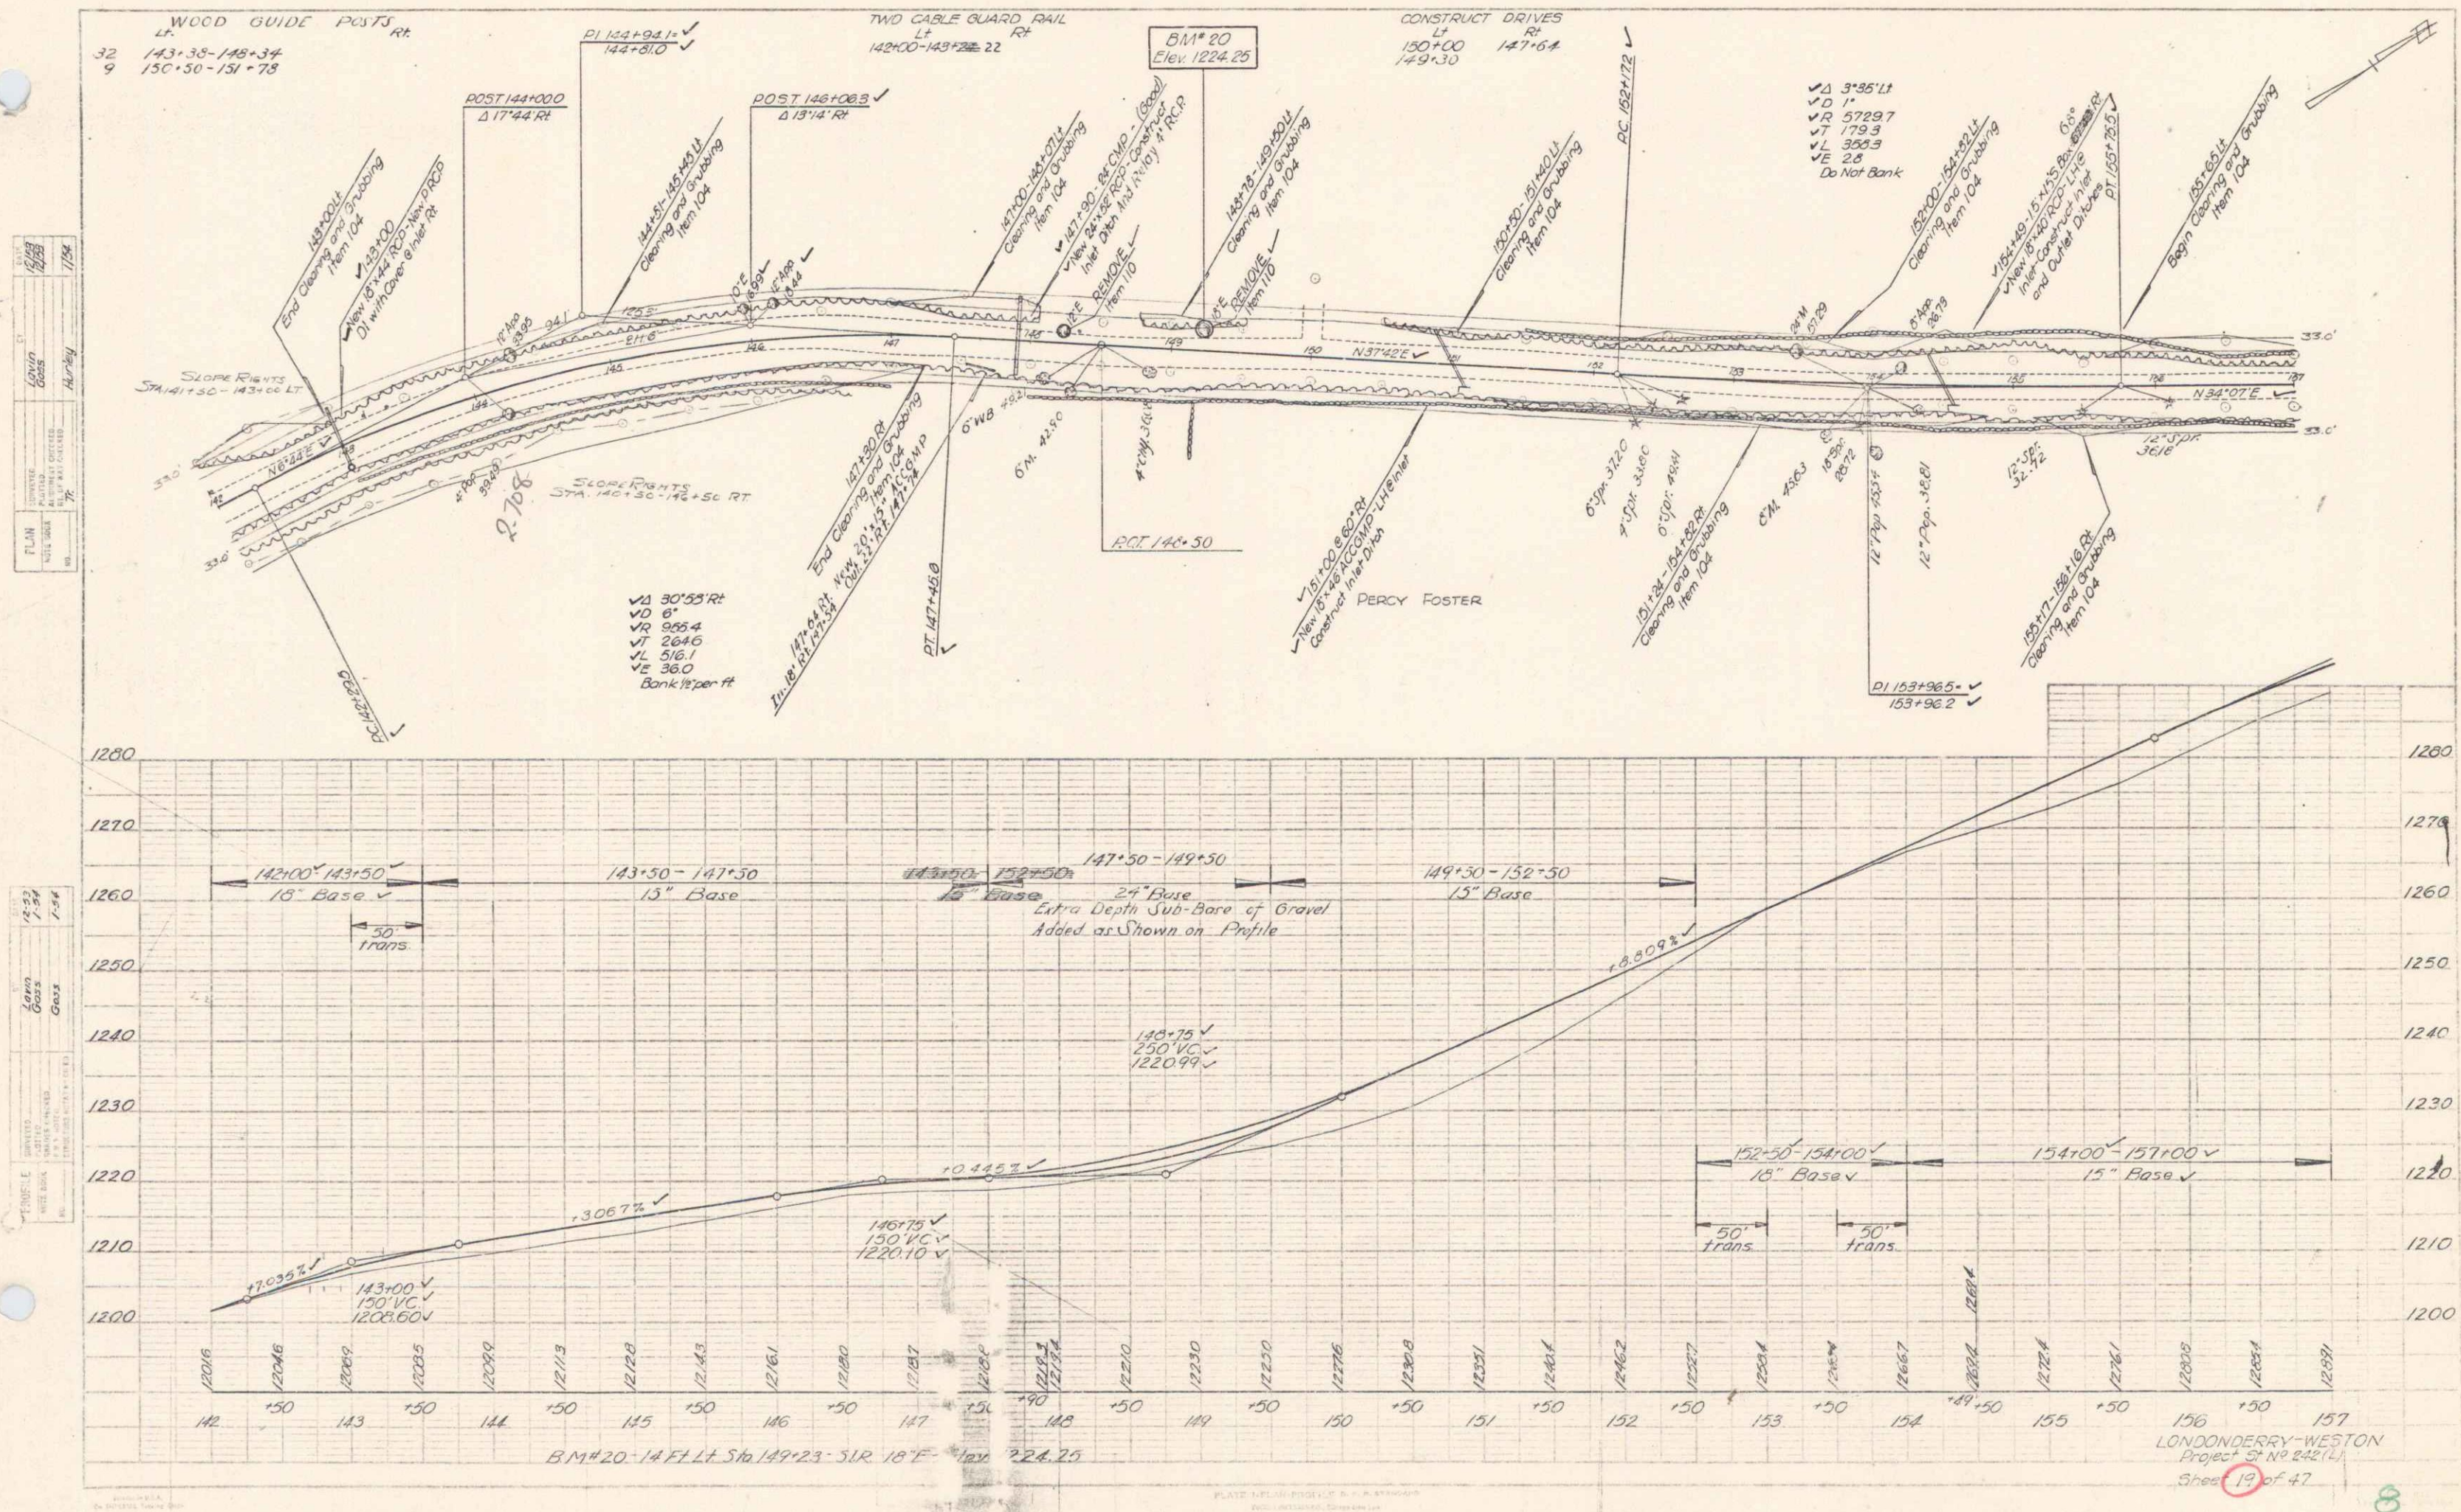


PLAN	DATE	12/23
BY	LOAN	12/23
CHECKED	LOAN	12/23
APPROVED	LOAN	12/23
DATE	12/23	

PROFILE	DATE	12/23
BY	LOAN	12/23
CHECKED	LOAN	12/23
APPROVED	LOAN	12/23
DATE	12/23	

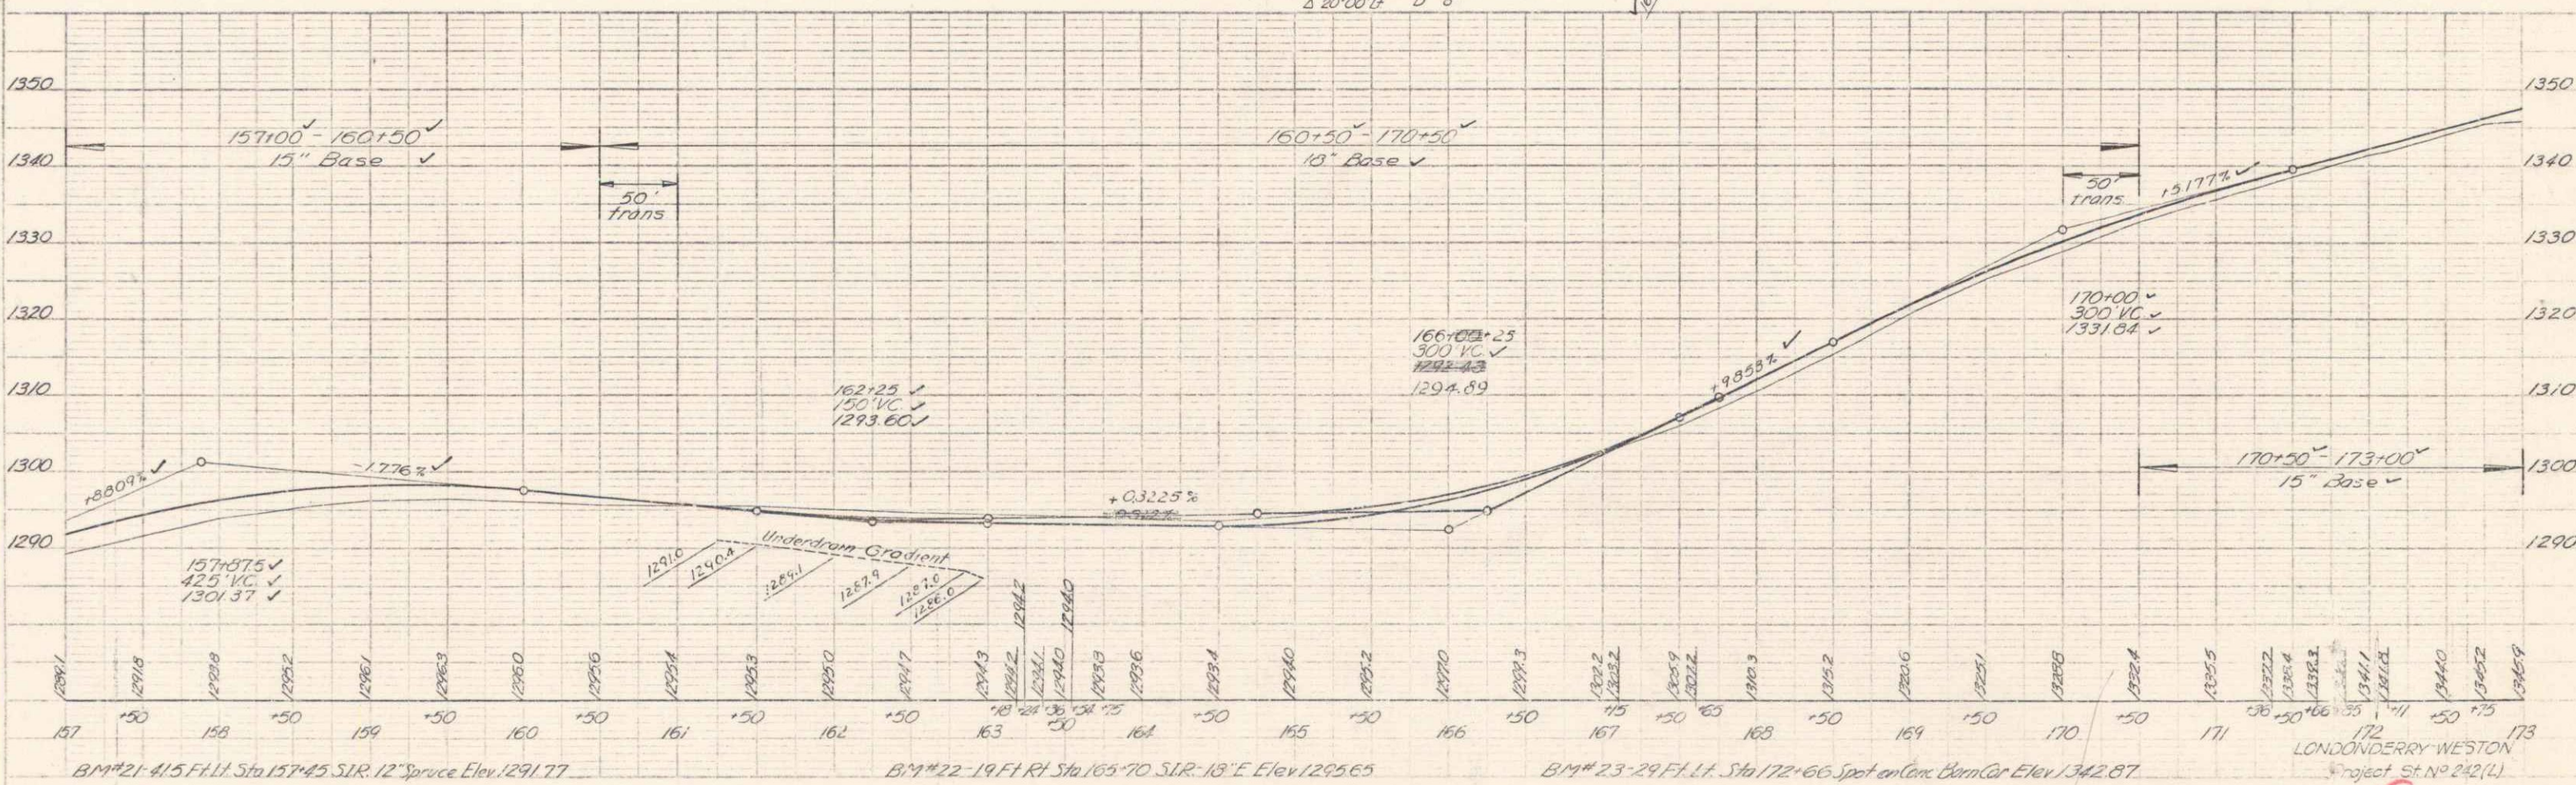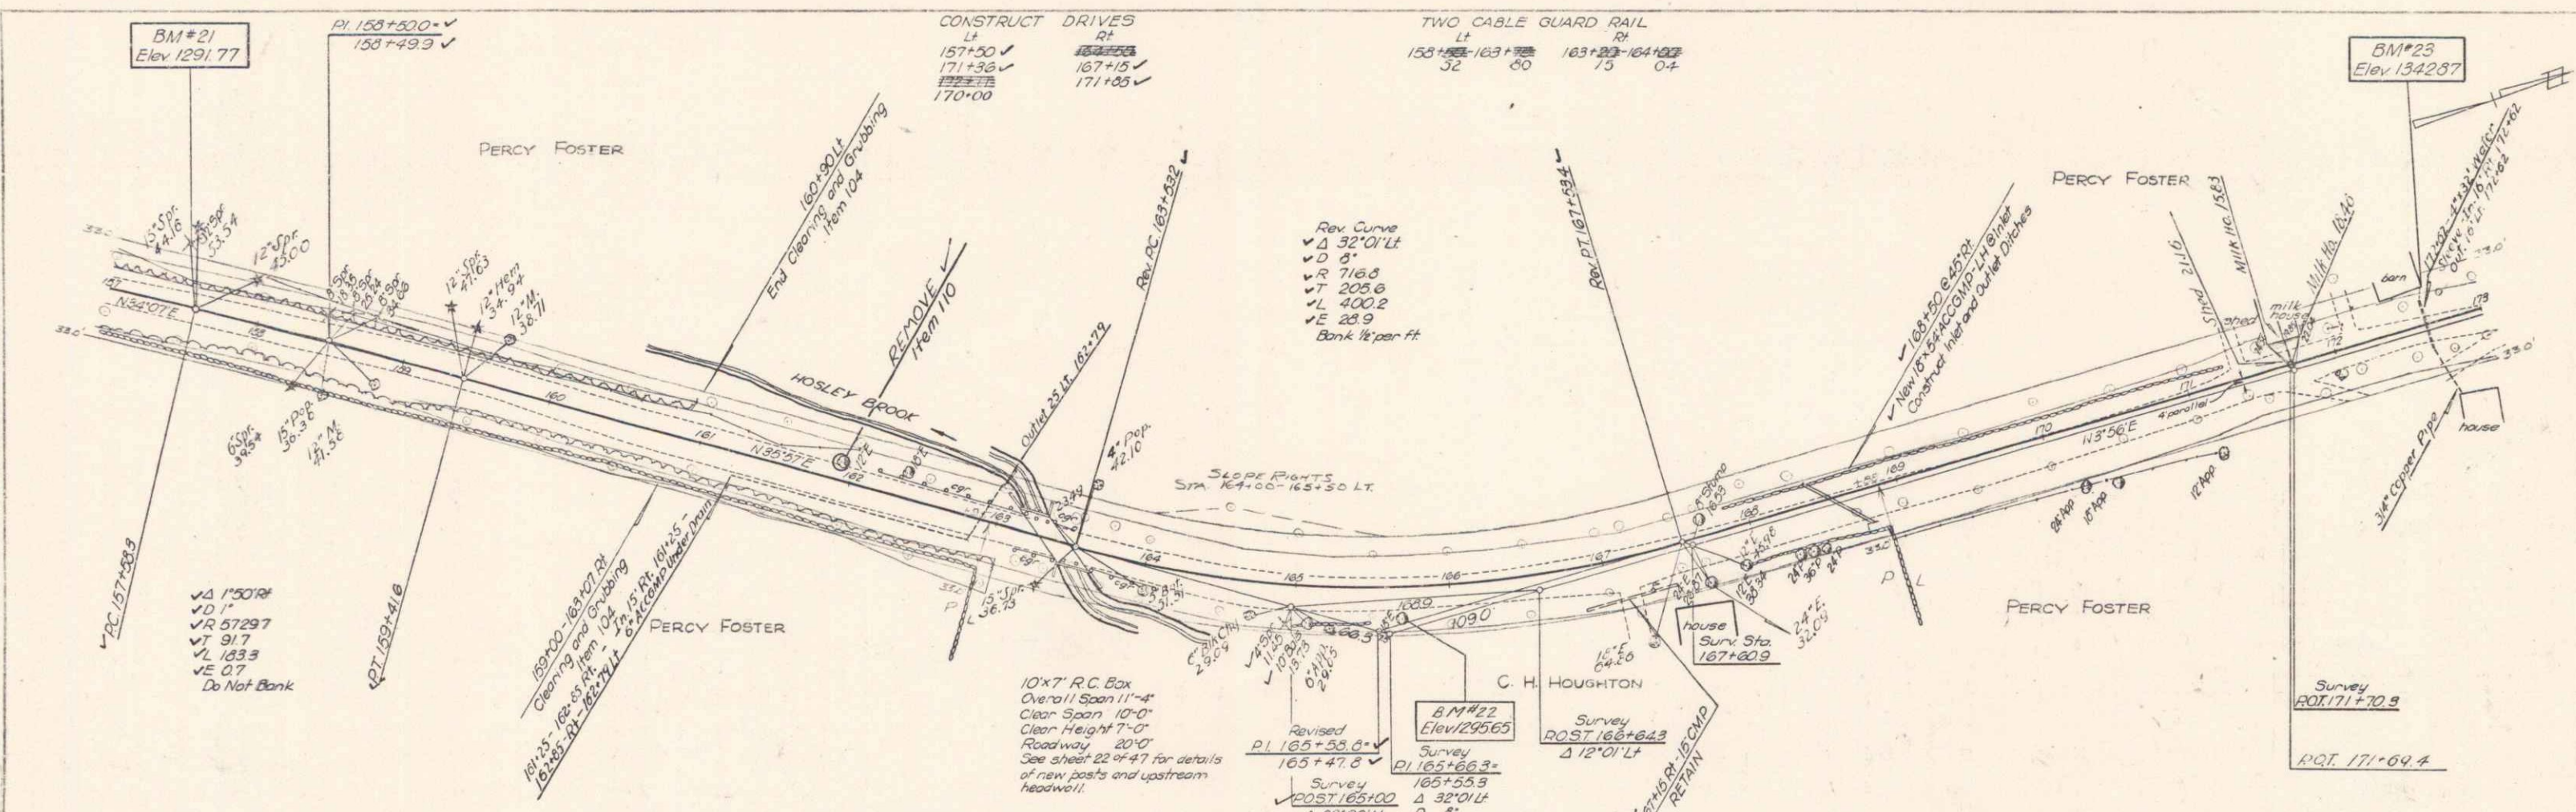

PLAN	DATE	BY	CHKD
12/18	12/18	Hurley	
12/18	12/18		
12/18	12/18		

PROFILE	DATE	BY	CHKD
12/18	12/18	Hurley	
12/18	12/18		
12/18	12/18		

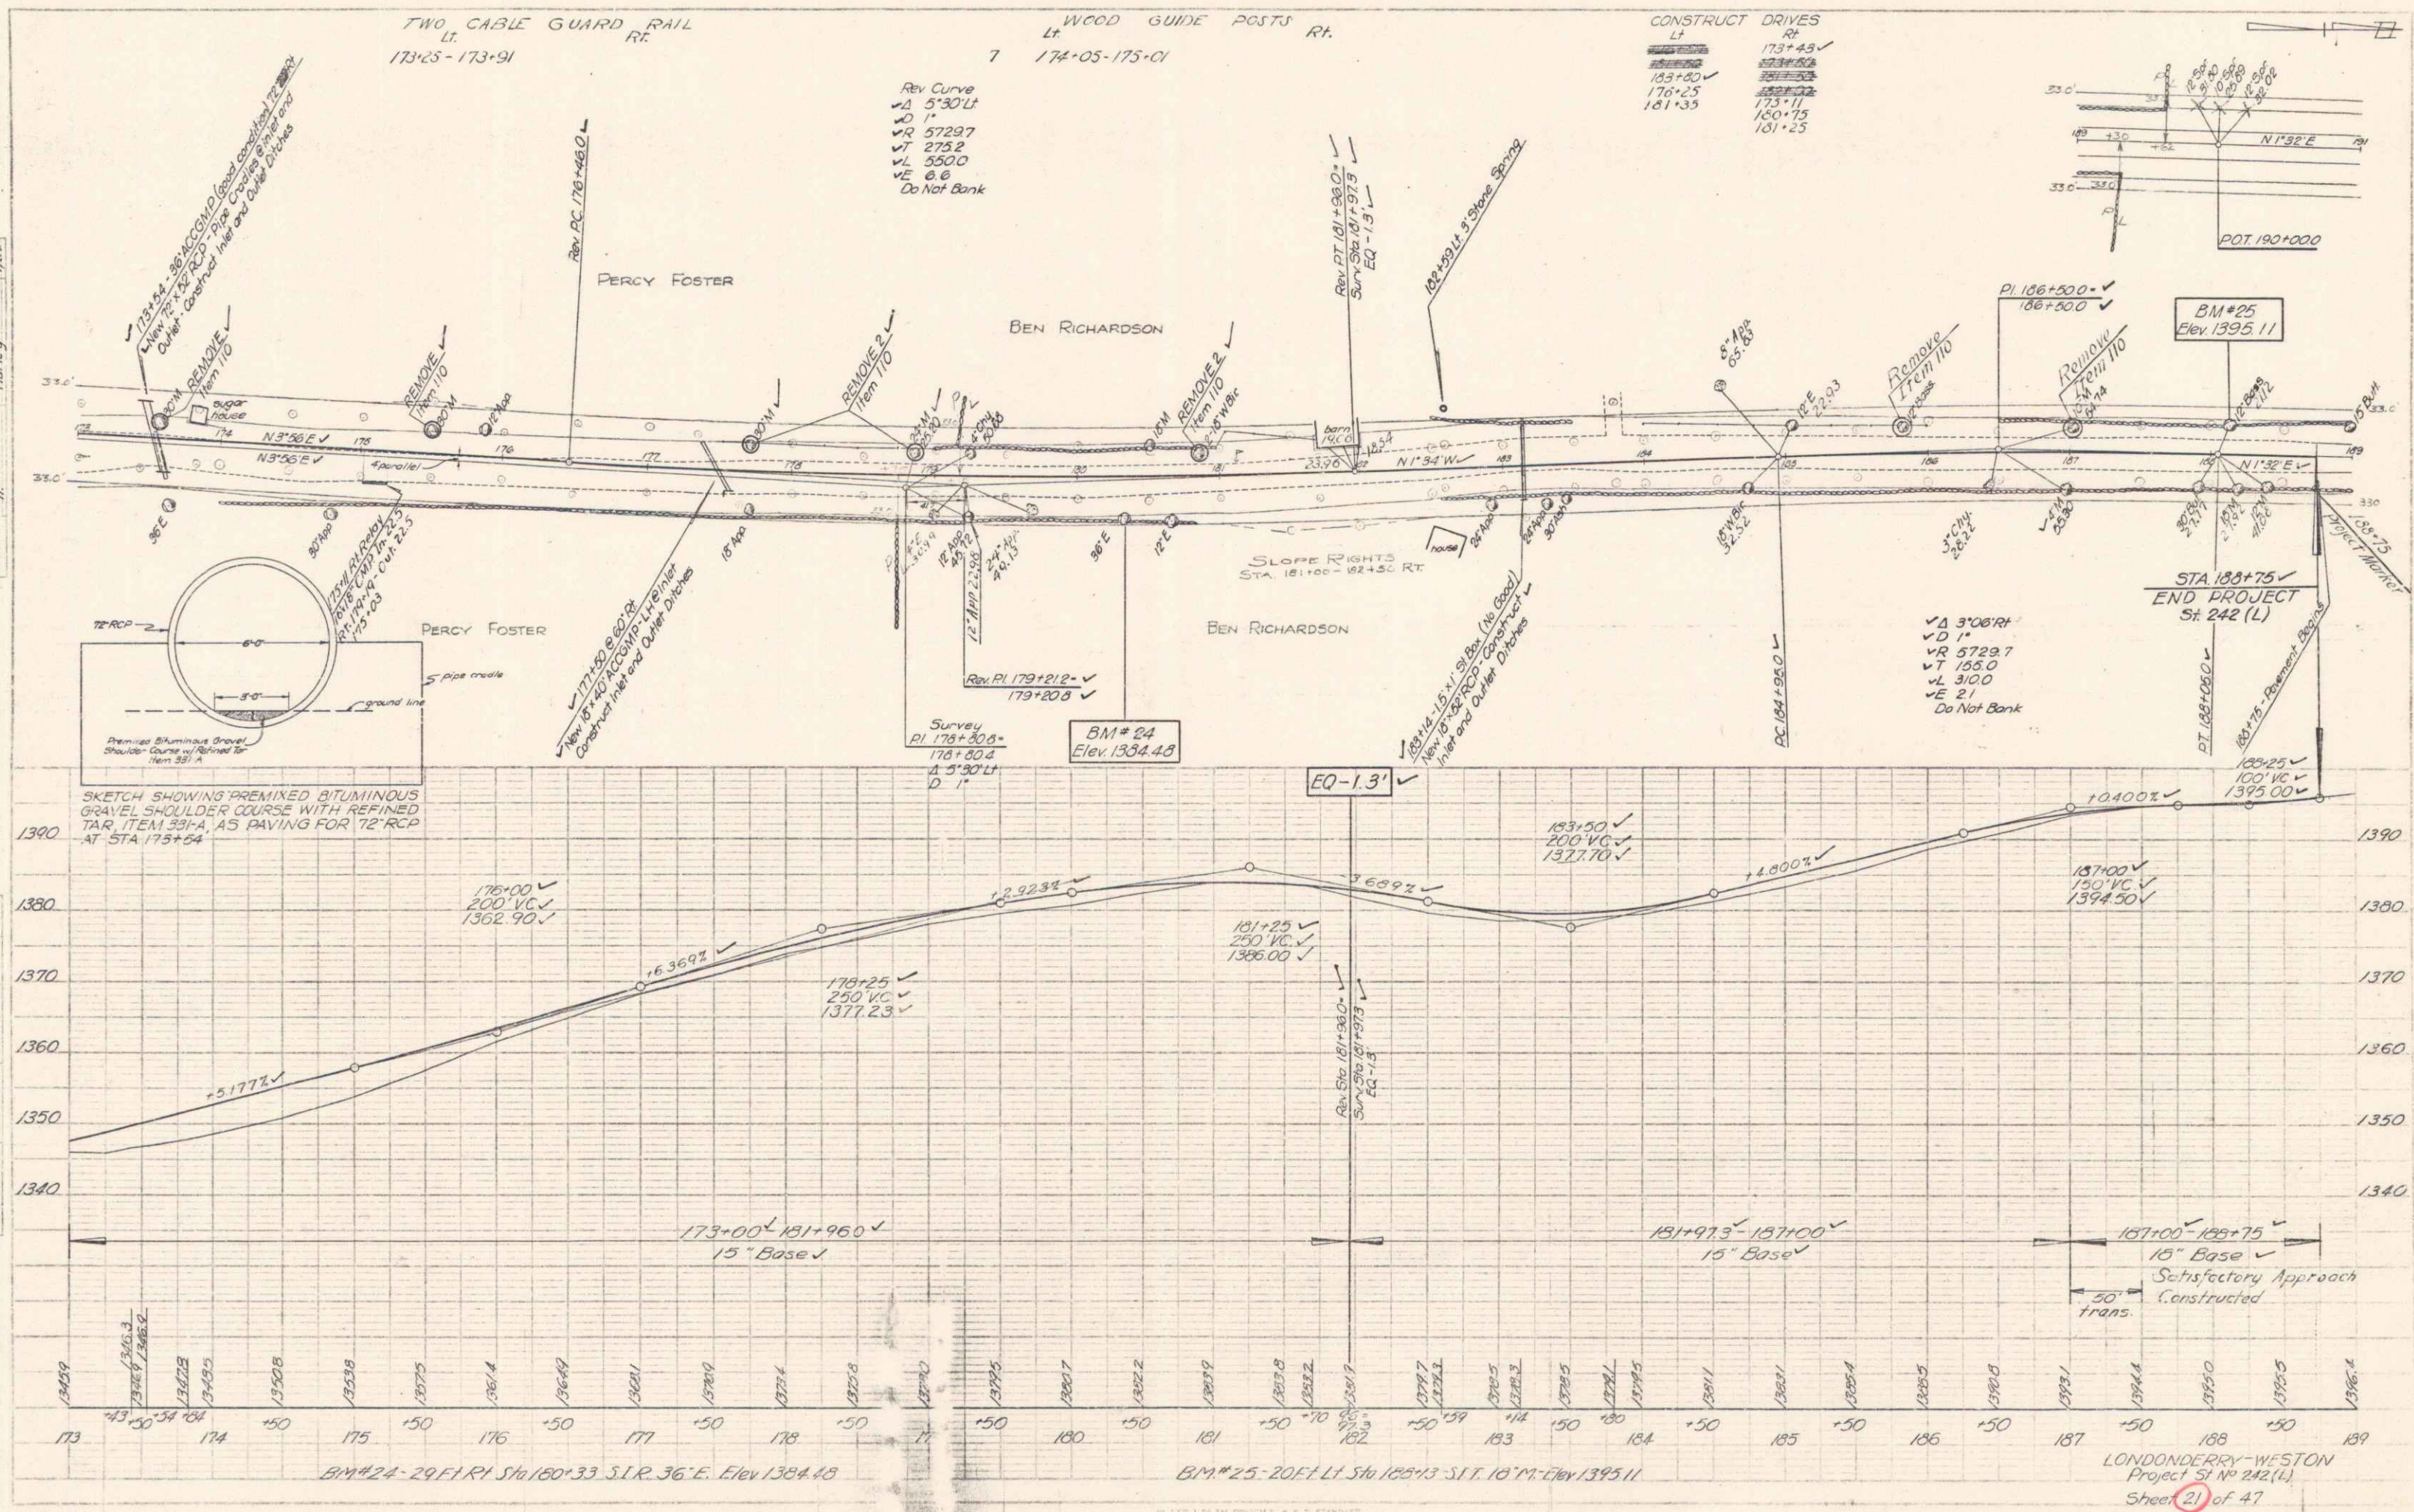

LONDONDERRY-WESTON
Project 51 No 242(L)
Sheet 21 of 47