

```

SHEET NO:
1      TITLE PAGE
2      TYPICAL CROSS SECTION OF IMPROVEMENT (DOUBLE TACK COAT OF REFINED TAR
3      ROADWAY STANDARD SHEET RS 56-1 (BANKING) WITH PEASTONE SEAL, ITEM 312-A
4      QUANTITY SHEET (ITEMS)
5      QUANTITY SHEET (DRAINAGE)
6      NO. EARTHWORK SHEETS
11- 22 PLAN & PROFILE SHEETS
23      SUPERSTRUCTURE DETAILS BRIDGE STA. 101+00-101+21
24      DETAILS ABUTMENT #1 BRIDGE STA. 101+00-101+21
25      DETAILS ABUTMENT #2 BRIDGE STA. 101+00-101+21
26      REINFORCING STEEL SCHEDULE BRIDGE STA. 101+00-101+21
27      DETAILS ABUTMENT #1 BRIDGE STA. 178+80-179+64
28      DETAILS ABUTMENT #2 " " " "
29      SUPERSTRUCTURE DETAILS " " " "
30      SUPERSTRUCTURE LAYOUT " " " "
31      REINFORCING STEEL SCHEDULE " " " "
32      BRIDGE STD. SHEET B5-50-56, DET. A,B,C,D, F OR G,H,K
33      BRIDGE STD. SHEET B5-56-2
34      ROADWAY STANDARD SHEET RS 56-3
35      " " " " -4
36      " " " " -8
37      " " " " -9
38      " " " " -11
39      " " " " -12
40-102 CROSS SECTIONS
103-106 CHANNEL SECTIONS

```

PROPOSED IMPROVEMENT

FEDERAL
AID SECONDARY PROJECT

COUNTY OF WASHINGTON



VERMONT ROUTE 100


BEGINNING AT THE GRANVILLE - WARREN TOWN LINE ON VT. RTE. 100
AND EXTENDING NORTHERLY 3.22 MILES

LENGTH OF ROADWAY 16,842.2 FEET = 3.190 MILES

LENGTH OF BRIDGE 84.0 FEET = 0.016 MILES



LENGTH OF PROJECT 16,926.2 FEET = 3.2057 MILES

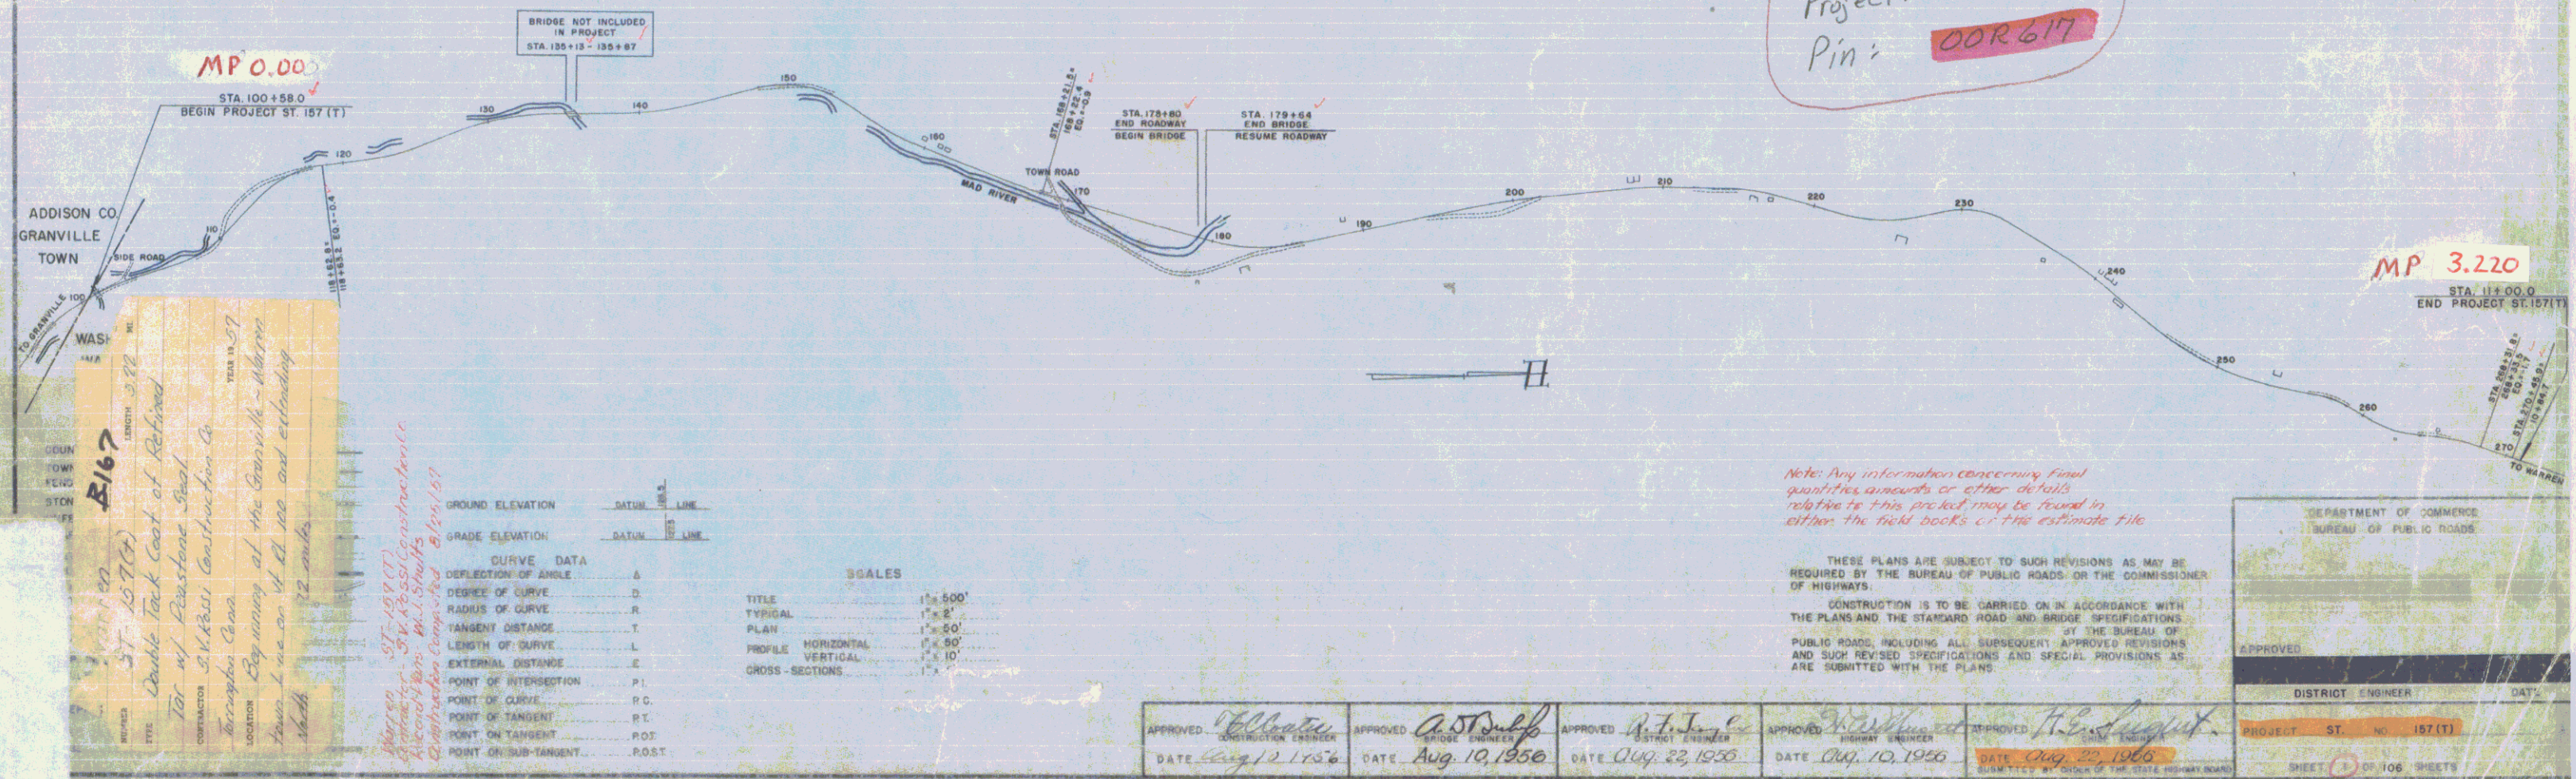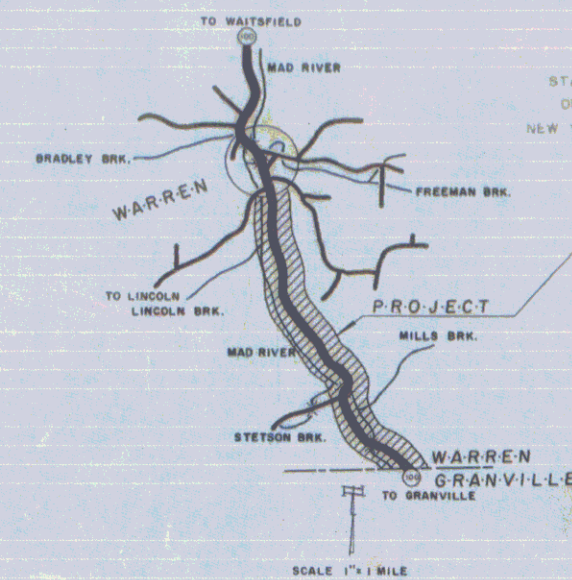

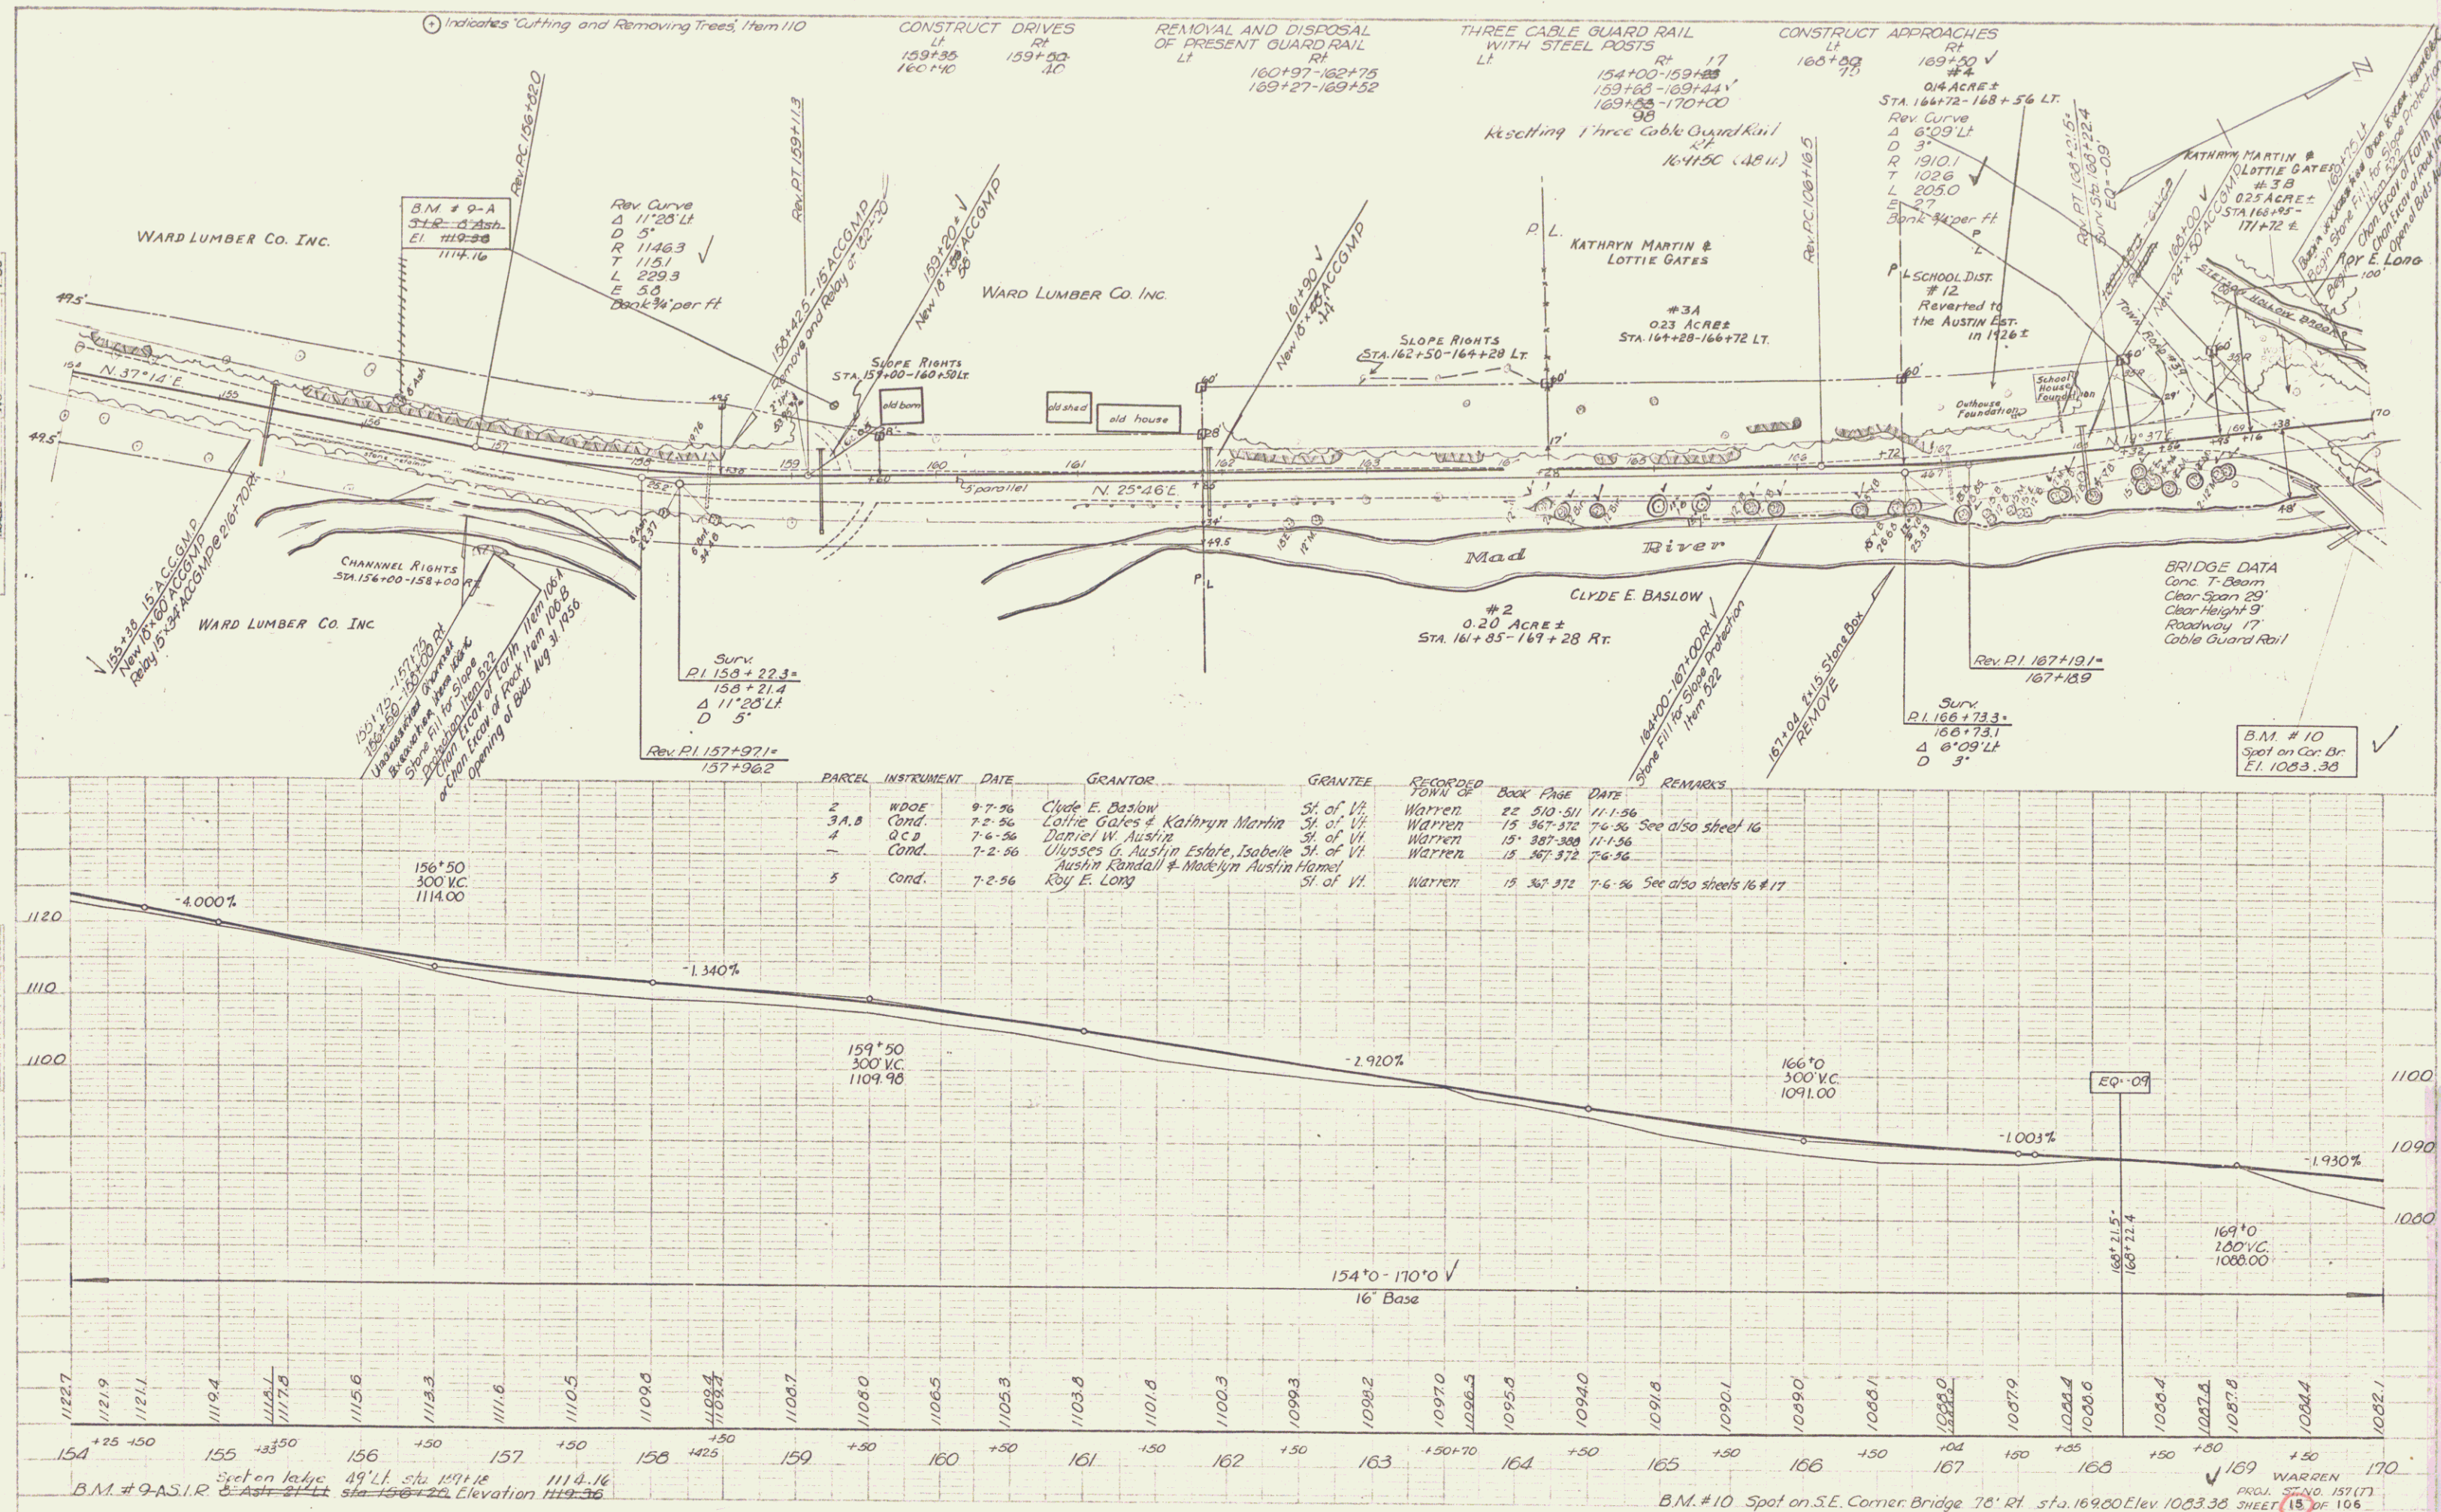

PLAN	11-59
NOTES	11-59
REVISIONS	11-59
DATE	11-59
BY	11-59
CHECKED	11-59
APPROVED	11-59
SCALE	1"=50'

SECTION	11-59
NOTES	11-59
REVISIONS	11-59
DATE	11-59
BY	11-59
CHECKED	11-59
APPROVED	11-59
SCALE	1"=50'

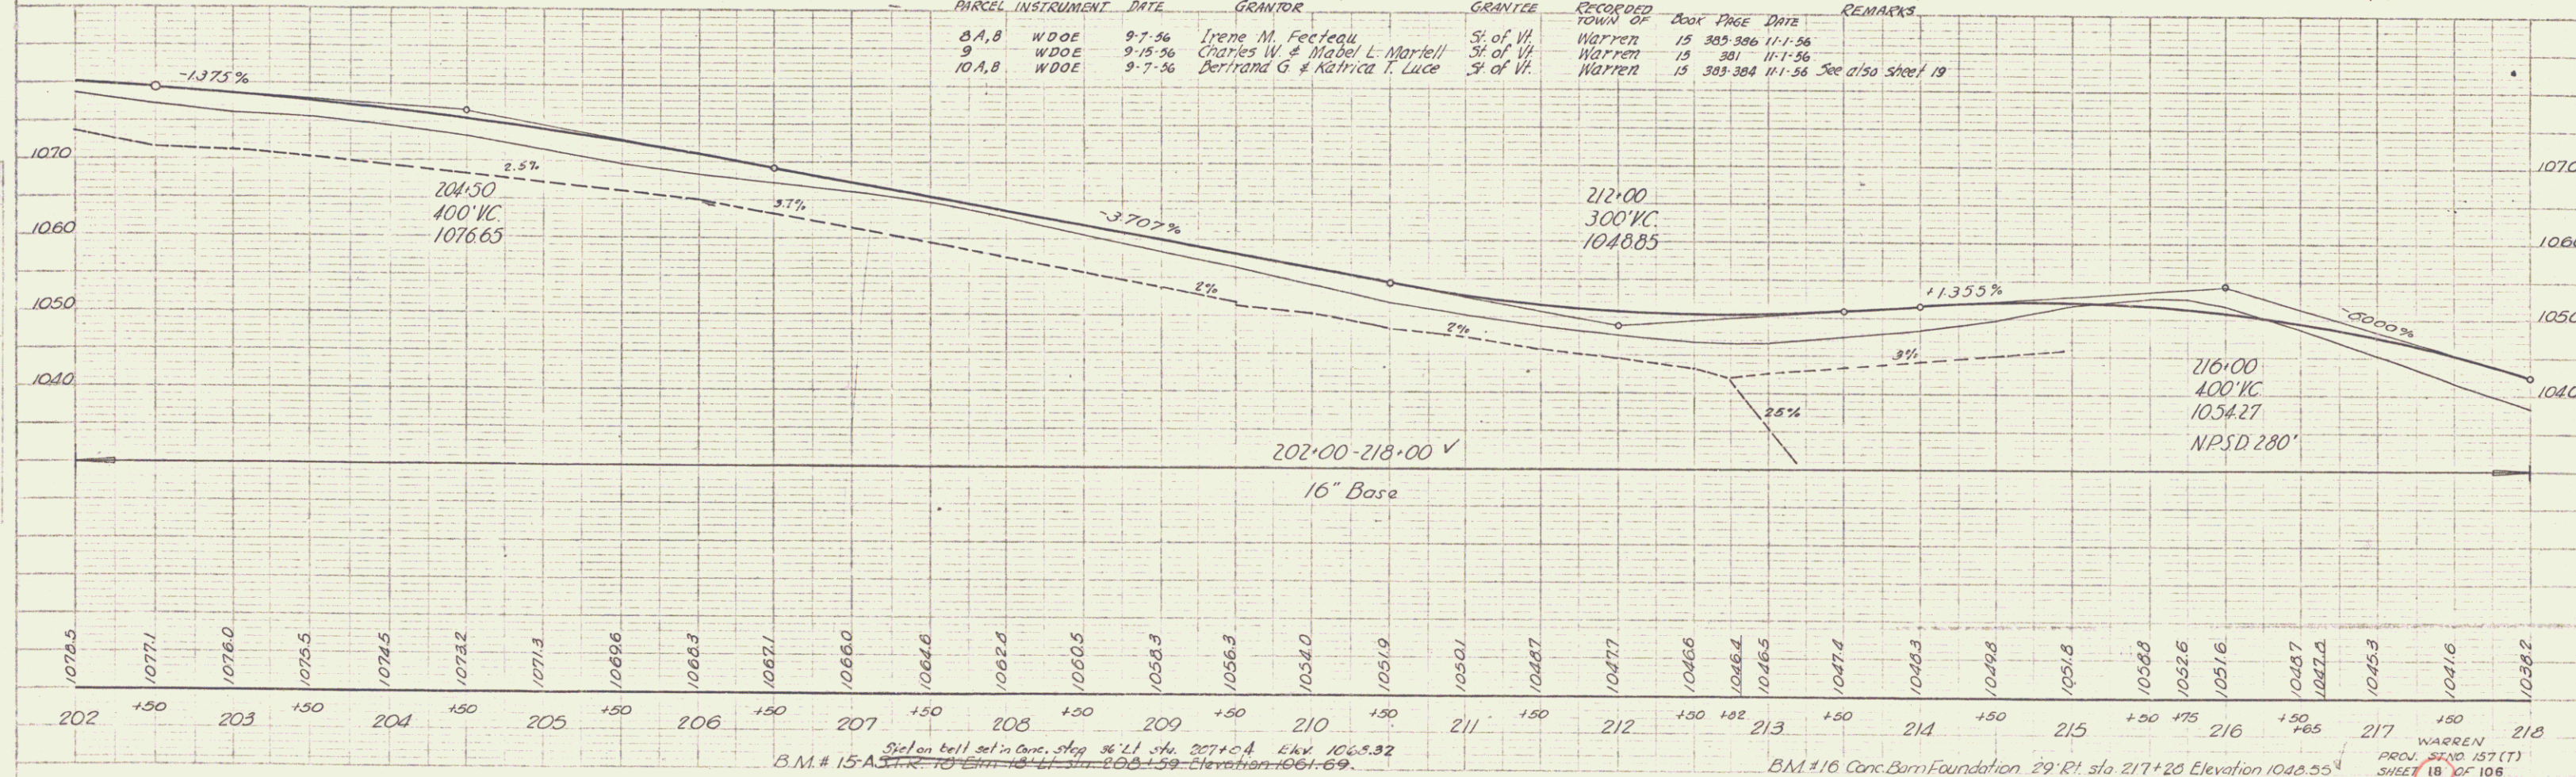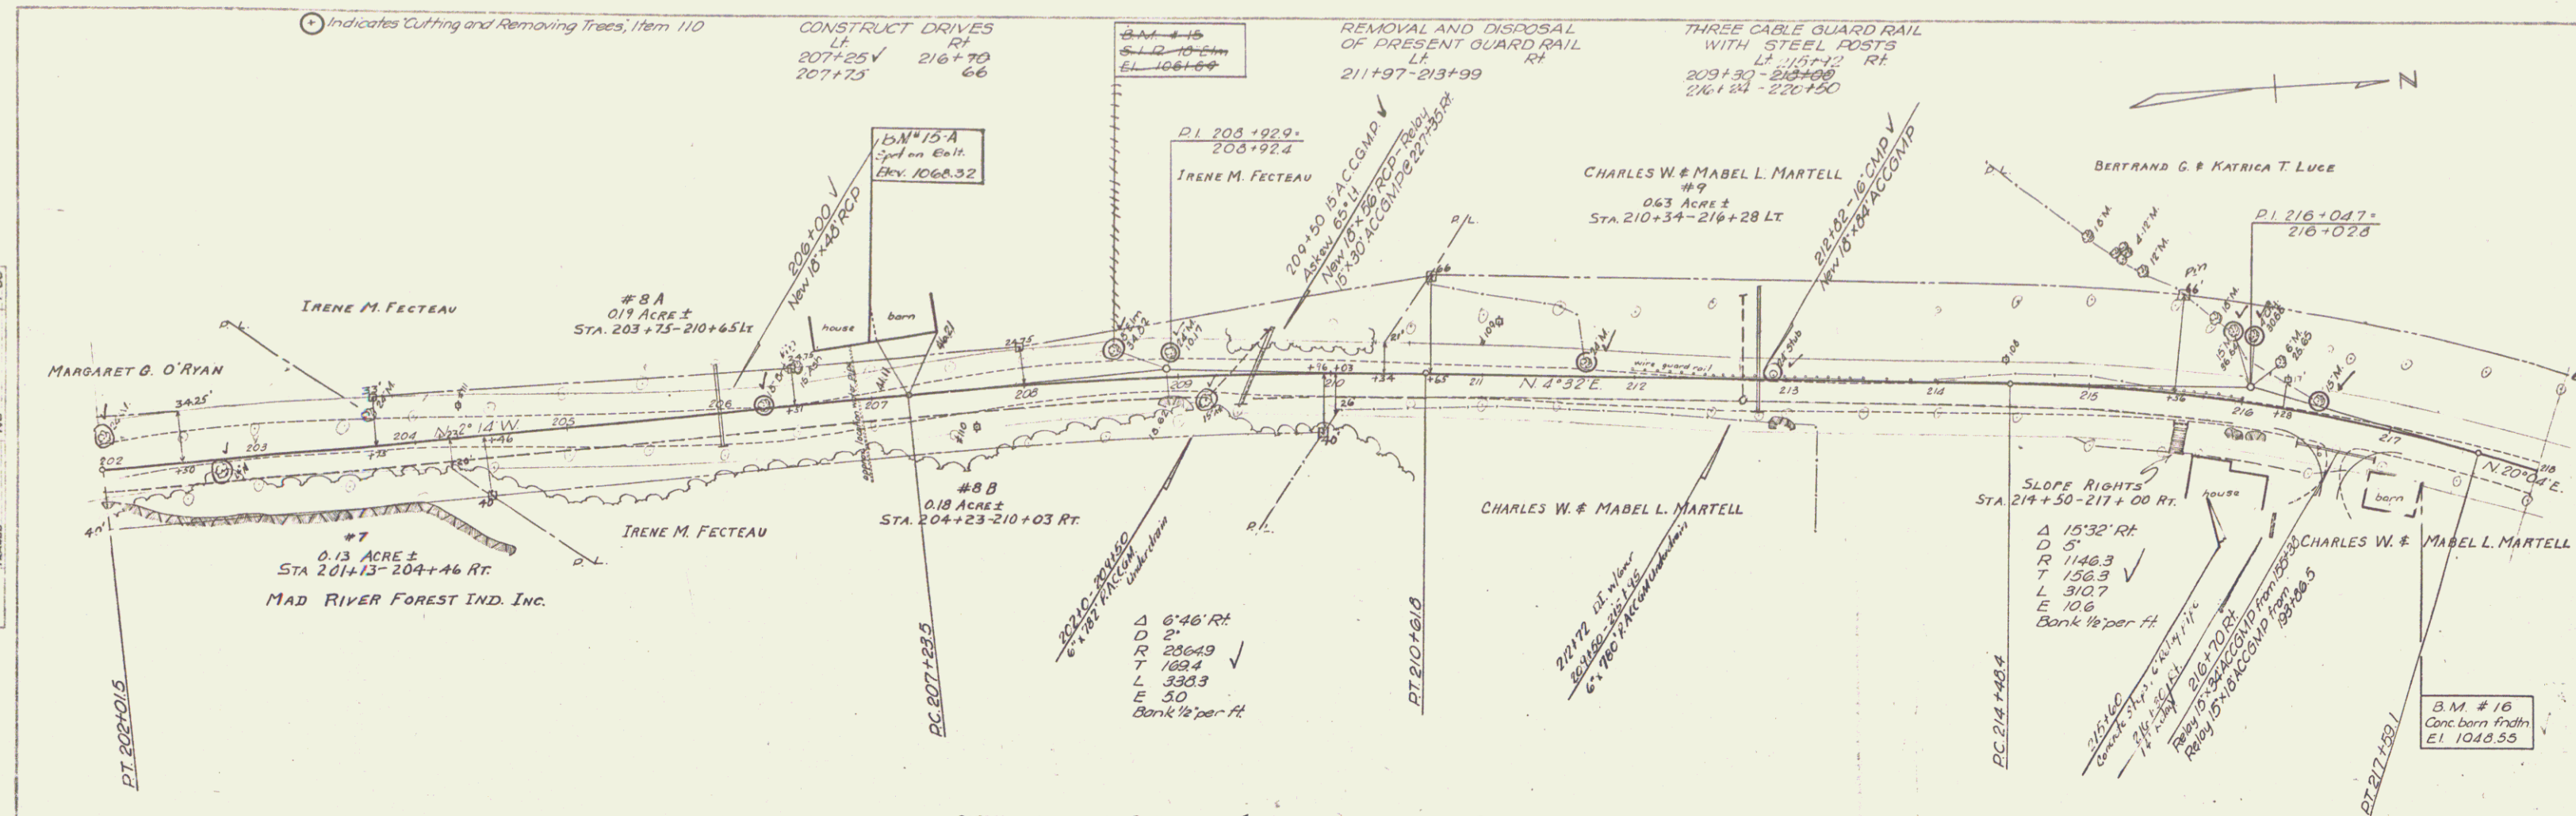


Station 207+00 set in conc. slope 36" L.I. Sta. 207+00 Ekv. 1065.32
B.M. # 15-A 10' Ekv. 1061.69

B.M. # 16 Conc. Barn Foundation 29' Rt. Sta. 217+20 Elevation 1048.55

WARREN
SHEET 18 OF 106

PLAN
 DATE: 1-56
 DRAWN BY: [illegible]
 CHECKED BY: [illegible]
 SCALE: 1" = 50'


PROFILE
 DATE: 1-56
 DRAWN BY: [illegible]
 CHECKED BY: [illegible]
 SCALE: 1" = 10'

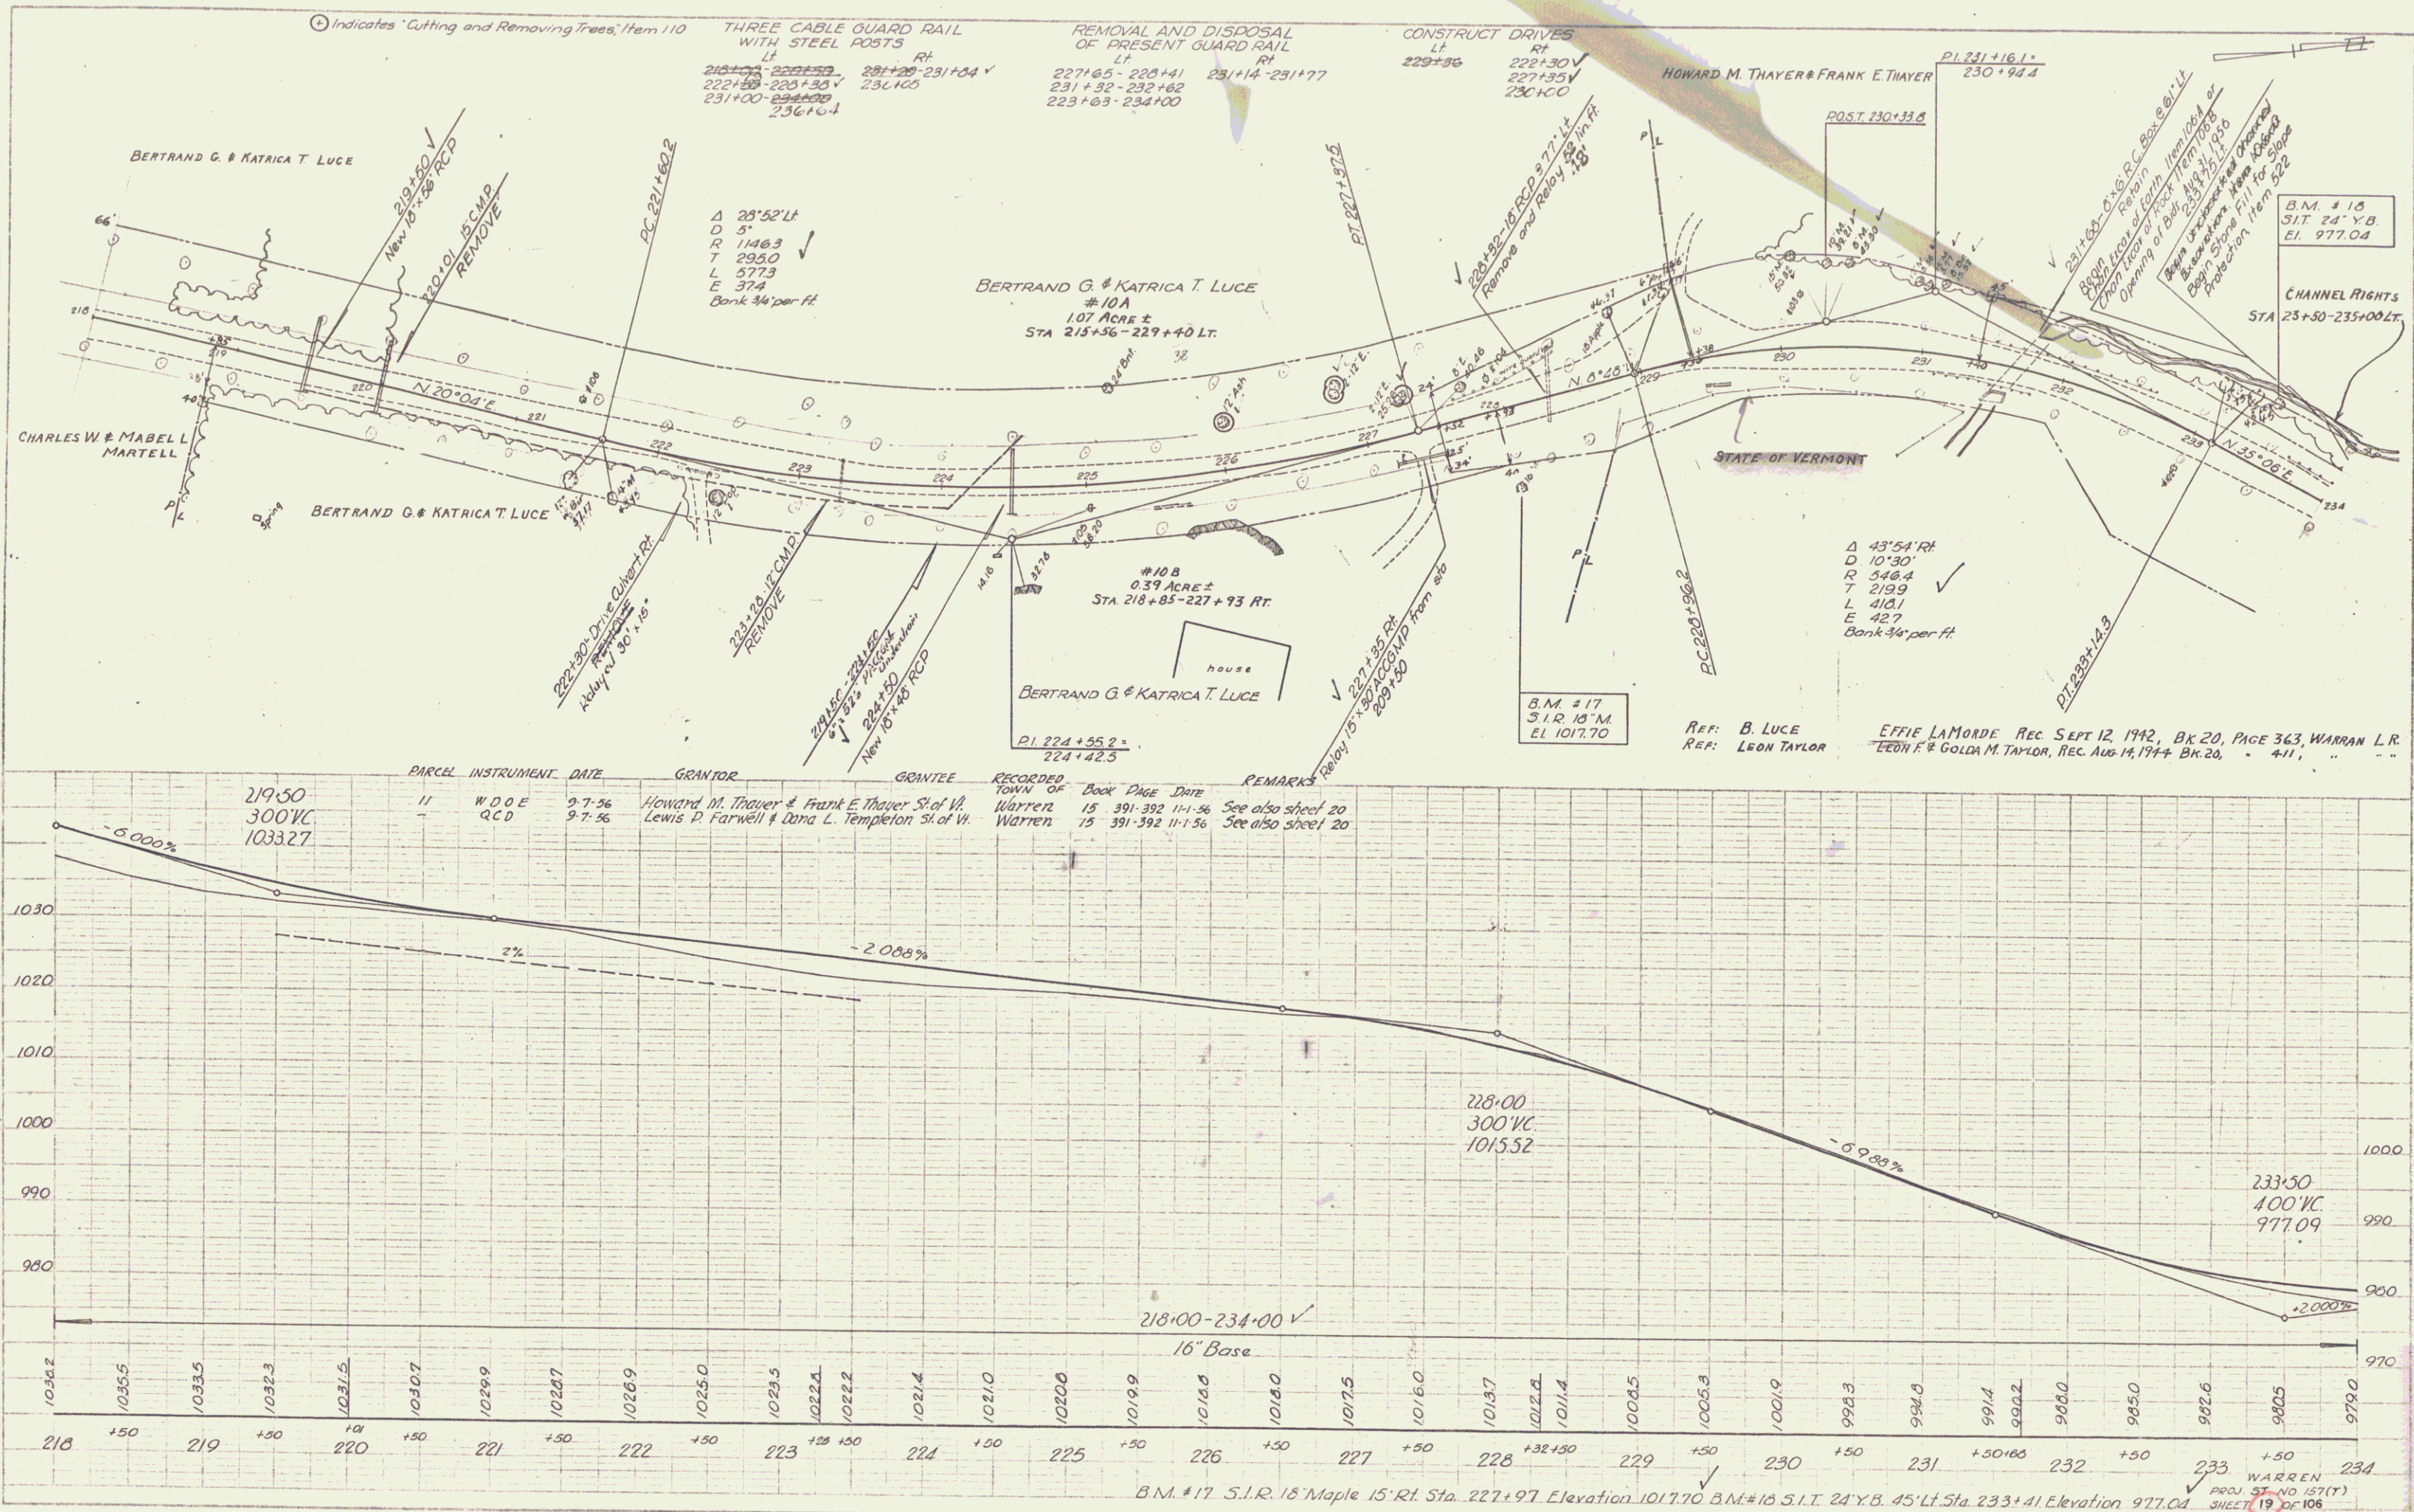

B.M. #17 S.I.R. 18' M. EL. 1017.70 B.M. #15 S.I.T. 24' Y.B. EL. 977.04
 SHEET 19 OF 108

PLAN	DATE	BY	CHECKED
1-56	1-56	1-56	1-56
1-56	1-56	1-56	1-56
1-56	1-56	1-56	1-56

FILE	DATE	BY	CHECKED
1-56	1-56	1-56	1-56
1-56	1-56	1-56	1-56
1-56	1-56	1-56	1-56

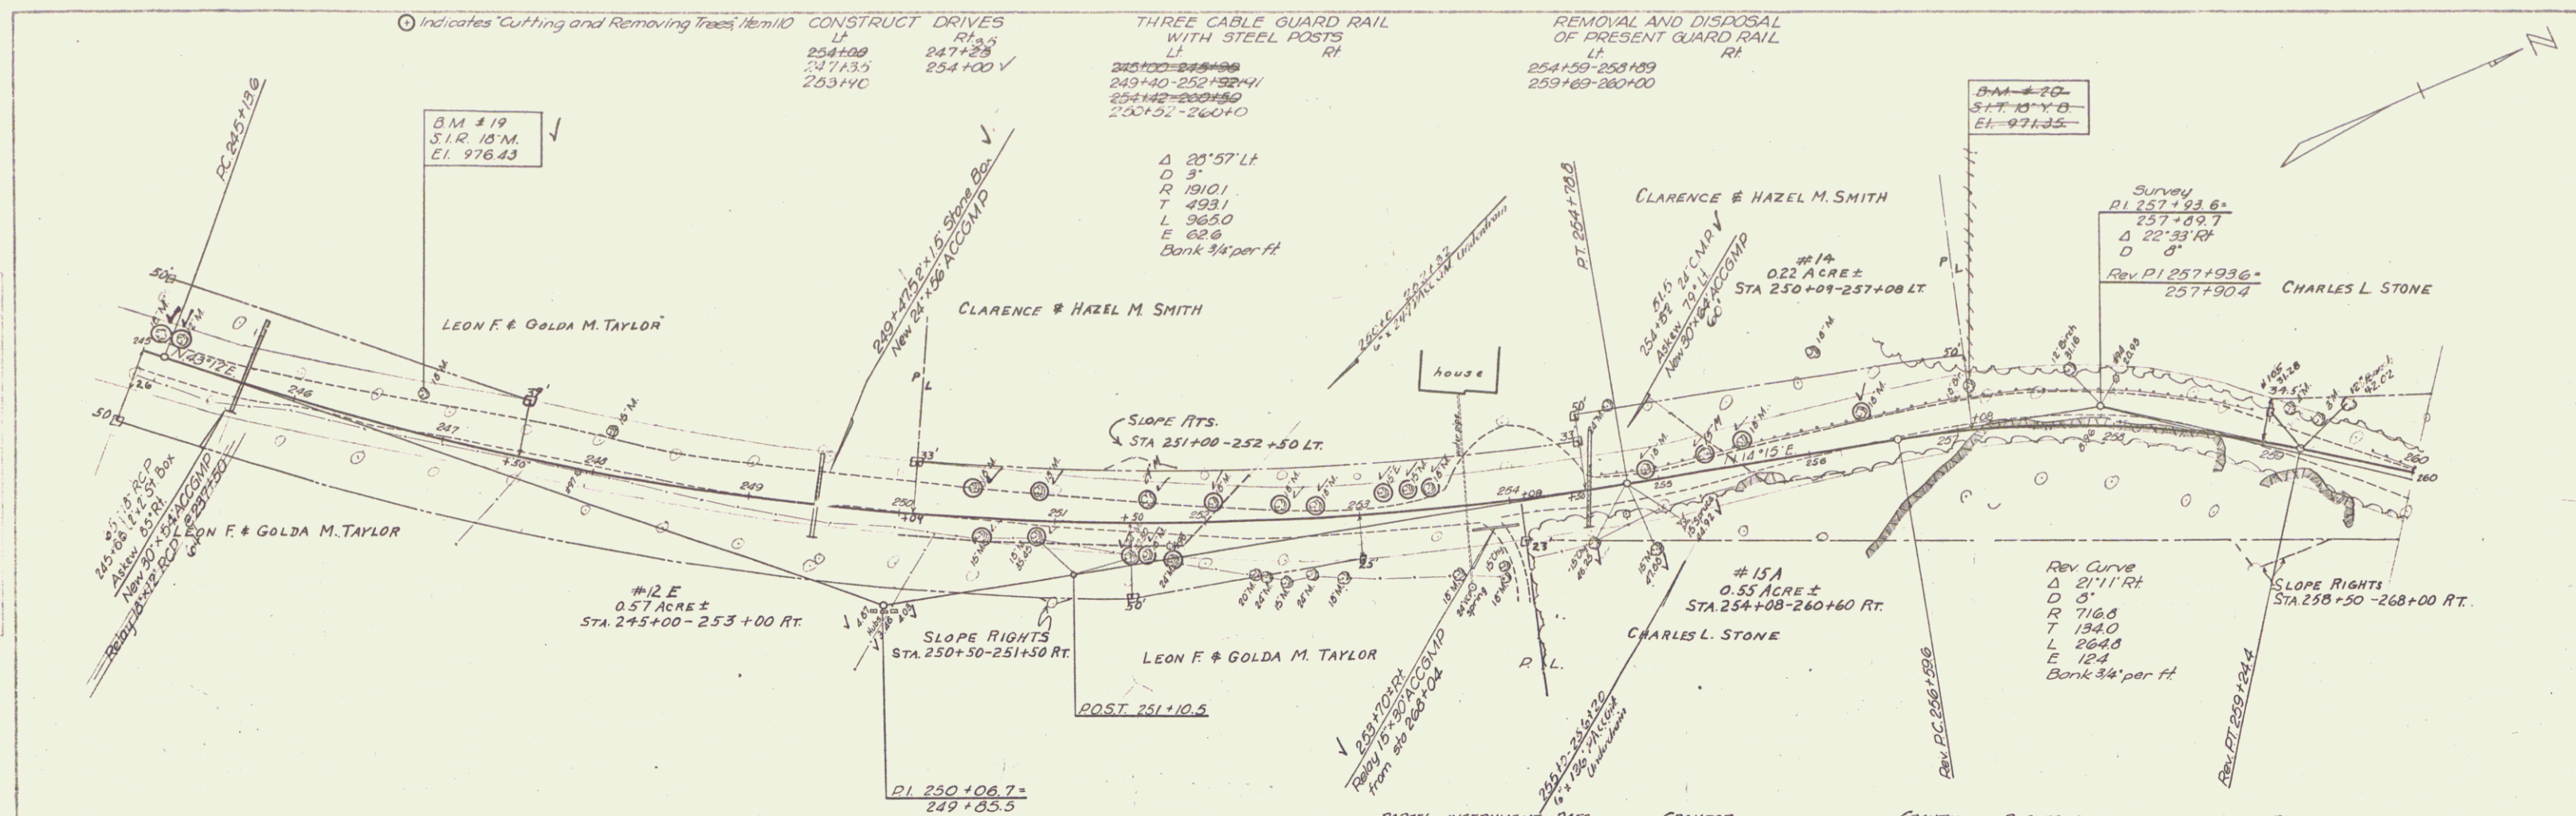

PARCEL	INSTRUMENT	DATE	GRANTOR	GRANTEE	RECORDED	TOWN OF	BOOK	PAGE	DATE	REMARKS
14	Cond.	7-2-56	Clarence & Hazel M. Smith	St. of Vt.	Warren	15	367-372	7-6-56		
13A,B,C,D	Wood	9-12-56	Charles L. Stone	St. of Vt.	Warren	22	507-508	11-1-56		See also sheet 22

