



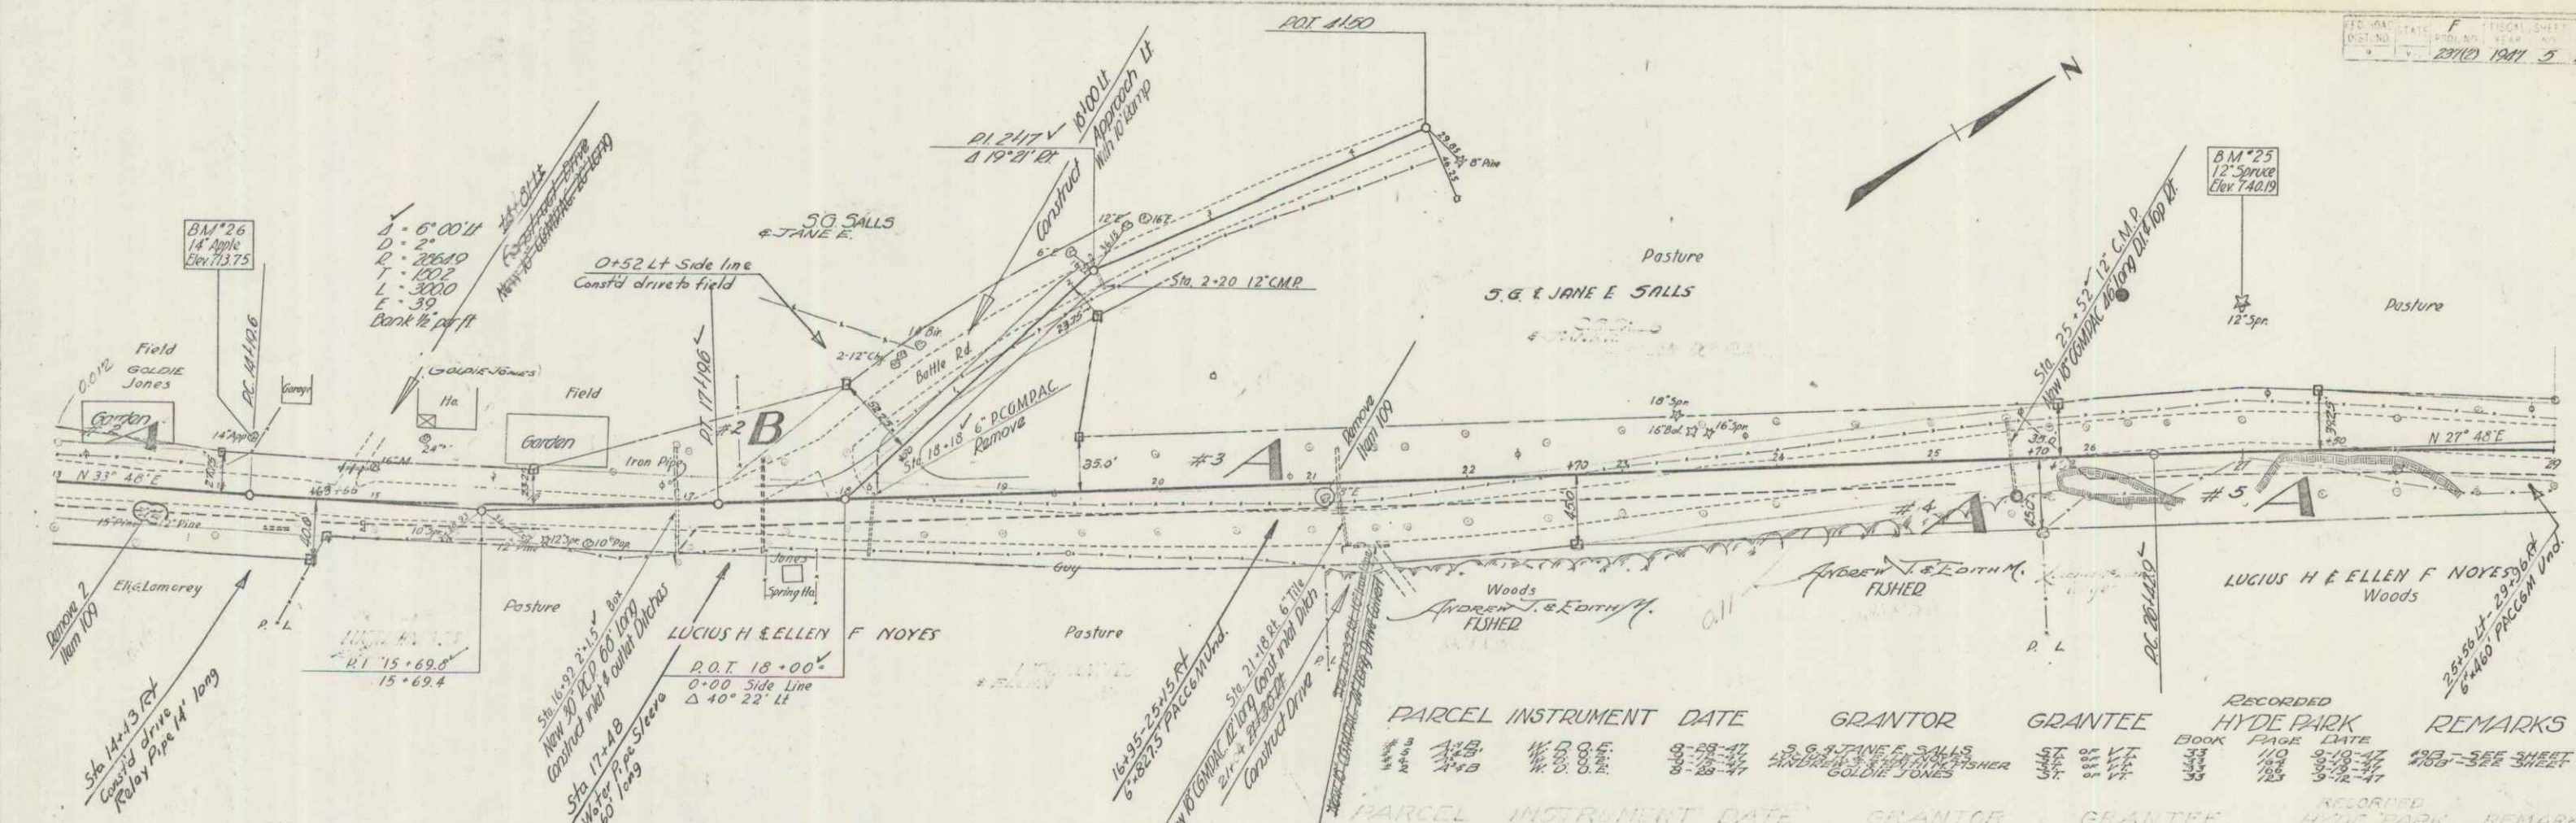

PARCEL	INSTRUMENT	DATE	GRANTOR	GRANTEE	RECORDED	HYDE PARK	REMARKS
118	118	9-28-47	J. & JANE E SALLS	37	110	9-28-47	283-356 SHEET 8
119	119	9-28-47	WILLIAM J. & EDITH M. FURER	37	110	9-28-47	
120	120	9-28-47	GOLDIE JONES	37	110	9-28-47	

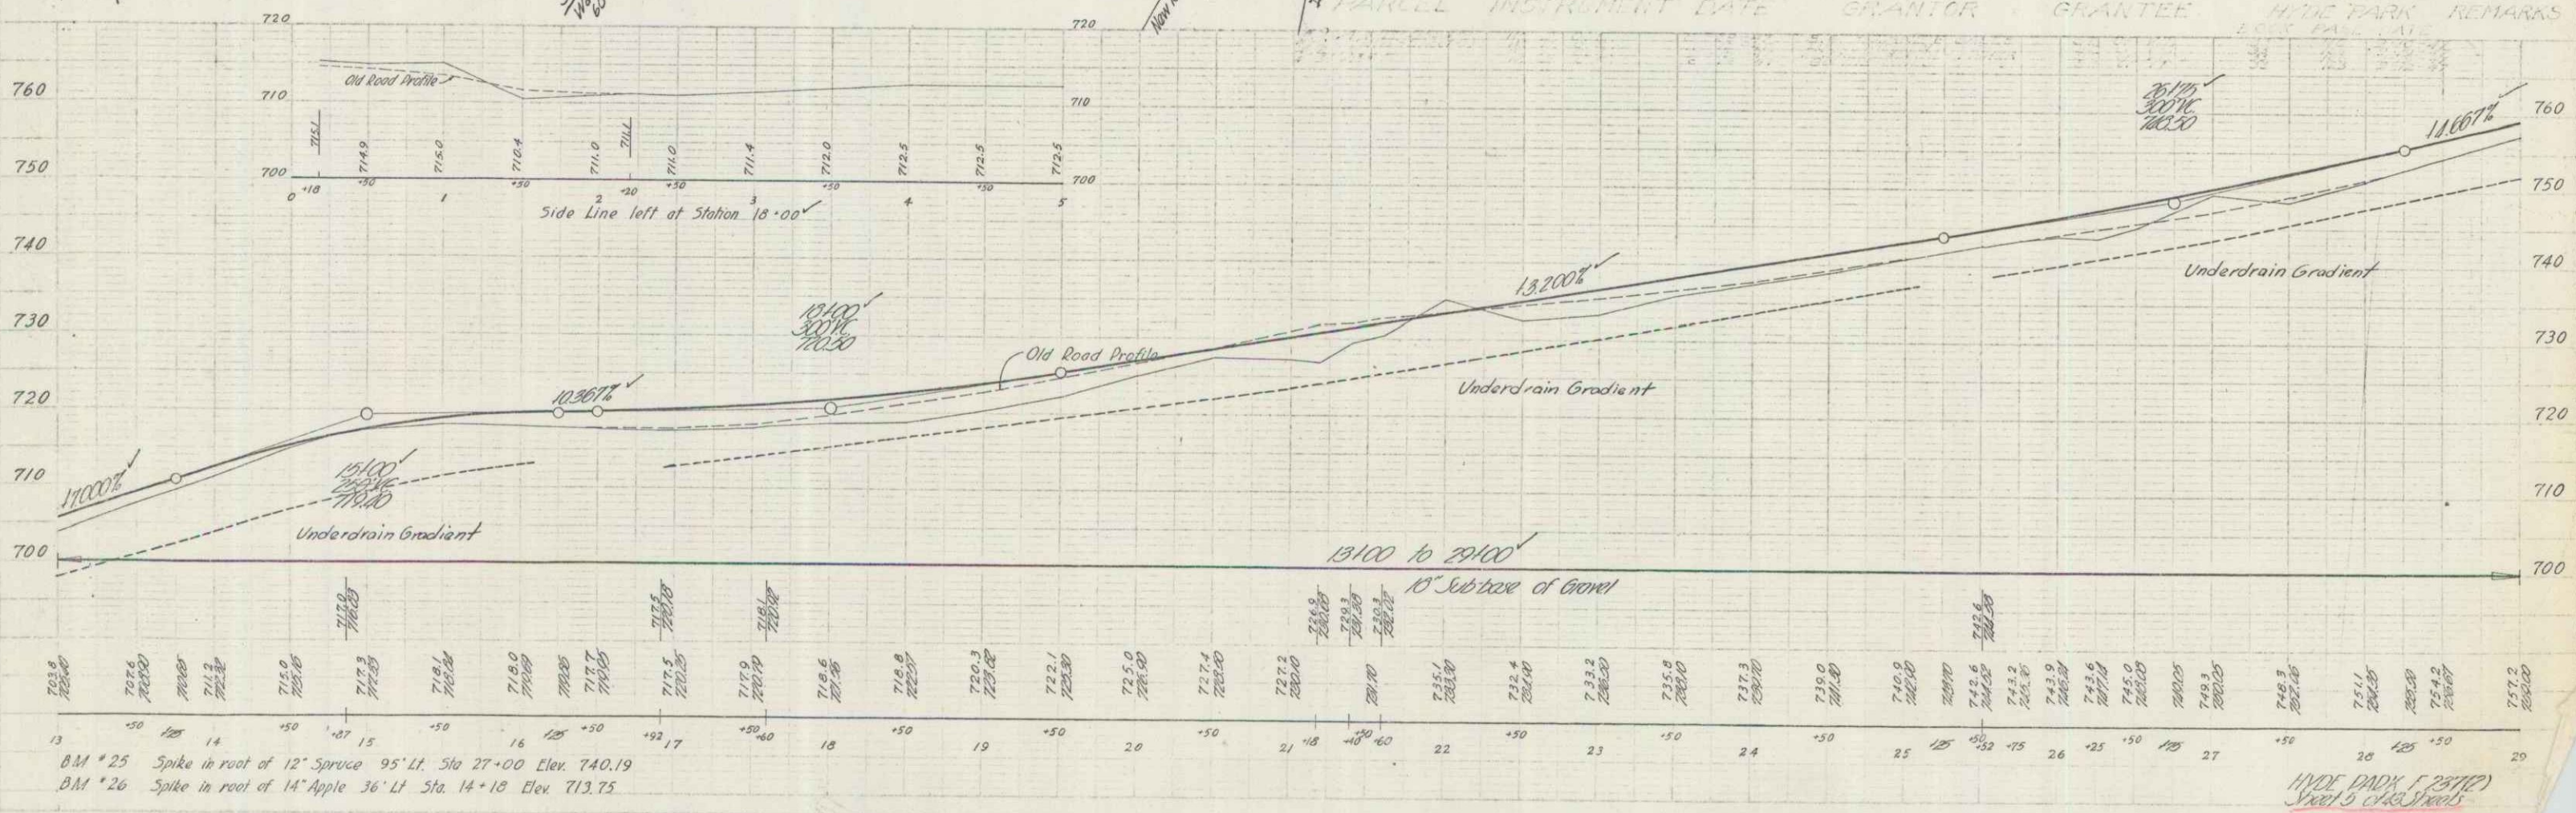

B.M. 25 Spike in root of 12 Spruce 95' Lt. Sta. 27+00 Elev. 740.19
 B.M. 26 Spike in root of 14 Apple 36' Lt. Sta. 14+10 Elev. 713.75

HYDE PARK (25712)
 1941 5 43