

INDEX OF SHEETS	
SHEET NO.	TITLE PAGE
1	TITLE PAGE
2	TYPICAL CROSS-SECTION OF IMPROVEMENT
3	BANKING AND WIDENING TABLES
4	PLAN AND PROFILE STA
5	Standard Structure Sheet S-31: Boundary Markers
6	Standard Structure Sheet S-40: Barricades, Signs, and Lights
7	Standard Structure Sheet S-41: Rounding of Cut Slopes
8-9	Cross-sections

Standard Structure Sheets Approved
by the Chief Engineer
3-28 July 11, 1933.
3-30 Aug. 13, 1934.
3-31 July 23, 1934.

(To Be Returned to R.O.W. Division)
Vt 100
PERMIT
TOWN FILE
RIGHT-OF-WAY DIVISION

STATE OF VERMONT STATE HIGHWAY DEPARTMENT

PLAN AND PROFILE OF PROPOSED STATE HIGHWAY

FEDERAL AID PROJECT

TOWN OF WESTFIELD


MORRISVILLE--NEWPORT ROAD

BEGINNING AT A POINT 900.5 FEET NORTHEASTERLY OF THE WESTFIELD-
LOWELL TOWN LINE AND EXTENDING 0.132 MILES ON ROUTE 100

LENGTH OF PROJECT: 601.0 FEET = 0.113 MILES

ROUTE VT 100
PROJECT: FAP 79 B(2)
DATE: 10/14/1940
PIN: 006641

FED. ROAD DIST. NO.	STATE	FED. AID PROJ. NO.	YEAR	SHEET NO.	TOTAL SHEETS
9	Vt.	79 B(2)	1941	1	9

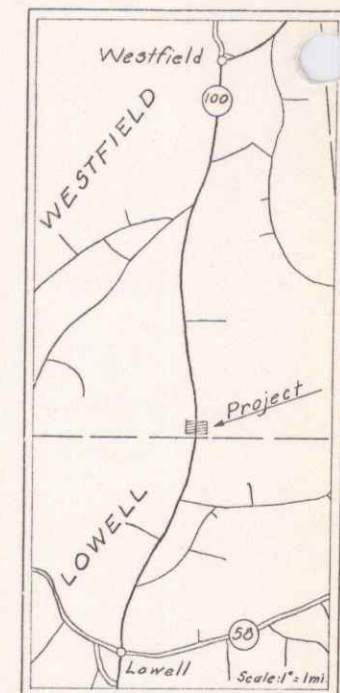


RECORD PLANS

CONVENTIONAL SIGNS	
COUNTY LINE	GROUND ELEVATION
TOWN LINE	GRADE ELEVATION
FENCE LINE	
STONE WALL	
UNFENCED PROPERTY	
GUARD RAIL	
TRAVELED WAY	
RAILROAD	
RETAINING WALL	
CENTER LINE	
SURVEY LINE	
CULVERT	
DROP INLET	
TROLLEY POLE	
POWER POLE	
TELEPHONE POLE	
TREES	
HEDGE	

CURVE DATA	
DEFLECTION ANGLE	Δ
DEGREE OF CURVE	D
RADIUS OF CURVE	R
TANGENT DISTANCE	T
LENGTH OF CURVE	L
EXTERNAL DISTANCE	E
POINT OF INTERSECTION	P. I.
POINT OF CURVE	P. C.
POINT OF TANGENT	P. T.
POINT ON TANGENT	P. O. T.

SCALE: 1" = 100'
Title: _____
Plan: _____
Profile: Horiz. _____
Vert. _____
Cross-sections: 1" = 5'

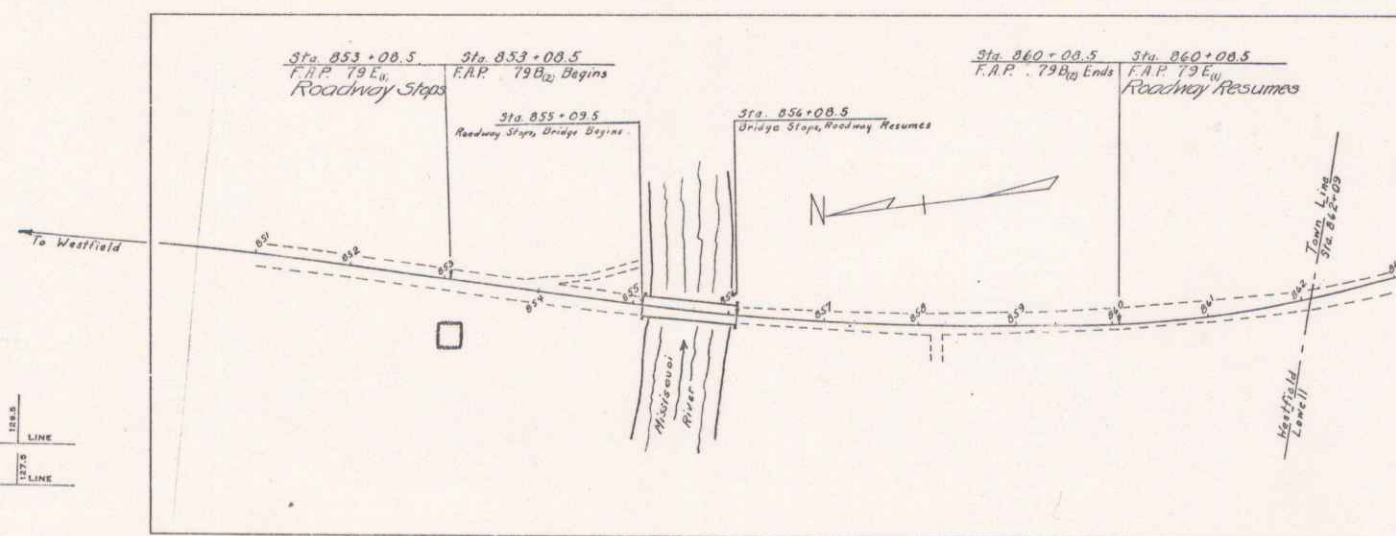

These plans are subject to such revisions as may be required by the Public Roads Administration or the Commissioner of Highways.

Construction is to be carried on in accordance with the plans and the Standard Road & Bridge Specifications of 1936, as approved December 29th, 1936, by the Public Roads Administration, including all subsequent approved revisions and such revised specifications and special provisions as are submitted with the plans.

RECOMMENDATIONS FOR APPROVAL:
DATE OF ENGINEER'S SUBMITTAL
FEDERAL ROAD AGENCY
APPROVED:
DATE OF APPROVAL
FEDERAL ROAD AGENCY


Approved: _____ 1940
ROAD ENGINEER
Approved: _____ 1940
DISTRICT HIGHWAY COMMISSIONER
SERIES FAP NO. 79-B(2) FILED
SHEET 1 OF 9

PARCEL	INSTRUMENT	DATE	GRANTOR	GRANTEE	RECORDED	REMARKS
A	WDOE	12-11-40	DENNIS DYER	ST. OF VT.	14 517-518 7-4-41	

$\Delta 7^{\circ}43'11''$
 $D 2^{\circ}$
 $R 286.40$
 $T 183.2$
 $L 383.3$
 $E 6.5$
 Do not bank

$\Delta 14^{\circ}36'11''$
 $D 5$
 $R 146.3$
 $T 146.3$
 $L 292.0$
 $E 9.4$

7780(2) 1941 4 9

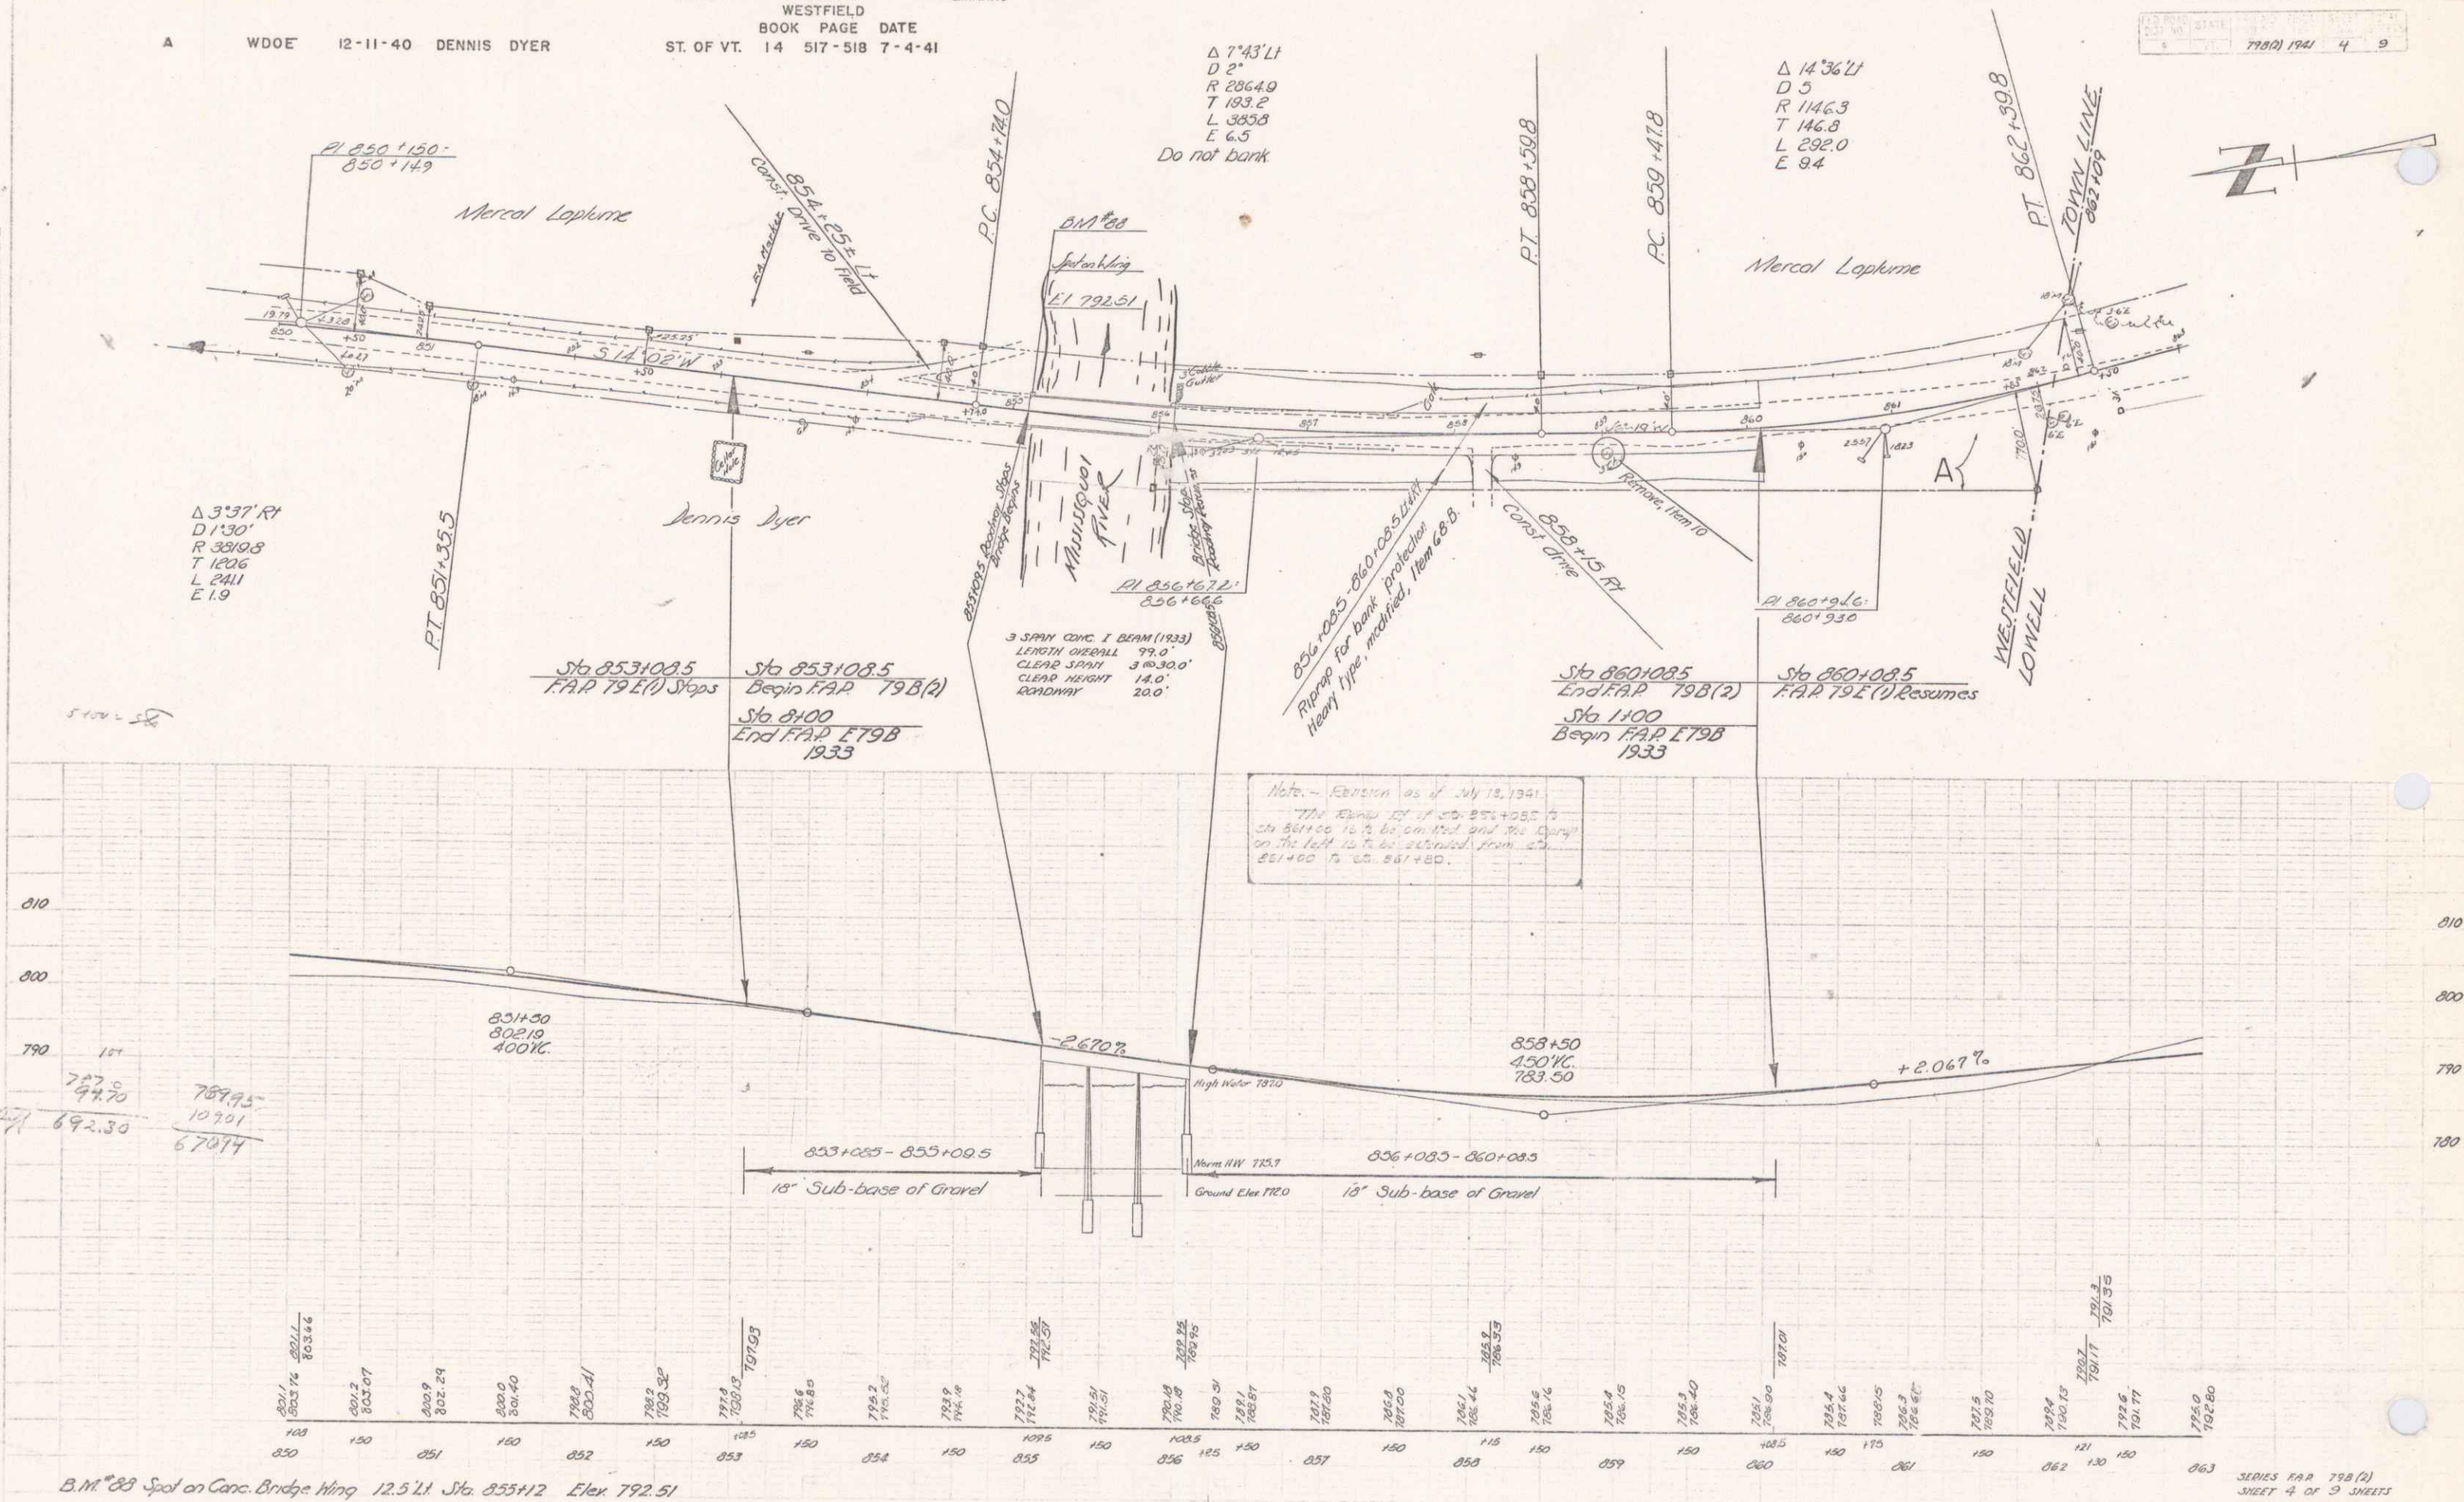

B.M. 88 Spot on Conc. Bridge Wing 12.5' Lt. Sta. 855+12 Elev. 792.51

SERIES PAR 798(2)
SHEET 4 OF 2 SHEETS