


PLAN	DATE	BY
DESIGNED	12/27	W. J. HARRIS
PLOTTED		
CHECKED		
NOTED		
NO.		

PROFILE	DATE	BY
DESIGNED		
PLOTTED		
CHECKED		
NOTED		
NO.		



PARCEL 1 MARSH, LAWRENCE J.
 STA. 98+97 RT. - 110+60 LT. AREA 1.02A±
 WD RECORDED ROCHESTER 12-2-72 BK. 39 PG. 111
 CONSTRUCT DRIVES (T) 101+10, 102+15, 104+00 &
 110+25 RT. - CULVERT RTS. (P) 104+77 - DRAINAGE
 & CULVERT RTS. (P) 102+85, 106+91 & 109+50 LT.
 SLOPE (P) 0.47A± STA. 102+70 - 110+60 LT.
 SLOPE (P) 0.45A± STA. 104+25 - 110+60 RT.

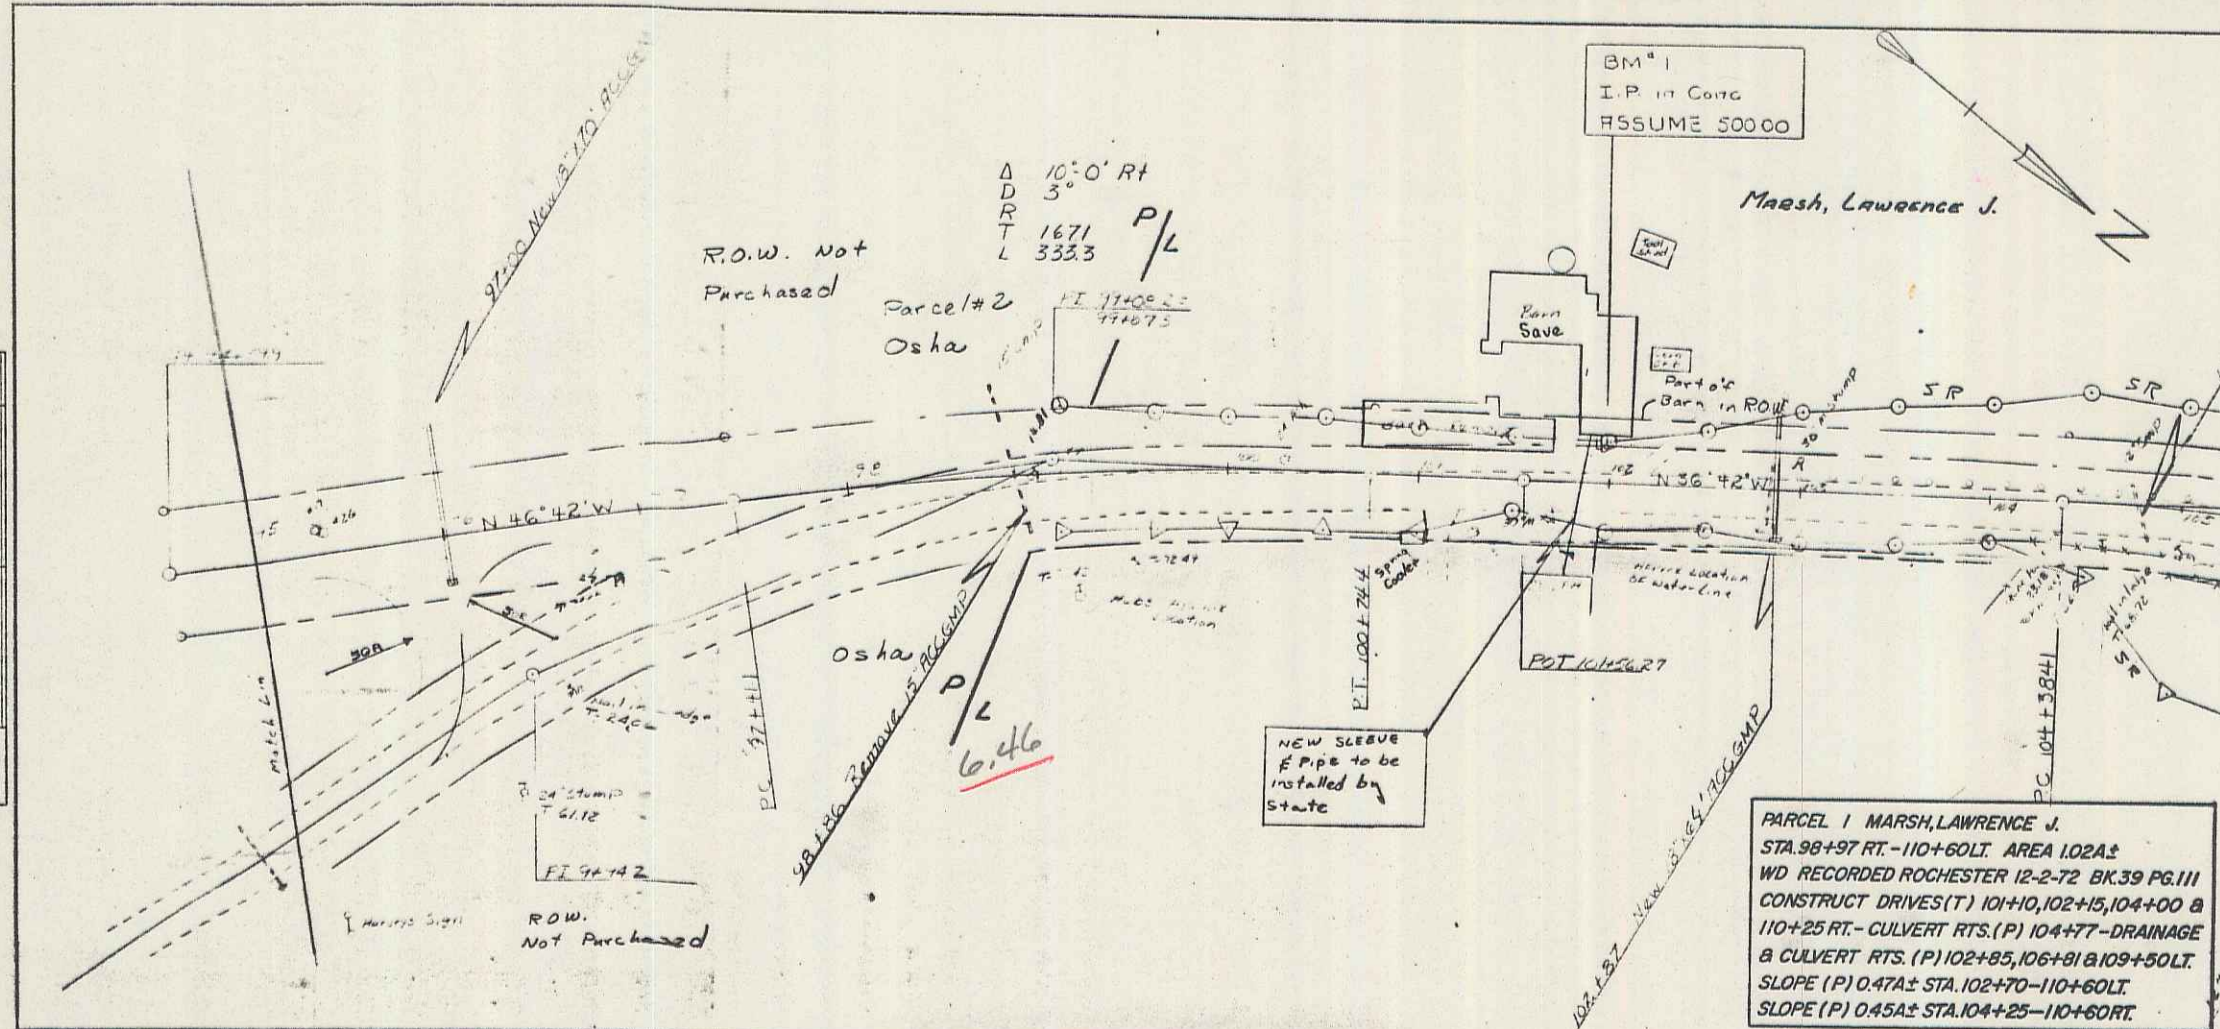