


POOR ORIGINAL COPY

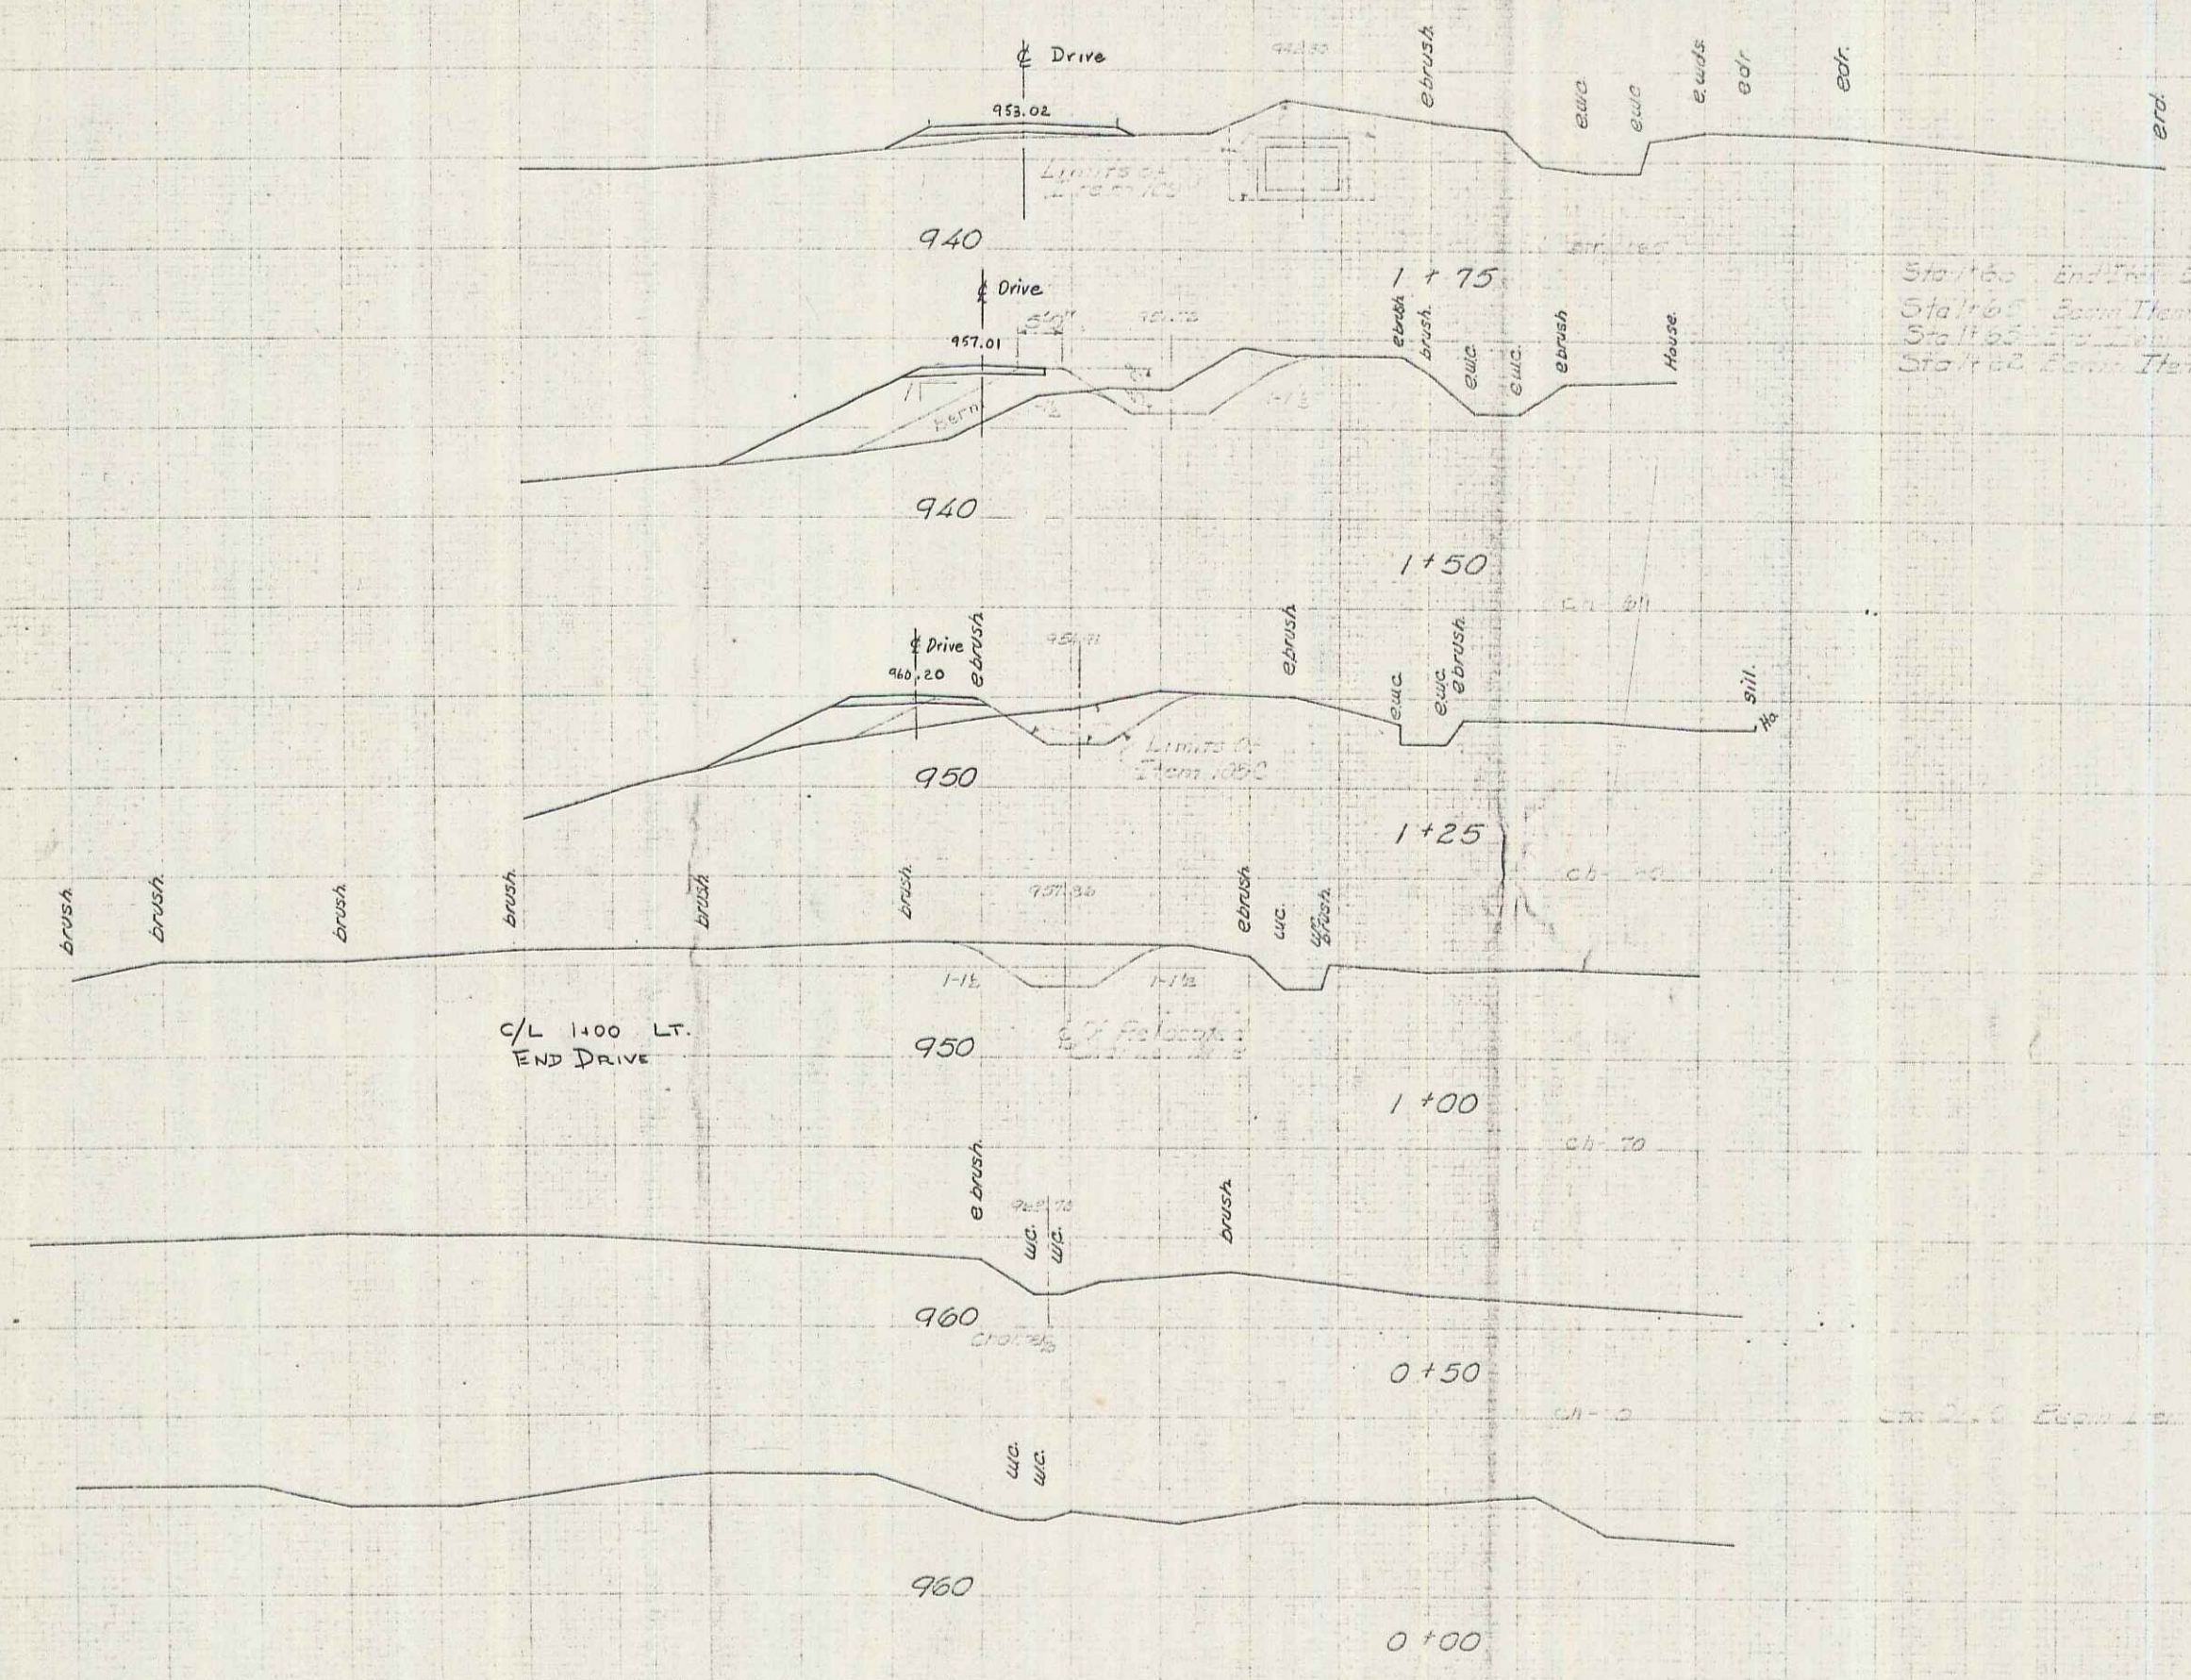

Sta 160 End Int. SIC
Sta 165 Begin Item 04; Structure Excavation
Sta 165 End Item 04
Sta 165 Begin Item 05; Stone Wall & Foundation (Left Side)

Channel Sections
16. POT 10+250=
C/L POT 2+00.0
Δ = 95°-00'

DATE OF SURVEY	
DESIGNER OF CHANNELS	
1. HANCOCK	
2. Fantoni	4/69
3. Hopkins	R.L.G.H.
4. SP.	
5. BMA 391	
6. VT-RP-100	
7. 0100	
8. 1+75	

5