


PLAN  
 CONT'D  
 1/2" = 100'  
 NOTE: BOOK 11 OF 11  
 DATE: 03/01/1969

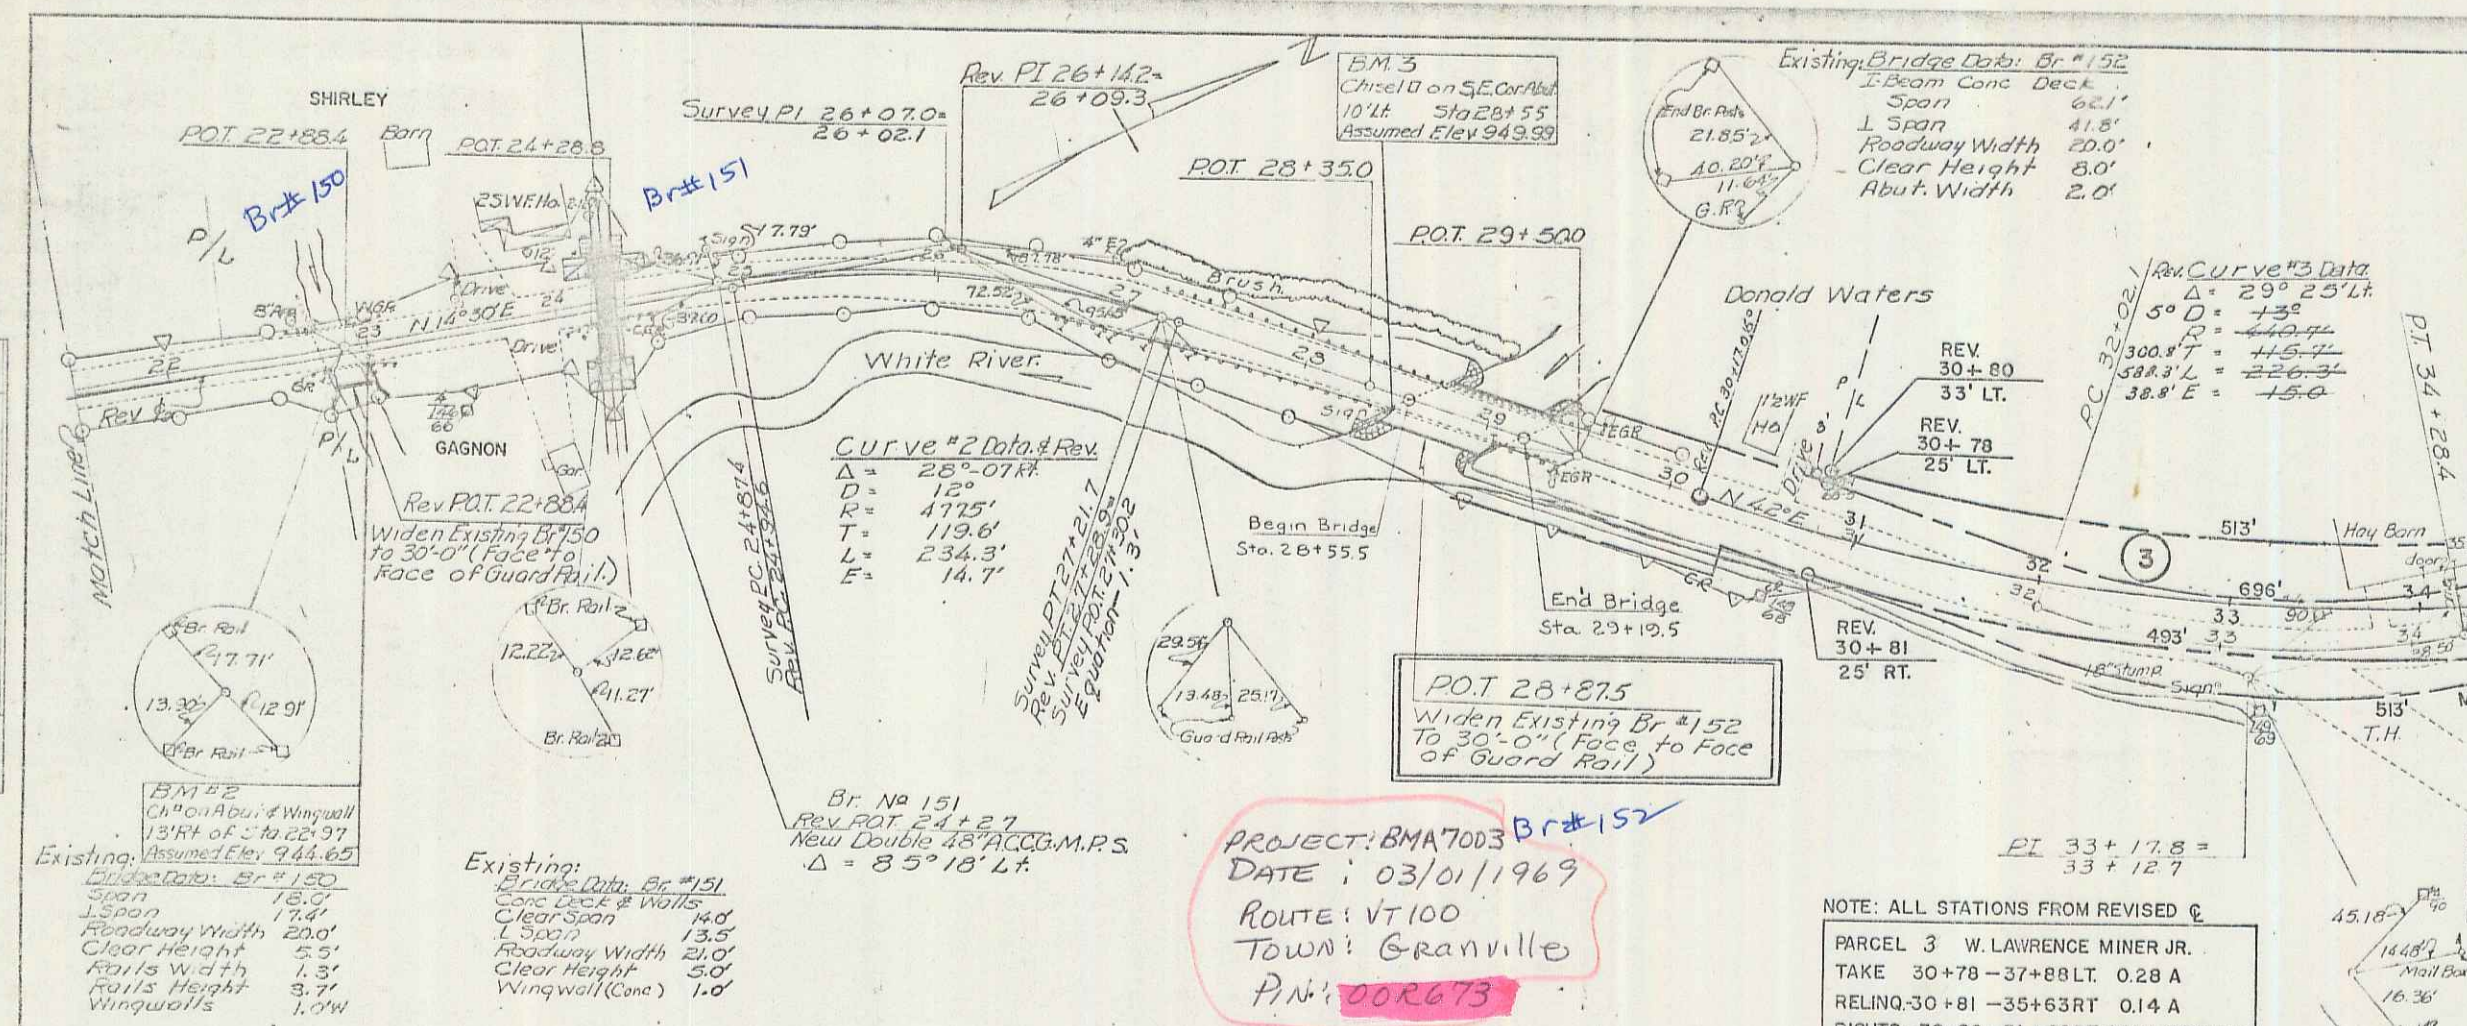

PROFILE  
 CONT'D  
 1/2" = 10'  
 NOTE: BOOK 11 OF 11  
 DATE: 03/01/1969

