


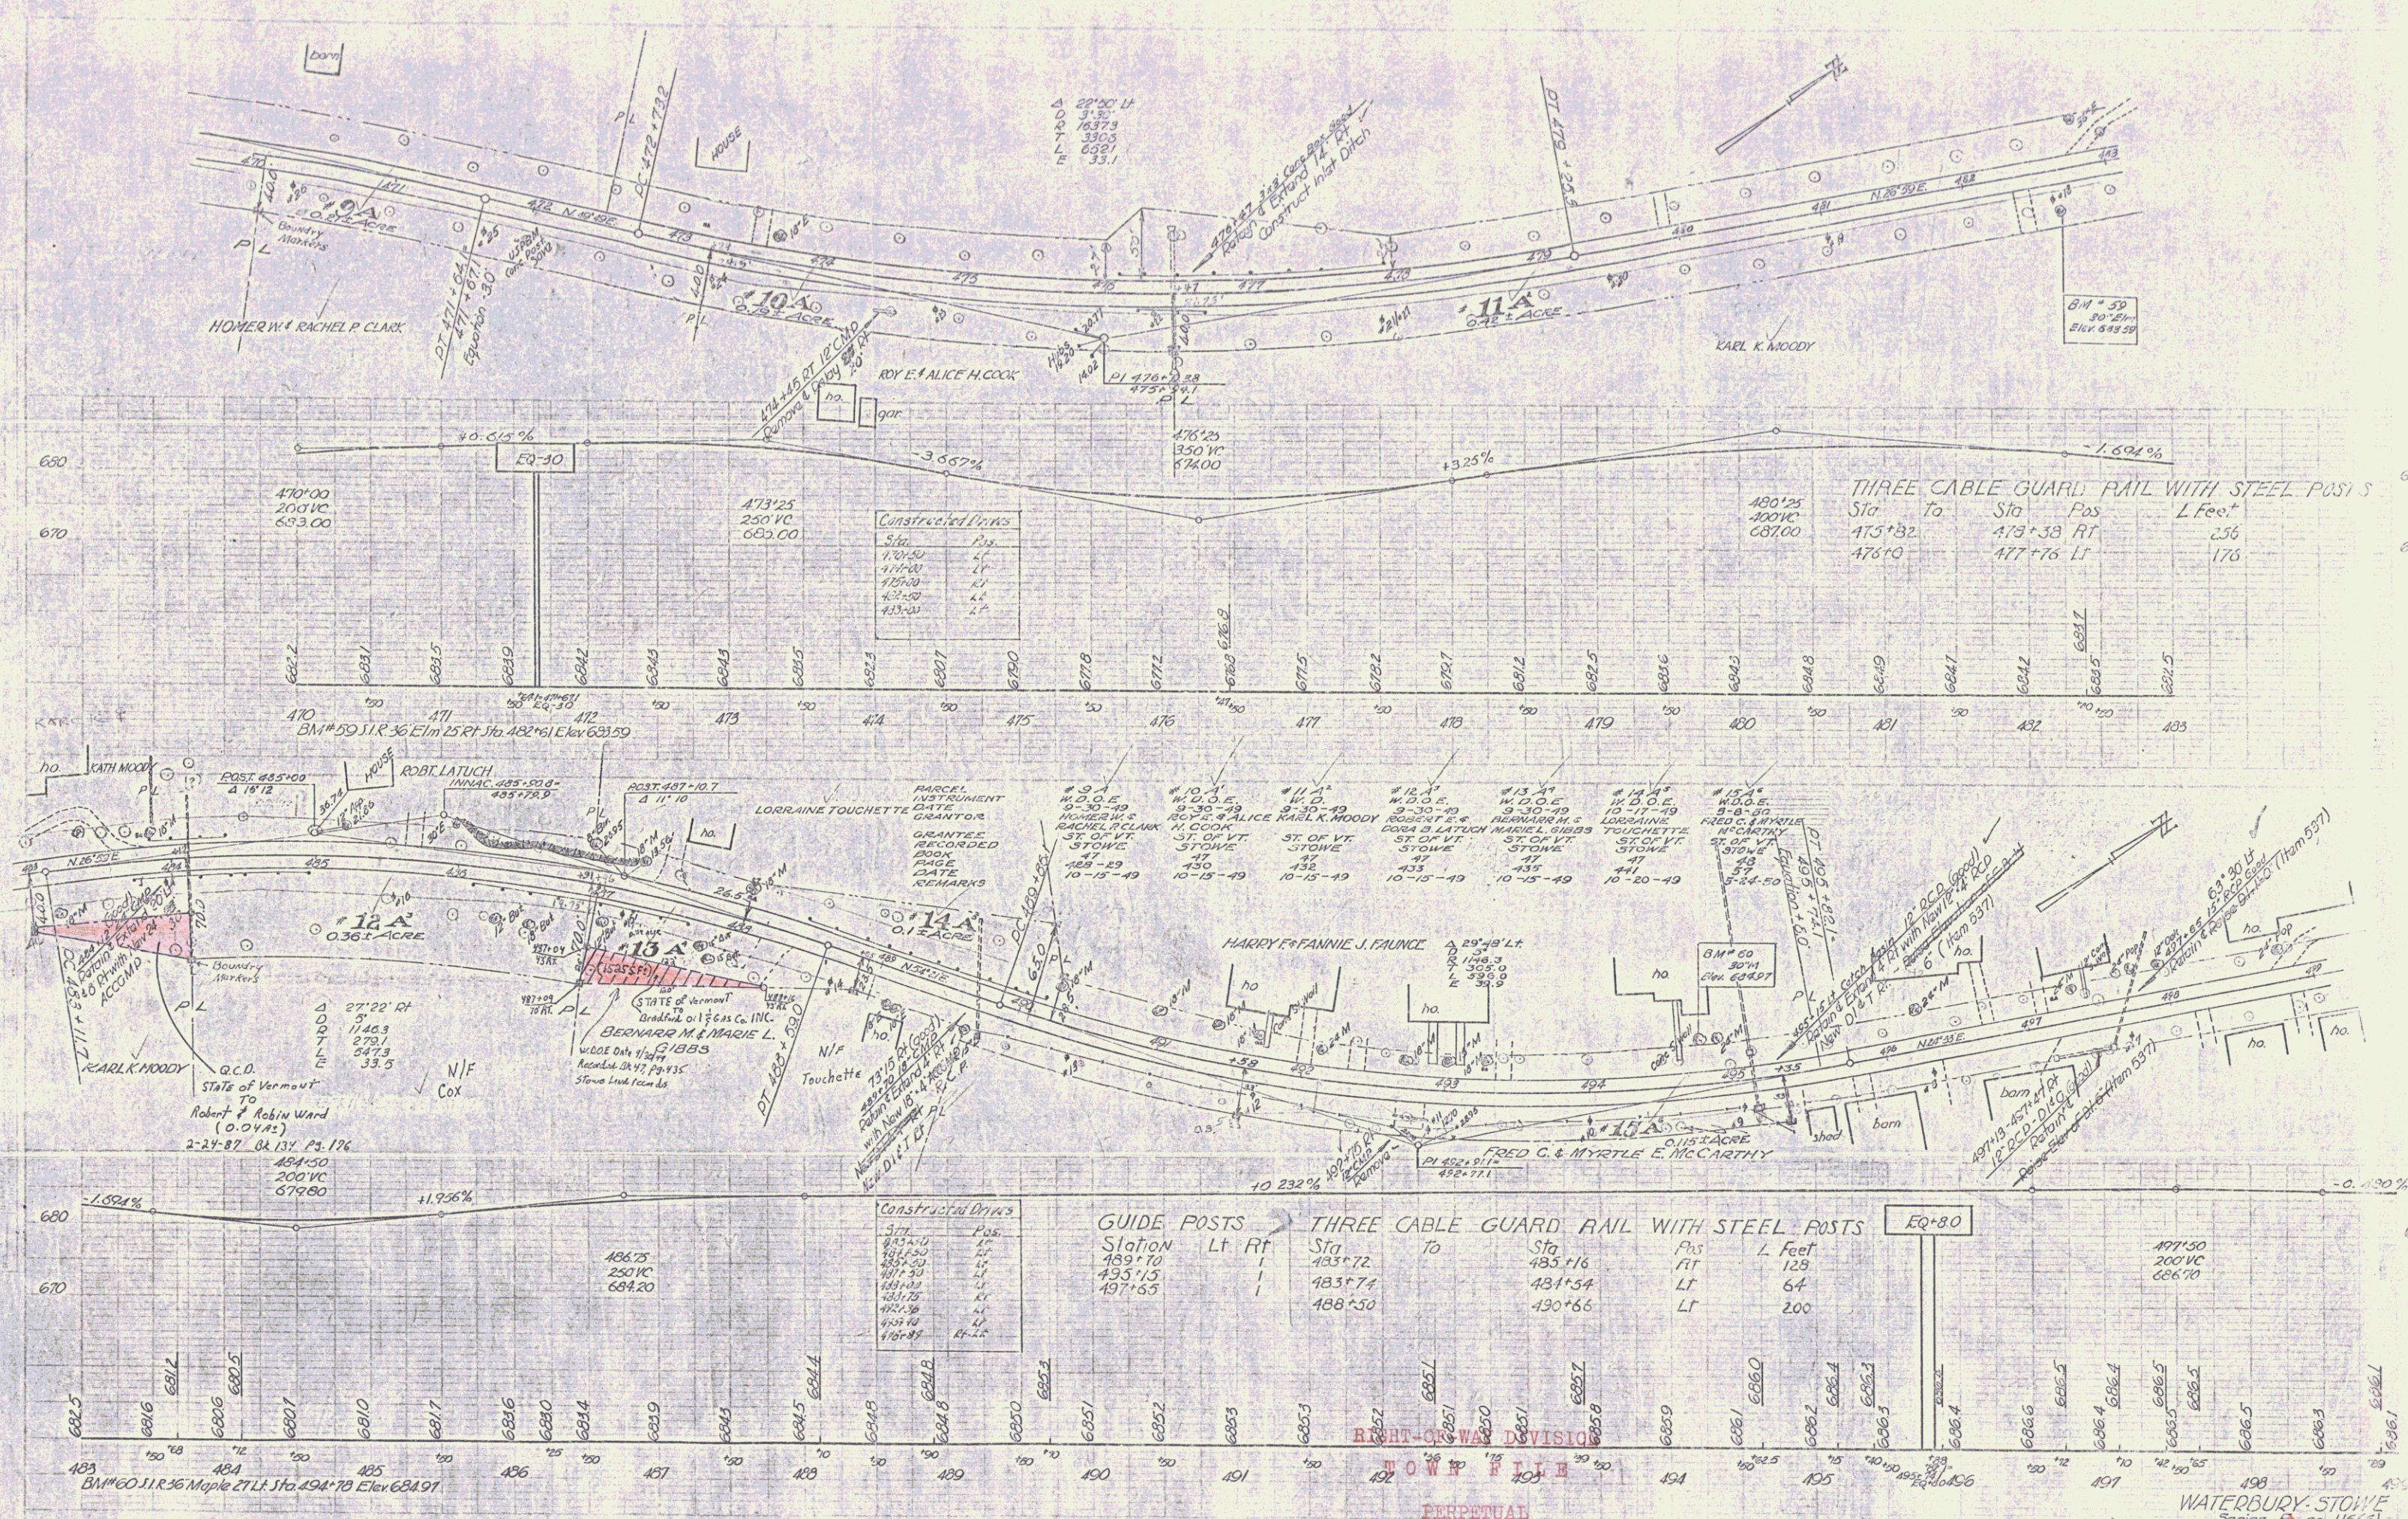

Constructed Drives

Sta.	Dist.
470+50	4.0
471+00	4.0
472+00	4.0
473+00	4.0
474+00	4.0
475+00	4.0

Constructed Drives

Sta.	Dist.
481+50	4.0
482+00	4.0
483+00	4.0
484+00	4.0
485+00	4.0
486+00	4.0

GUIDE POSTS

Station	Lt	Rt
489+70		
495+70		
497+50		

THREE CABLE GUARD RAIL WITH STEEL POSTS

Sta.	To	Sta.	To	Sta.	To	Sta.	To	Sta.	To
489+70	493+72	493+72	493+72	493+72	493+72	493+72	493+72	493+72	493+72
495+70	495+70	495+70	495+70	495+70	495+70	495+70	495+70	495+70	495+70
497+50	497+50	497+50	497+50	497+50	497+50	497+50	497+50	497+50	497+50

Town of Stowe Vt 100
(To Be Returned To R.O.W. Division)

WATERBURY STONE
Series 118 (5)
Sheet 118 (5)
JAN 09 1904