





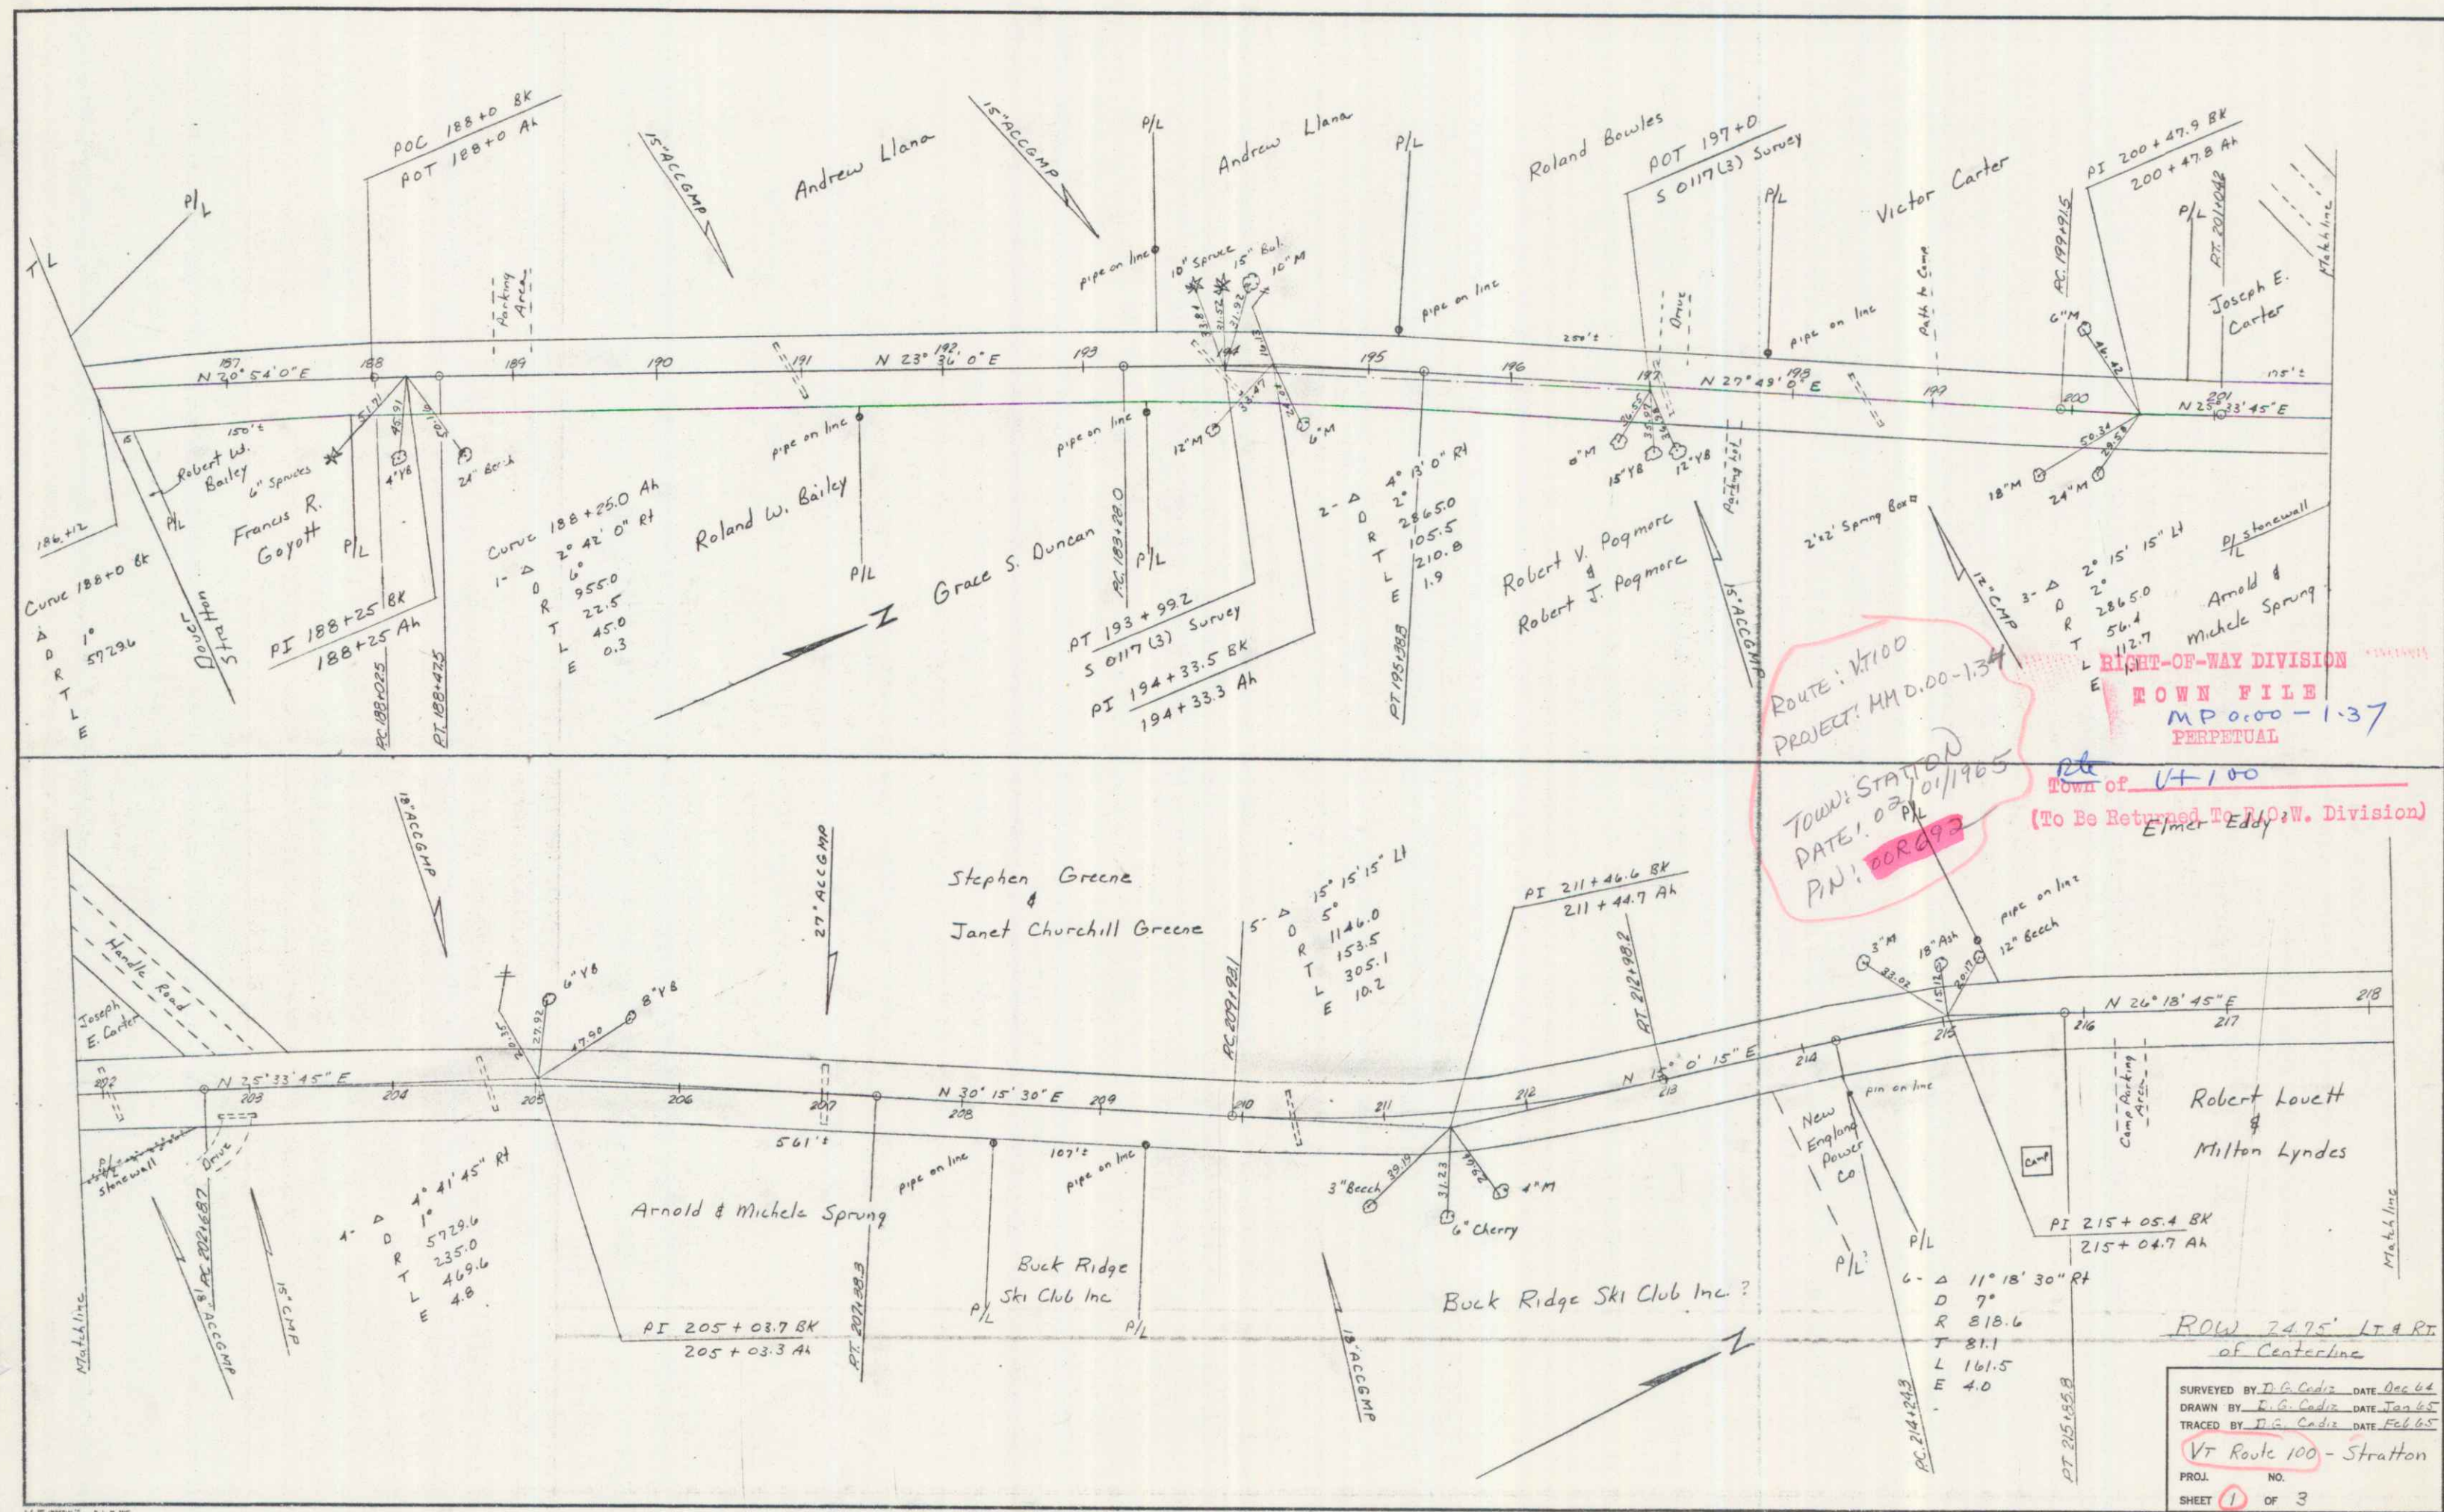

ROW 24.75' LT & RT
 of Centerline
 SURVEYED BY D. G. Gads DATE Feb 64
 DRAWN BY D. G. Gads DATE Jan 65
 TRACED BY D. G. Gads DATE Feb 65
 VT Route 100 Stratton
 PROJ. NO. 2
 SHEET 2 OF 3

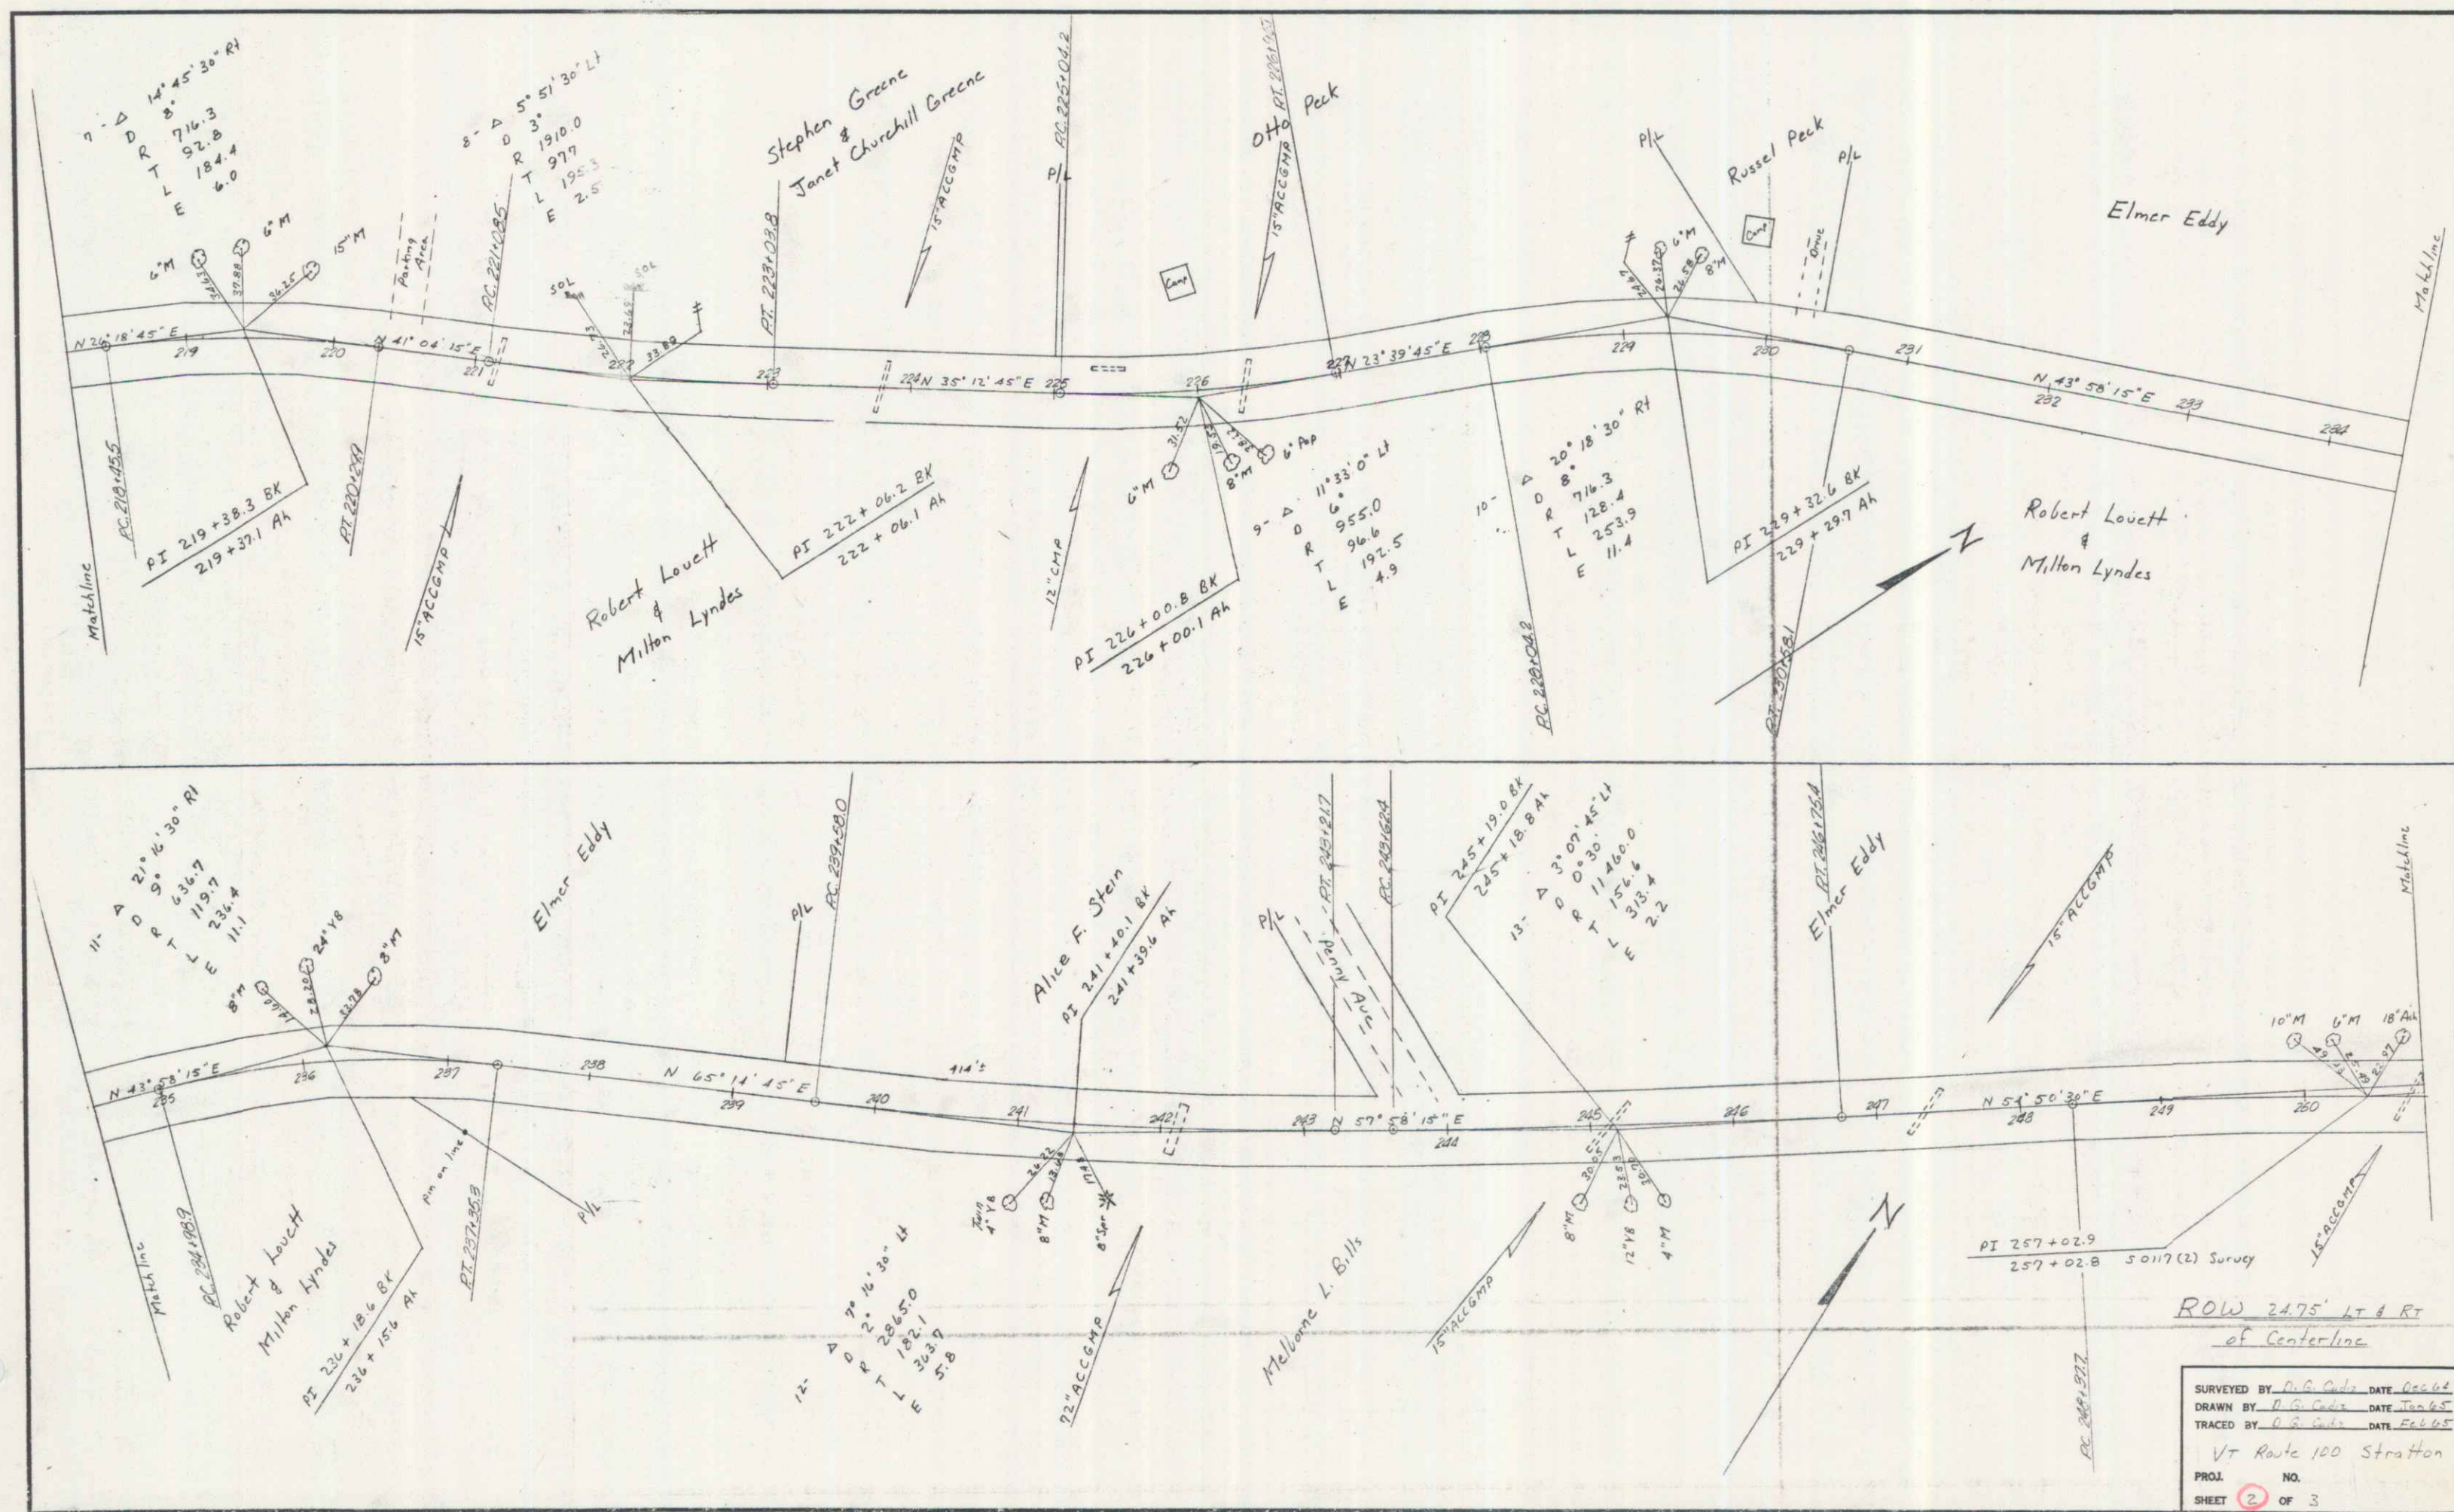