



PLAN	7-33
DATE	8-33
BY	W.C.
CHECKED	W.C.
APPROVED	W.C.

PROF	8-33
DATE	8-33
BY	W.C.
CHECKED	W.C.
APPROVED	W.C.

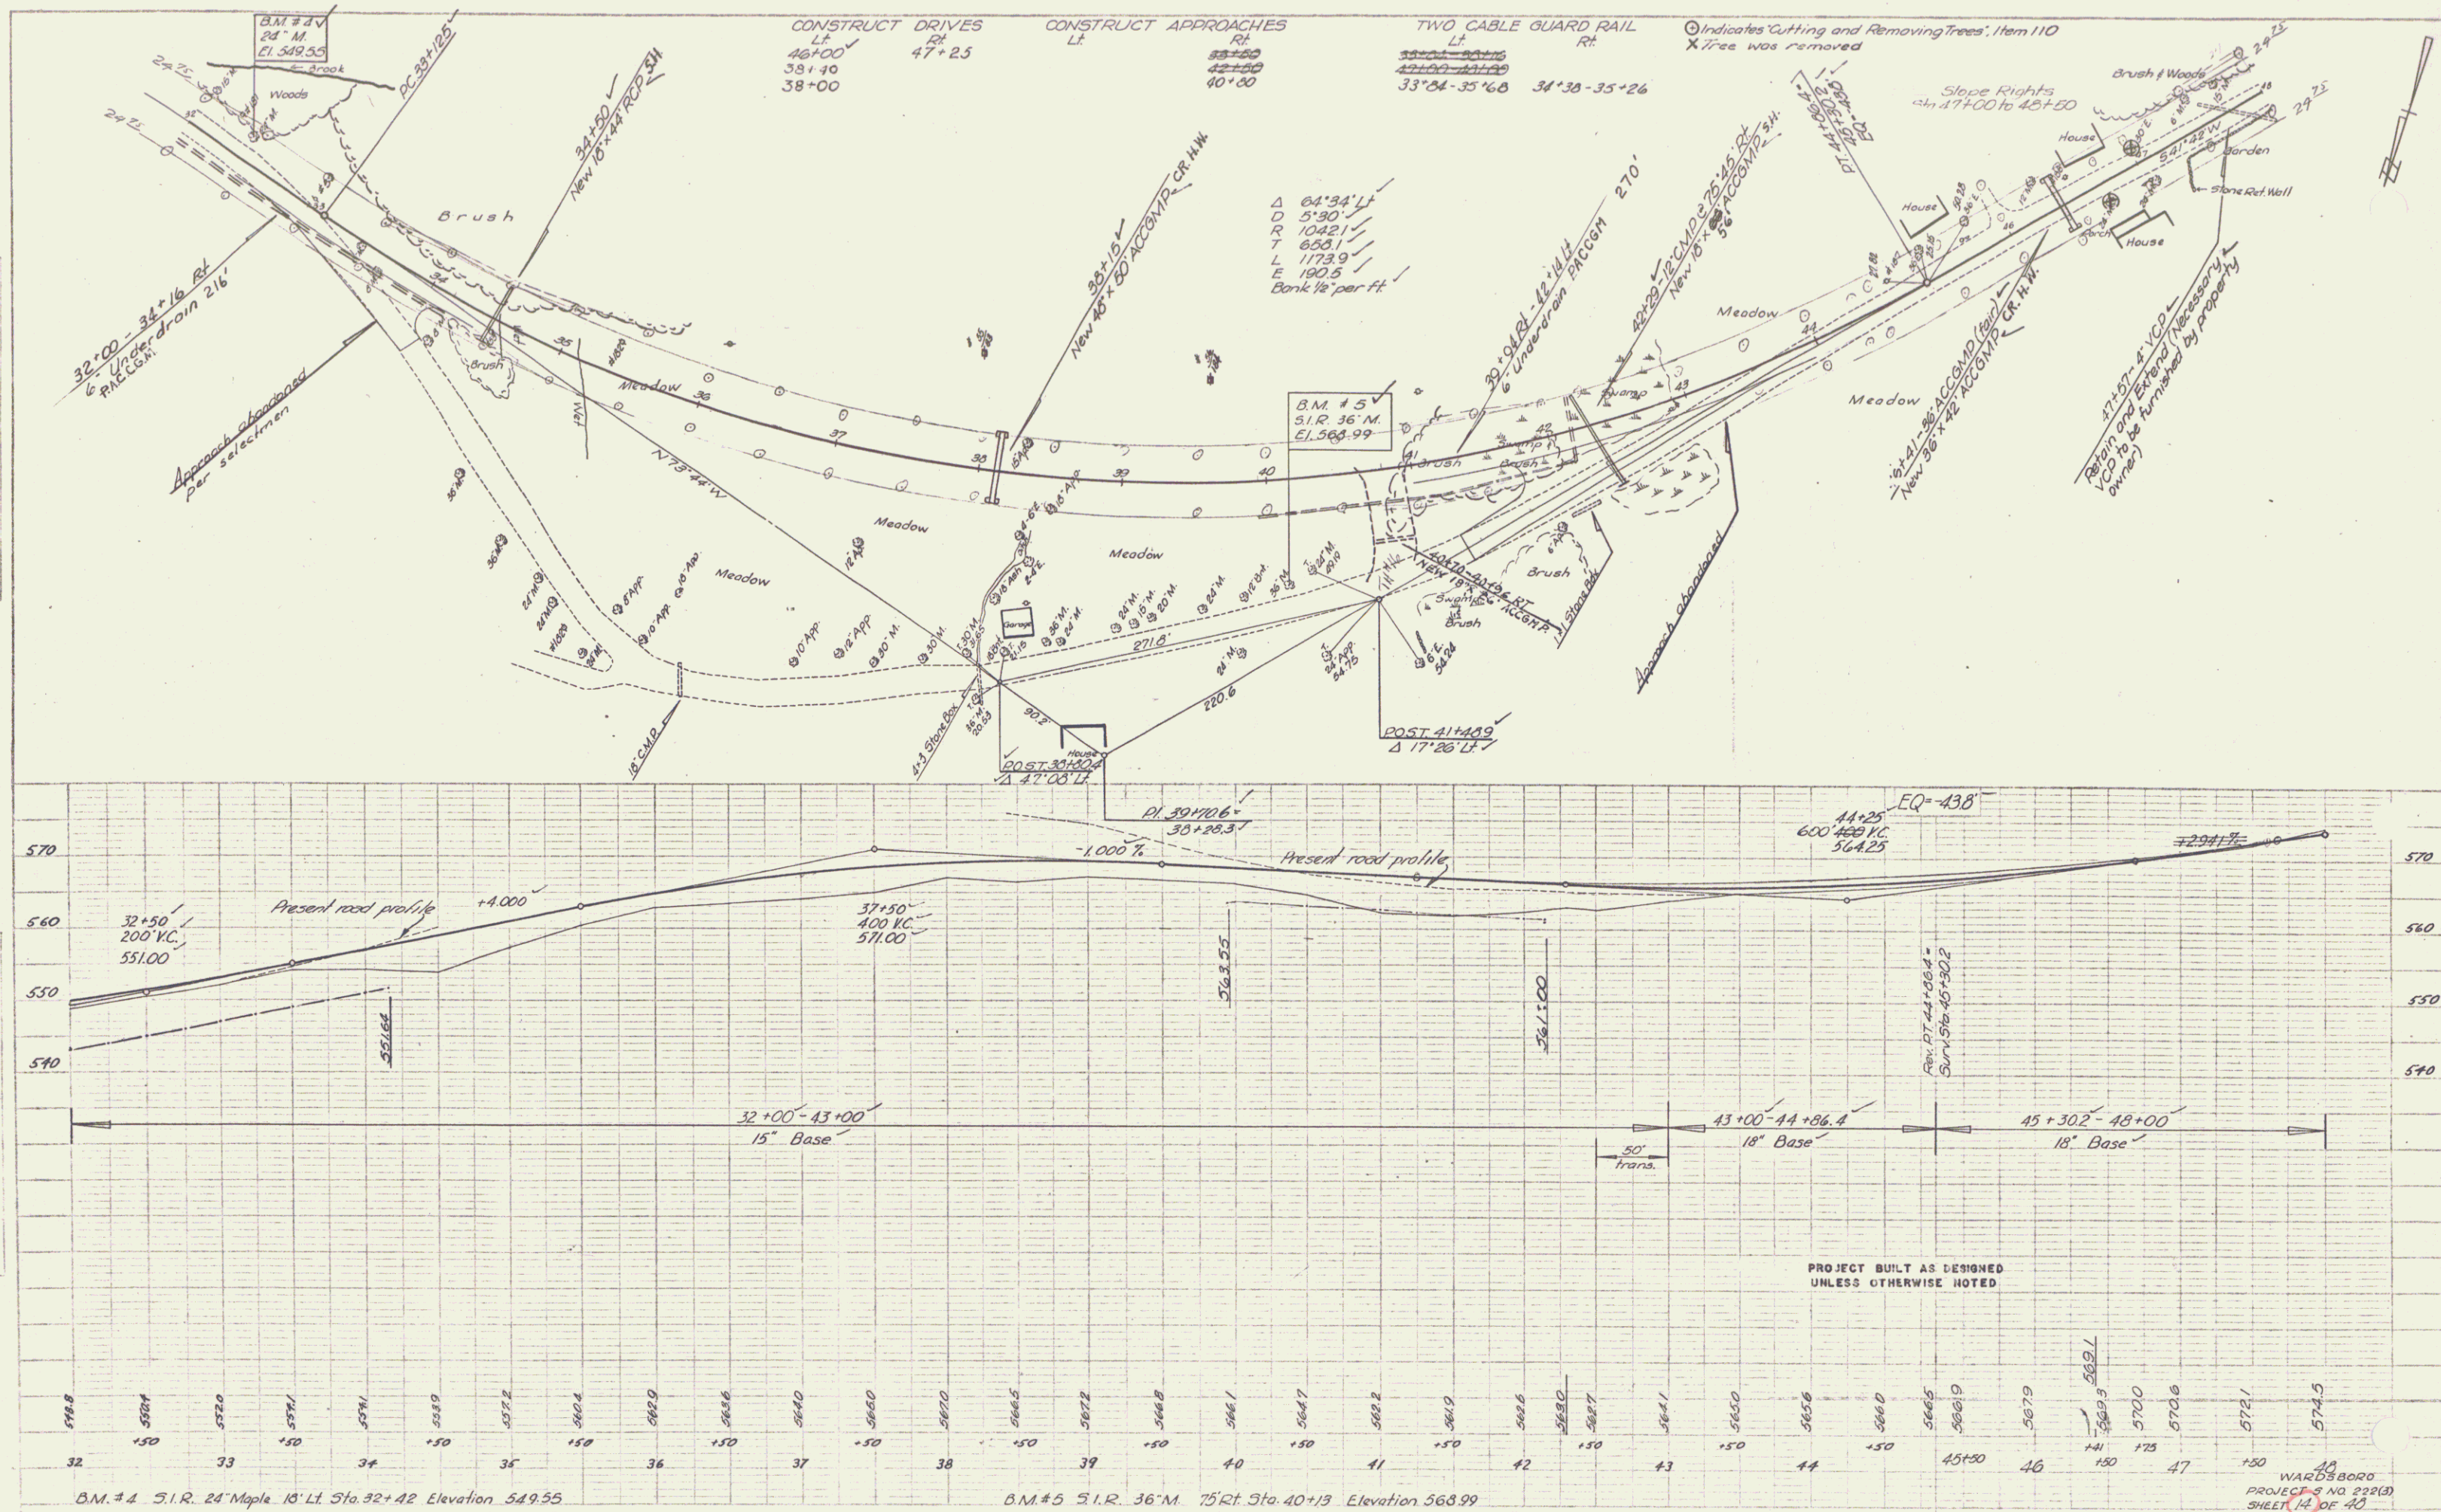


PLAN
 DATE: 12/1/54
 BY: JSC/BA
 CHECKED: WJ
 SCALE: 1" = 40'

PROFILES
 DATE: 12/1/54
 BY: JSC/BA
 CHECKED: WJ
 SCALE: 1" = 10'

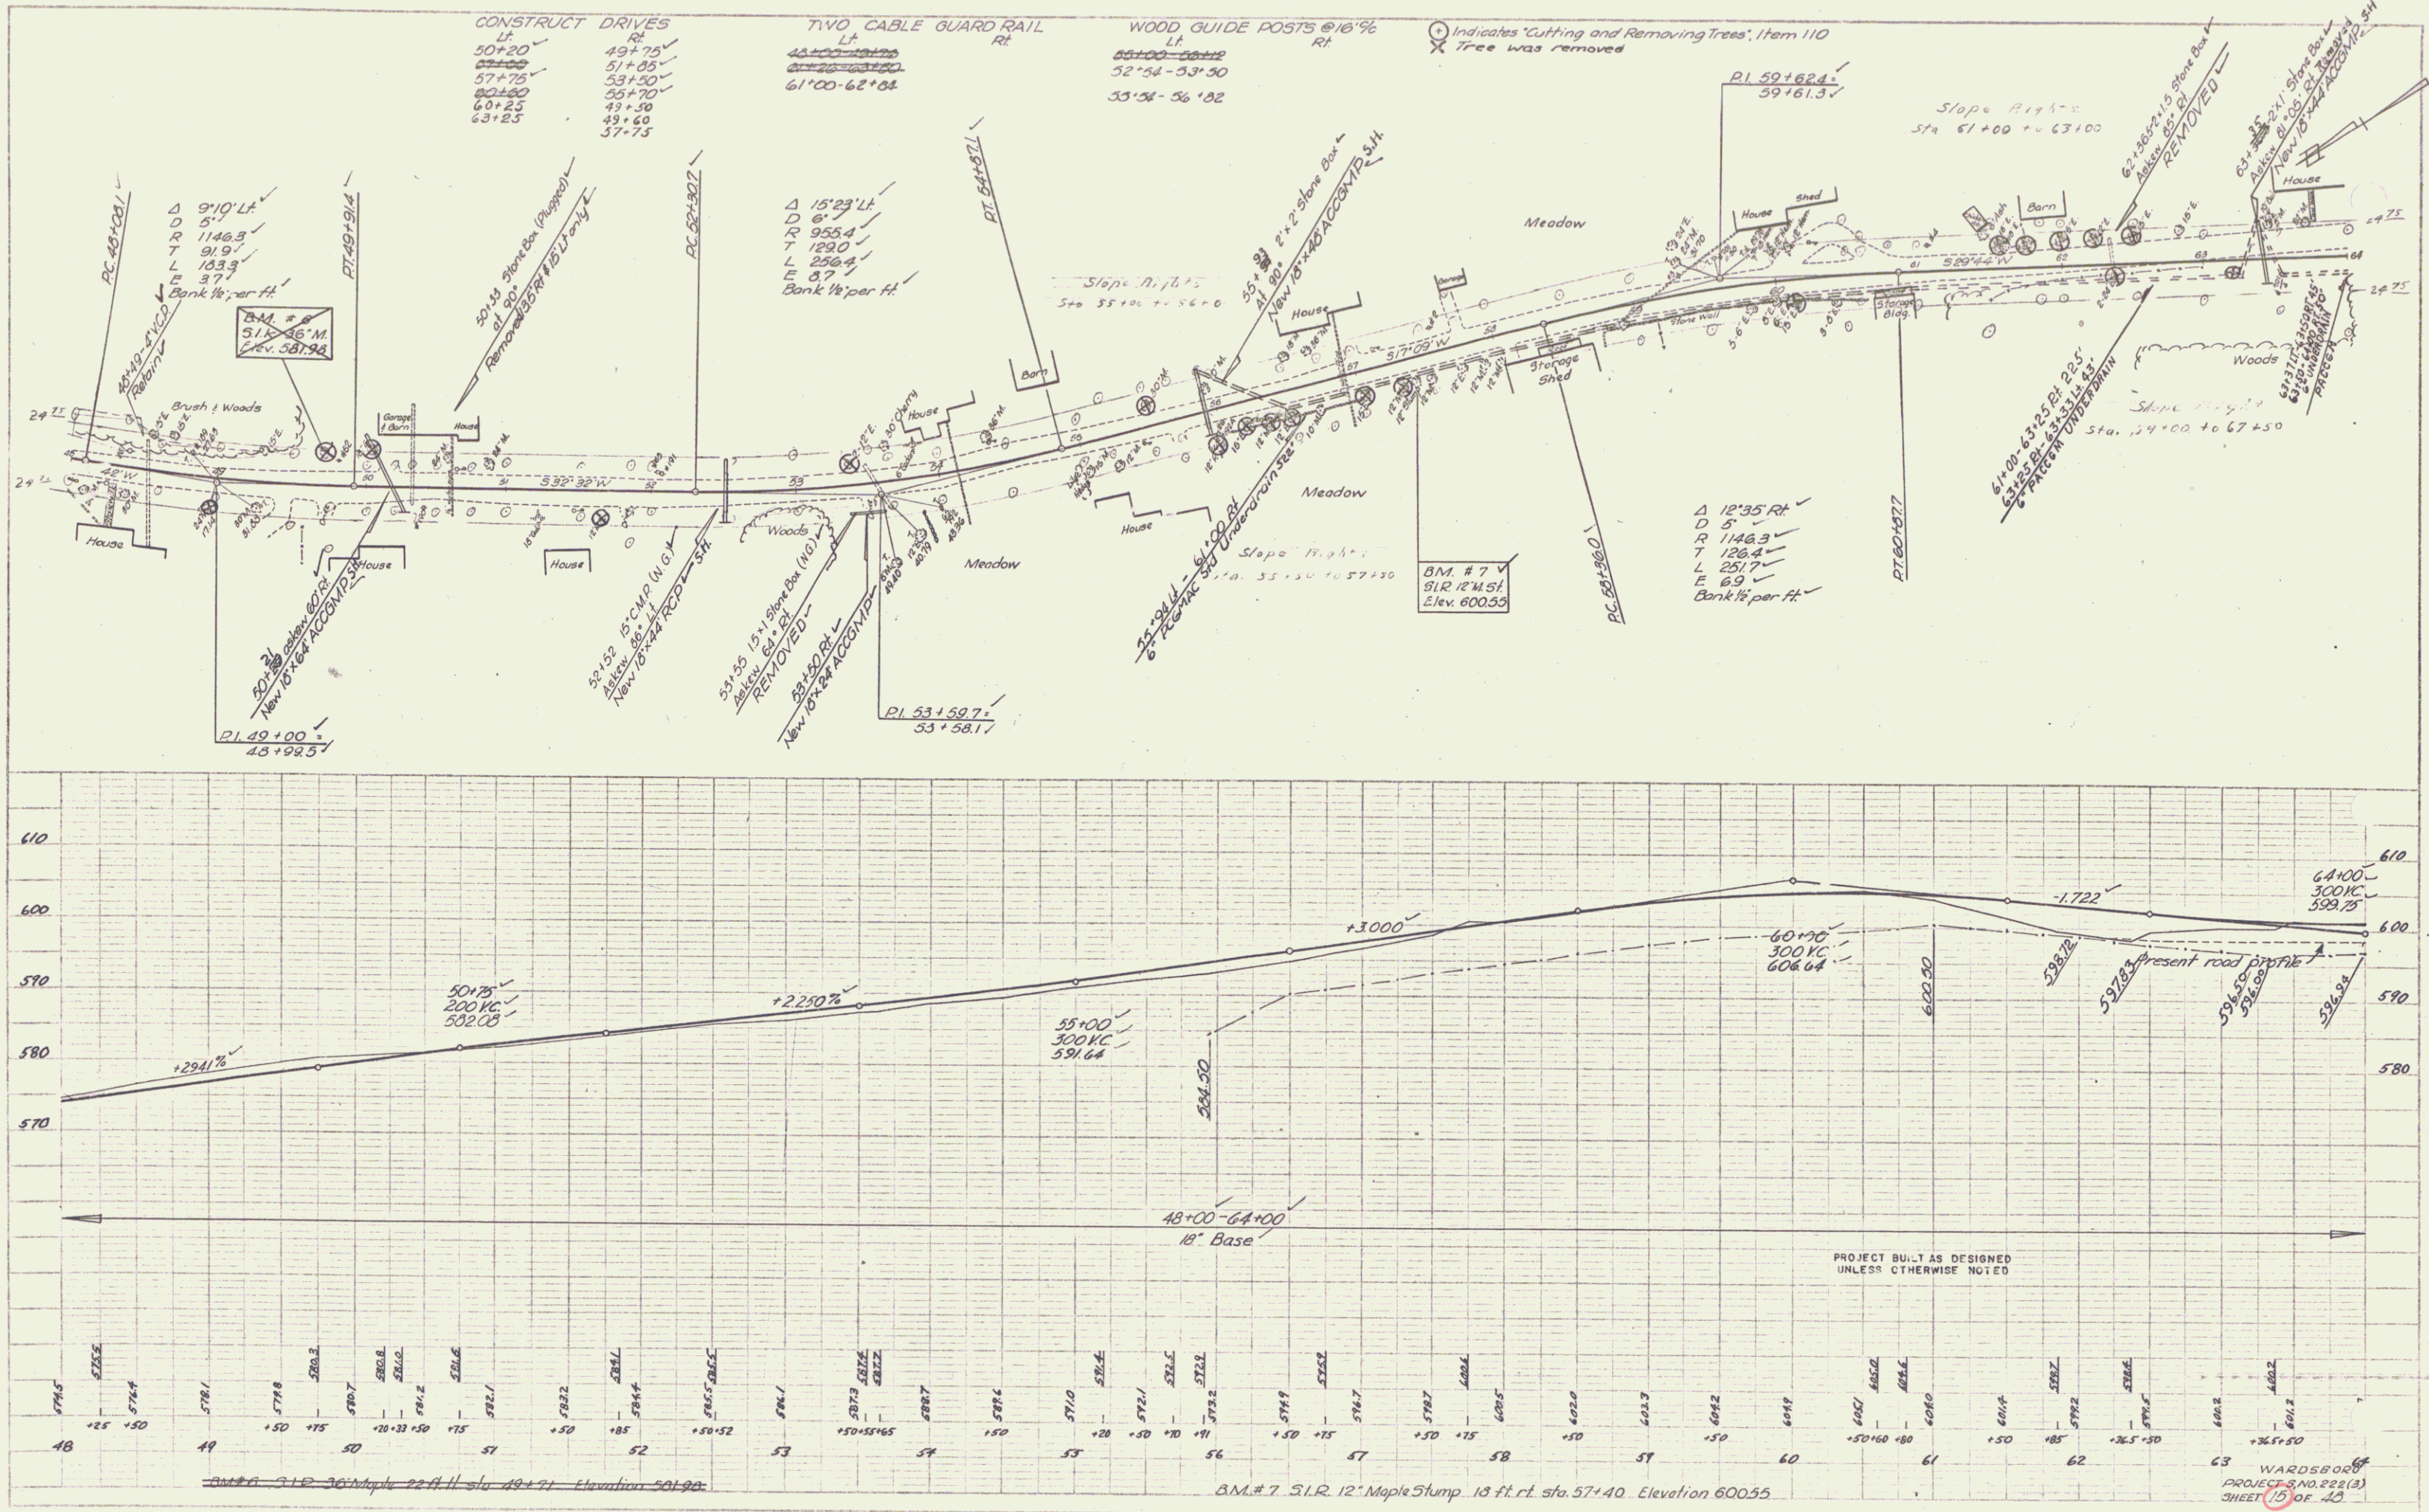


DATE	10/21/04	BY	NU
REVISION			
1	10/21/04	NU	8-35
2	10/21/04	NU	8-35

DATE	10/21/04	BY	NU
REVISION			
1	10/21/04	NU	8-35
2	10/21/04	NU	8-35

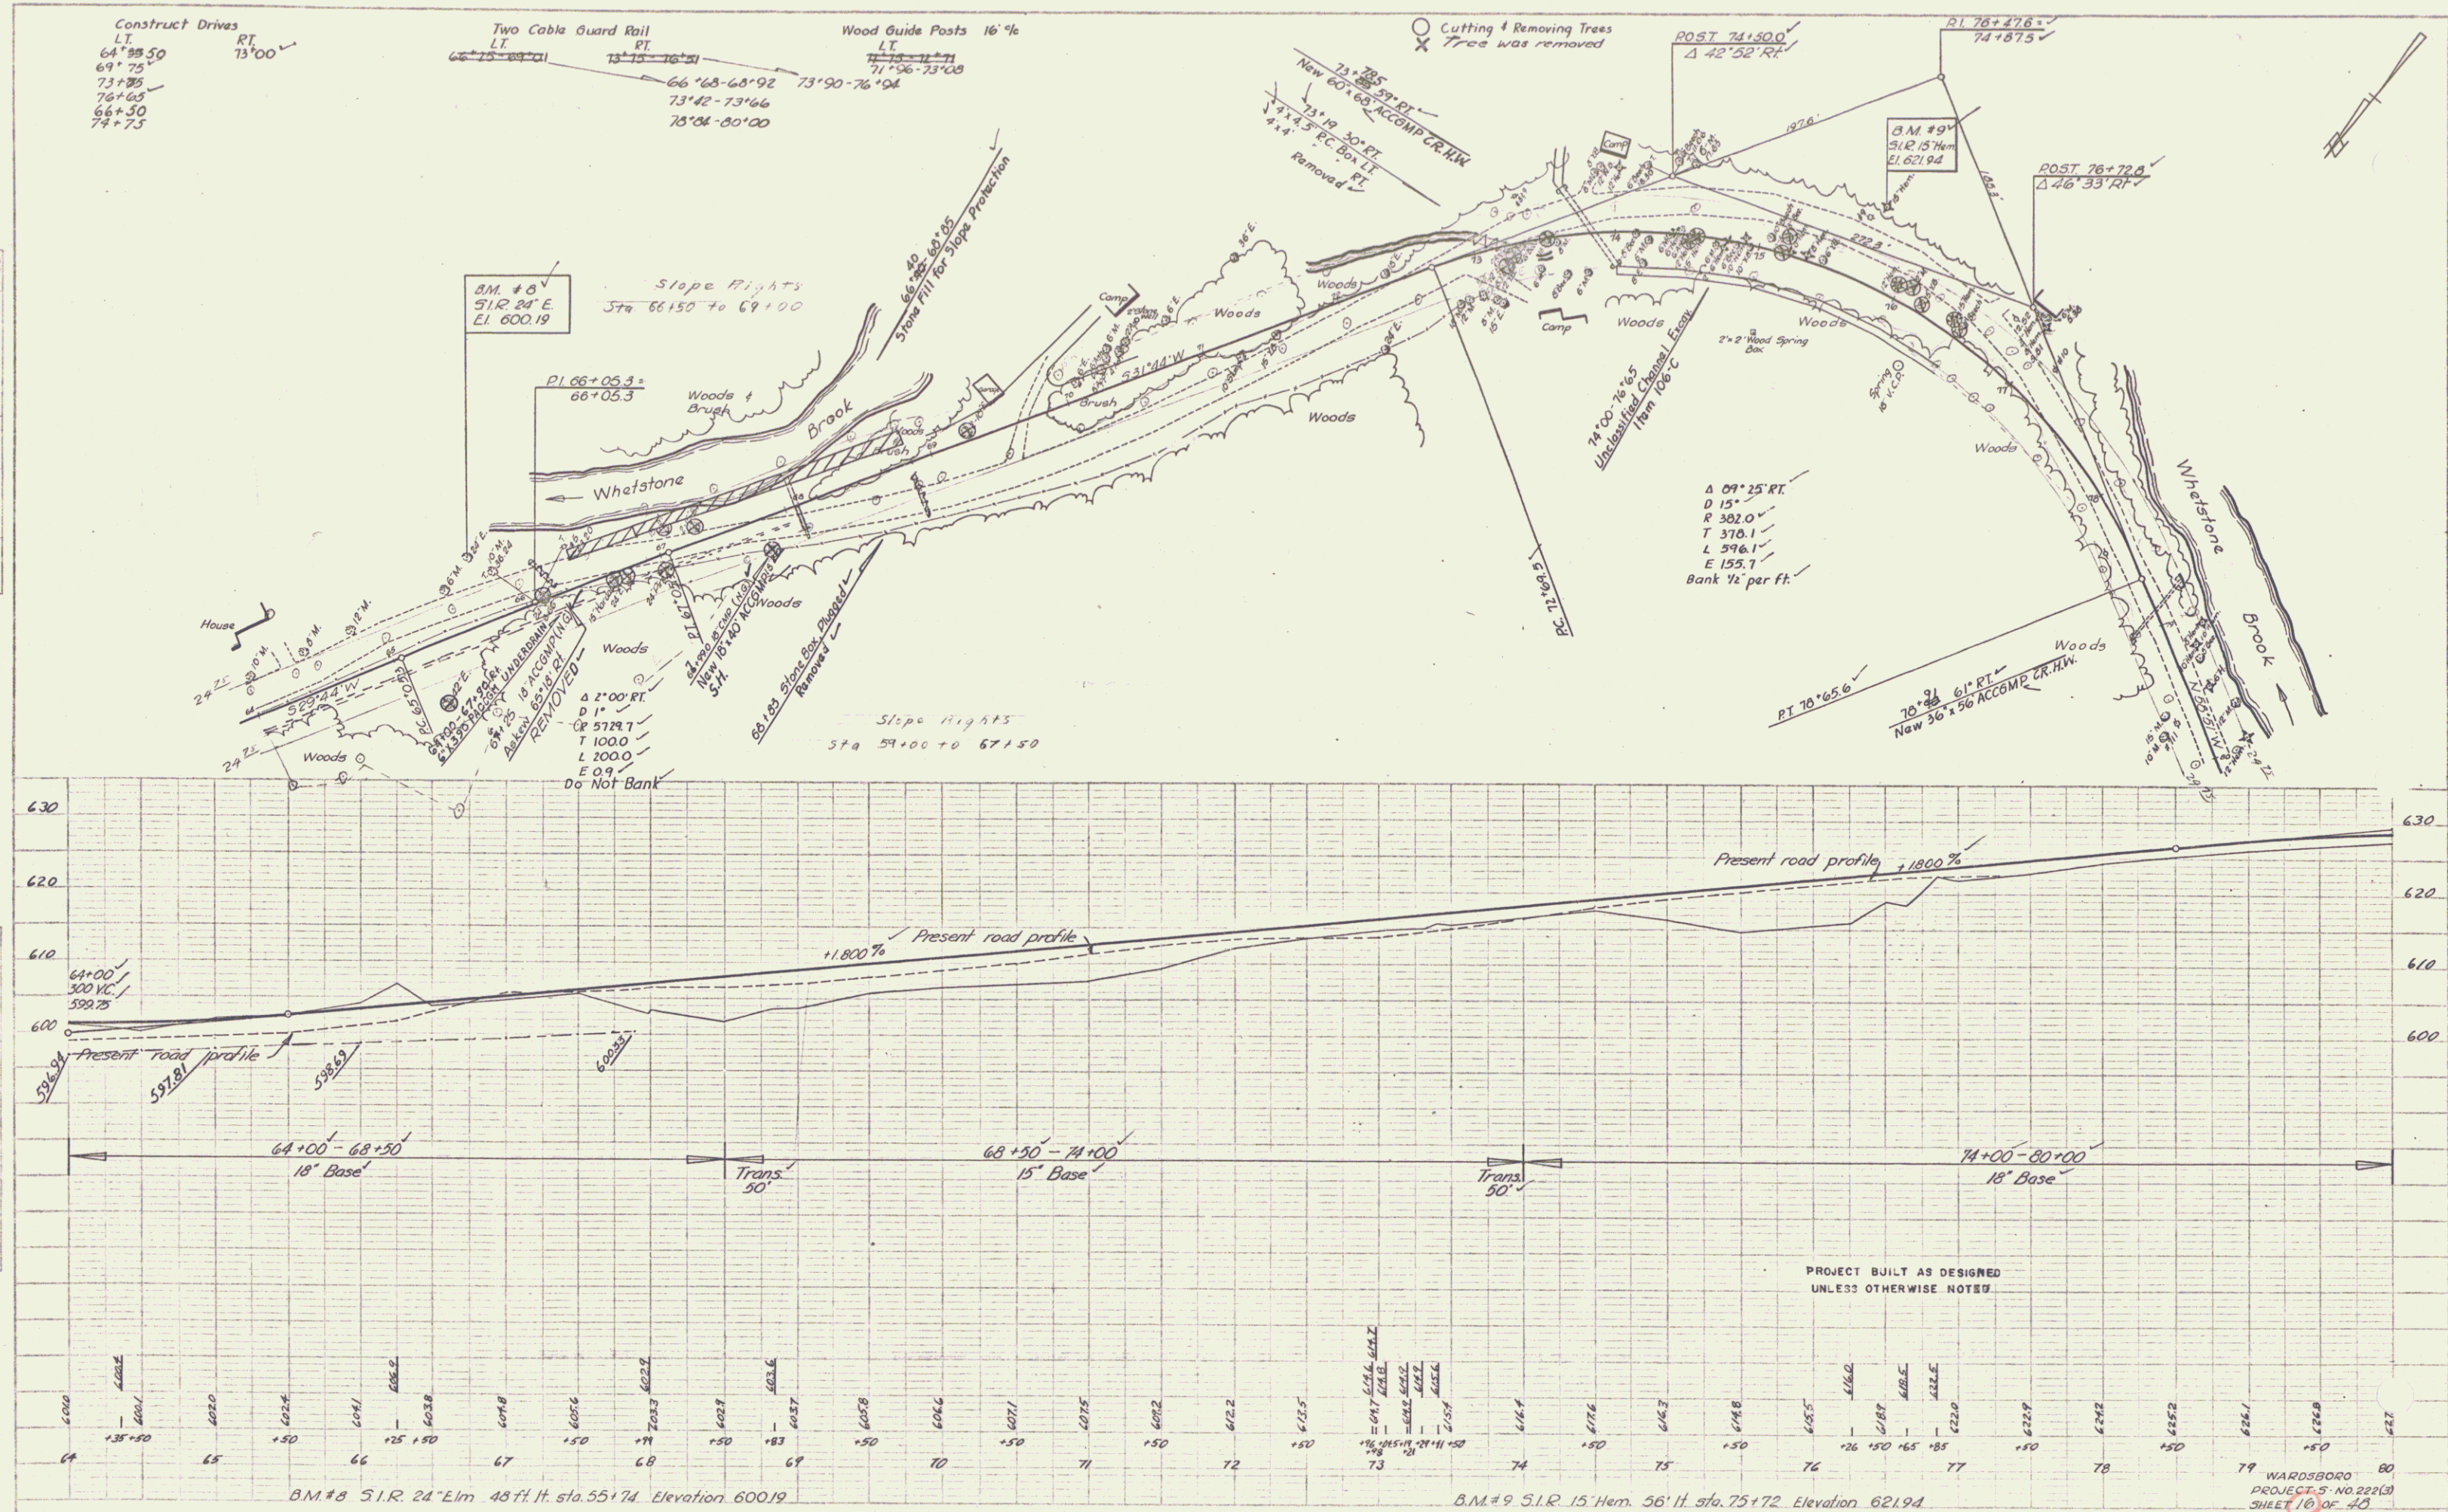



PLAN
 DATE 10/1/24
 NO. 1
 8-35

PROFILE
 DATE 10/1/24
 NO. 1
 8-35

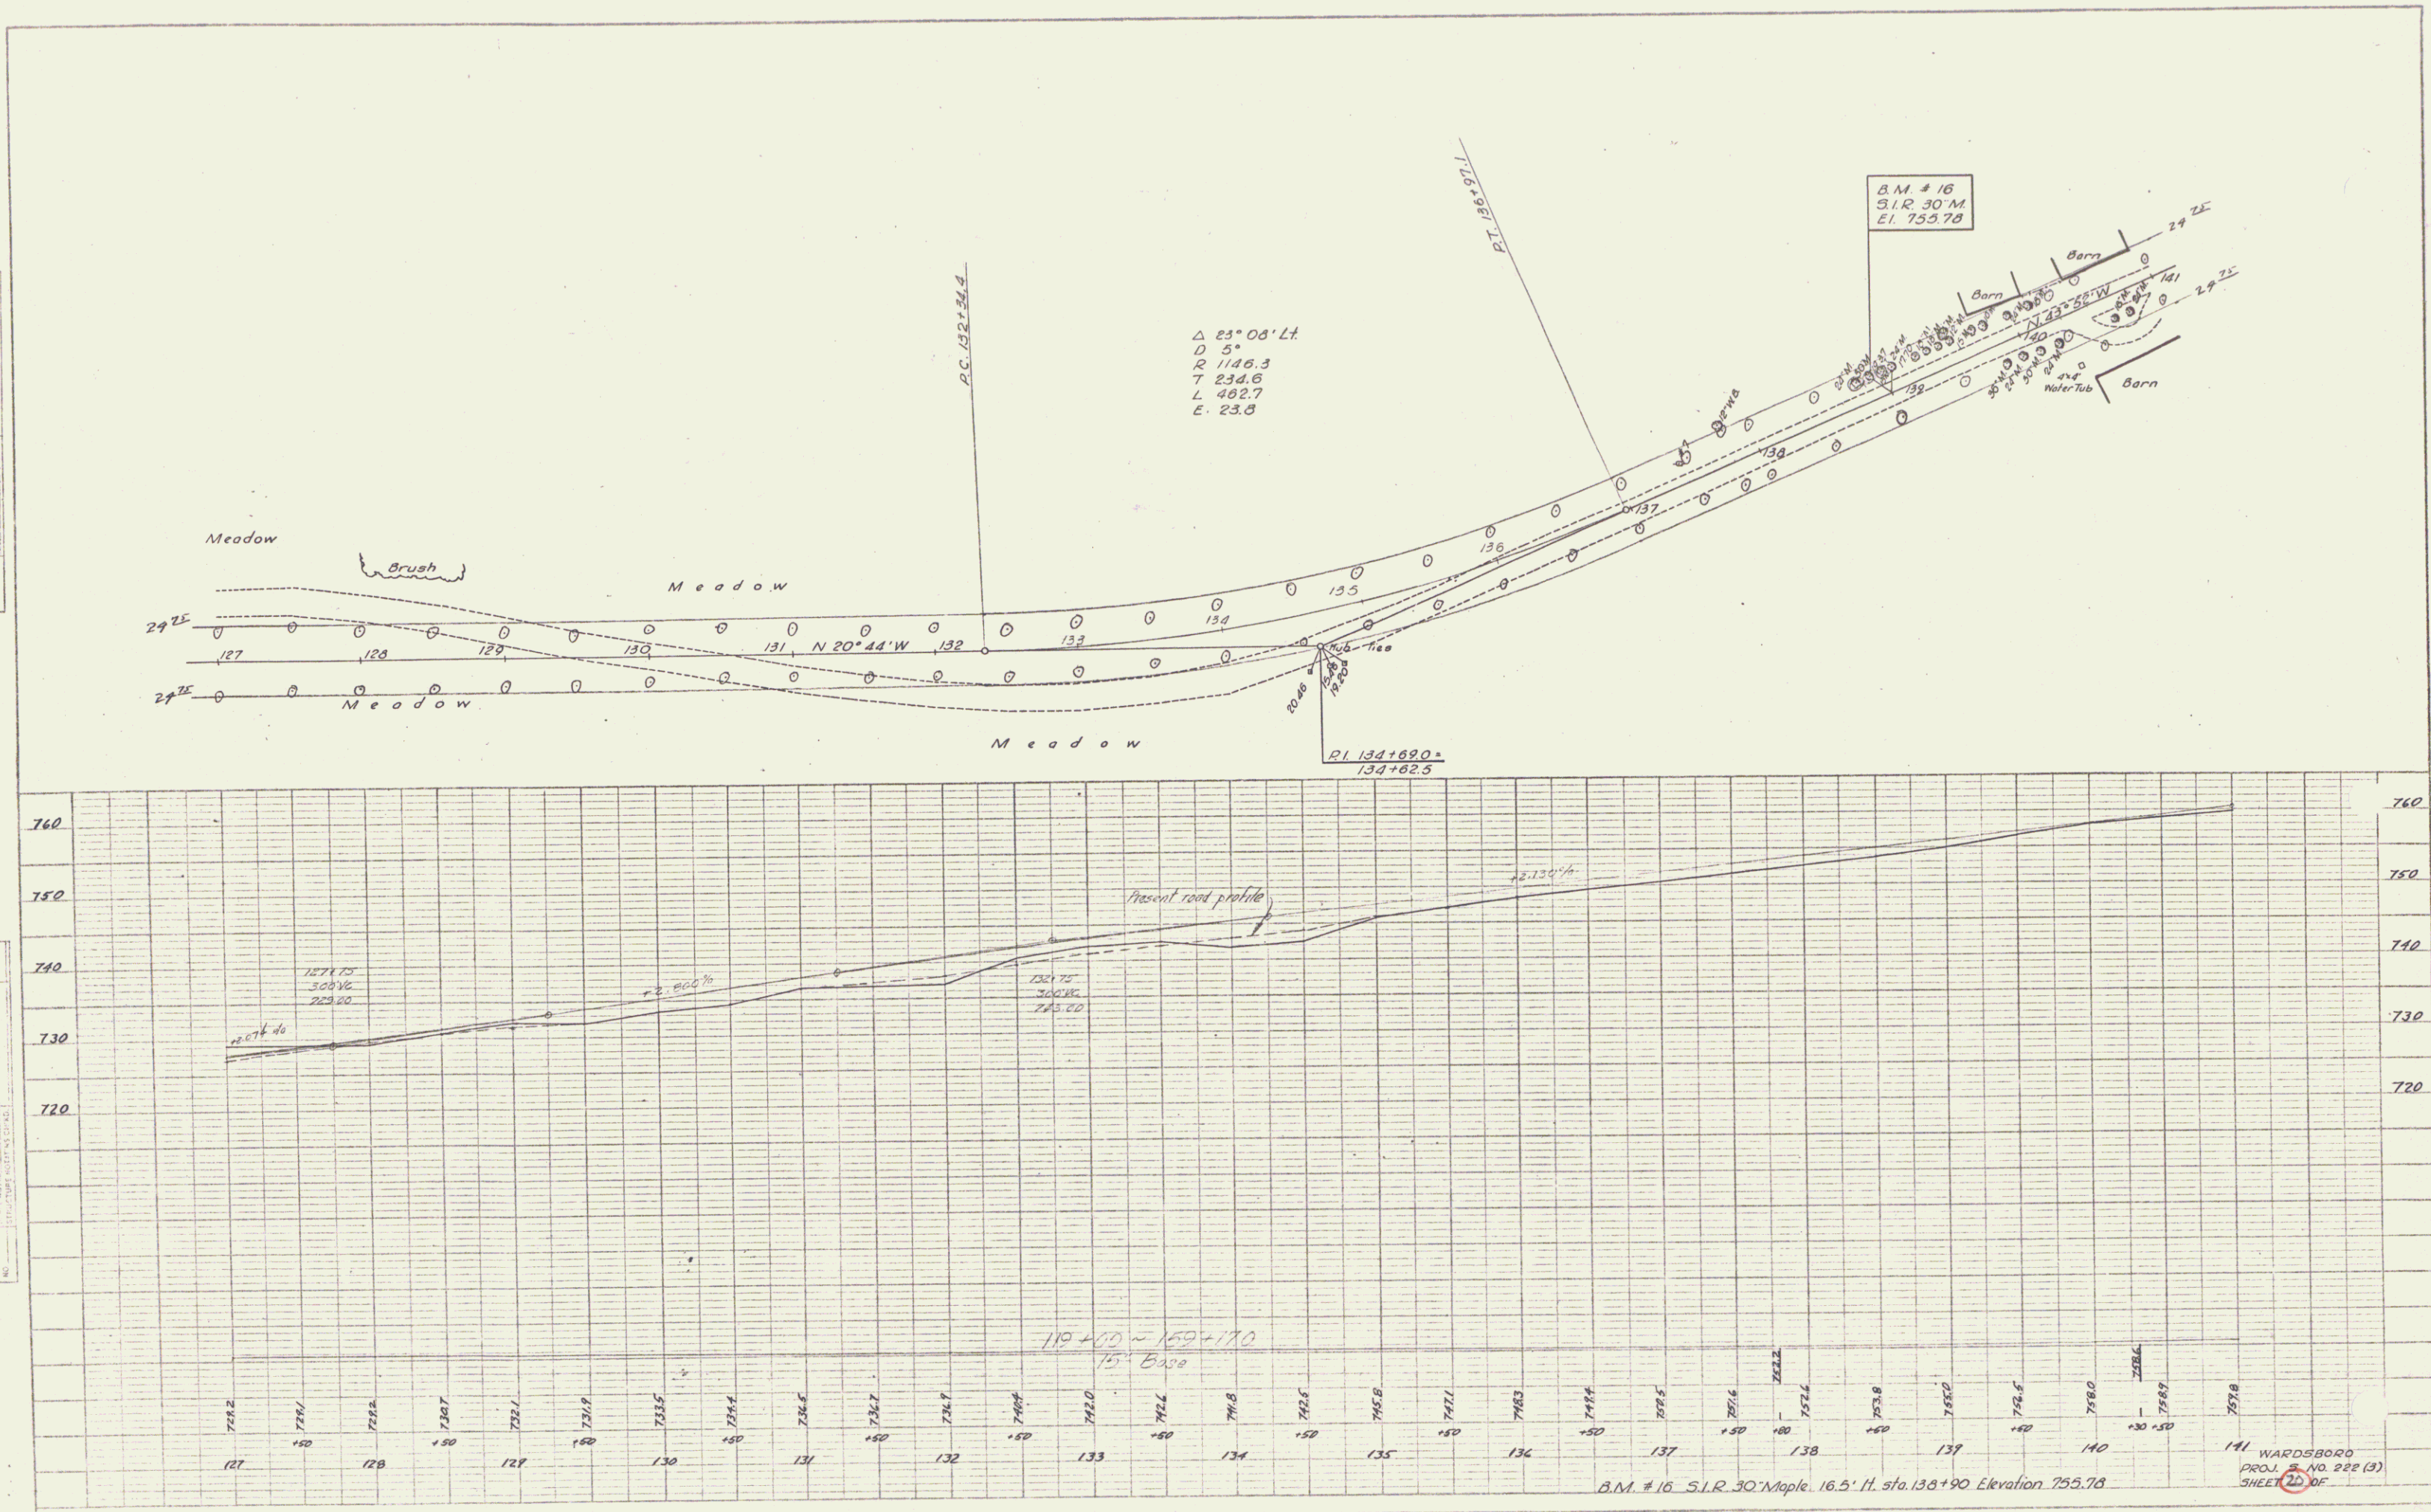

PLAN
 DATE 7-33
 8-33
 12-33
 1-34
 2-34
 3-34
 4-34
 5-34
 6-34
 7-34
 8-34
 9-34
 10-34
 11-34
 12-34
 1-35
 2-35
 3-35
 4-35
 5-35
 6-35
 7-35
 8-35
 9-35
 10-35
 11-35
 12-35

PROJ. 12-33
 1-34
 2-34
 3-34
 4-34
 5-34
 6-34
 7-34
 8-34
 9-34
 10-34
 11-34
 12-34
 1-35
 2-35
 3-35
 4-35
 5-35
 6-35
 7-35
 8-35
 9-35
 10-35
 11-35
 12-35

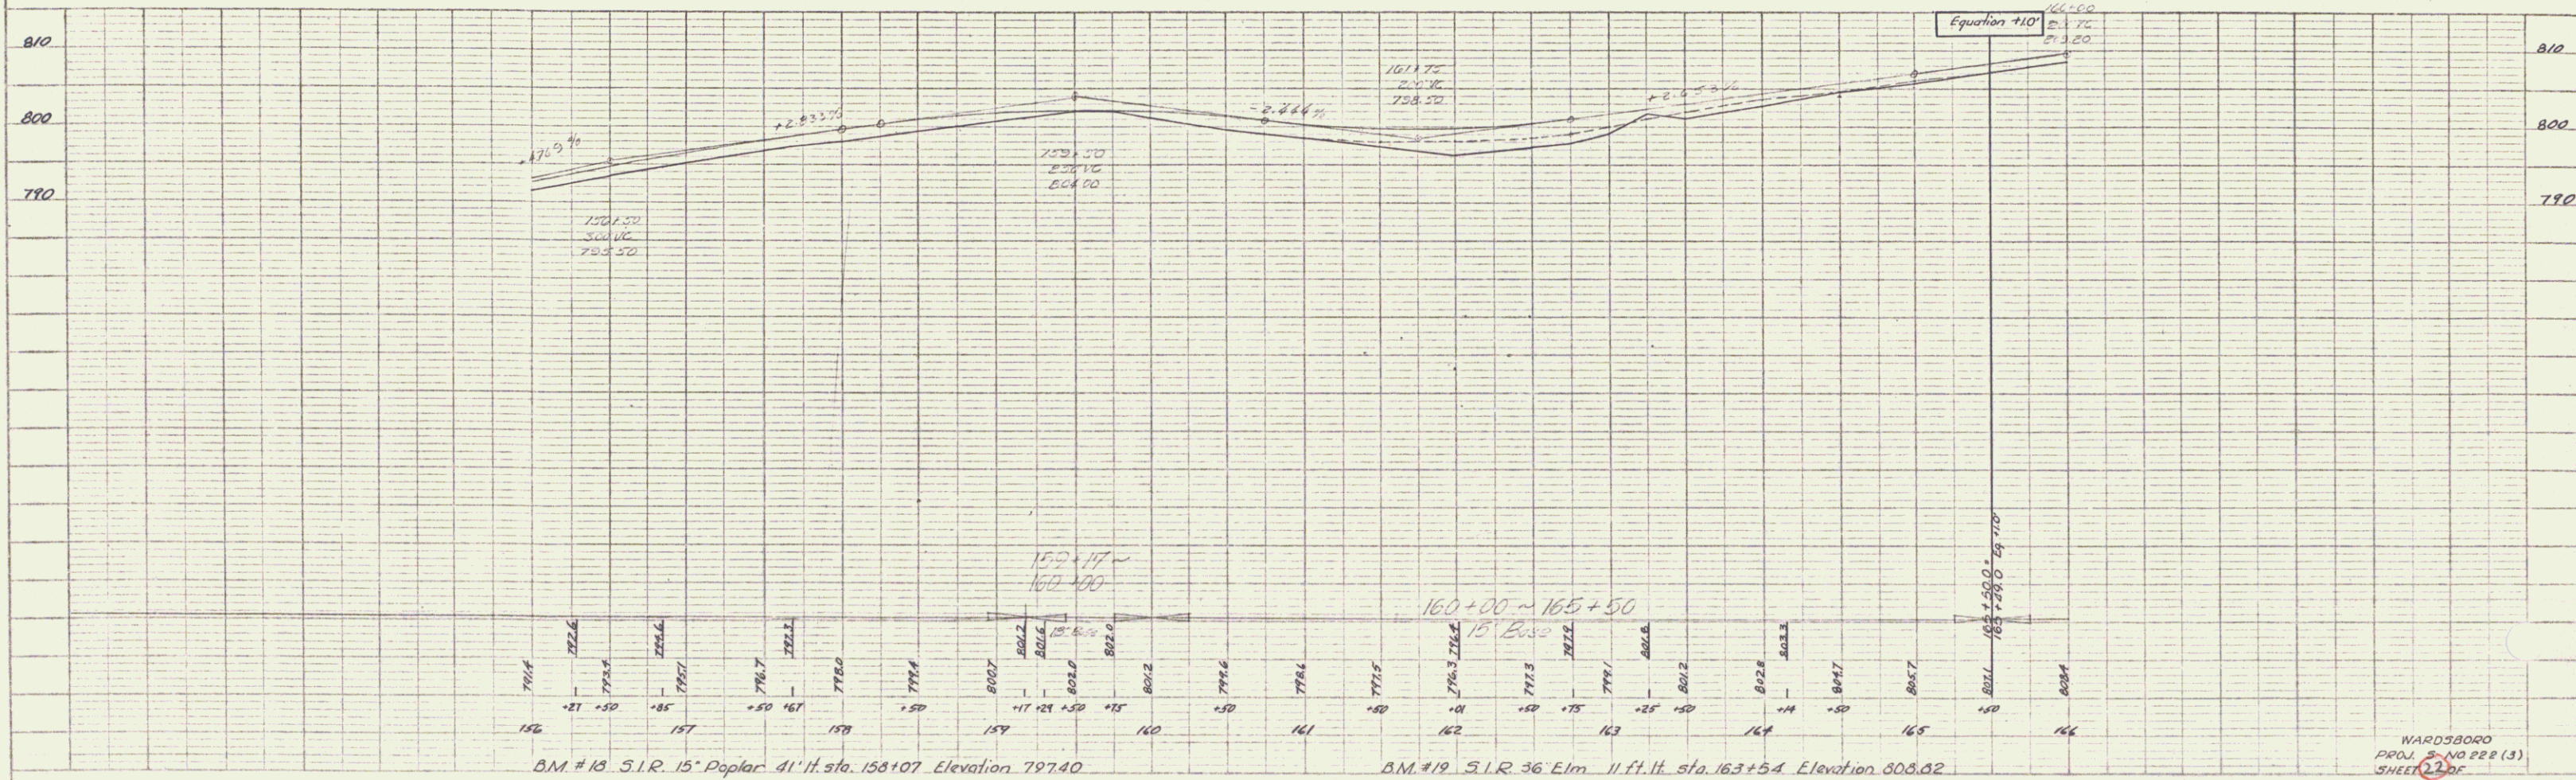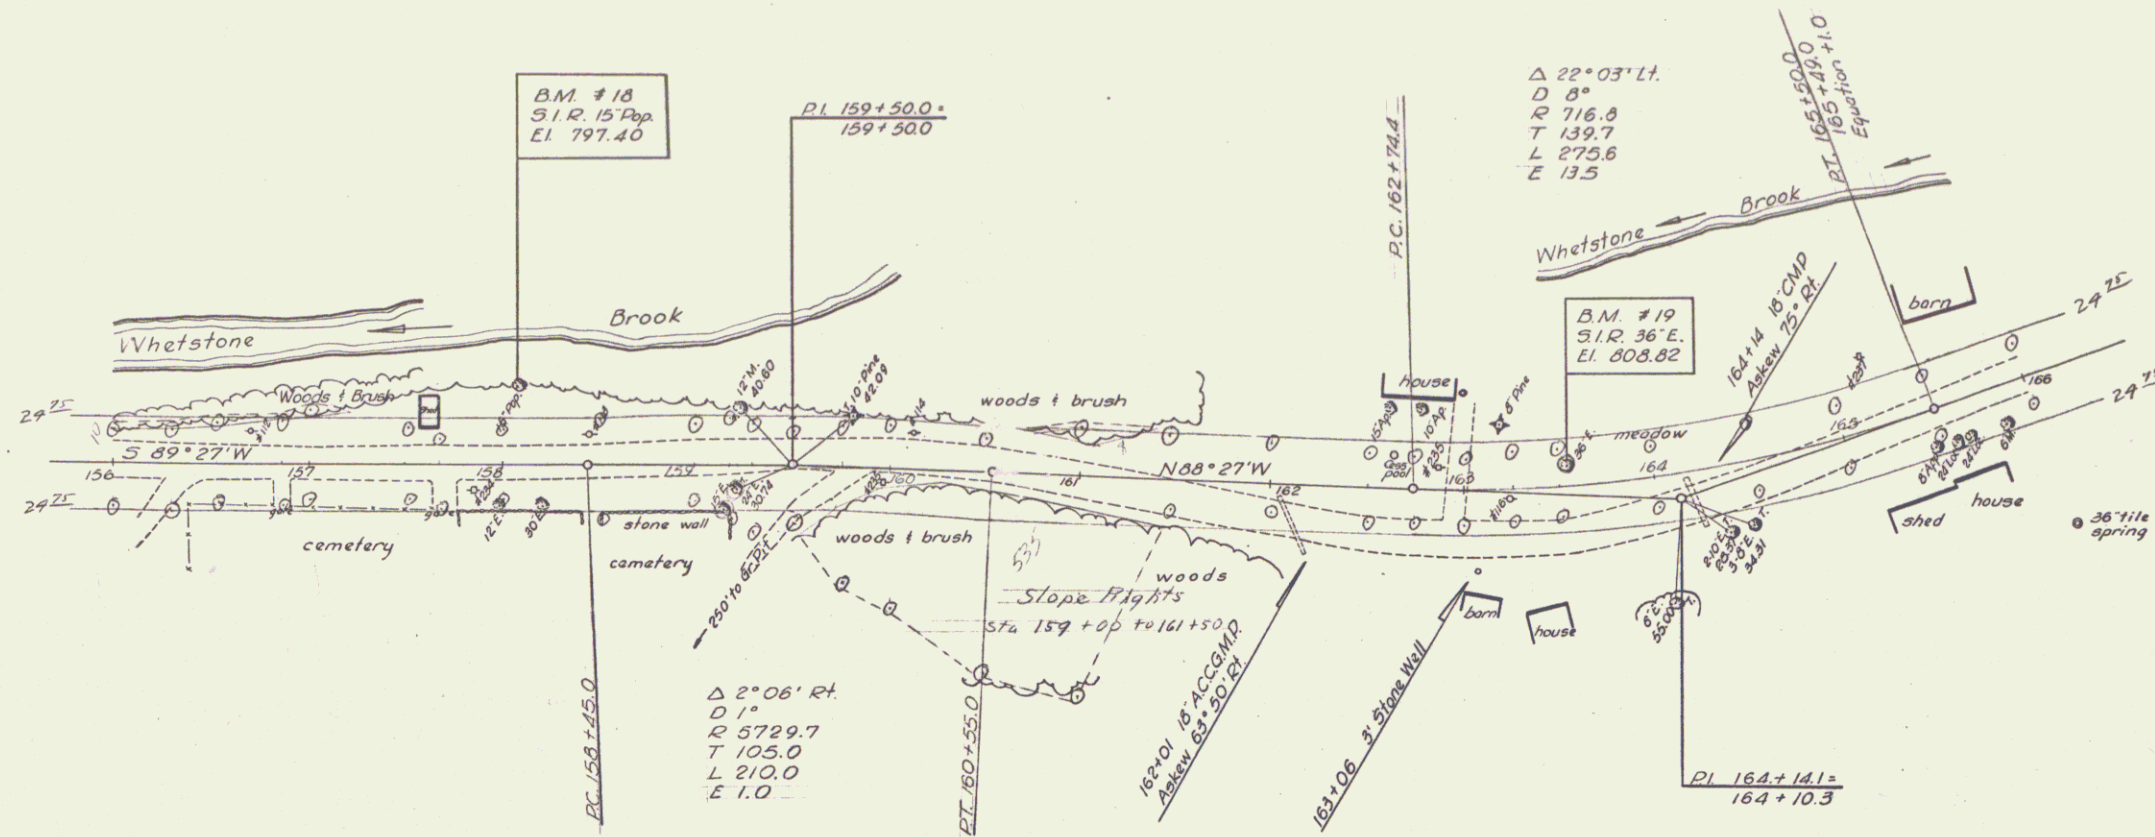

WARDSBORO
 PROJ. 12-33
 SHEET 12 OF 12

