

INDEX OF SHEETS

SHEET NO.	TITLE PAGE
1	TITLE PAGE
2-4	TYPICAL CROSS SECTION OF IMPROVEMENT (GRADING, DRAINAGE, & BASE, WITH GUARD RAIL, AND DOUBLE TACK COAT OF REFINED TAR, WITH PEA STONE SEAL, ITEM 23A)
5	BANKING AND WIDENING TABLES
6-21	PLAN AND PROFILE
22	STD. STRUCT. SHEET
23	PIPE CULVERTS
24	SCW-3 DETAILS, FOR 3X3 WINGS (SCW-4 DETAILS FOR 4X4 WINGS)
25	S-30 GUARD RAIL
26	S-30A STD. UND., BOUND. MARKERS
27	S-40 BARRICADES, SIGNS & LIGHTS
28	S-41 ROUNDING OF SLOPES
29	S.C. 2-4 DETAILS, 4'X5' R.C.B. WINGS, 4'X5' R.C.B.
30-32	EXTENSION TO SLAB BRIDGE STA. 619+25
33	CHANNEL SECTIONS "B" LINE STA. 619+16 RT.
34	TYPICAL SECTIONS (ROADSIDE IMPROVEMENT ITEMS)
35-112	CROSS SECTION SHEETS

STANDARD STRUCTURE SHEETS
 APPROVED BY THE CHIEF ENGINEER
 S-26 JULY 11, 1933
 S-30 AUGUST 15, 1934

STATE OF VERMONT
 STATE HIGHWAY DEPARTMENT

PLAN AND PROFILE OF PROPOSED
 STATE HIGHWAY


FEDERAL AID PROJECT

TOWN OF MORRISTOWN *Pin #00R701*

HARDWICK - HYDE PARK ROAD

ON ROUTE 15, BEGINNING AT THE WOLCOTT - MORRISTOWN
 TOWN LINE AND EXTENDING NORTHWESTERLY 3.546 MILES
 LENGTH OF F.A. PROJECT 117A (1) 18,723.5 FT. = 3.546 MILES

LENGTH OF STATE ROUTE 100 336.0 FT. = 0.063 MILES
 TOTAL LENGTH OF PROJECT 19,059.5 FT. = 3.609 MILES

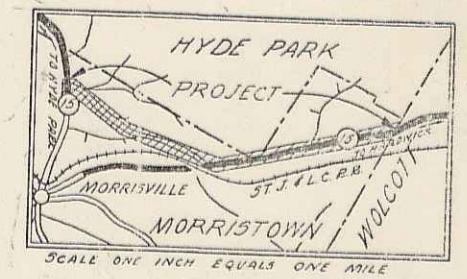


(To Be Returned To R.O.W. Division)
 Town of Morrillville
 Right-of-Way Division

RECORD PLANS
 By G.A. Pierce

*Project No. FAP 117A(1)
 Rte. VT 15*


CONVENTIONAL SIGNS

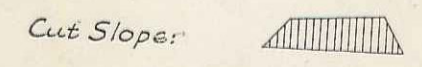

- COUNTY LINE
- TOWN LINE
- STONE WALL
- UNFENCED PROPERTY
- GUARD RAIL
- TRAVELED WAY
- RAILROAD
- RETAINING WALL
- CENTER LINE
- SURVEY LINE
- CULVERT
- TROLLEY POLE
- POWER POLE
- TELEPHONE POLE
- TREES
- HEDGE

- GROUND ELEVATION
- DATUM
- GRADE ELEVATION
- DATUM
- CURVE DATA
- DEFLECTION ANGLE
- DEGREE OF CURVE
- RADIUS OF CURVE
- TANGENT DISTANCE
- LENGTH OF CURVE
- EXTERNAL DISTANCE
- POINT OF INTERSECTION
- POINT OF CURVE
- POINT OF TANGENT
- POINT ON TANGENT

- TITLE
- TYPICAL
- PLAN
- PROFILE
- CROSS SECTIONS
- SCALE
- 1" = 1000'
- 1" = 2'
- 1" = 50'
- 1" = 50'
- 1" = 10'
- 1" = 5'

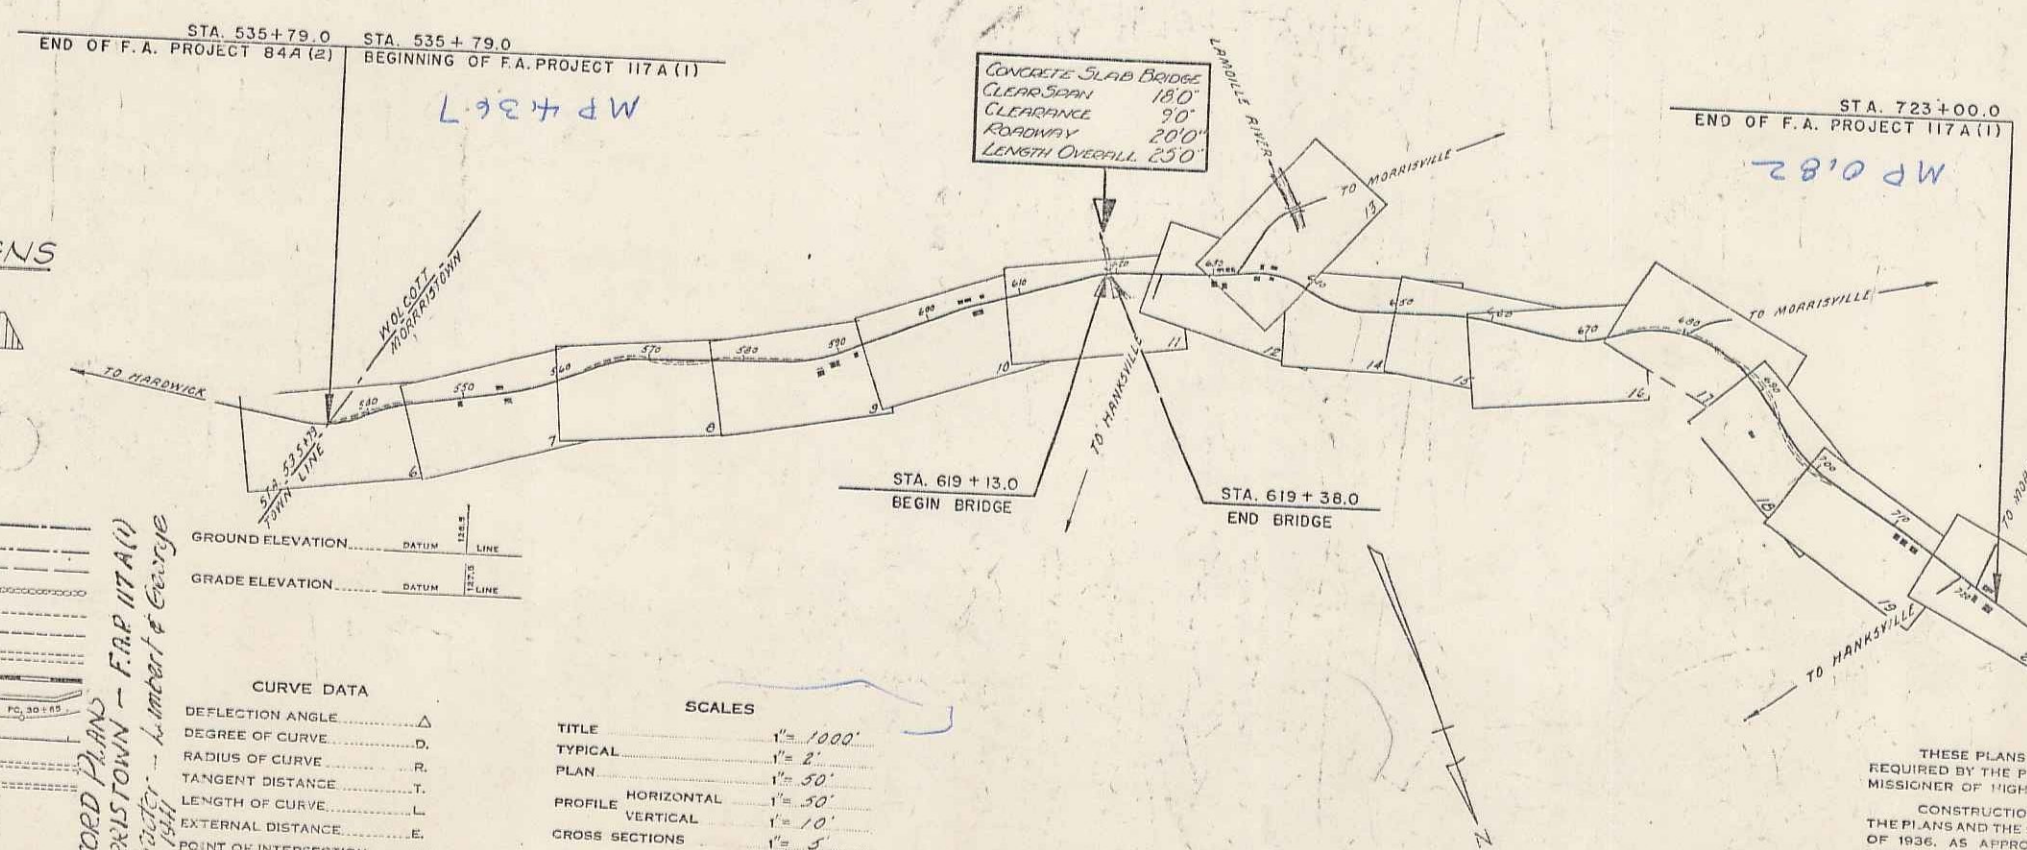


APPROVED: *H. E. Sargent*
 COMMISSIONER OF HIGHWAYS
 SUBMITTED BY ORDER OF THE STATE HIGHWAY BOARD

RECOMMENDED FOR APPROVAL
 DISTRICT ENGINEER
 PUBLIC ROADS ADMINISTRATION
 FEDERAL WORKS AGENCY

THESE PLANS ARE SUBJECT TO SUCH REVISIONS AS MAY BE
 REQUIRED BY THE PUBLIC ROADS ADMINISTRATION OR THE COM-
 MISSIONER OF HIGHWAYS
 CONSTRUCTION IS TO BE CARRIED ON IN ACCORDANCE WITH
 THE PLANS AND THE STANDARD ROAD AND BRIDGE SPECIFICATIONS
 OF 1936, AS APPROVED DECEMBER 29TH, 1936, BY THE PUBLIC
 ROADS ADMINISTRATION, INCLUDING ALL SUBSEQUENT APPROVED
 REVISIONS AND SUCH REVISED SPECIFICATIONS AND SPECIAL
 PROVISIONS AS ARE SUBMITTED WITH THE PLANS

APPROVED: *G. A. Pierce* ROAD ENGINEER
 APPROVED: *H. E. Sargent* DISTRICT HIGHWAY COMMISSIONER
 SERIES FAP No. 117A(1) FILED
 SHEET 1 OF 118


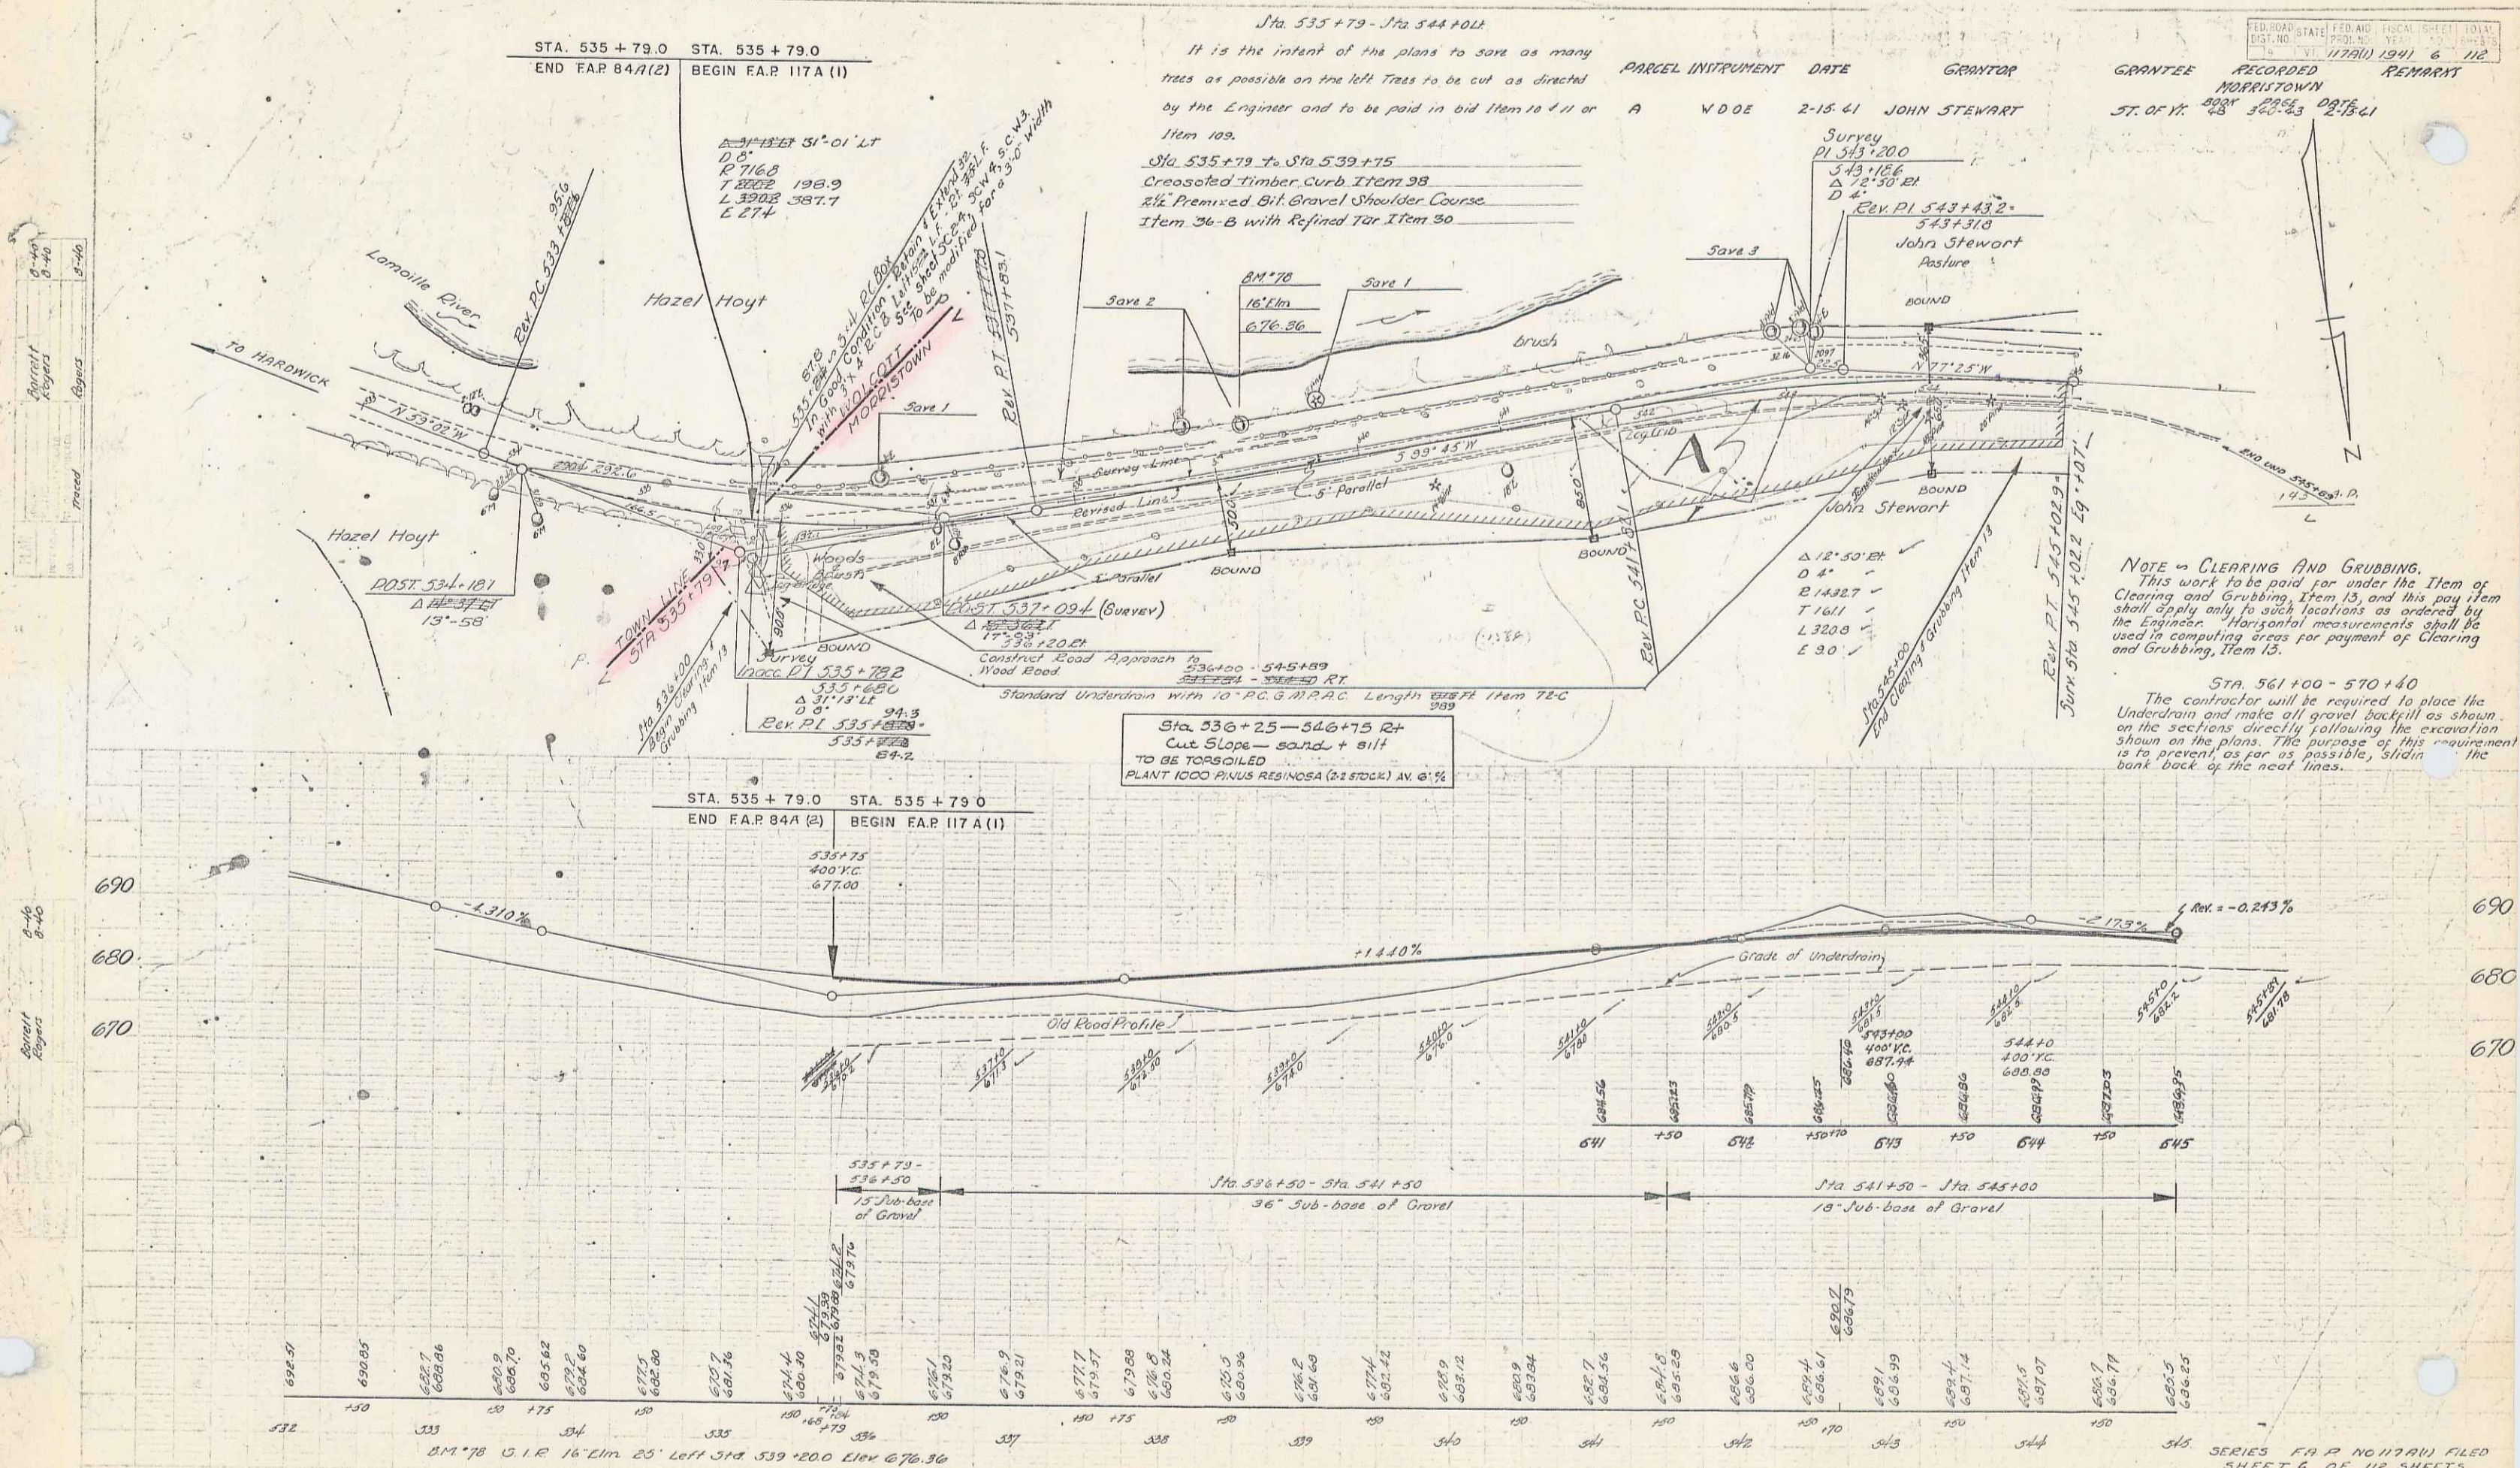


SERIES FAP NO 117A(1) FILED
SHEET 6 OF 112 SHEETS

PARCEL INSTRUMENT DATE GRANTOR GRANTEE RECORDED REMARKS
 B.C. WDOE 27-41 JOHN STEWART ST. OF V. MORRISTOWN
 BOOK PAGE DATE
 28 340 23 213-41

Δ 12° 40' LF
 D 2'
 E 2064.9
 T 3180
 L 633.3
 E 176

STATE OF NEW JERSEY
 DEPT. OF TRANSPORTATION
 DIVISION OF HIGHWAYS
 PROJECT NO. 117-111-194
 SHEET 7 OF 112

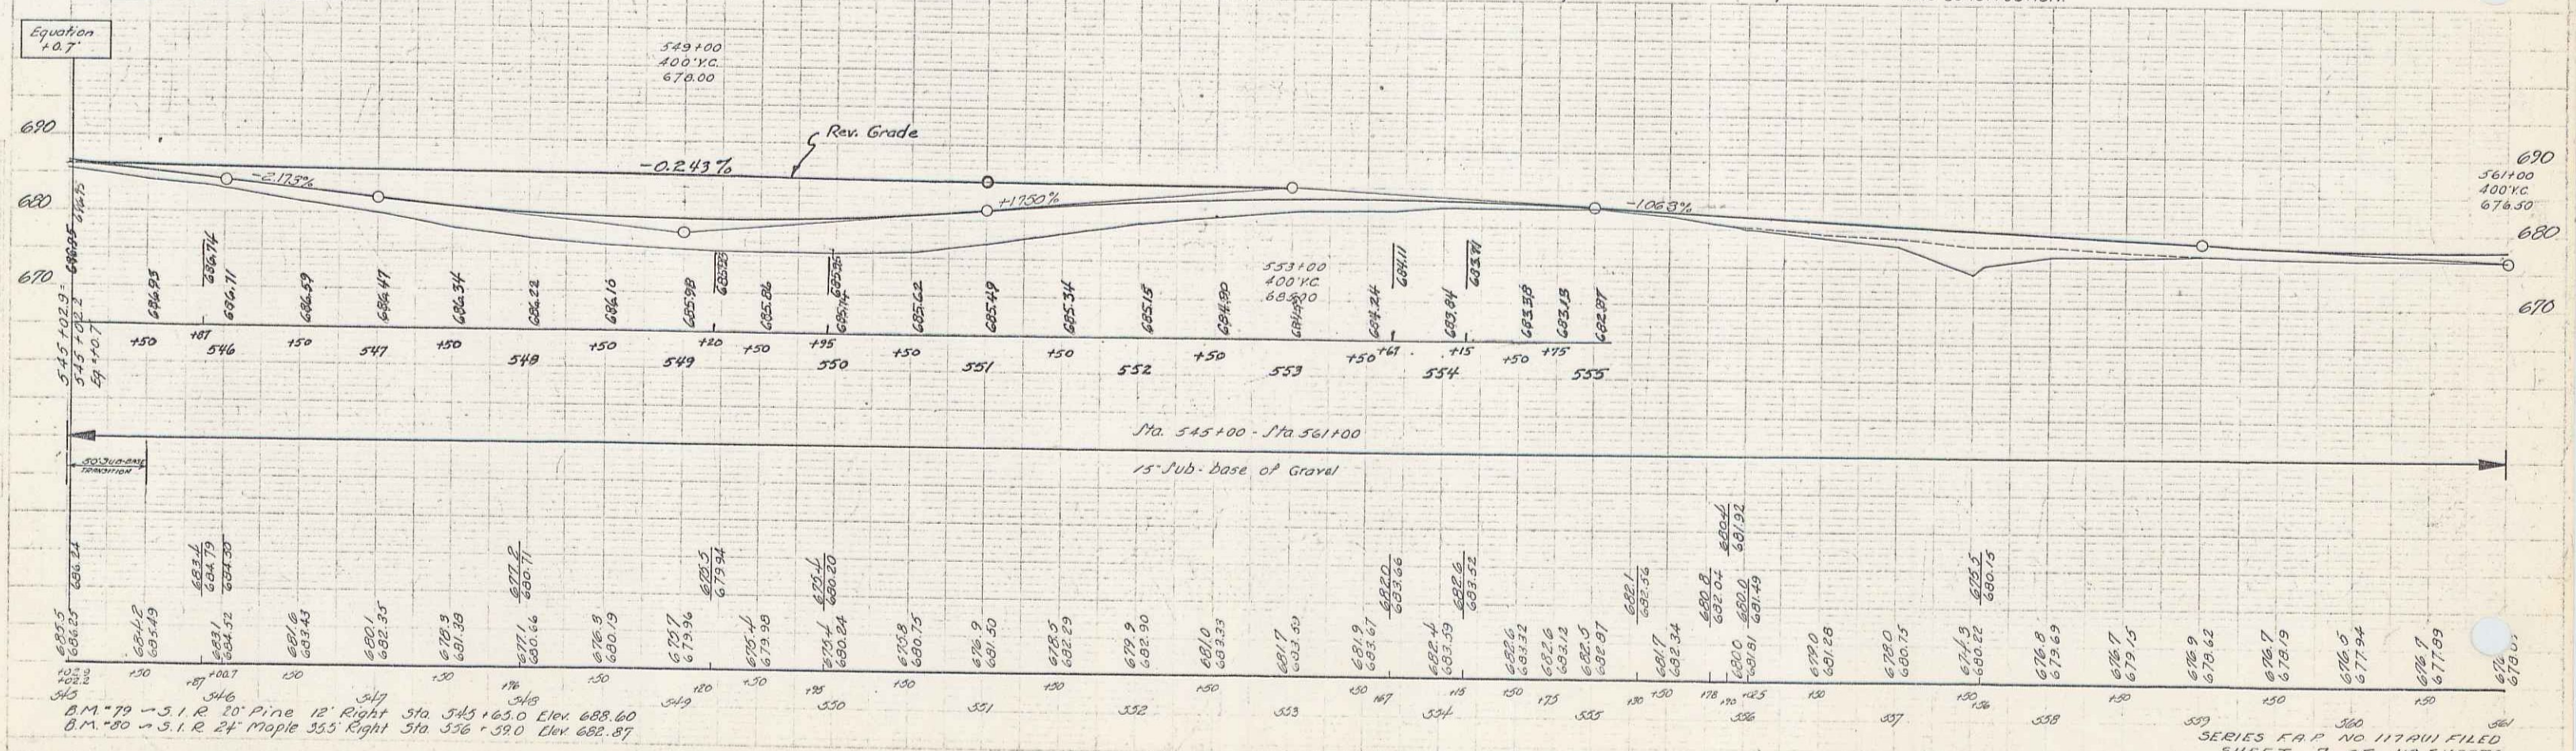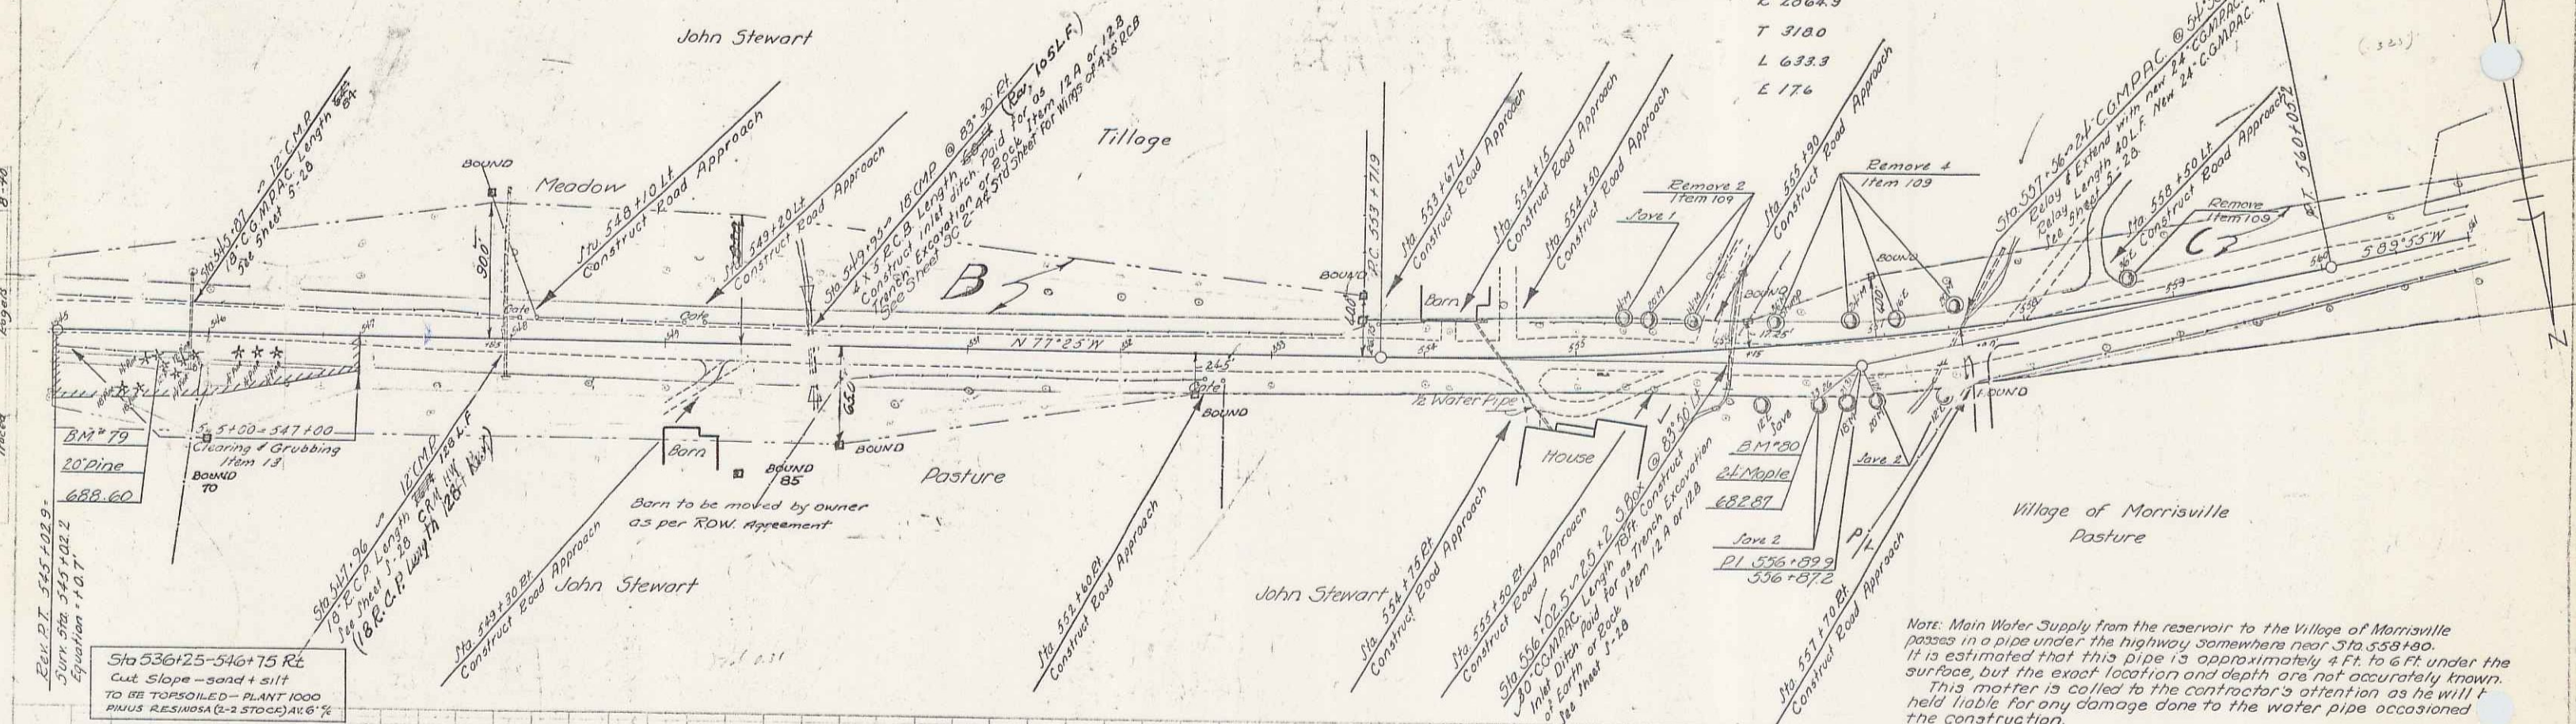



Note: Main Water Supply from the reservoir to the Village of Morrisville passes in a pipe under the highway somewhere near Sta 558+00. It is estimated that this pipe is approximately 4 ft. to 6 ft. under the surface, but the exact location and depth are not accurately known. This matter is called to the contractor's attention as he will be held liable for any damage done to the water pipe occasioned the construction.

SERIES F.A.P. NO. 117-111-194
 SHEET 7 OF 112 SHEETS



PARCEL	INSTRUMENT	DATE	GRANTOR	GRANTEE	RECORDED	REMARKS
D	W.D.O.E.	2-7-41	JOHN STEWART	ST. OF VT.	BOOK 560-43	2-15-41
A	W.D.	11-26-40	VILLAGE OF MORRISVILLE	ST. OF VT.	215	1-30-41
A, B	W.D.O.E.	1-27-41	LEO R. & LENA A. EDSON	ST. OF VT.	284-5	1-30-41

STA 567+00LT - STA 569+50
Shoulder on left widened See Cross Sections
Sheets 48 of 112 Sheets.

ED. ROAD	DATE	FILE NO.	TOTAL SHEET	TOTAL
9	VI	115-201	1141	112

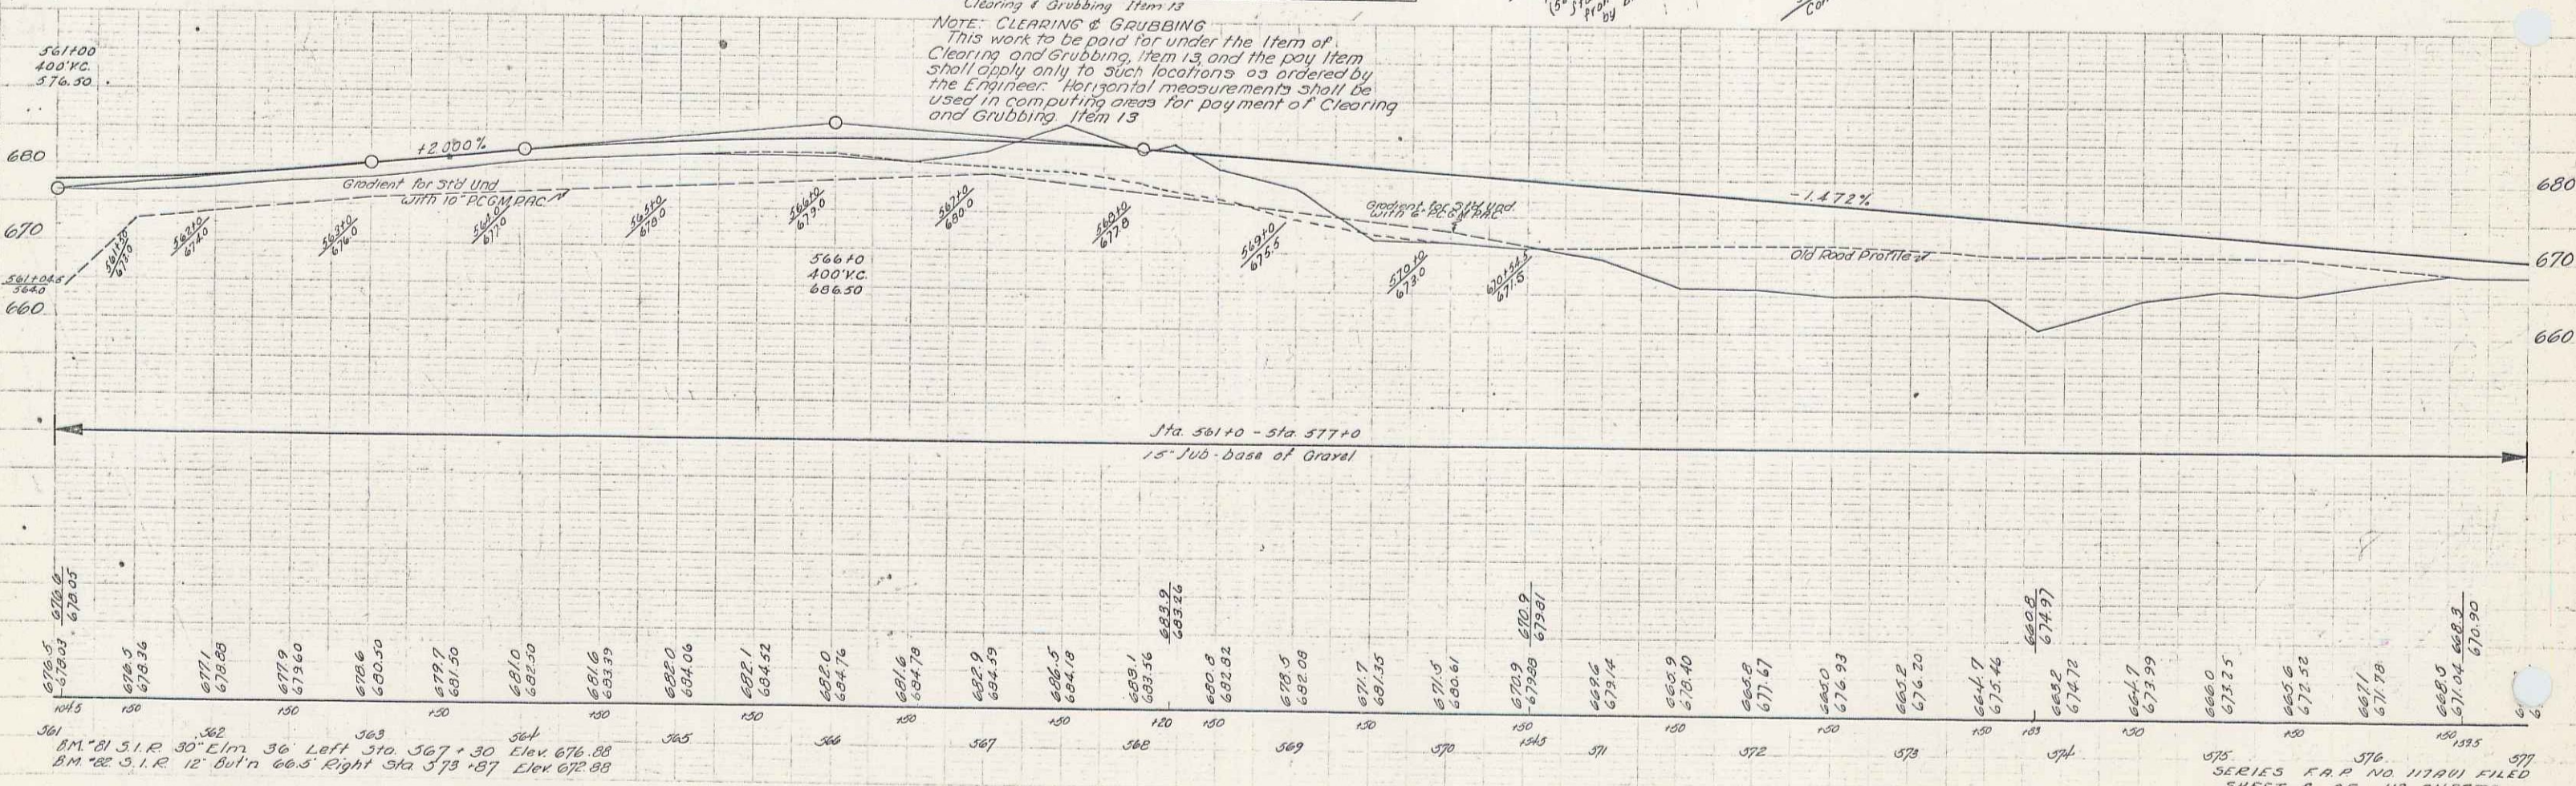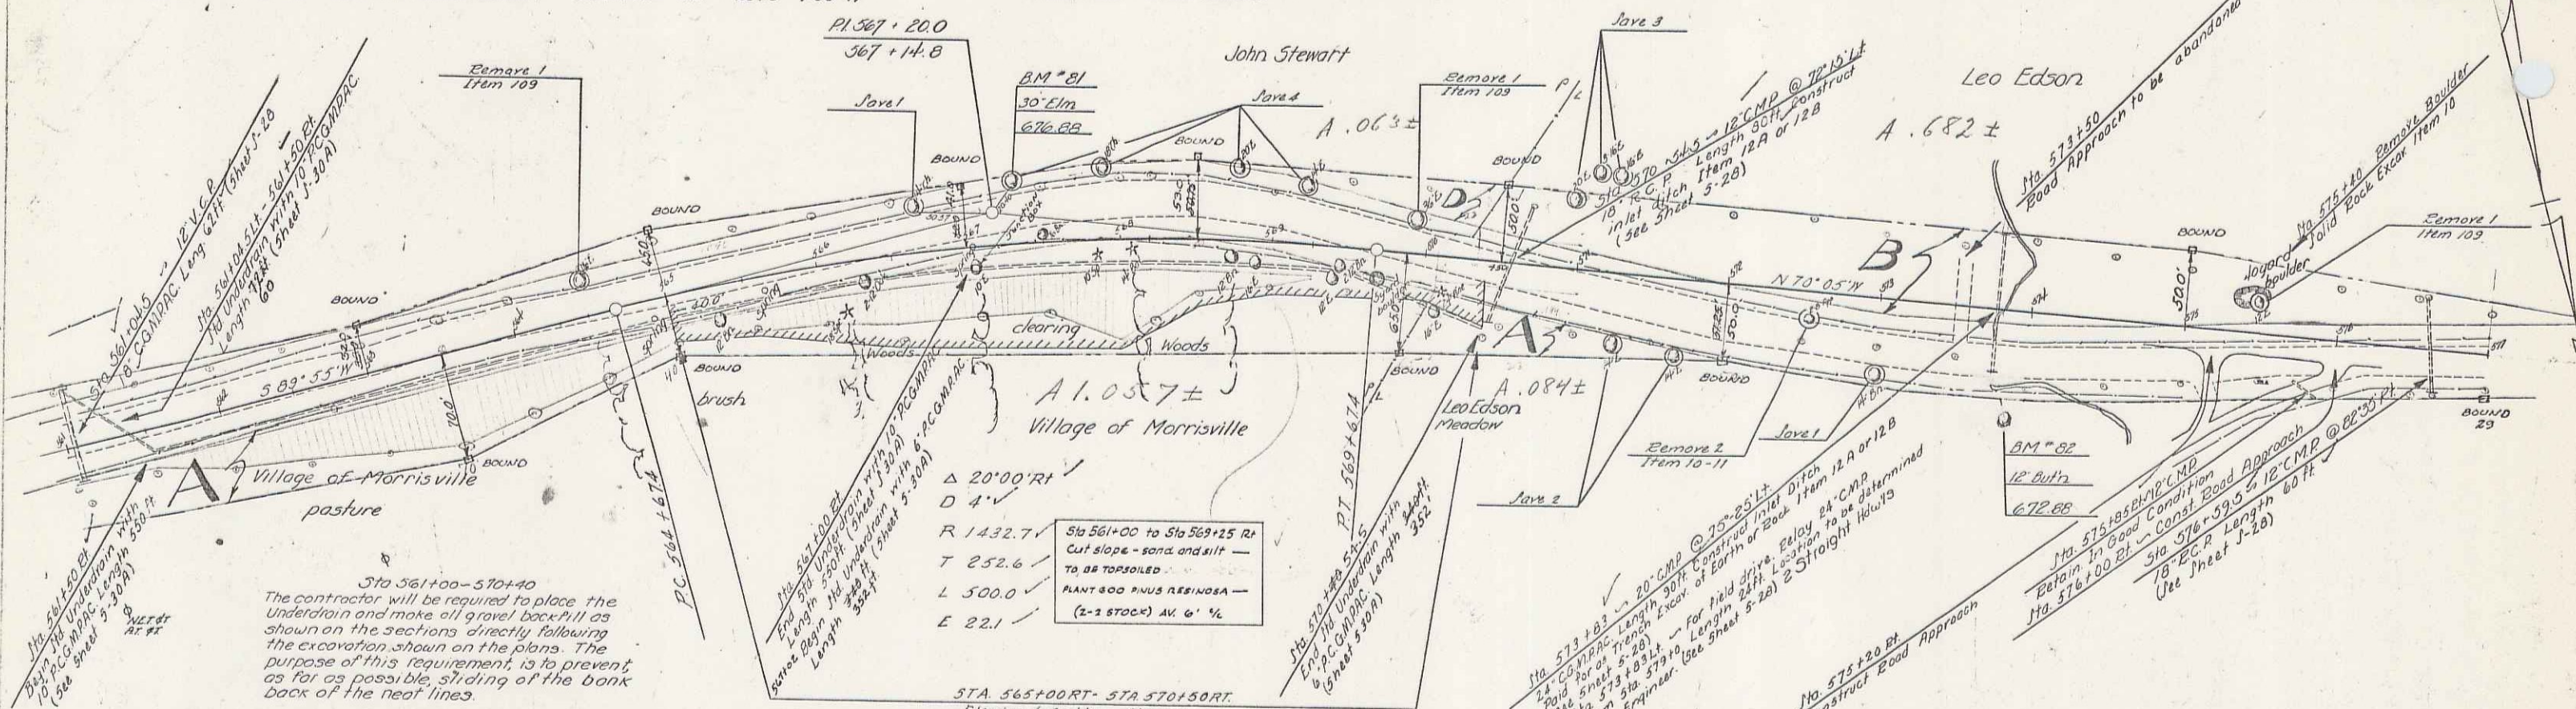


SERIES R.A. NO. 117201 FILED
SHEET 8 OF 112 SHEETS

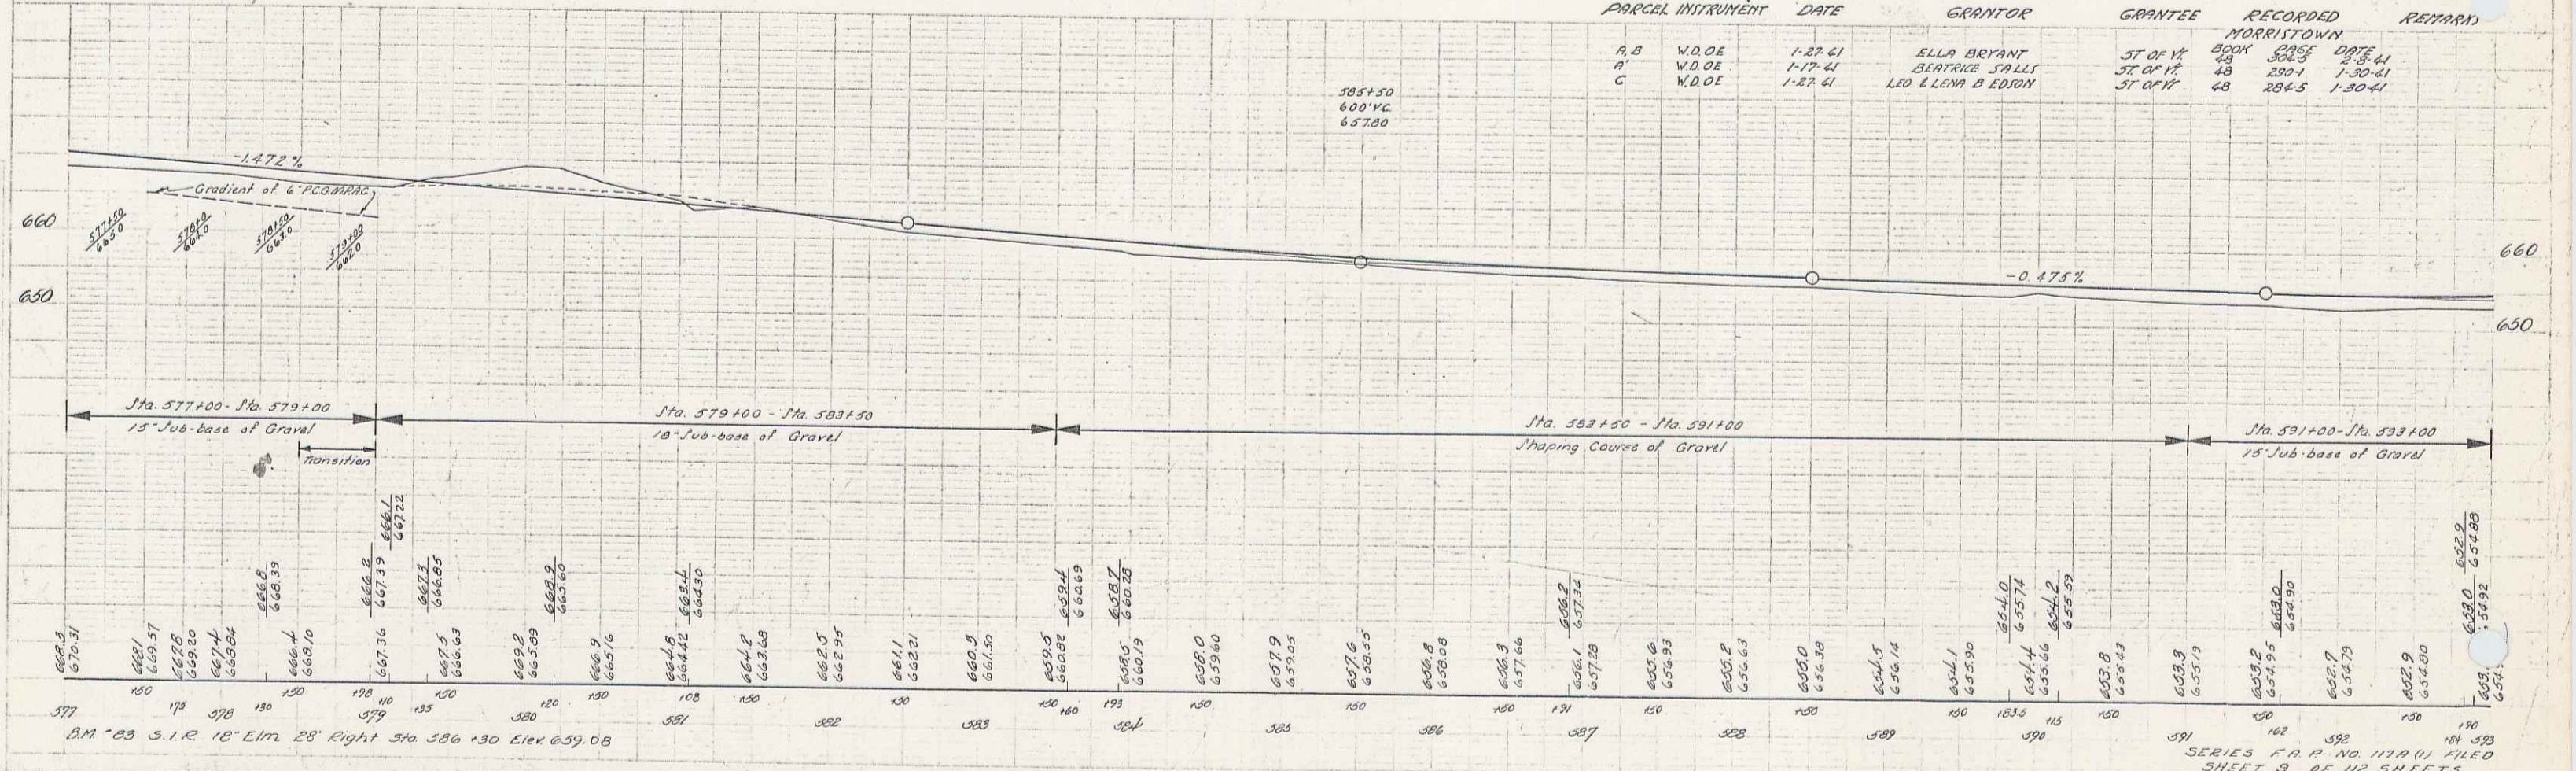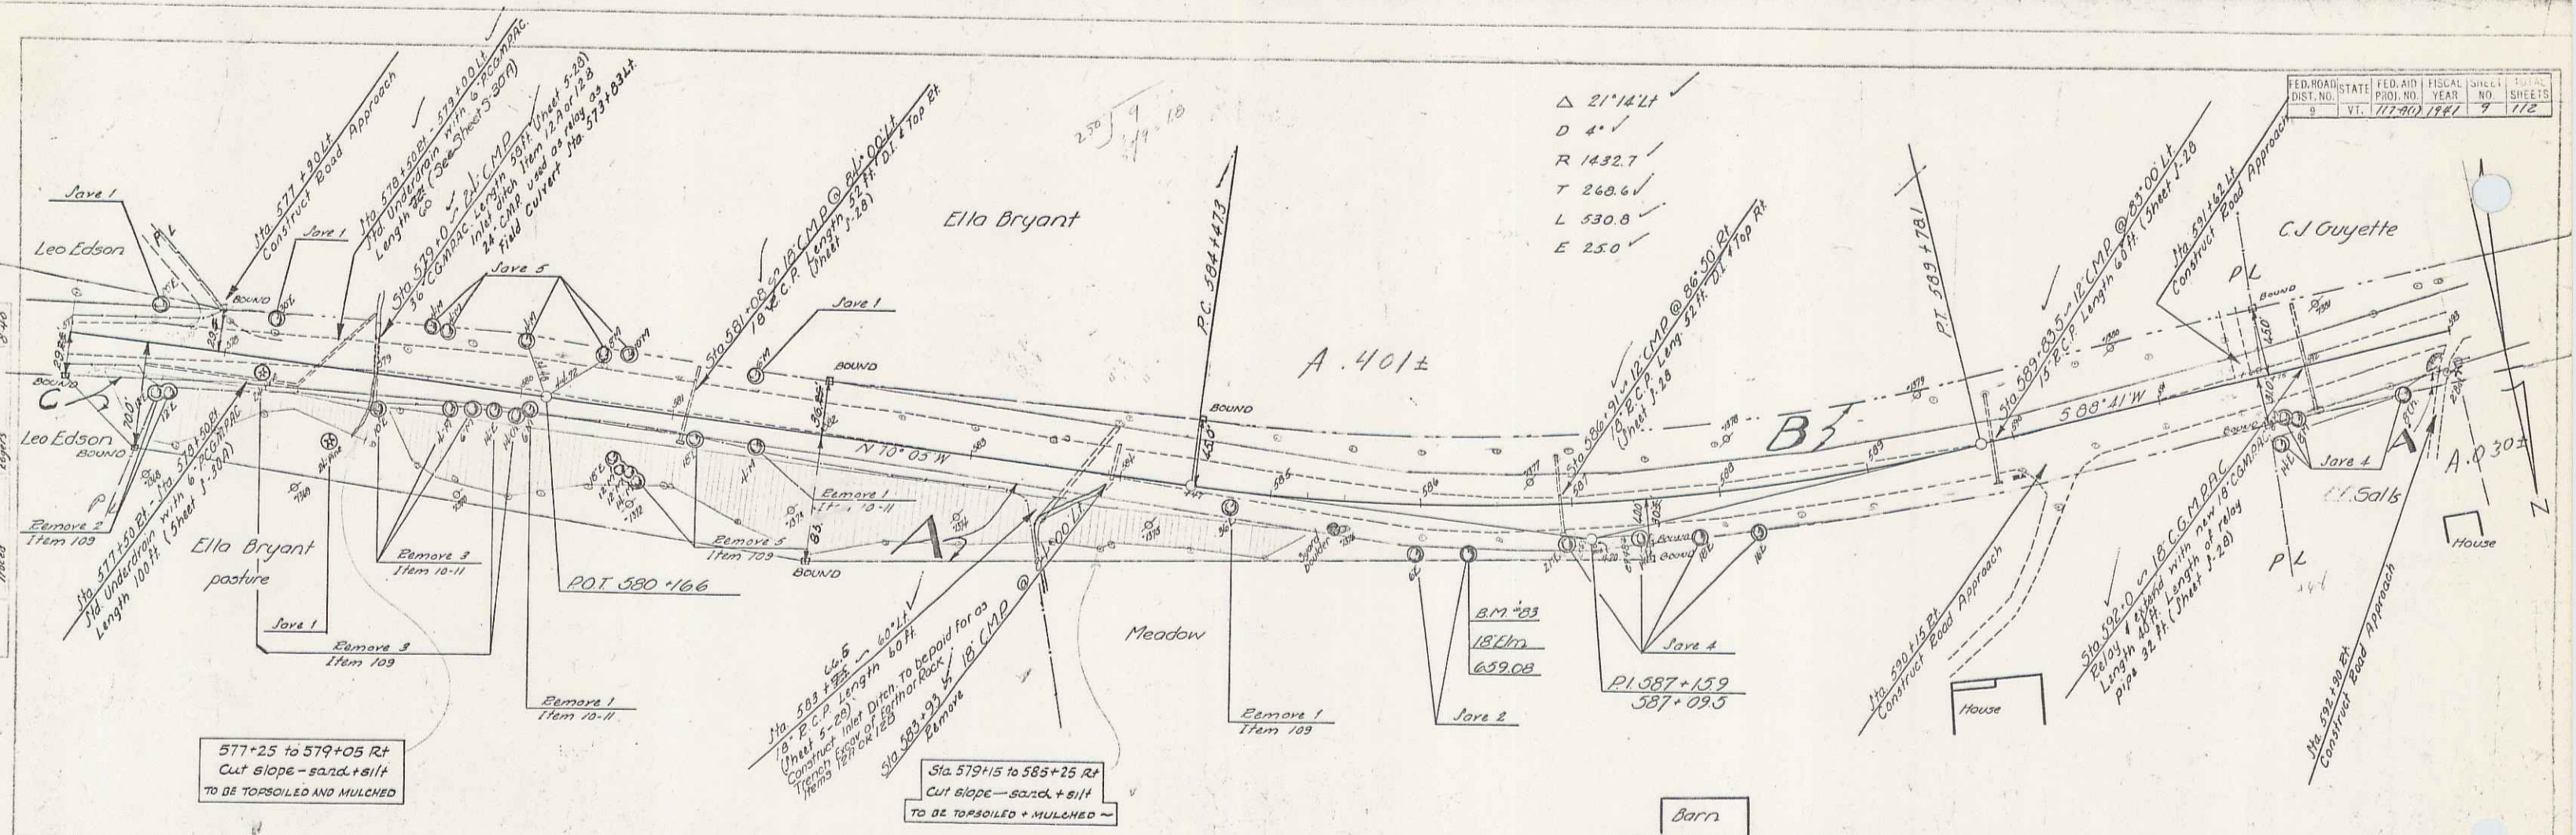


PARCEL INTRUMENT	DATE	GRANTOR	GRANTEE	RECORDED	REMARKS
A.B.	W.D.O.E.	1-23-61	ELLA BRYANT	ST OF 14	BOOK 288.5 DATE 1-30-61
A.	W.D.O.E.	1-17-61	BEATRICE SPALLS	ST OF 14	BOOK 288.5 DATE 1-30-61
C.	W.D.O.E.	1-27-61	LEO ELLA B. EDSON	ST OF 14	BOOK 288.5 DATE 1-30-61

FEED ROAD DIST. NO.	STATE	FED. AID PROJ. NO.	FISCAL YEAR	SHEET NO.	TOTAL SHEETS
0	VT.	117-90	1941	10	112

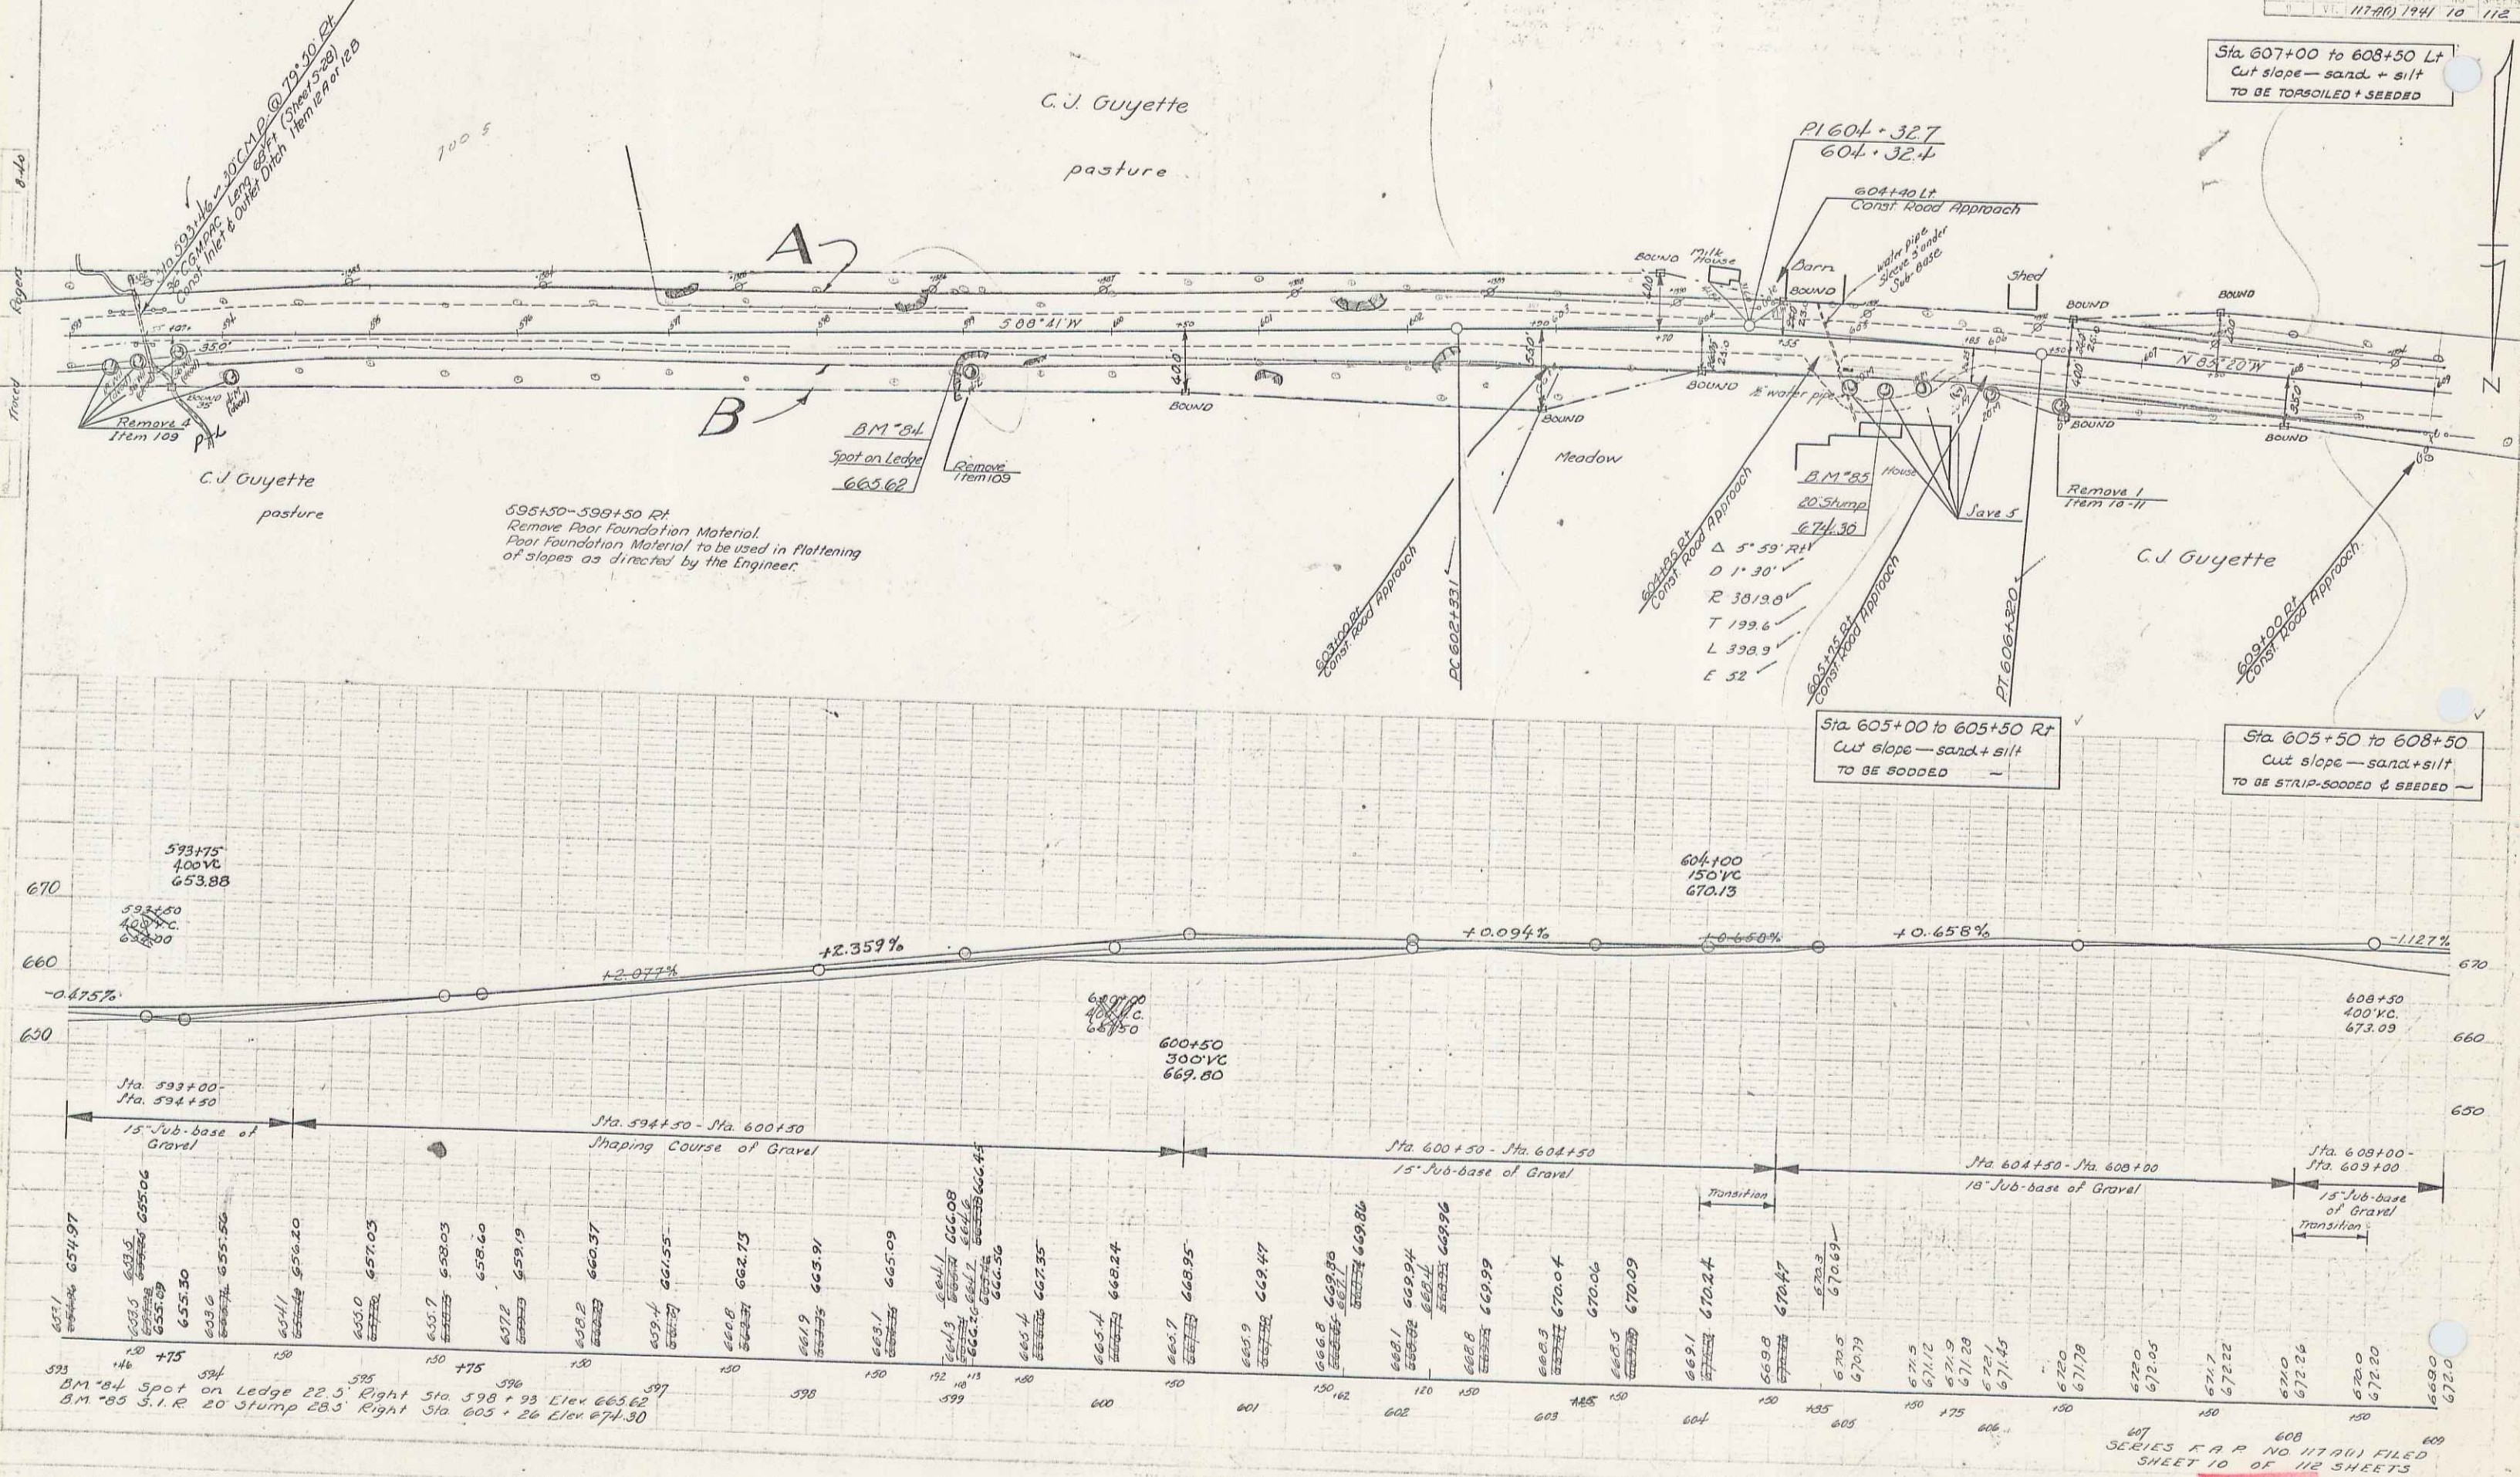

		MORRISTOWN			
			BOOK	PAGE	DATE
C.D.	W.D.OE	1-27-41	G.J. & BERTHA GUYETTE	ST. OF VT.	28
A.B.C.	W.D.OE		MARGUERITE BILLINGS	ST. OF VT.	286-78
A.	C.D.OE	1-27-41	C.H. STAFFORD LIONS INC.	ST. OF VT.	48
A.	W.D.OE	2-28-41	M.E. & B.G. BRIGHT	ST. OF VT.	48
					366-78
					3-3-41

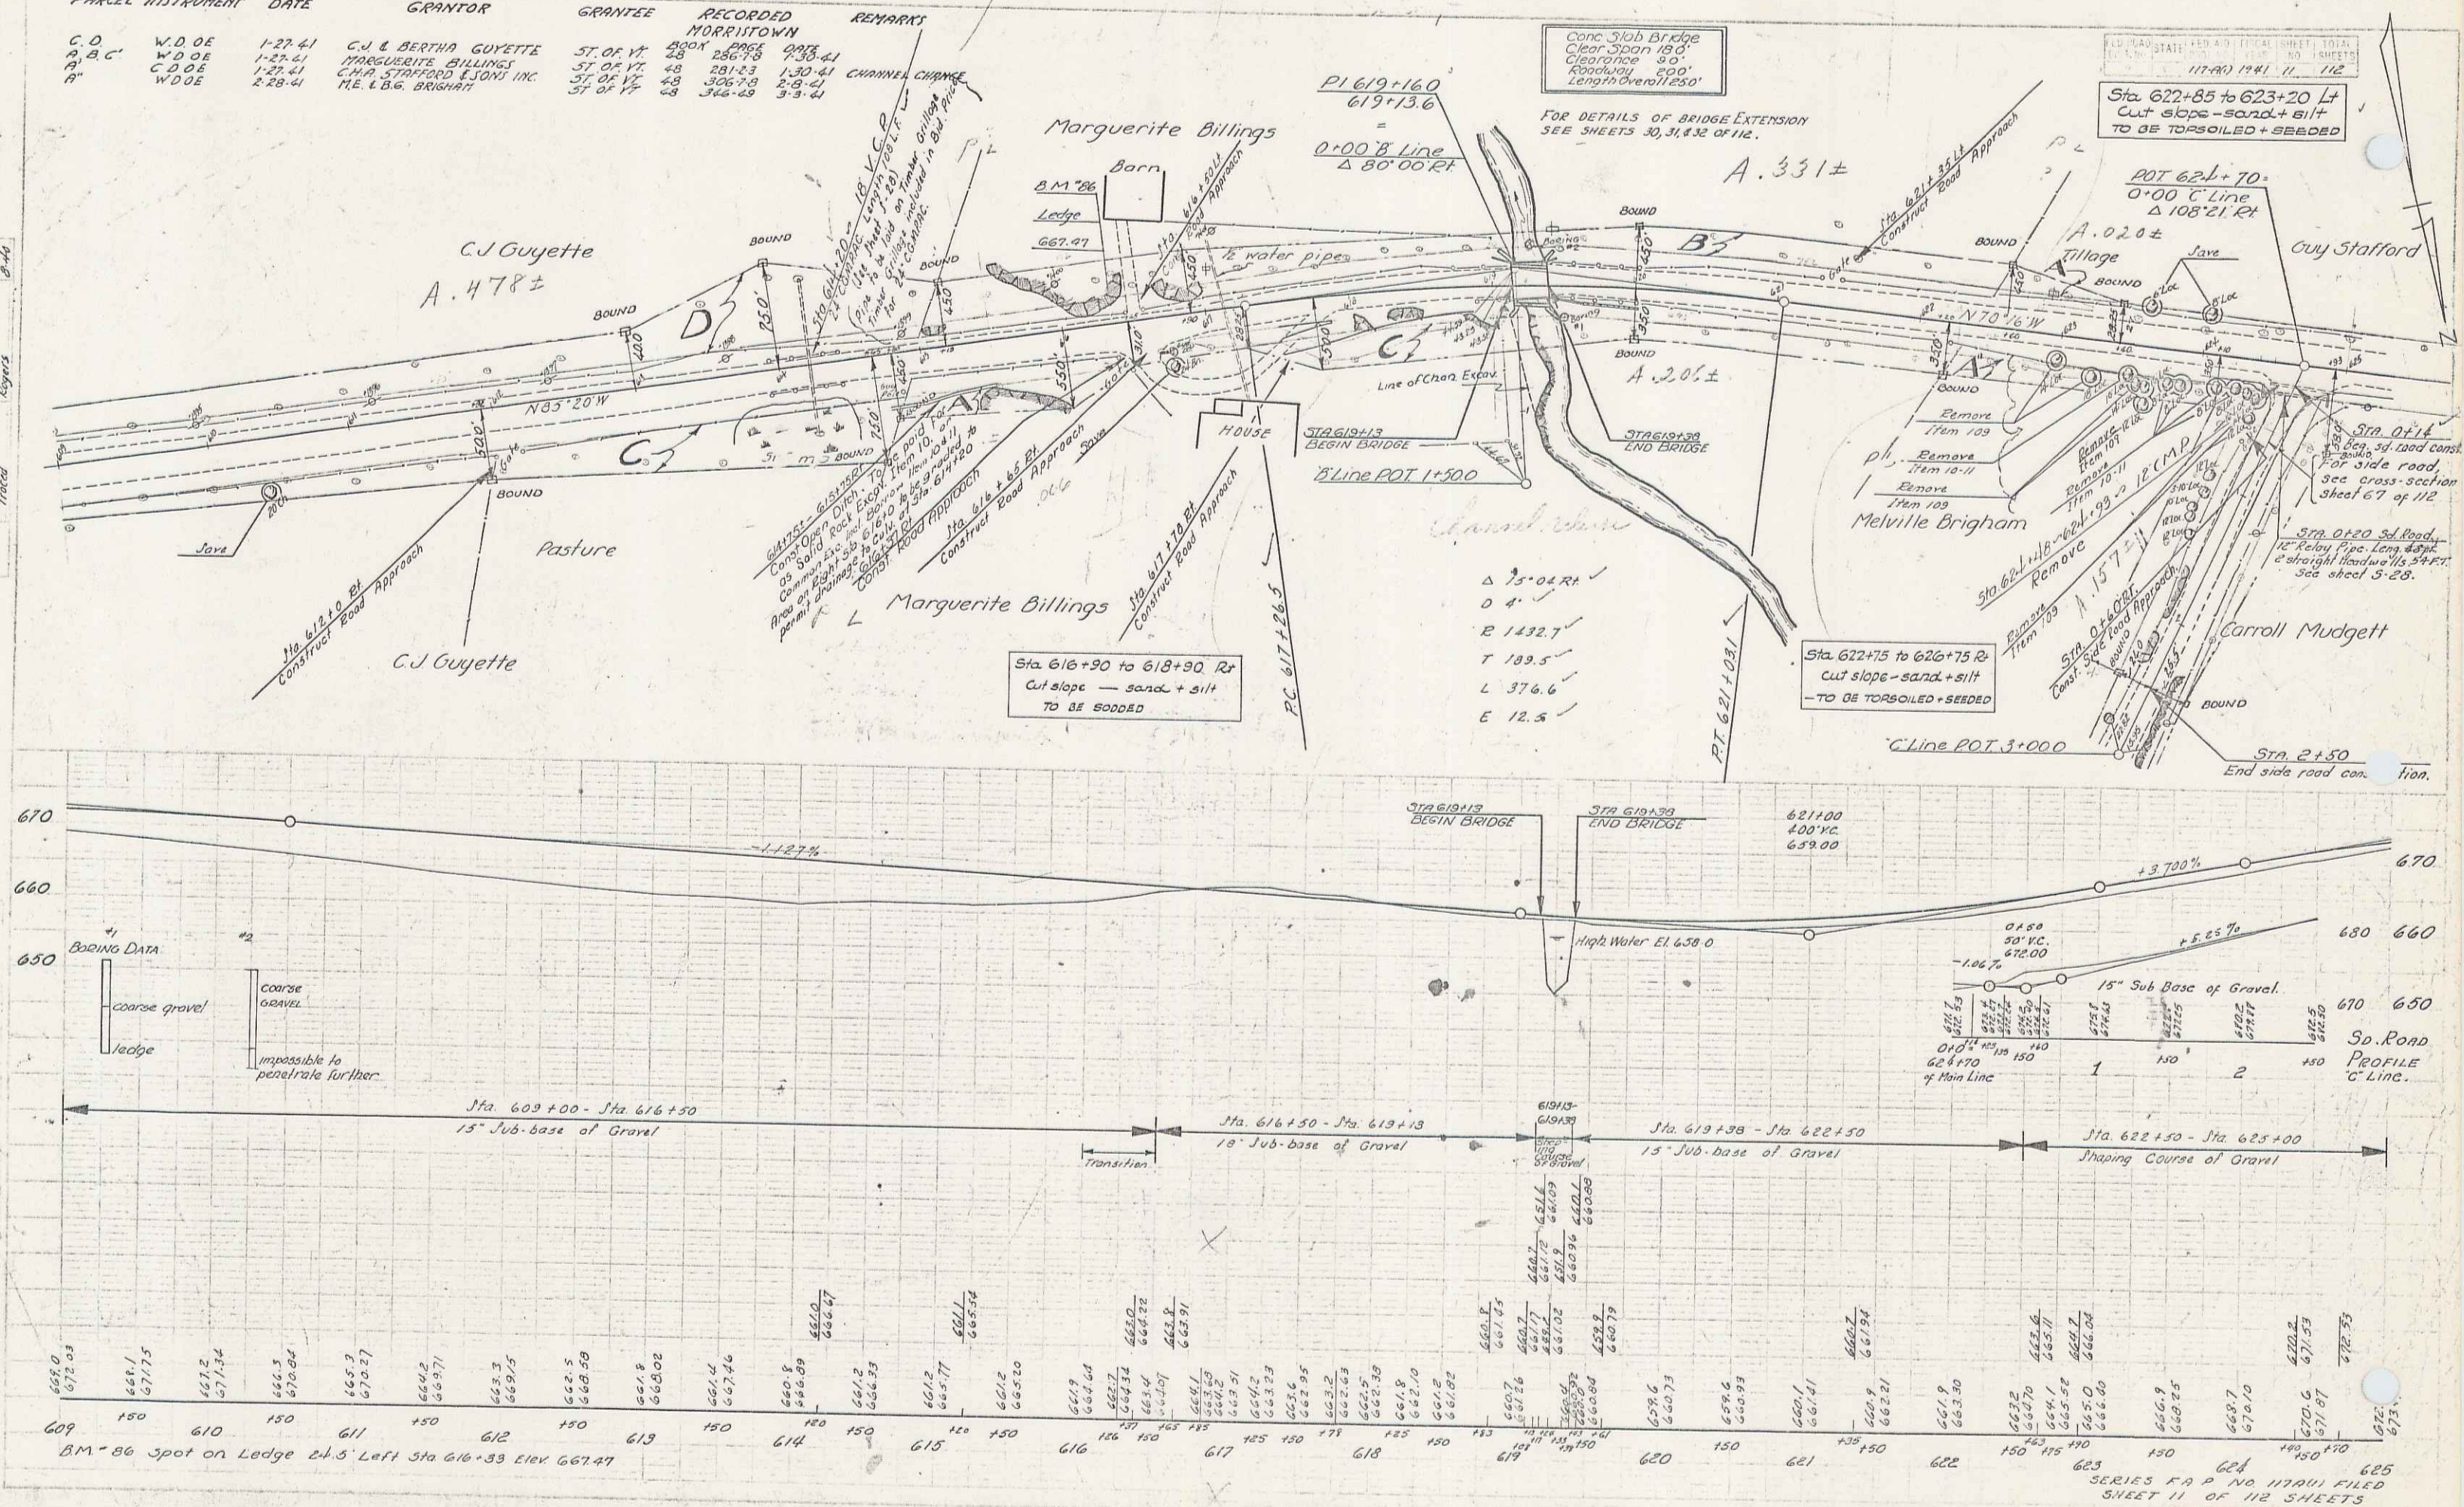

NOTE: Main Water Supply from the reservoir to the village of Morrisville passes in a pipe under the highway somewhere near Sta 636+75. It is estimated that this pipe is approximately 4 ft. to 6 ft. under the surface, but the exact location and depth are not accurately known.

This matter is called to the contractors attention as he will be held liable for any damage done to the water pipe occasioned by the construction.

This matter is called to the contractors attention as he will be held liable for any damage done to the water pipe occasioned by the construction

Sta 622+75 to 626+75 Rt
cut slope ~ sand + silt
TO BE TOPSOILED + SEED -


Sta. 6.35+70.00: Rt. This area to be graded in 30' as to properly cover the new pipe culvert and fill up against the present building foundation. The contractor will also be required to remove sufficient material at this location to provide an approach to the pasture for the property owner and will be required to place a 30' culvert of necessary length, in connection with this construction.

The contractor will not be permitted to carry out any excavation in front of M.E. Brigham's residence in 1940 and shall give the property owner sufficient time to remove or transplant shrubs and growing bushes that this property owner may desire to move.

Sta 634+00 ~ 635+50 Rt ~
cut slope - sand + silt
TO BE SCRPED

Sta. 636+00 - 640+00 -
Clearing & Grubbing Item

NOTE: - CLEARING AND GRUBBING
be paid for under the Item of
Grubbing, Item 13, and this pay Item
only to such locations as ordered
clear. Horizontal measurements shall
computing areas for payment of
Grubbing, Item 13

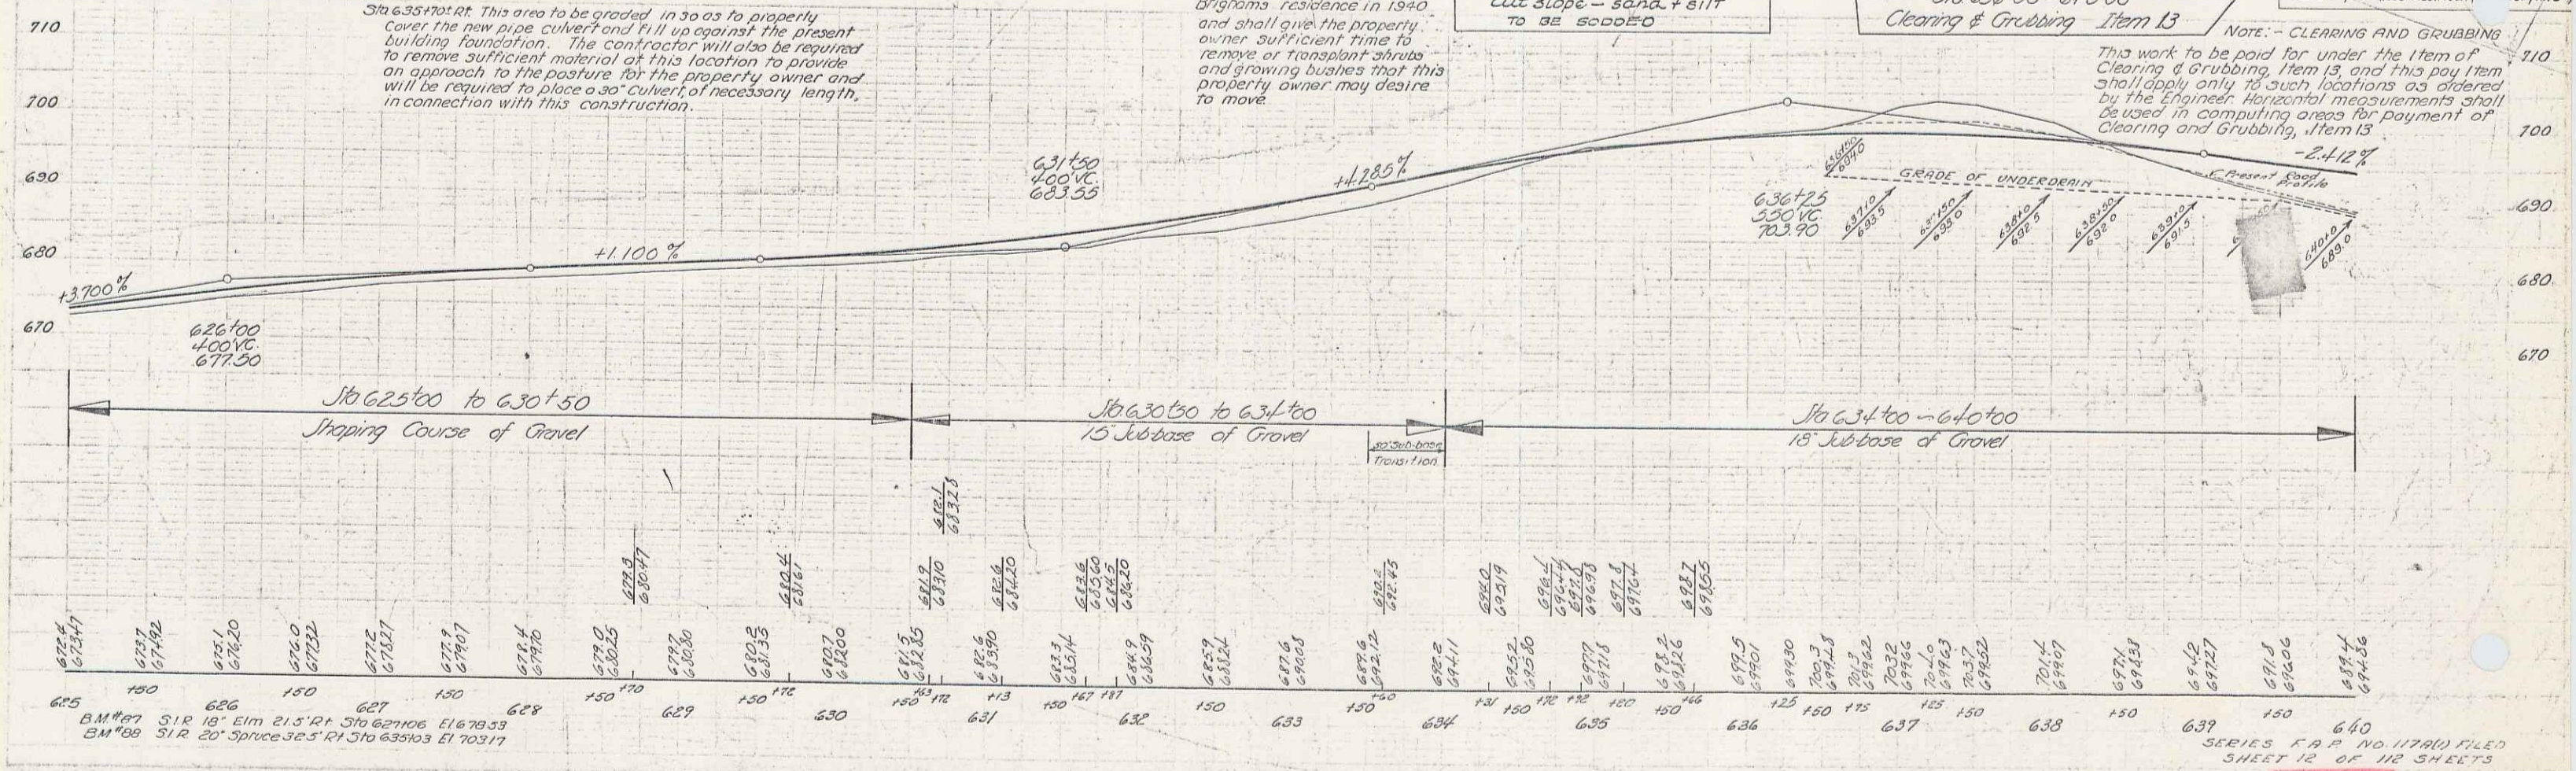


640
SERIES F.A.P. NO. 117A(1) FILED
SHEET 12 OF 112 SHEETS

$\Delta 2^{\circ}59'Lt.$
 $D1^{\circ}$
 $R5729.7$
 $T1492$
 $L298.3$
 $E1.9$

FED. ROAD DIST. NO.	STATE	FED. AID FUND NO.	FISCAL YEAR	SHEET NO.	TOTAL SHEETS
9	VI.	117A(0	1941	12	11

Station	OFFSETS FROM Q
633	00A
+50	15R
634	30R
+50	40A
635	40A
+50	30R
636	10R
+50	00R

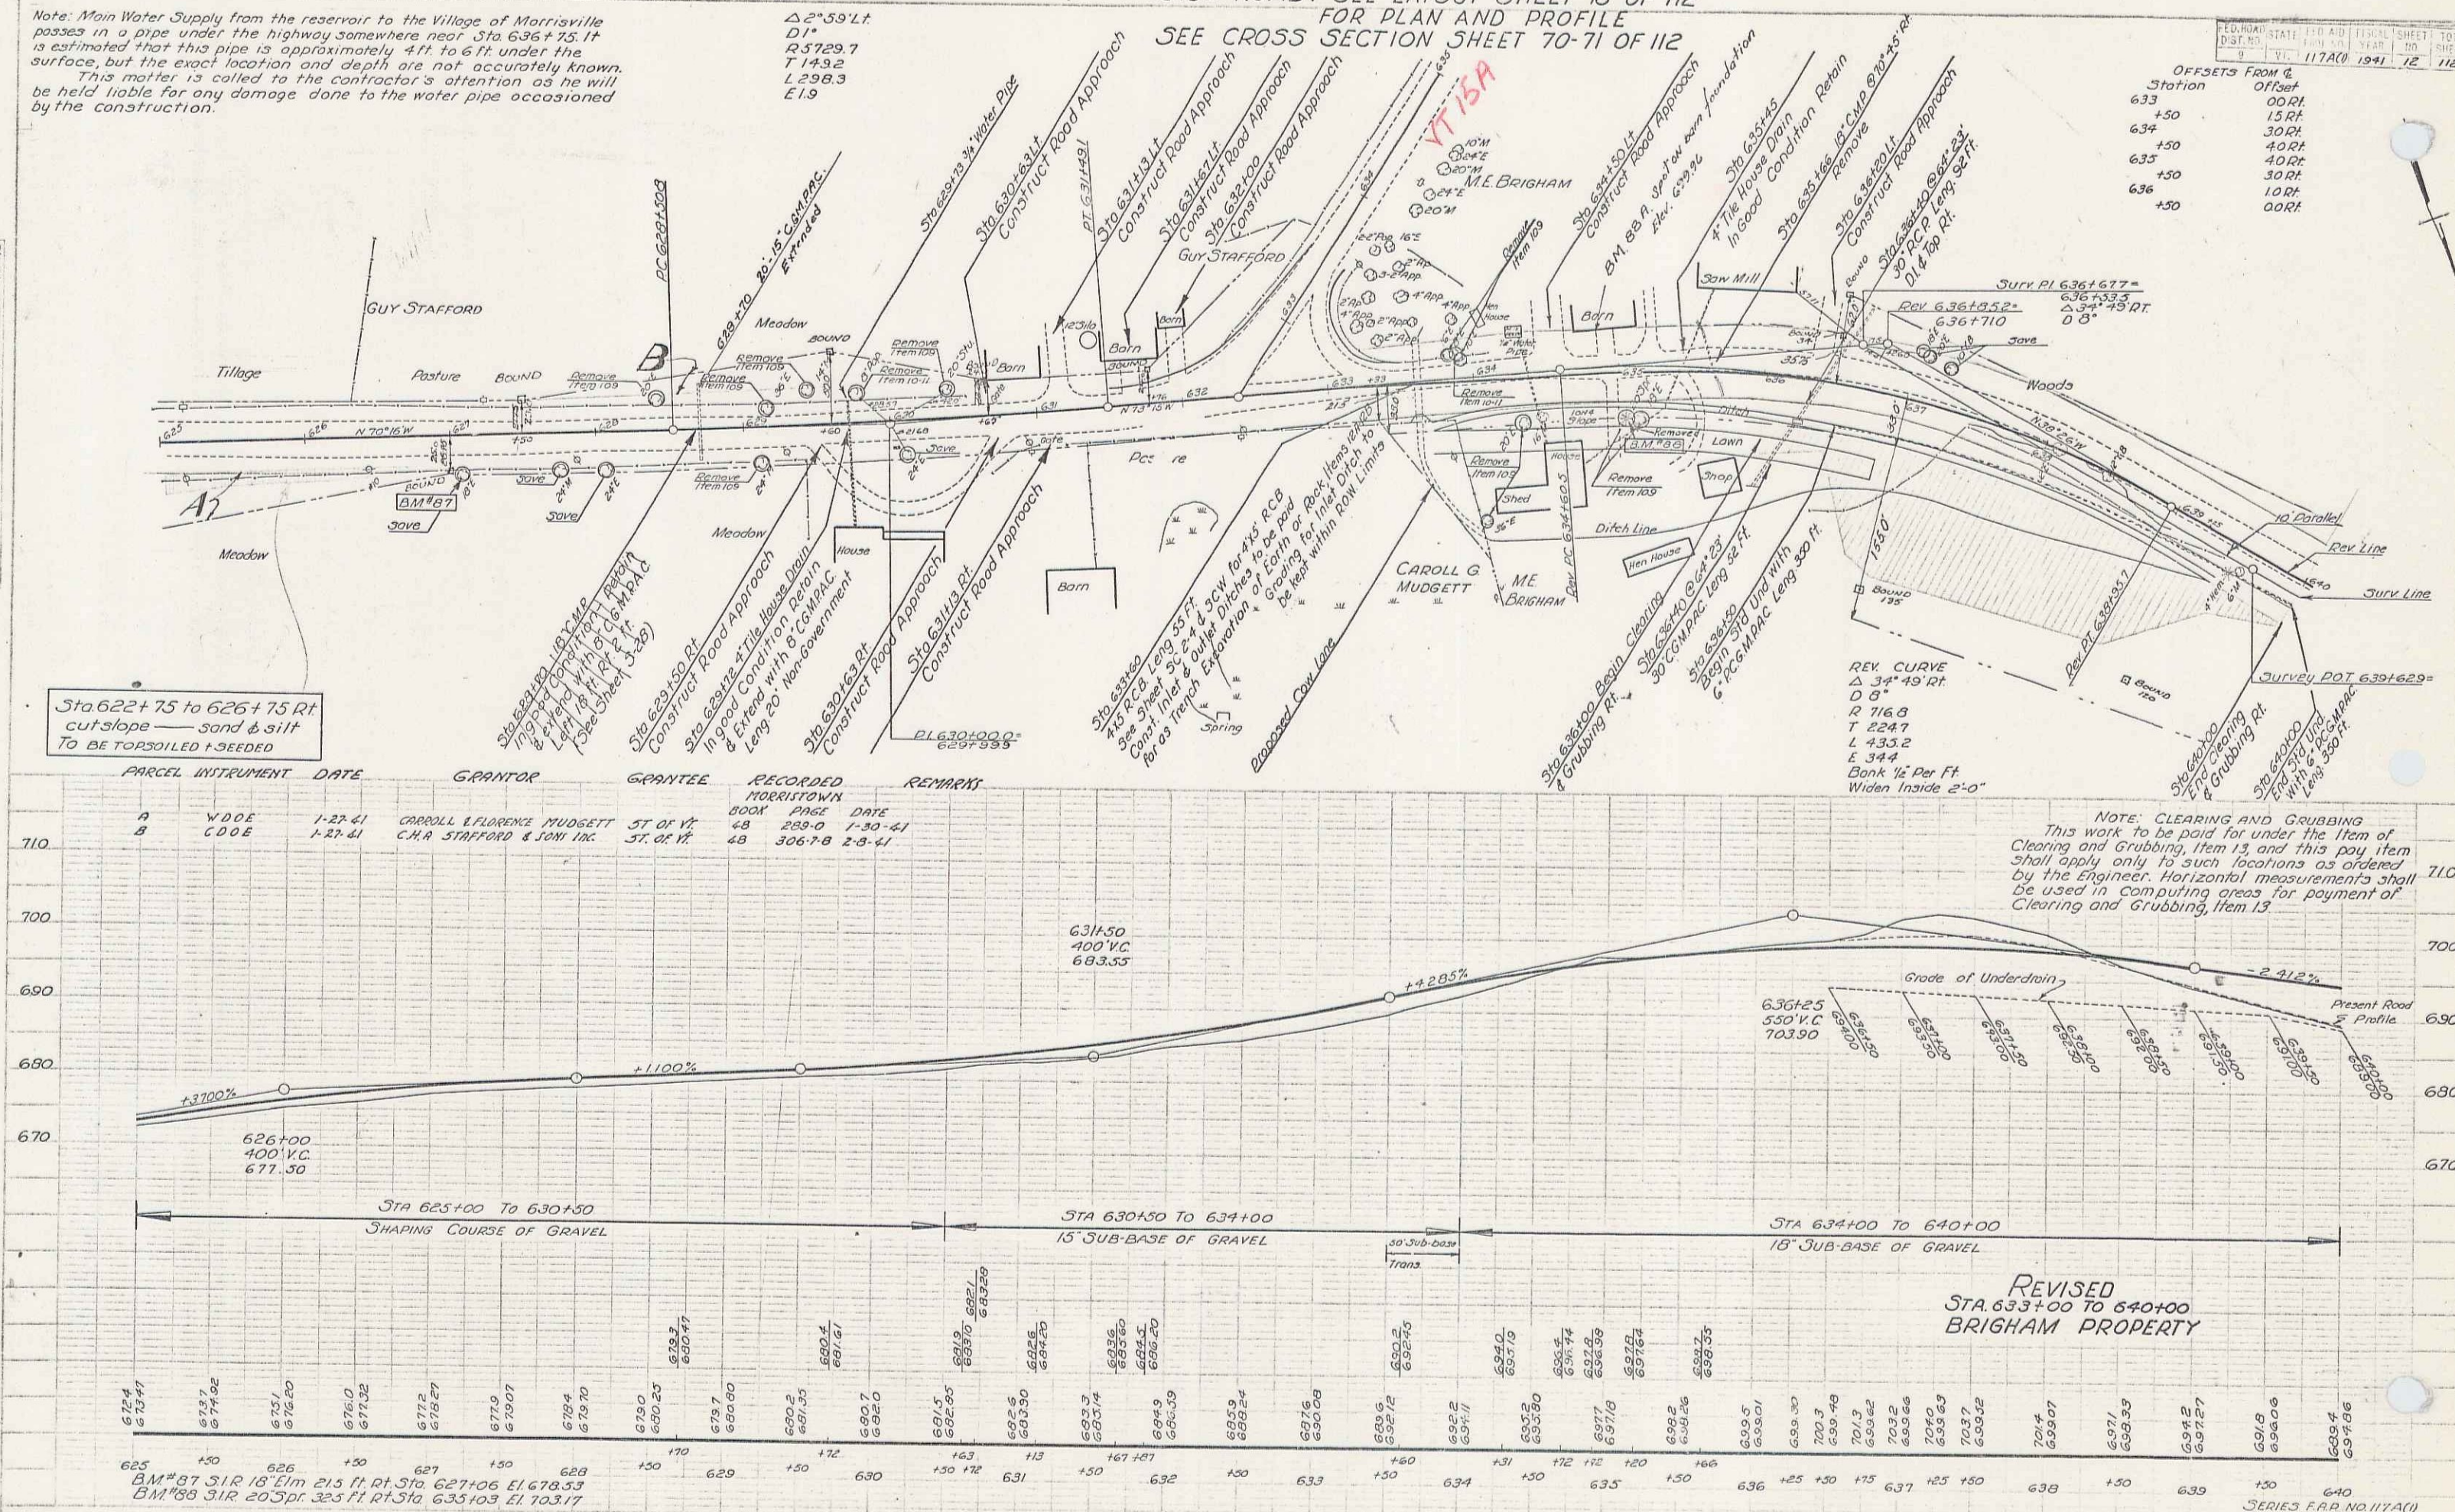

NOTE: CLEARING AND GRUBBING
This work to be paid for under the item of
Clearing and Grubbing, Item 13, and this pay item
shall apply only to such locations as ordered
by the Engineer. Horizontal measurements shall
be used in computing areas for payment of
Clearing and Grubbing, Item 13.


REVISED
STA. 633+00 TO 640+00
BRIGHAM PROPERTY

640
SERIES F.A.R. NO. 117A(1)
SHEET 12 OF 112
12A OF 112



9

PARCEL	INSTRUMENT	DATE	GRANTOR	GRANTEE	RECORDED	REMARKS
C	C.D.O.E.	1-27-41	CHA. STAFFORD & SONS INC.	ST. OF VT.	BOOK PAGE	
C	N.D.O.E.	2-28-41	M.E.L. B.G. BRIGHAM	ST. OF VT.	48 346.63 3-3-41	


DIST. NO.	STATE	FILE NO.	YEAR	SHEET NO.	TOTAL SHEETS
9	VT.	11740	1941	13	112

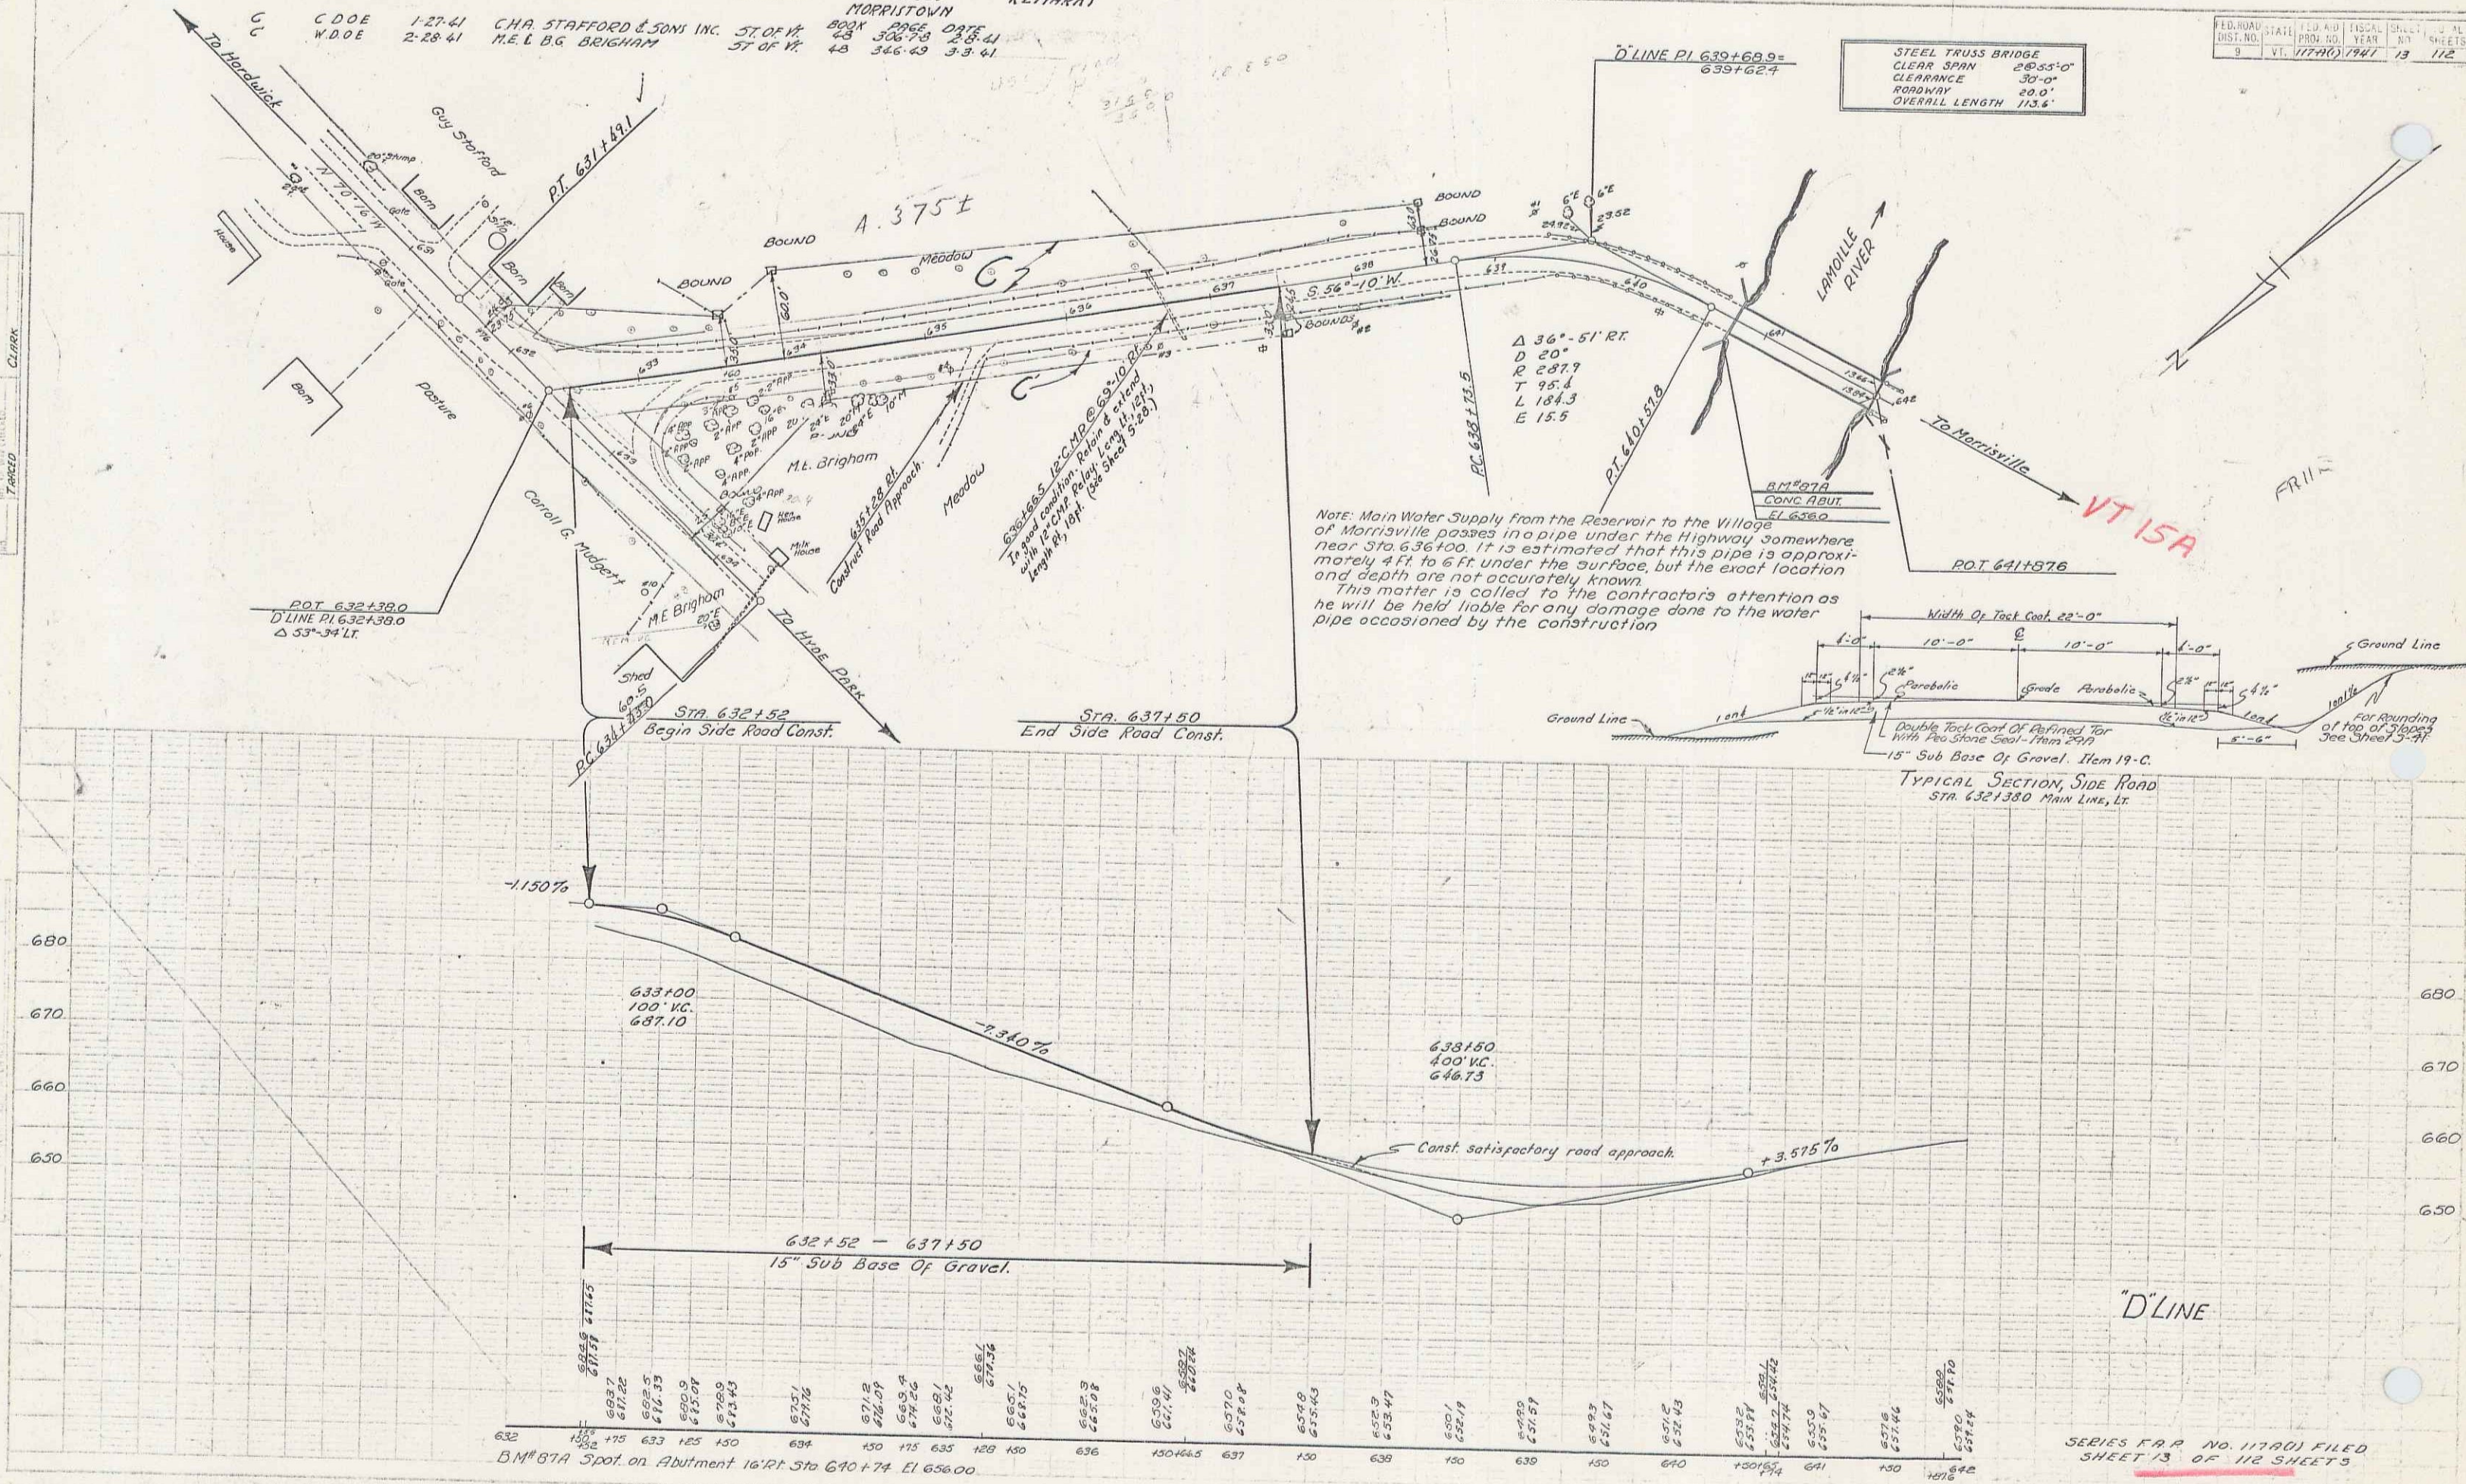


SERIES F.A.P. NO. 117401 FILED
 SHEET 13 OF 112 SHEETS

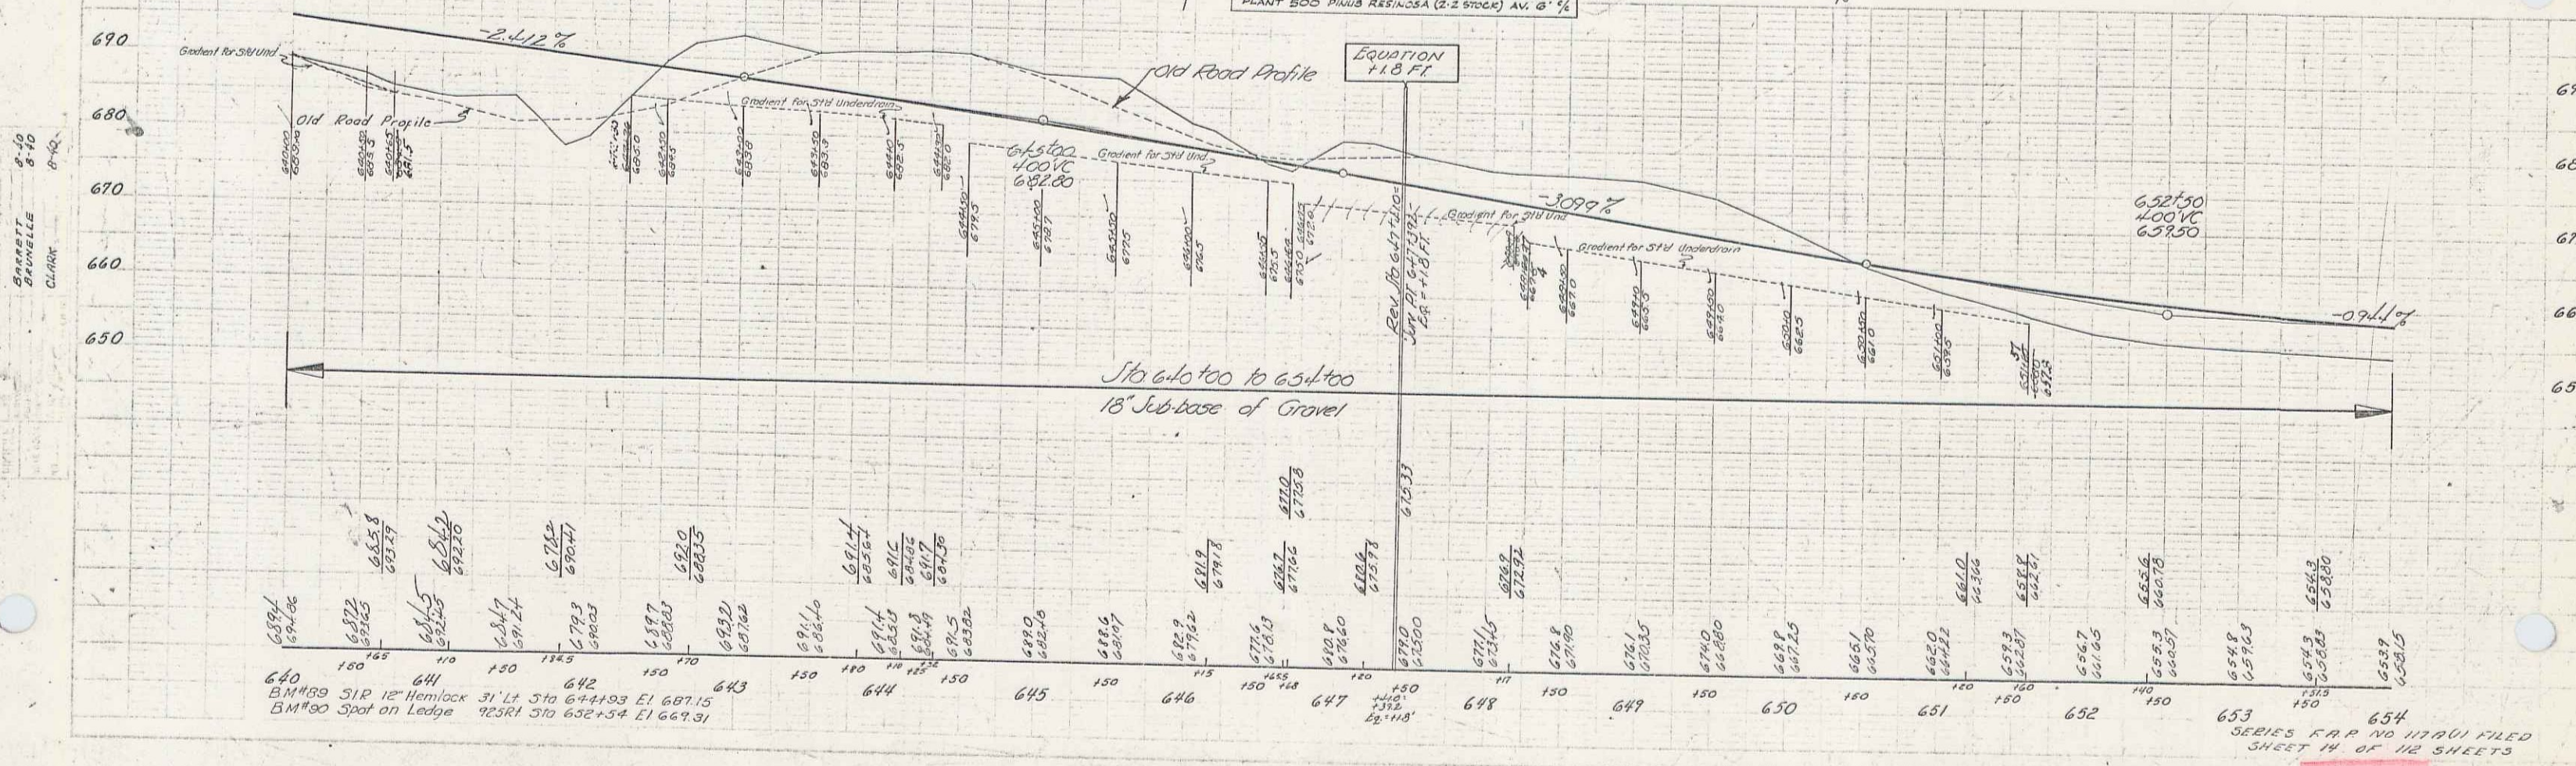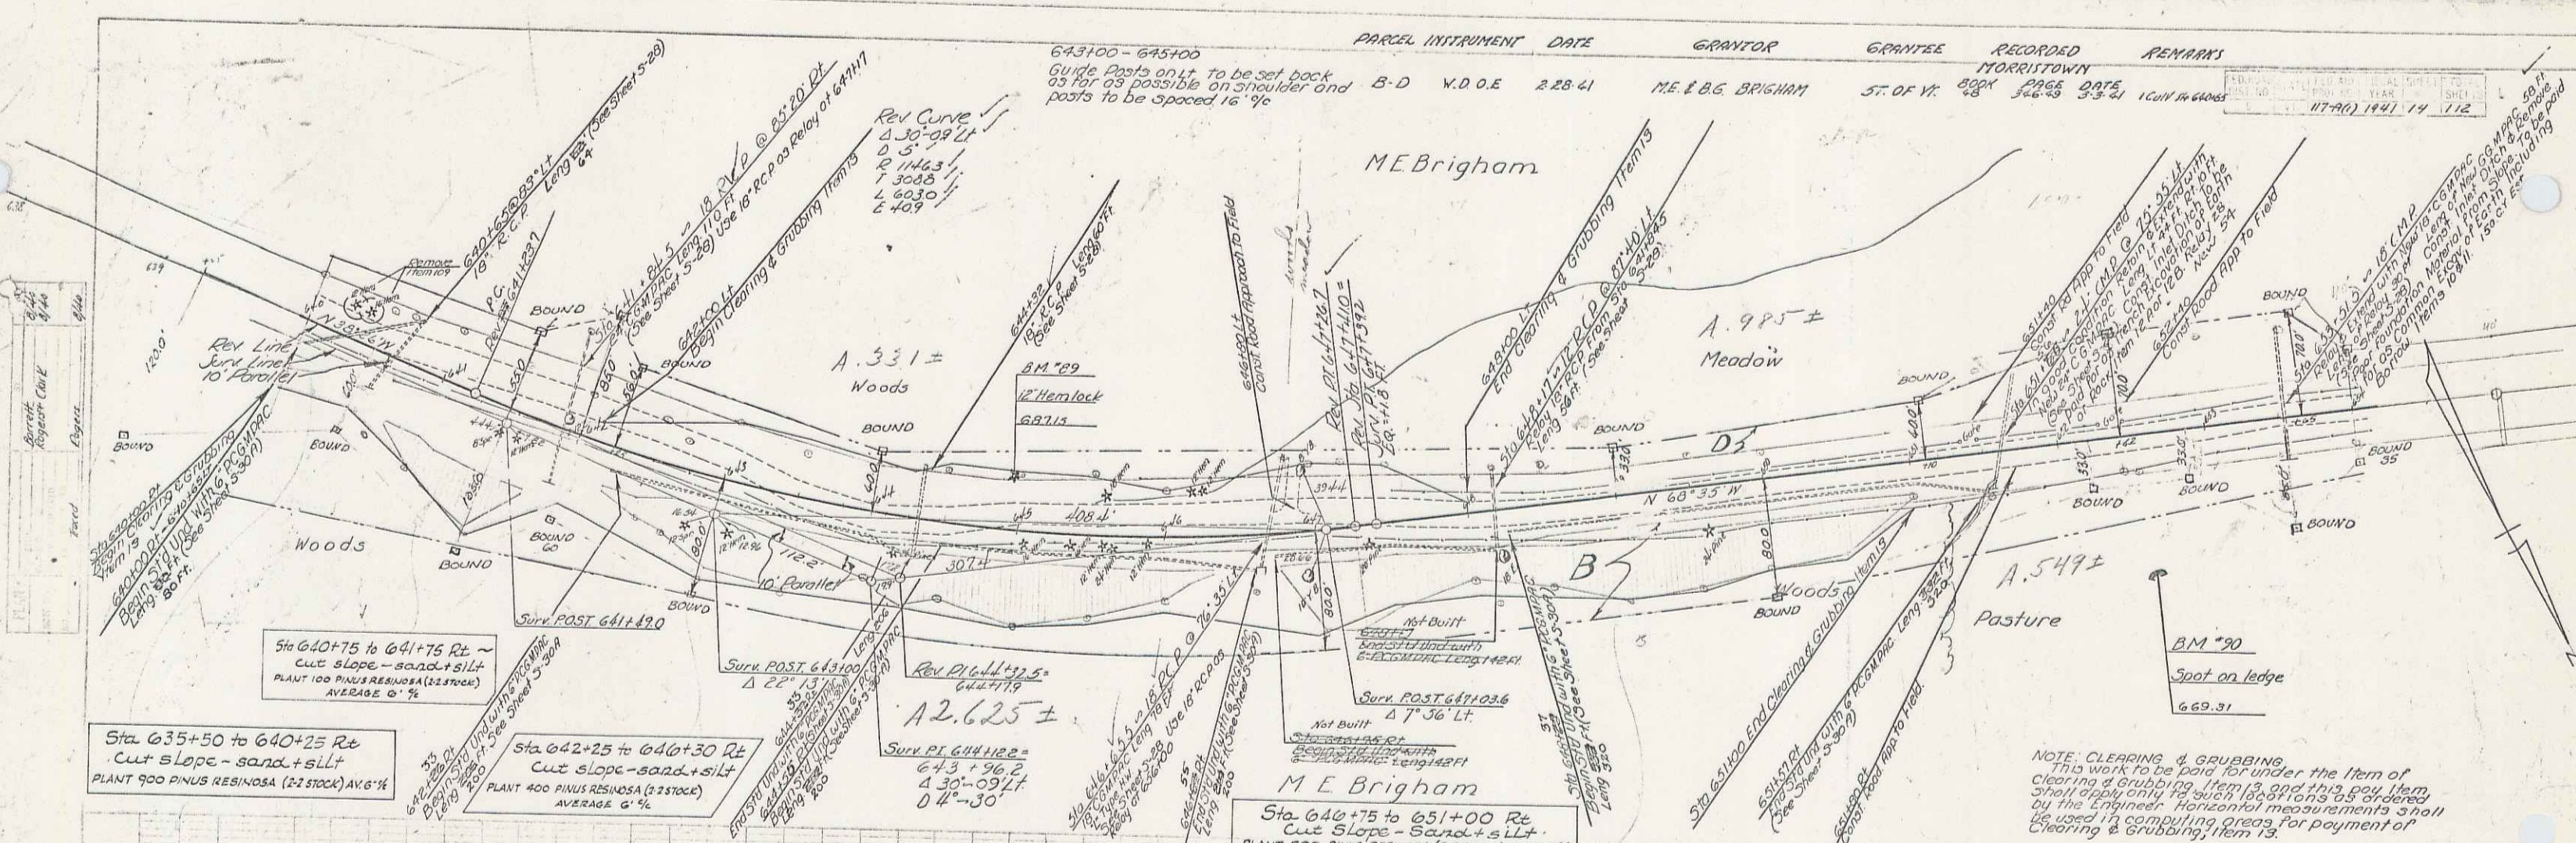

1941	1942	1943	3315	331
------	------	-----


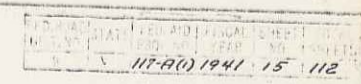


Sta 659+75 to 661+75 Rt
Cut slope - sand & silt
TO BE TOPSOILED + MULCHED
PLANT 300 PINUS RESINOSA (2-2.50CK) @ 6'.

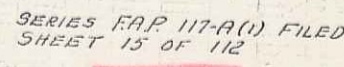

PARCEL	INSTRUMENT	DATE	GRANTOR	GRANTEE	RECORDED	REMARKS
A.B	N.D.O.E.	2-3-61	O.D. & ADELAIDE MATTHEWS	ST. OF VT.	BOOK PAGE 28 300-123 285-41	

COUNTY STATE FILED AND PUBLIC RECORDS
 DIST. NO. 17-100 YEAR 1961
 117-100 1741 16 112

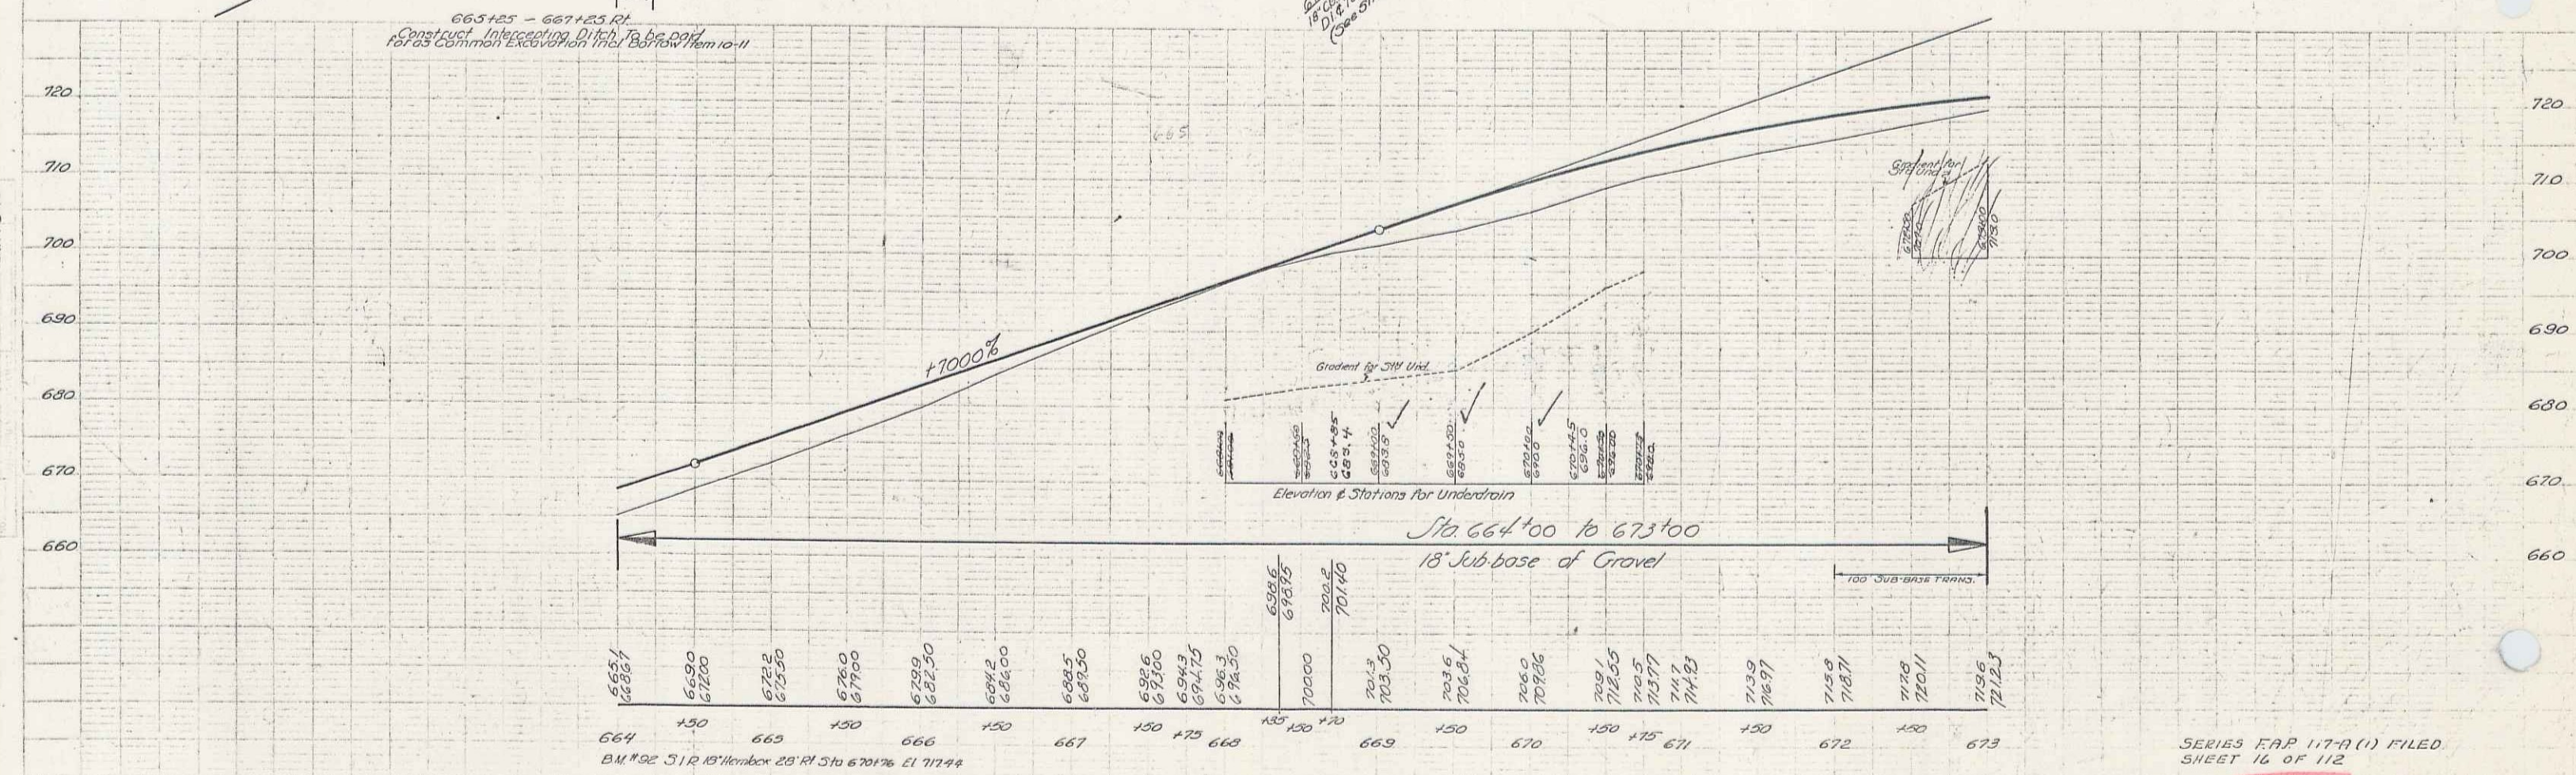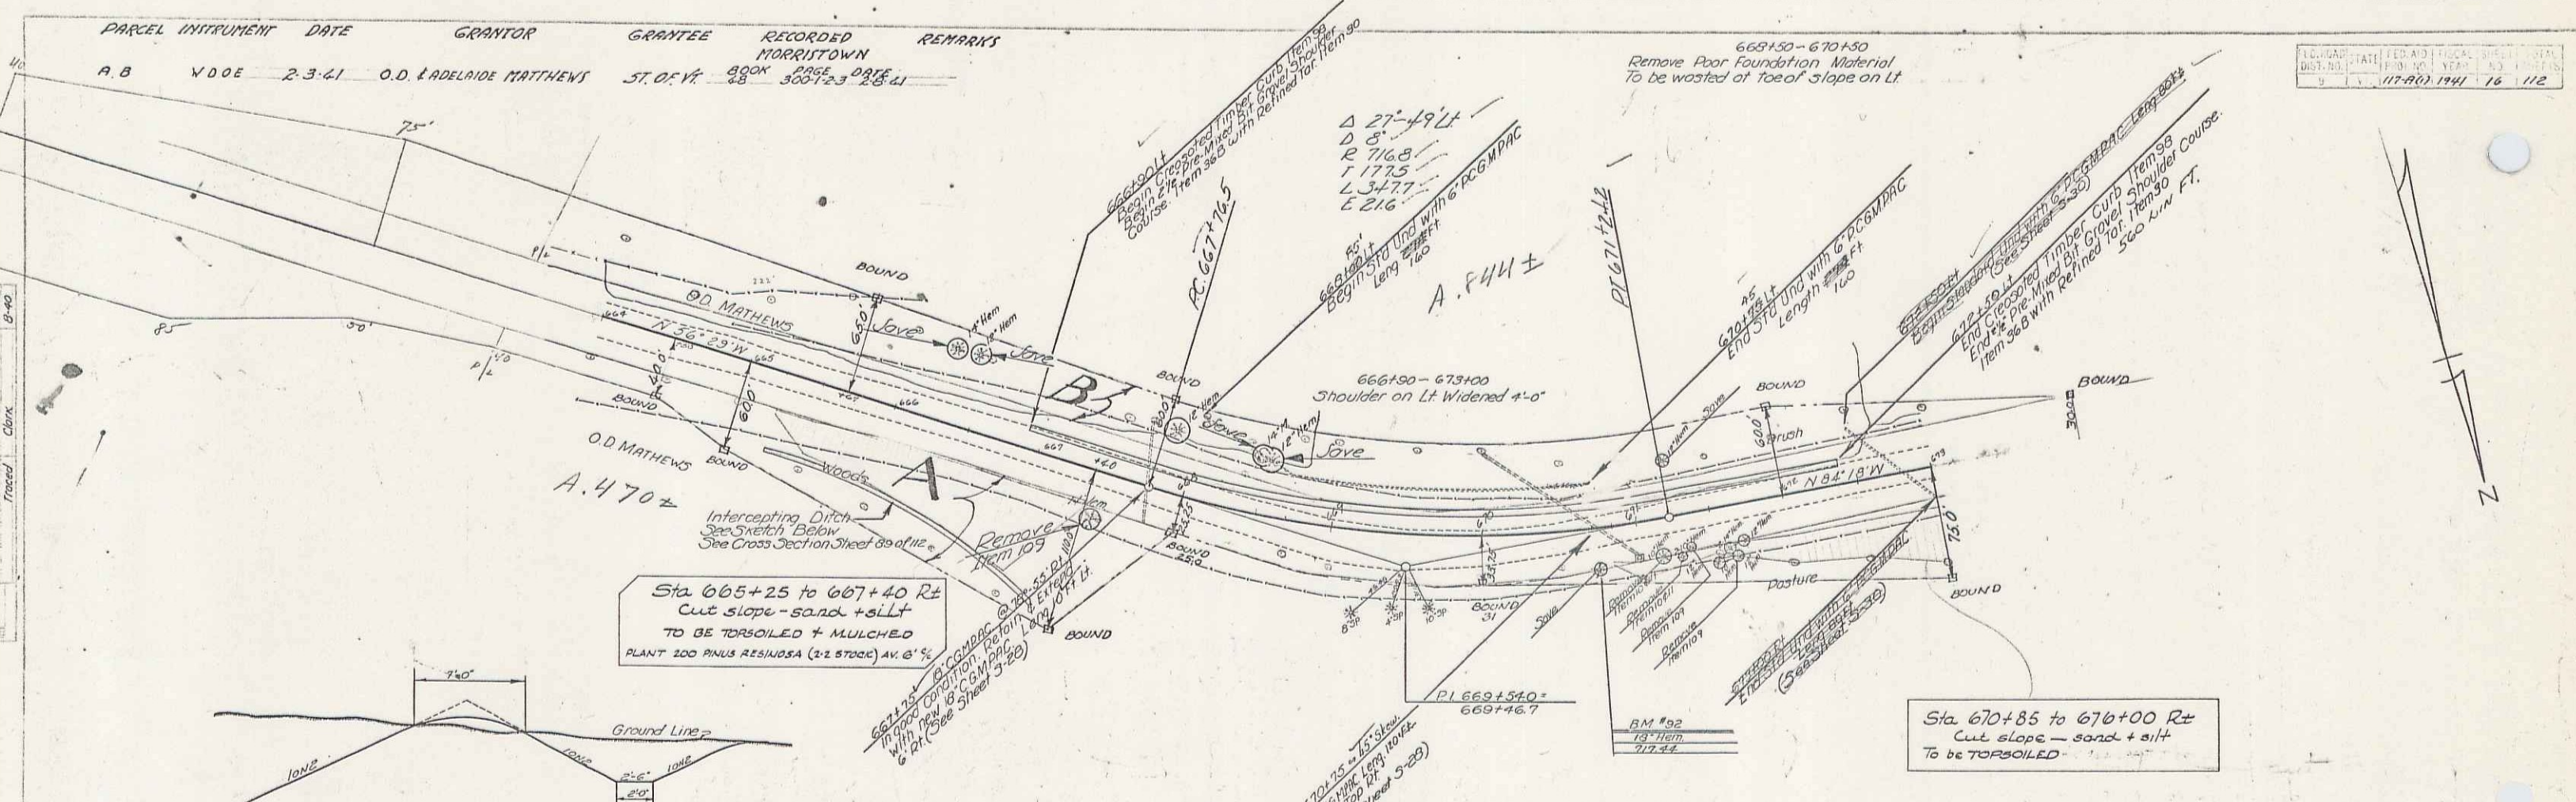


SERIES FAP 117-A(1) FILED
 SHEET 16 OF 112

PARCEL	INSTRUMENT	DATE	GRANTOR	GRANTEE	RECORDED	REMARK
C.D.E.	W.D.E.	2-3-41	O.D. & ADELAIDE MATTHEWS	ST OF VT	BOOK PAGE DATE	
A	W.D.E.	1-27-41	HOWARD H. & FRANCES LYON	ST OF VT	48 339-40 2-15-41	

TO ROAD	STATE	FED. AID	FISCAL YEAR	SHEET NO.	TOTAL SHEETS
VI.	17-20	1941	17	112	



Note:
Sta 673+00 to 676+00
Shoulder on right widened 6'-0".

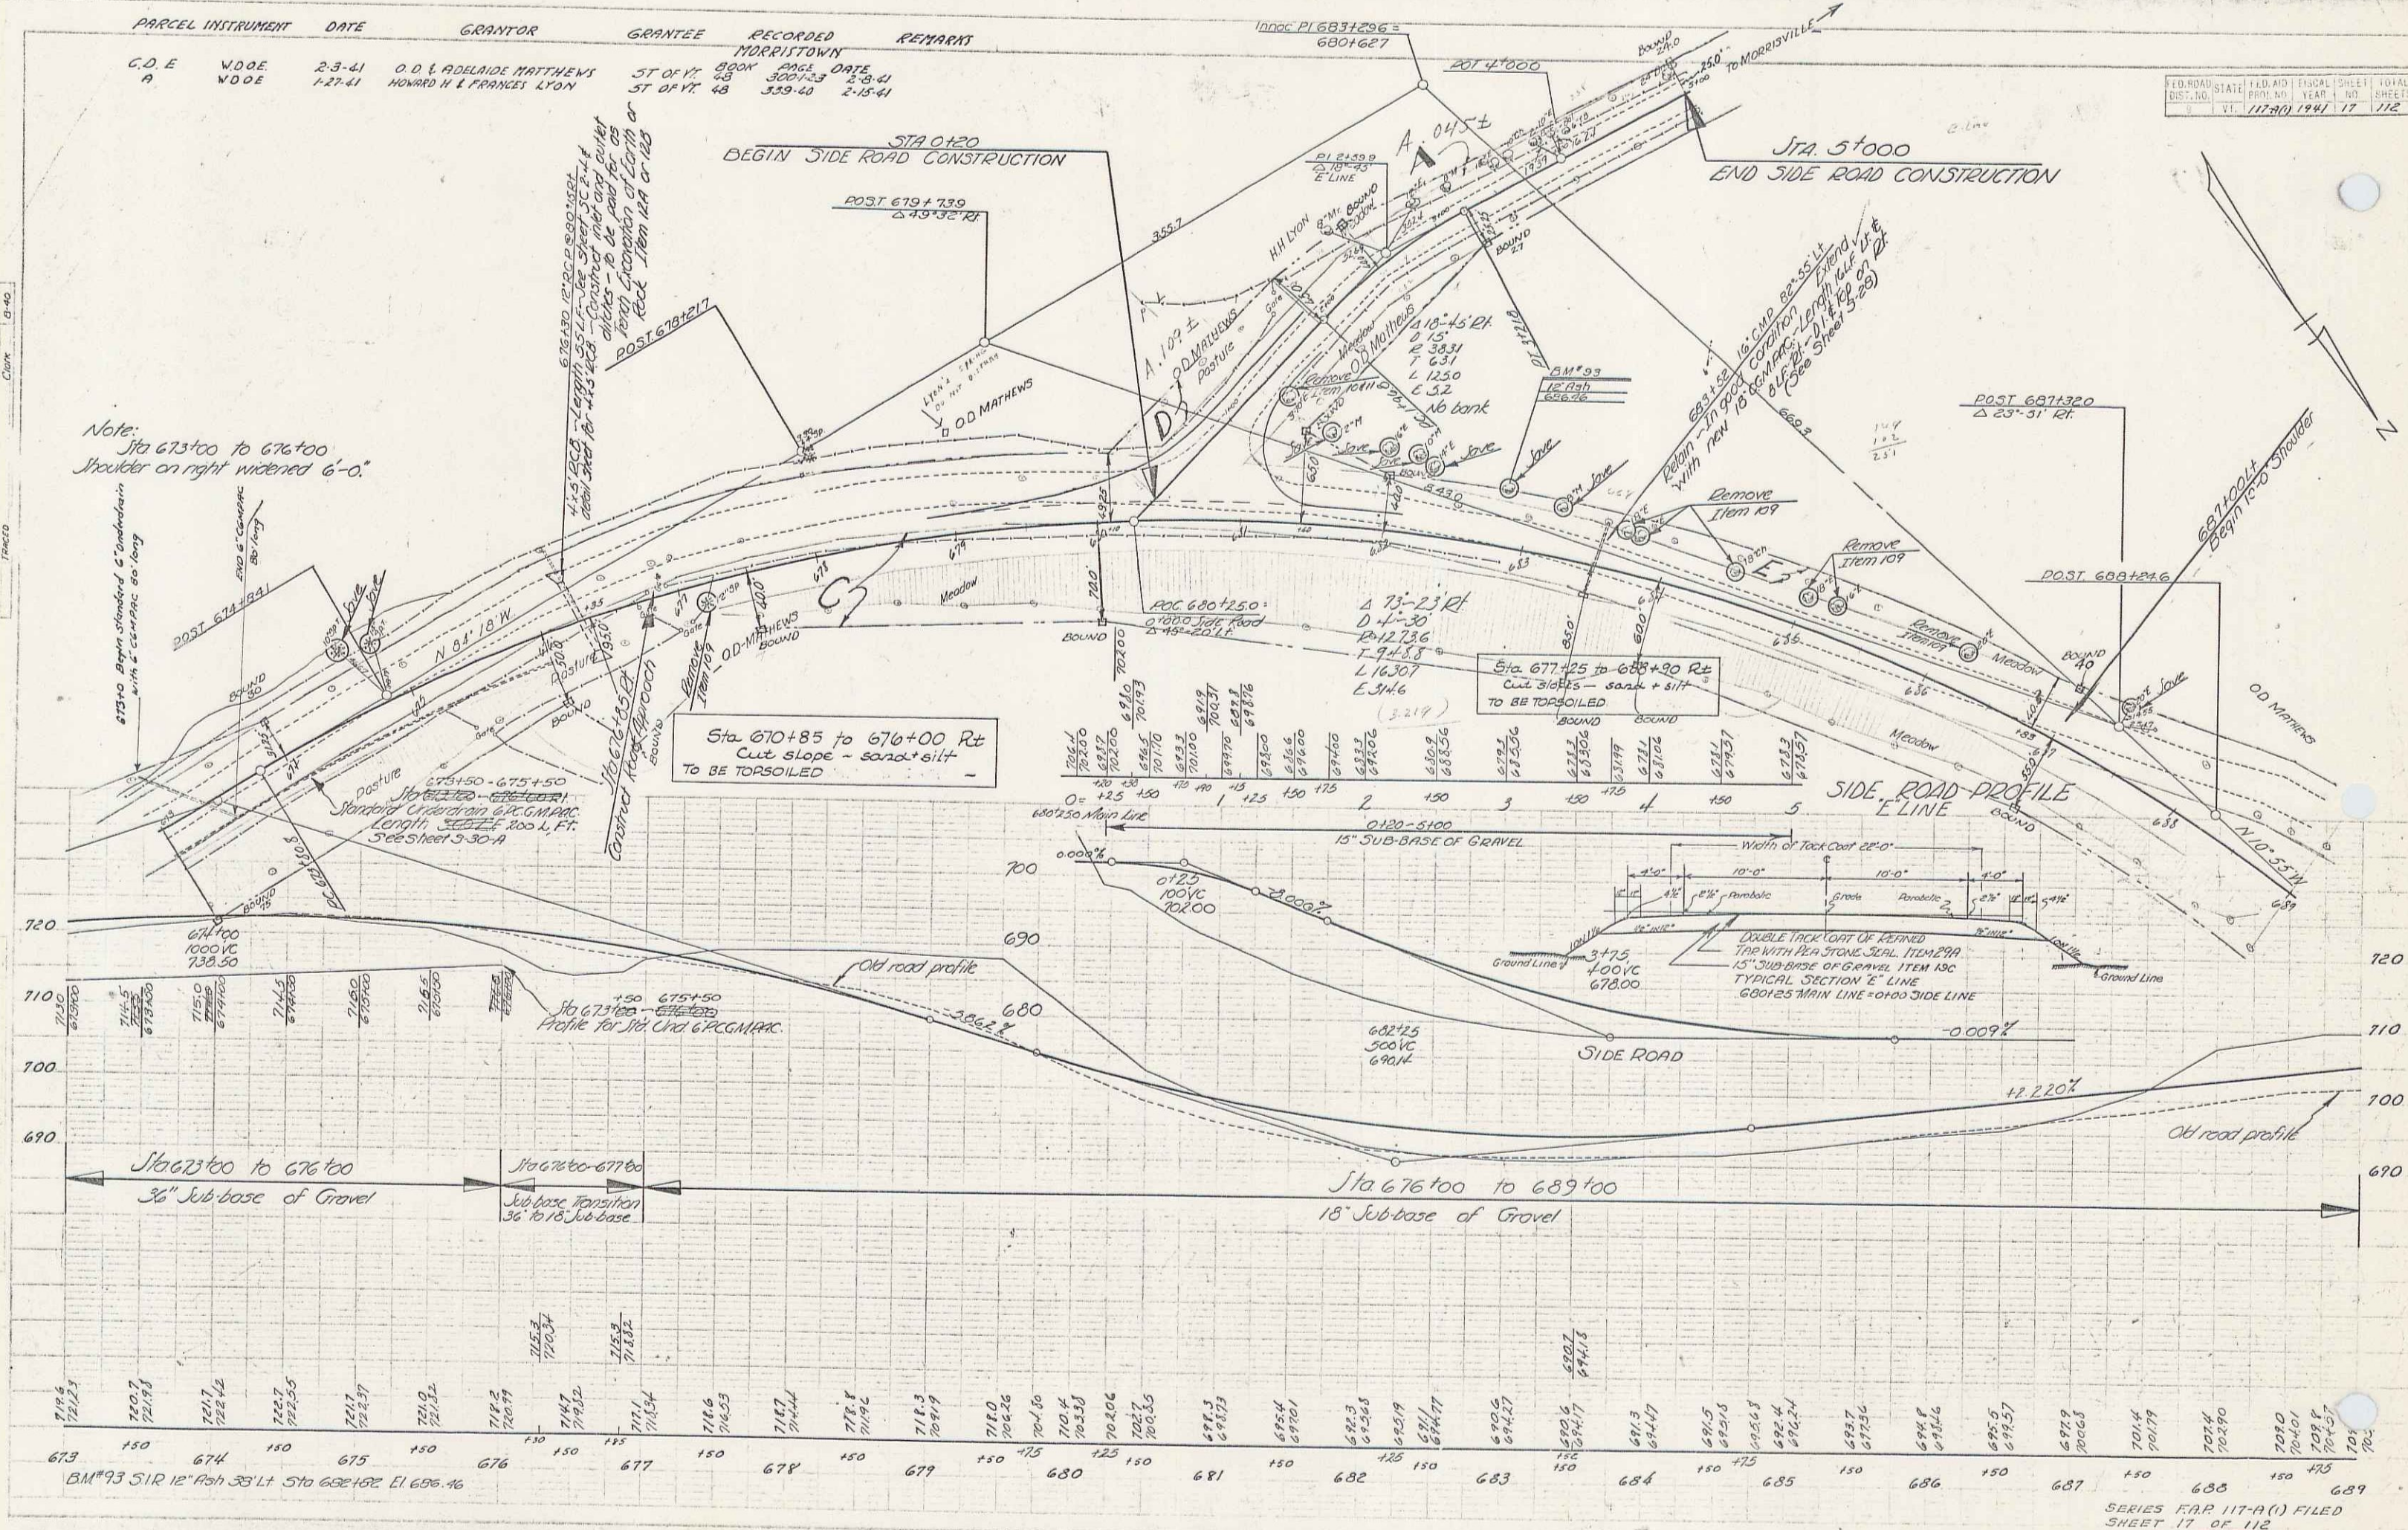

SERIES FAR 117-A(1) FILED
SHEET 17 OF 112


PARCEL	INSTRUMENT	DATE	GRANTOR	GRANTEE	RECORDED	REMARKS
A, B	W.D.O.E.	1-27-41	WALTER EUGEN SANDERS	ST. OF N.	BOOK 1800 PAGE 354	2-15-41
A, B	W.D.O.E.	1-27-41	HERBERT L. RUTH SMITH	ST. OF N.	BOOK 1800 PAGE 354	2-15-41

FED. ROAD DIST. NO.	STATE	FED. AID PROJ. NO.	FISCAL YEAR	SHEET NO.	TOTAL SHEETS
9	VI	117-100	1941	18	112

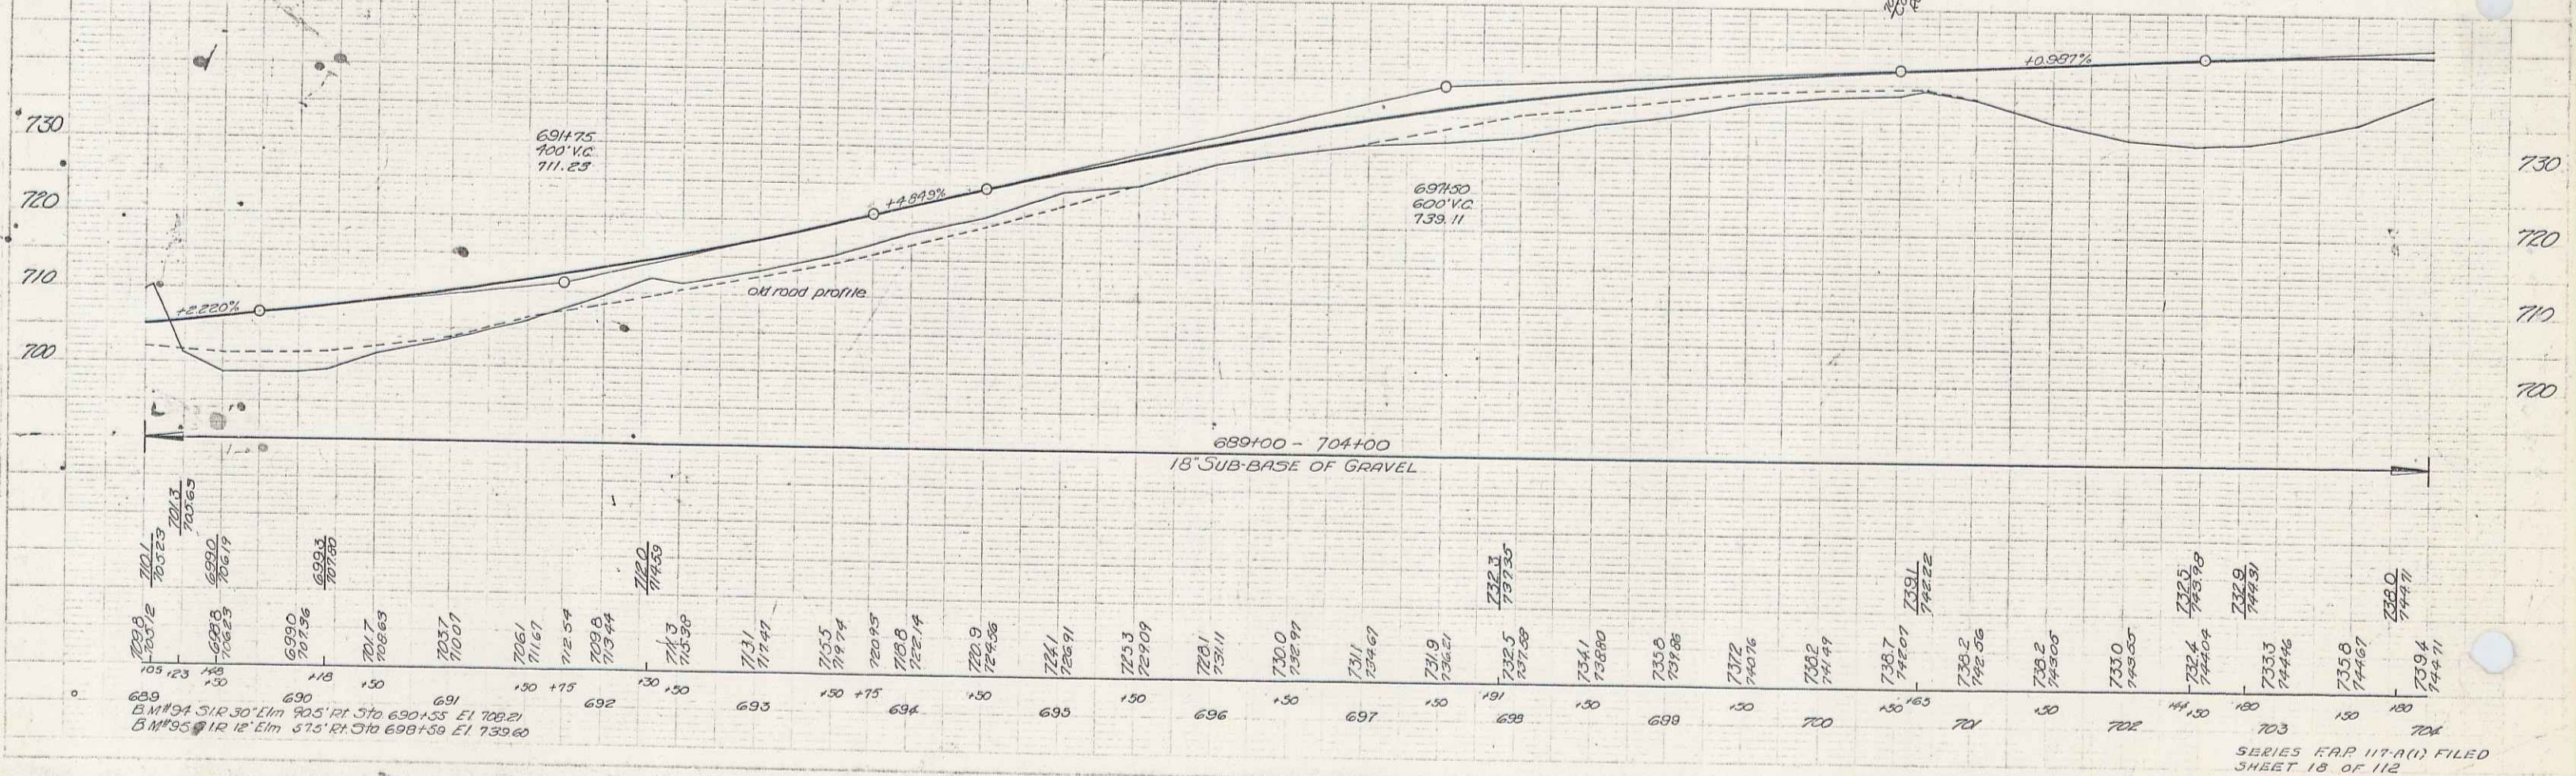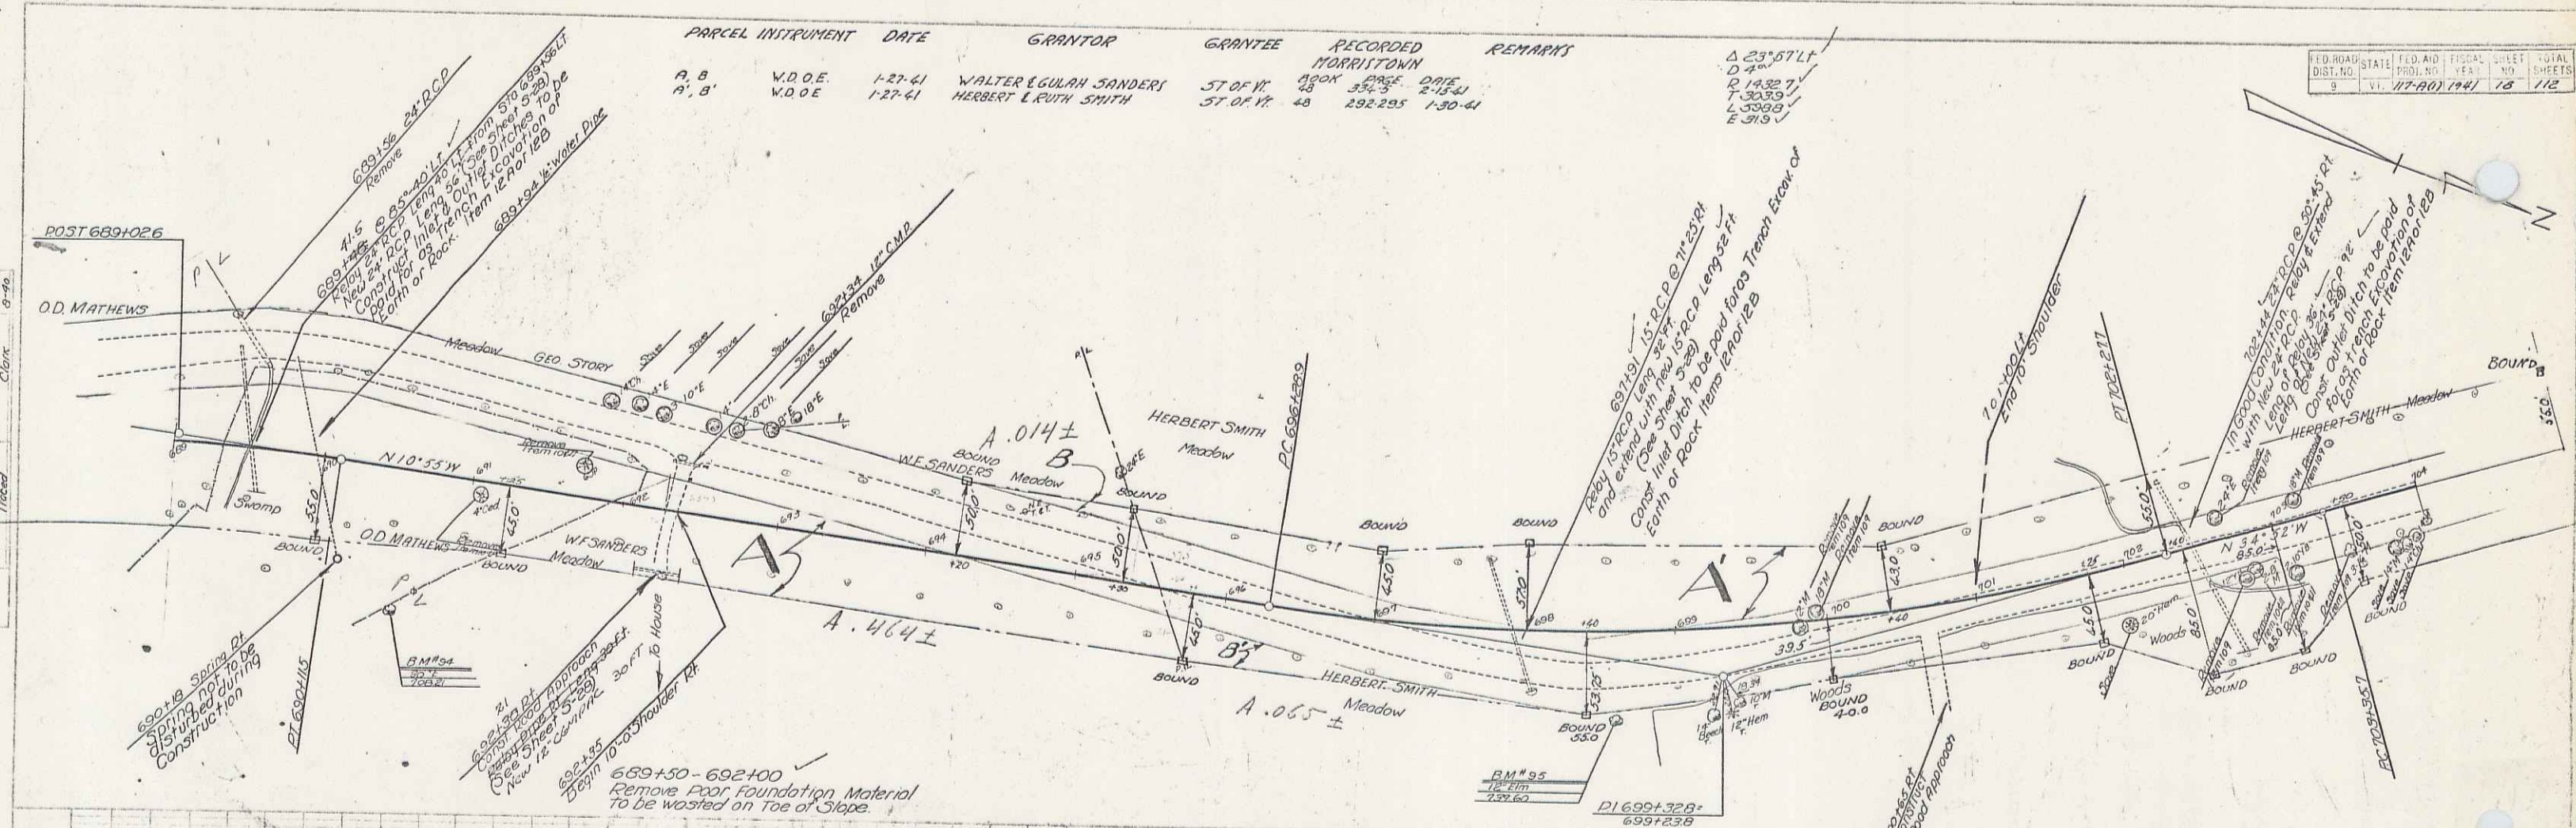


SERIES FAR 117-A(1) FILED
SHEET 18 OF 112

FED. ROAD DIST. NO.	STATE	FED. AID PROJ. NO.	FISCAL YEAR	SHEET NO.
9	VT.	117A(6)	1941	19

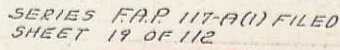

PARCEL	INSTRUMENT	DATE	GRANTOR	GRANTEE	RECORDED	REMARKS
					MORRISON 'N	
D.E.	W.D.O.E.	1-27-61	HERBERT & RUTH SMITH	57 OF 17	BOOK PAGE DATE 48 292-295	1-30-61
A	W.D.O.E.	1-27-61	HECTOR & MARION BAILEY	57 OF 17	48 280-1	1-30-61

DIST. NO.	STATE	PROJ. NO.	YEAR	NO.	SHEET
9	VI.	117-A(1)	1941	20	112

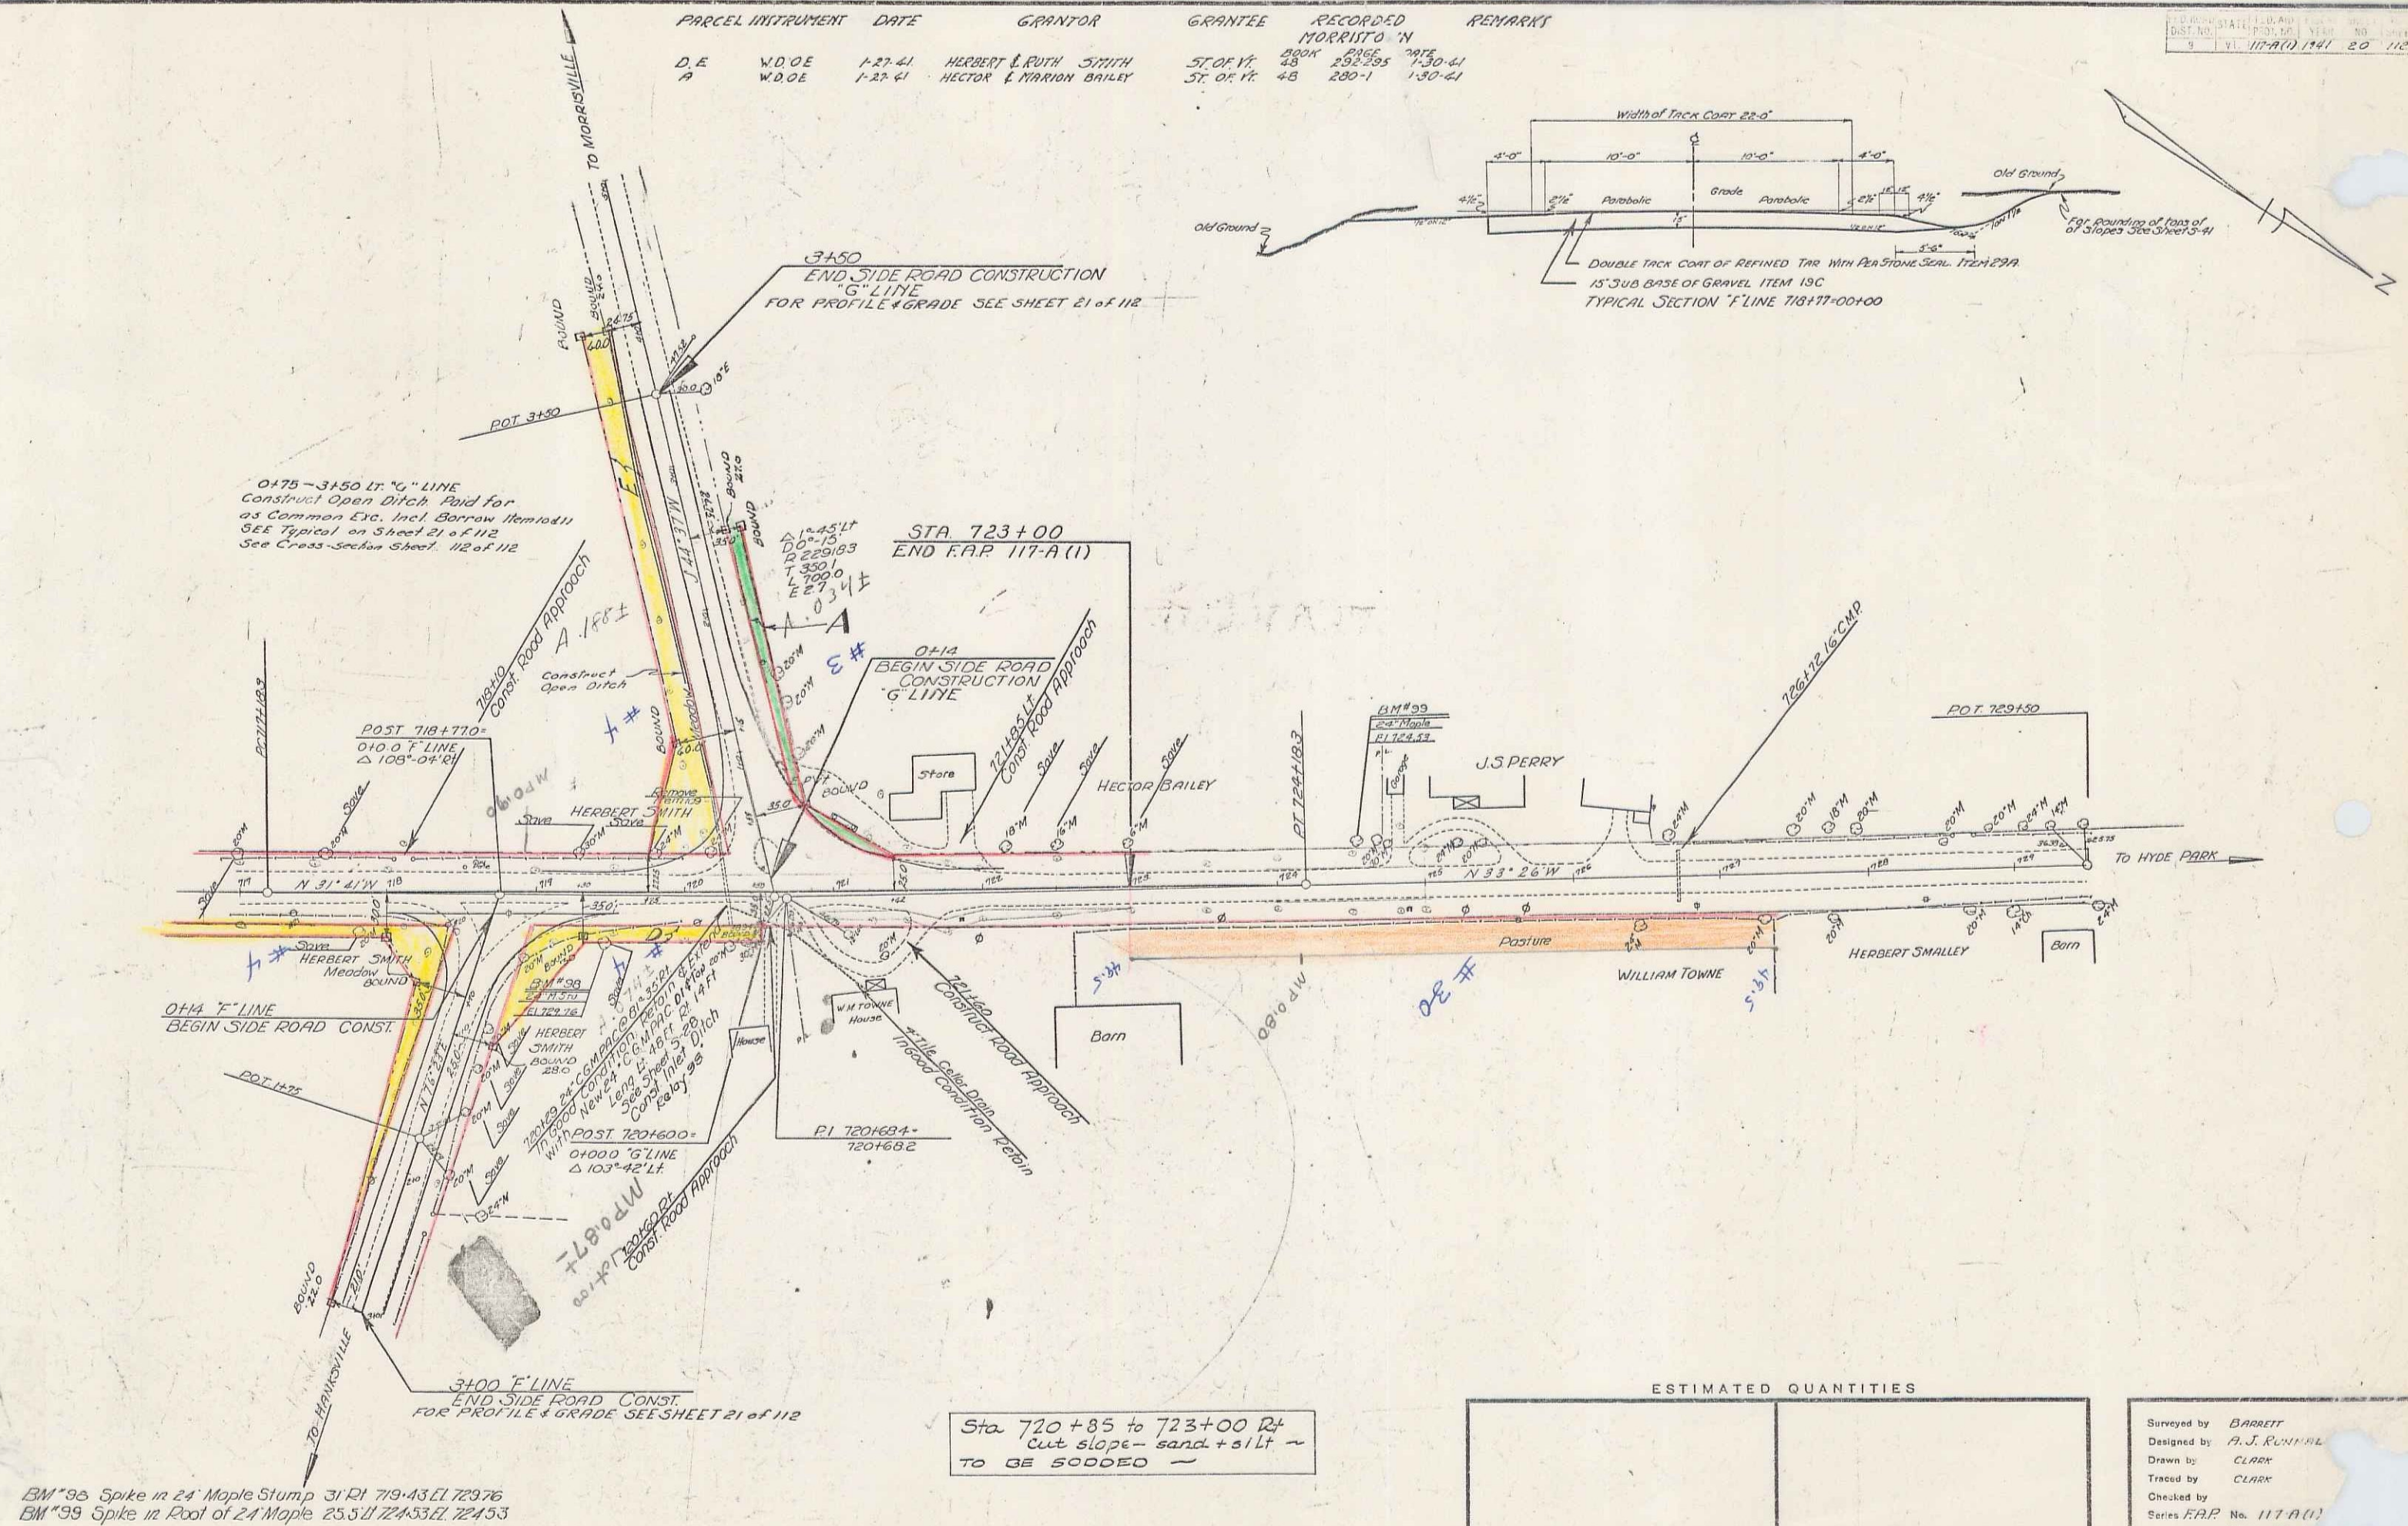

Sta 720+85 to 723+00 Rt
cut slope - sand + silt ~
TO BE SODDED ~

ESTIMATED QUANTITIES

Surveyed by *BARRETT*
Designed by *A. J. RUNNEL*
Drawn by *CLARK*
Traced by *CLARK*
Checked by
Series *F.A.P.* No. *117A(1)*
Sheet *20* of *117*