


P-16	F.S. BARRETT C.F. LAYNE	5/14 5/16
	L.F. CONE	9/37
TRACED		

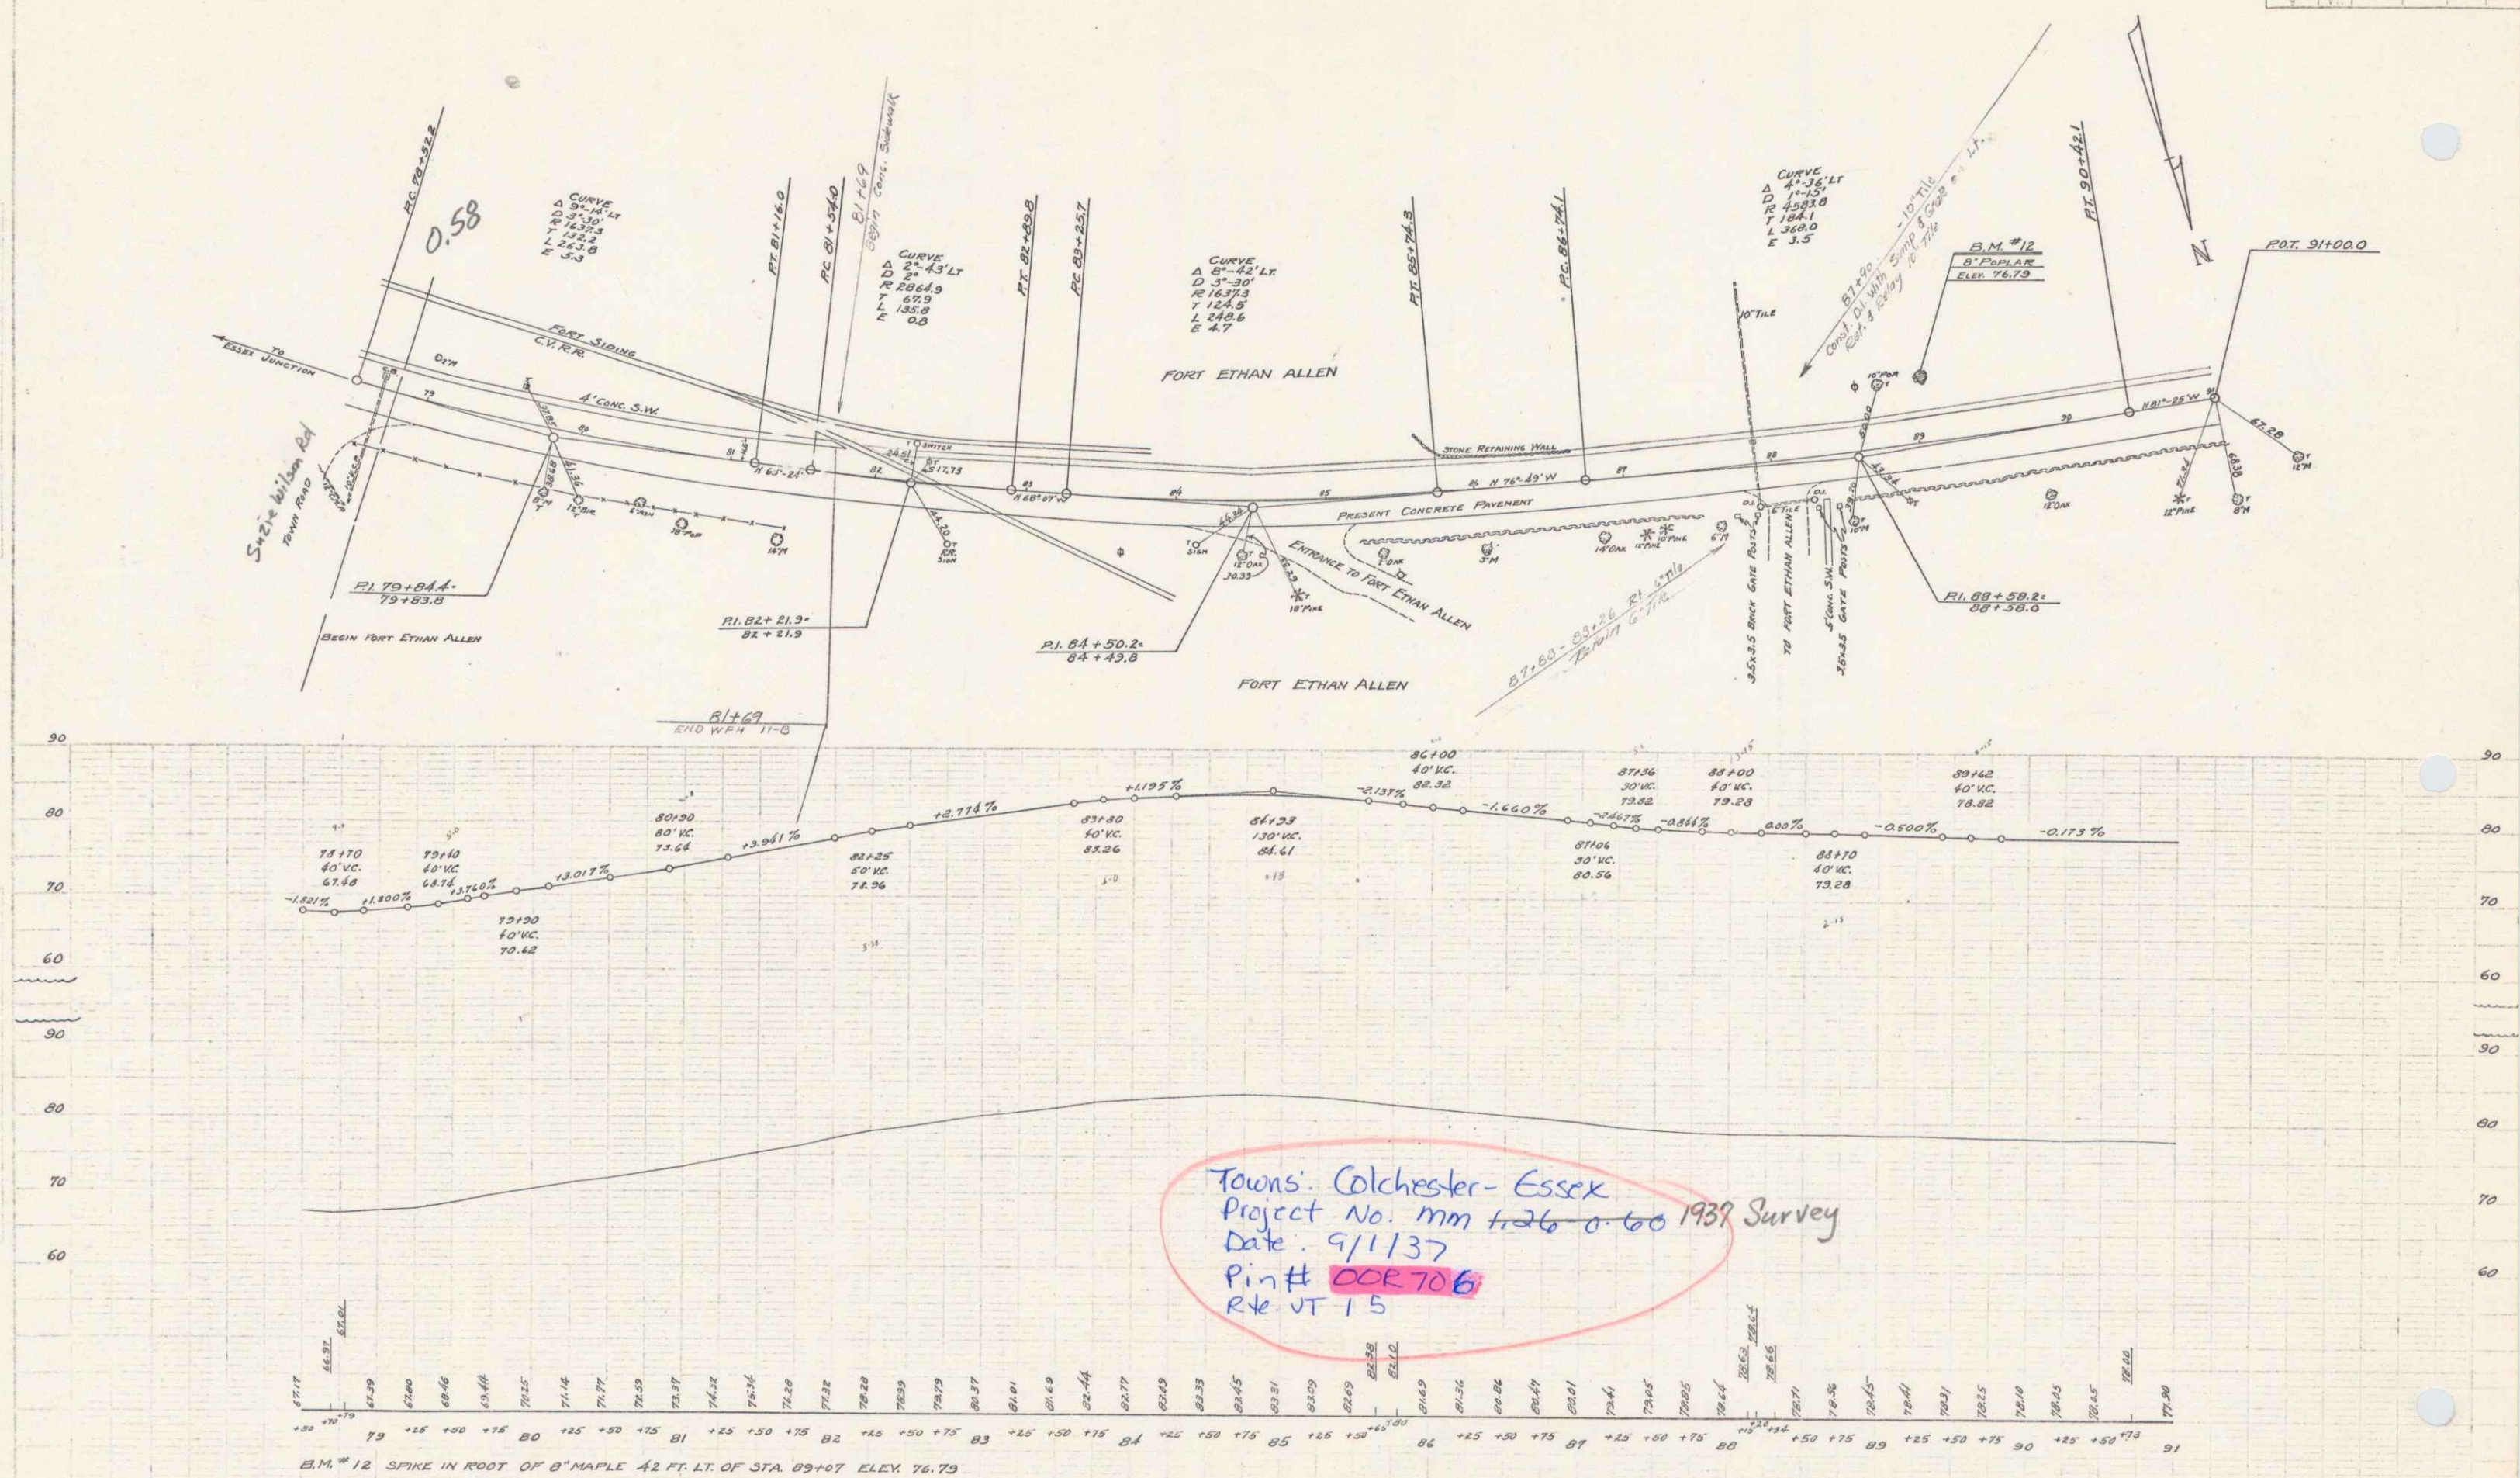

Towns: Colchester - Essex
Project No. mm ~~126~~ 0-60 1937 Survey
Date: 9/1/37
Pin # **000706**
Rte VT 15