
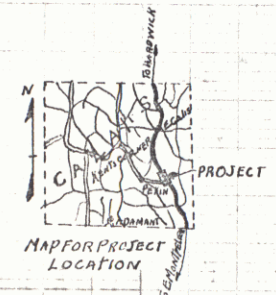


POOR ORIGINAL COPY

PARCEL	INSTRUMENT	DATE	GRANTOR	GRANTEE	RECORDED	REMARKS
C	W.DOE.	OCTOBER 25, 1910	LILY CLOUGH	STATE OF VT.	BOOK PAGE DATE	
A	W.DOE.	OCTOBER 25, 1910	GEORGE CLOUGH	STATE OF VT.	22 247 OCT 26, 1910	



BRIDGE	
CONC. BEAM	34.3'
OVERALL	31.0'
CL. SPAN	9.0'
CL. HEIGHT	22.0'
ROADWAY	22.0'

STATE			
DATE	FILE	NO.	REV.
1914-N	1910	1	20

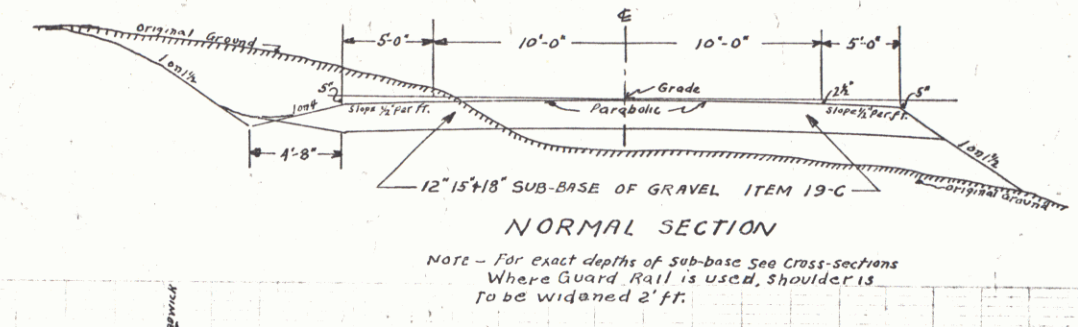

- INDEX OF SHEETS
- 1-4 LAYOUTS
 - 5 BANKING + WIDENING TABLES
 - 6 STANDARD STRUCTURE SHEET S-28 PIPE CULVERTS
 - 7 " " " " S-30 GUARD RAIL
 - 8 " " " " S-40 BARRICADES, SIGN, + LIGHTS
 - 9-29 CROSS-SECTIONS

Town: Calais
Project No. ST. 144-N
Date: 1/1/14
Rte. VT 14
Pin # 00R 757

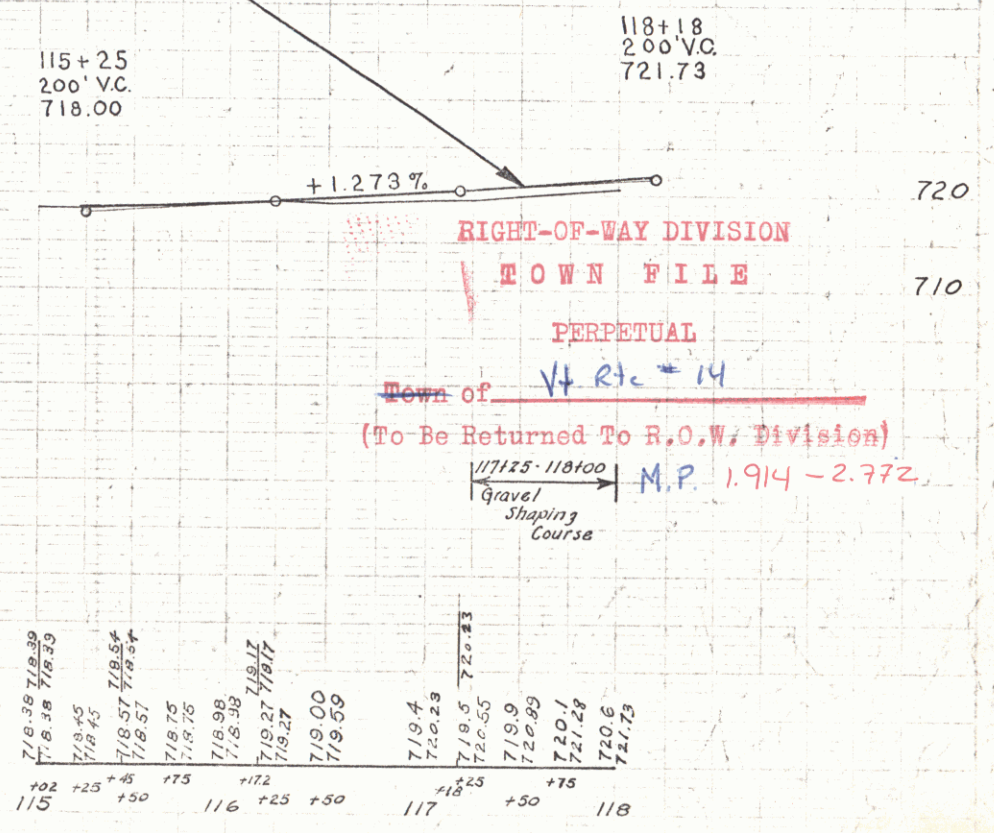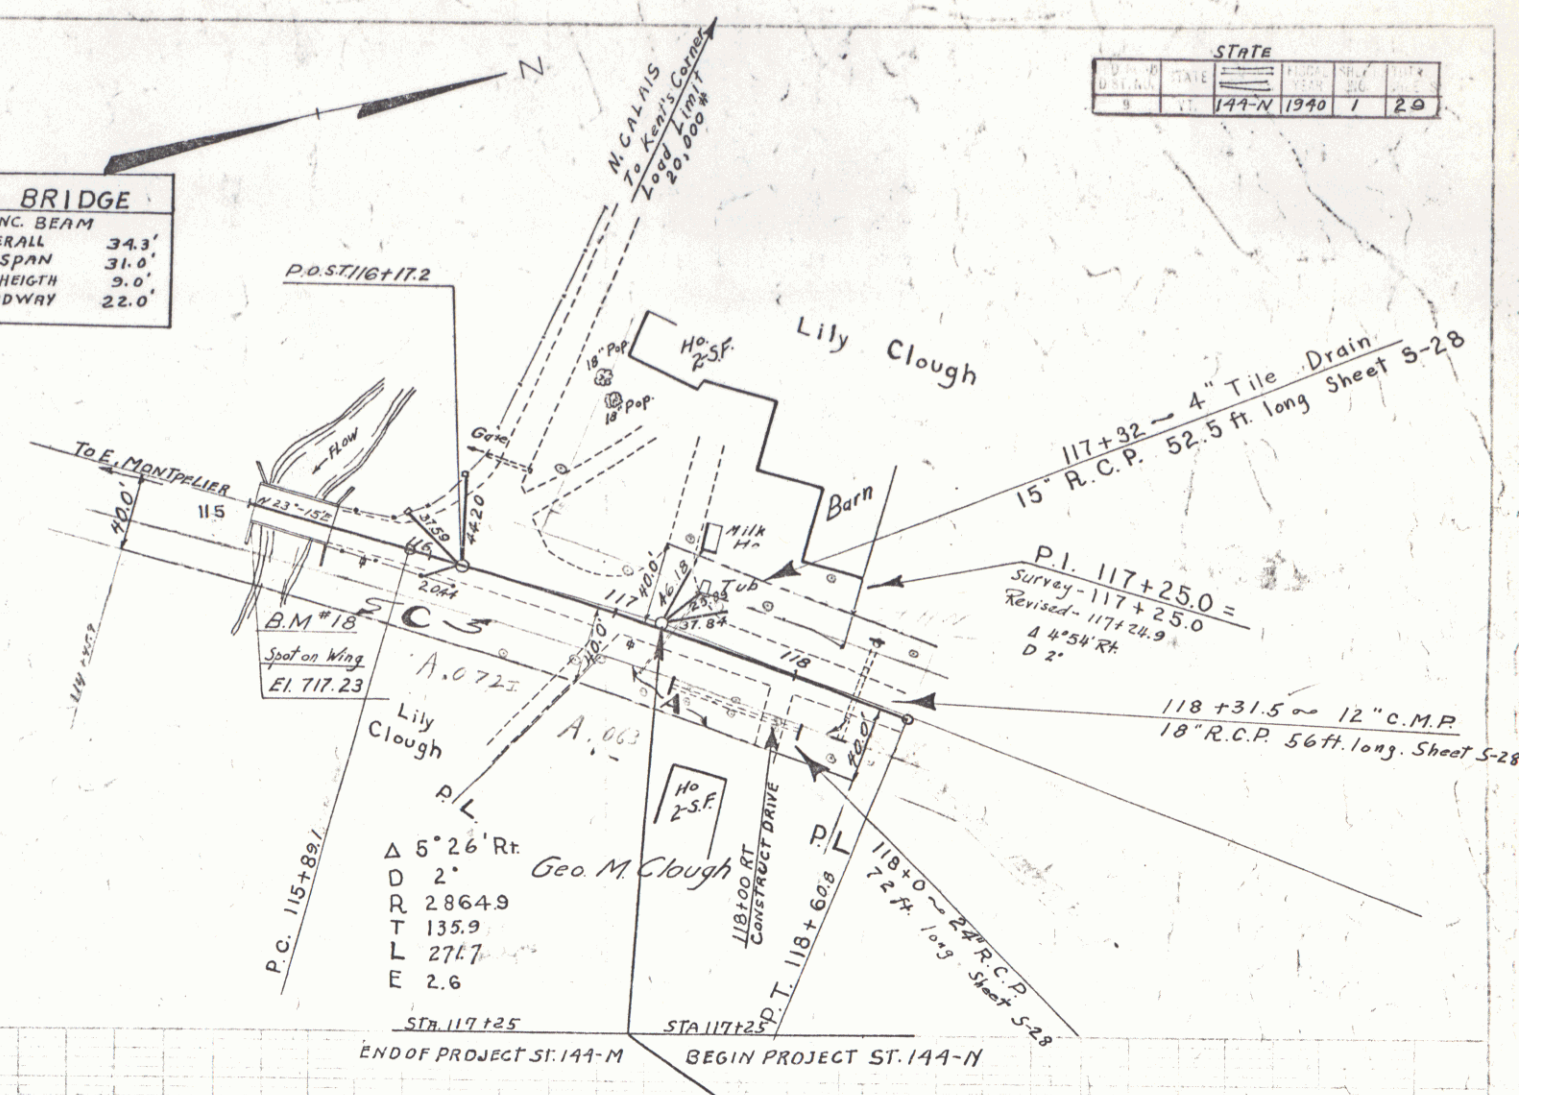

115+25 - Spot Elevation 12" R.C.P. 50' 115+102 Elev. 717.23