



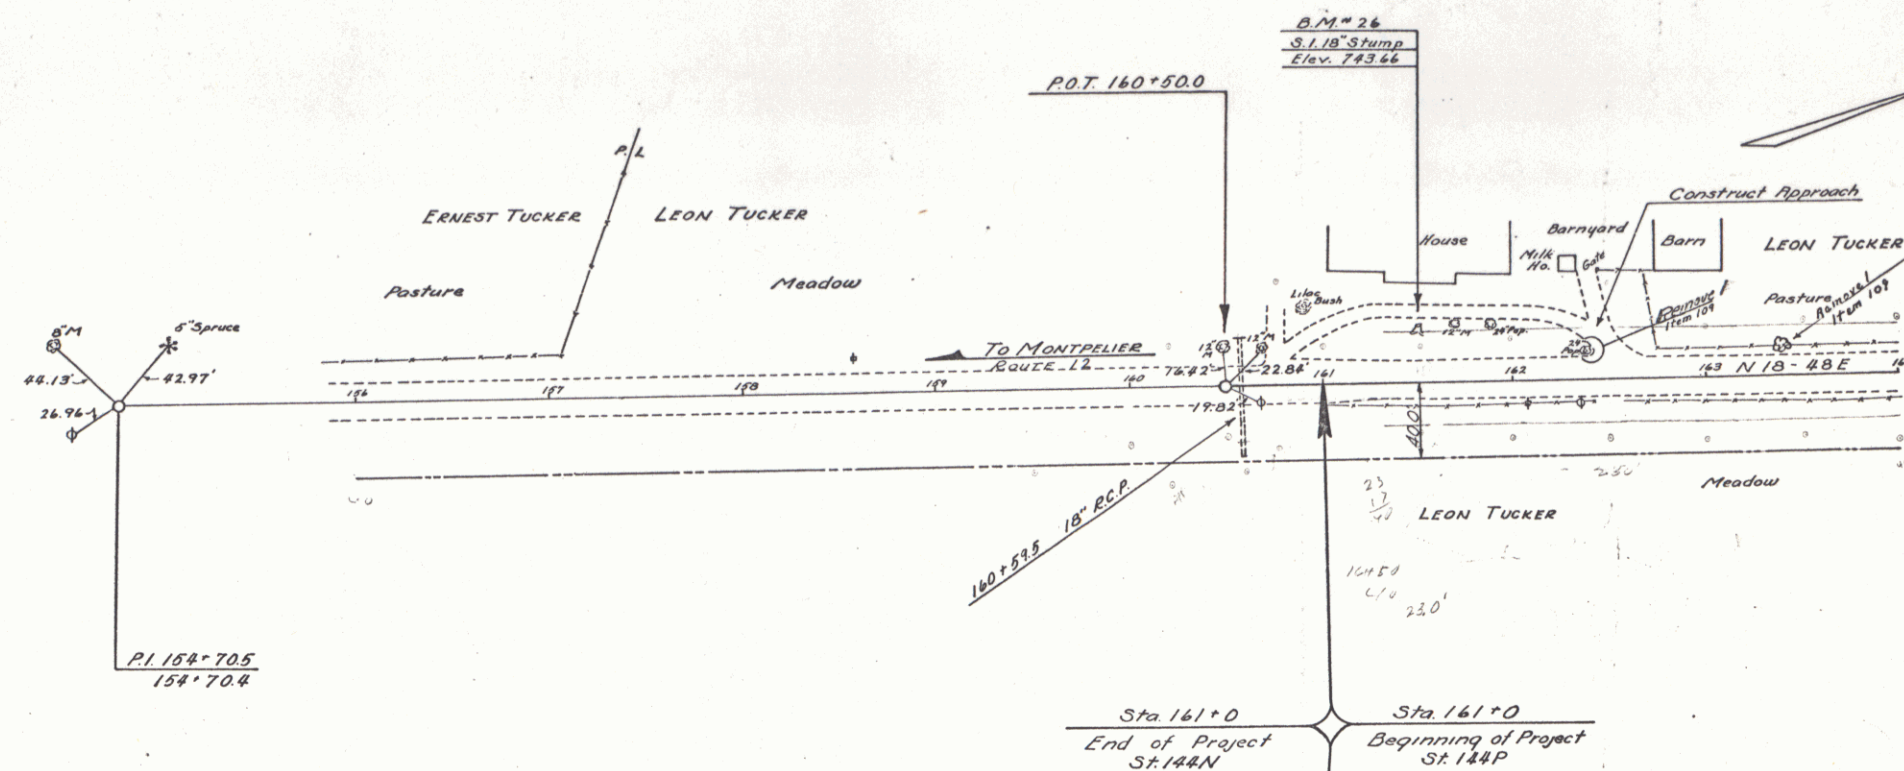

PARCEL	INSTRUMENT	DATE	GRANTOR	GRANTEE	RECORDED BOOK PAGE DATE	REMARKS
--------	------------	------	---------	---------	-------------------------	---------

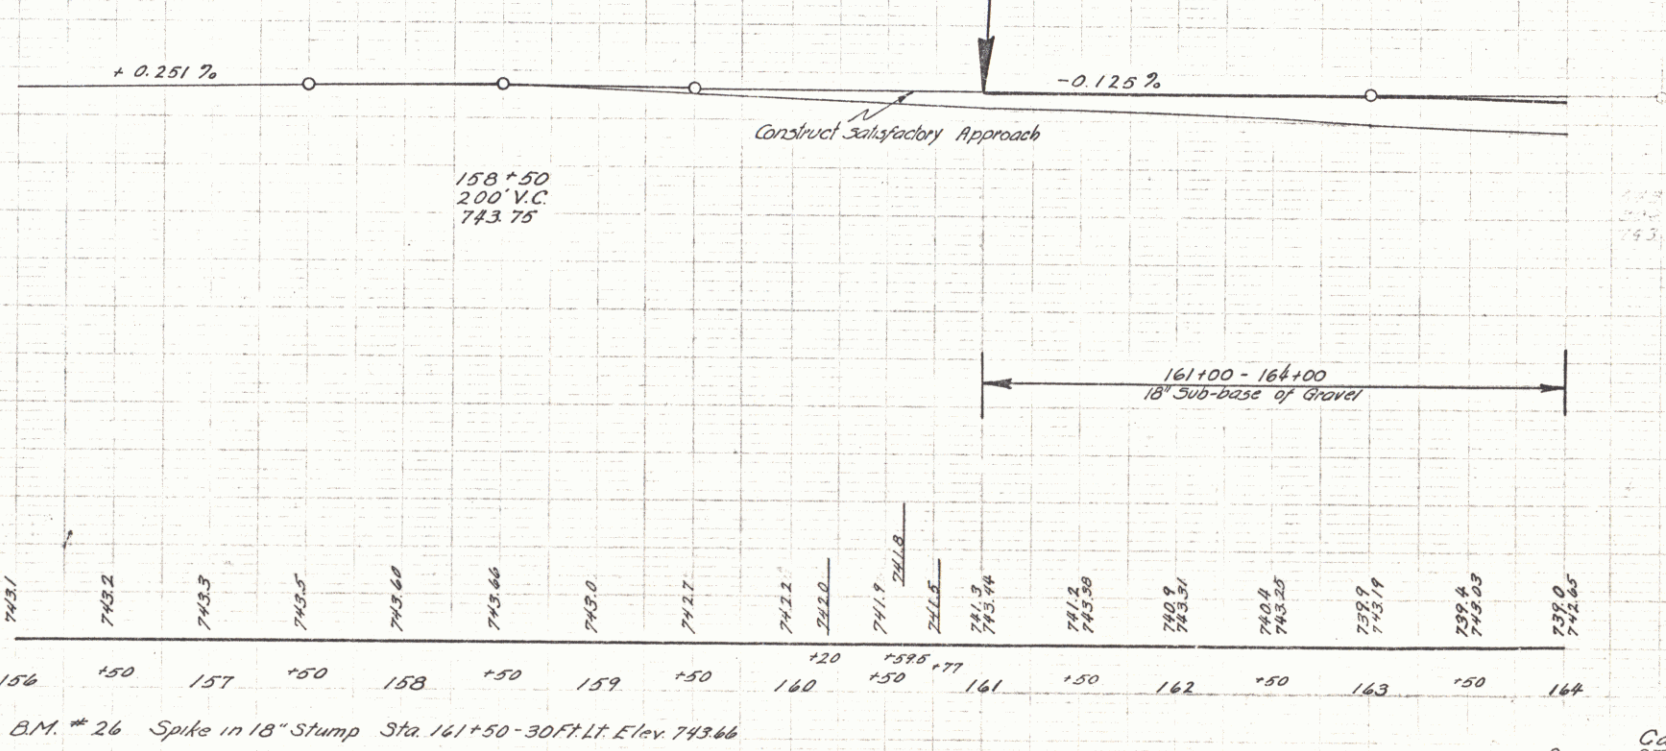

743.1	743.2	743.3	743.5	743.6	743.6	743.0	742.7	742.2	741.9	741.8	741.9	743.4	741.2	743.2	743.1	743.2	739.9	743.1	739.8	743.2	739.0	742.6
156	150	157	150	158	150	159	150	160	150	159	161	150	162	150	163	150	164					

B.M. # 26 Spike in 18" Stump Sta 161+50 - 30 Ft. Lt. Elev. 743.66

Series Galais
ST. No. 144P
Sheet 4 of 84 Sheets