

INDEX OF SHEETS		
SHEET NO.	TITLE PAGE	
1	TYPICAL CROSS-SECTION OF IMPROVEMENT	DOUBLE TACK COAT OF REFINED TAR WITH PEA STONE SEAL, ITEM 29 A
2	BANKING AND WIDENING TABLES	
3	PLAN AND PROFILE	
4	15 CORRUGATED GALVANIZED PLATE ARCH	14'7"-52' LONG
5	16 STANDARD STRUCTURE SHEET	S 28 PIPE CULVERTS
6	17	S 30A BOUNDARY MARKERS ETC.
7	18	S 40 BARRICADES, SIGNS & LIGHTS
8	19	S 41 ROUNDING OF SLOPES
9	20	S49-46 SPRING MOUNTED PANEL TYPE GUARD RAIL WITH STEEL POSTS
10	21	SB 11 BARRICADES, SIGNS & LIGHTS
11	22-27 CROSS SECTION SHEETS	
12	20A STANDARD STRUCTURE SHEET	S52-48 STEEL BEAM GUARD RAIL WITH STEEL POSTS (TYPE 1 FLEX BEAM)
13	20B	S51-48 STEEL BEAM GUARD RAIL WITH STEEL POSTS (TYPE 2 SAFETY BEAM)

STANDARD STRUCTURE SHEETS APPROVED BY THE CHIEF
ENGINEER VERMONT STATE DEPARTMENT OF HIGHWAYS

S 28 APRIL 26, 1941
S 30A APRIL 19, 1941
S 40 DEC. 18, 1945

STATE OF VERMONT
STATE HIGHWAY DEPARTMENT

PLAN AND PROFILE OF PROPOSED STATE HIGHWAY


SECONDARY PROJECT

TOWN OF HARDWICK Pin# 00R762

HARDWICK-CRAFTSBURY ROAD
VERMONT ROUTE 14

BEGINNING AT THE INTERSECTION OF VT. ROUTE 15 AND VT. ROUTE 12 B AND EXTENDING NORTHERLY 15394.9 FT.

LENGTH OF PROJECT 15394.9 FT. = 2.916 MILES

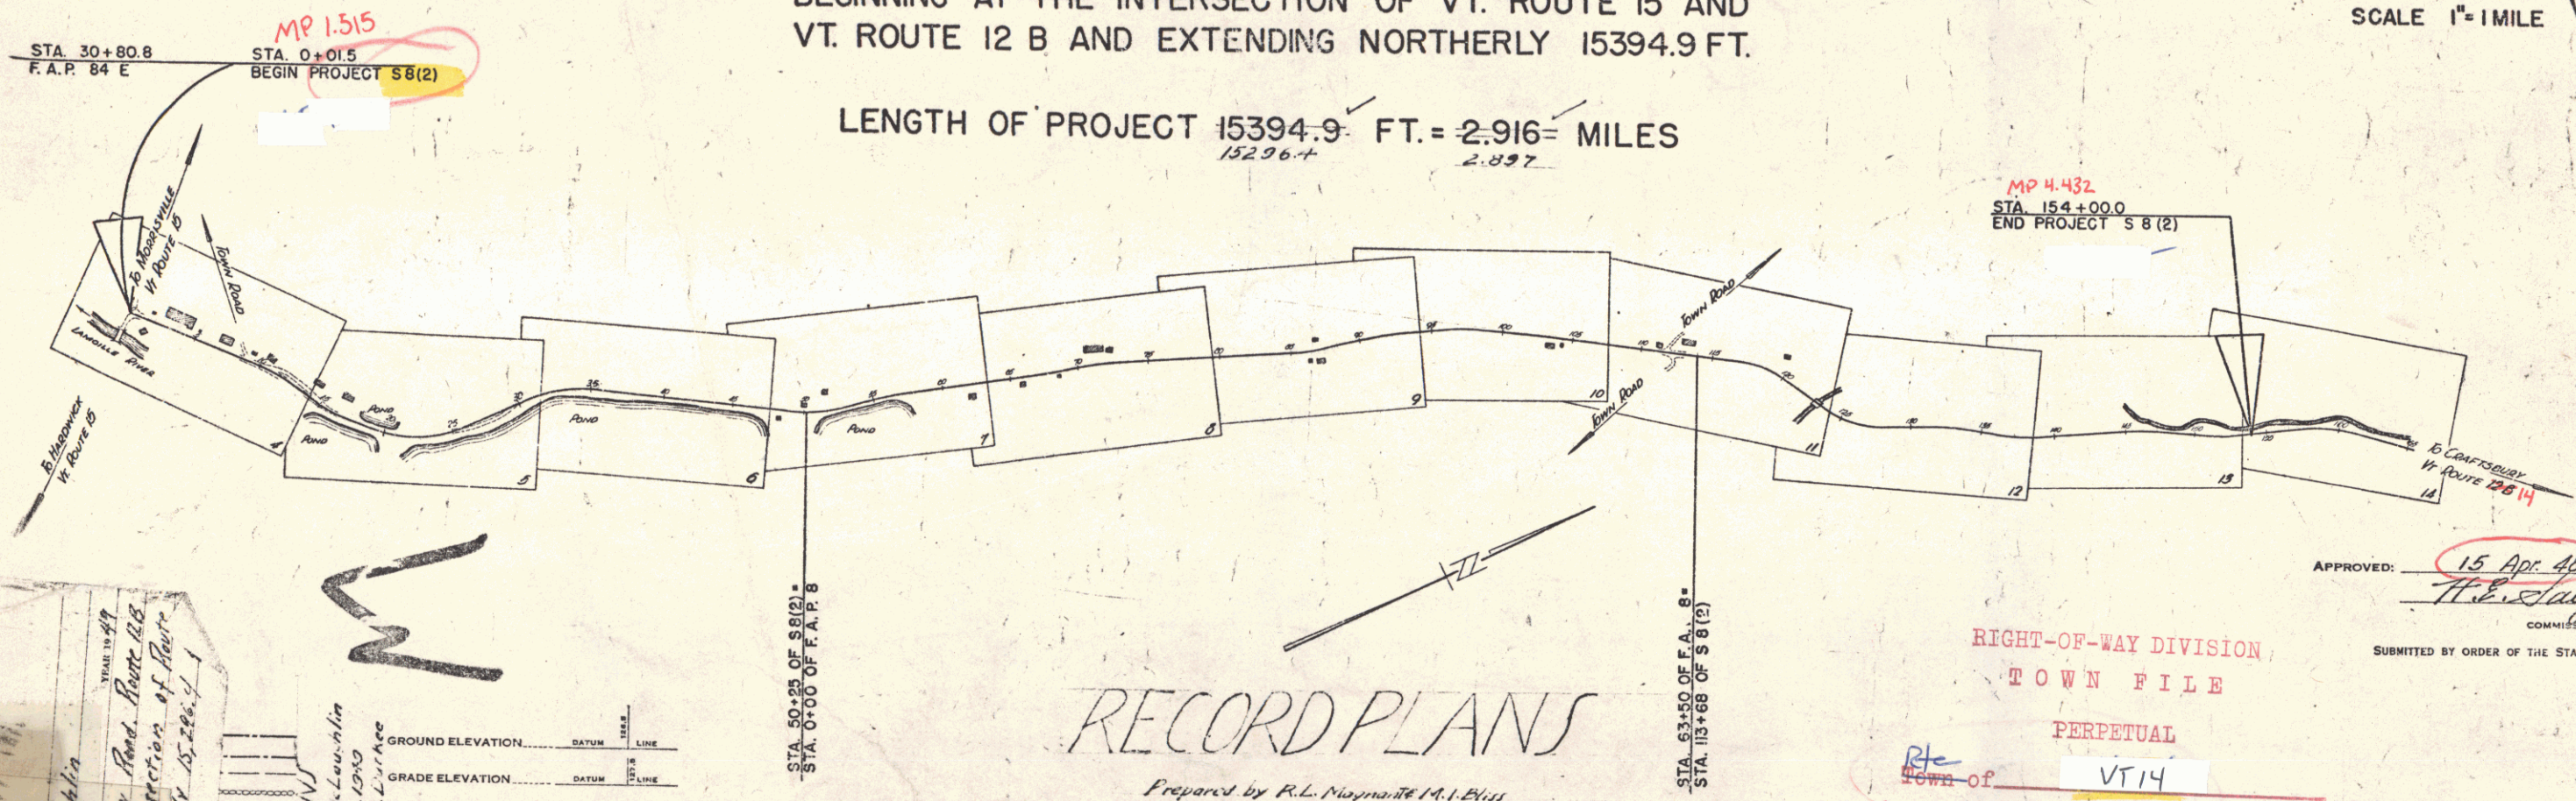

PROJECT: Hardwick VT-12-B
NUMBER: 1-102
DATE: March 2, 1947
LOCATION: Hardwick, Craftsbury Road, Route 14
Beginning at the intersection of Route 15 and extending northerly 15,394.9 ft.

CURVE DATA		
DEFLECTION ANGLE	DATE	TIME
DEGREE OF CURVE		
RADIUS OF CURVE		
TANGENT DISTANCE		
LENGTH OF CURVE		
EXTERNAL DISTANCE		
POINT OF INTERSECTION	P. I.	
POINT OF CURVE	P. C.	
POINT OF TANGENT	P. T.	
POINT ON TANGENT	P. O. T.	

SCALES		
TITLE	1" = 600'	
TYPICAL	1" = 2'	
PLAN	1" = 50'	
HORIZONTAL	1" = 50'	
PROFILE	1" = 10'	
CROSS SECTIONS	1" = 5'	

RECORD PLANS

Prepared by R.L. Magnum & M.I. Bliss
Resident Engineer - John A. Durfee


RIGHT-OF-WAY DIVISION
TOWN FILE
PERPETUAL
Form of VT 14
(To Be Returned To R.O.W. Division)

THESE PLANS ARE SUBJECT TO SUCH REVISIONS AS MAY BE REQUIRED BY THE PUBLIC ROADS ADMINISTRATION OR THE COMMISSIONER OF HIGHWAYS.


CONSTRUCTION IS TO BE CARRIED ON IN ACCORDANCE WITH THE PLANS AND THE STANDARD ROAD AND BRIDGE SPECIFICATIONS OF 1936, AS APPROVED DECEMBER 29TH, 1936 BY THE PUBLIC ROADS ADMINISTRATION, INCLUDING ALL SUBSEQUENT APPROVED REVISIONS AND SUCH REVISED SPECIFICATIONS AND SPECIAL PROVISIONS AS ARE SUBMITTED WITH THE PLANS.

APPROVED: *[Signature]* DISTRICT HIGHWAY COMMISSIONER
APPROVED: *[Signature]* DISTRICT HIGHWAY COMMISSIONER
SERIES F S No 8(2) FILED
SHEET 1 OF 47

FED. ROAD DIST. NO.	STATE	PROJECT NO.	FISCAL YEAR	SHEET NO.	TOTAL SHEETS
9	VT.	8(2)	1947	1	47

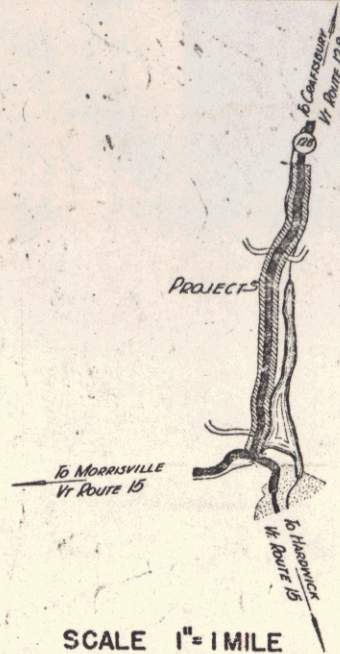

BEING PART OF THE LAND ACQUIRED BY
THE STATE OF VERMONT BY WD FROM
GORDON PIERCE APPLEBY AND STELLA
ROSAMOND APPLEBY DATED 4/13/83 AND
RECORDED 4/28/83 IN BK 68, PG 460-62
OF HARDWICK LAND RECORDS.

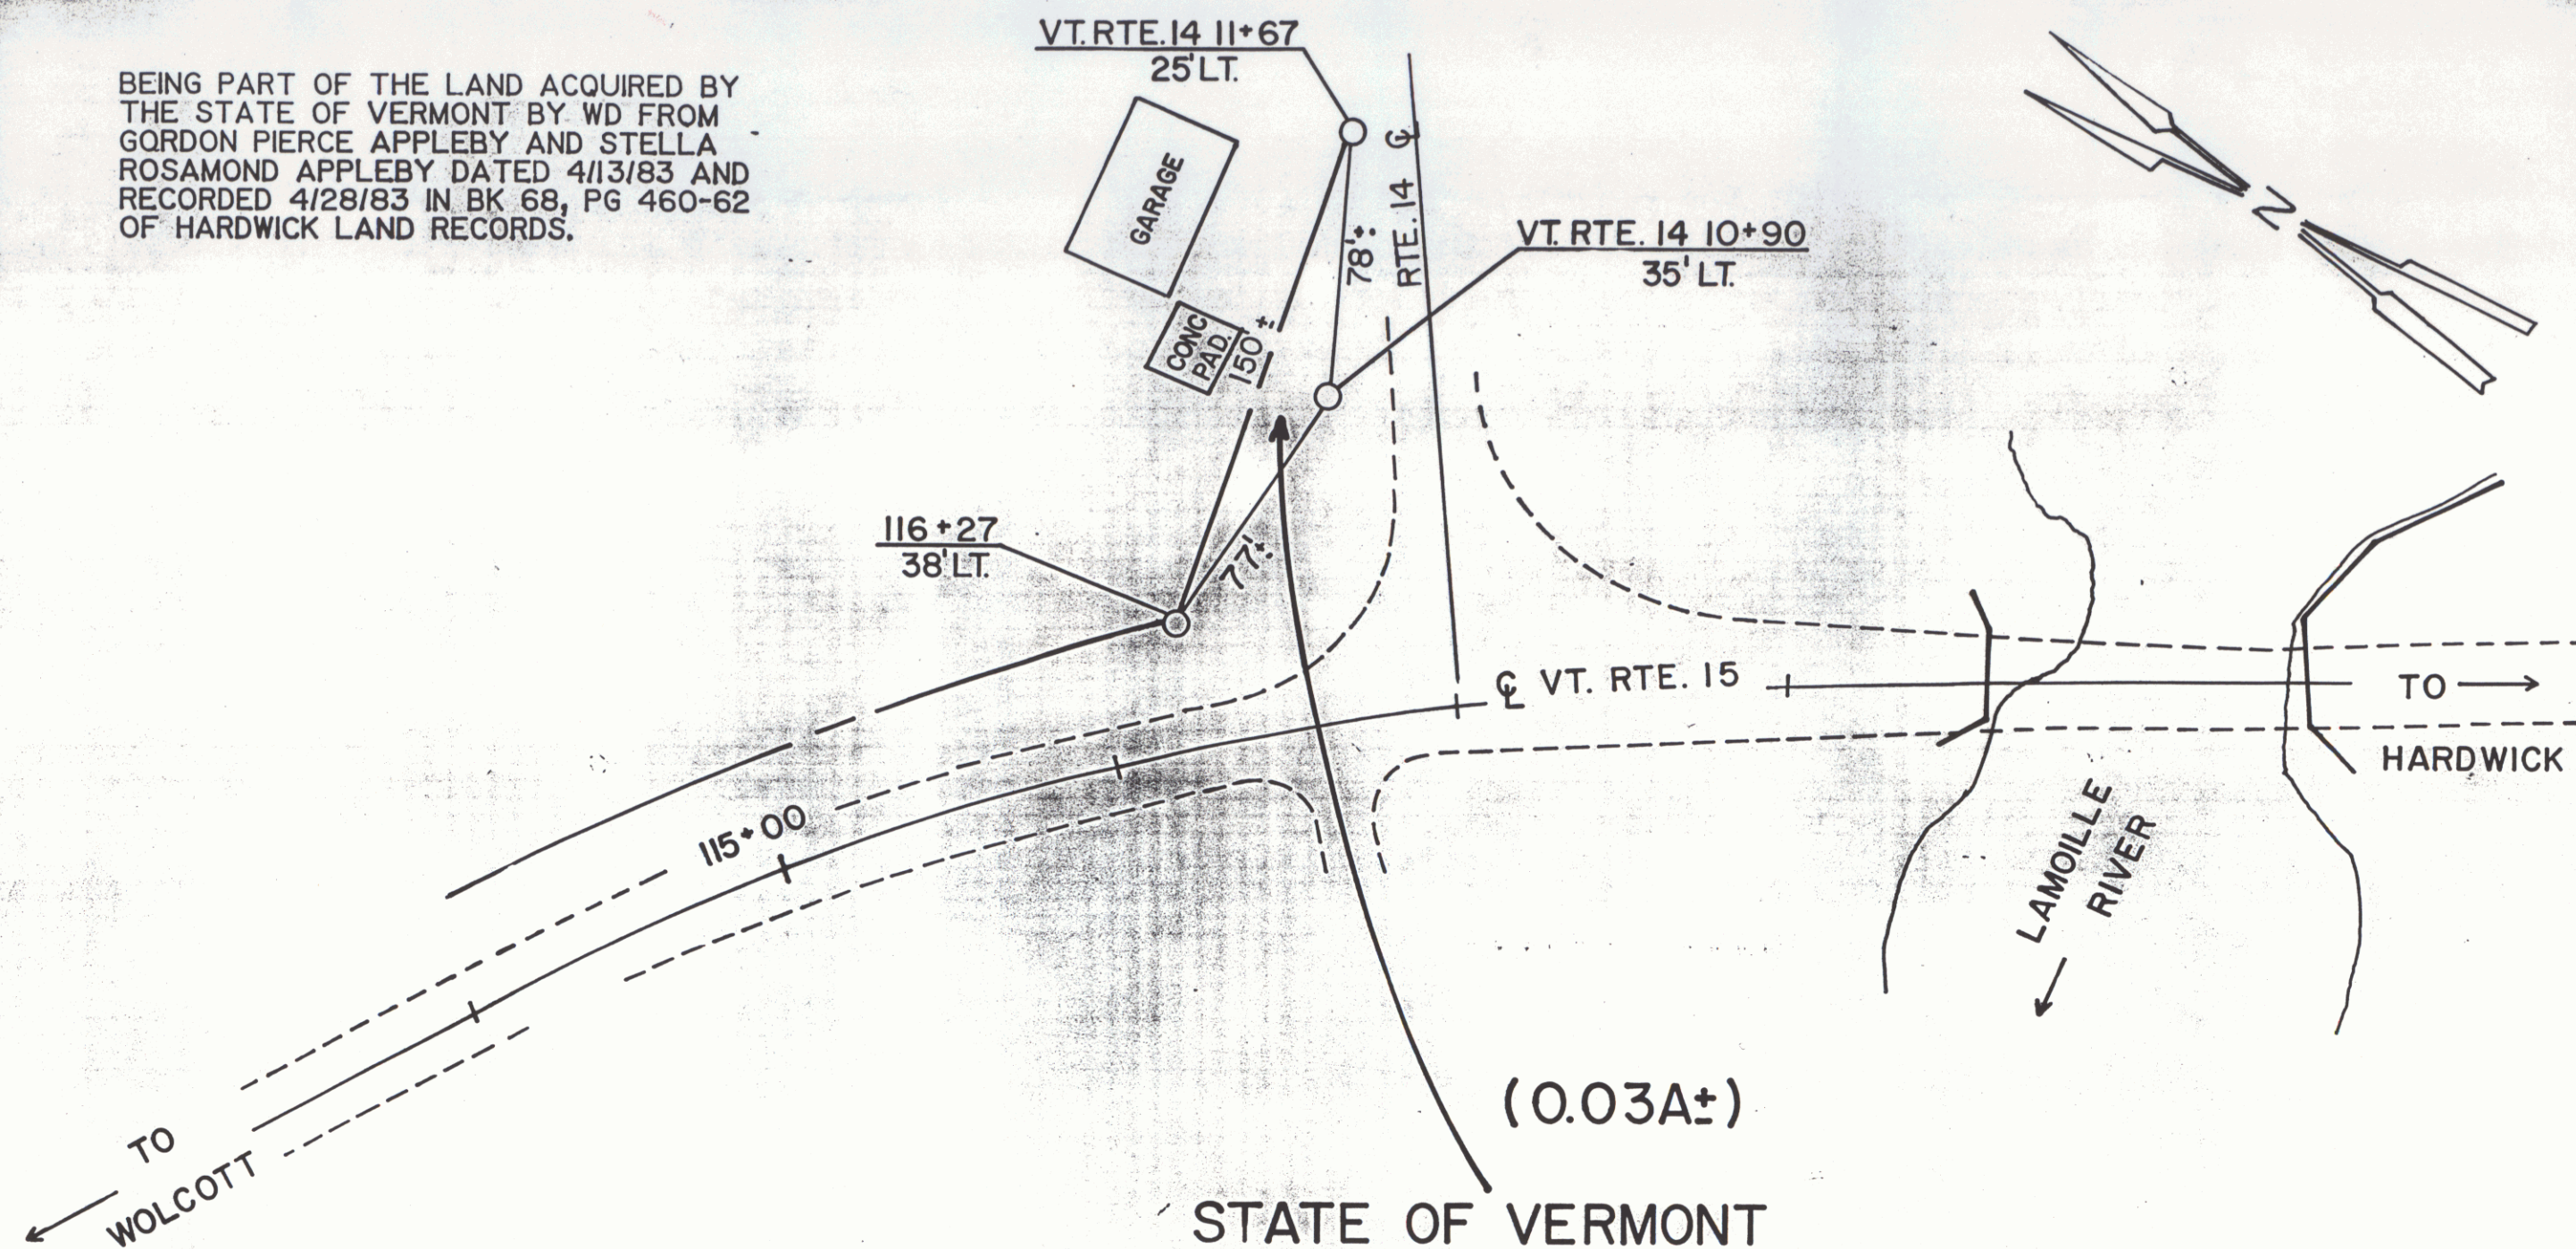


(0.03A±)
STATE OF VERMONT
TO
GORDON PIERCE APPLEBY
& STELLA ROSAMOND APPLEBY



RF: BRP 030-2(5)S V44 VT 15

STATE OF VERMONT
AGENCY OF TRANSPORTATION

SHEET 4A

TOWN OF HARDWICK

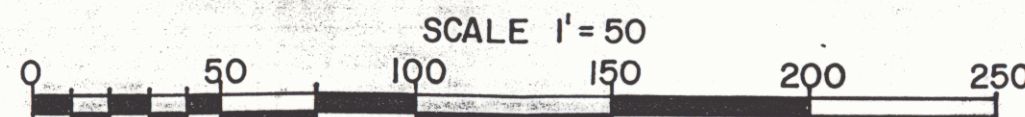


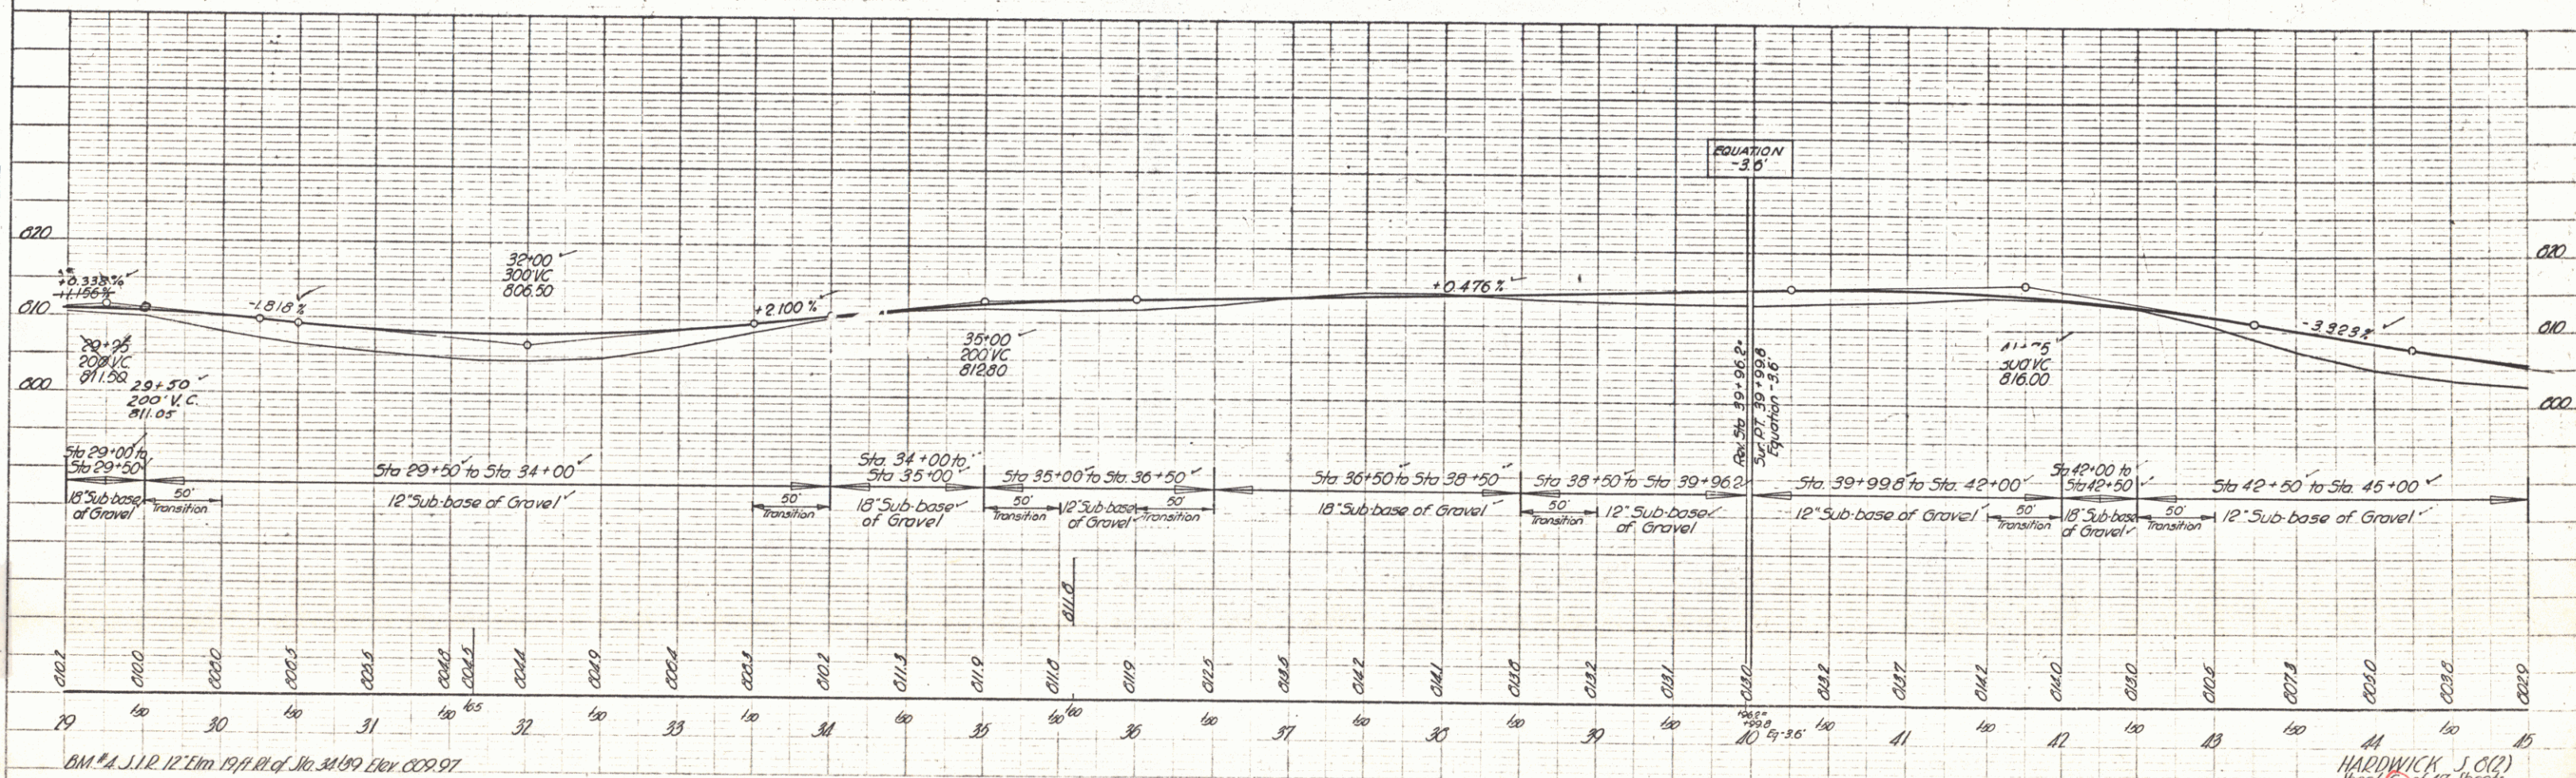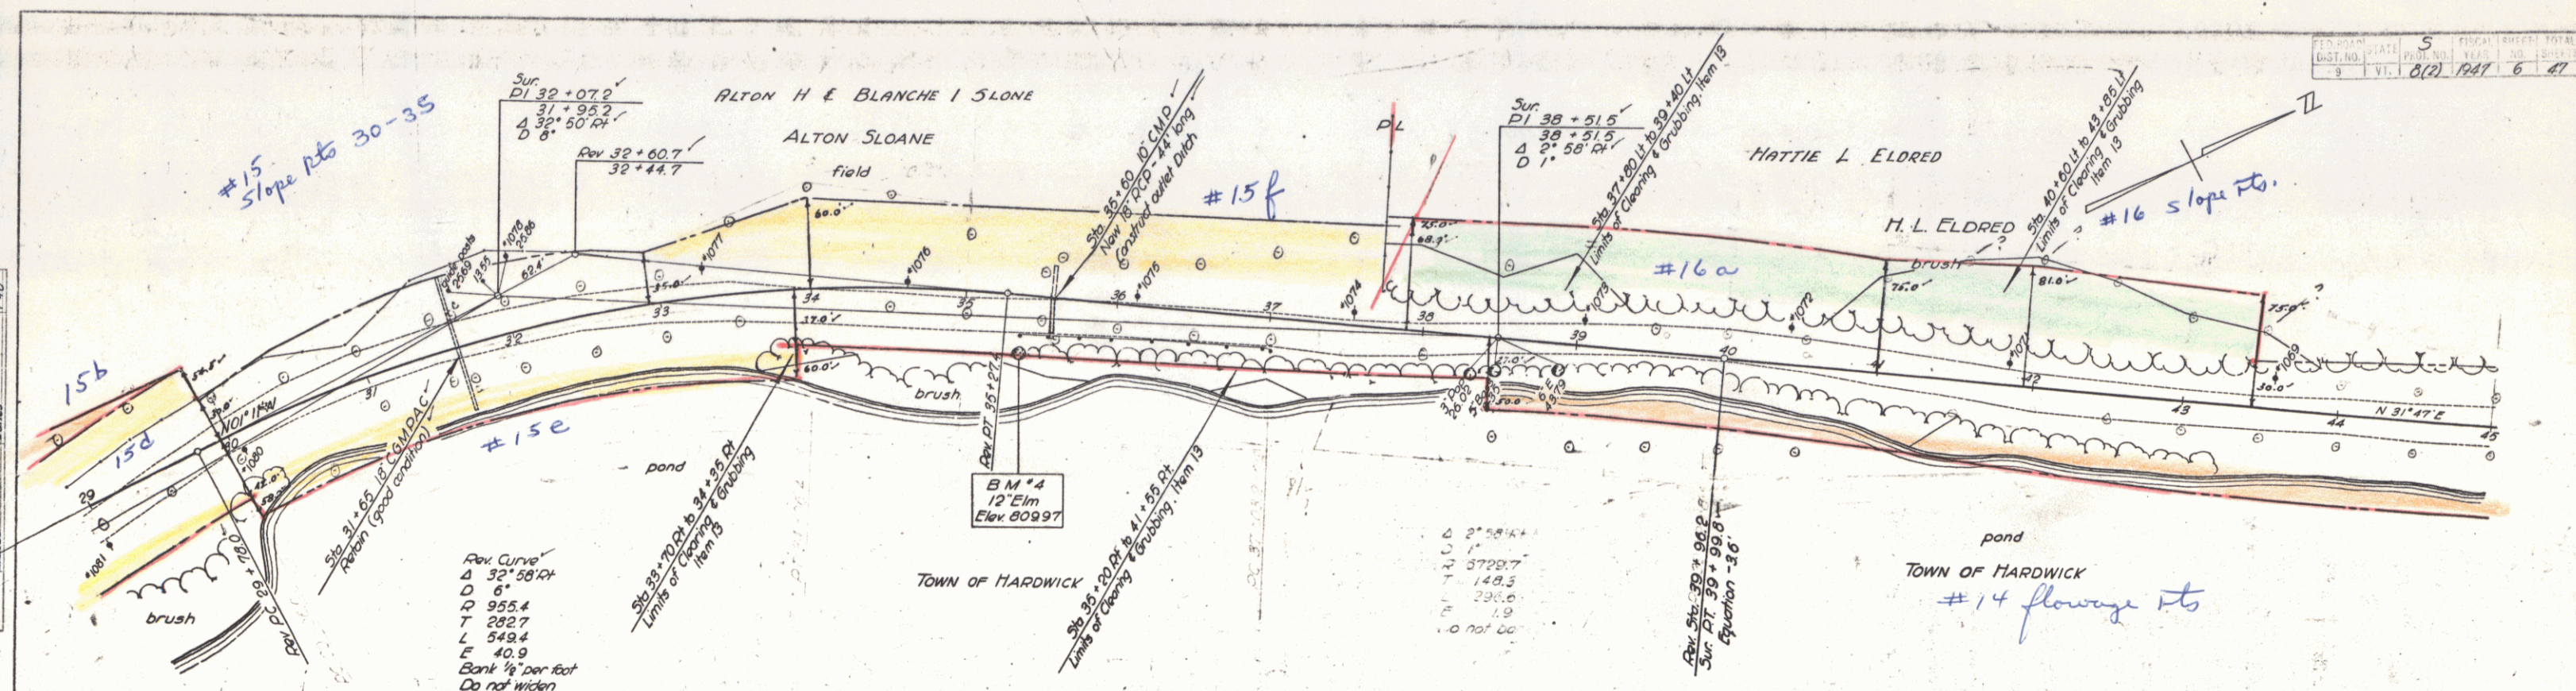

HARDWICK 58(2)
Sheet 6 of 47 Sheets

PLAN
 9-27-48
 NOTE BOOK
 1-18

PROFILE
 9-27-48
 NOTE BOOK
 1-18

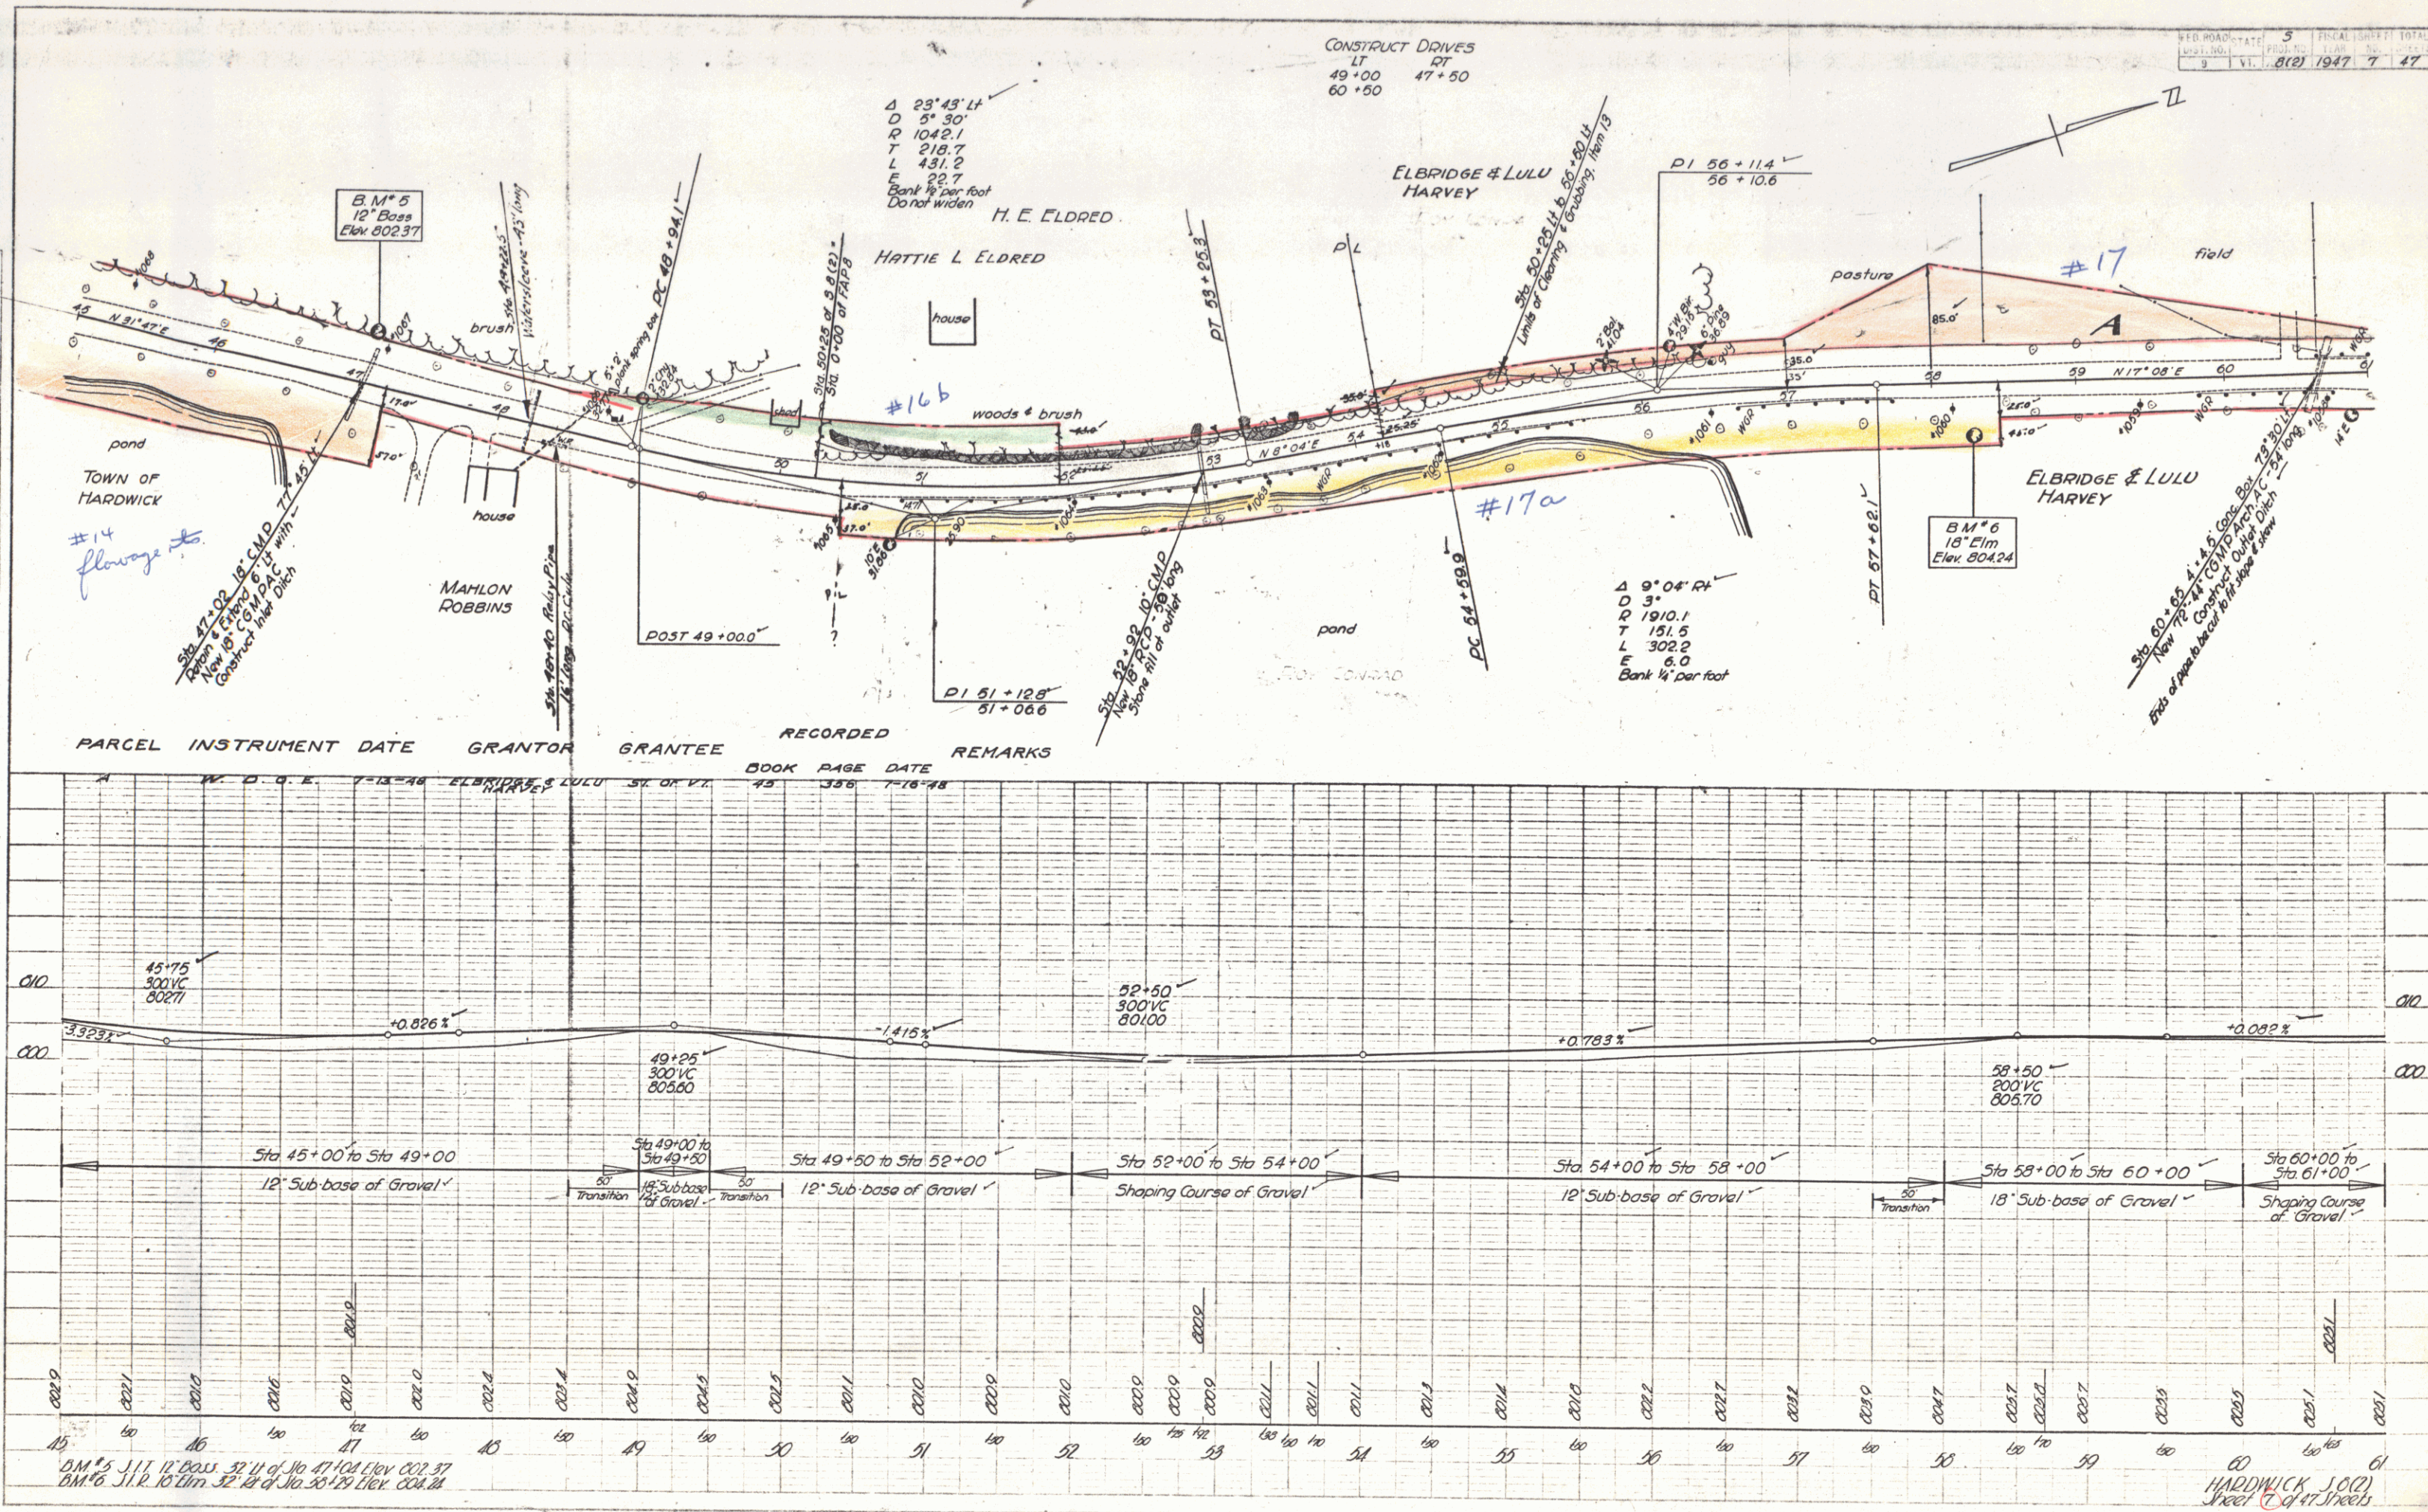

PLAN	DATE	BY	CHECKED
9-17	9-17	9-17	9-17
9-17	9-17	9-17	9-17
9-17	9-17	9-17	9-17
9-17	9-17	9-17	9-17

PROFILE	DATE	BY	CHECKED
9-17	9-17	9-17	9-17
9-17	9-17	9-17	9-17
9-17	9-17	9-17	9-17
9-17	9-17	9-17	9-17



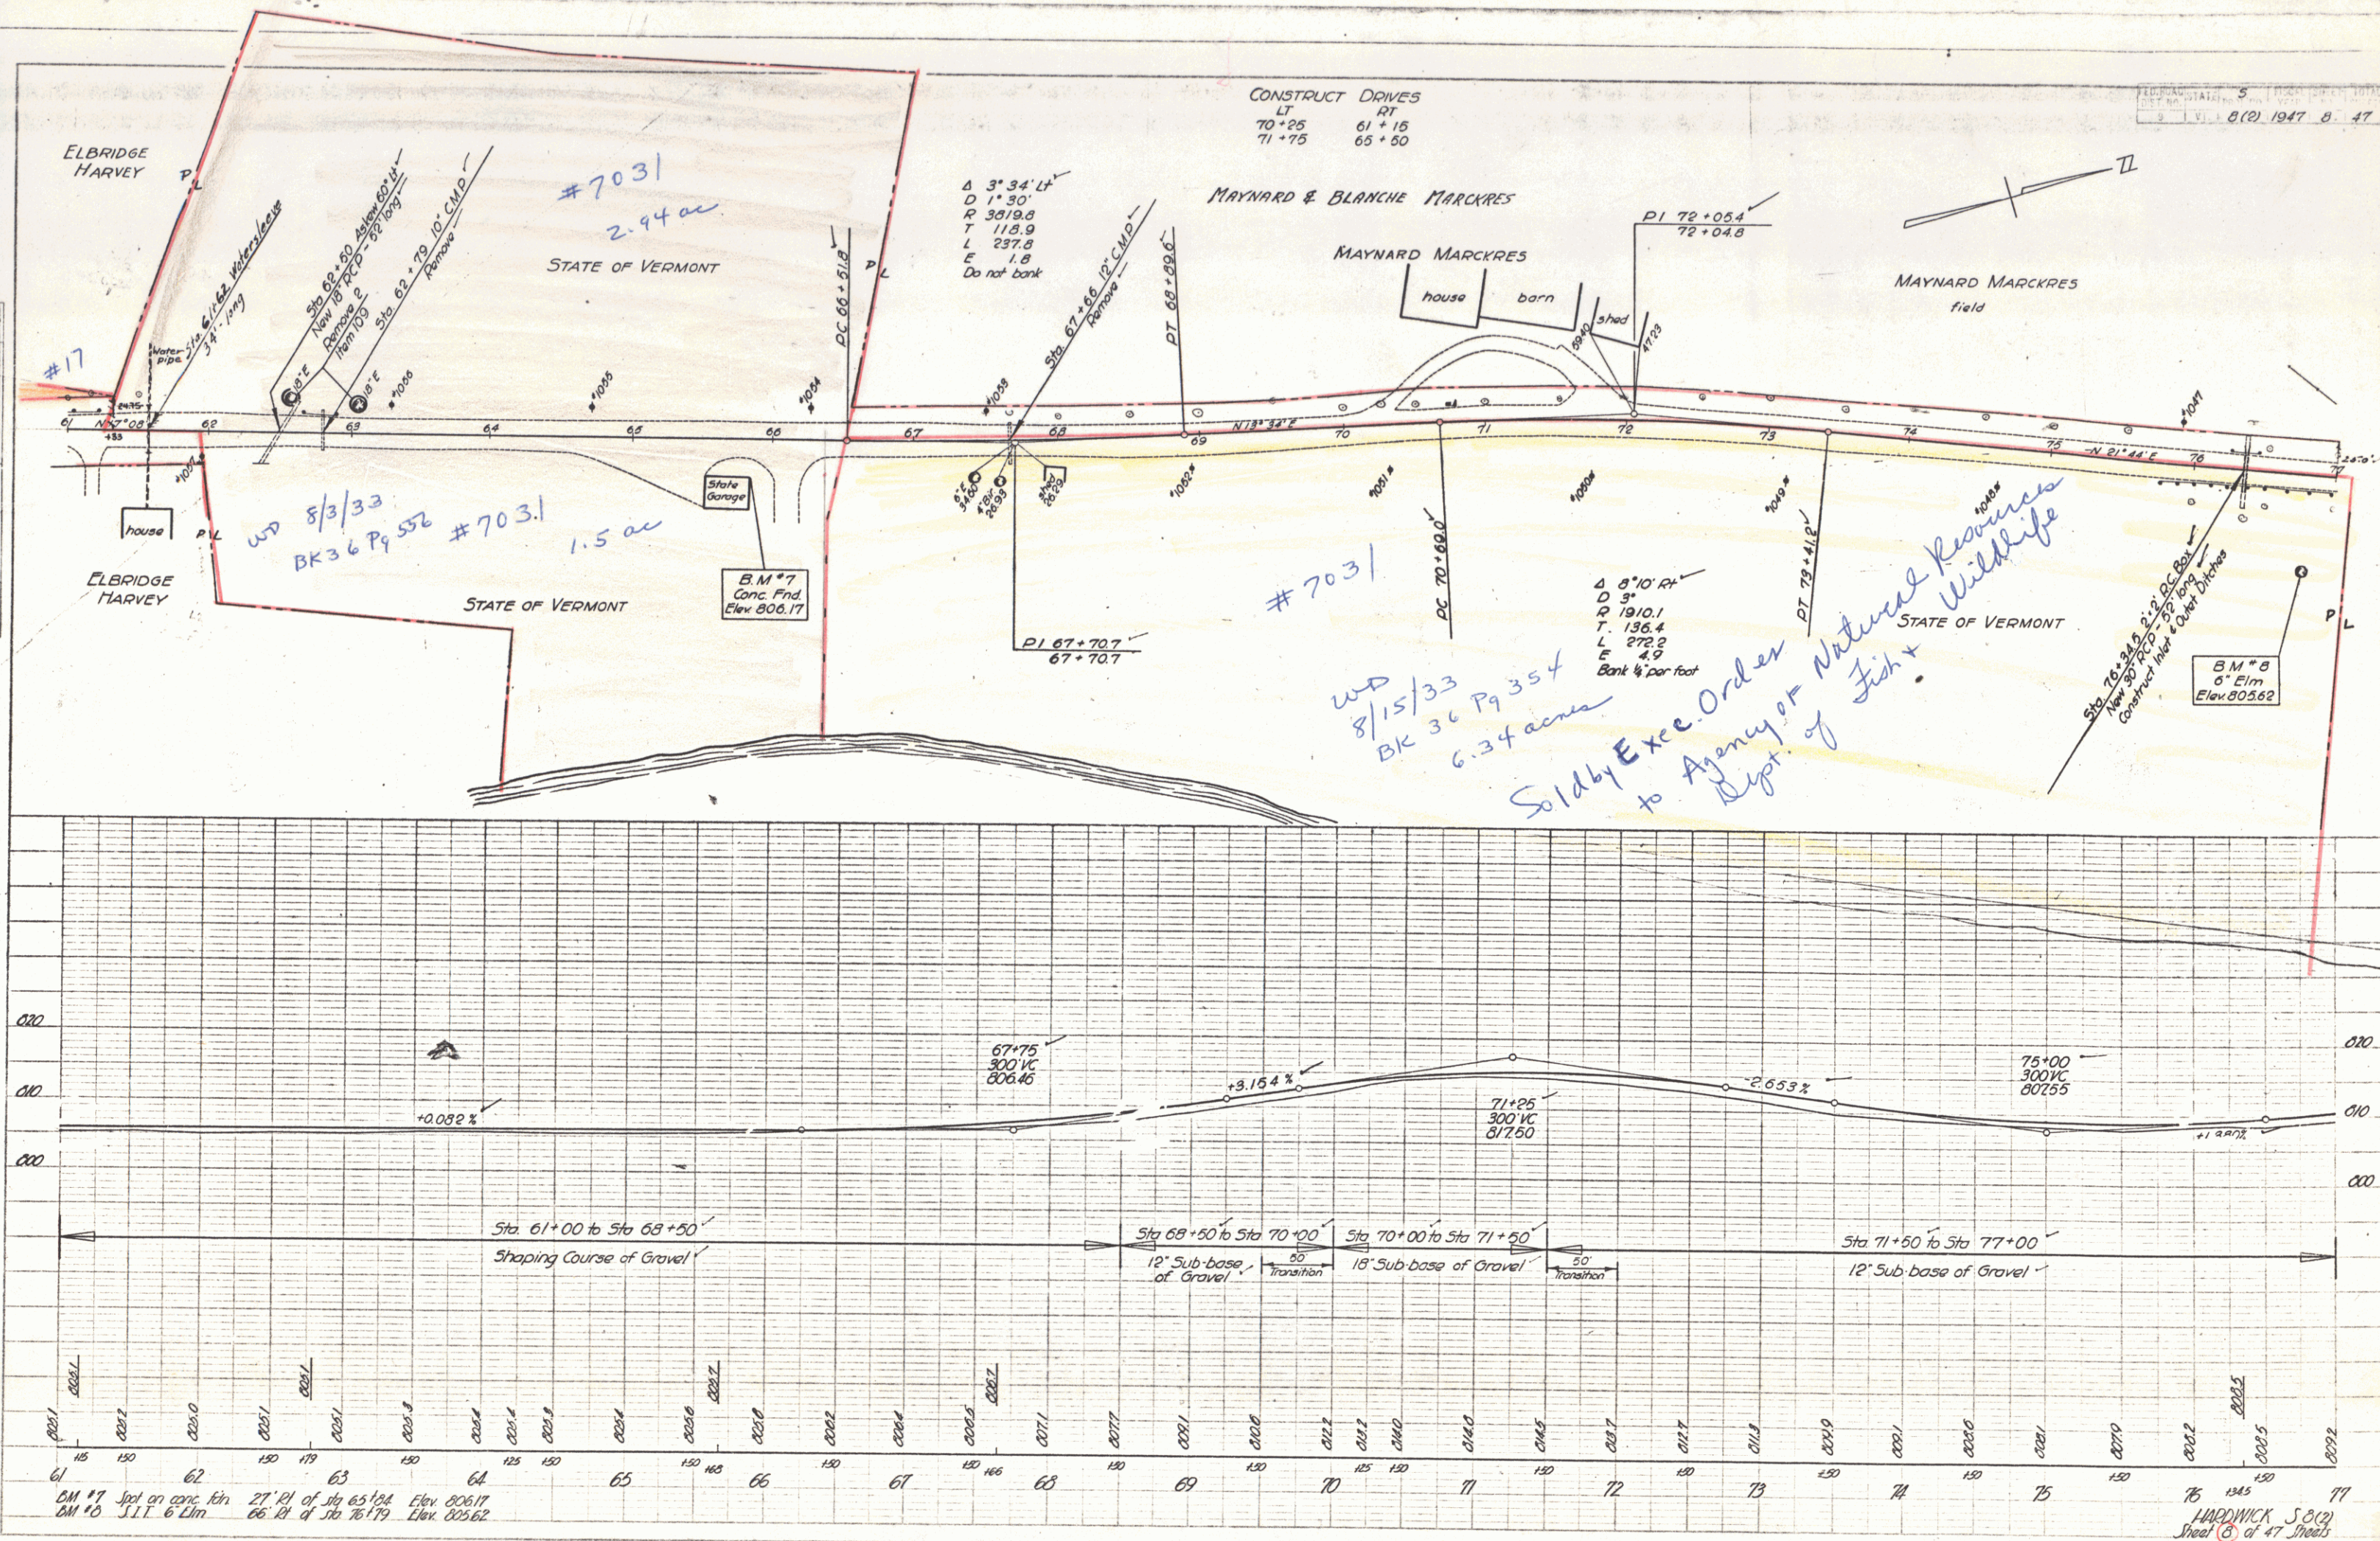


PLATE 1 - PLAN PROFILE OF R.R. & R.E. STATIONS

K.E.C.O. No. 34810

HARDWICK 58(2) Sheet 8 of 47 Sheets

BEING ALL THE SAME LAND AND PREMISES
ACQUIRED BY THE STATE OF VERMONT FROM
CARL AND DAISY G. LOURA BY WARRANTY DEED
DATED AUGUST 7, 1933 AND RECORDED IN BOOK
36 PAGE 354, OF THE TOWN OF HARDWICK LAND
RECORDS.

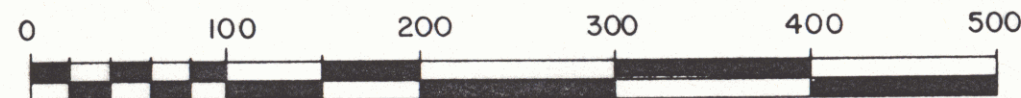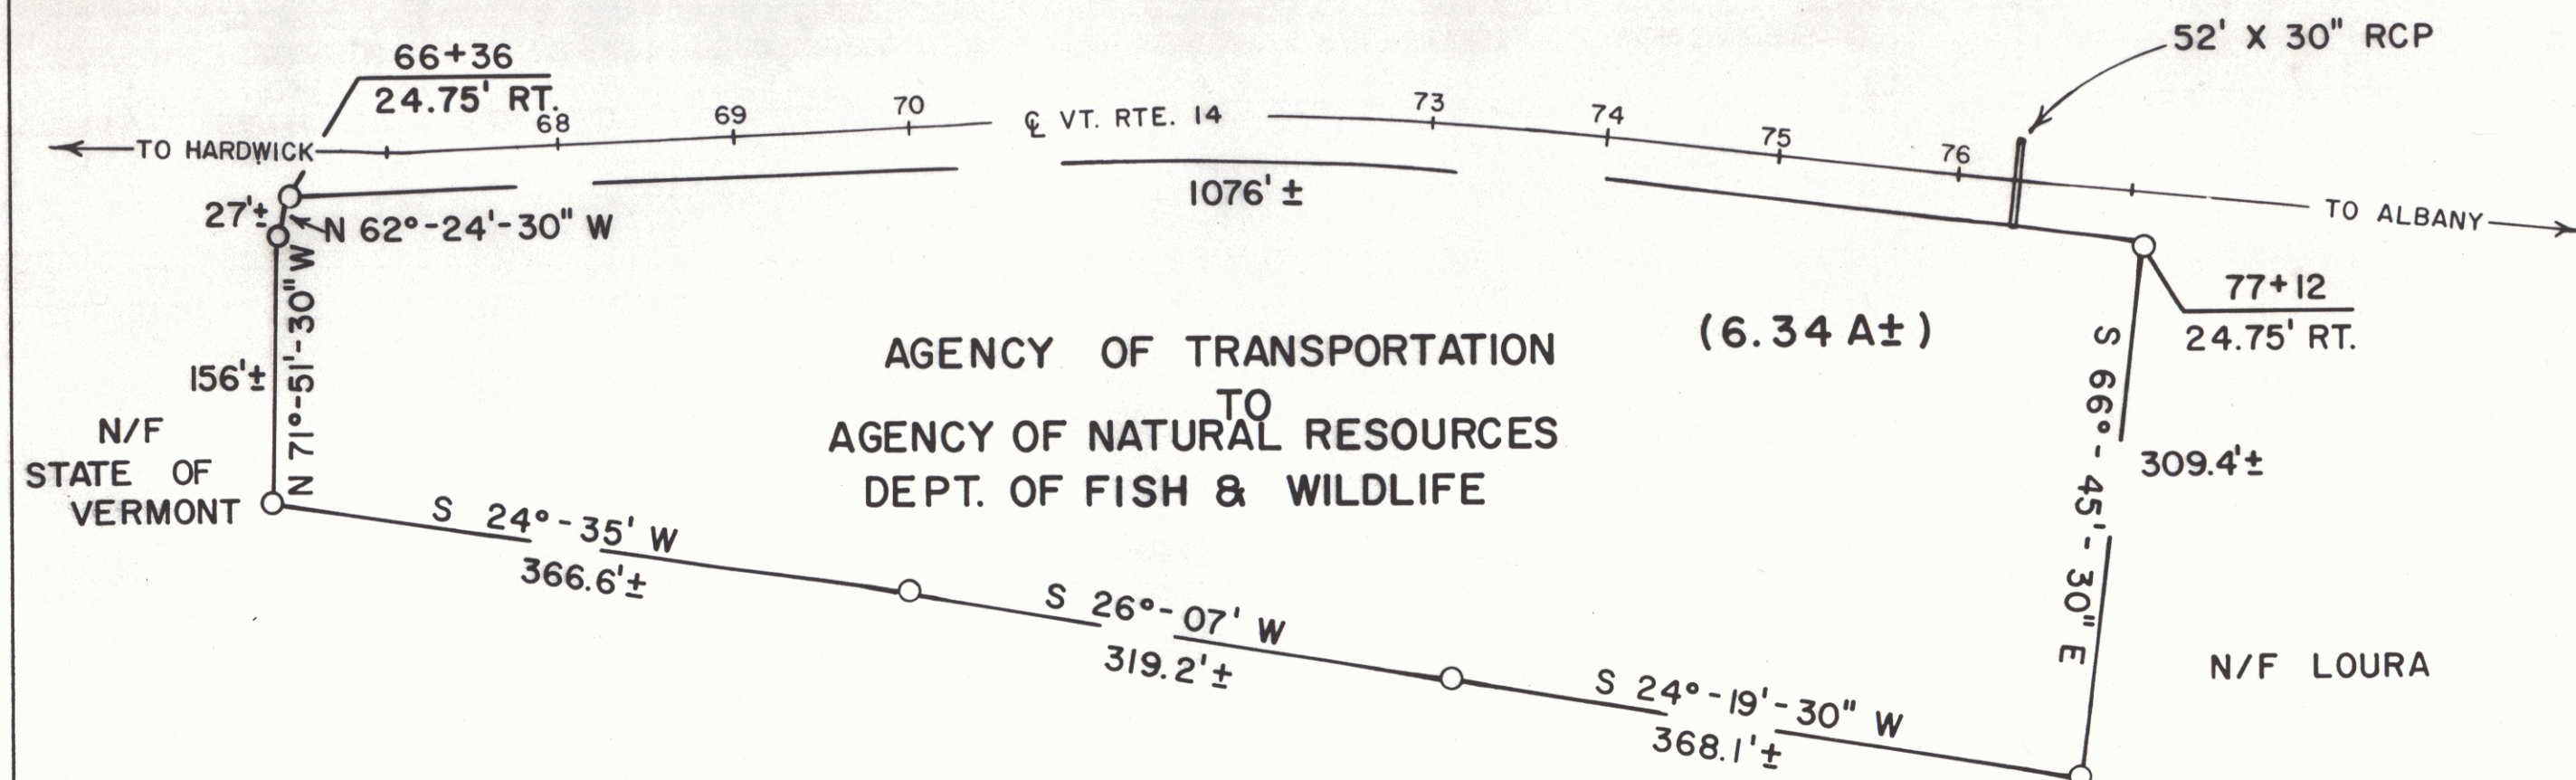


RF: HARDWICK S 8(2) SHEET 8 OF 47

STATE OF VERMONT
AGENCY OF TRANSPORTATION

TOWN OF HARDWICK

APPROX. SCALE 1"=100' DATE 2-17-88 DRAWN BY M.J.R.

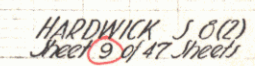

PLAN	DATE	BY	REVIEWED	DATE	BY
1-18	1-18	1-18	1-18	1-18	1-18
NOTE BOOK	ALIGNED CHECKED	DATE	BY	DATE	BY
1-18	1-18	1-18	1-18	1-18	1-18

PROFILE	DATE	BY	REVIEWED	DATE	BY
1-18	1-18	1-18	1-18	1-18	1-18
NOTE BOOK	ALIGNED CHECKED	DATE	BY	DATE	BY
1-18	1-18	1-18	1-18	1-18	1-18


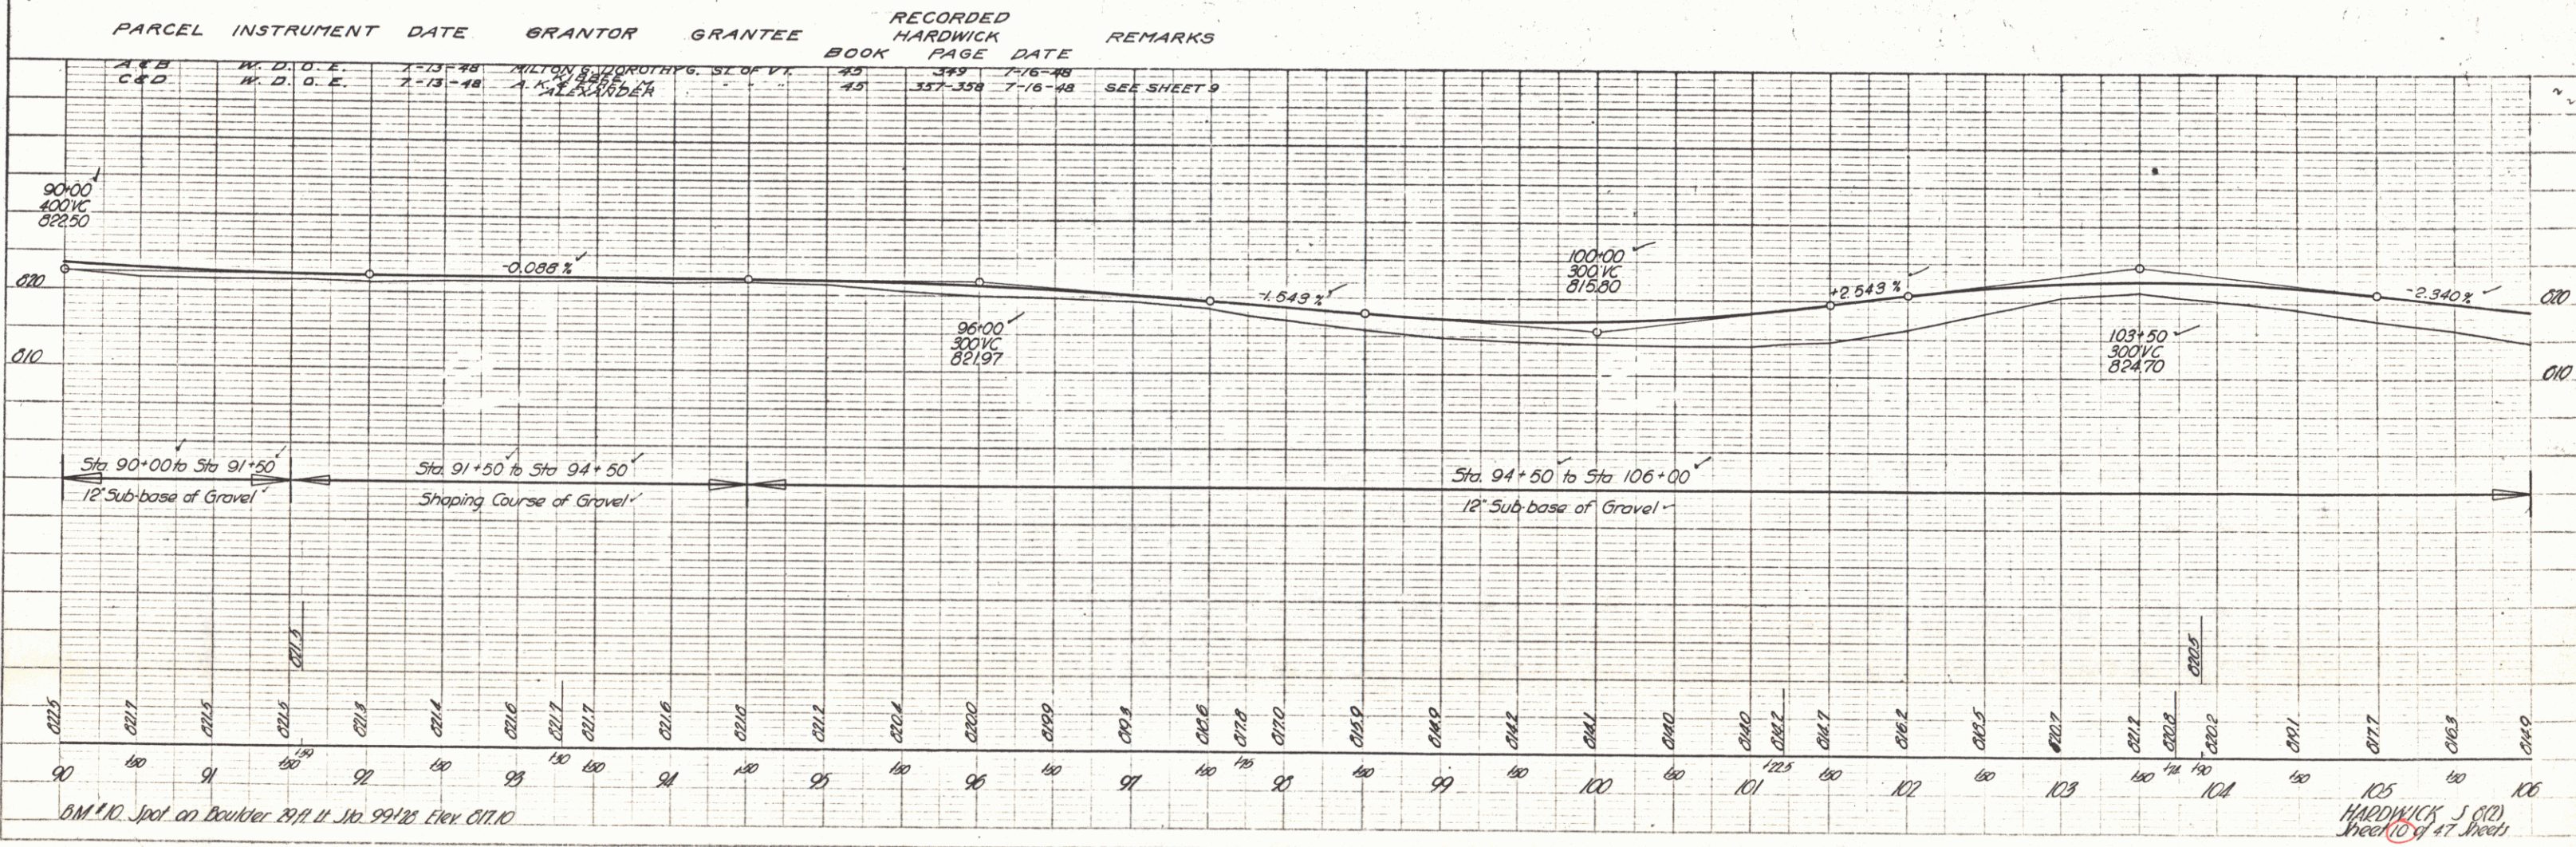


PLATE 1 - PLAN PROFILE & ELEV. & DIST. STATIONED
 1/2" = 1' & 1" = 100' HORIZ.
 1" = 10' VERT.
 W. D. O. E. 1-18-48
 1/2" = 1' & 1" = 100' HORIZ.
 1" = 10' VERT.

HARDWICK 5 (12)
 Sheet 10 of 47 Sheets

DATE	9-28
BY	SPARKING Ave III
SUBMITTED	
PLOTTED	
NOTE BOOK	
NO	
GRIDES CHECKED	
R. M. S. NOTED	
STRUCTURE NOTAT NS CH KD.	

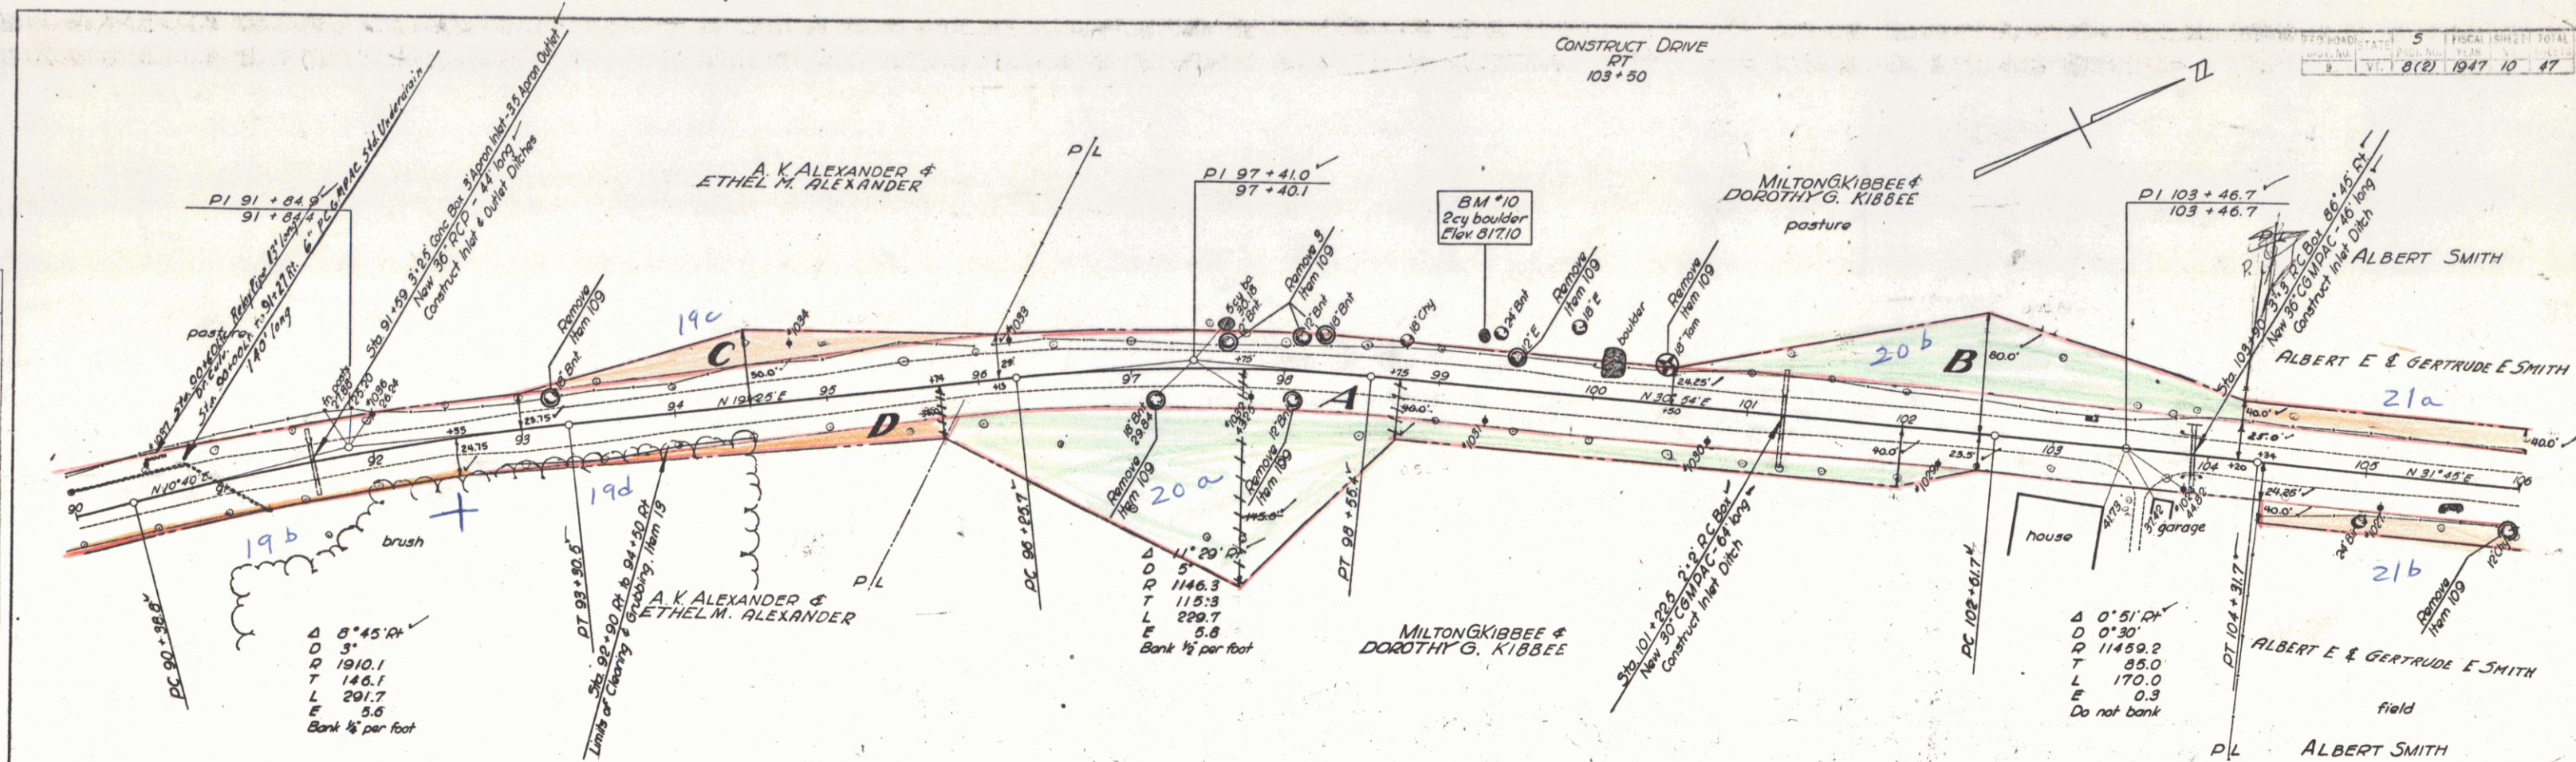