

INDEX OF SHEETS	
SHEET NO.	1
1	TITLE PAGE
2	TYPICAL CROSS-SECTION OF IMPROVEMENT
3	BANKING AND WIDENING TABLES
4	QUANTITY SHEET - ITEMS
5	QUANTITY SHEET - DRAINAGE
6-8	EARTHWORK SHEETS
9-16	PLAN AND PROFILE SHEETS
17	CONSTRUCTION DETAILS CD (DRAINAGE AND MARKERS)
18	CONSTRUCTION DETAILS CD1 (DITCHES)
19	STANDARD STRUCTURE SHEET S 40 (BARRICADES, SIGNS & LIGHTS)
20	STANDARD STRUCTURE SHEET S 46-46 (GUARD RAIL)
21	STANDARD STRUCTURE SHEET S 53-48 (DRAINAGE)
22-47	CROSS SECTIONS

STATE OF VERMONT DEPARTMENT OF HIGHWAYS

PROPOSED IMPROVEMENT

TOWNS OF GREENSBORO AND CRAFTSBURY


COUNTY OF ORLEANS

VERMONT ROUTE 14

HARDWICK-CRAFTSBURY ROAD

BEGINNING AT THE HARDWICK-GREENSBORO TOWN
LINE AND EXTENDING NORTHERLY 12,063.7 FEET.
LENGTH OF PROJECT 12,063.7 FEET = 2.285 MILES.

PROJECT NAME & NUMBER	TYPE	PAVEMENT AREA
Greensboro - Craftsbury S 166 (6)	Dbl. Tk - Pst. Sl.	26,697 S.Y.
RECORD PLANS		
MATERIALS		
SUB-BASE OF GRAVEL Slatney Pit, Wolcott, Vt.	STRUCTURAL STEEL Bethlehem Steel Co.	
CRUSHED GRAVEL Fleming Pit, Wolcott, Vt.	Bethlehem Steel Co.	
REFINED TAR Koppers, Everett, Mass.	R.C.P. Vt. Concrete Pipe Co., Windsor, Vt.	
PEASTONE FOR SEAL Nado Plant, Johnson, Vt.	ACC.GMP N.Eng Metal Culin Co., Boston, Mass.	
GUARD RAIL PAINT Bradley Labs., Braintree, Mass.	CABLE FOR GUARD RAIL American Steel & Wire Co., New Haven, Conn.	
CONTRACTOR Earl & Merry, Inc., Rutland, Vt.	CONTRACT DATED 23 June 1955	
RESIDENT ENG'R C.B. Foster	CONTRACT STARTED 23 June 1955	
INSPECTOR R. Trombley	CONTRACT COMPLETED 17 Sept. 1956	
RECORD PLANS W.B. Lowe 14 Feb. 1957	CONTRACT ACCEPTED 17 Sept. 1956	

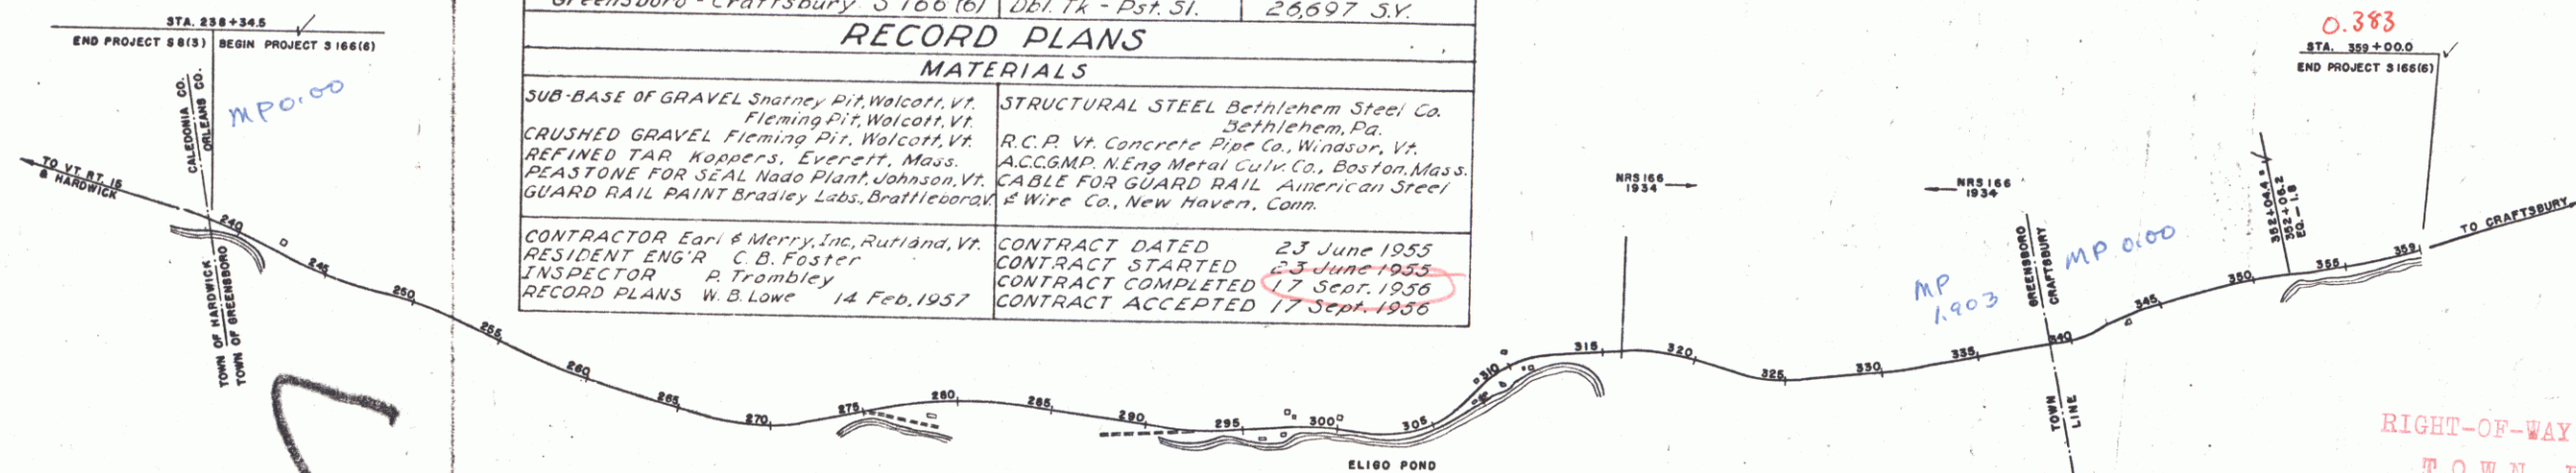

RIGHT-OF-WAY DIVISION
TOWN FILE
PERPETUAL
Pt
of VT 14
(To Be Returned To R.O.W. Division)

NOTE: ANY FURTHER INFORMATION CONCERNING
FINAL QUANTITIES, AMOUNTS OR OTHER DETAILS
RELATIVE TO THIS PROJECT MAY BE FOUND IN
EITHER THE FIELD BOOKS OR THE ESTIMATE
FILE.

PROJECT Greensboro - Craftsbury
SOURCE S 166 (6)
TYPE Dbl. Tk. Pst. Sl. - 4' Right of Way
CONTRACTOR Earl & Merry, Inc.
LOCATION Beginning at Hardwick-Greensboro town line and extending northerly 12,063.7 ft.
YEAR 1955

GROUND ELEVATION	DATUM	LINE
GRADE ELEVATION	DATUM	LINE
CURVE DATA		
DEFLECTION OF ANGLE	A	
DEGREE OF CURVE	D	
RADIUS OF CURVE	R	
TANGENT DISTANCE	T	
LENGTH OF CURVE	L	
EXTERNAL DISTANCE	E	
POINT OF INTERSECTION	PI	
POINT OF CURVE	PC	
POINT OF TANGENT	PT	
POINT ON TANGENT	POT	
POINT ON SUB-TANGENT	POST	

TITLE	SCALE
TYPICAL	1" = 50'
PLAN	1" = 2'
HORIZONTAL	1" = 50'
PROFILE	1" = 10'
CROSS-SECTIONS	1" = 5'

THESE PLANS ARE SUBJECT TO SUCH REVISIONS AS MAY BE
REQUIRED BY THE BUREAU OF PUBLIC ROADS OR THE COMMISSIONER
OF HIGHWAYS.

CONSTRUCTION IS TO BE CARRIED ON IN ACCORDANCE WITH
THE PLANS AND THE STANDARD ROAD AND BRIDGE SPECIFICATIONS
OF 1948, AS APPROVED JULY 25, 1949 BY THE BUREAU OF
PUBLIC ROADS, INCLUDING ALL SUBSEQUENT APPROVED REVISIONS
AND SUCH REVISED SPECIFICATIONS AND SPECIAL PROVISIONS AS
ARE SUBMITTED WITH THE PLANS.

APPROVED J.C. Coates CONSTRUCTION ENGINEER DATE 2-15-1957	APPROVED J. W. Foster SECONDARY ENGINEER DATE Feb. 14, 1955	APPROVED J. W. Foster DEPUTY ENGINEER DATE Feb. 14, 1955	APPROVED J. W. Foster HIGHWAY ENGINEER DATE 16 Feb. 1955	APPROVED H. B. Gault CHIEF ENGINEER DATE 11 Feb. 1955
---	---	--	--	---


DEPARTMENT OF COMMERCE
BUREAU OF PUBLIC ROADS


APPROVED _____
DIVISION ENGINEER DATE _____

PROJECT S NO. 166 (6)
SHEET 1 OF 47 SHEETS
WEBSTER-MARTIN, INC. CONSULTING ENGINEERS
80 RUTLAND, VERMONT


PLAN
SERVED BY
PAULSON & MARTIN, INC.
NOTE BOOK
RT. OF WAY CHECKED
NO.

PROFILE
SERVED BY
PAULSON & MARTIN, INC.
NOTE BOOK
RT. OF WAY CHECKED
NO.

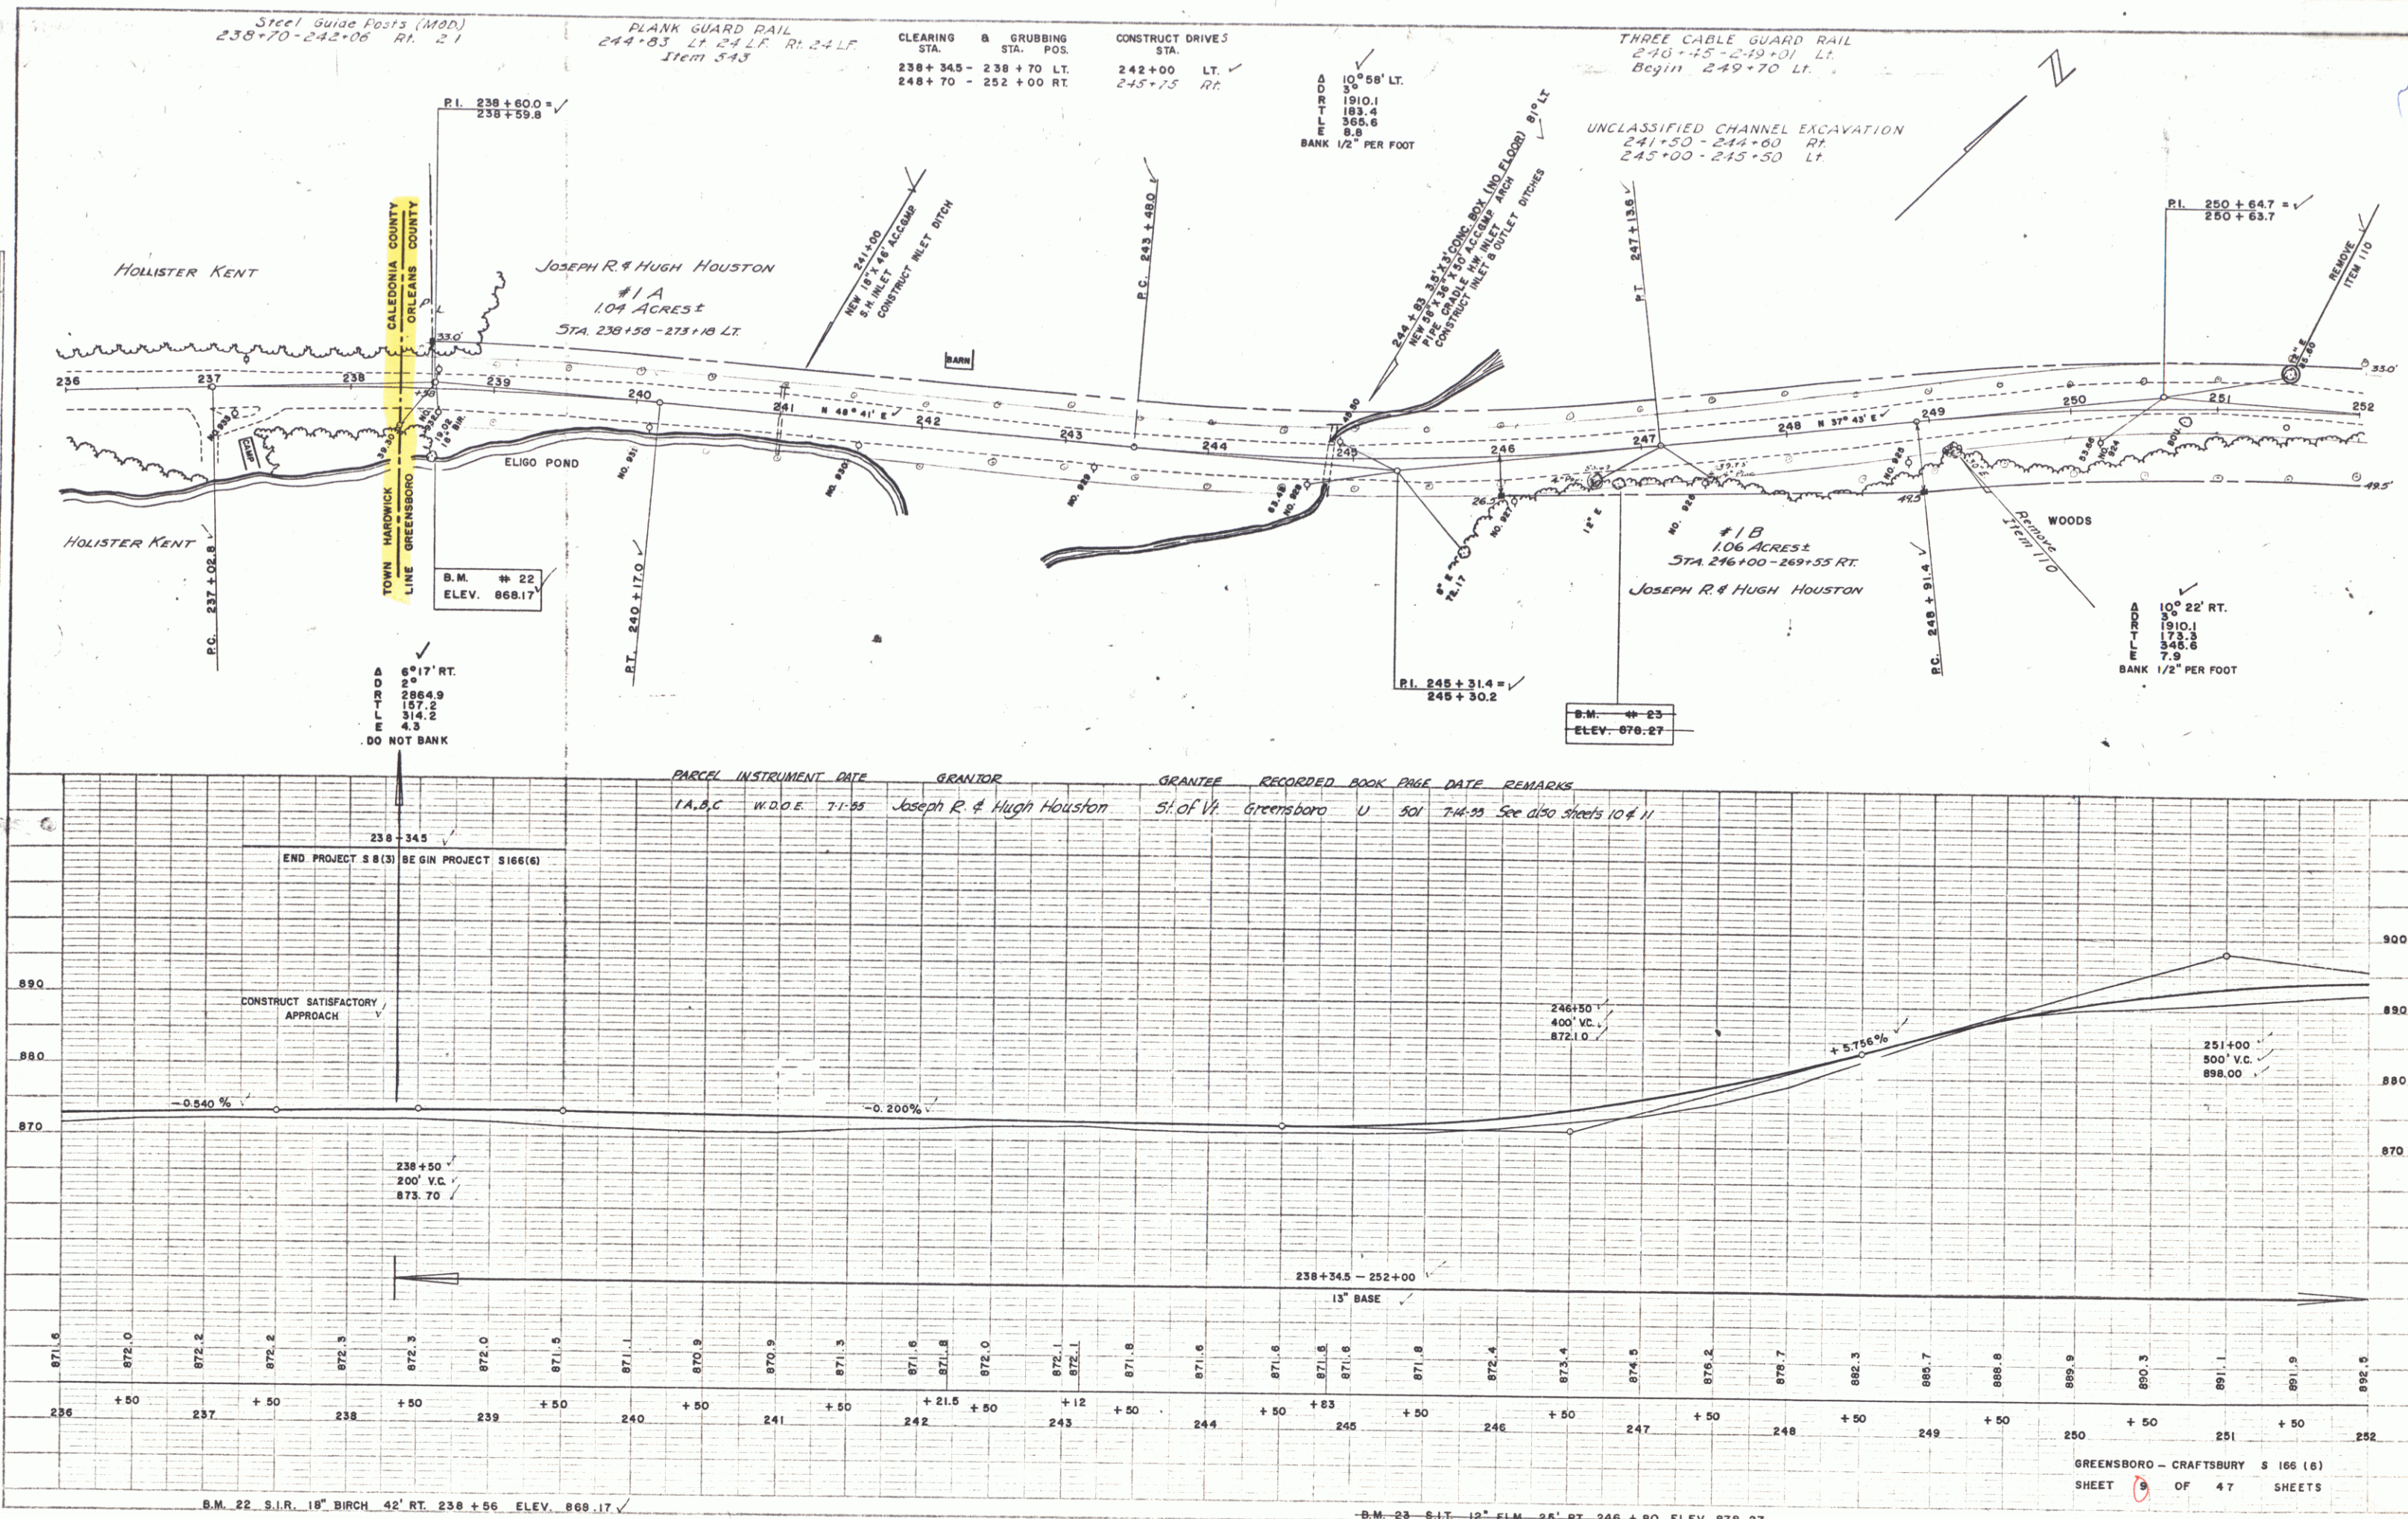


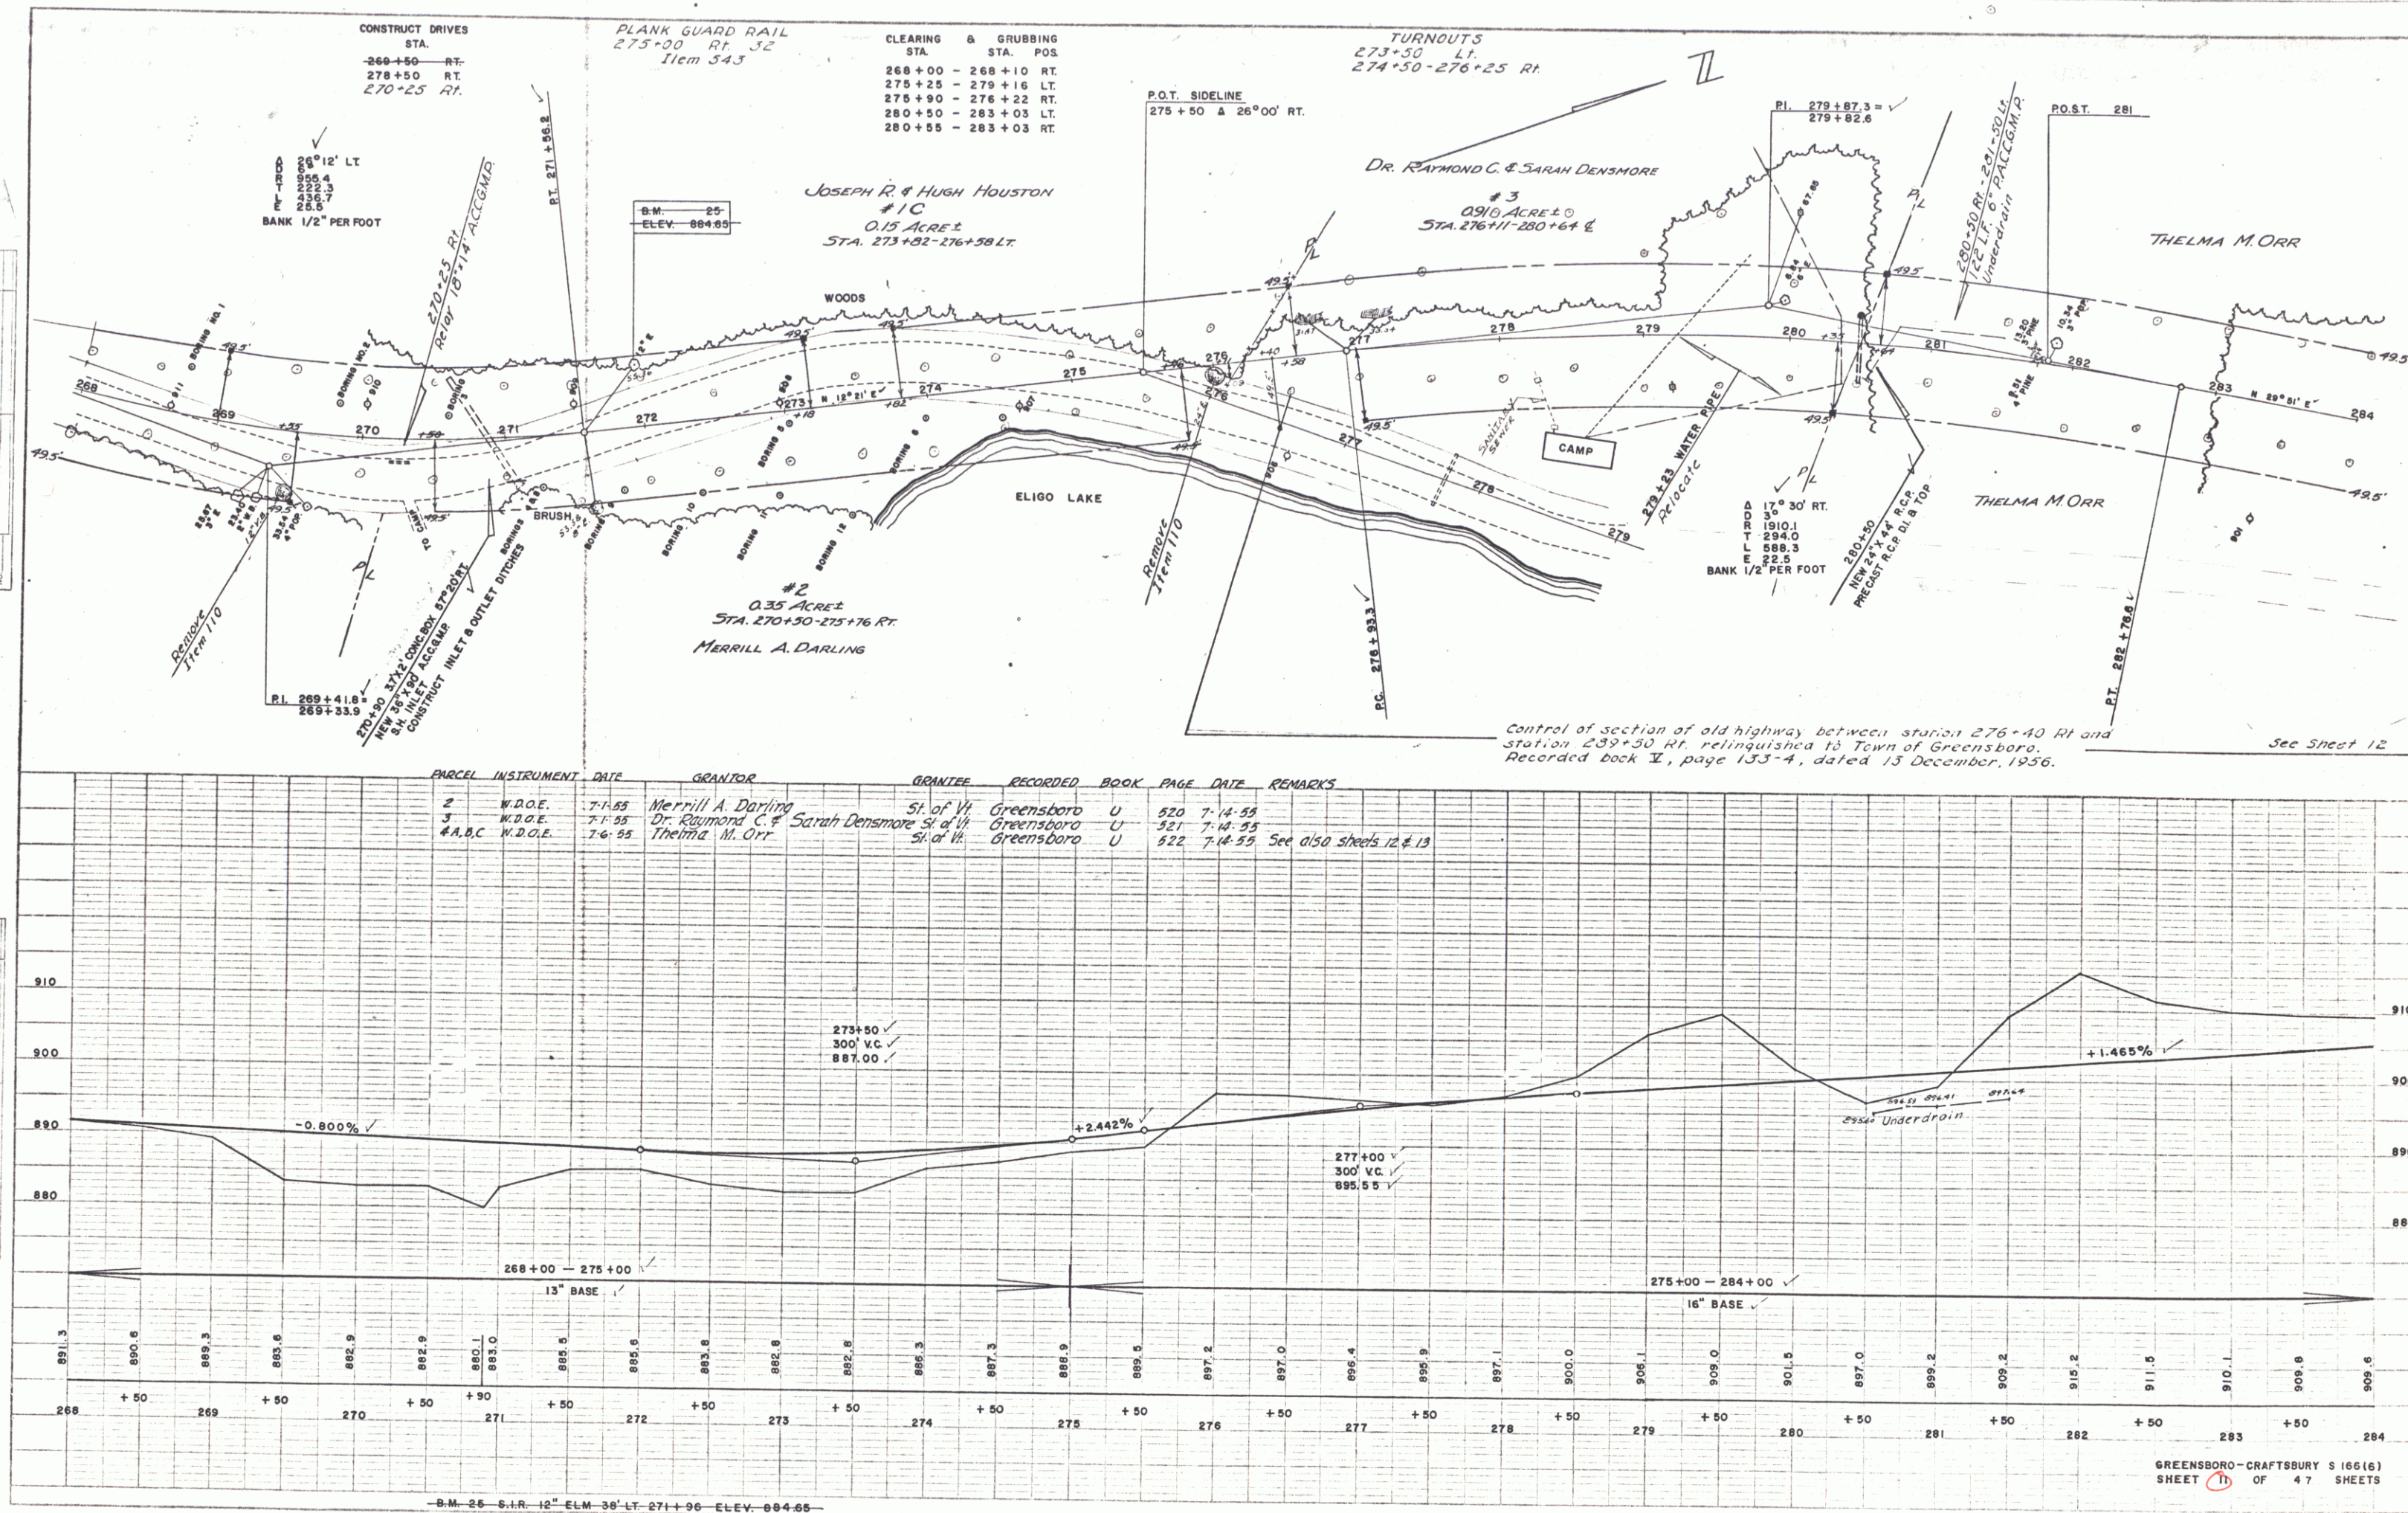

PLAN
 DRAWN BY
 CHECKED BY
 DATE
 SCALE
 SHEET NO.
 OF SHEETS

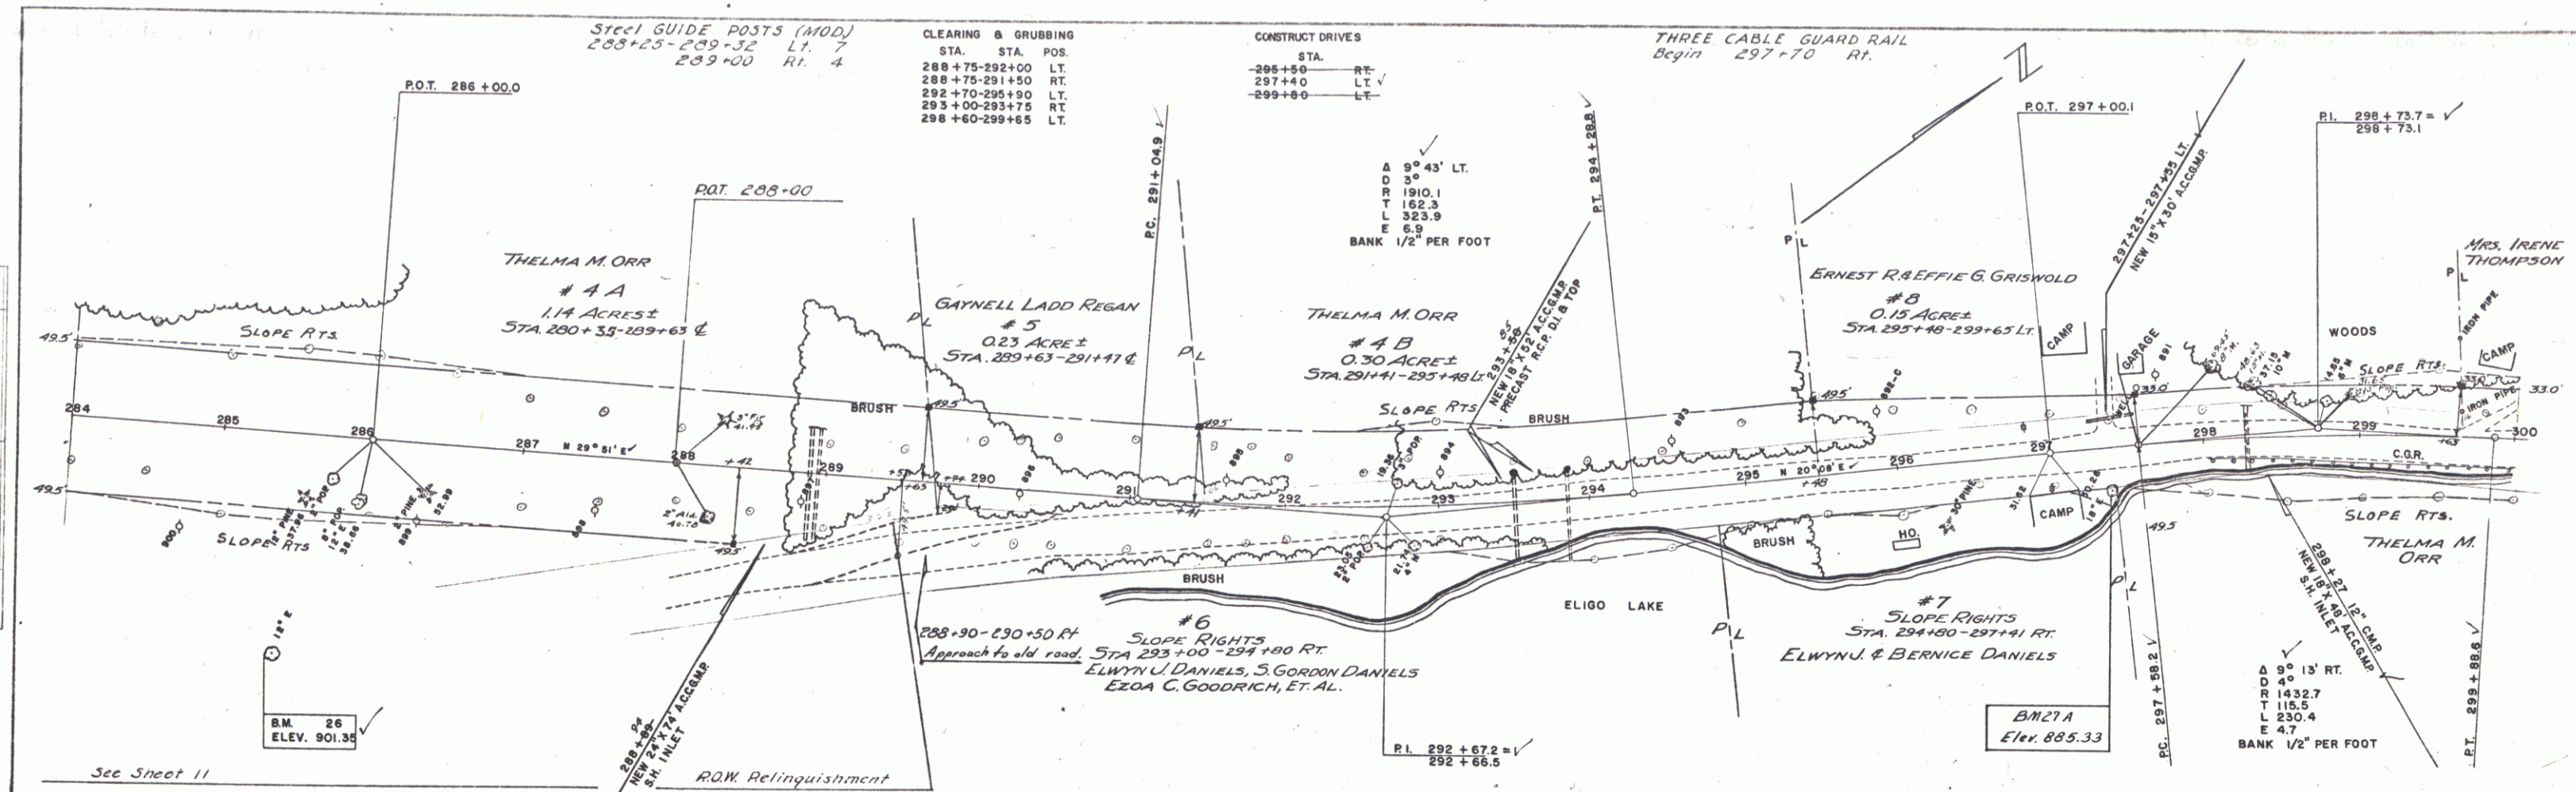


PROFILE
 DRAWN BY
 CHECKED BY
 DATE
 SCALE
 SHEET NO.
 OF SHEETS

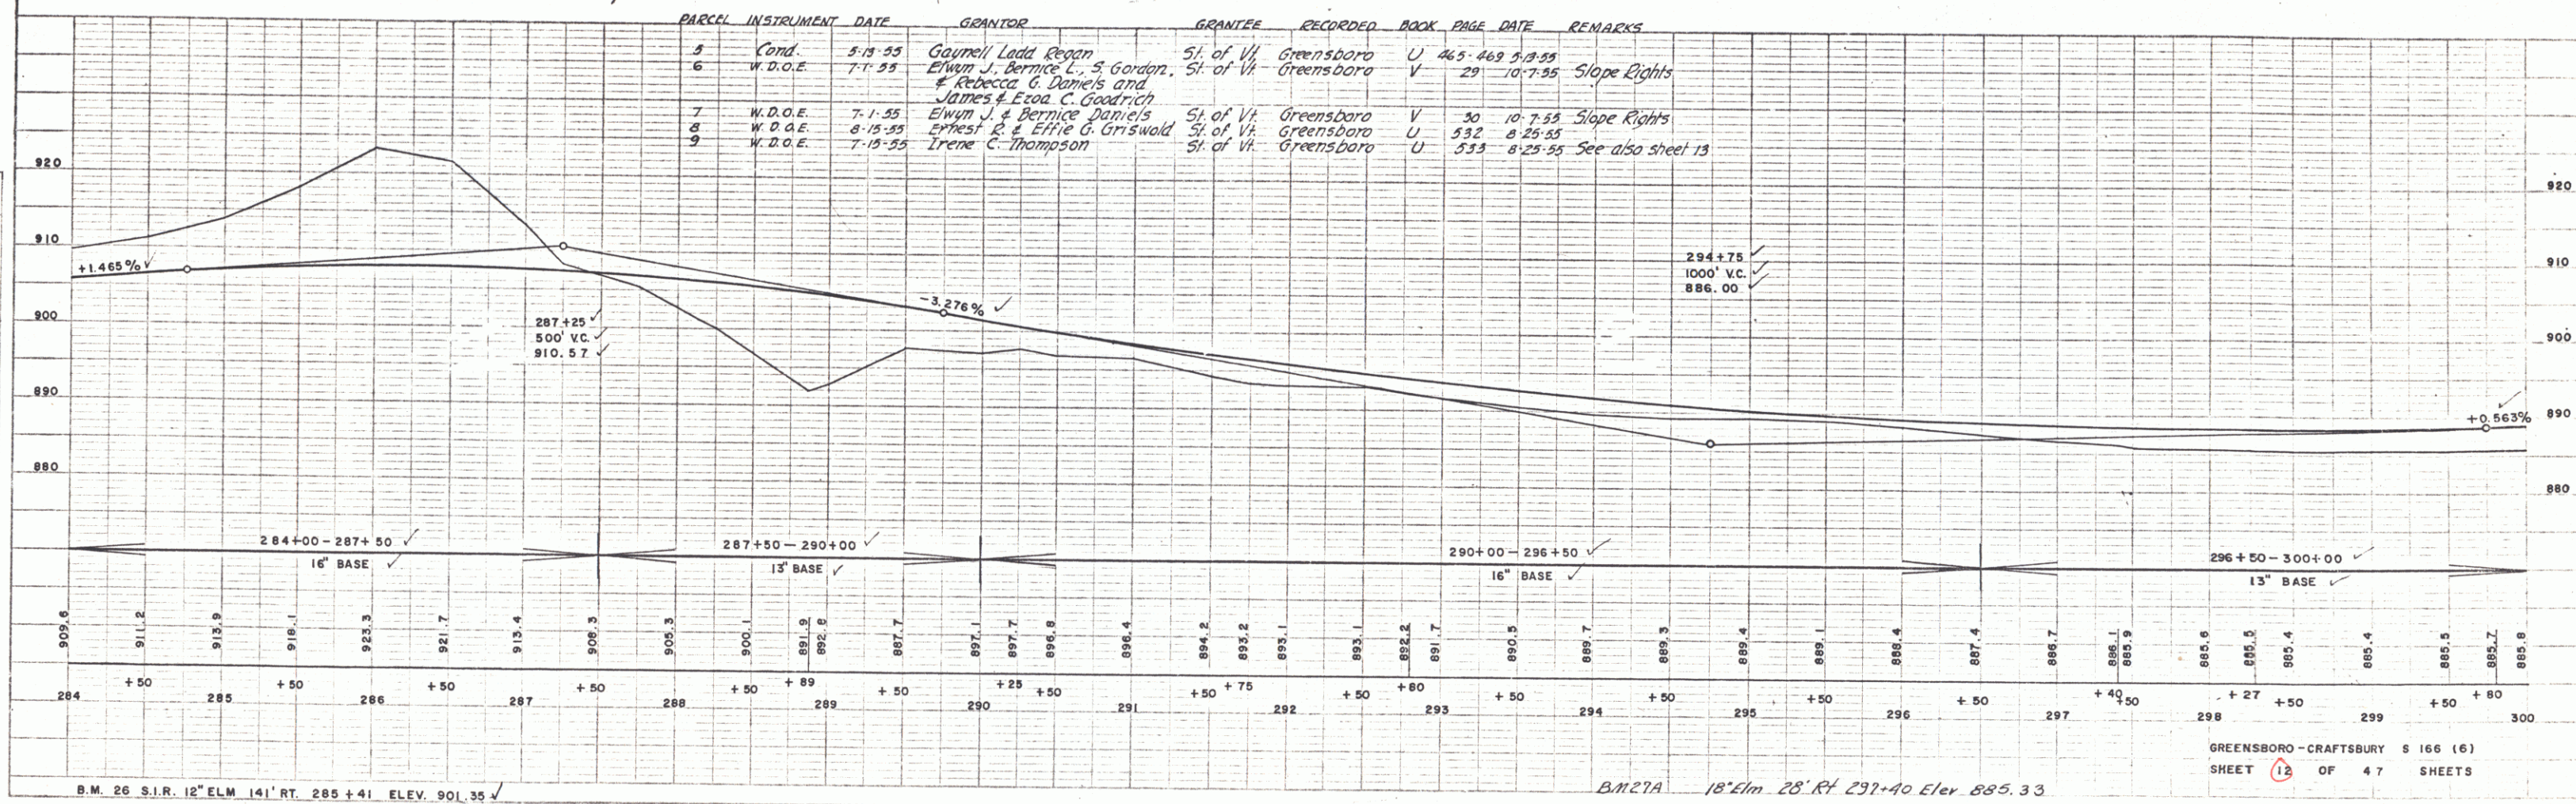

PARCEL	INSTRUMENT	DATE	GRANTOR	GRANTEE	RECORDED	BOOK	PAGE	DATE	REMARKS
5	Cond.	5-15-55	Gaynell Ladd Regan	5/1 of 1/4	Greensboro	U	465	469	5-15-55
6	W.D.O.E.	7-1-55	Elwyn J. Bernice L. S. Gordon & Rebecca G. Daniels and James & Edoe C. Goodrich	5/1 of 1/4	Greensboro	V	29	10-7-55	Slope Rights
7	W.D.O.E.	7-1-55	Elwyn J. & Bernice Daniels	5/1 of 1/4	Greensboro	V	30	10-7-55	Slope Rights
8	W.D.O.E.	8-15-55	Ernest R. & Effie G. Griswold	5/1 of 1/4	Greensboro	U	532	8-25-55	Slope Rights
9	W.D.O.E.	7-15-55	Irene C. Thompson	5/1 of 1/4	Greensboro	U	533	8-25-55	See also sheet 13


PLAN
SPALDING
WEBSTER-MARTIN INC. 11-54

PLAN
SPALDING
WEBSTER-MARTIN INC. 11-54

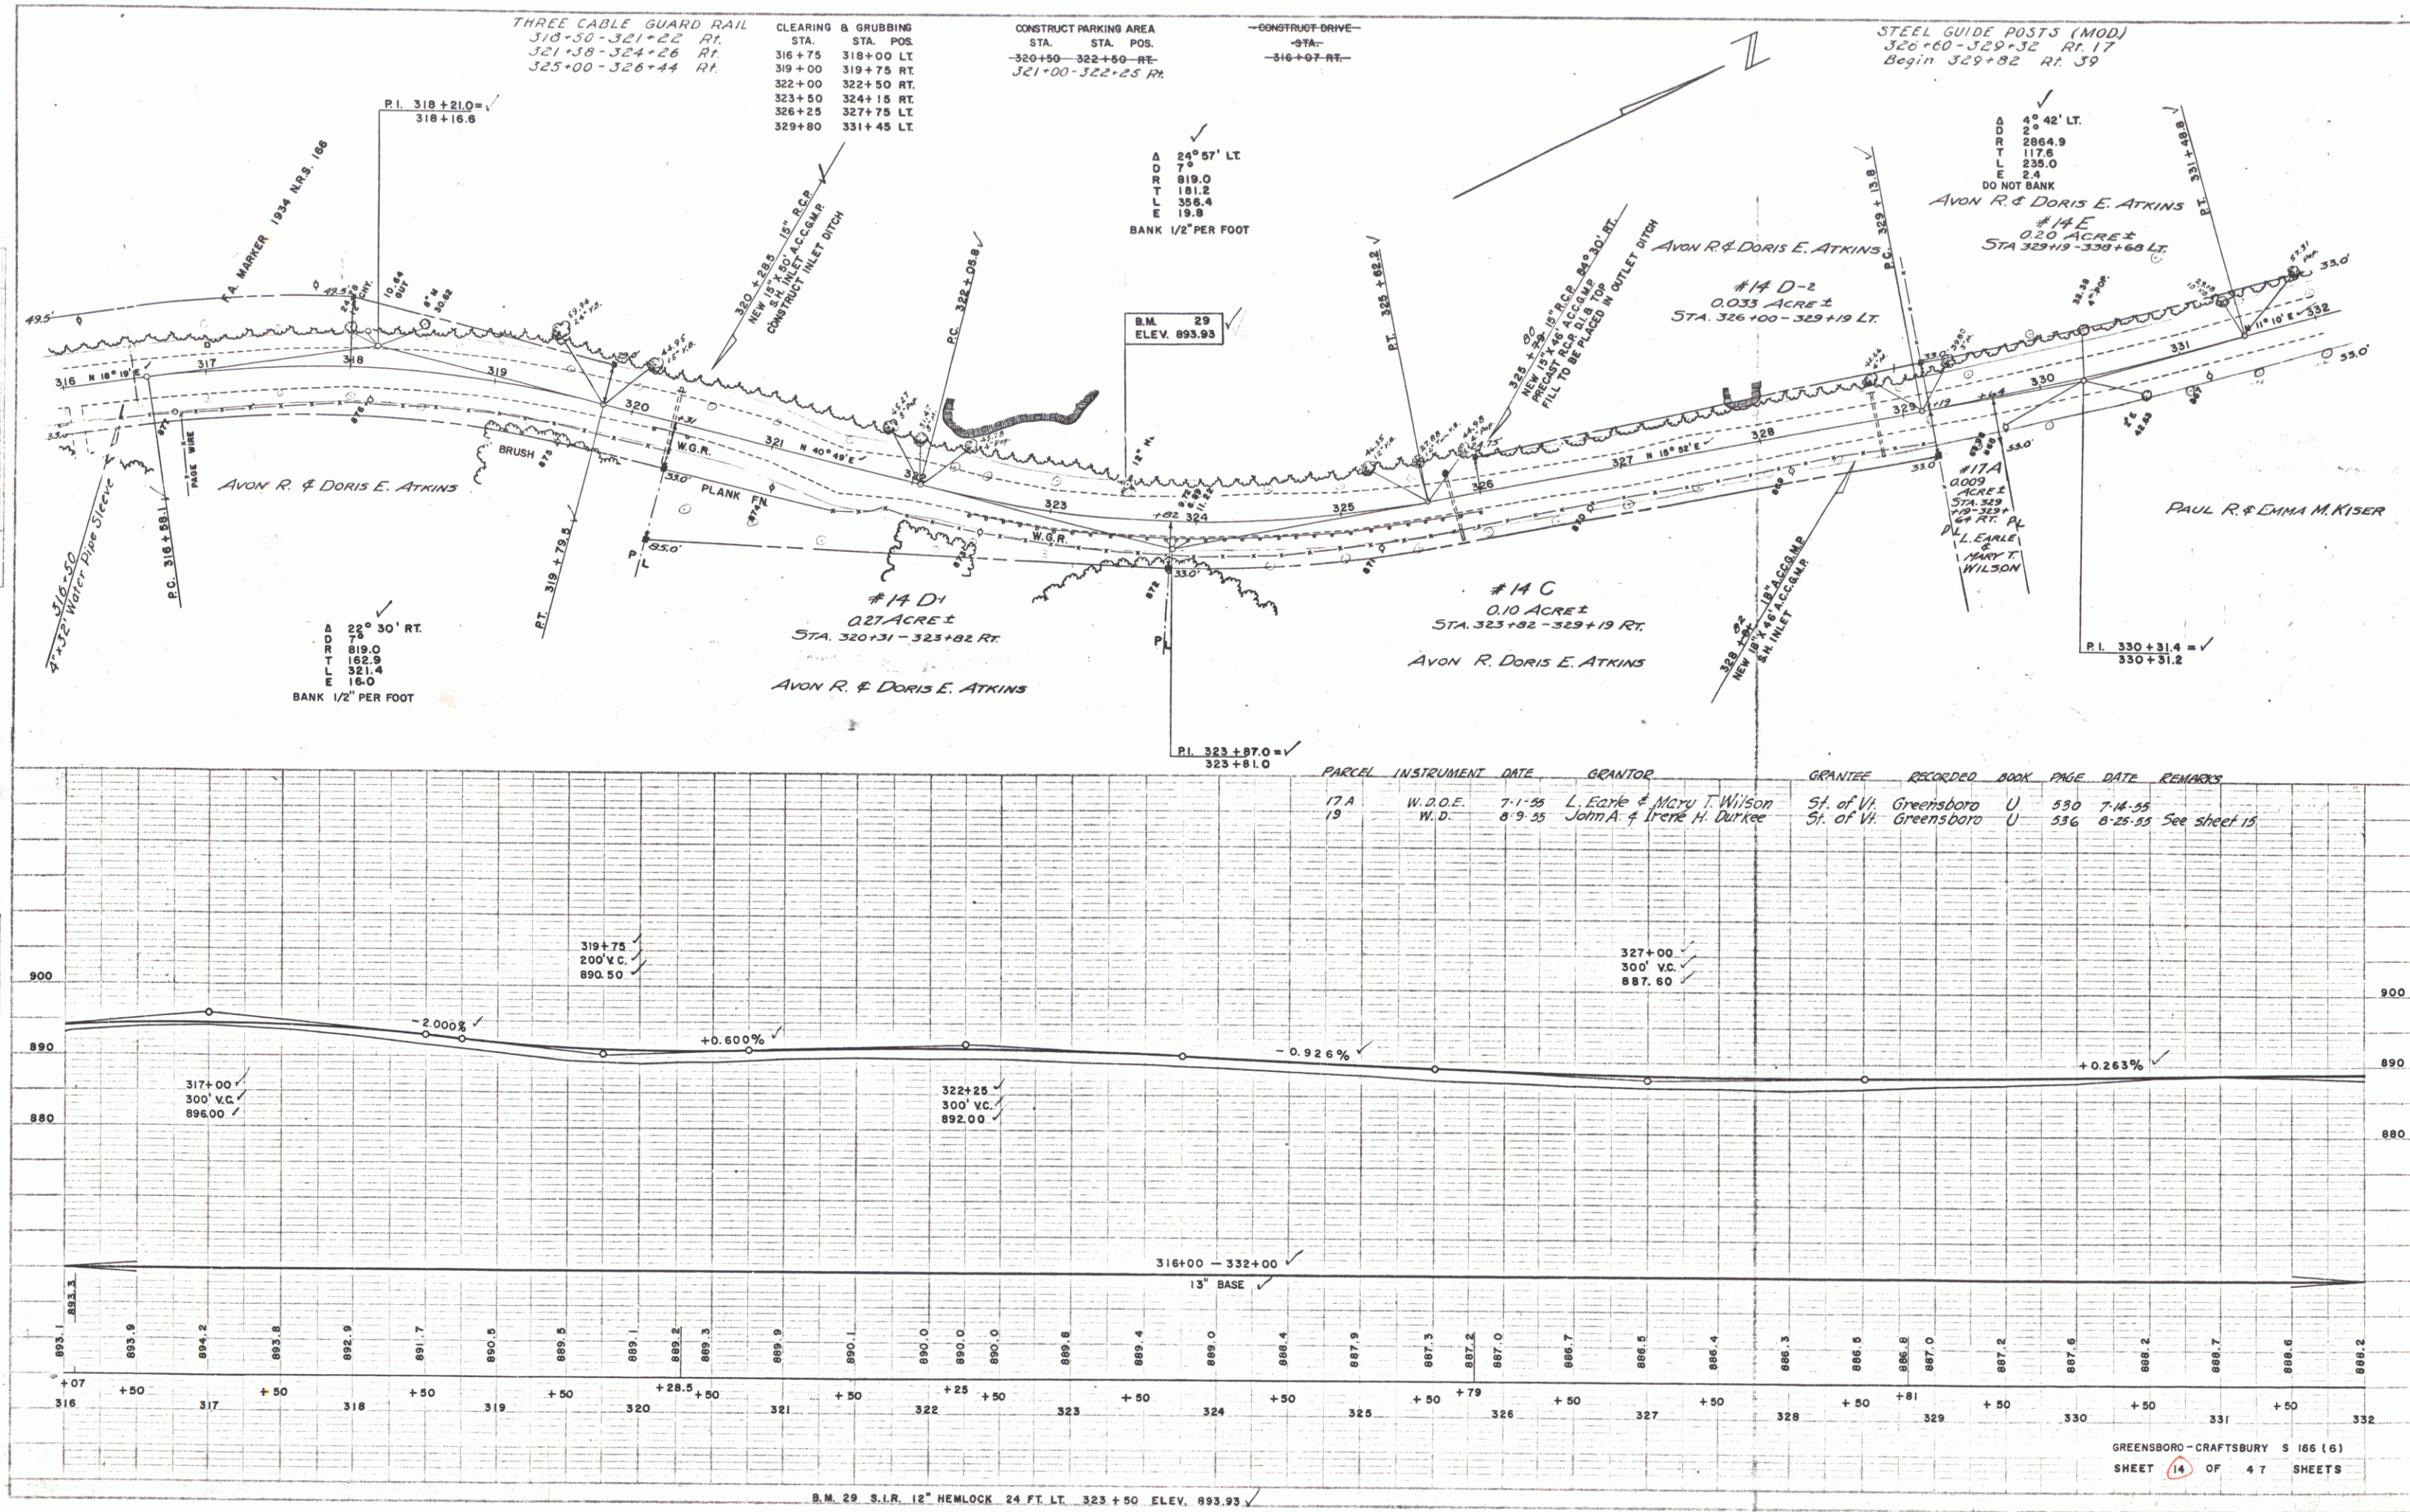

PLAN
 DATE 7-24
 BY SPANGLING
 CHECKED BY WEBSTER-MARTIN INC.
 NO. 11-54

PLAN
 DATE 7-24
 BY SPANGLING
 CHECKED BY WEBSTER-MARTIN INC.
 NO. 11-54

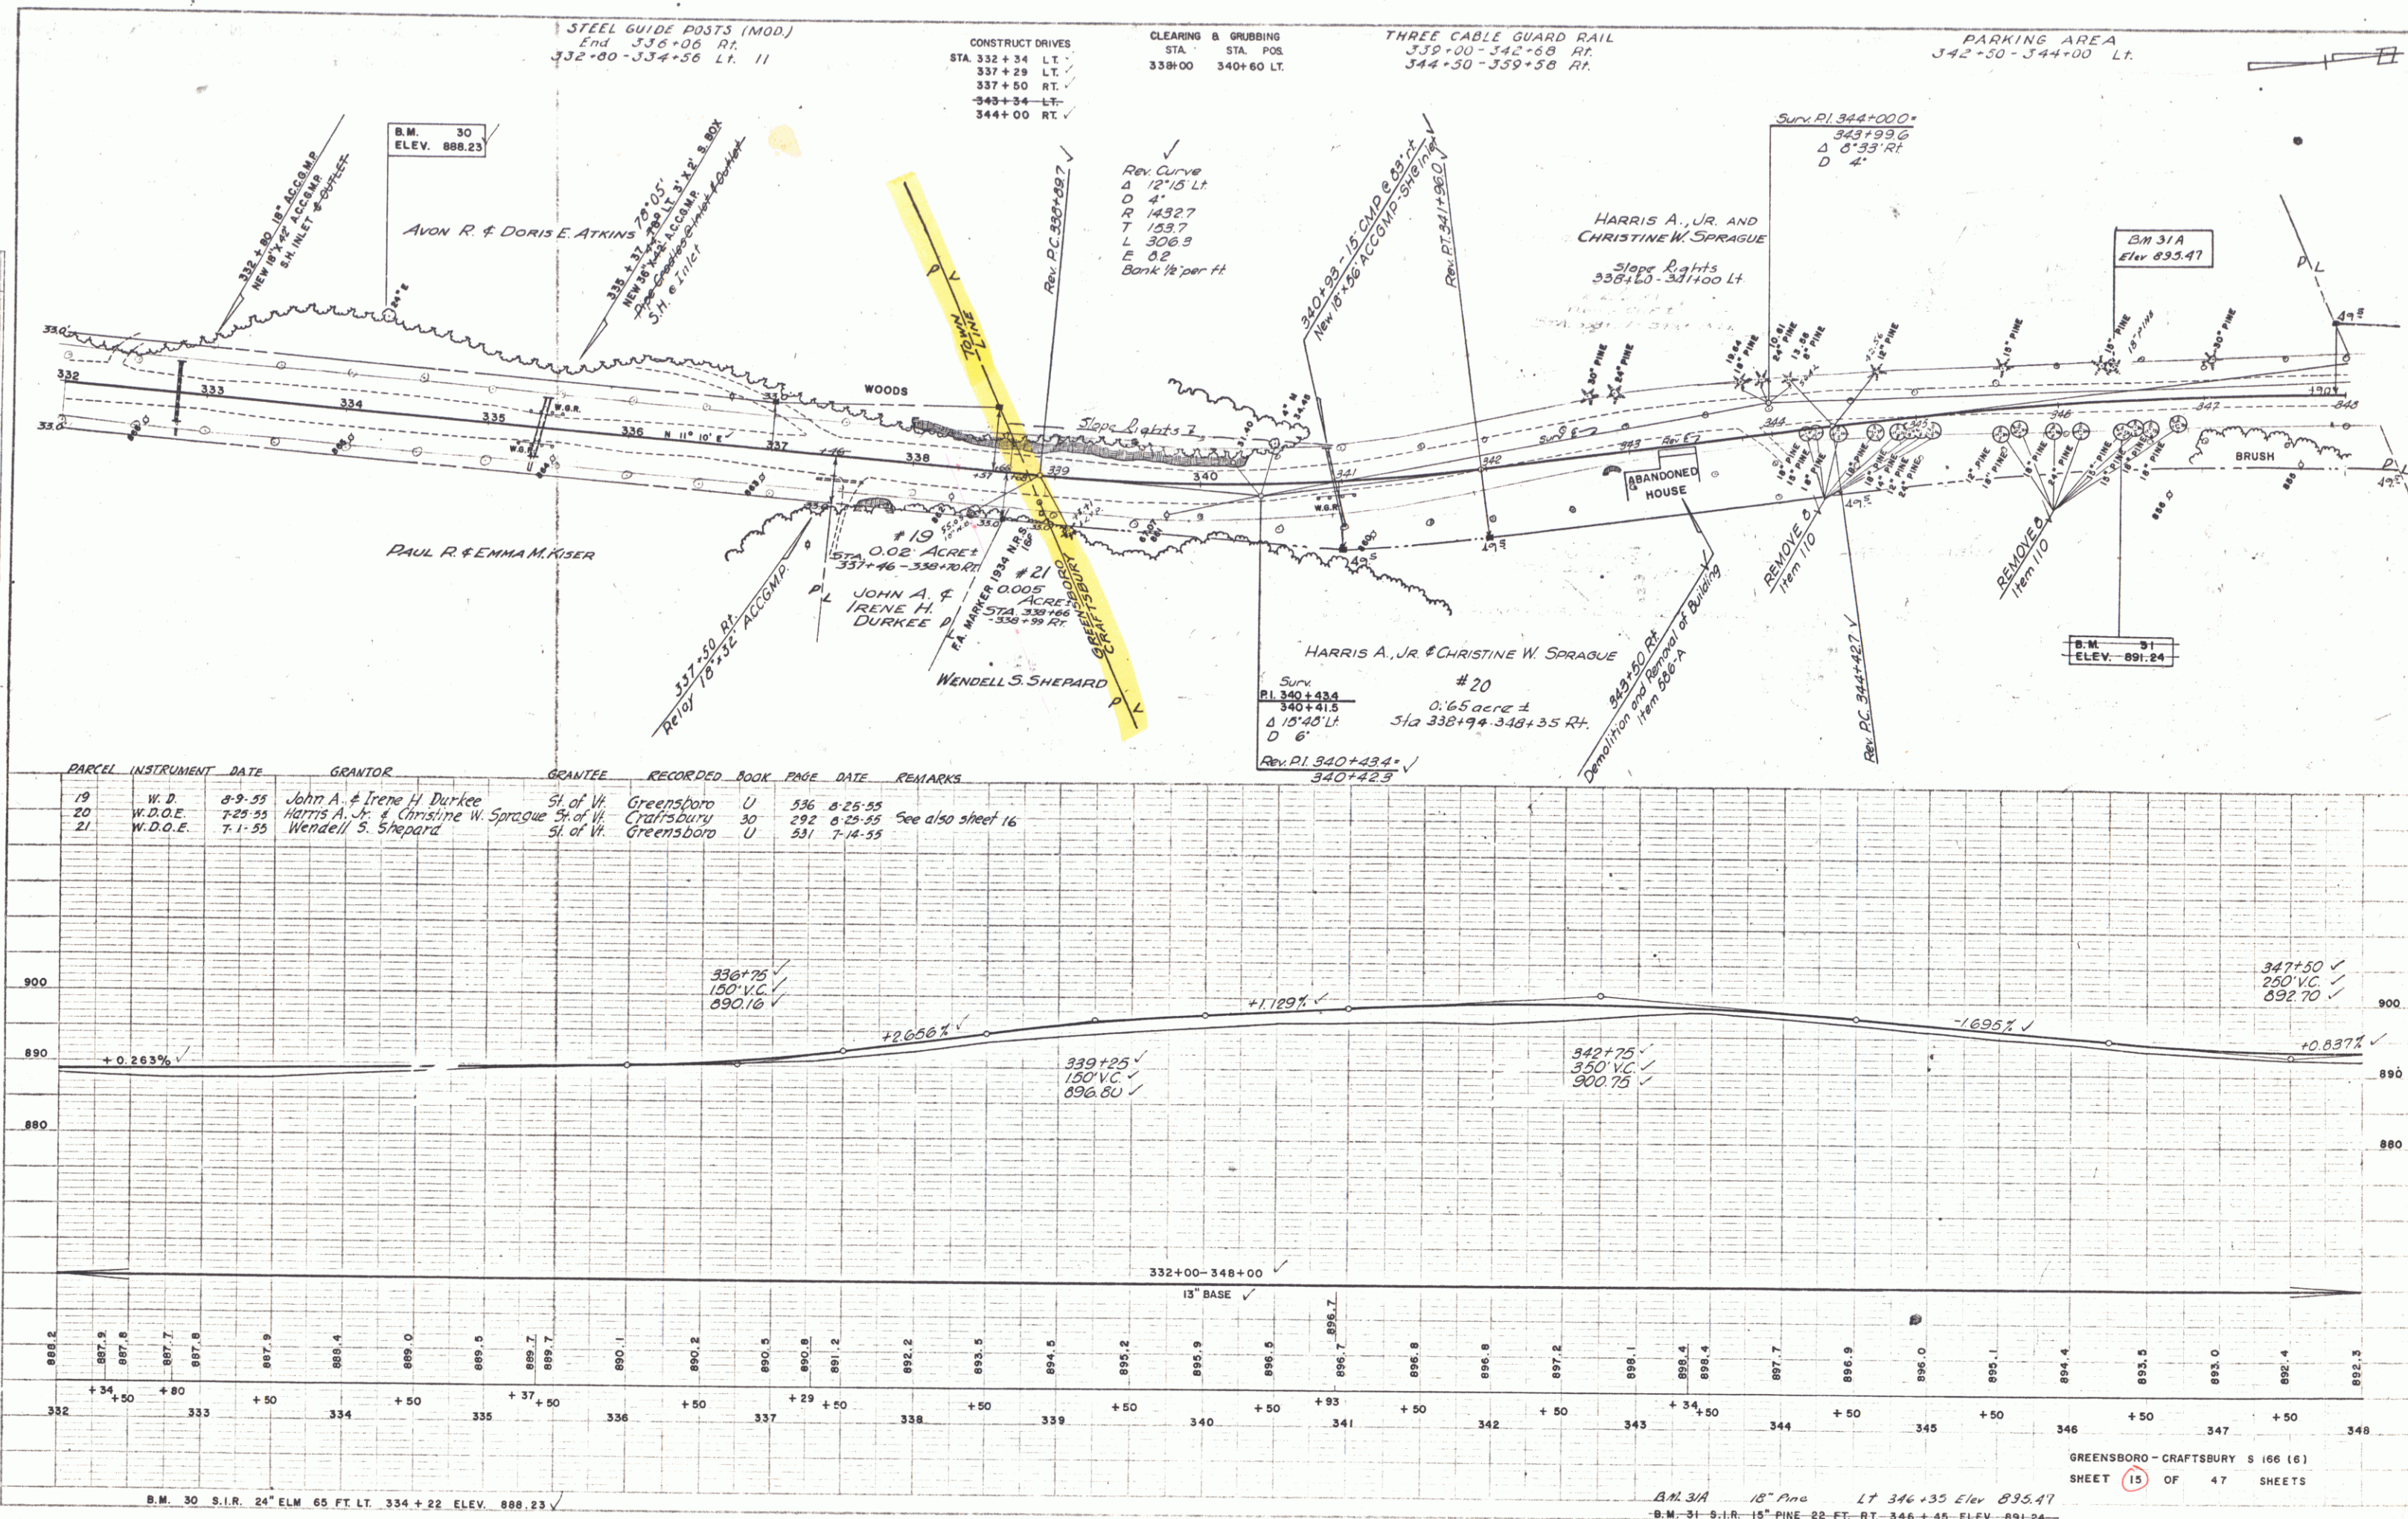

PARCEL	INSTRUMENT	DATE	GRANTOR	GRANTEE	RECORDED	BOOK	PAGE	DATE	REMARKS
19	W.D.	8-9-55	John A. & Irene H. Durkee	St. of W. Greensboro	U	536	8-25-55		
20	W.D.O.E.	7-25-55	Harris A. Jr. & Christine W. Sprague	St. of W. Greensboro	U	292	6-25-55	See also sheet 16	
21	W.D.O.E.	7-1-55	Wendell S. Shepard	St. of W. Greensboro	U	231	7-14-55		

GREENSBORO - CRAFTSBURY S 166 (6)
 SHEET 15 OF 47 SHEETS

B.M. 31A 18" Pine LT 346+35 Elev 895.47
 B.M. 31-9:1R 18" Pine 22-FT. RT. 346+45 Elev 891.24

