


CURVE DATA
D 10
R 5729.58
T -
L -
E -
2T-L -
From 3+00 to 7+91.8

PRESENT	NEW
Concrete Slab Bridge	Twin Plate Pipe Arch
Clear Span 18'-0"	Rise 7'-11"
Perpendicular	
Span 13'-0"	Span 12'-6"
Clear Height 7'-0"	
Road Width 28'-0"	Road Width 34'-0"
Waterway 91'±	Waterway 156'±

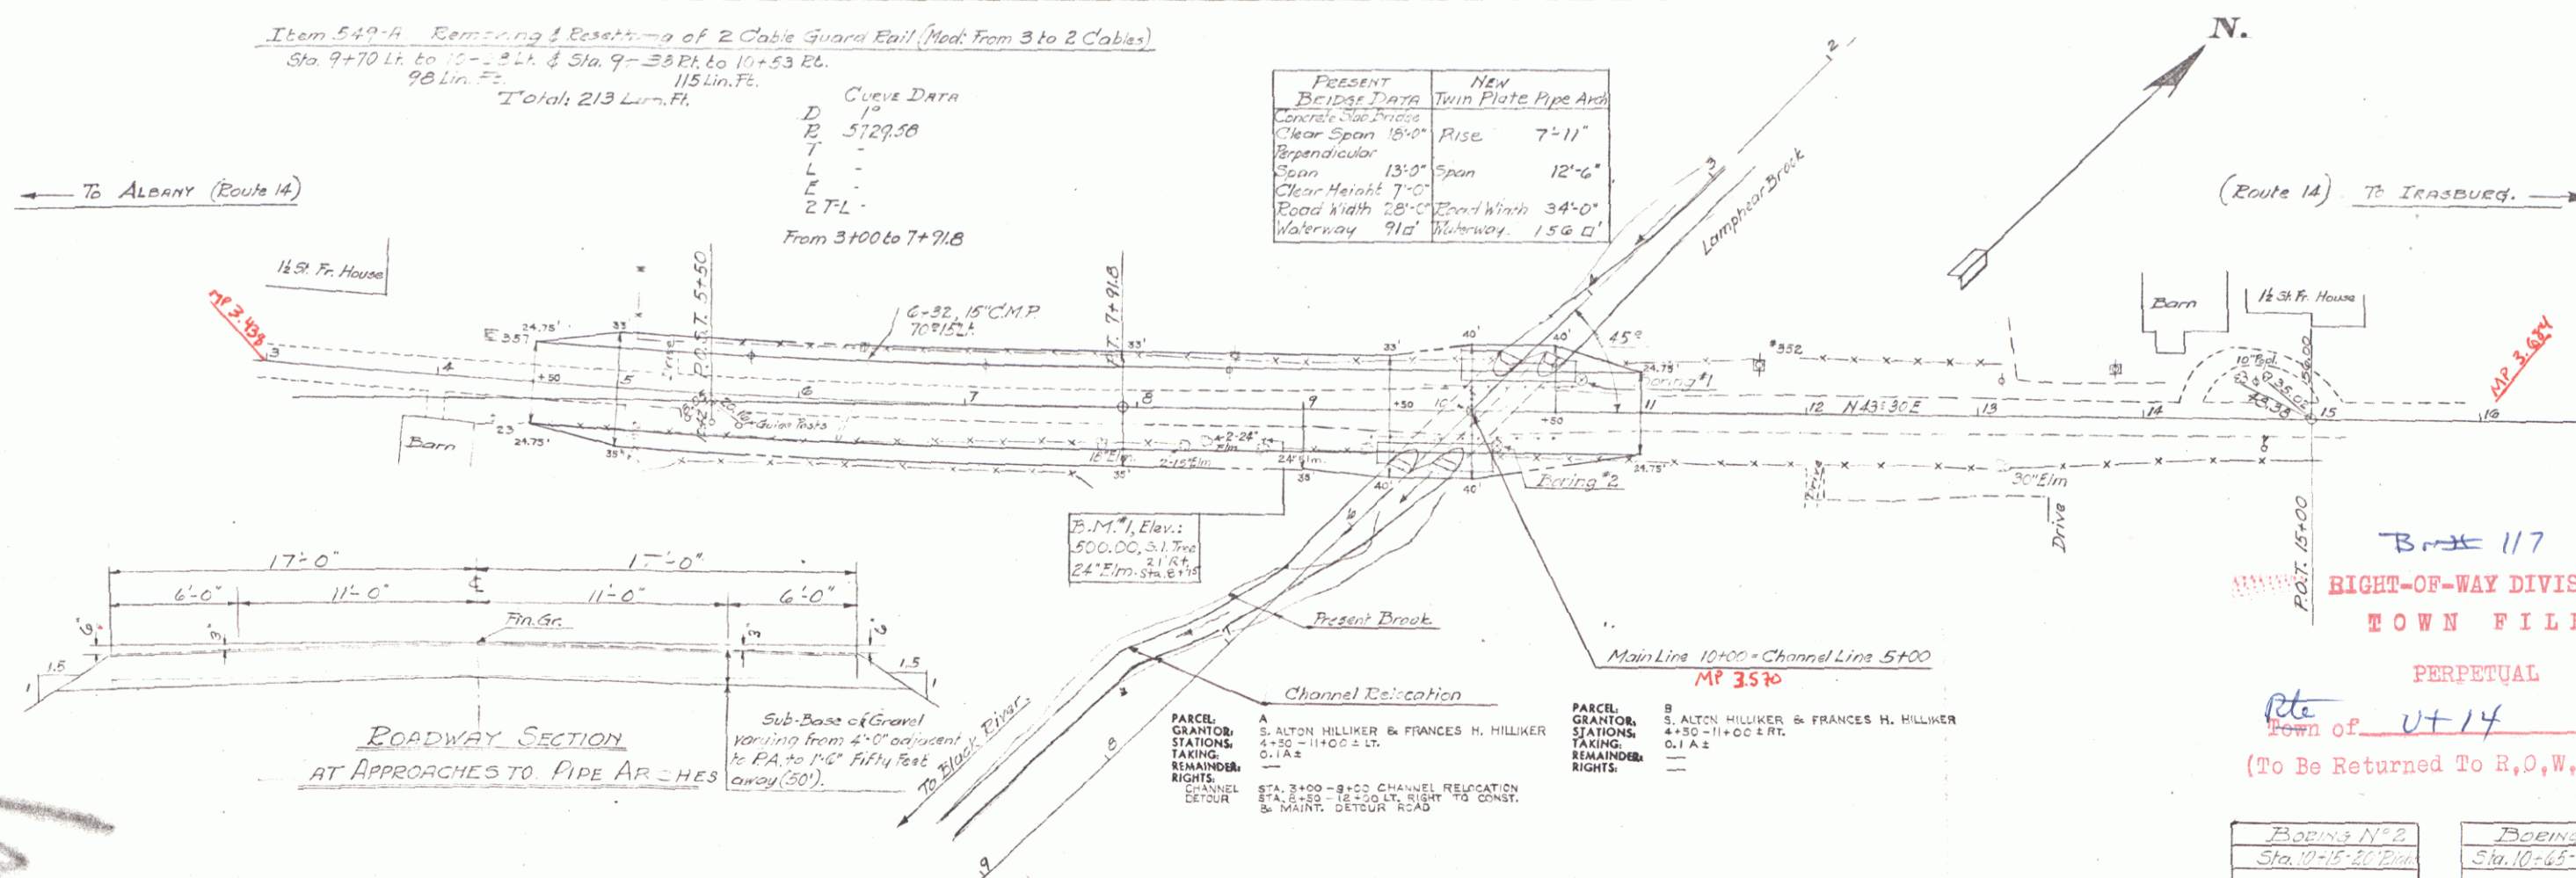

P.O. 7-15+
 Box 117
 RIGHT-OF-WAY DIVISION
 TOWN FILE

PERPETUAL
Rte
Town of U+14
(To Be Returned To R.O.W. Division)

[illegible]

ALDANY
 Point: PROFILE #BORINGS
 ROUTE 16
 Section: Horizontal 145'-0"
 Vertical 1"=10'-0"
Project MA 251/2503 M/60.
 Drawn by I.E.B. 3/61
 Checked by J.J.P. 6/61
 Date: 6/1/61
 Pin #00R77

16 SHEETS LIST OF SHEETS

	1. PLAN & PROFILE	
	2. PLANS & ELEVATIONS	
	3. DETAILS OF PLATE PIPE ARCH No. 1	
	4. DETAILS OF PLATE PIPE ARCH No. 2	
	5. DETAILS OF PLATE PIPE ARCH No. 1 & No. 2	
	6. EROSION CONTROL	
	7-10 ROADWAY X SECTIONS	
	11-14 CHANNEL X SECTIONS	

4 15. BRONCHIDES, SIGNS, & LIGHTS (FOR BRONCHES) S.O. E-1

SHEET NO. 1 OF 15