

SHEET NO.	TITLE	PAGE
1	TYPICAL CROSS-SECTION OF IMPROVEMENT	DOUBLE TACK COAT OF REFINED TAR WITH PEASTONE SEAL, ITEM 312-A (MODIFIED)
2	BANKING AND WIDENING TABLES	
3	QUANTITY SHEET (DRAINAGE)	
4	QUANTITY SHEET (ITEMS)	
5	EARTHWORK SHEETS	
6-16	PLAN AND PROFILE SHEETS	
17-34	STANDARD STRUCTURE SHEET	S-40 BARRICADES, SIGNS AND LIGHTS
35	"	S-41 TYPICAL GRADING
36	"	S-45-45 PLANK GUARD RAIL
37	"	S-46-45 BOUNDARY MARKERS
38	"	S-47-45 PIPE CULVERTS
39	"	S-48-45 THREE CABLE GUARD RAIL WITH STEEL POSTS
40	"	SC-1 BOX CULVERT
41	"	SC-21 BOX CULVERT (DETAILS)
42	"	
43-47	CROSS SECTIONS	

STANDARD STRUCTURES SHEETS APPROVED BY THE CHIEF ENGINEER, VERMONT STATE DEPARTMENT OF HIGHWAYS.



S-40 JUNE 10, 1950
S-46-45 JAN. 16, 1950
S-47-45 JAN. 16, 1950
S-48-46 MAY 13, 1946

PROJECT NAME AND NUMBER	TYPE	PAVEMENT AREA
JOHNSON HYDE PARK	DELT TYPE ASPHALT WITH PEASTONE SEAL	53,721 SQ.
RECORD PLANS MATERIALS		
GRAVEL - HOWARD PIT, LOCAL	R.C.P. - VERMONT CONCRETE PIPE CO., WINDSOR	
SAND - STERN'S PIT, LOCAL	AC/GMP - N.E. METAL CULVERT CO., BOSTON	
CEMENT - LONE STAR, GLEN FALLS, VERMONT, N.Y.	PAC/GMP - ORANGEBURG, H.P. BEARD, JOHNSON, VT.	
STEEL - TRUSCON STEEL CO., BOSTON, MASS.	CRM - BECK BROS. GRANITE CO., BARRIE, VT.	
CABLE - AMERICAN STEEL & WIRE CO., NEW HAVEN, CONN.	AGGREGATES FOR CONCRETE - A. JADEAU, JOHNSON, VT.	
CONTRACTOR - A.L. DOUGHERTY CO.	CRUSHED GRAVEL	
RES. ENGINEER - W.B. McALLISTER	CONTRACT DATED - DEC. 18, 1950	
INSPECTORS - E. GUYSSON	CONTRACT STARTED - MAY 3, 1951	
RECORD PLANS - M. VAN KLEE, JR.	CONTRACT COMPLETED - NOV 20, 1951	
	CONTRACT ACCEPTED - NOV 20, 1951	

Any further information concerning final quantities, amounts or other details relative to this project may be found in either the field book(s) or the estimate file.

STATE OF VERMONT STATE HIGHWAY DEPARTMENT PLAN AND PROFILE OF PROPOSED STATE HIGHWAY FEDERAL PROJECT TOWNS OF JOHNSON-HYDE PARK COUNTY OF LAMOILLE VERMONT ROUTE 100-C JOHNSON-HYDE PARK ROAD

BEGINNING AT A POINT 2,005.0 FEET EASTERLY OF THE INTERSECTION OF VERMONT ROUTES 15 AND 100-C AND EXTENDING EASTERLY
21,976.8 FEET EXCLUDING BRIDGES 3817.5
LENGTH OF NON-GOV'T PARTICIPATION 5,814.4 FT. = 0.723
LENGTH OF GOV'T PARTICIPATION 18,159.3 FT. = 3.439
LENGTH OF PROJECT 21,973.7 FT. = 4.162 MI.
21,976.8

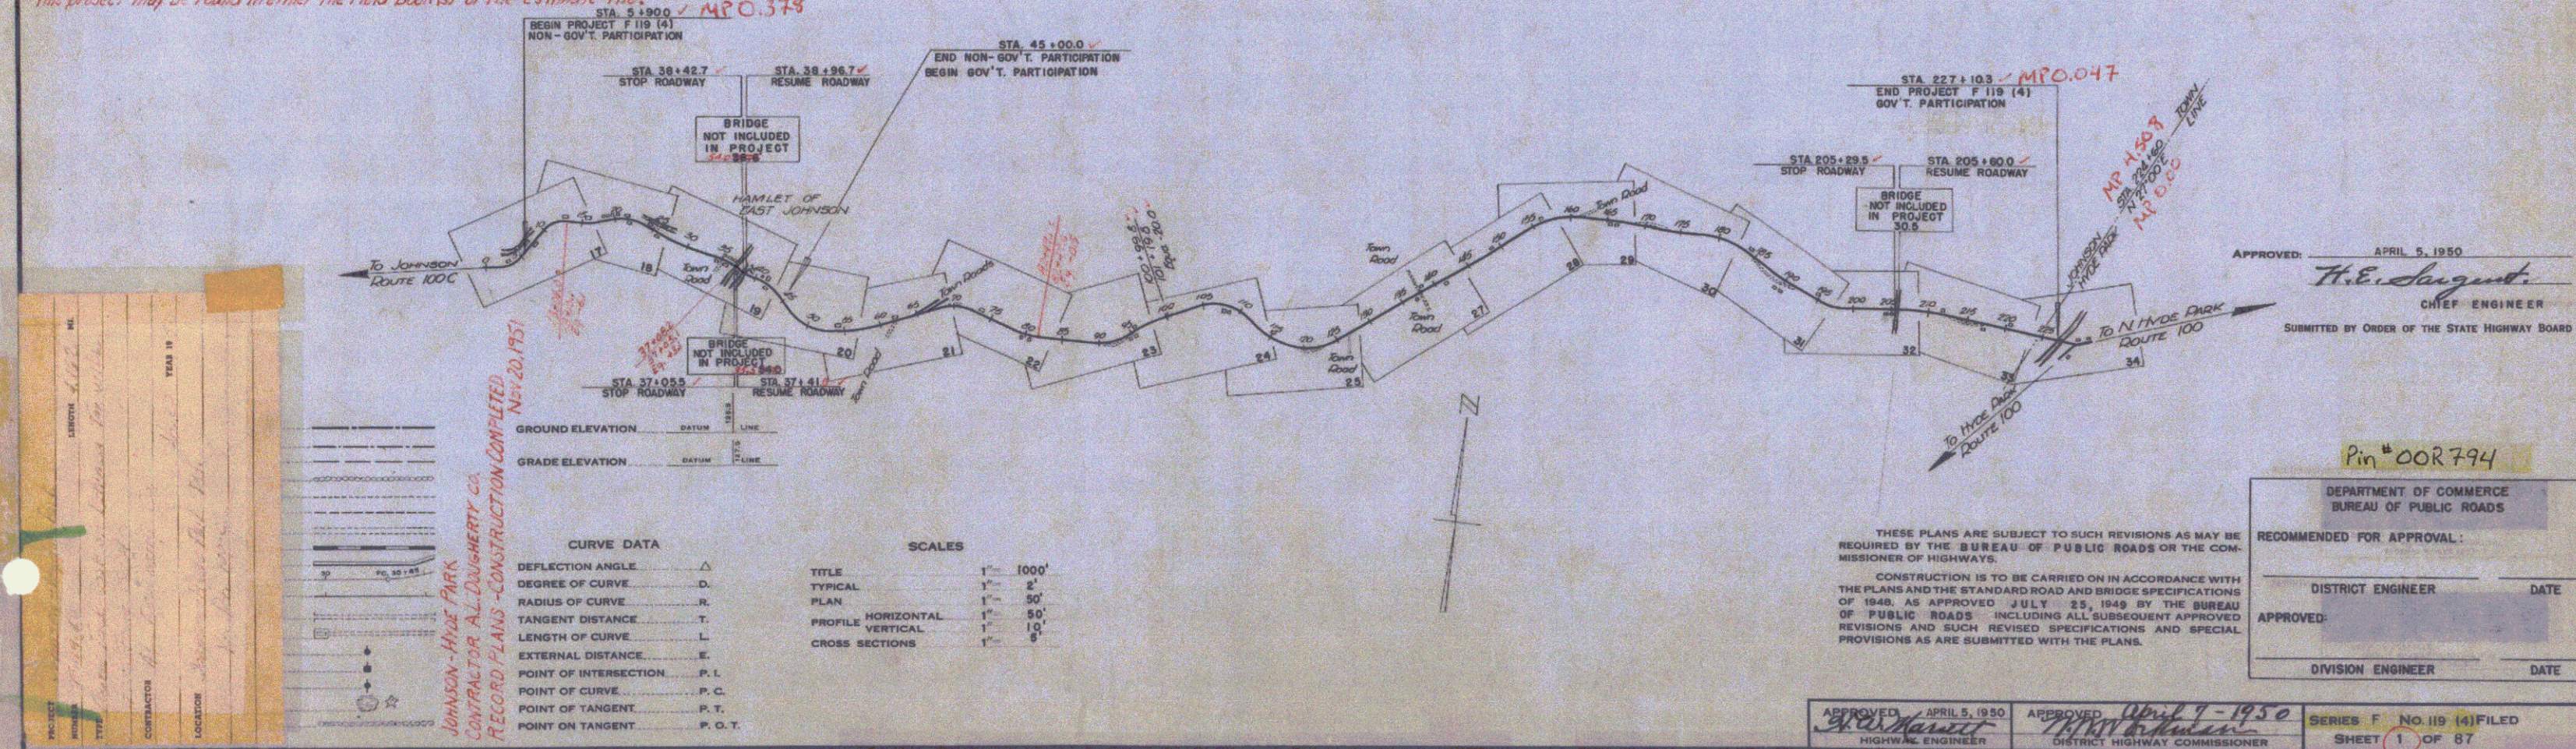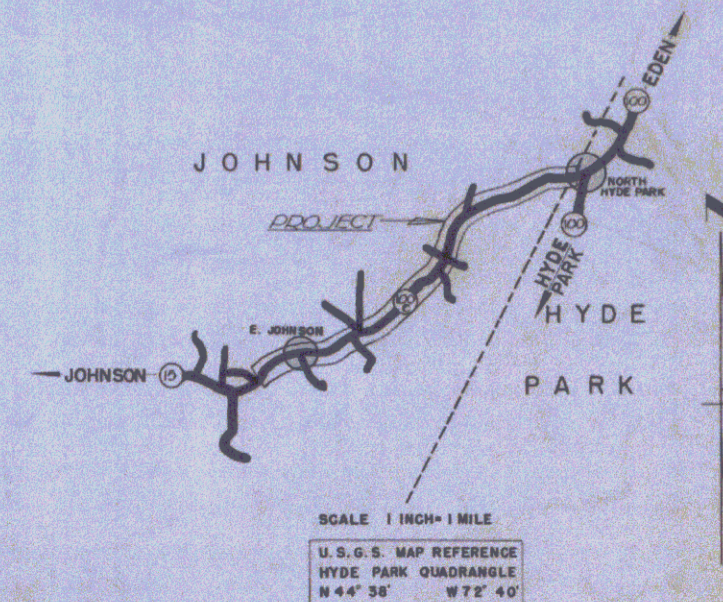

APPROVED: APRIL 5, 1950
H.E. August
CHIEF ENGINEER
SUBMITTED BY ORDER OF THE STATE HIGHWAY BOARD

Pin #00794
DEPARTMENT OF COMMERCE
BUREAU OF PUBLIC ROADS
RECOMMENDED FOR APPROVAL:
DISTRICT ENGINEER DATE
APPROVED:
DIVISION ENGINEER DATE

APPROVED: APRIL 5, 1950
H.E. August
HIGHWAY ENGINEER
APPROVED: April 9, 1950
H.E. August
DISTRICT HIGHWAY COMMISSIONER
SERIES F NO. 119 (4) FILED
SHEET 1 OF 87