


ITEM 542 THREE CABLE GUARD RAIL
W/STEEL POSTS
STA 43+55 - STA 44+00 LT.
STA 43+45 - STA 44+25 RT.


ITEM 543 CONCRETE & DISPOSED
OF EXISTING BRIDGE
STA 43+45 - STA 44+00 RT.
STA 43+55 - STA 44+25 LT.
STA 44+00 - STA 44+25 RT.
STA 44+00 - STA 44+25 LT.

EXISTING BRIDGE
CONC. T-BEAM
CLEAR SPAN 31'-0"
PERPENDICULAR SPAN 10'-0"
CLEAR ROADWAY 10'-0"
CLEAR HEIGHT 13'-0"
PATTERN AREA 2'-0" W/
CONSTRUCTED 1986

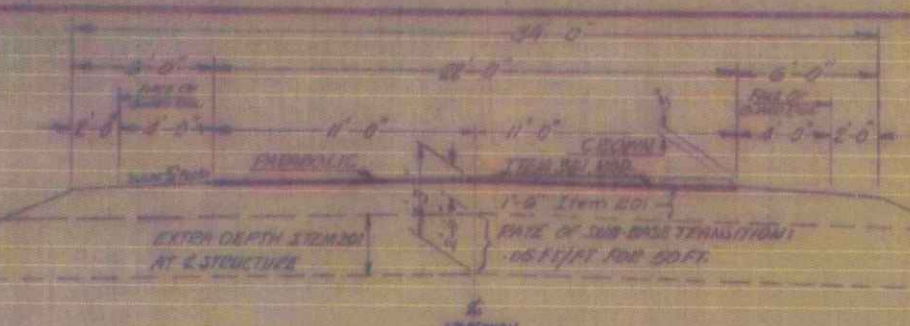

TYPICAL ROADWAY SECTION
SCALE: 1" = 10'-0"

BRIDGE BETTERMENT PROJECT
IN THE TOWN OF WAITSFIELD, COUNTY OF WASHINGTON, ON
VARIABLE ROUTE 100, BEGINNING AT A POINT 0.40 MILES
NORTHERLY OF THE WARREN - WAITSFIELD TOWN-LINE AND
EXTENDING NORTHERLY 0.02 MILES.
PROJECT LENGTH = 0.02 MILES = 154 FEET.

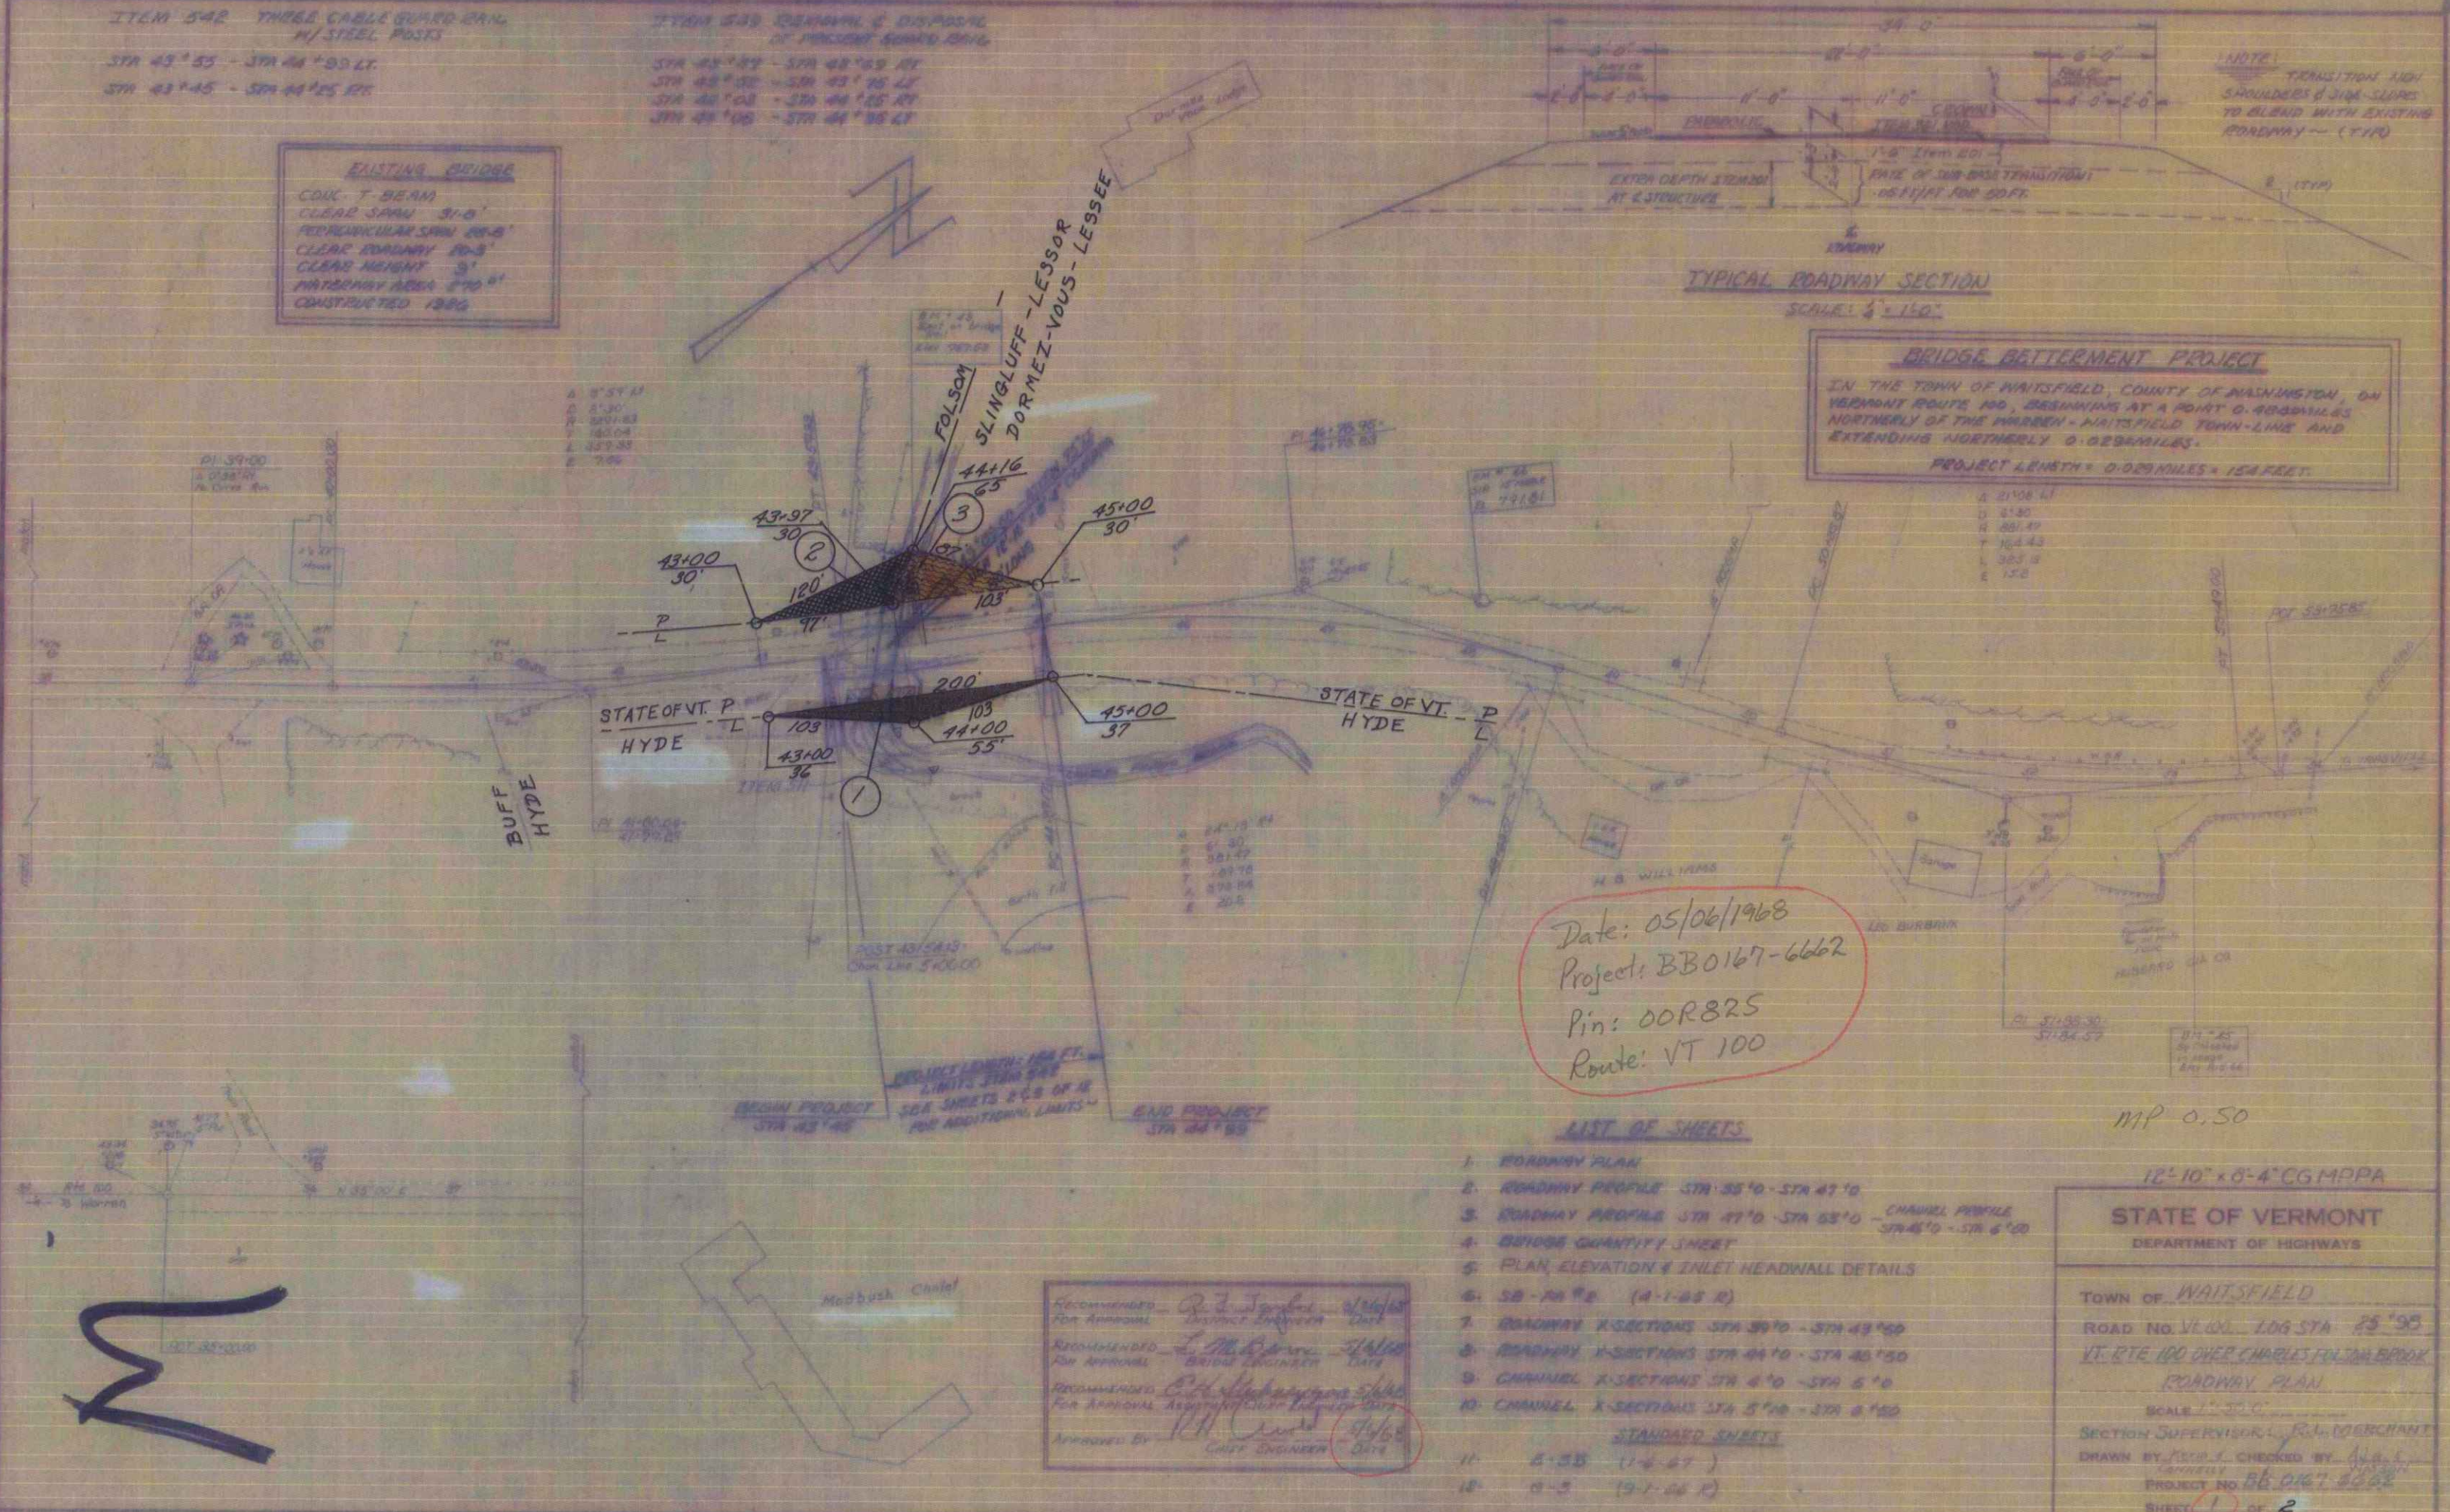

- LIST OF SHEETS**
1. ROADWAY PLAN
 2. ROADWAY PROFILE STA 38+0 - STA 47+0
 3. ROADWAY PROFILE STA 47+0 - STA 48+0 - CHANNEL PROFILE STA 47+0 - STA 48+0
 4. BRIDGE QUANTITY SHEET
 5. PLAN ELEVATION & INLET HEADWALL DETAILS
 6. SB - PA 1/2 (A-1-65 R)
 7. ROADWAY X-SECTIONS STA 39+0 - STA 43+00
 8. ROADWAY X-SECTIONS STA 44+0 - STA 45+00
 9. CHANNEL X-SECTIONS STA 4+0 - STA 5+0
 10. CHANNEL X-SECTIONS STA 5+0 - STA 6+00
 11. 6-35 (1-4-67)
 12. 6-3 (1-1-66 R)

Recommended For Approval: *[Signature]* 5/6/68
Recommended For Approval: *[Signature]* 5/6/68
Recommended For Approval: *[Signature]* 5/6/68
Approved By: *[Signature]* 5/6/68
Chief Engineer

12" 10" x 6" 4" CG MPPA

STATE OF VERMONT
DEPARTMENT OF HIGHWAYS

TOWN OF WAITSFIELD
ROAD NO. 100 LOG STA 25+95
VT. RTE 100 OVER CABLES FOR BRIDGE
ROADWAY PLAN
SCALE 1" = 10'-0"

SECTION SUPERVISOR: R. J. MORGAN
DRAWN BY: R. J. MORGAN
CHECKED BY: *[Signature]*
PROJECT NO. BB 0167-6662
SHEET 1 OF 2