



PLAN	DATE	BY	CHECKED
PLAN	10-27-52	W.H.C.	W.H.C.
NOTE BOOK	10-27-52	W.H.C.	W.H.C.
NO.			

BEGIN VT RTE. 100
STA 0+33.4

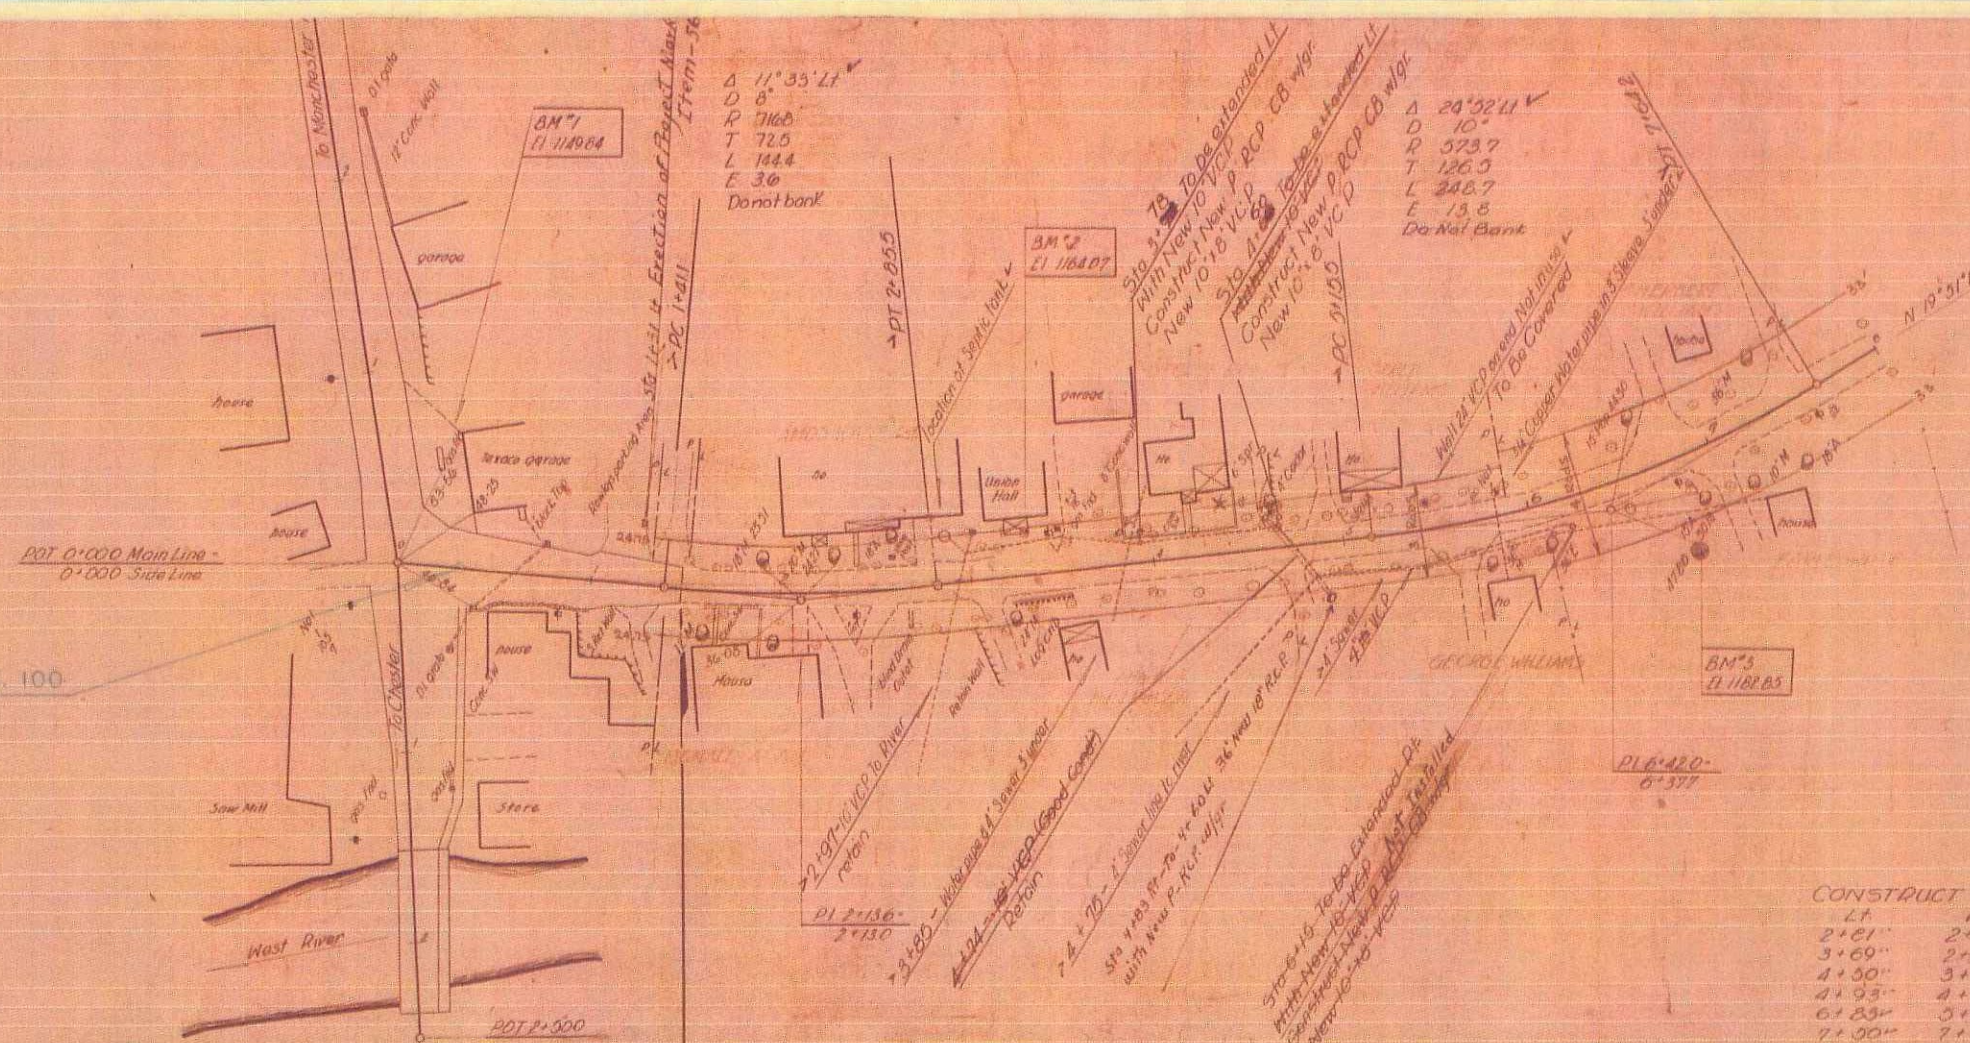

CONSTRUCT DRIVES	
LI	RI
2+51"	2+57"
3+60"	3+45" (Approach to Train Road)
4+50"	3+15"
4+93"	4+75"
6+83"	5+65"
7+00"	7+00"

PLAN	DATE	BY	CHECKED
PLAN	10-27-52	W.H.C.	W.H.C.
NOTE BOOK	10-27-52	W.H.C.	W.H.C.
NO.			

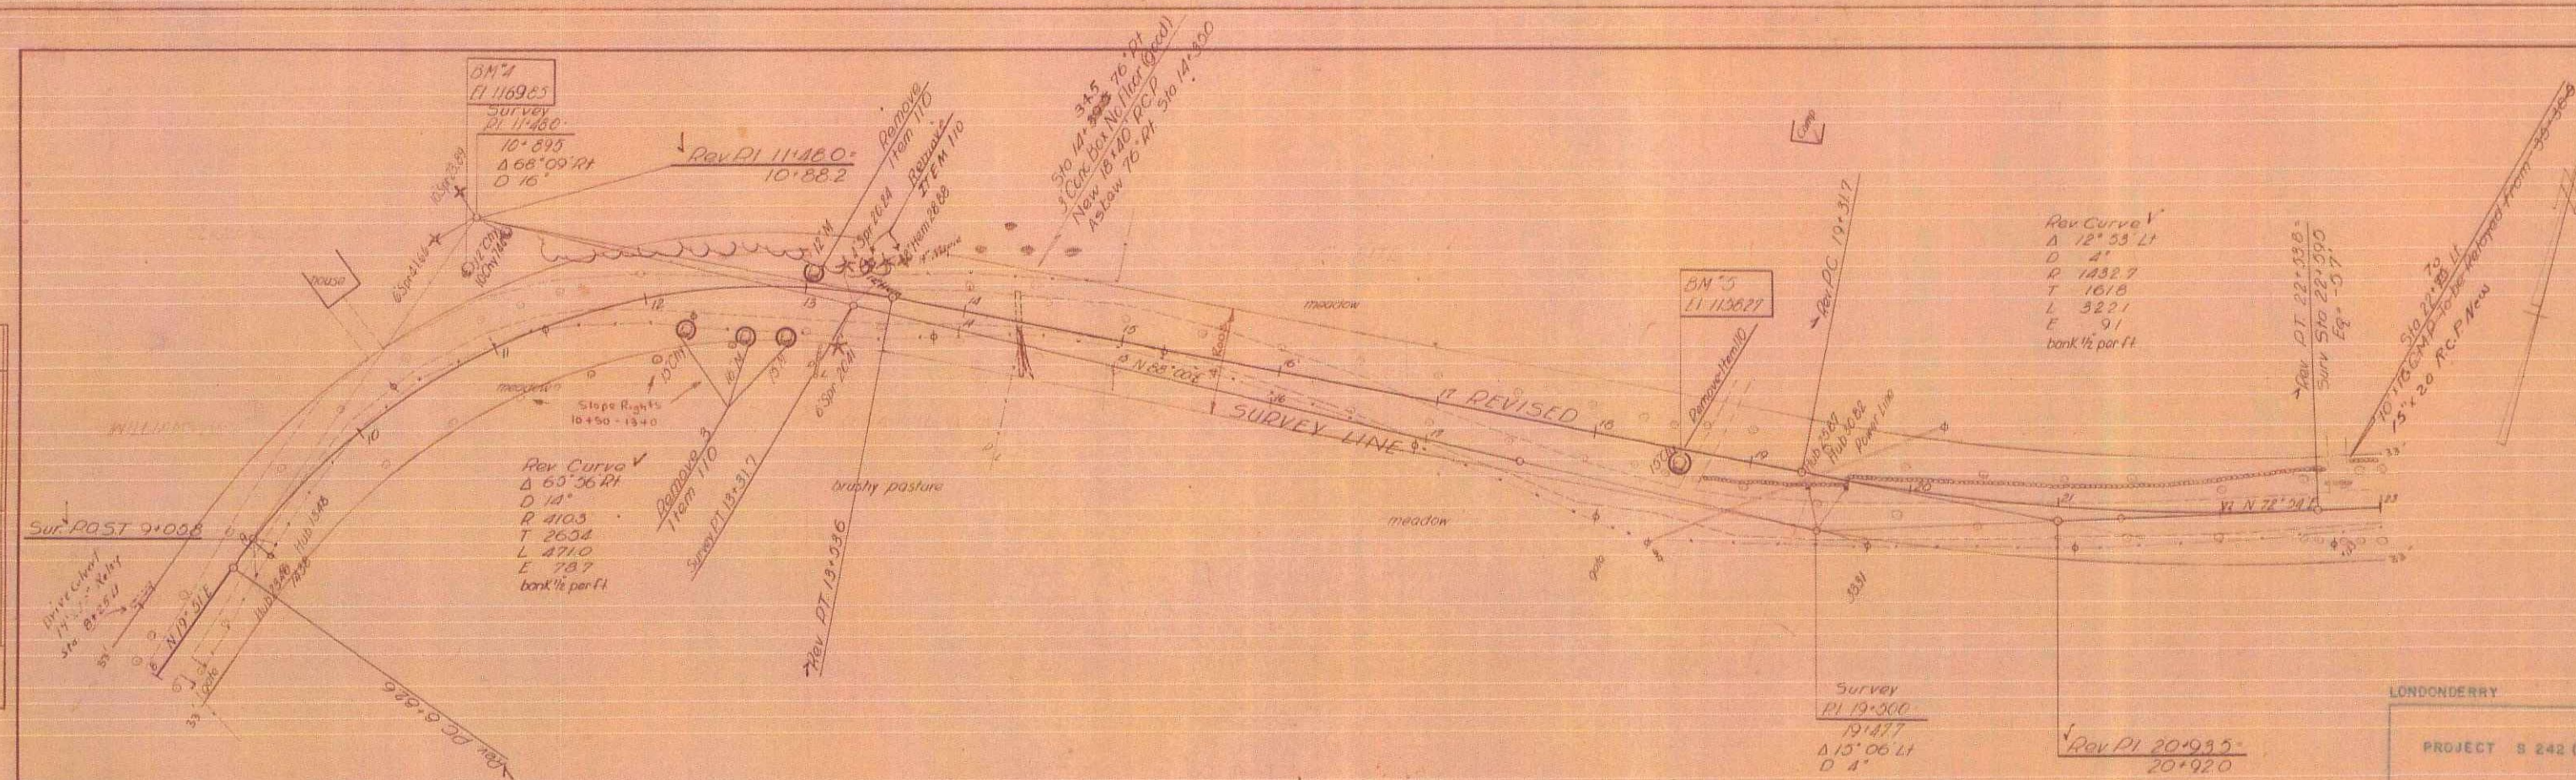

CONSTRUCT DRIVES	
LI	RI
12+50"	13+30"
18+67"	
22+70"	
RI 17	

LONDONDERRY
PROJECT S 242 (2) 1952
SHEET 2 OF 3
4