
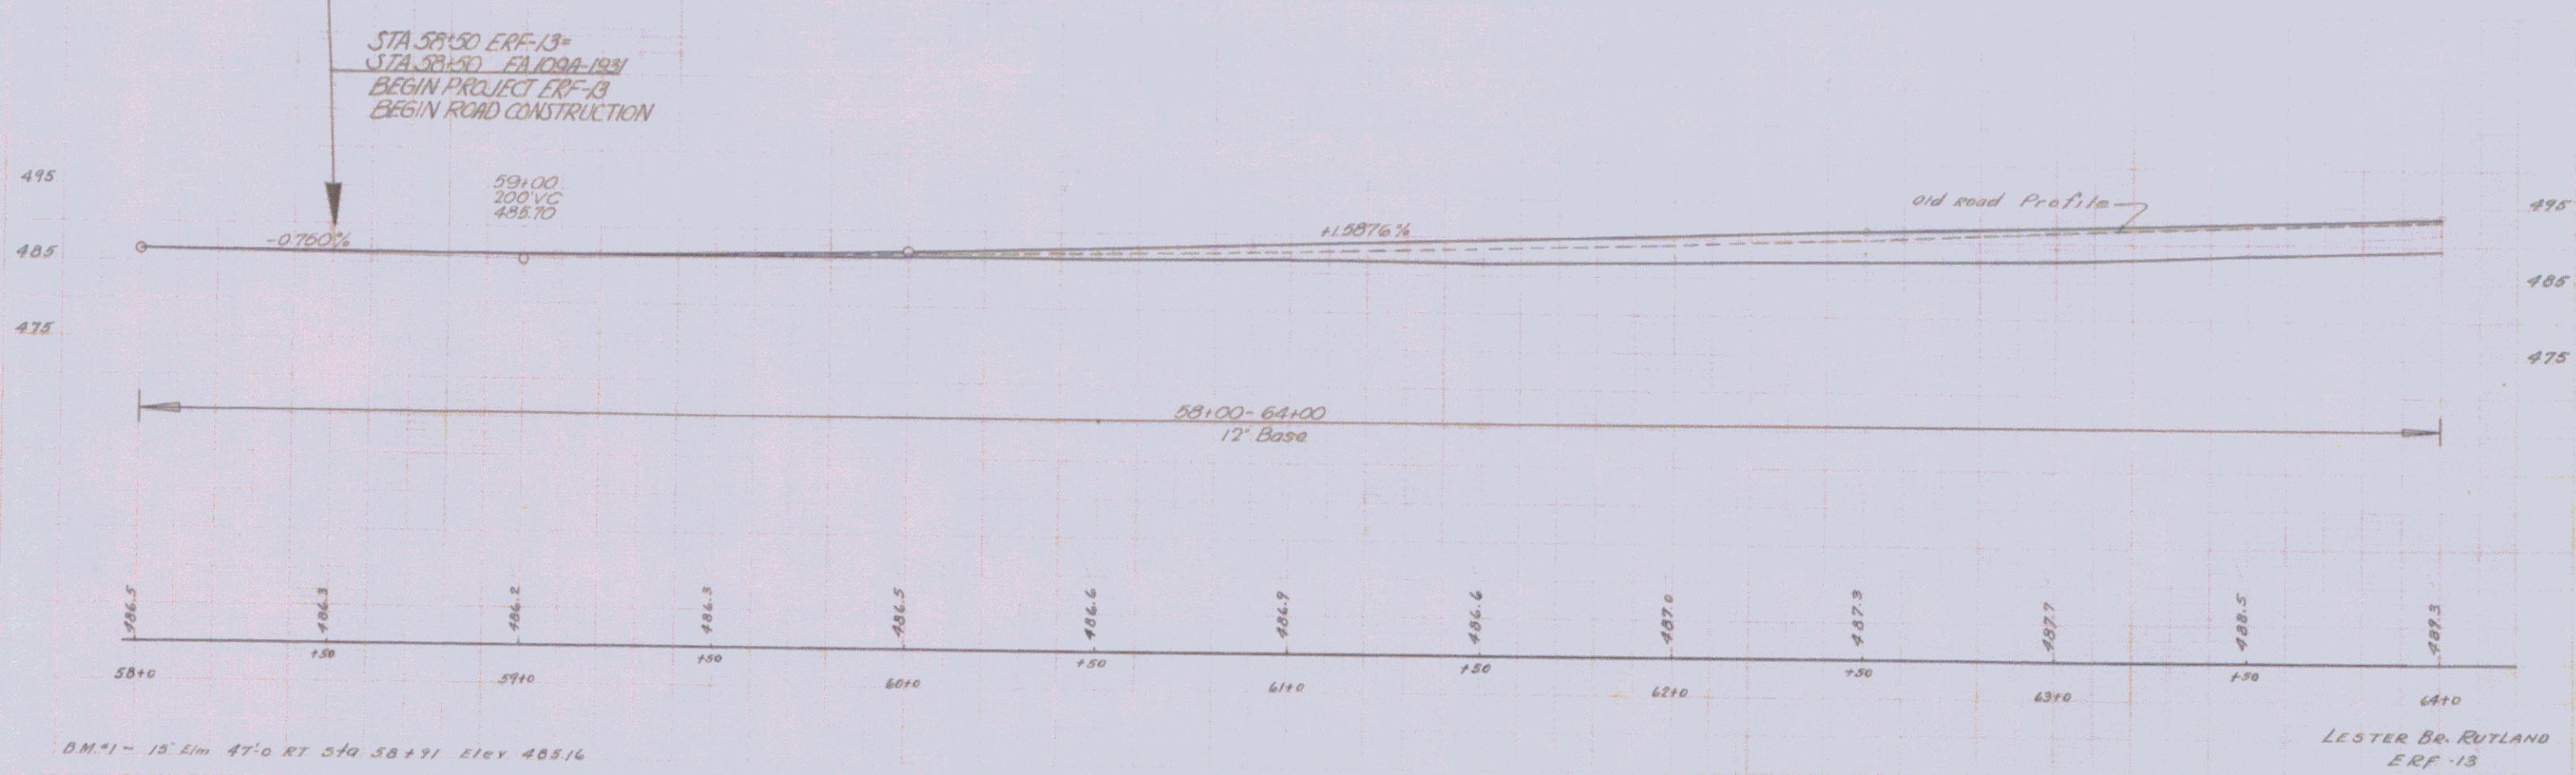


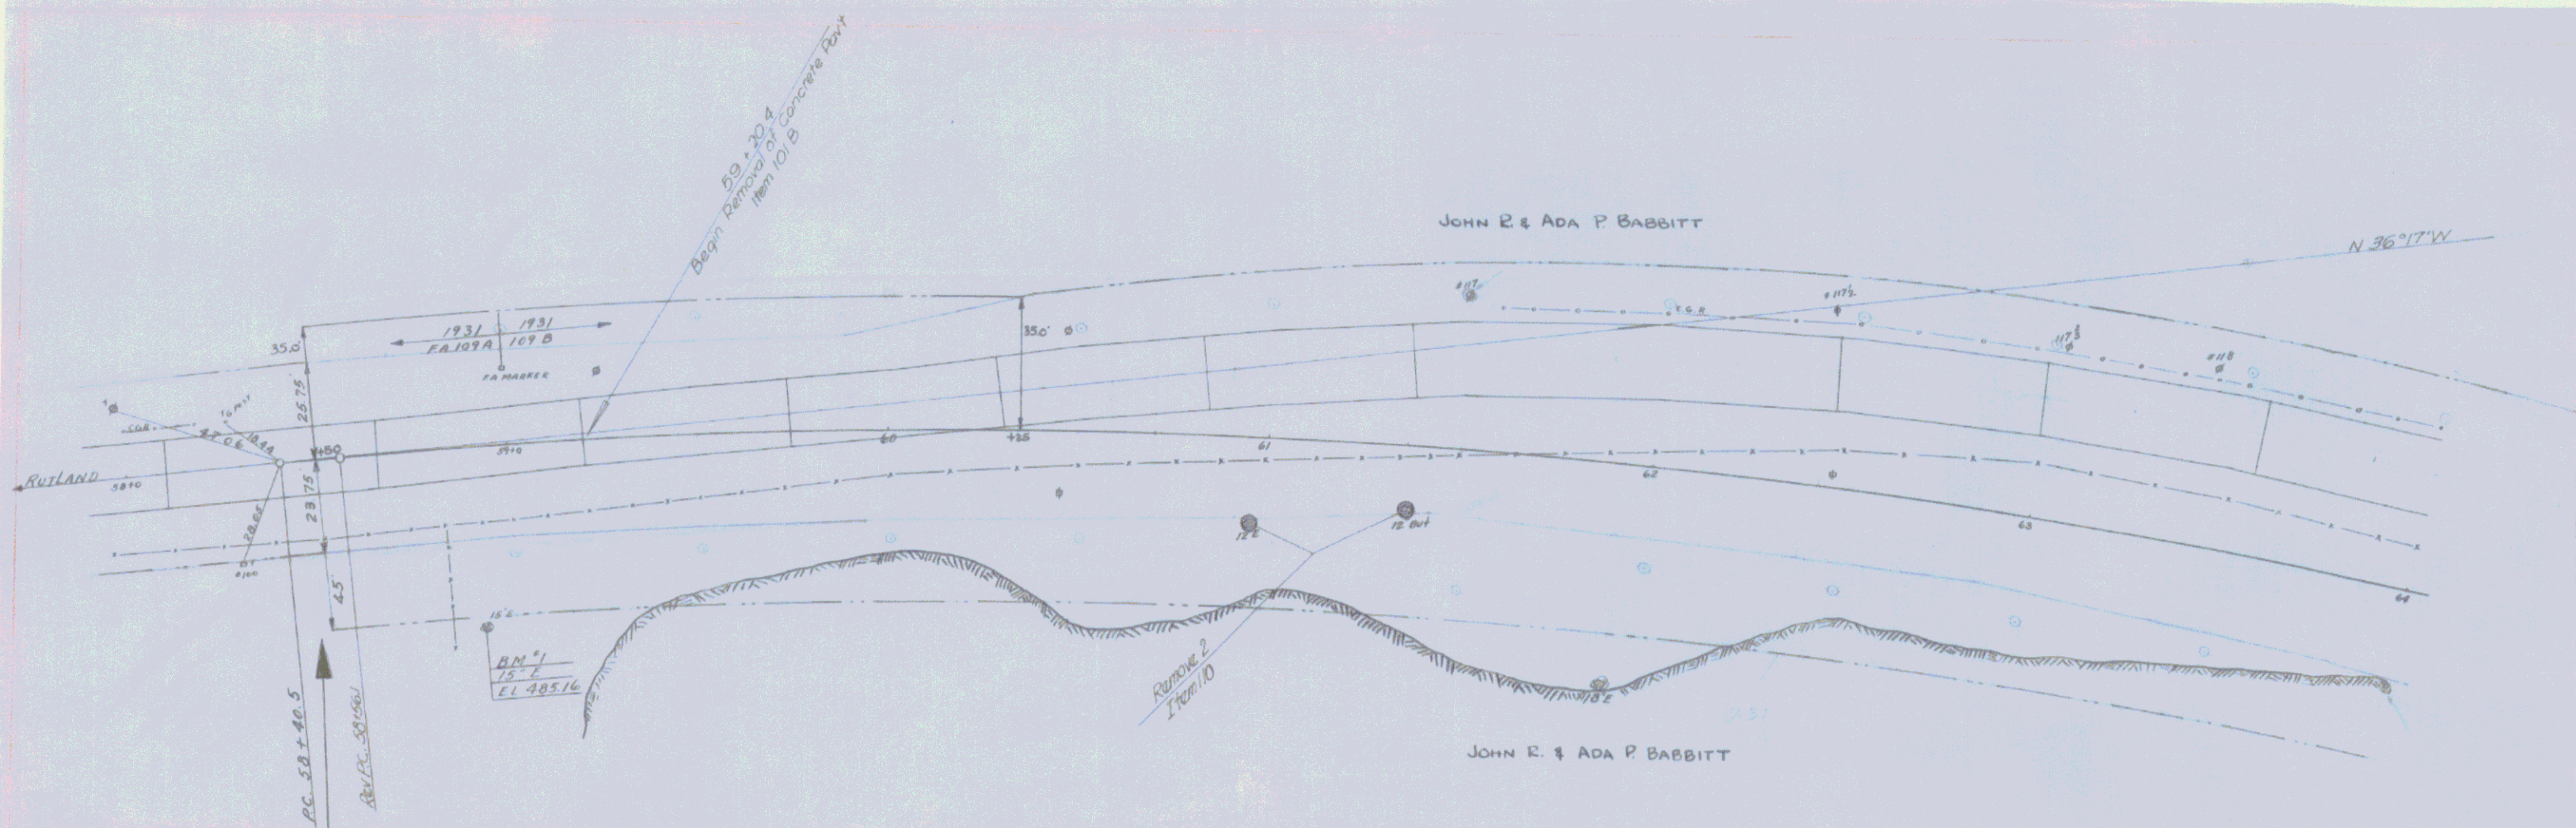

DM #1 - 15' Elm 47'0 RT STA 58+91 Elev 485.16

LESTER BR. RUTLAND
ERF-13
Sheet 4 of 24