


POOR ORIGINAL COPY

NO.	DATE	BY	REVISION
1	10/1/50	J. H. L.	1. 10/1/50
2	10/1/50	J. H. L.	2. 10/1/50
3	10/1/50	J. H. L.	3. 10/1/50
4	10/1/50	J. H. L.	4. 10/1/50
5	10/1/50	J. H. L.	5. 10/1/50
6	10/1/50	J. H. L.	6. 10/1/50
7	10/1/50	J. H. L.	7. 10/1/50
8	10/1/50	J. H. L.	8. 10/1/50
9	10/1/50	J. H. L.	9. 10/1/50
10	10/1/50	J. H. L.	10. 10/1/50

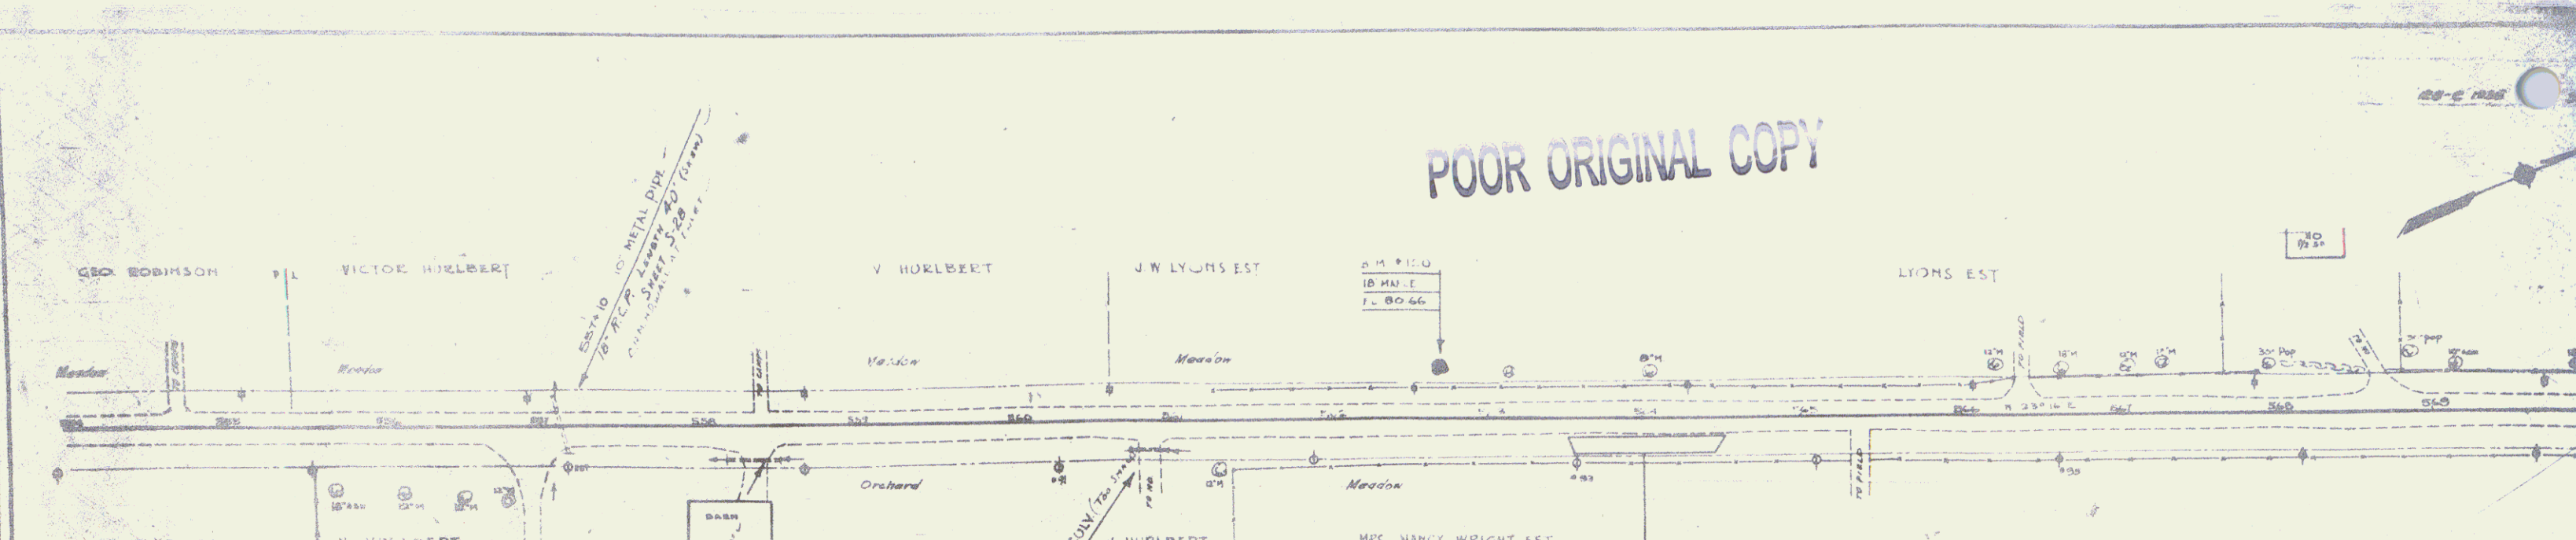

563+50 to 564+50
18\"/>

564+50 to 565+50
18\"/>

MRS. NANCY WRIGHT EST.
SEE JAS. LARUSKY, AQT

563+50-564+50 RT
PARKING AREA


SPECIAL 1 ON 4 SLOPES
310 561+50 TO 562+50 RT

SPECIAL DITCH RT 562+50+00 TO 563+50+00

STA. TO STA.	LT.	RT.	LENGTH	WIDTH	SOFT
561+50	562+50	LT.	100'	7'	2450
562+50	563+50	LT.	100'	8'	1600
563+50	564+50	RT.	100'	10'	1000
564+50	565+50	RT.	100'	9'	3400
565+50	566+50	LT.	100'	10'	3000
566+50	567+50	LT.	100'	8'	3000
567+50	568+50	RT.	100'	9'	400
568+50	569+50	LT.	100'	6'	900
569+50	570+50	RT.	100'	9'	900
570+50	571+50	LT.	100'	8'	400
571+50	572+50	LT.	100'	10'	1500
572+50	573+50	RT.	100'	10'	1500
573+50	574+50	RT.	100'	9'	2100
574+50	575+50	LT.	100'	9'	3400

WEIGHT EST.

NO.	DATE	BY	REVISION
1	10/1/50	J. H. L.	1. 10/1/50
2	10/1/50	J. H. L.	2. 10/1/50
3	10/1/50	J. H. L.	3. 10/1/50
4	10/1/50	J. H. L.	4. 10/1/50
5	10/1/50	J. H. L.	5. 10/1/50
6	10/1/50	J. H. L.	6. 10/1/50
7	10/1/50	J. H. L.	7. 10/1/50
8	10/1/50	J. H. L.	8. 10/1/50
9	10/1/50	J. H. L.	9. 10/1/50
10	10/1/50	J. H. L.	10. 10/1/50

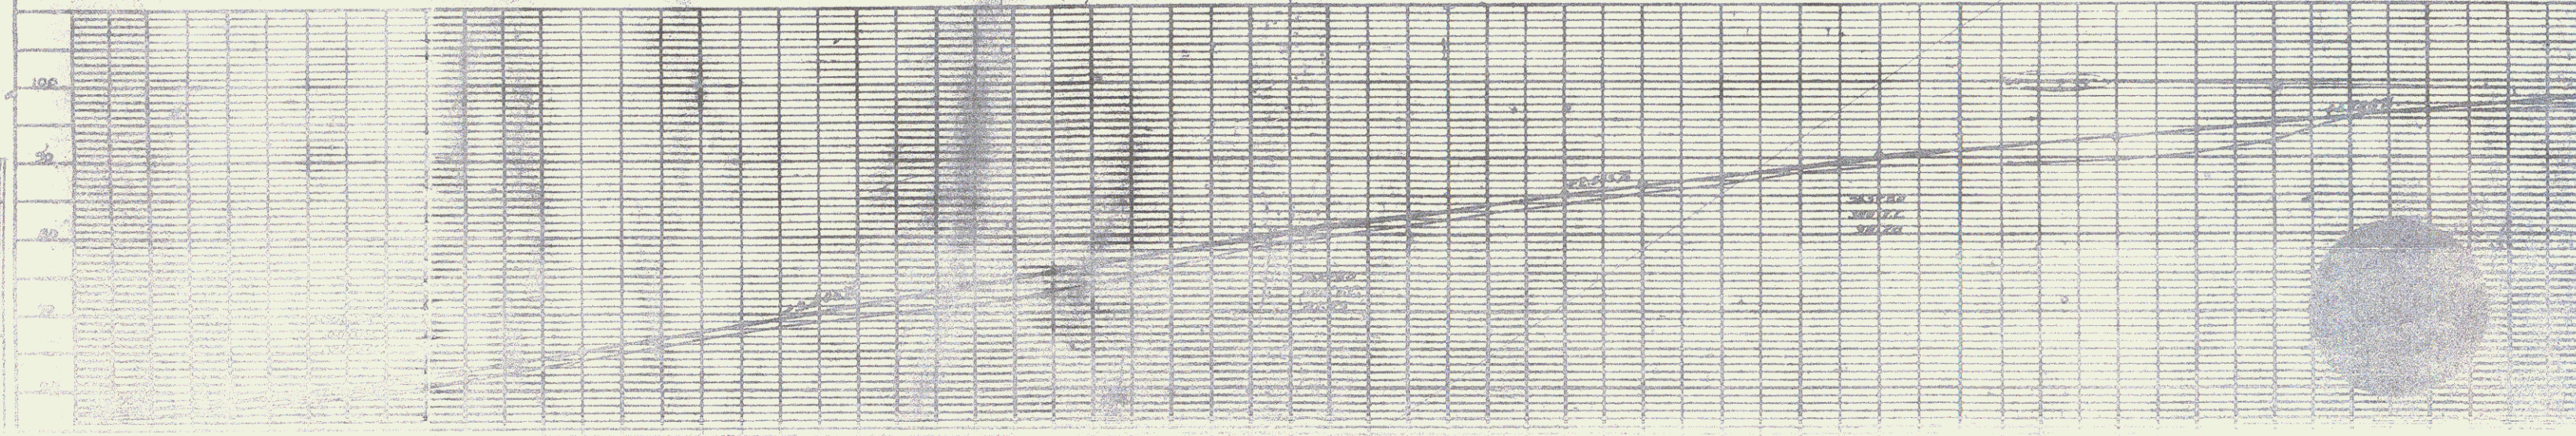

9

9