


TOWN OF WILMINGTON COUNTY OF WINDHAM VERMONT ROUTE 100 WILMINGTON-JAMAICA ROAD

BEGINNING AT VERMONT ROUTE 9 AND EXTENDING NORTHERLY
ON VERMONT ROUTE 100 TO THE WILMINGTON-DOVER TOWN LINE,
A DISTANCE OF 4.840 MILES ±

LENGTH OF PROJECT 25,559.60 FEET = 4.840 MILES

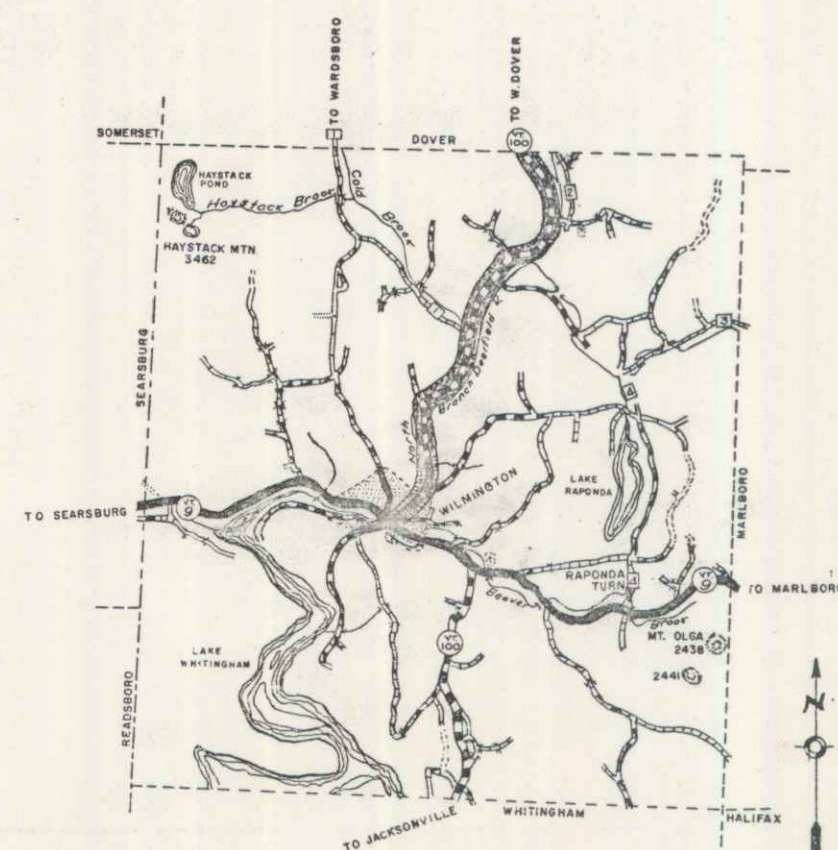

LEGEND

PROJECT 522(1) 1946
SURVEY BY MANNING AUG 1964

SCALE

0 0.5 1 MI

ROUTE: VT 100
TOWN: WILMINGTON
DATE: 08/01/1964
PROJECT: MM 2.52-7.36
PW: ~~SECRET~~
OTR 120

MP 2.52 - 7.36 (7.442)

RIGHT-OF-WAY DIVISION
TOWN FILE

PERPETUAL

pte
Town of VT 100

(To Be Returned To R.O.W. Division)



WILMINGTON

SURVEYED BY MANNING DATE AUG 64
DRAWN BY LAUFMAN DATE SEPT 64
TRACED BY DATE

VI ROUTE 100

PROJ. NO.
SHEET 1 OF 10


VT 100

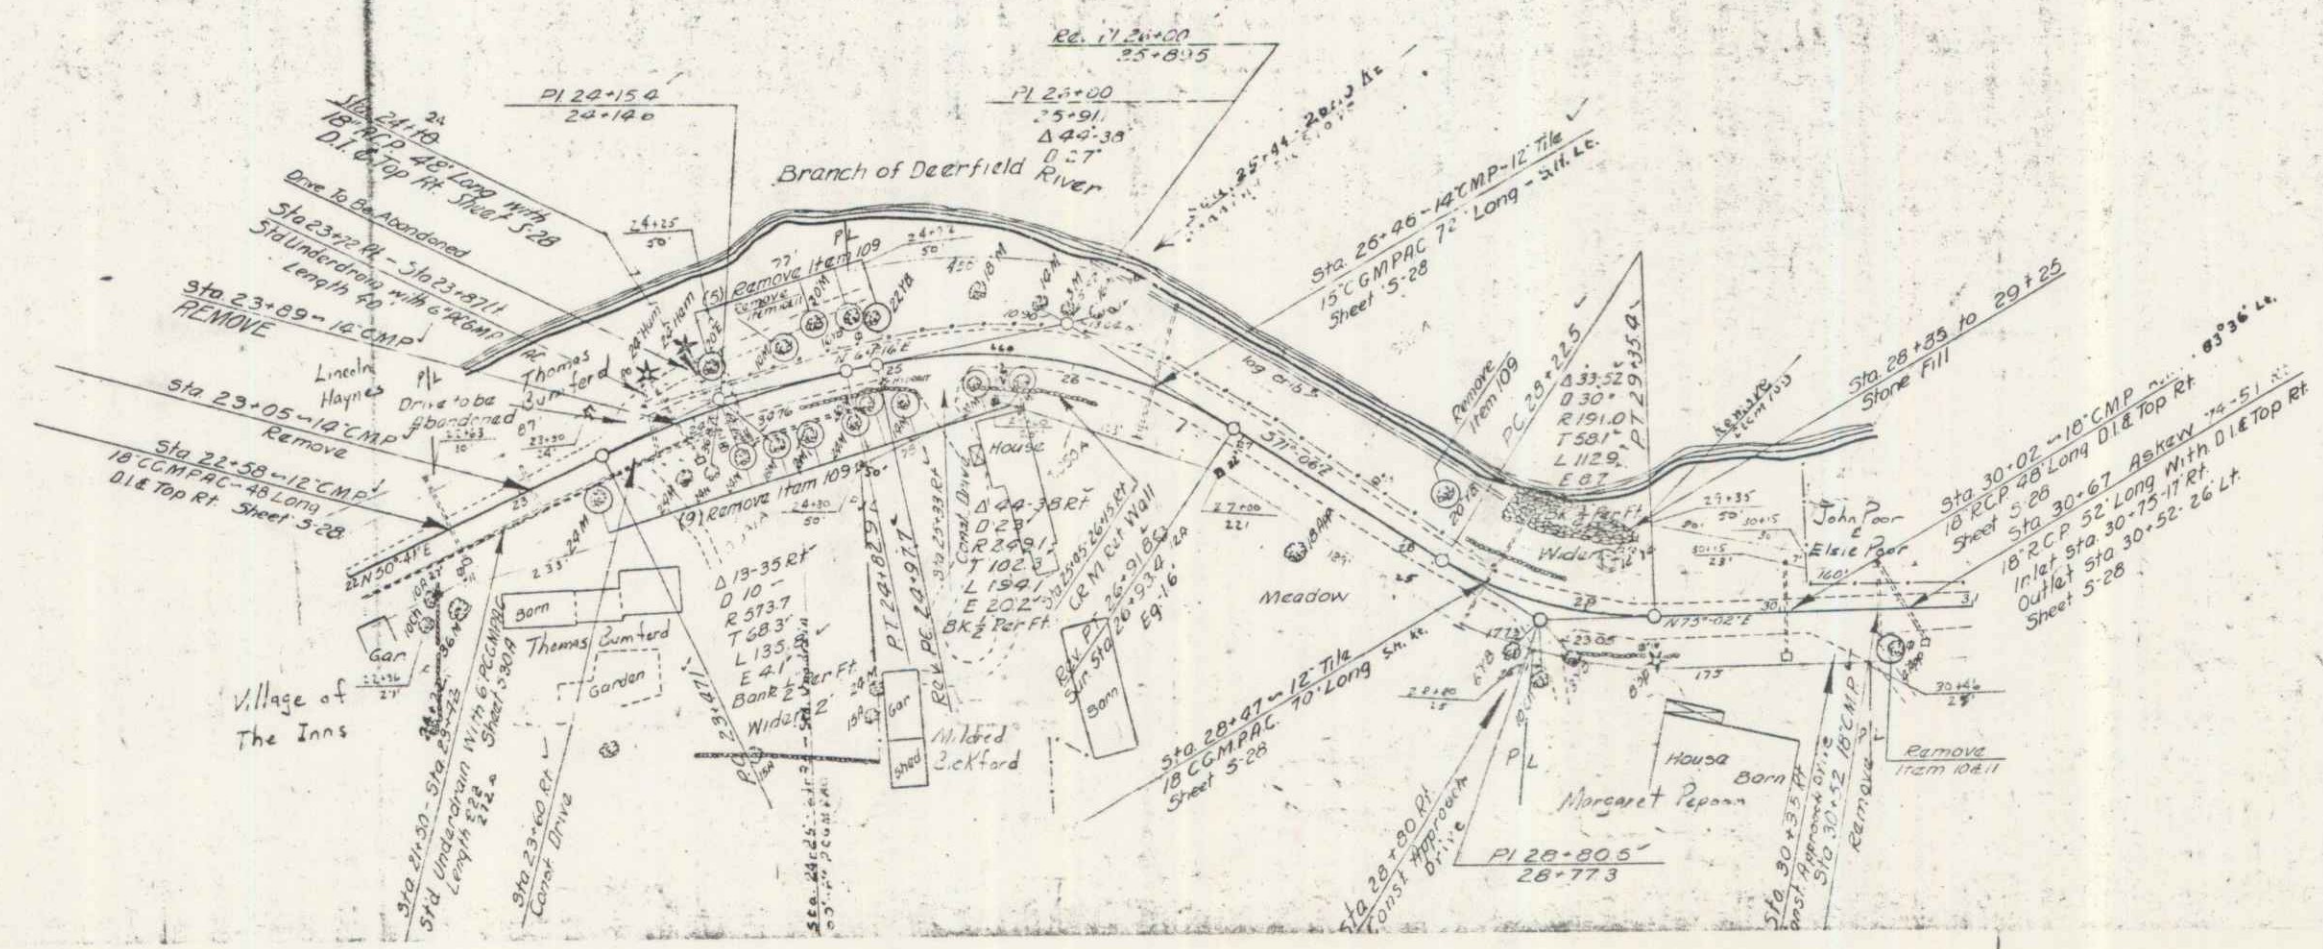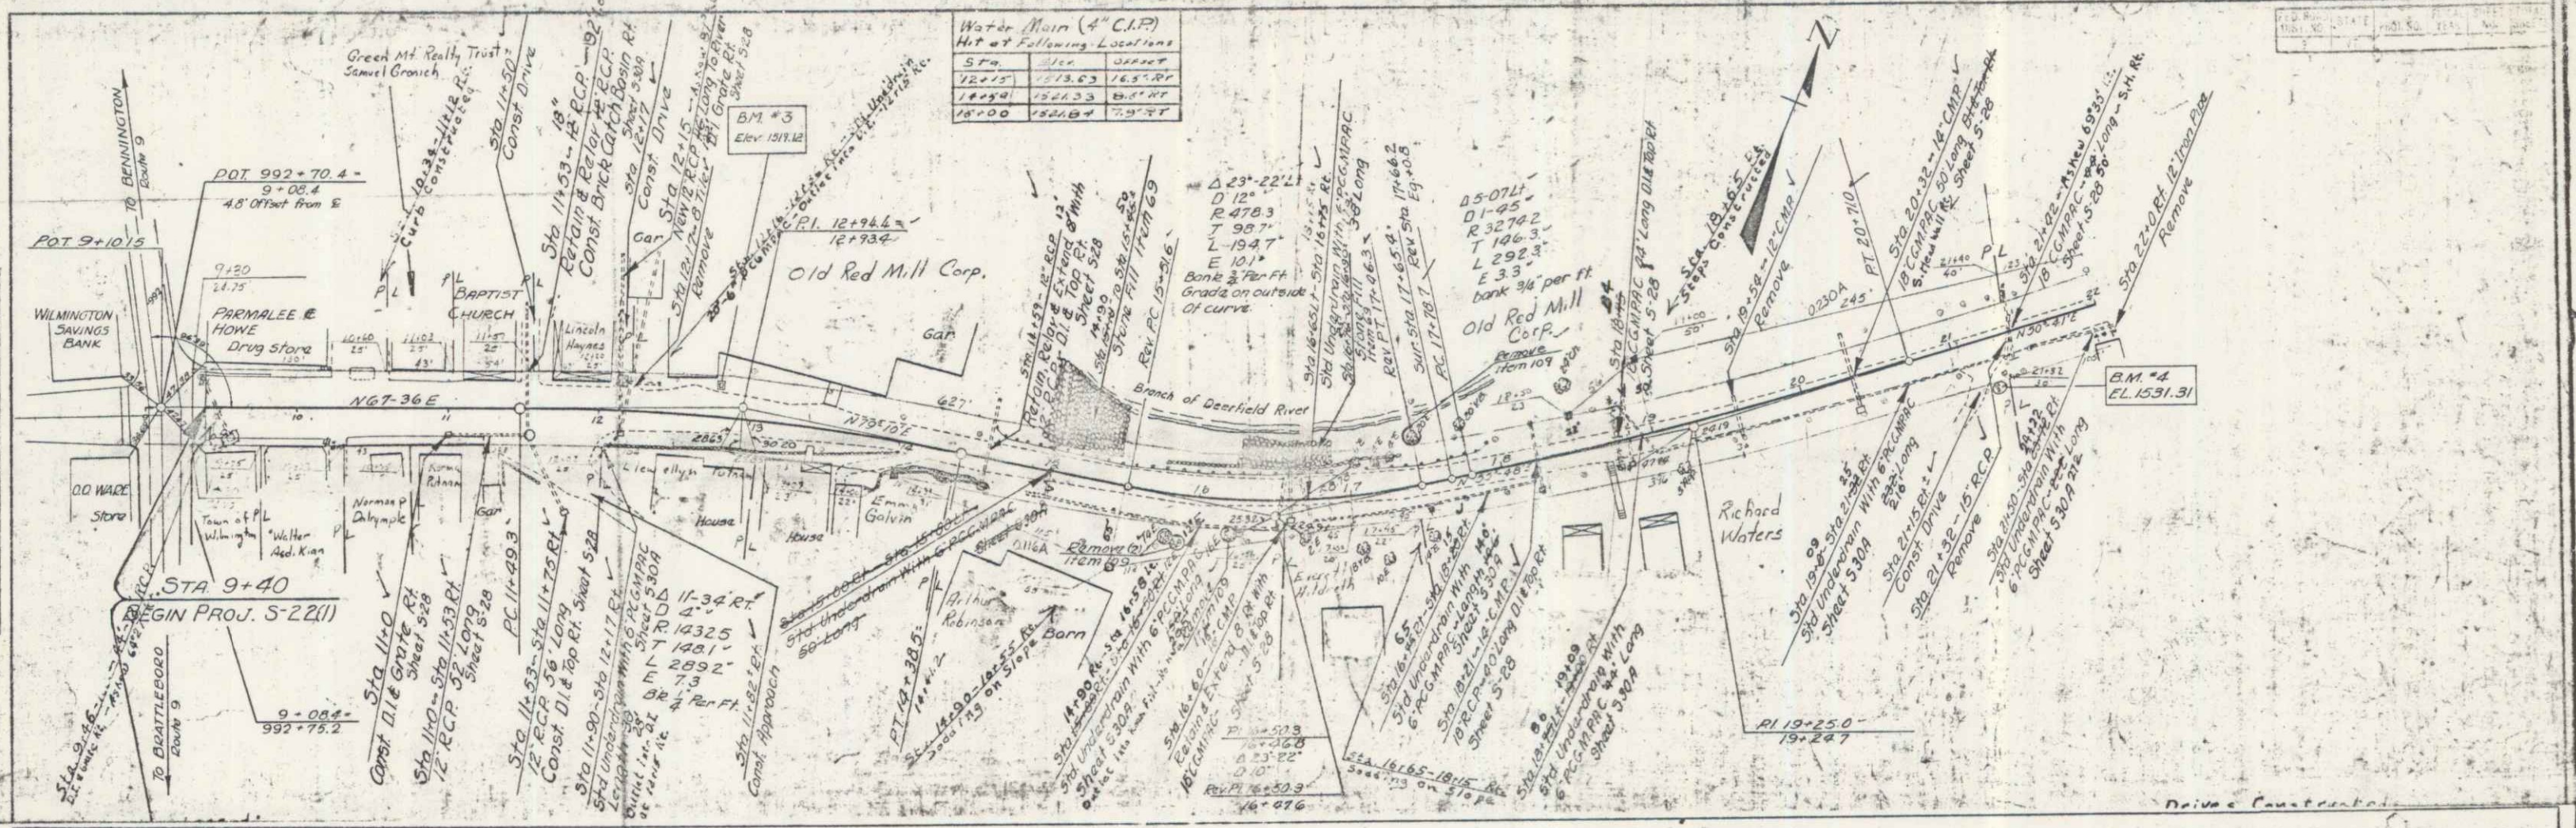


WILMINGTON
VT ROUTE 100
SHEET 2 OF 10

PLAN
 DRAWN BY
 CHECKED BY
 DATE
 NOTE BOOK
 NO. OF PAGES
 NO. OF SHEETS



Sta 33+0-51+34+0 LT
 Poor foundation material (Muck)
 to be disposed of as directed by
 the Engineer.

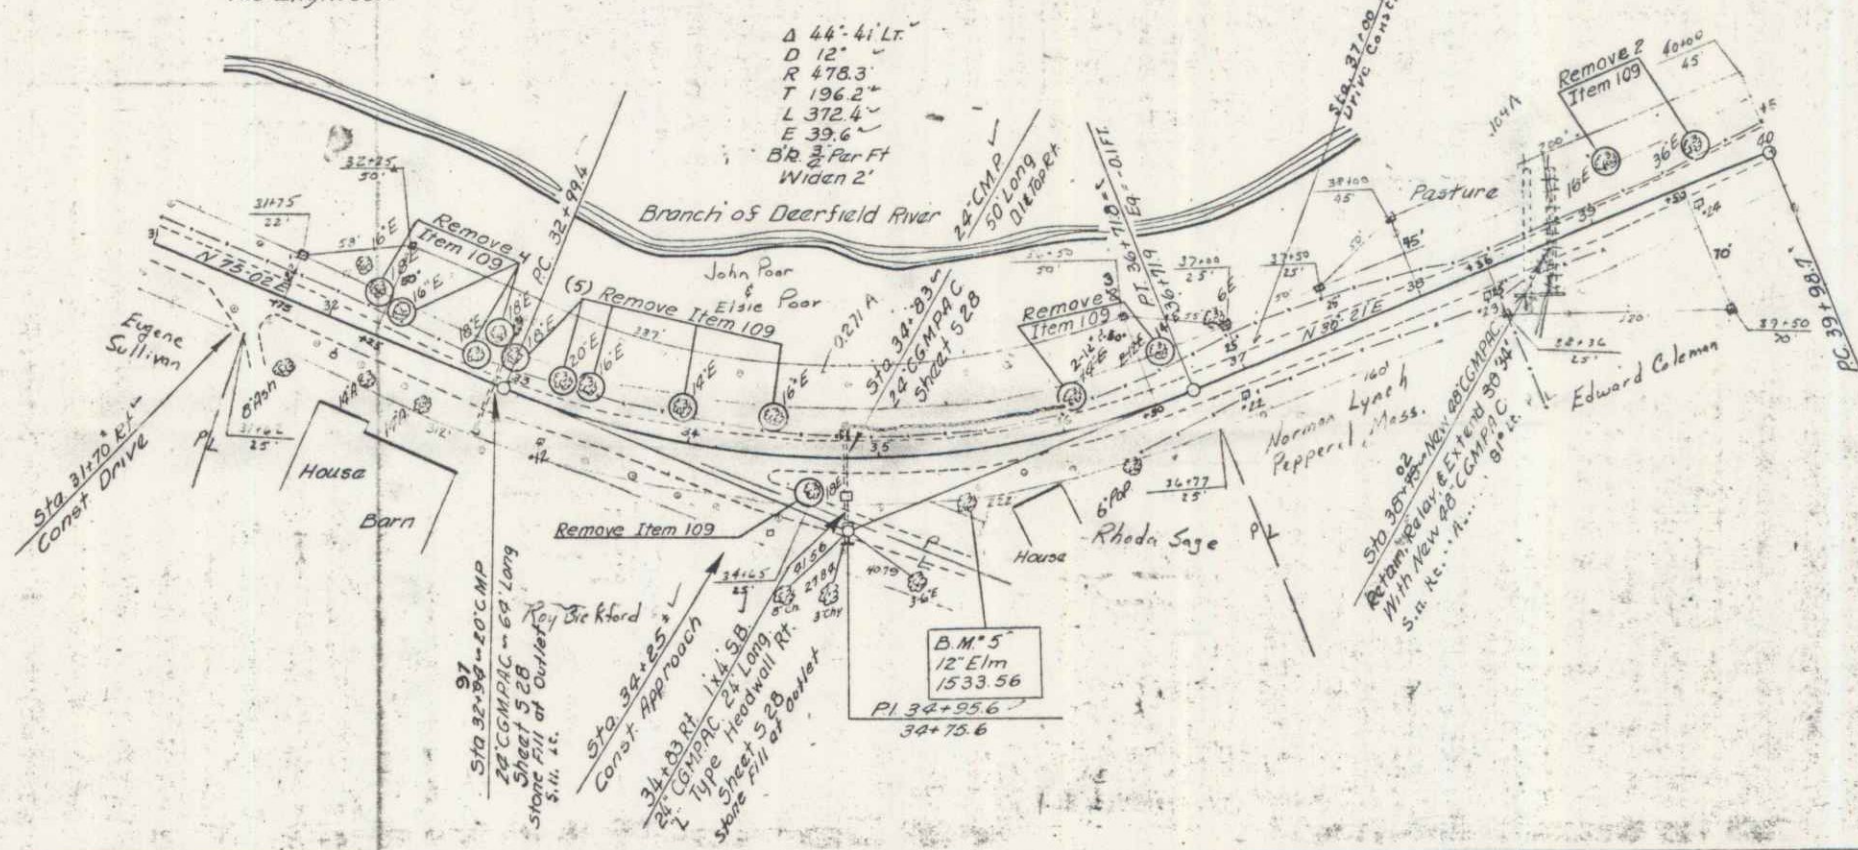


PLAN
 DRAWN BY
 CHECKED BY
 DATE
 NOTE BOOK
 NO. OF PAGES
 NO. OF SHEETS

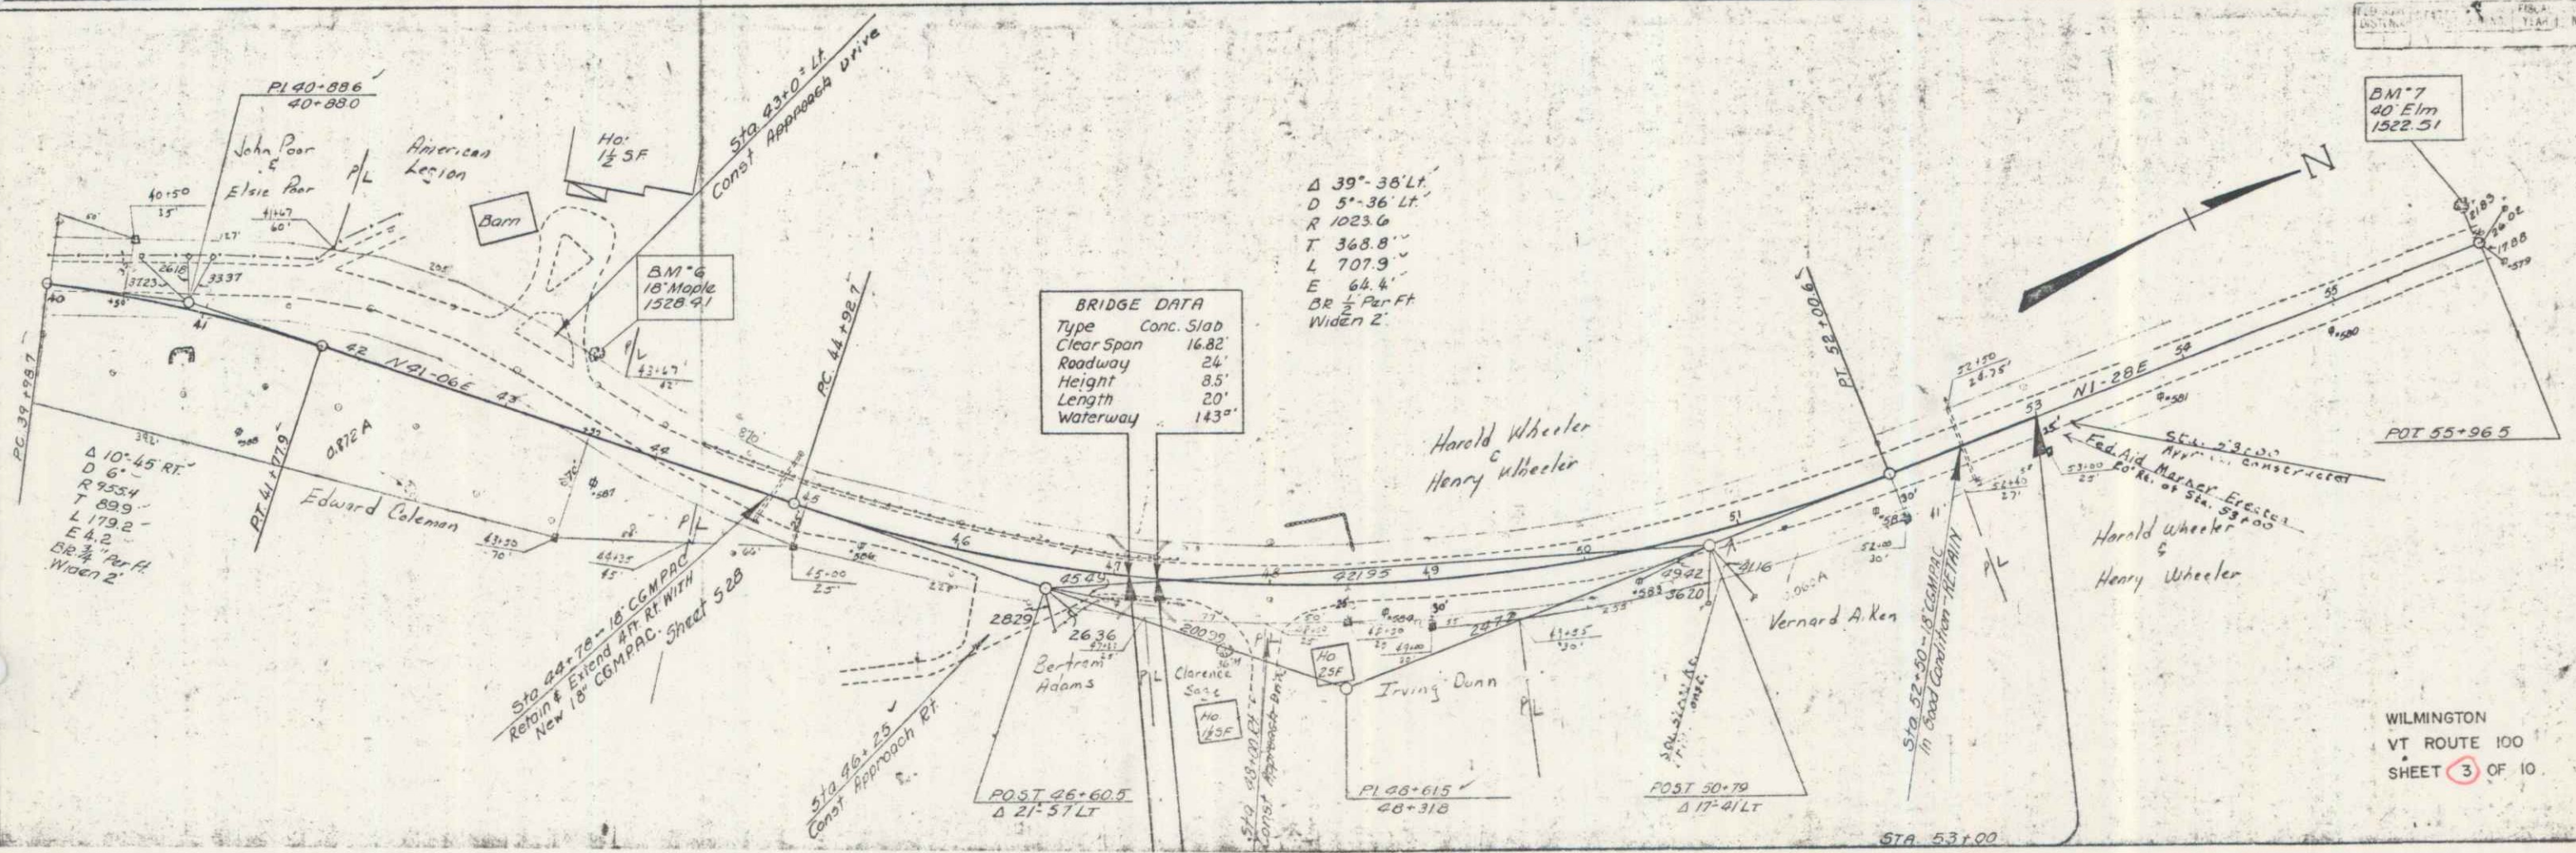


Sta. 53+00.0
PROJ. 5.22(1)1946 ENDS

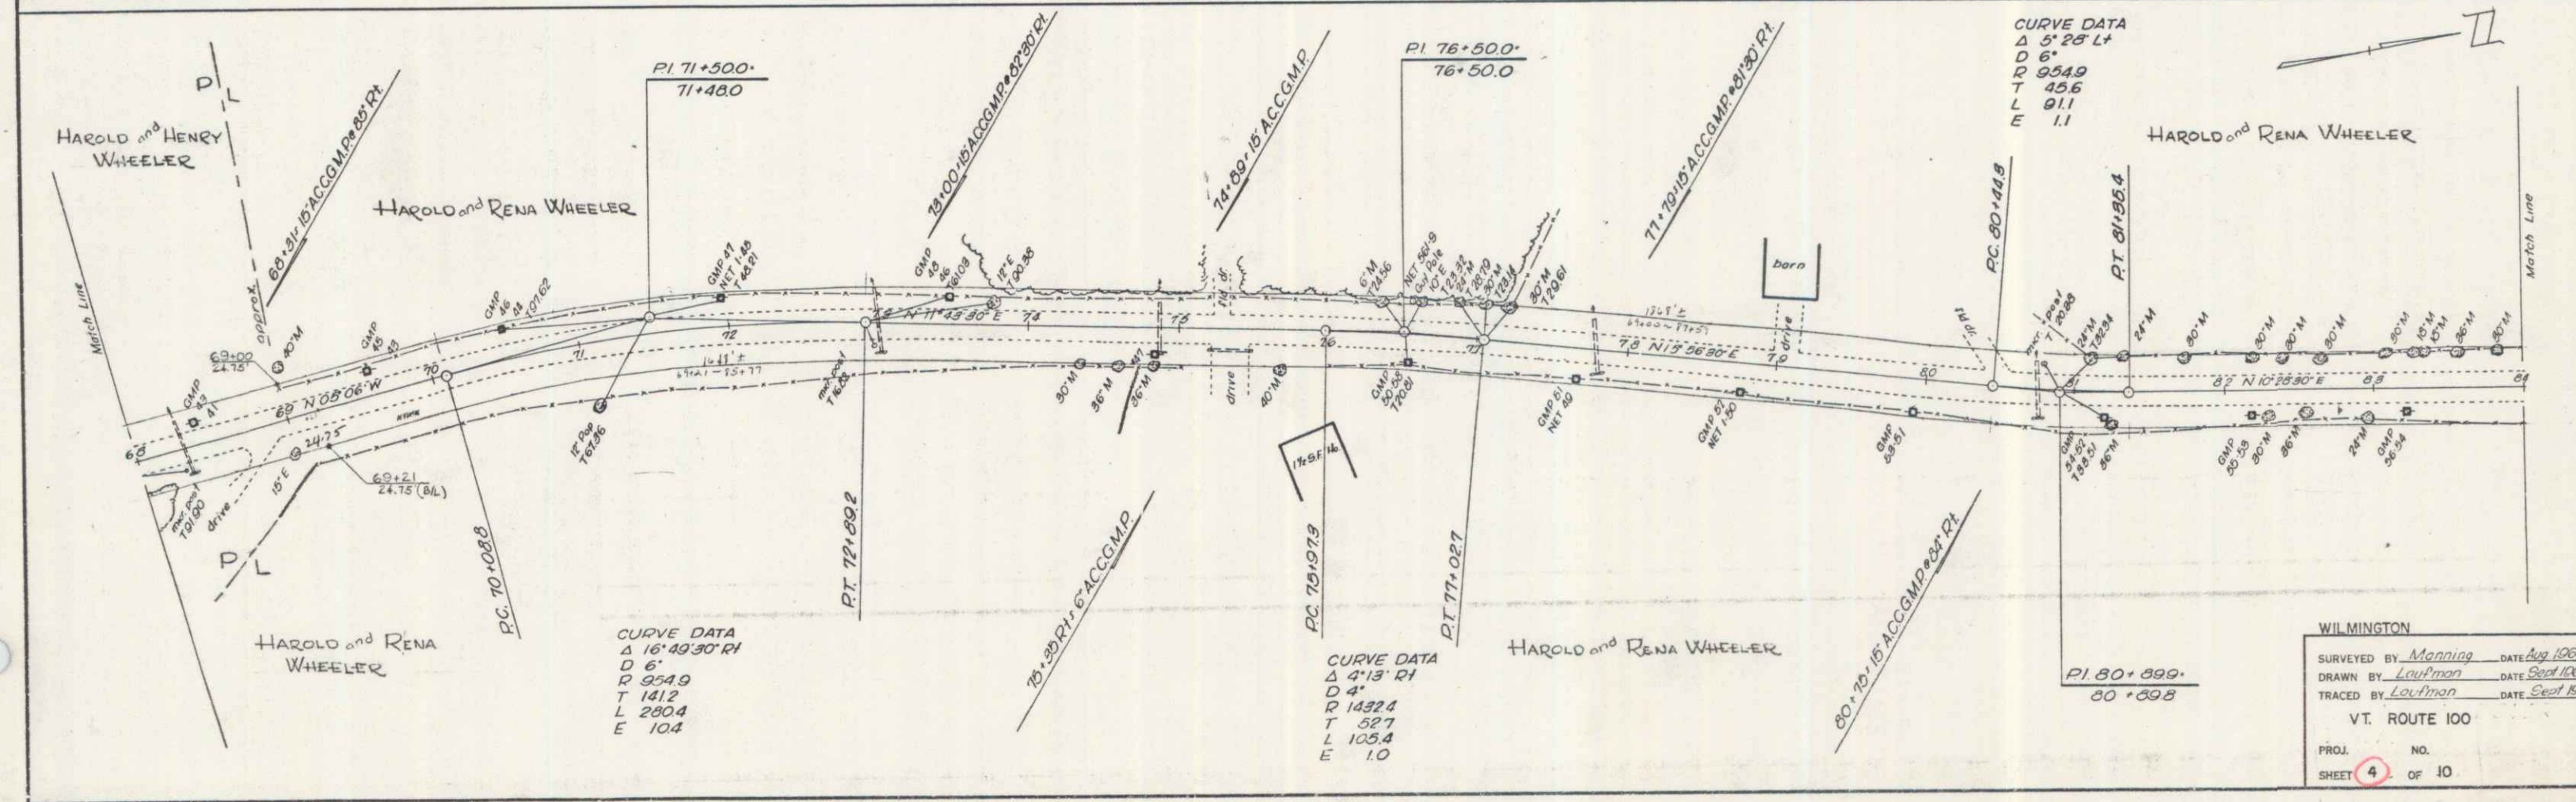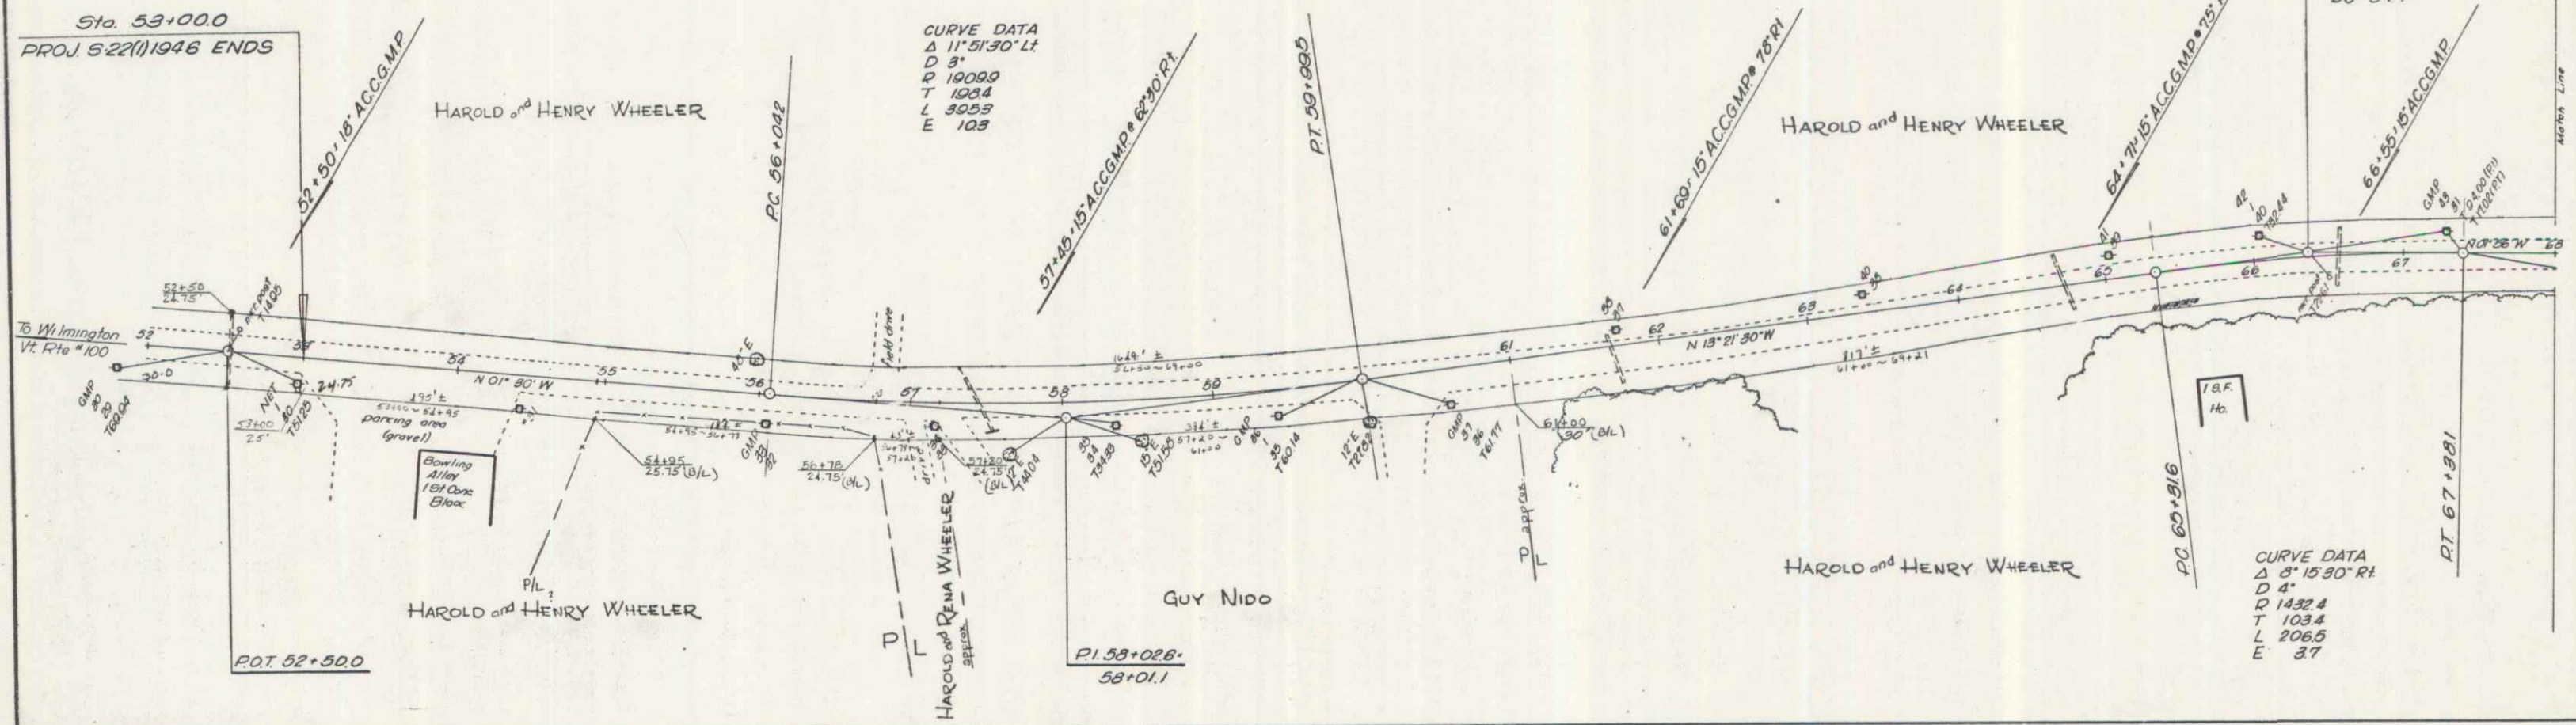



WILMINGTON
SURVEYED BY Manning DATE Aug. 1964
DRAWN BY Loufman DATE Sept. 1964
TRACED BY Loufman DATE Sept. 1964
VT. ROUTE 100
PROJ. NO.
SHEET 4 OF 10

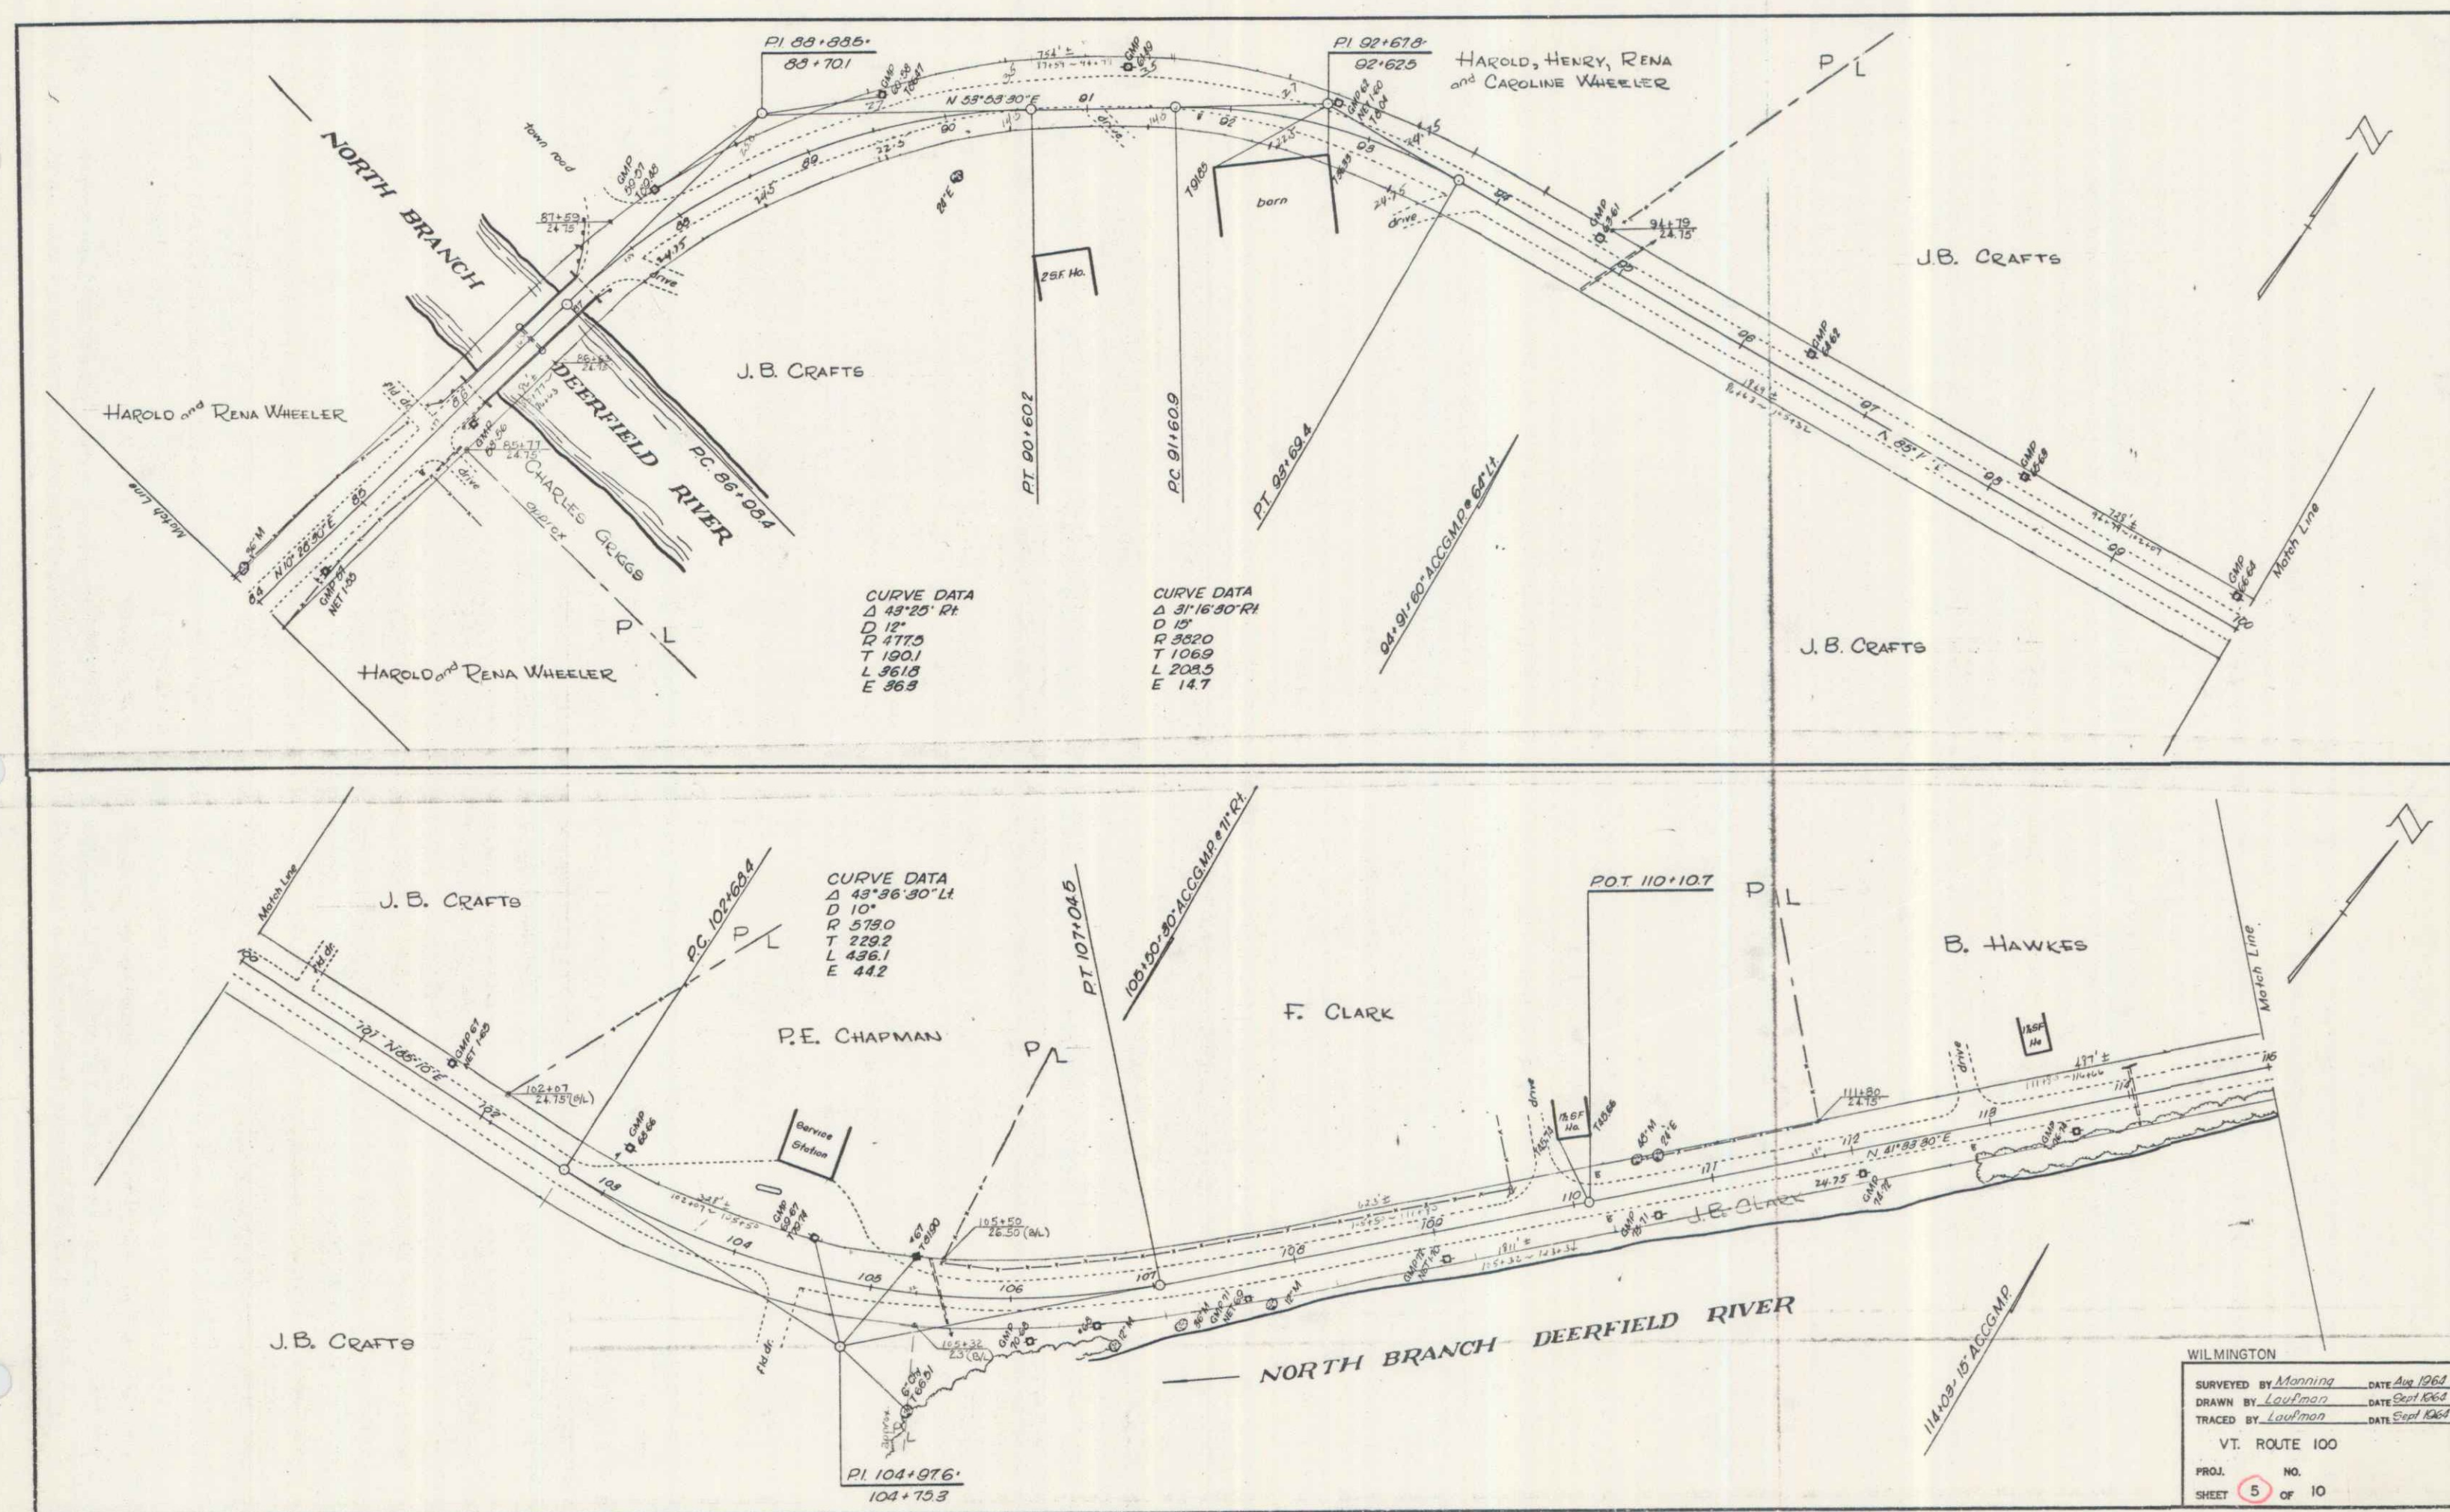

WILMINGTON
 SURVEYED BY Manning DATE Aug 1964
 DRAWN BY Loufman DATE Sept 1964
 TRACED BY Loufman DATE Sept 1964
 VT. ROUTE 100
 PROJ. NO. 5
 SHEET 5 OF 10

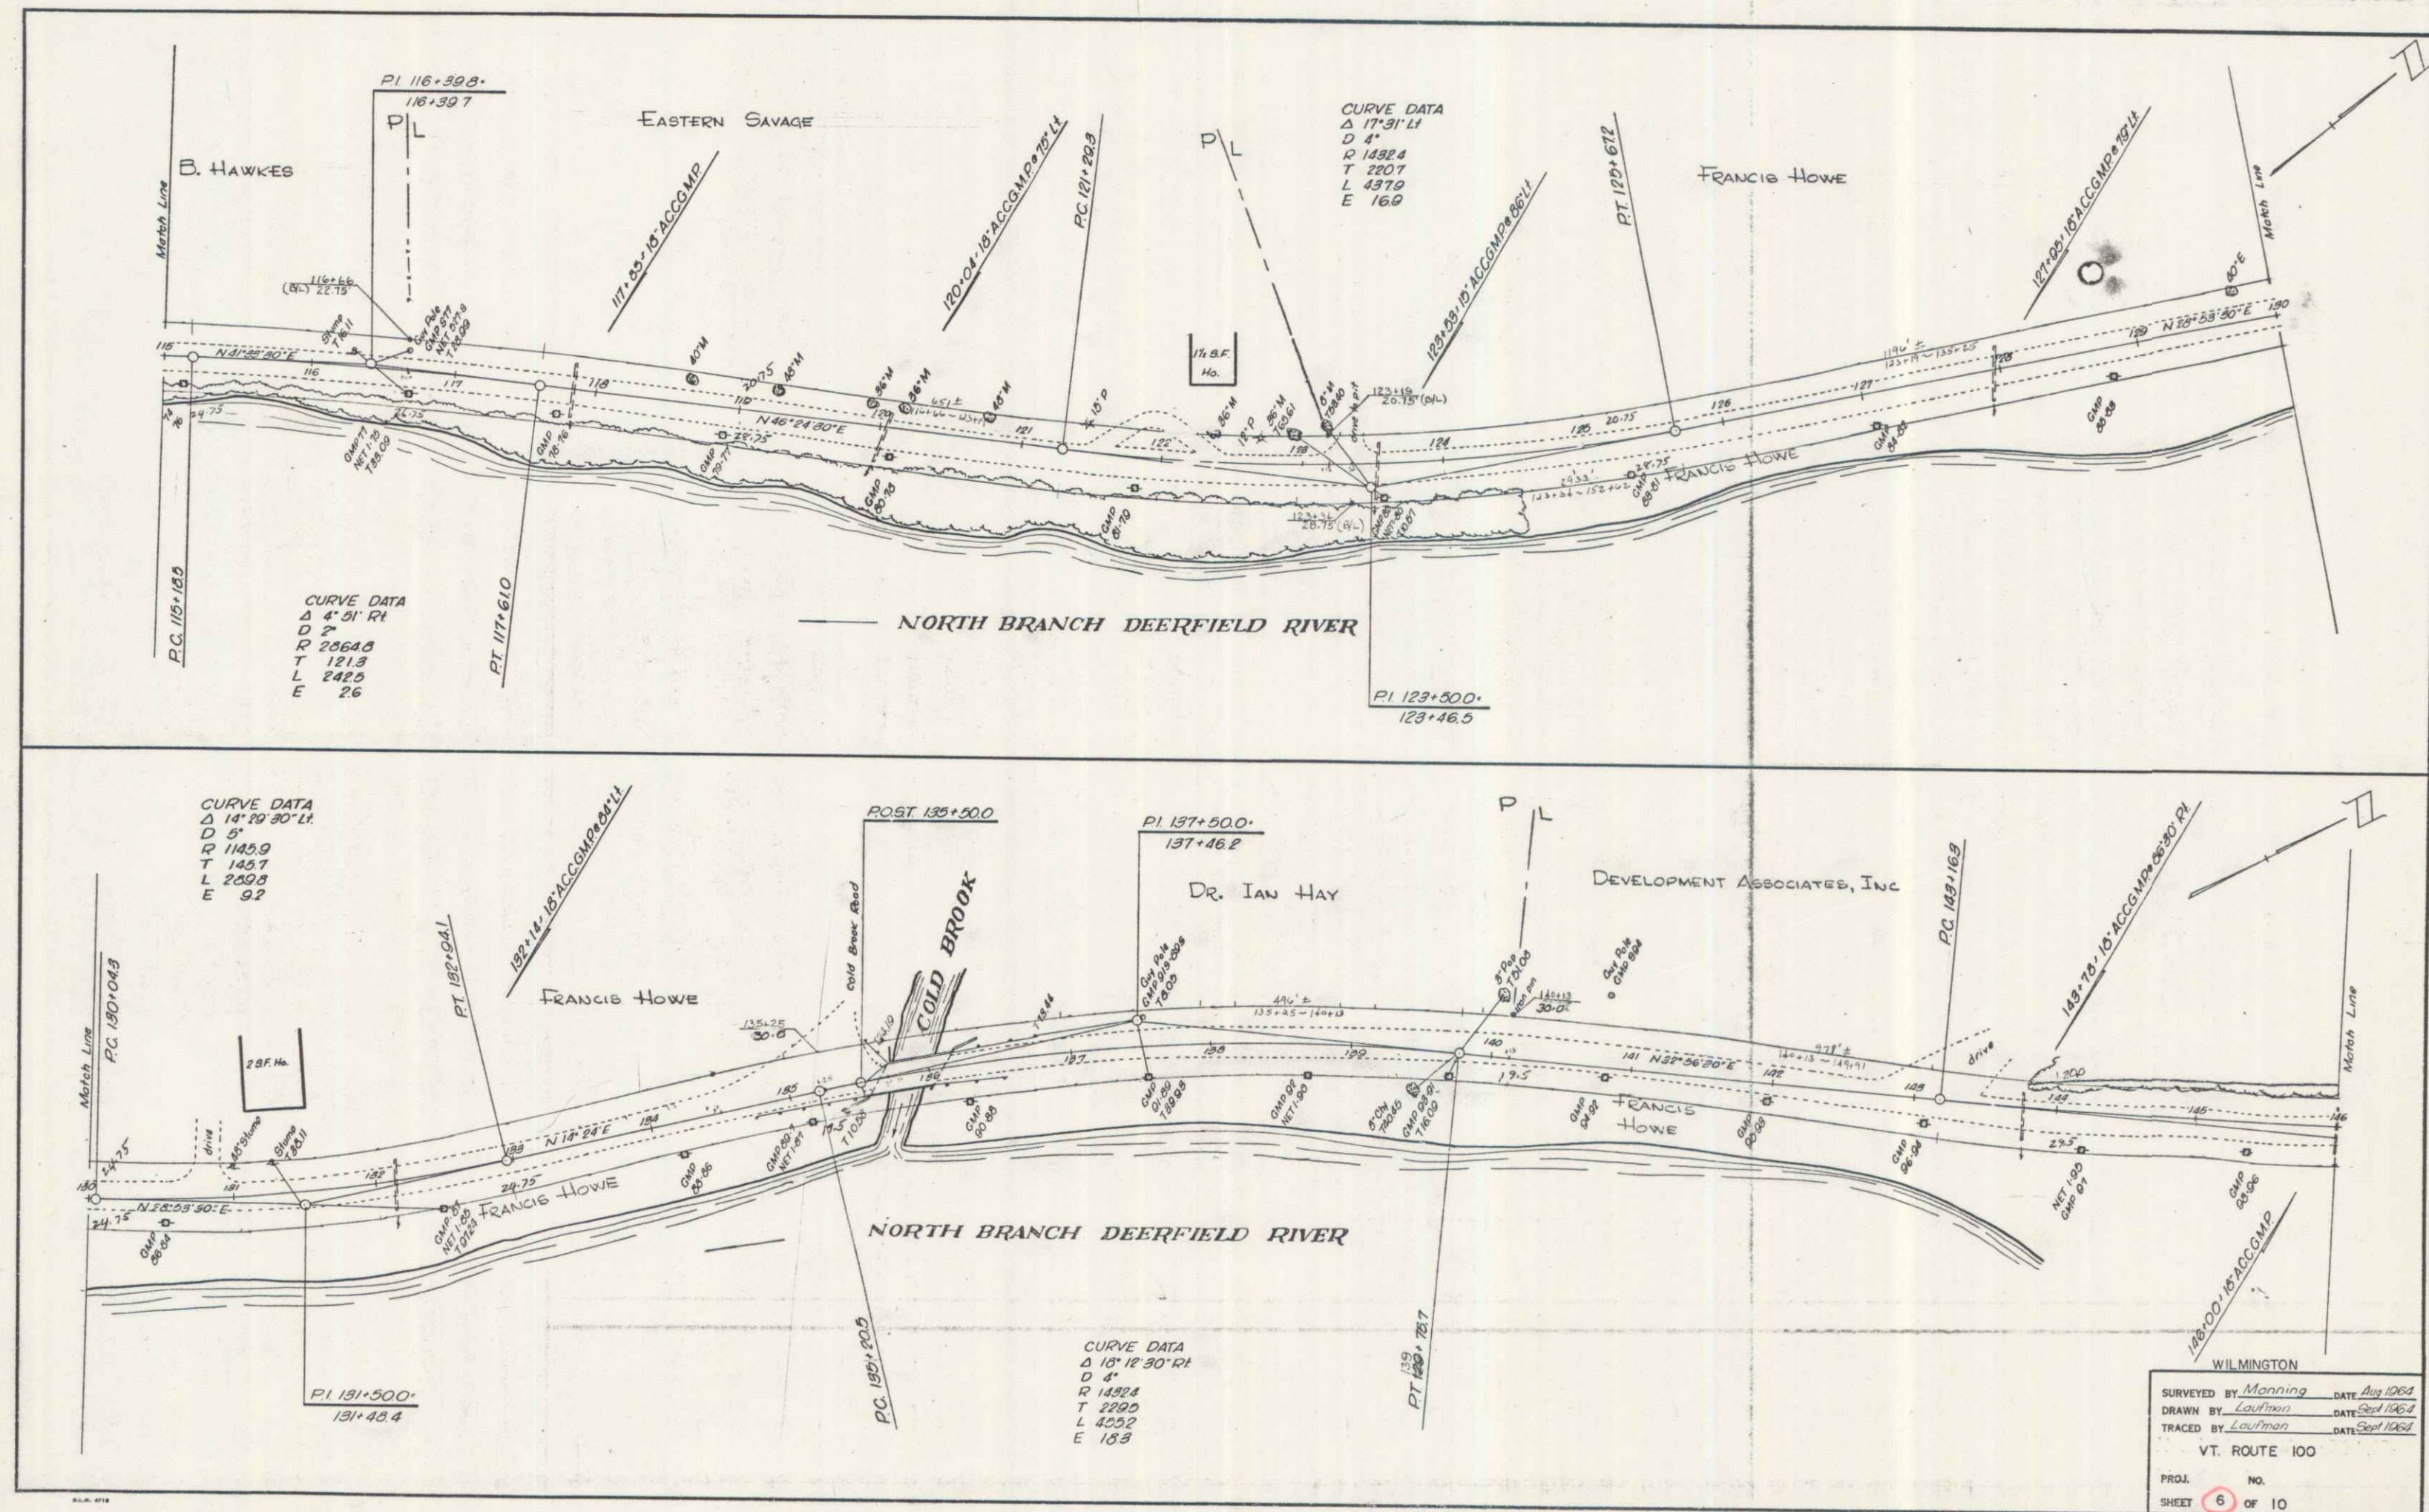

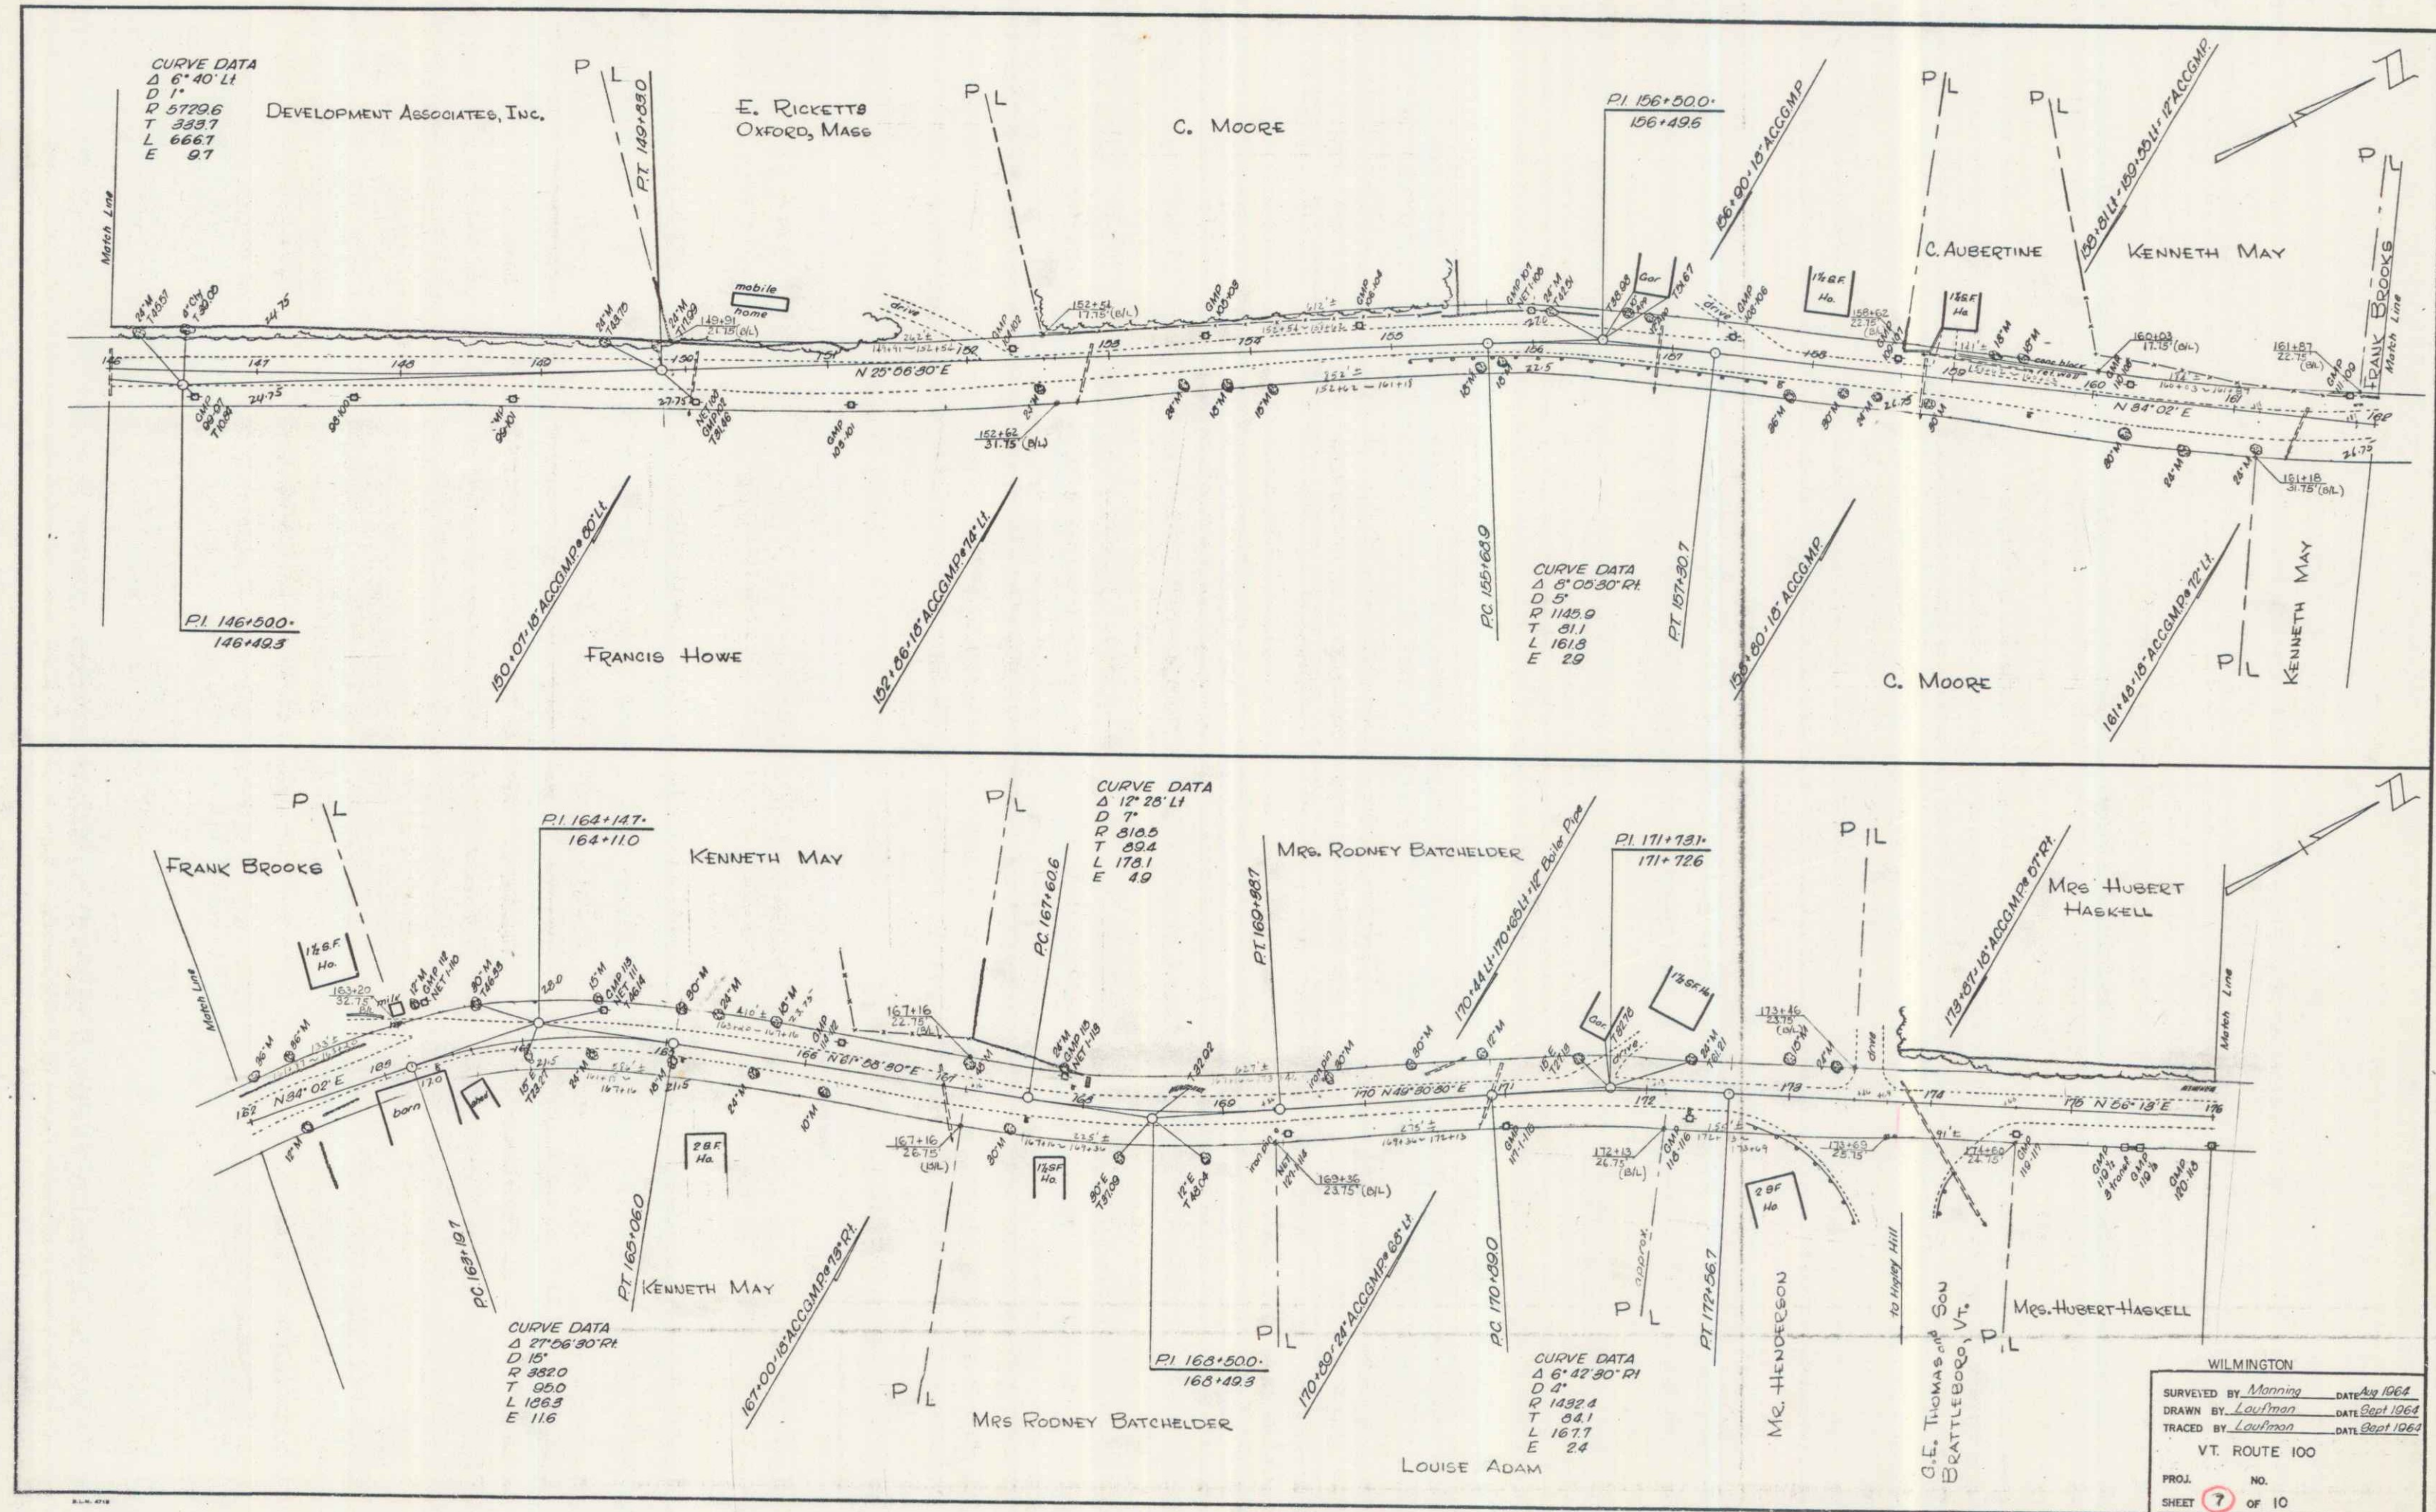

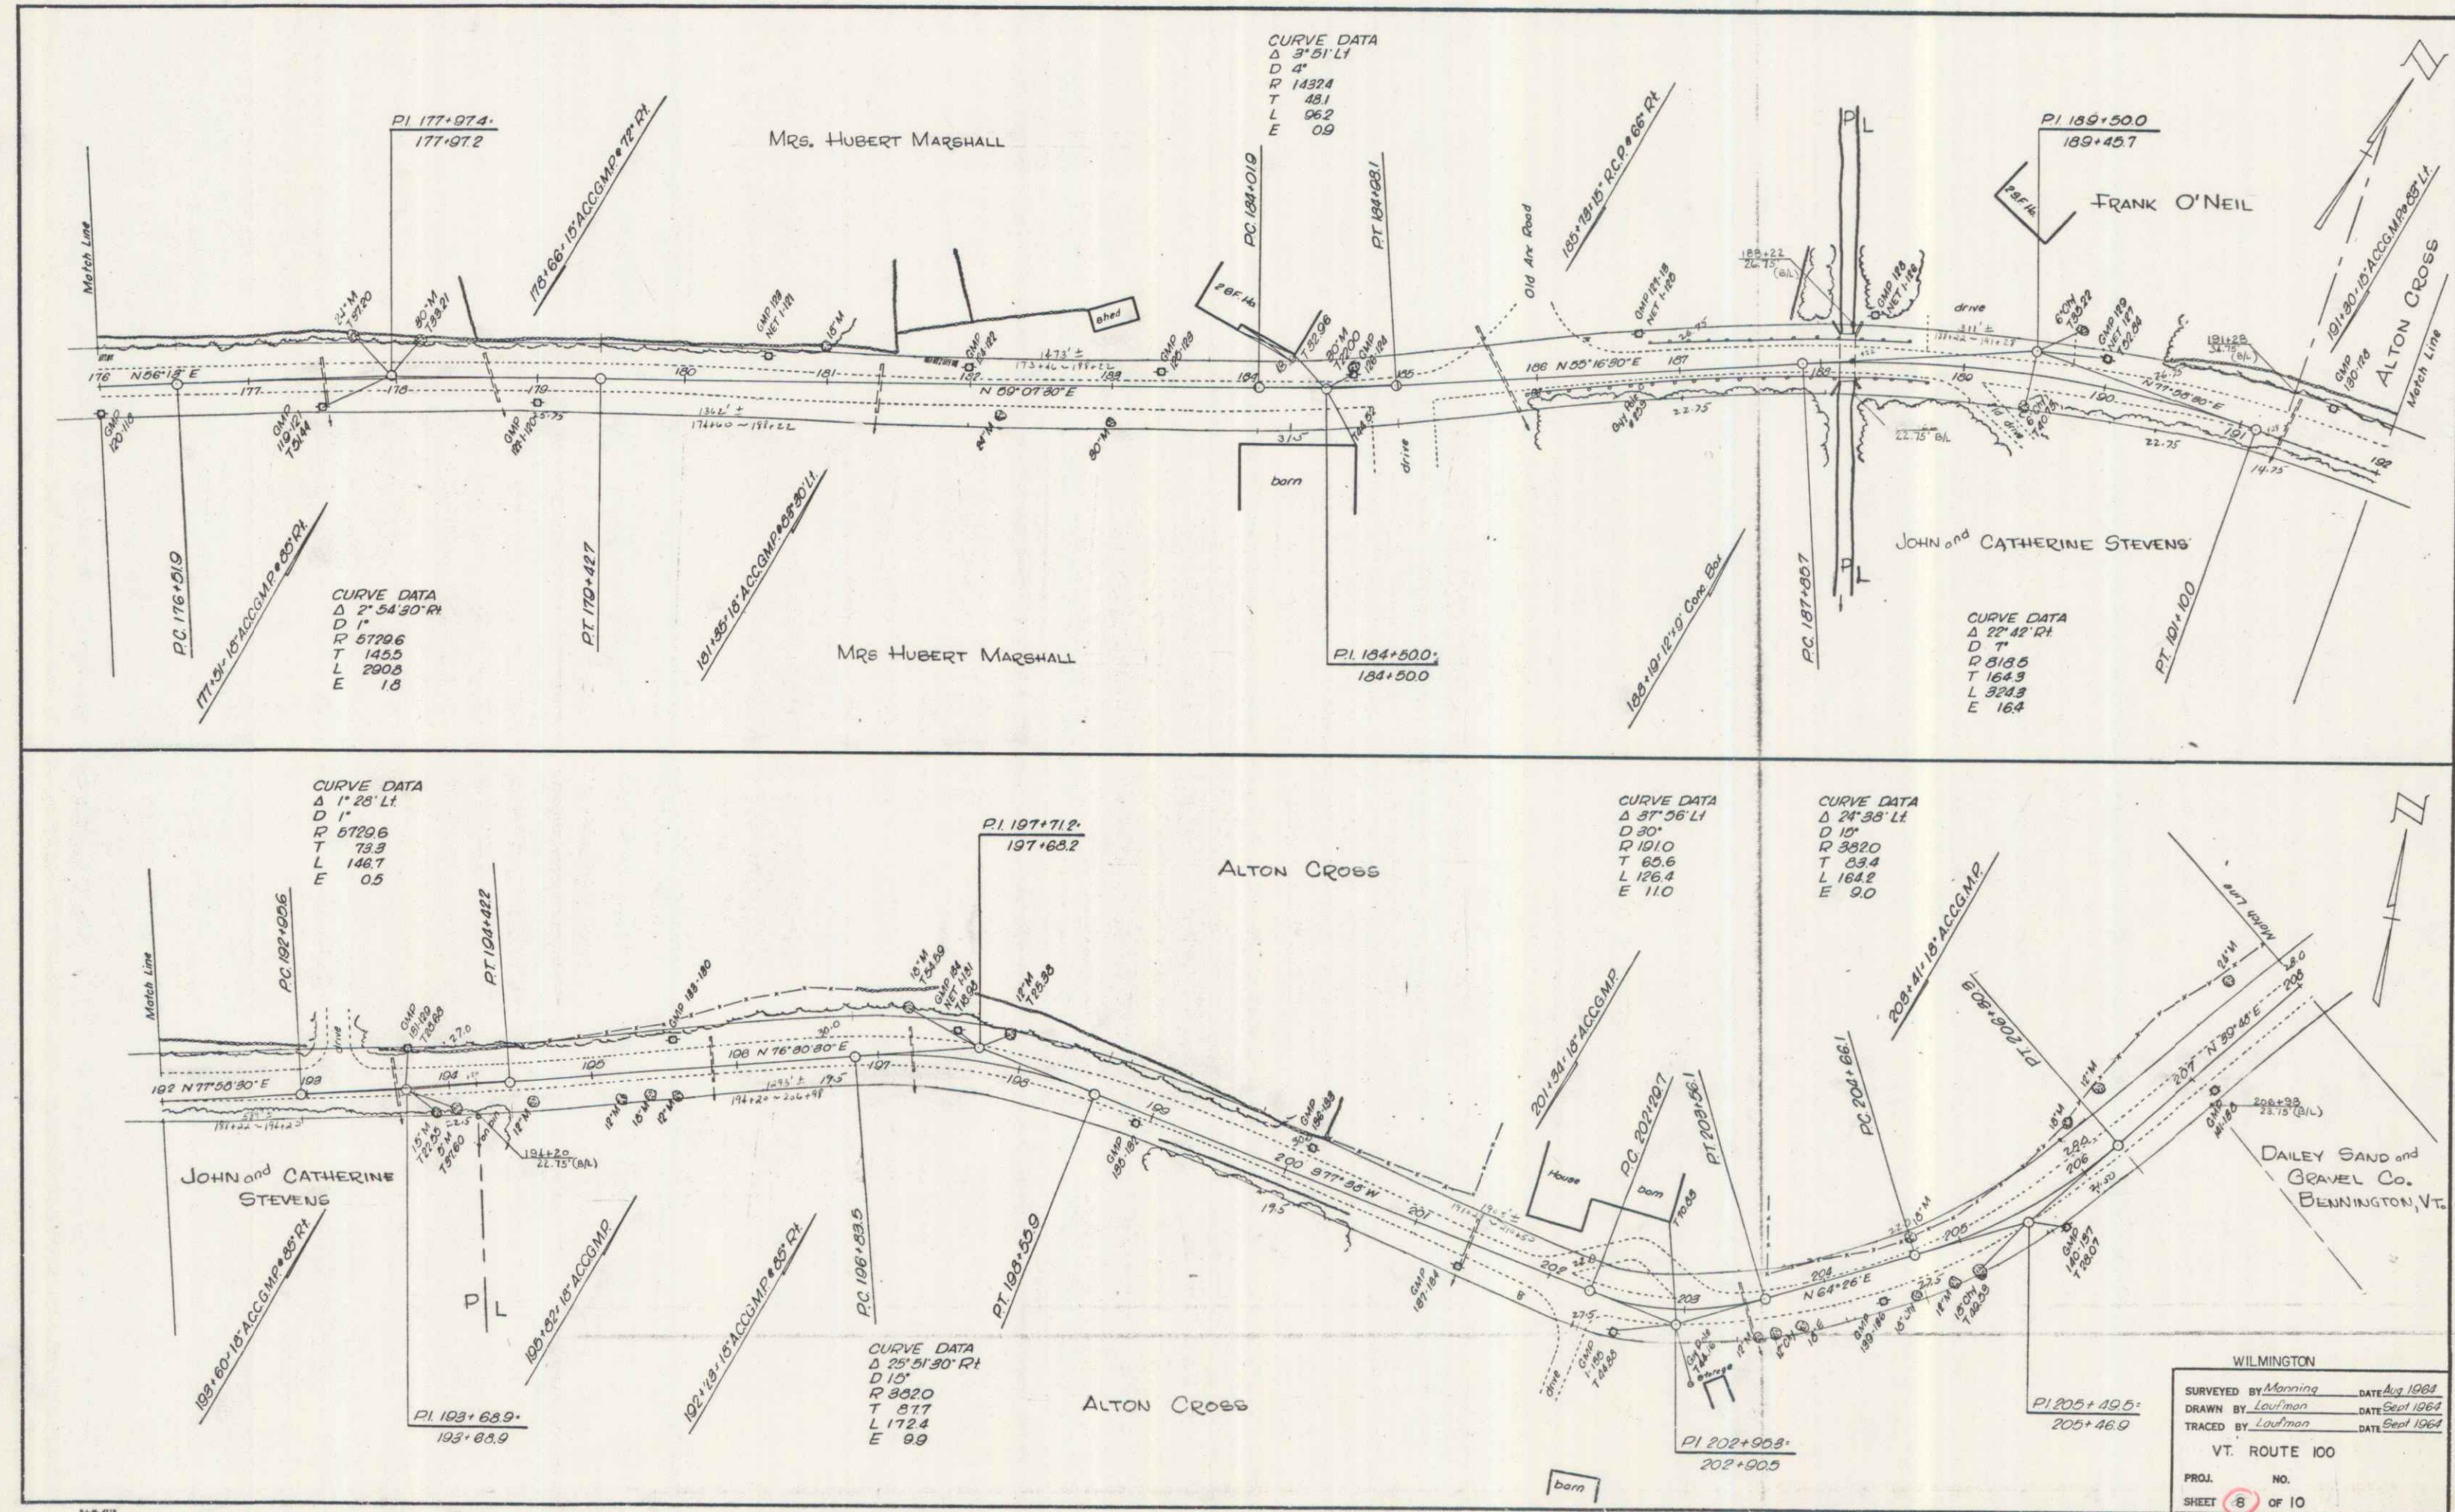

WILMINGTON
 SURVEYED BY Manning DATE Aug 1964
 DRAWN BY Loutman DATE Sept 1964
 TRACED BY Loutman DATE Sept 1964
 VT. ROUTE 100
 PROJ. NO.
 SHEET 8 OF 10

