

INDEX OF SHEETS

SHEET NO.	1	TITLE PAGE
2	TYPICAL CROSS-SECTION OF IMPROVEMENT	SINGLE TRACK COAT OF CUTOBACK ASPHALT WITH CRUSHED PEA STONE ITEM 304
3	QUANTITY SHEET (ITEMS)	
4	EARTHWORK SHEET (ROADWAY)	
5	PRELIMINARY INFORMATION SHEET	
6-7	PLAN AND PROFILE SHEET SHEETS	
8	DETAILS OF SUPERSTRUCTURE	
9	DETAILS OF ABUTMENT NO. 1	
10	DETAILS OF ABUTMENT NO. 2	
11	DETAILS OF REINFORCING STEEL	
12	STANDARD BRIDGE SHEET SB-55-1 (BRIDGE RAILING DETAILS)	
13	STANDARD BRIDGE SHEET SB-50-20 (DETAILS C, D, E, H, J, K AND L)	
14	STANDARD STRUCTURE SHEET SB-11 (BARRICADES, SIGNS AND LIGHTS)	
15	STANDARD STRUCTURE SHEET S-48-46 (THREE CABLE GUARD RAIL)	
16	CONSTRUCTION DETAILS (C/D) DRAINAGE AND MARKERS	
17	CONSTRUCTION DETAILS (C/D-1) DITCHES	
18-22	CROSS SECTIONS	
23-25	CHANNEL SECTIONS	

STATE OF VERMONT
DEPARTMENT OF HIGHWAYS

PROPOSED IMPROVEMENT


FEDERAL AID
SECONDARY PROJECT

TOWN OF FAIRFIELD
COUNTY OF FRANKLIN
STATE AID ROUTE 2
BRIDGE OVER FAIRFIELD RIVER

BEGINNING AT A POINT APPROXIMATELY 0.20 MI. EAST OF THE INTERSECTION OF STATE AID ROUTES 2 AND 3 AND EXTENDING 350.0 FEET EASTERLY

LENGTH OF ROADWAY 261.0 FEET+0.049 MILE
LENGTH OF BRIDGE 89.0 FEET+0.017 MILE
LENGTH OF PROJECT 350.0 FEET+0.066 MILE

PROJECT MAP NO. 5-53(7)
FAIRFIELD-5-53(7)
CONTRACTOR: OSCAR L. OLSON
CONTRACT STARTED: JULY 20, 1954
CONTRACT COMPLETED: MAY 31, 1955
CONTRACT ACCEPTED: MAY 31, 1955

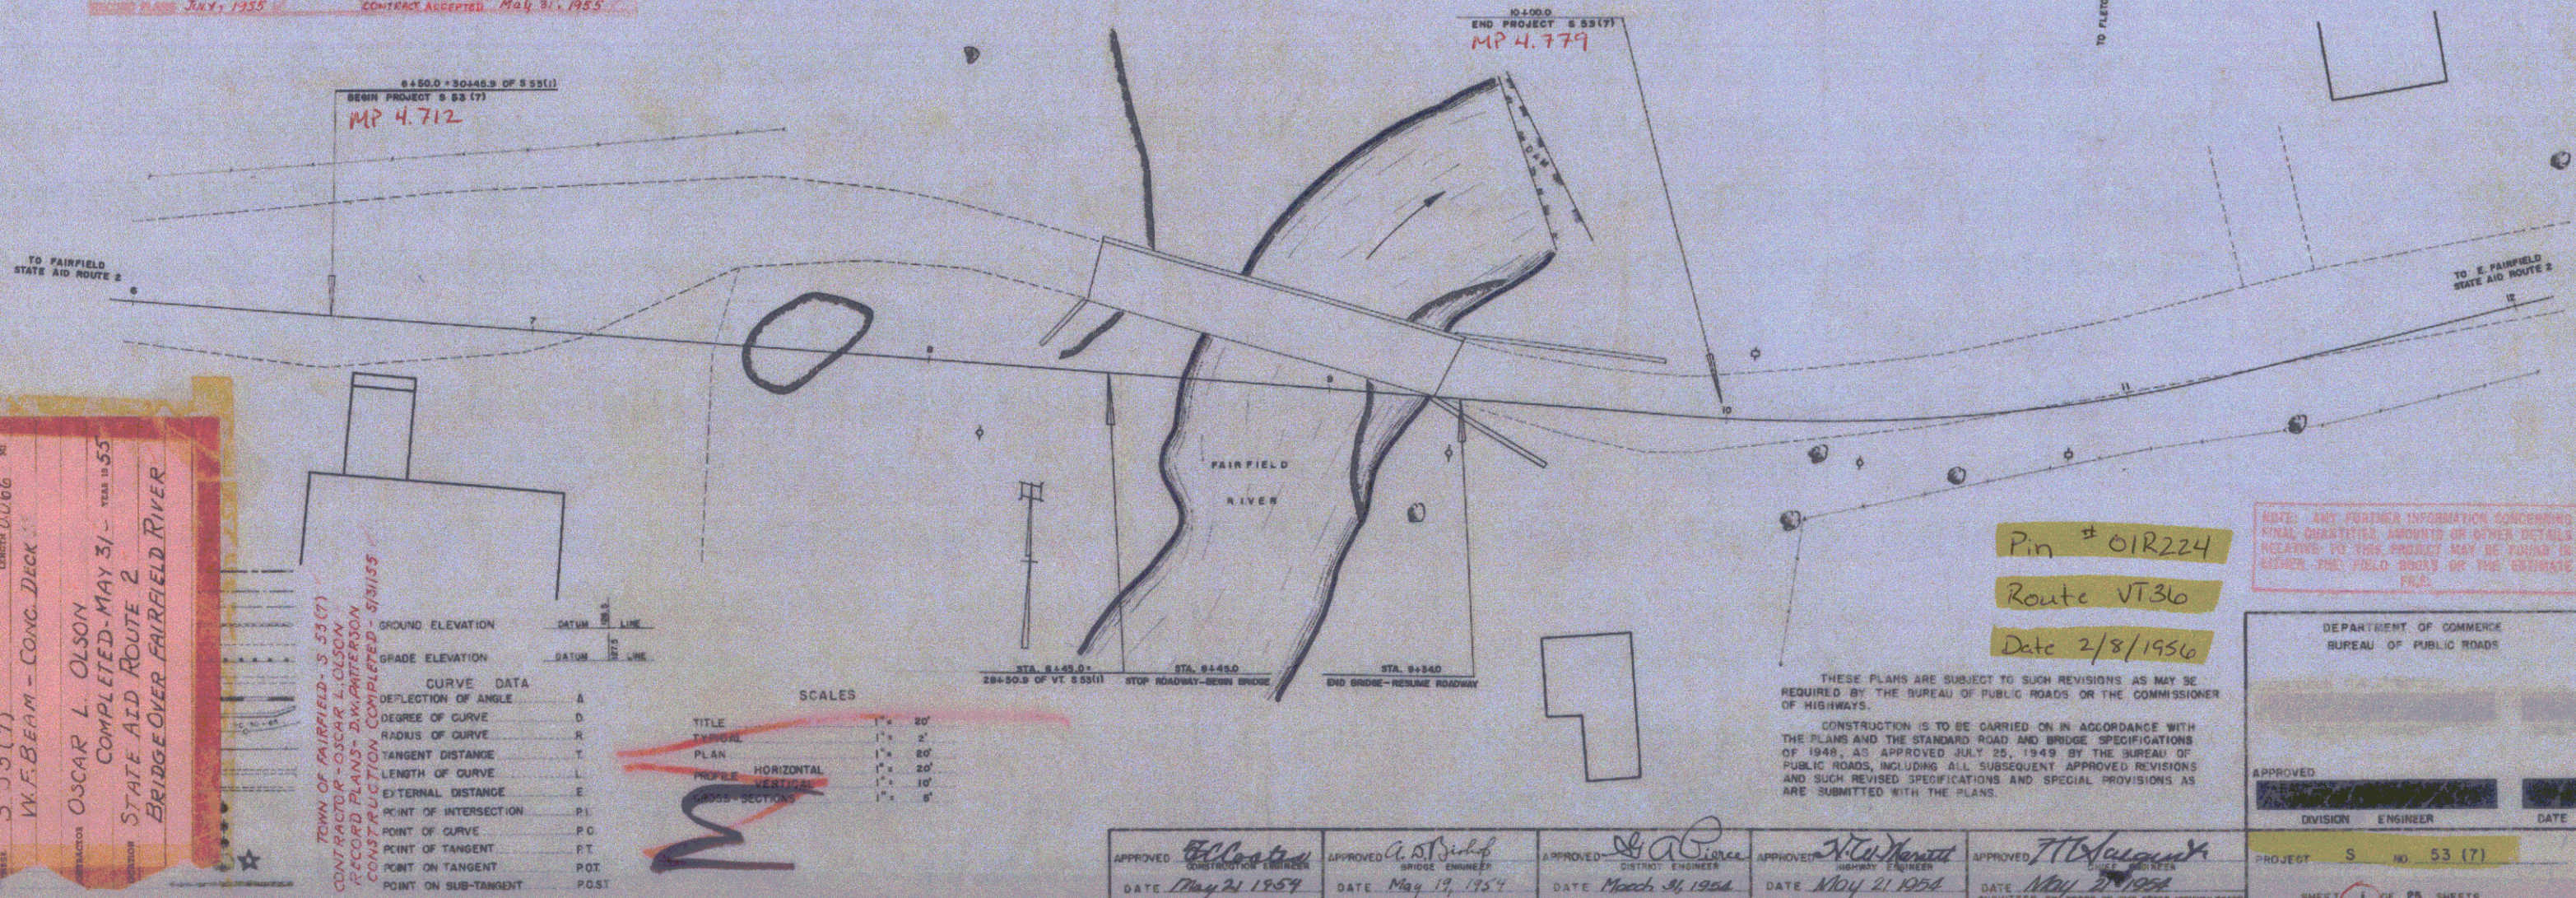

FAIRFIELD
S-53(7)
V.F. BEAM - CONC. DIAPHRAGM
OSCAR L. OLSON
COMPLETED MAY 31, 1955
STATE AID ROUTE 2
BRIDGE OVER FAIRFIELD RIVER

TOWN OF FAIRFIELD-5-53(7)
CONTRACTOR: OSCAR L. OLSON
RECORD PLANS - DIMENSIONED
CONSTRUCTION COMPLETED 5/31/55

SCALES

TITLE	1" = 20'
PLAN	1" = 20'
PROFILE	1" = 20'
CROSS-SECTION	1" = 5'

APPROVED DATE May 21, 1954	APPROVED DATE May 19, 1954	APPROVED DATE March 26, 1954	APPROVED DATE May 21, 1954	APPROVED DATE May 21, 1954
SUBMITTED BY ORDER OF THE STATE HIGHWAY BOARD				

DEPARTMENT OF COMMERCE
BUREAU OF PUBLIC ROADS

PROJECT S NO. 53 (7)
SHEET 1 OF 25 SHEETS

