


Spanning 945
Traced Bulky 1045

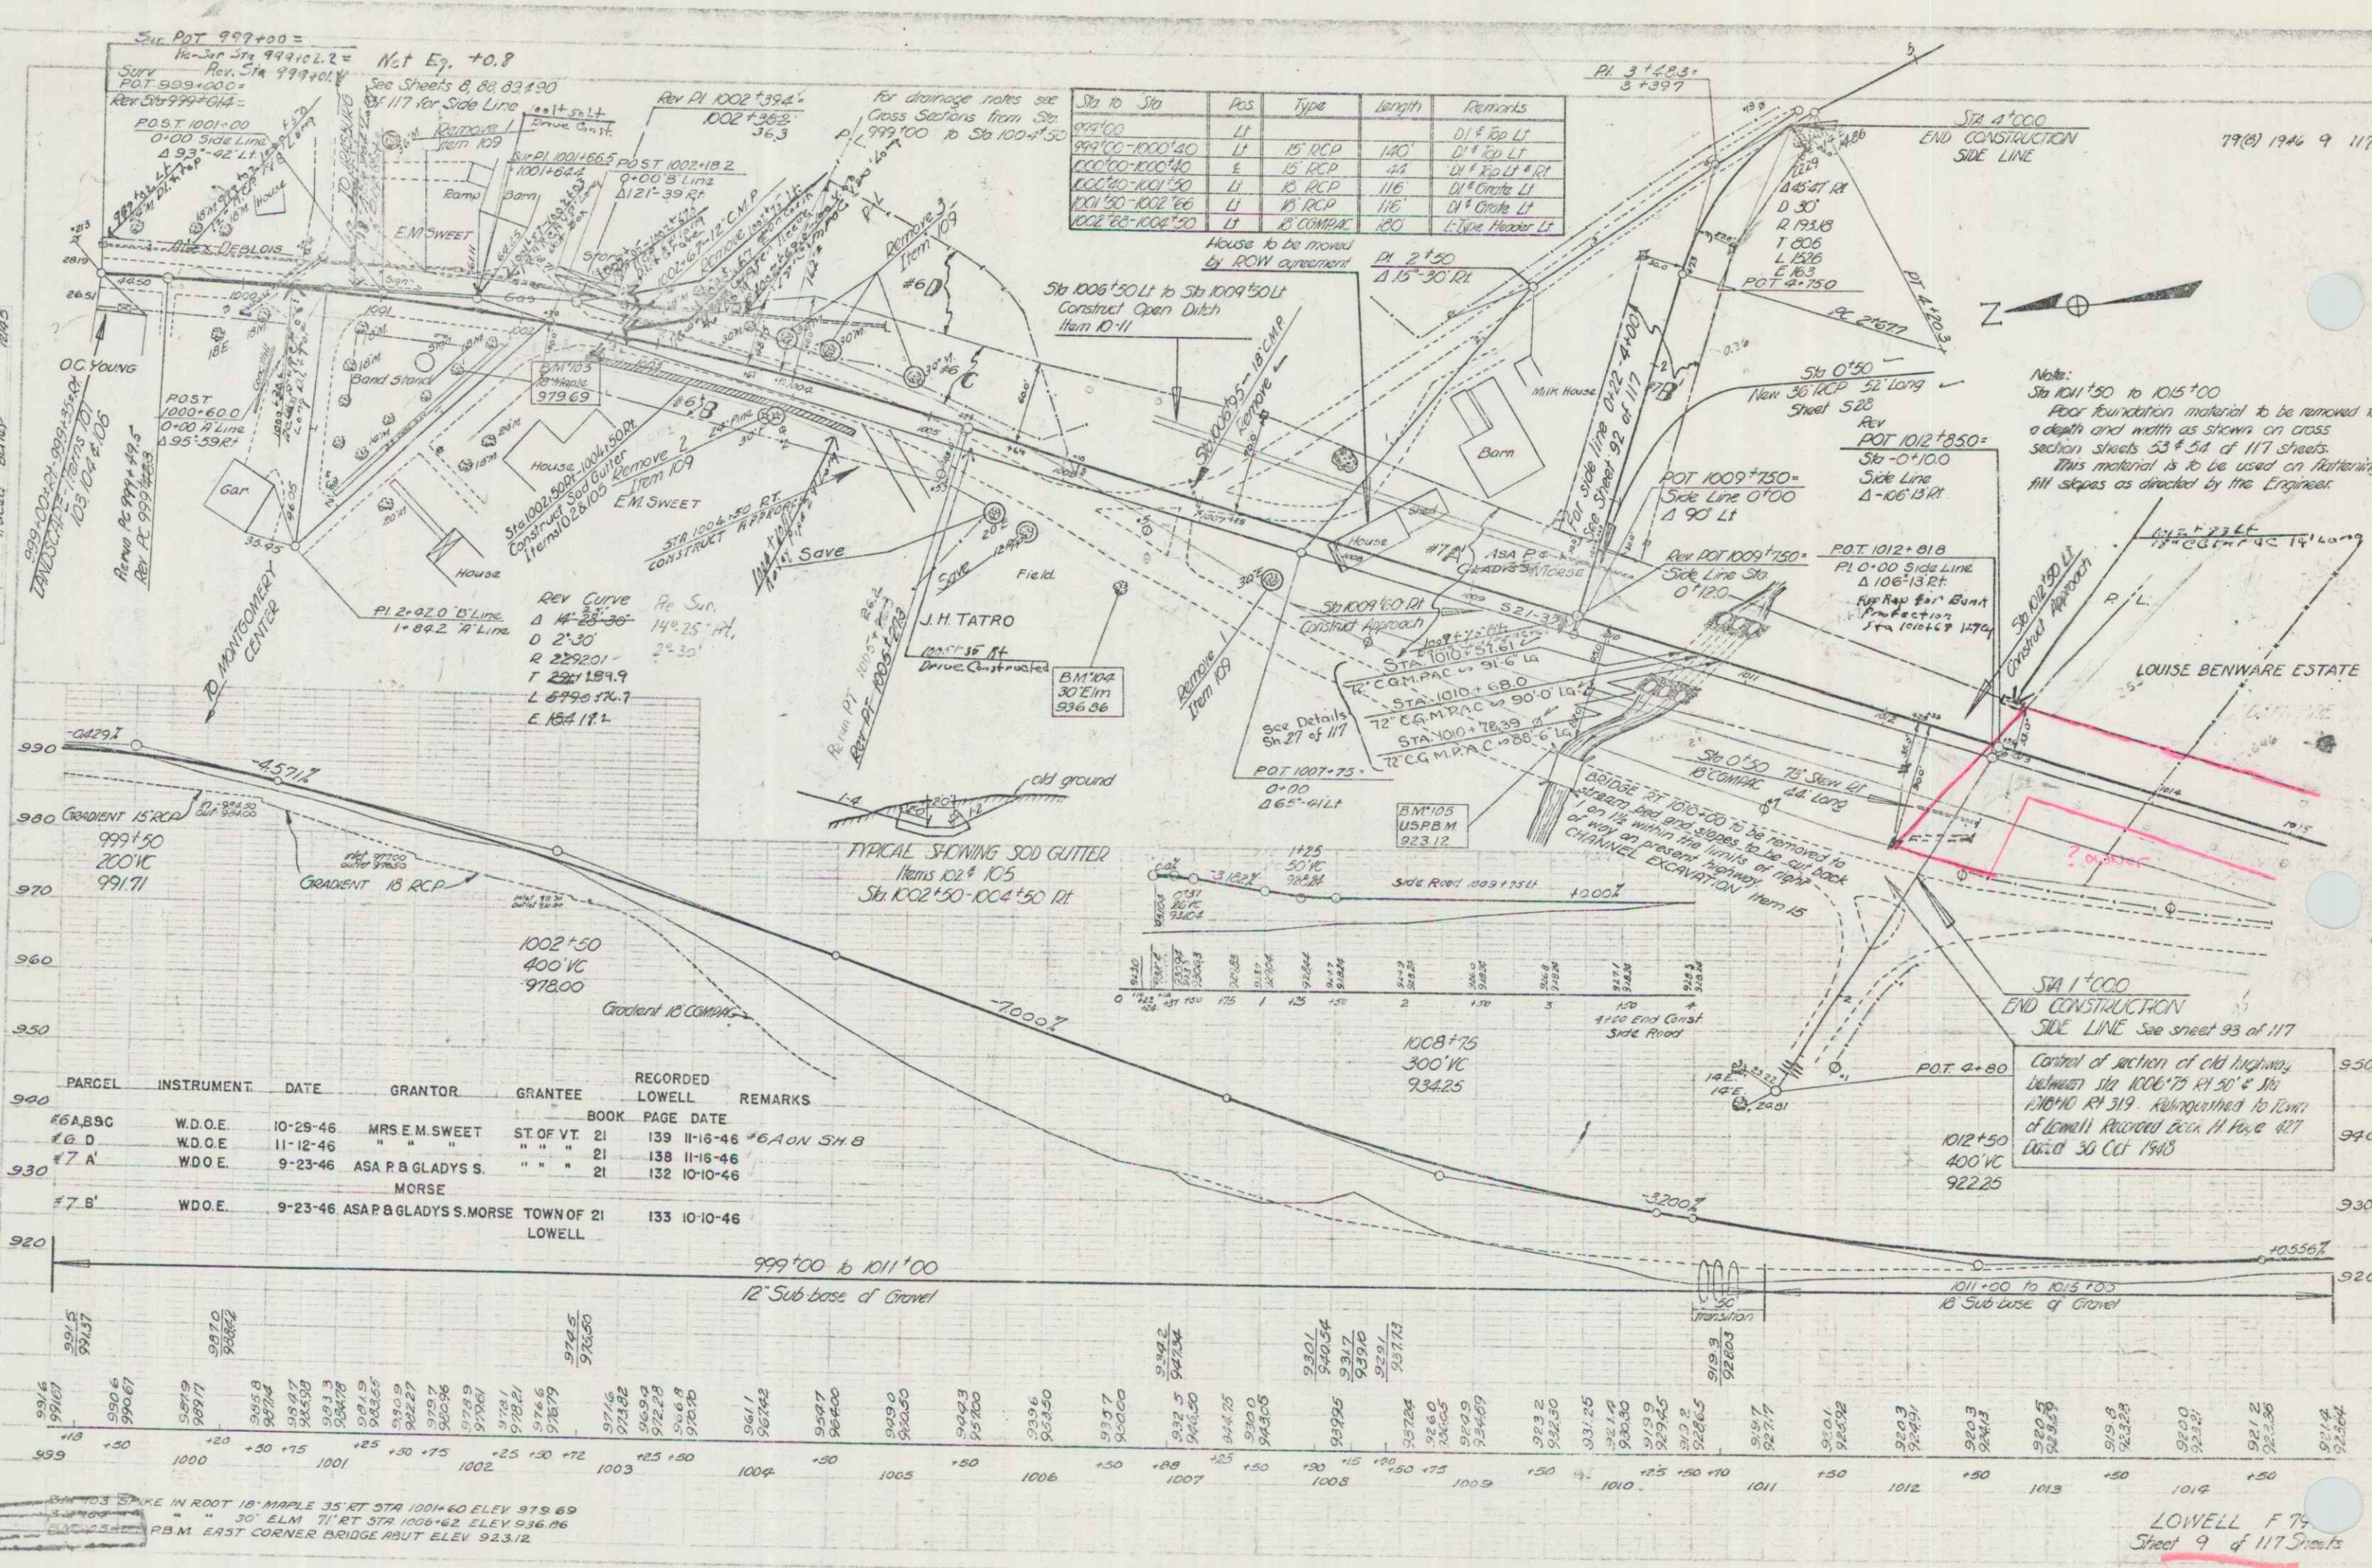

79(8) 1946 9 117

Notes:
Sta 1011+50 to 1015+00
Floor foundation material to be removed to a depth and width as shown on cross section sheets 53 & 54 of 117 sheets.
This material is to be used on flattening fill slopes as directed by the Engineer.

Control of section of old highway between Sta 1006+75 RT 30' & Sta 1010+40 RT 319. Realigning to Town of Lowell. Revised Dec. 11 Page 117. Dated 30 Oct 1946

LOWELL F. 79
Sheet 9 of 117 Sheets