


Direct Constructed
Sta 1076+40 L.P.
Sta 1077+70 L.P.

BRIDGE DATA NEW CONSTRUCTION


TYPE	CONC T-BM	CONC T-BM
OVERALL SPAN	43'-0"	43'-0"
CLEAR SPAN	40'-0"	40'-0"
CLEAR HEIGHT	6'-0"	6'-0"
WATERWAY	24'-0"	24'-0"
BODY WIDTH	20'-0"	50'-0"
STREAM DATA	Velocity - Slow	Drift - None
		Ice Condition - Negligible

Spanning 1145
Bulky 1245

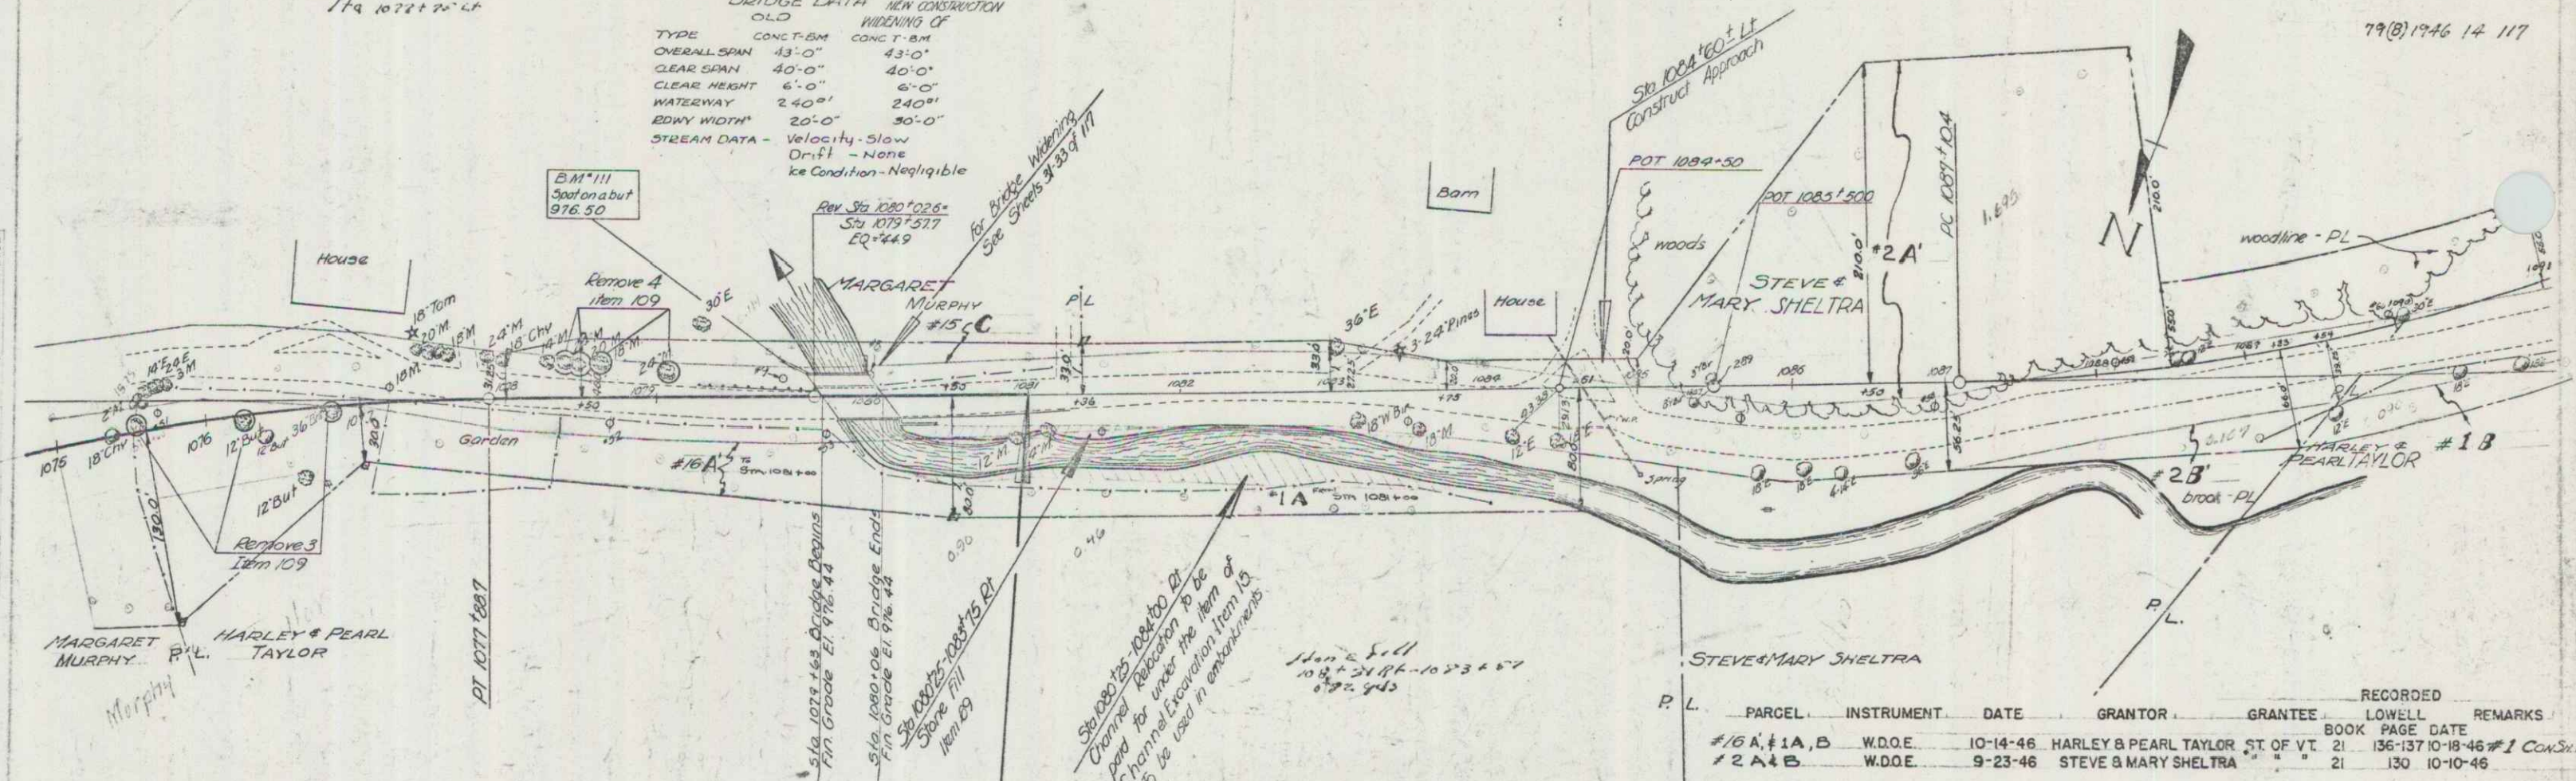

PARCEL	INSTRUMENT	DATE	GRANTOR	GRANTEE	RECORDED	REMARKS
#16 A, #1A, B	W.D.O.E.	10-14-46	HARLEY & PEARL TAYLOR	ST. OF VT.	21	136-137 10-18-46 #1 Con. S. 12
#2 A, B	W.D.O.E.	9-23-46	STEVE & MARY SHELTRA	"	21	130 10-10-46

Note: Layout sheet 14 and cross section sheets 97-103 of 117 show a source of material for use as borrow and/or sub-base of gravel provided that the material meets the requirements for borrow, item 11 and for sub-base of gravel, item 14C. If material is taken from this source, contractor will be required to stay within neat lines of excavation as shown on cross sections and layouts.

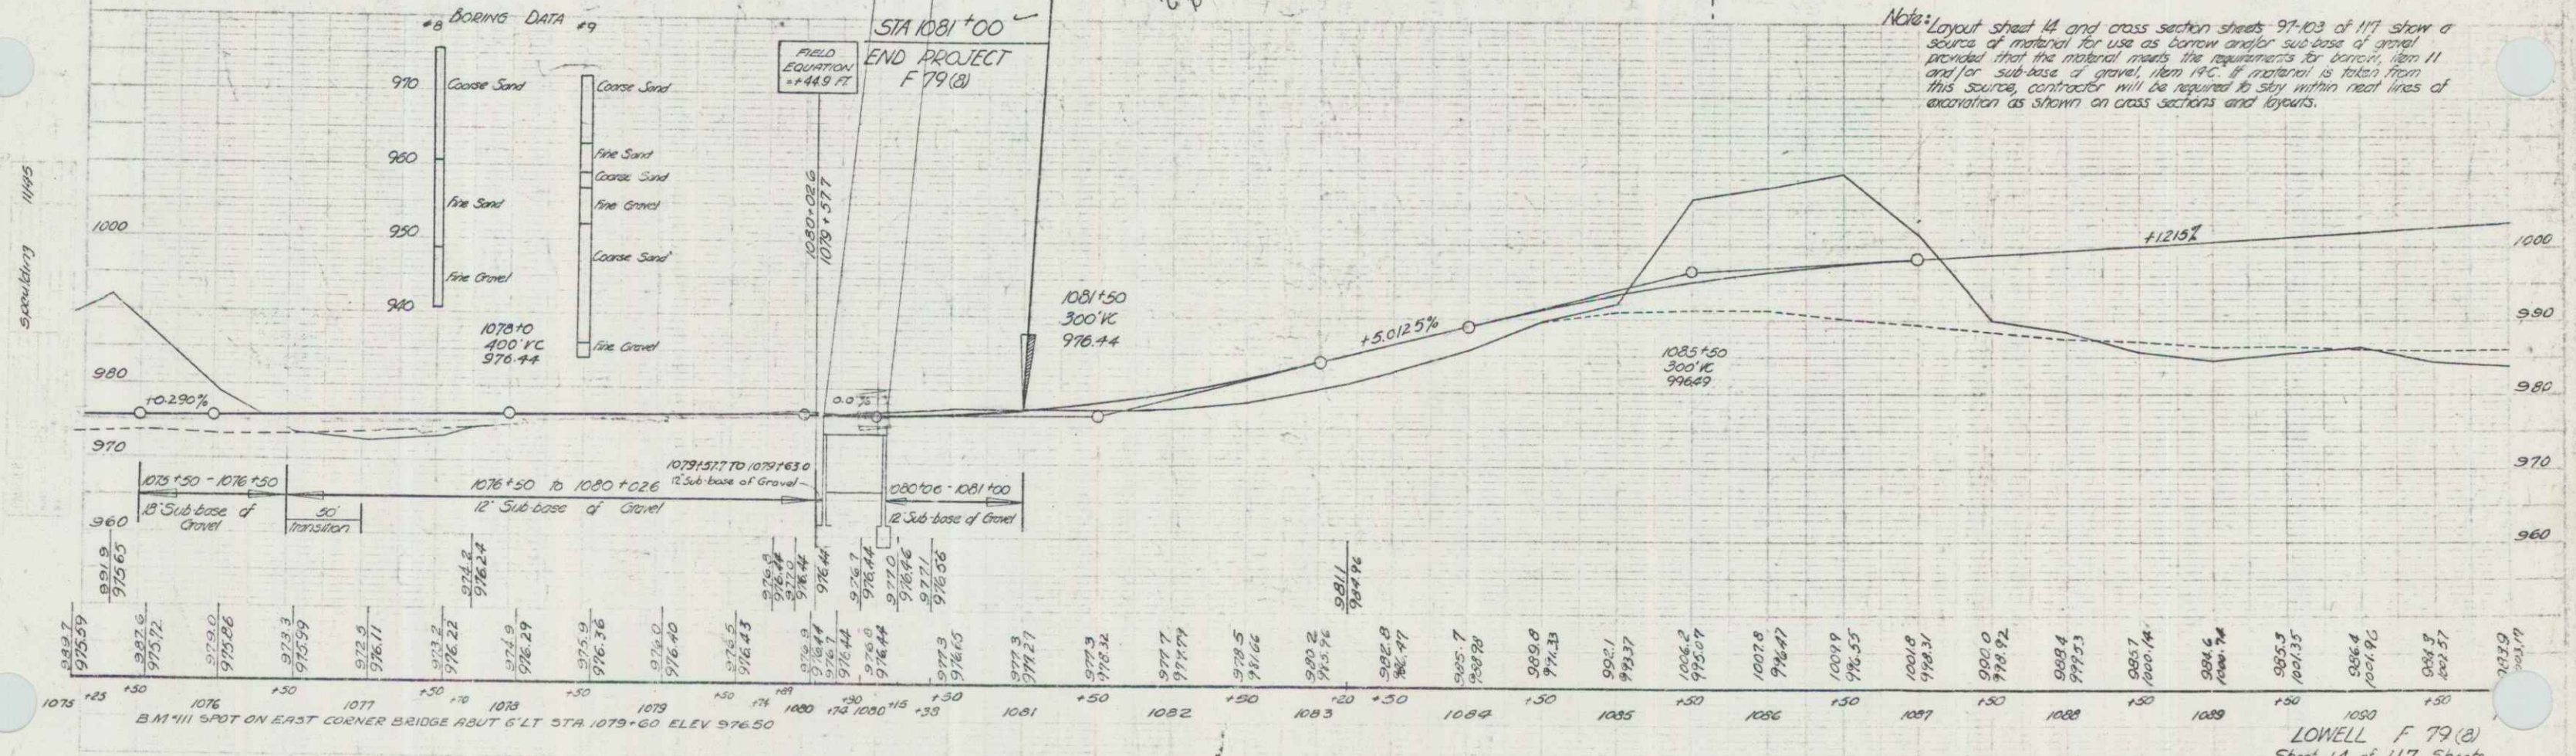

LOWELL F 79 (2)
Sheet 14 of 117 Sheets