
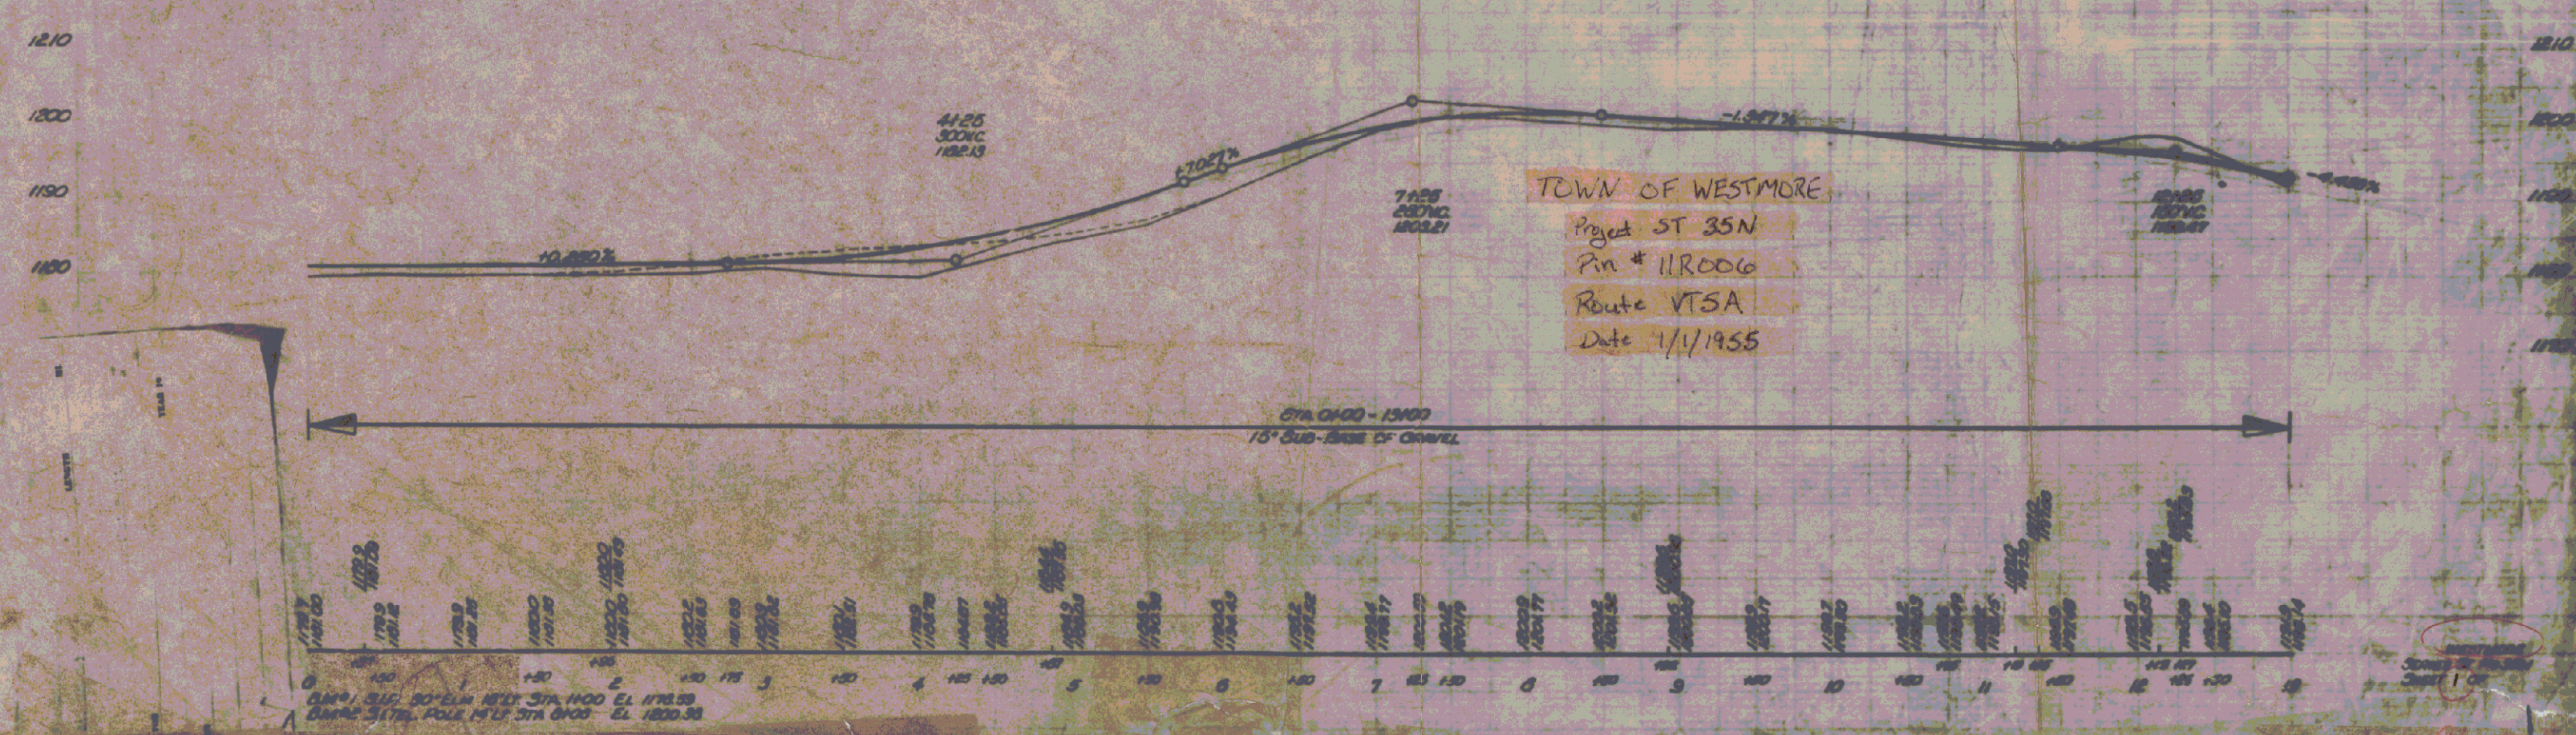


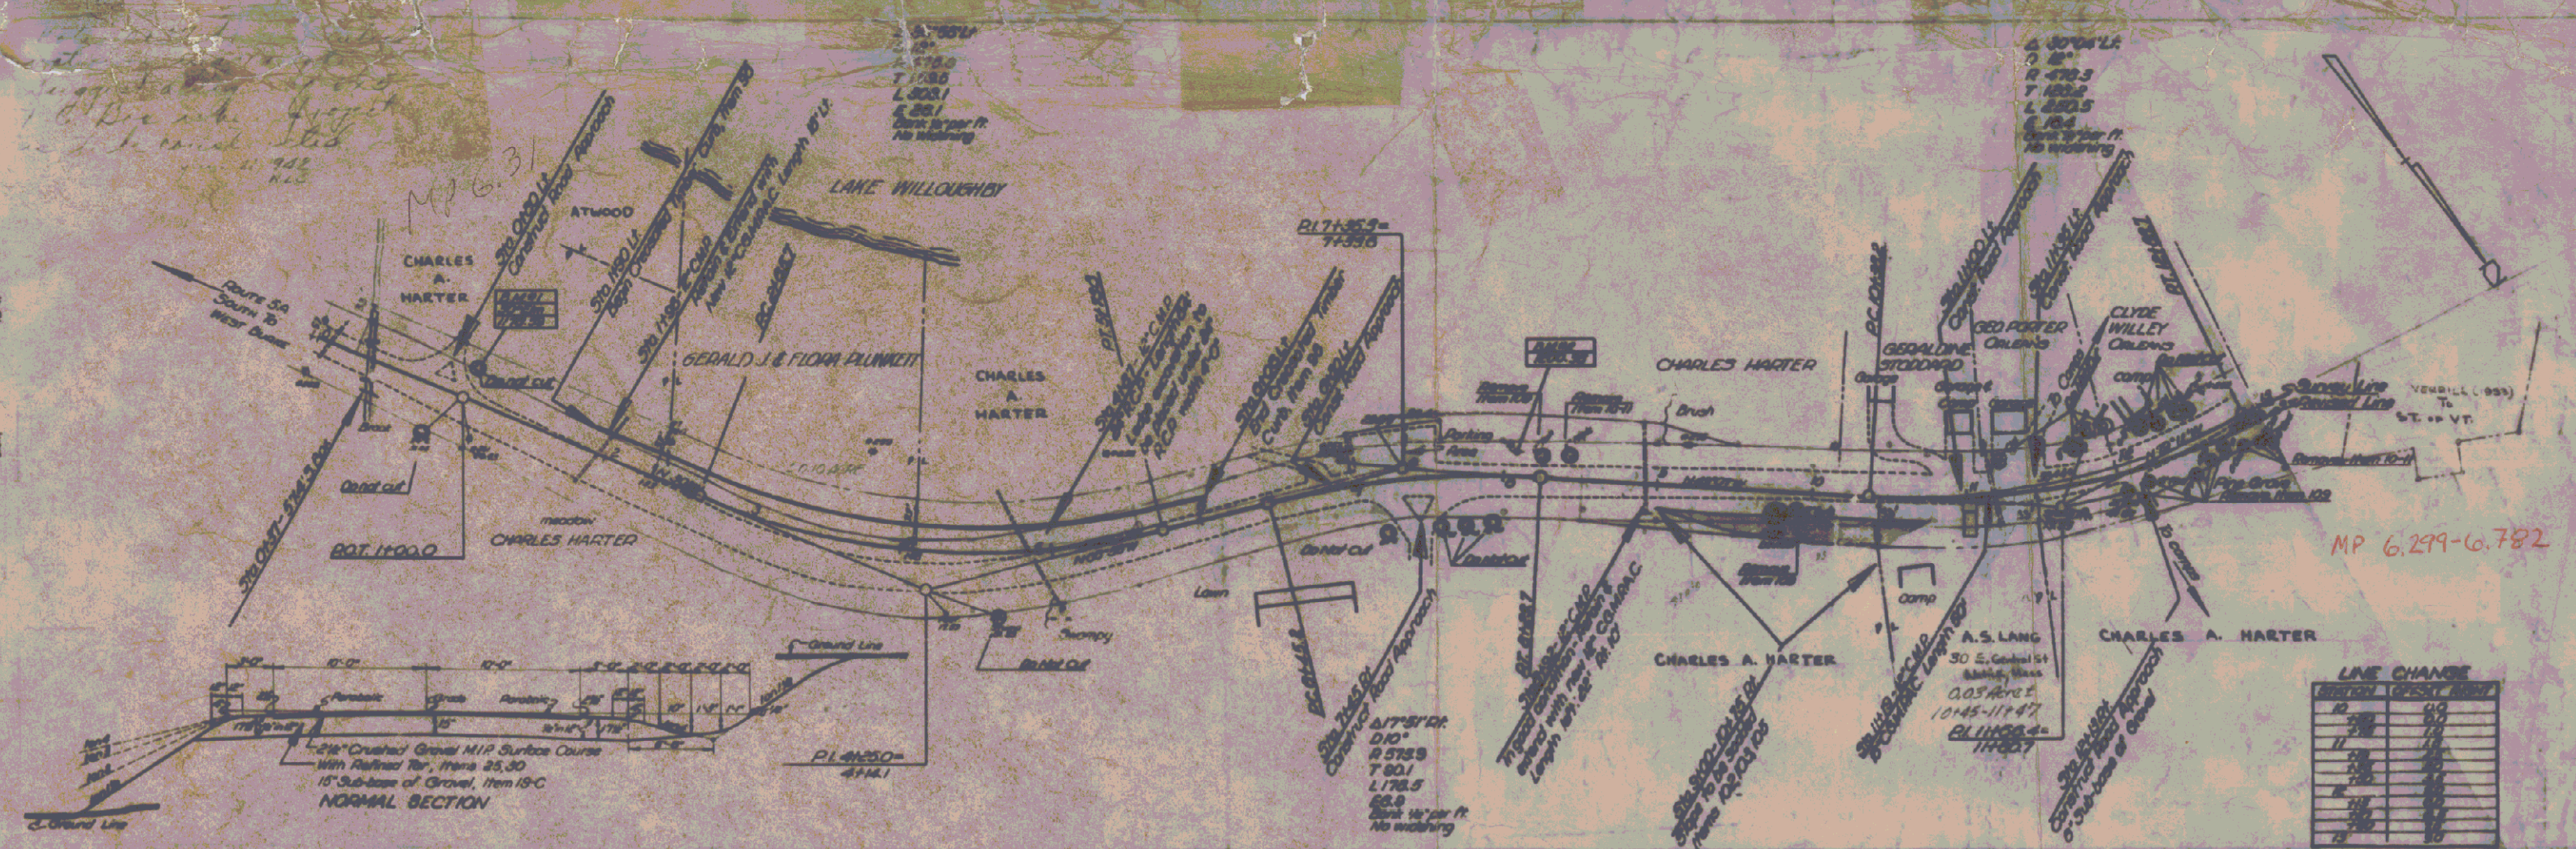

11820