


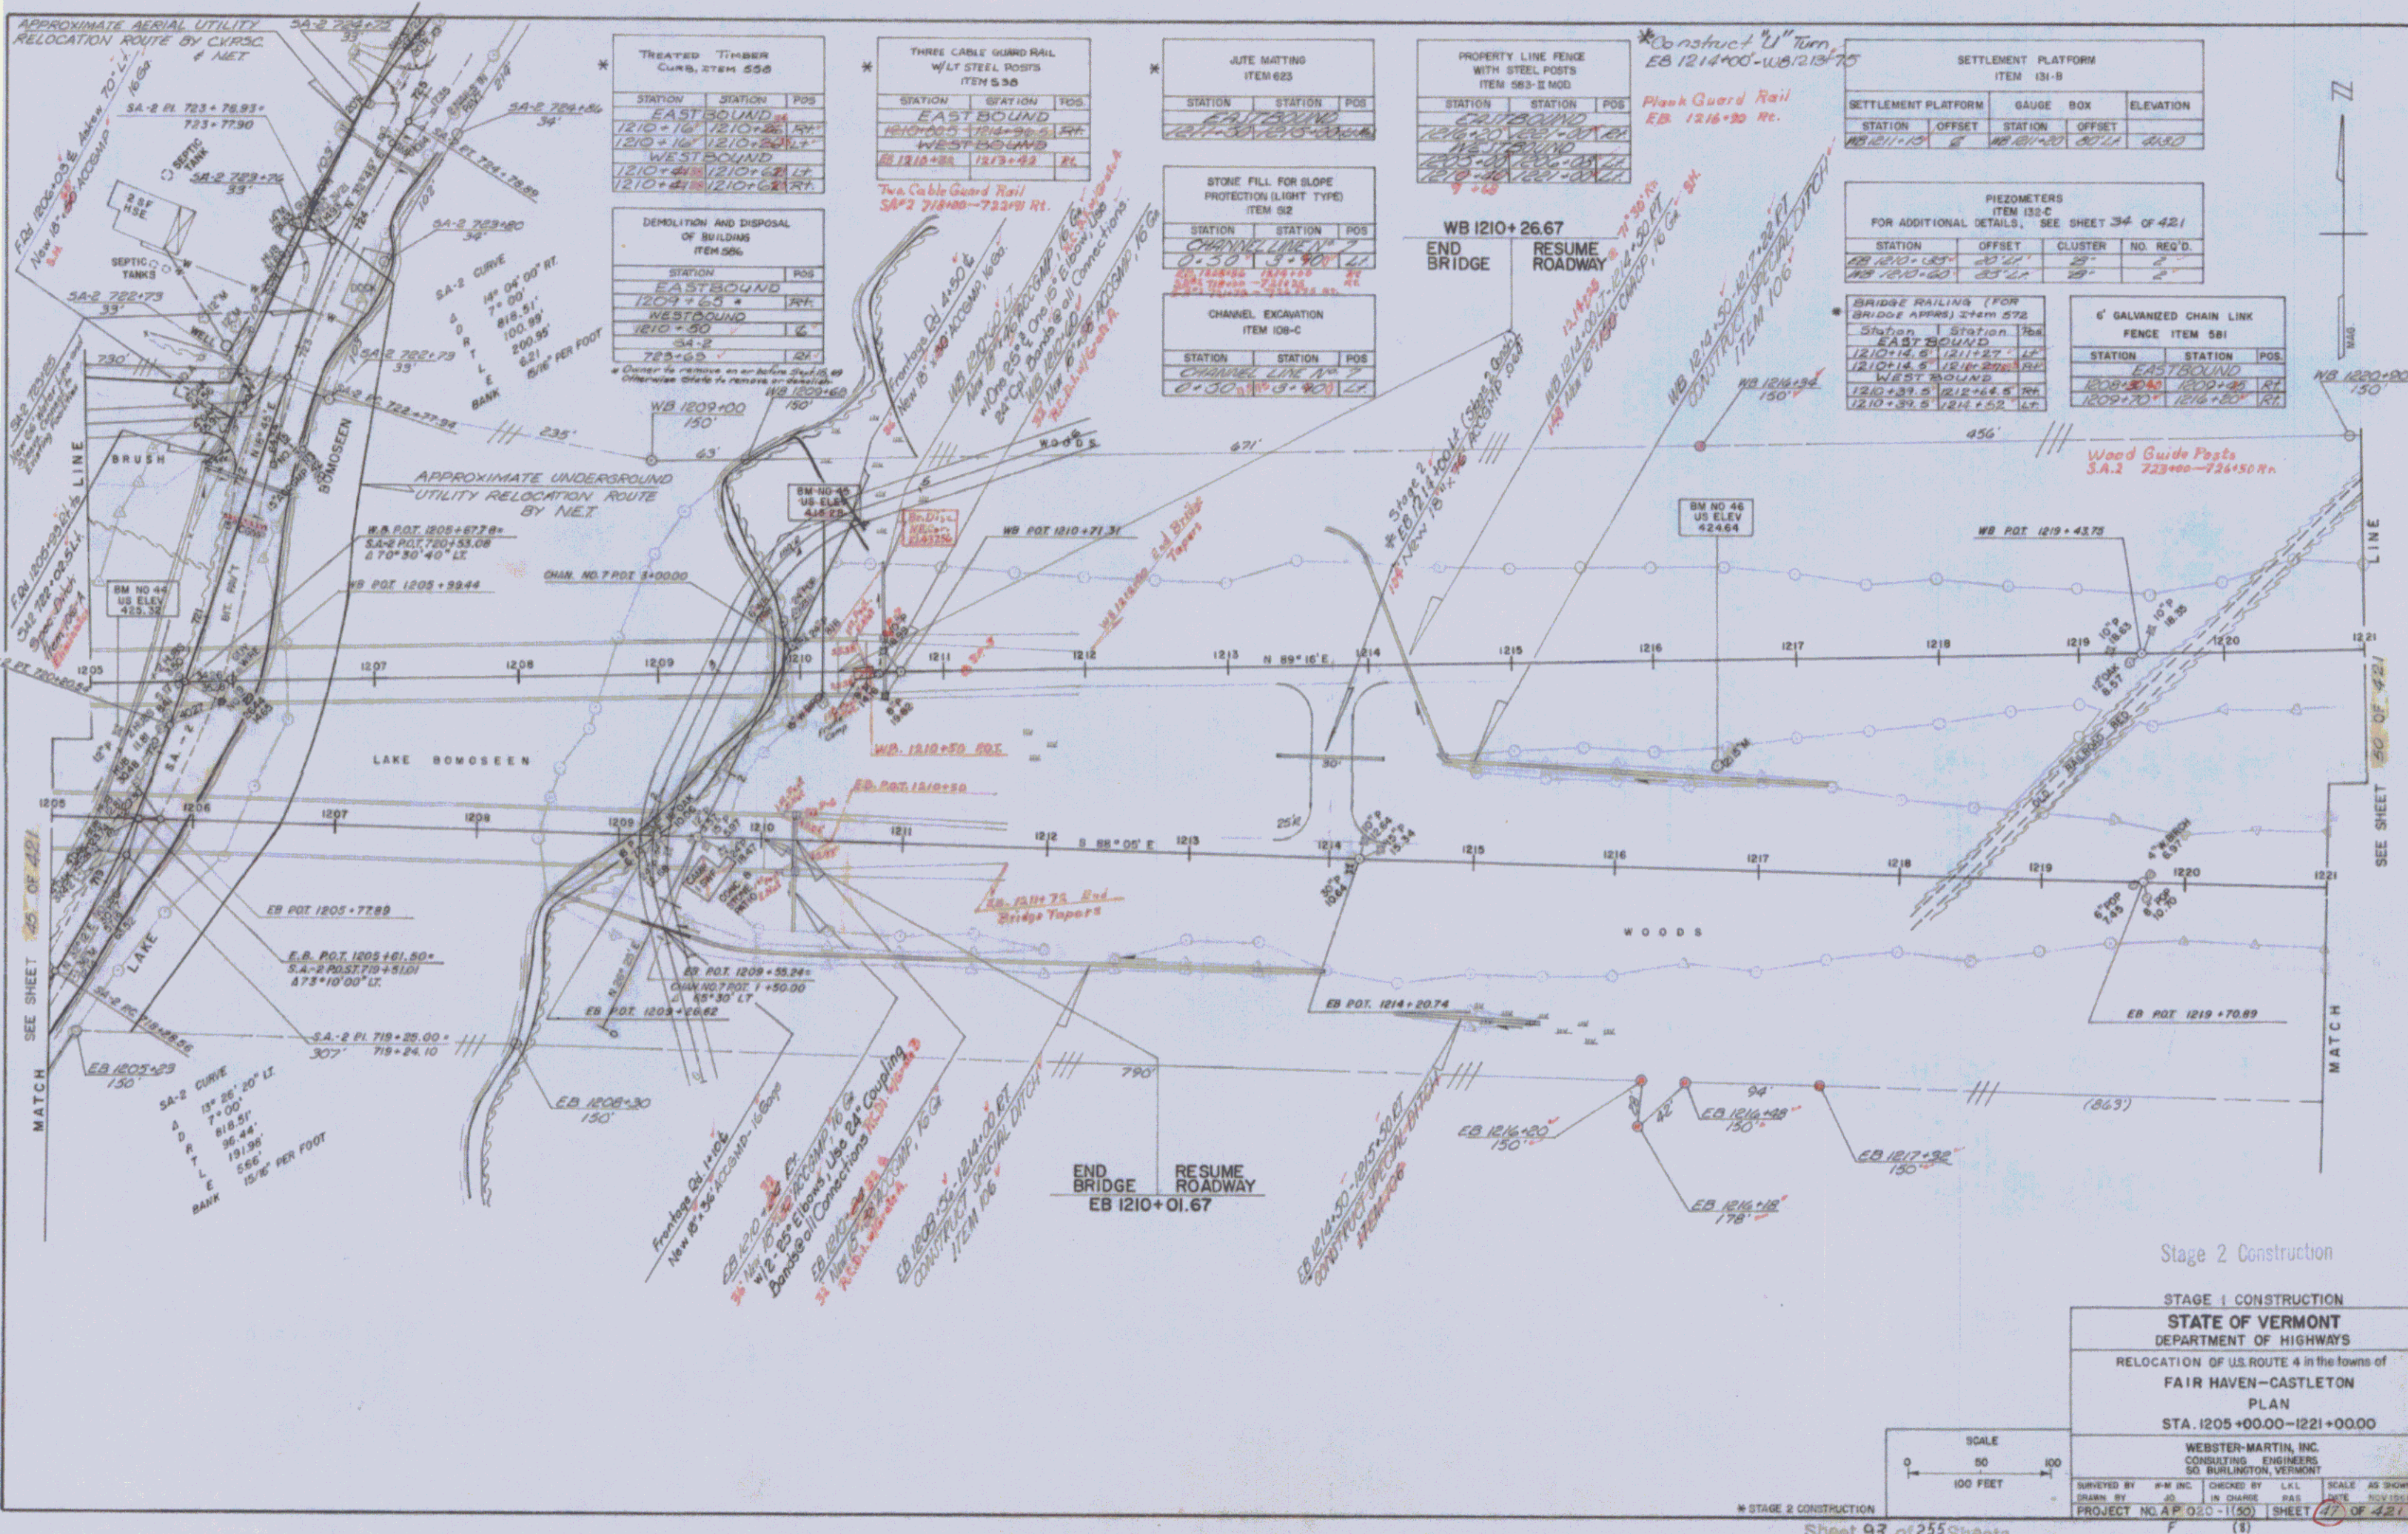

Stage 2 Construction

STAGE 1 CONSTRUCTION

STATE OF VERMONT
DEPARTMENT OF HIGHWAYS

RELOCATION OF U.S. ROUTE 4 in the towns of
FAIR HAVEN—CASTLETON

PLAN

STA. 1205+00.00—1221+00.00

WEBSTER-MARTIN, INC.
CONSULTING ENGINEERS
50 BURLINGTON, VERMONT

SURVEYED BY: J.M. INC. CHECKED BY: L.A.L. DATE: NOV 1958
DRAWN BY: J.S. IN CHARGE: P.A.S. SHEET: 17 OF 421

PROJECT NO. A.P. 020-1150

SCALE 0 50 100 FEET

Sheet 93 of 255 Sheets