
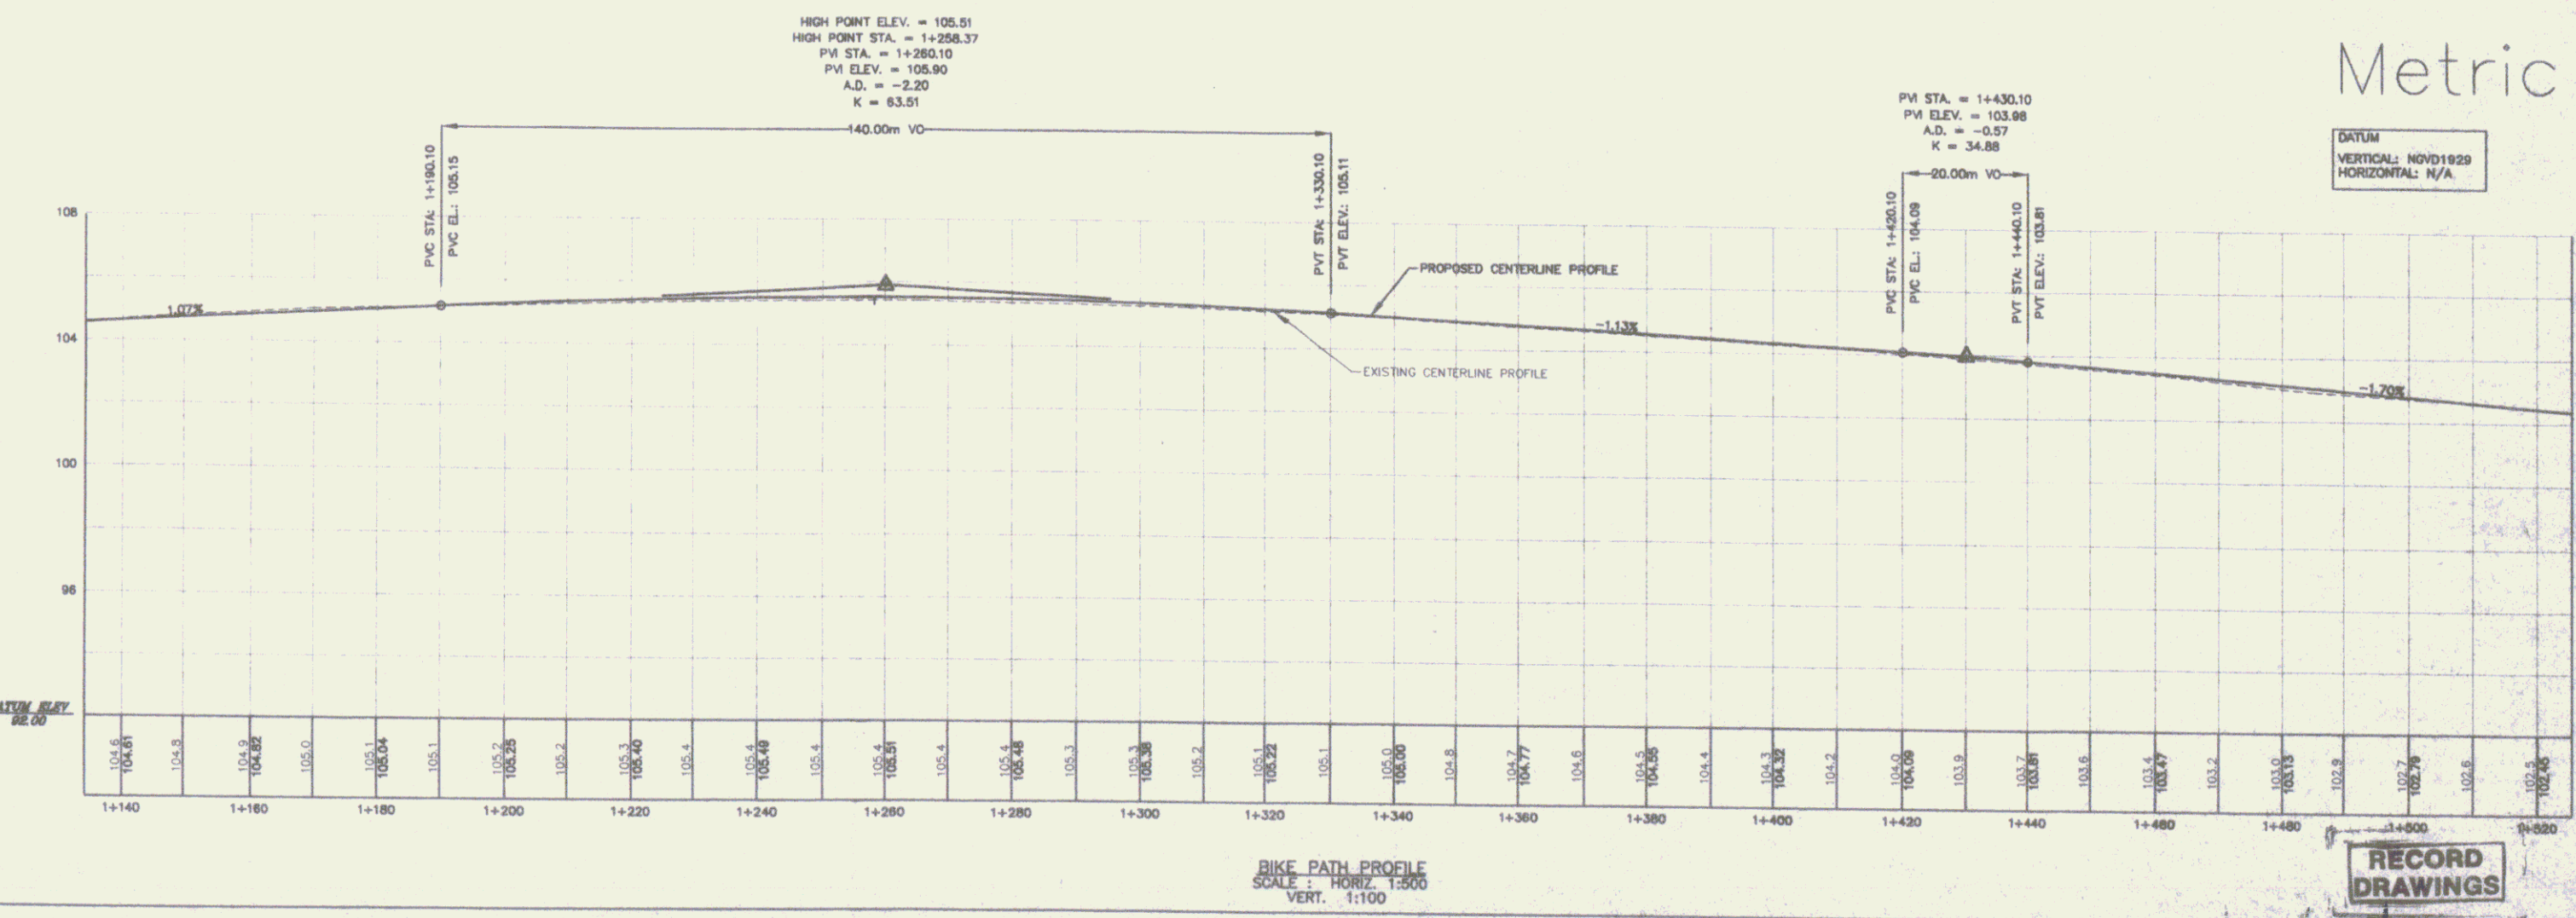


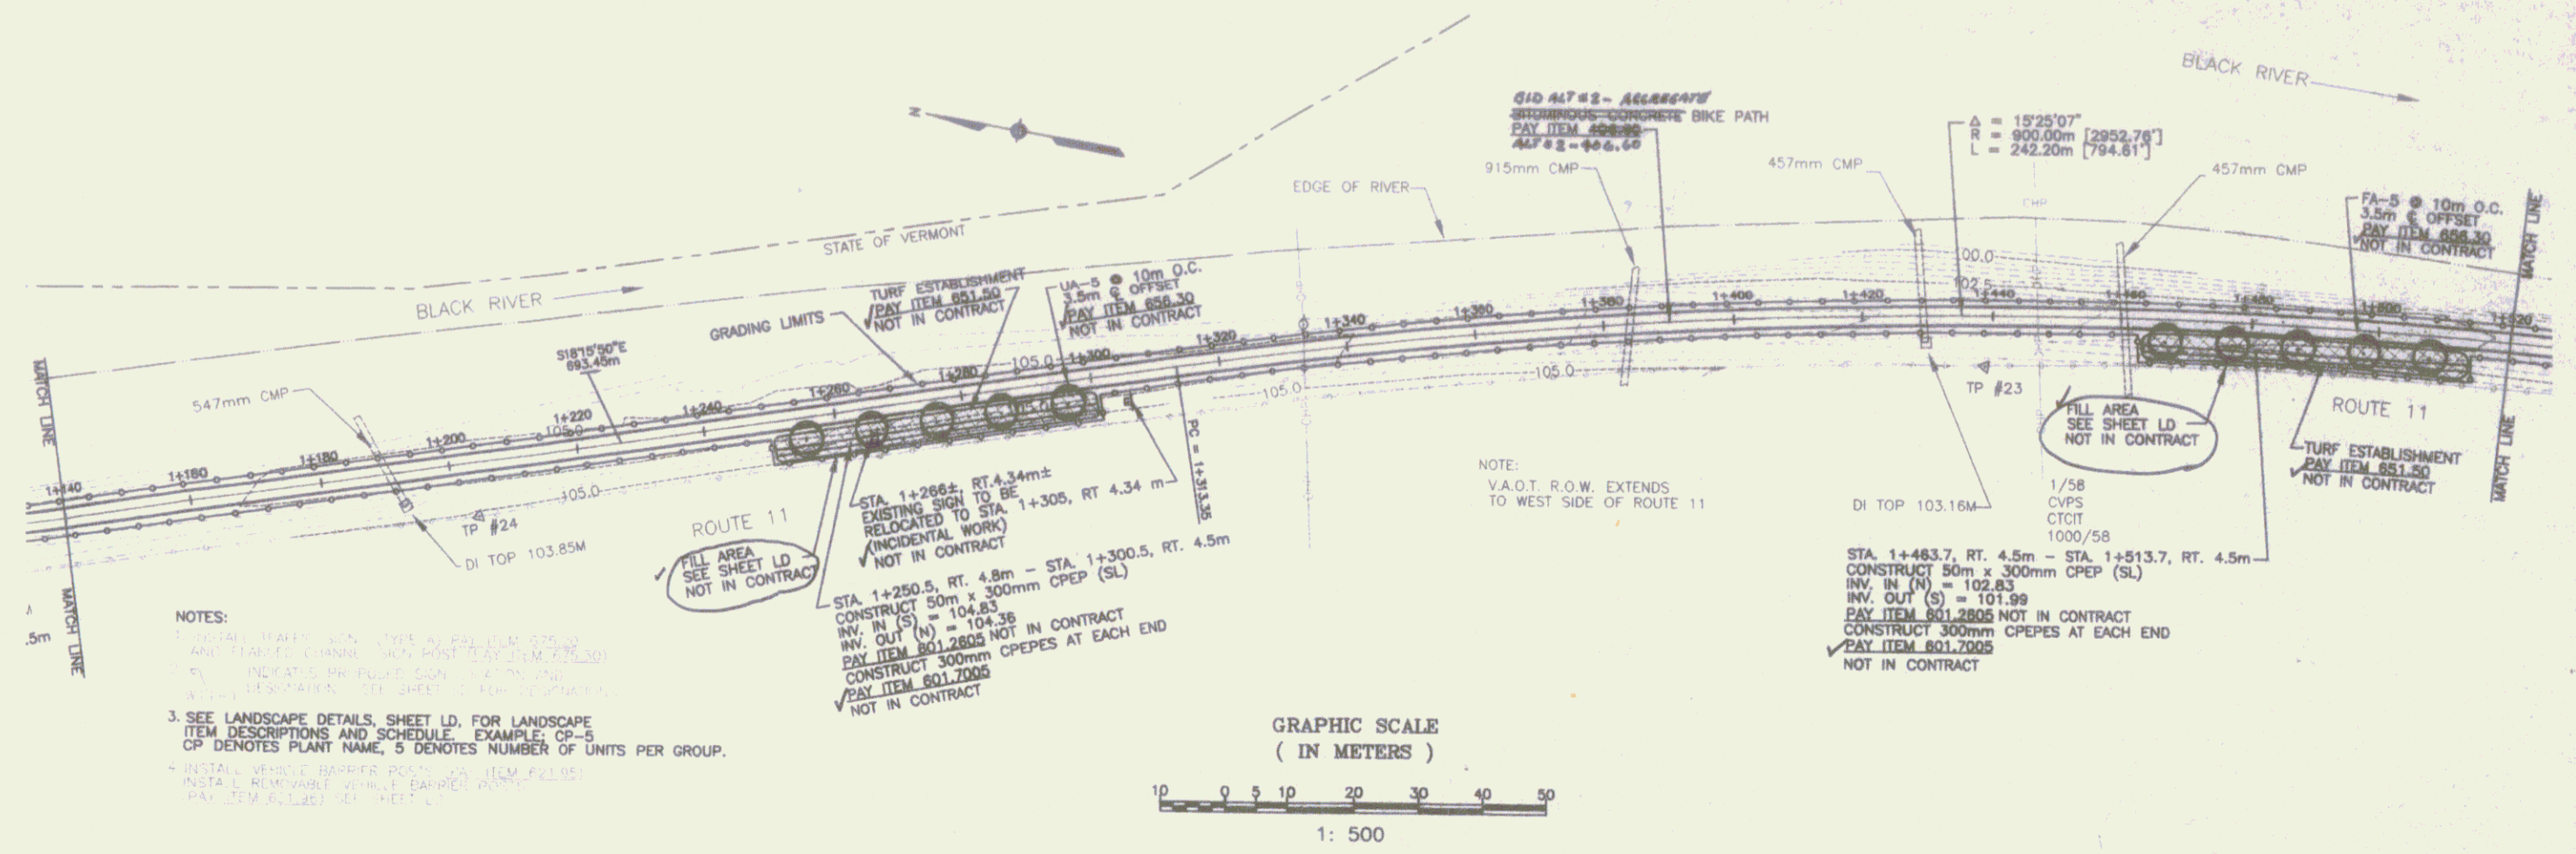

Engineering and project information block containing:

- Project title: SPRINGFIELD TRANSPORTATION PATH PHASE 1
- Location: TOWN OF SPRINGFIELD, VERMONT
- Sheet title: PLAN AND PROFILE
- Scale: METRIC
- Record drawings stamp: RECORD DRAWINGS
- Sheet number: PP4
- Sheet count: SHEET 6