

1. Title Sheet and Typical Cross Section of Improvement
2. Plan and Profile Sheet
3. Standard Sheet E-2(B) Barricades, Signs and Lights
4. Bridge Plan and Elevation Views
5. Slab Details
6. Railing Details
7. Abutments "H" #2, Plan, Elevation and Details
8. Reinforcing Steel Schedule
- 9-10. Roadway Sections
- 11-13. Channel Sections

[illegible]

SURVEY LINE
 TOWN LINE
 FENCE LINE
 STORE WALL
 FENCED PROPERTY
 GUARD RAIL
 TRAVELED HWY
 RAILROAD
 RETAINING WALL
 CENTER LINE
 SURVEY LINE
 CLAYERS
 DROP IN
 TROUGH
 POWER POLE
 TELEPHONE
 TREE
 HEDGE

GRADE ELEVATION
 GRADE ELEVATION
 CURVE DATA
 POINT OF CURVE
 RADIUS OF CURVE
 CHORD BEARING
 LENGTH OF CURVE
 EXTERNAL DISTANCE
 POINT OF INTERSECTION
 POINT OF CURVE
 POINT OF TANGENCY
 POINT ON TANGENT
 POINT ON TANGENT

33
 Box
 33



51-99L
 Kelly Construction, Inc.
 Project Completed: Oct. 1994
 Word Rings: A & Mac Dargel

33
 Box
 33

PROPOSED IMPROVEMENT

TOWN OF GROTON

GROTON STATE FOREST
COUNTY OF CALEDONIA
GROTON-MARSHFIELD STATE HIGHWAY
BEGINNING AT A POINT APPROXIMATELY 3.2 MI. NORTHWESTERLY
OF THE JUNCTION OF U.S. 302 AND GROTON-MARSHFIELD STATE
HIGHWAY AND EXTENDING NORTHWESTERLY 2.23 FEET.
LENGTH OF ROADWAY=200 FEET=0.038 MI.
LENGTH OF BRIDGE = 23 FEET=0.004 MI.
LENGTH OF PROJECT =223 FEET=0.042 MI.

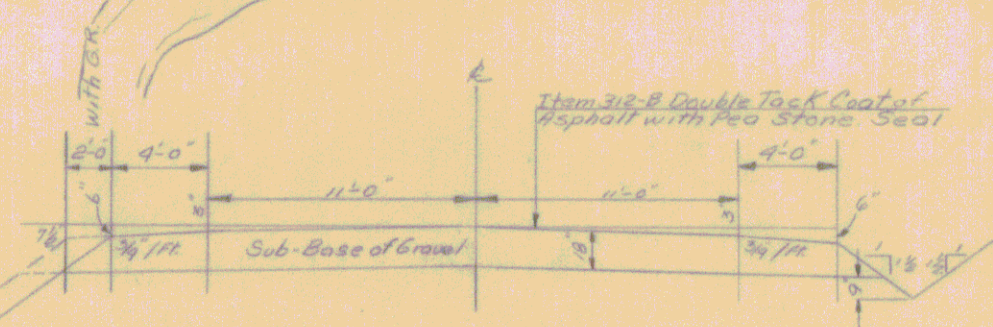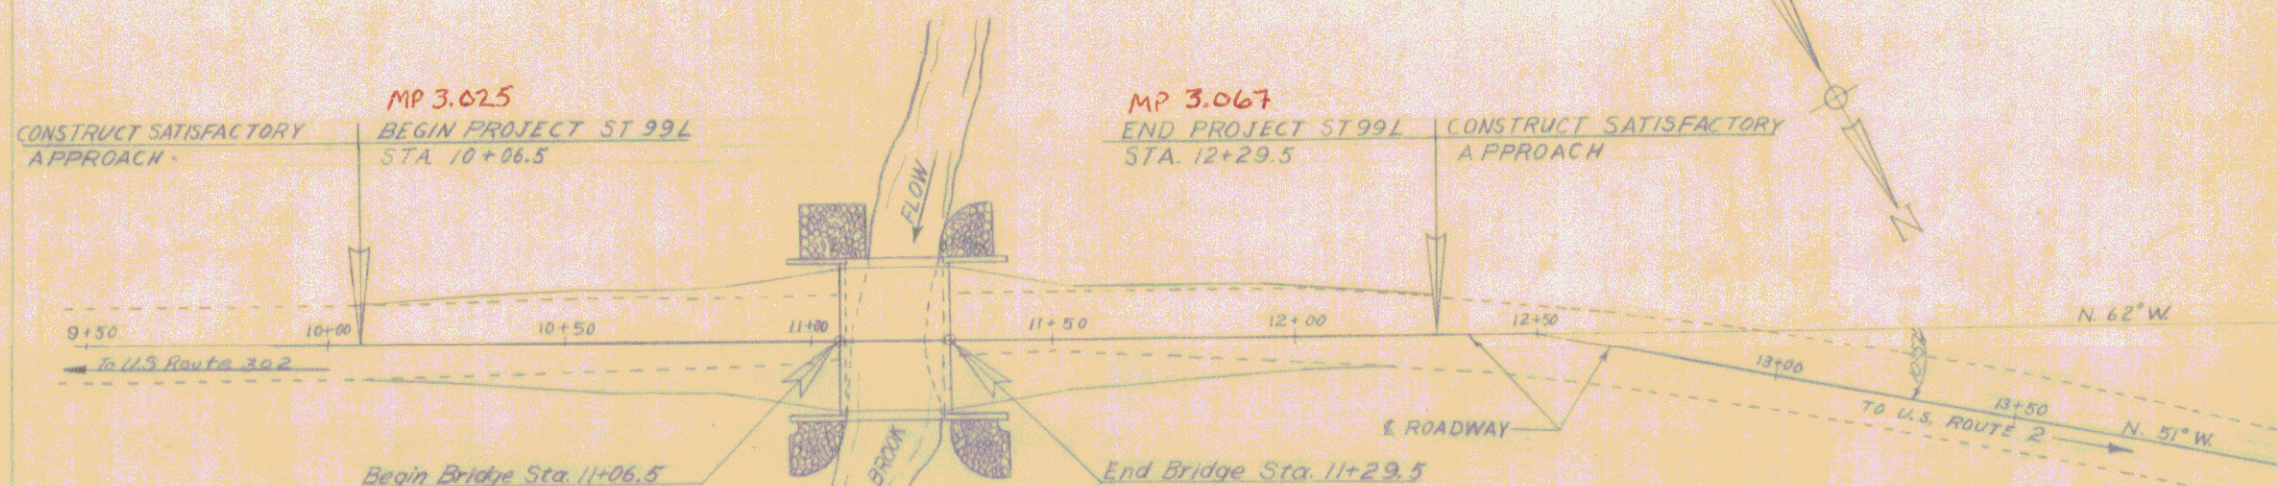

DEPARTMENT OF FISH & GAME
COMMISSIONER George H. Brown
DATE Sept 5, 1963

DEPARTMENT OF FORESTS & PARKS
COMMISSIONER *Harry H. Merrill*
DATE *9/5/63*

DEPARTMENT OF WATER RESOURCES
COMMISSIONER R. W. Dieme
DATE Sept 5, 1963

RECOMMENDED FOR APPROVAL *Embryon*
DATE *9/6/63*

RECOMMENDED FOR APPROVAL *RJ Lumb*
DATE *9/16/63*

APPROVED: A. O. Berhop
DATE: 2/5/64

5799L

SUMMARY OF QUANTITIES				Route VT232		
ITEM NO.	ITEM	UNIT	BRIDGE RAMP		TOTAL	TOTAL LEINA
			Abut 1	Abut 2		
101-A	Common Excavation	C.Y			560	560
101-B	Solid Rock Excavation	C.Y			20	20
104	Clearing and Grubbing	C.S			1/2	1/2
105	Unclassified Channel Exp.	C.Y			30	30
107	Structure Excavation	C.Y	95	105	200	200
109	Maintenance of Traffic					
	For Bridge Project	C.S			1/2	1/2
119	Bulldozer Rental	HR			5	5
201-A	Sub-base of Gravel					
	measured in Place	C.Y			500	500
211	Gravel Overhaul	C.Y/mi			1000	1000
222	Gravel Backfill	C.Y	25	27	52	52
312-B	Double Tack Coat of Asphalt					
	with Pea Stone Seal	Gal			565	565
401-B	Concrete Class 8 Modified	C.Y	35	36	71	71
902	Reinforcing Steel	LB	592	723	1315	1315
991-B	One Way Temporary Bridge	C.S			1	1
992	Removal of Present					
	Superstructure	C.S			1	1
542	Stonefill for Slope Protection	C.Y	20	15	35	35
572	Bridge Paving				140	140
611	Seeding	LB			55	55
615	Commercial Fertilizer for Grasses	LB			700	700
622	Mulch	Ton			100	100