

INDEX OF SHEETS

1	TITLE PAGE
2	TYPICAL CROSS-SECTION OF IMPROVEMENT
3	BANKING AND WIDENING TABLES
4	QUANTITY SHEET (ITEMS)
5	QUANTITY SHEET (DRAINAGE)
6-7	EARTHWORK SHEETS
8-11	PLAN AND PROFILE SHEETS
12	DETAILS - 120" CORR. GALV. METAL PLATE PIPE
13	CONSTRUCTION DETAILS (DRAINAGE AND MARKERS)
14	CONSTRUCTION DETAILS CD 1 (DITCHES)
15	CONSTRUCTION DETAILS CD 2 (TYPICAL GRADING)
16	CONSTRUCTION DETAILS CD 4 (GRANITE CURB)
17	STANDARD STRUCTURE SHEET S 40 (BARRICADES, SIGNS AND LIGHTS)
18	STANDARD STRUCTURE SHEET S 48-46 (THREE CABLE GUARD RAIL W/STEEL POSTS)
18A	STANDARD STRUCTURE SHEET (DEAD END ANCHORAGE AT BRIDGE APPROACH)
19	STANDARD STRUCTURE SHEET 53-48 (PRECAST DROP INLETS)
20-41	CROSS SECTIONS
42	PRELIMINARY INFORMATION SHEET
43	BRIDGE PLAN & ELEVATION
44	CUBICAL SPIRAL-EASEMENT CURVE
45	DETAILS OF ABUTMENT NO. 1
46	DETAILS OF PIER NO. 1
47	DETAILS OF PIER NO. 2
48	DETAILS OF PIER NO. 3
49	DETAILS OF PIER NO. 4
50	DETAILS OF ABUTMENT NO. 2
51	SUPERSTRUCTURE SO APPROACH SPAN
52	SUPERSTRUCTURE CONTINUOUS SPAN
53	DETAILS OF BM. DIAPH. BRGS. CONT. SPAN
54	SUPERSTRUCTURE NO. APPROACH SPAN
55	SIDEWALK EXP. JOINT ABUTMENT NOS. 1 & 2
56	SIDEWALK EXP. JOINT PIER NOS. 1 & 4
57	LAYOUT OF BRIDGE RAIL
58	DETAILS OF POST AND RAILING AND SUMMARY OF EST. QUANTITY
59	SO. APPROACH SLAB
60	NO. APPROACH SLAB
61	STANDARD STRUCTURE SHEET SB-20 (DETAIL D.L.N.)
62	STANDARD STRUCTURE SHEET SB-11 (BARRICADES, SIGNS AND LIGHTS)
63-68	SO. CHANNEL SECTIONS
69-70	NO. CHANNEL SECTIONS

STANDARD STRUCTURE SHEET APPROVED BY THE CHIEF ENGINEER, VERMONT STATE DEPARTMENT OF HIGHWAYS.

S 40 JUNE 10, 1950

STATE OF VERMONT
STATE HIGHWAY DEPARTMENT

PLAN AND PROFILE OF PROPOSED
STATE HIGHWAY

FEDERAL INTERSTATE PROJECT

TOWN OF ST. JOHNSBURY

COUNTY OF CALEDONIA


U.S. ROUTE 5

ST. JOHNSBURY-LYNDONVILLE ROAD

BEGINNING AT A POINT 12,110.0 FEET NORTHERLY OF THE NORTHERLY VILLAGE LIMITS OF THE VILLAGE OF ST. JOHNSBURY AND EXTENDING NORTHERLY 2,550.0 FT.

LENGTH OF ROADWAY 2092.04 FT. = 0.396 MI.
LENGTH OF BRIDGE 457.96 FT. = 0.087 MI.
LENGTH OF PROJECT 2550.0 FT. = 0.483 MI.

FED. ROAD DIST. NO.	STATE	PROJ. NO.	FILED NO.	TOTAL SHEETS
1	VT.	FL 115(17)	POST 1	70

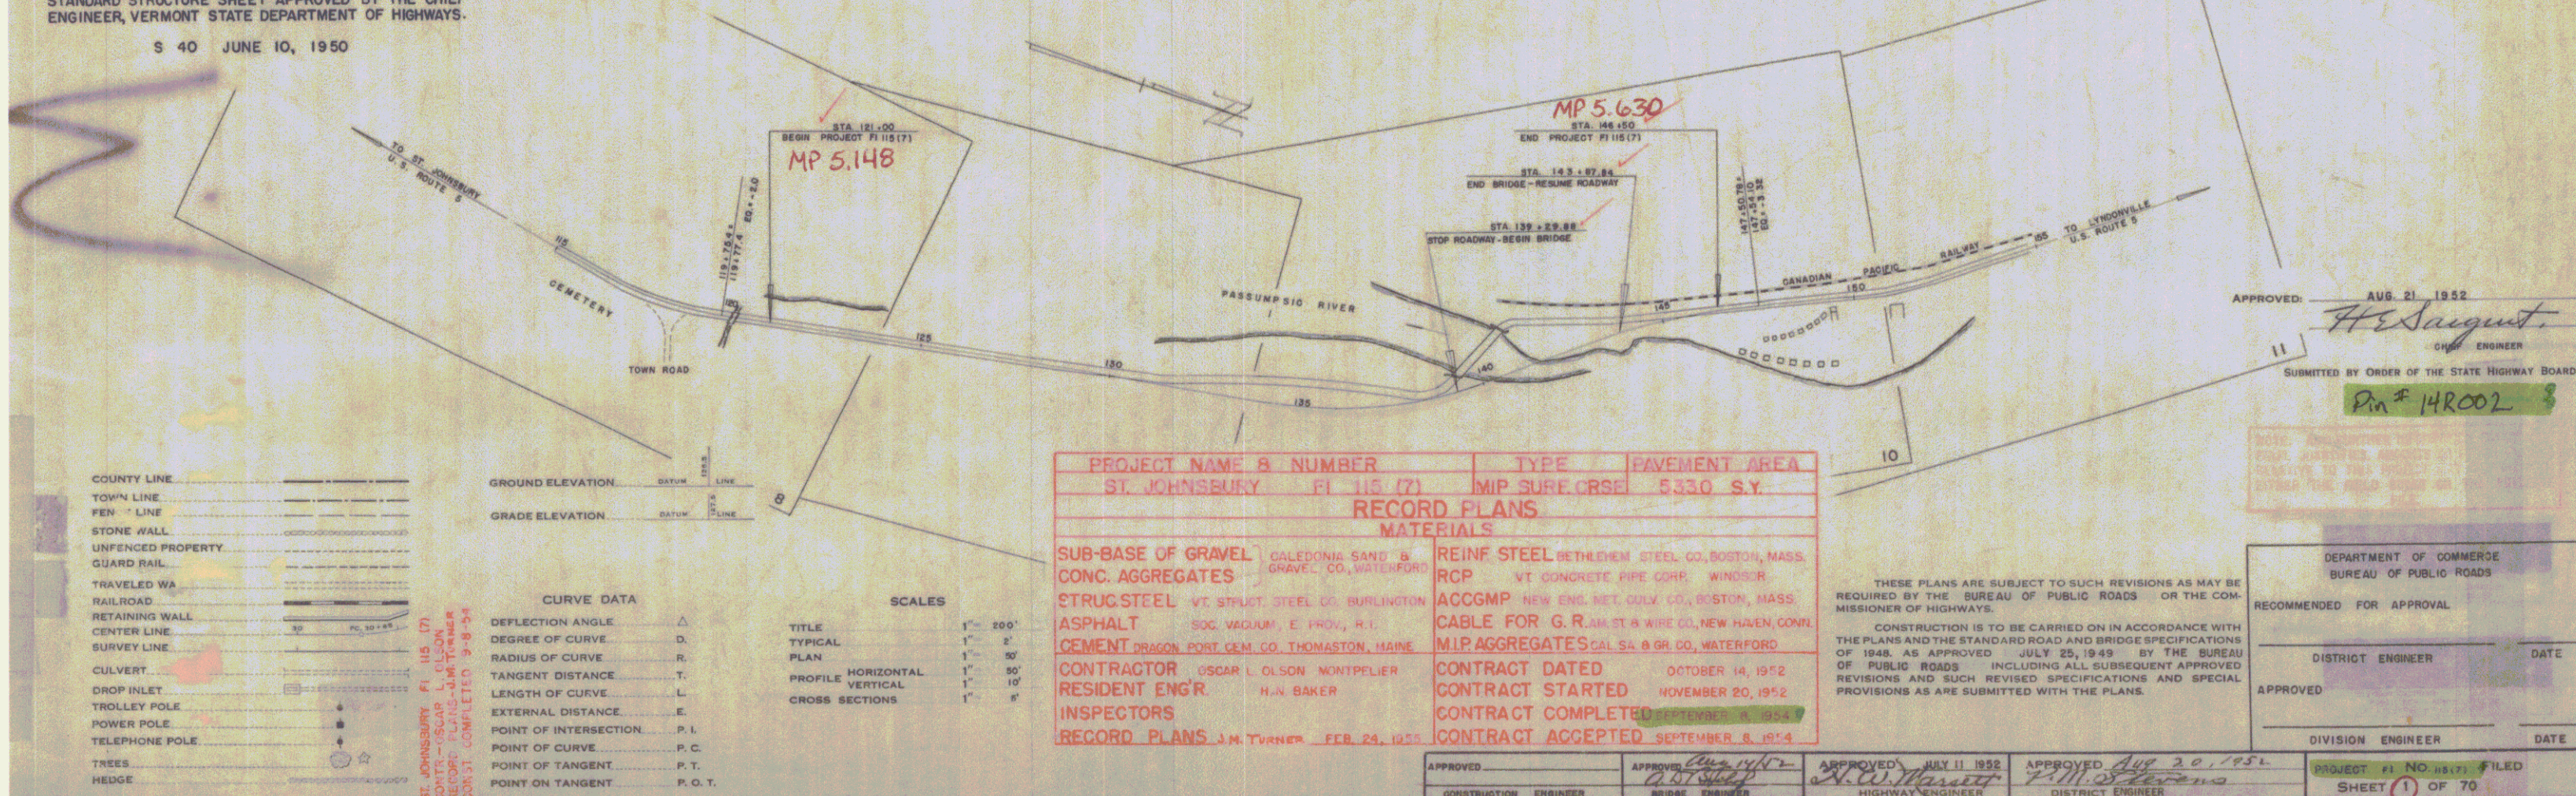

PROJECT NAME & NUMBER	TYPE	PAVEMENT AREA
ST. JOHNSBURY FL 115(17)	MIP SURFACE	5330 S.Y.
RECORD PLANS		
MATERIALS		
SUB-BASE OF GRAVEL	CALEDONIA SAND & GRAVEL CO., WATERFORD	REINF. STEEL BETHLEHEM STEEL CO., BOSTON, MASS.
CONC. AGGREGATES	VT. CONCRETE PIPE CORP., WINDSOR	RCP
STRUC. STEEL	VT. STRUCT. STEEL CO., BURLINGTON	ACCGMP NEW ENG. MET. CO., BOSTON, MASS.
ASPHALT	SOC. VACUUM, E. PROV., R.I.	CABLE FOR G. R. JAMES & SONS CO., NEW HAVEN, CONN.
CEMENT	PORT CEM. CO., THOMASTON, MAINE	MIP AGGREGATES CAL. S. & GR. CO., WATERFORD
CONTRACTOR	OSCAR L. OLSON, MONTPELIER	CONTRACT DATED
RESIDENT ENG'R	H.W. BAKER	CONTRACT STARTED
INSPECTORS		CONTRACT COMPLETED
RECORD PLANS	J.M. TURNER, FEB. 24, 1955	CONTRACT ACCEPTED

THESE PLANS ARE SUBJECT TO SUCH REVISIONS AS MAY BE REQUIRED BY THE BUREAU OF PUBLIC ROADS OR THE COMMISSIONER OF HIGHWAYS.

CONSTRUCTION IS TO BE CARRIED ON IN ACCORDANCE WITH THE PLANS AND THE STANDARD ROAD AND BRIDGE SPECIFICATIONS OF 1948, AS APPROVED JULY 25, 1949 BY THE BUREAU OF PUBLIC ROADS INCLUDING ALL SUBSEQUENT APPROVED REVISIONS AND SUCH REVISED SPECIFICATIONS AND SPECIAL PROVISIONS AS ARE SUBMITTED WITH THE PLANS.

DEPARTMENT OF COMMERCE
BUREAU OF PUBLIC ROADS
RECOMMENDED FOR APPROVAL

DISTRICT ENGINEER DATE

APPROVED DIVISION ENGINEER DATE

APPROVED	APPROVED	APPROVED	APPROVED	PROJECT FILE NO. 115(17) FILED
CONSTRUCTION ENGINEER	BRIDGE ENGINEER	HIGHWAY ENGINEER	DISTRICT ENGINEER	SHEET (1) OF 70