


INDEX OF SHEETS
SHEET NO. 1 TITLE PAGE
- 2 PLAN AND PROFILE STA. 0+00 TO 5+00
- 3 & 4 BRIDGE STA. 1+03.8

STATE OF VERMONT
STATE HIGHWAY DEPARTMENT

PLAN AND PROFILE OF PROPOSED
STATE HIGHWAY
FEDERAL AID PROJECT

TOWN OF POWNAL
NORTH POWNAL BRIDGE
OVER HOOSIC RIVER AT STATE LINE

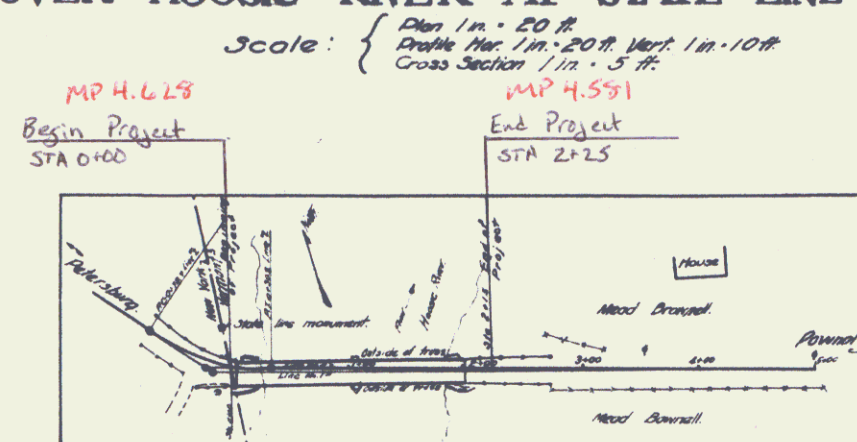


LAYOUT
Scale 1 in. = 80 ft.

CONVENTIONAL SIGNS

COUNTY LINE	GROUND ELEVATION	DEFLECTION ANGLE
TOWN LINE	GRADE ELEVATION	DEGREE OF CURVE
FENCE LINE		RADIUS OF CURVE
STONE WALL		TANGENT DISTANCE
UNFENCED PROPERTY		LENGTH OF CURVE
GUARD RAIL		EXTERNAL DISTANCE
TRAVELED WAY		POINT OF INTERSECTION
RAILROAD		POINT OF CURVE
RETAINING WALL		POINT OF TANGENT
CENTER LINE		
SURVEY LINE		
CULVERT		
DROP INLET		
TROLLEY POLE		
POWER POLE		
TELEPHONE POLE		
TREES		
AGE		

FILED
STATE
DATE
BY
33 18 7 4

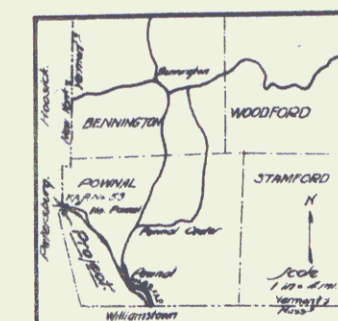

Pin # 245111

Route VT346

Date 1/1/1924

SUBMITTED BY ORDER OF THE STATE HIGHWAY BOARD

CHIEF ENGINEER
DEPARTMENT OF HIGHWAYS

RECOMMENDED
DISTRICT ENGINEER
BUREAU OF PUBLIC ROADS
RECOMMENDED FOR APPROVAL
CHIEF ENGINEER
BUREAU OF PUBLIC ROADS
APPROVED
DIRECTOR - BUREAU OF PUBLIC ROADS

SERIES F No. 59 FILED
SHEET 1 OF 4